

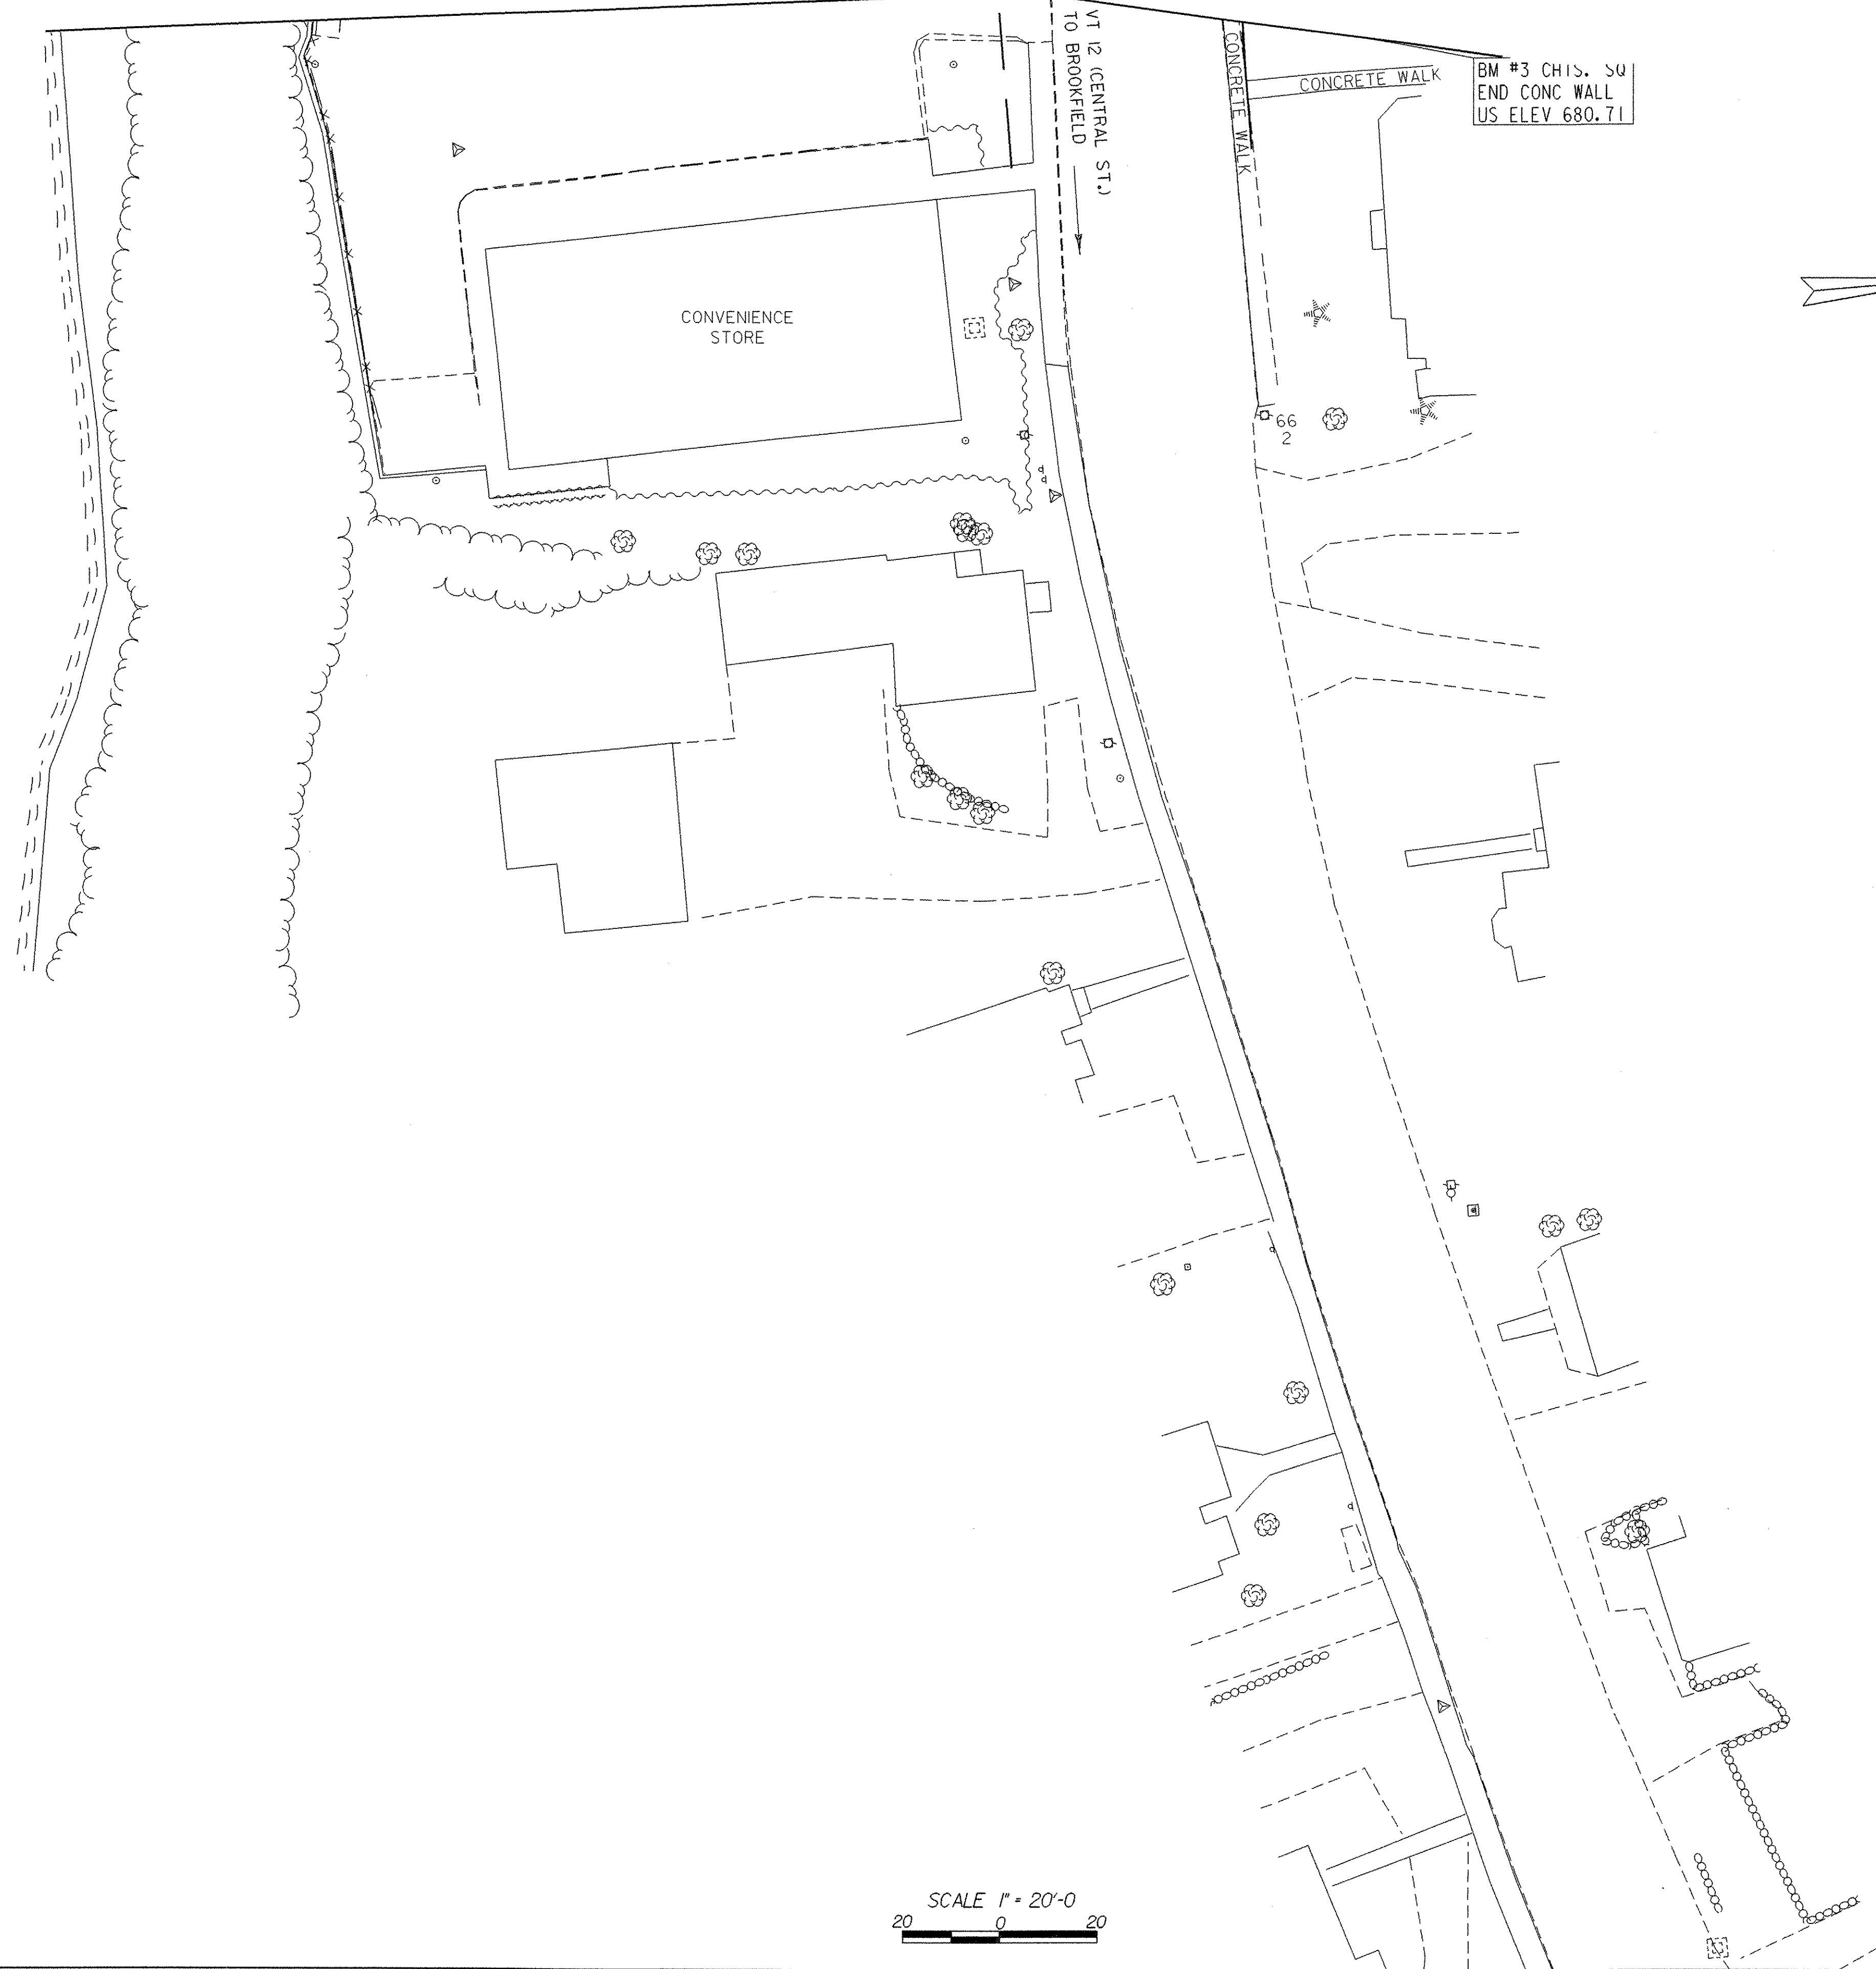


MATCH LINE D-D

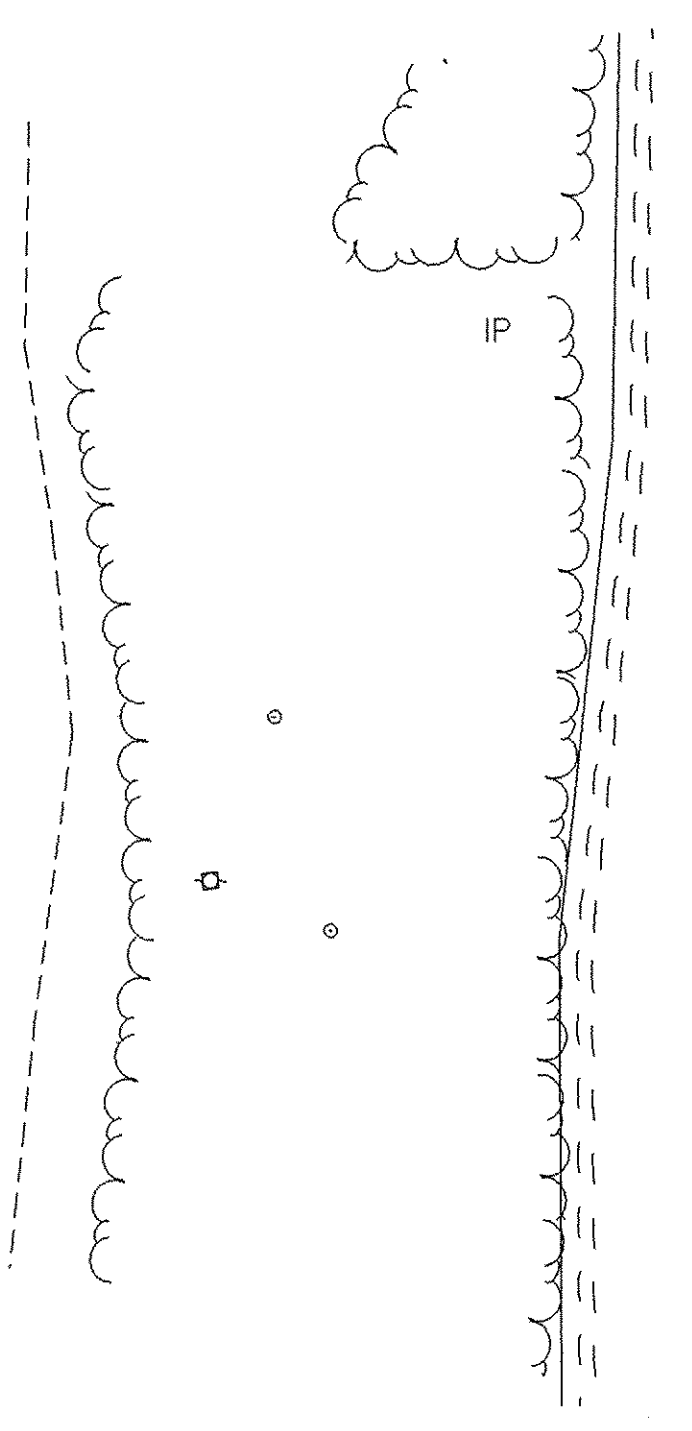

BM #3 CHIS. SQ  
END CONC WALL  
US ELEV 680.71

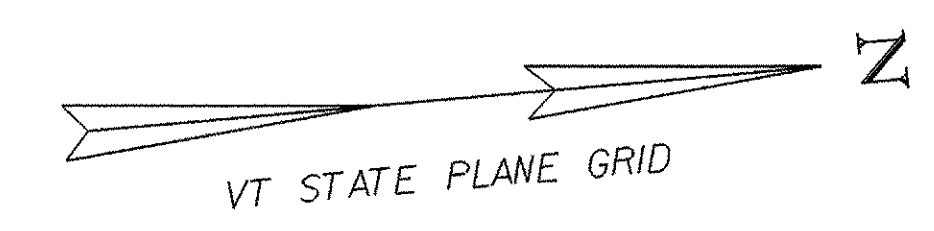

SCALE 1" = 20'-0"

### PLAN SHEET 4

PROJECT NAME:	RANDOLPH	
PROJECT NUMBER:	BRF 0241 (29)	
FILE NAME: /str5/88j096/sj096bdr.dgn	PLOT DATE: 29-AUG-2006	DRAWN BY: G. SHANGRAW
PROJECT LEADER: W. SYMONDS	CHECKED BY: T. SUMNER	SHEET 23 OF 135
DESIGNED BY: W. B. SYMONDS	sj0961a4.i	