


NOTE: PROPOSED CENTERLINE ELEVATIONS ARE SHOWN IN BOLD.

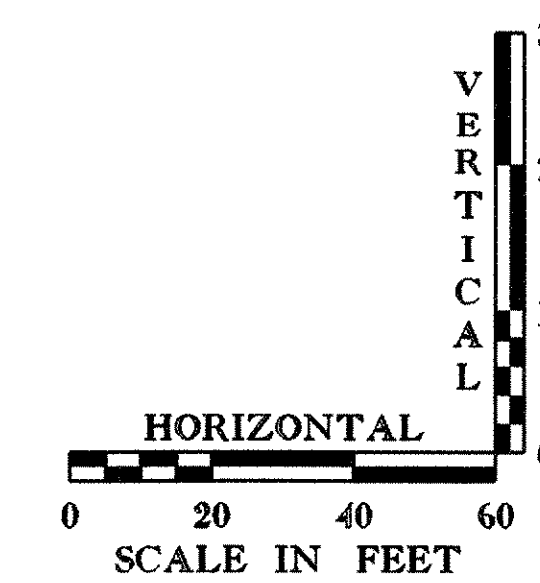

TEMPORARY DETOUR PROFILE

| | | | |
|-----------------|----------------------------|--------------|-----------------|
| PROJECT NAME: | RANDOLPH | PLOT DATE: | 29-AUG-2006 |
| PROJECT NUMBER: | BRF 0241 (29) | DRAWN BY: | G. SHANGRAW |
| FILE NAME: | /str/5/88j096/sj096tem.dgn | DESIGNED BY: | W.B. SYMONDS |
| | | CHECKED BY: | T. SUMNER |
| | | | SHEET 41 OF 135 |