


PLAN

SCALE 1" = 10'-0"

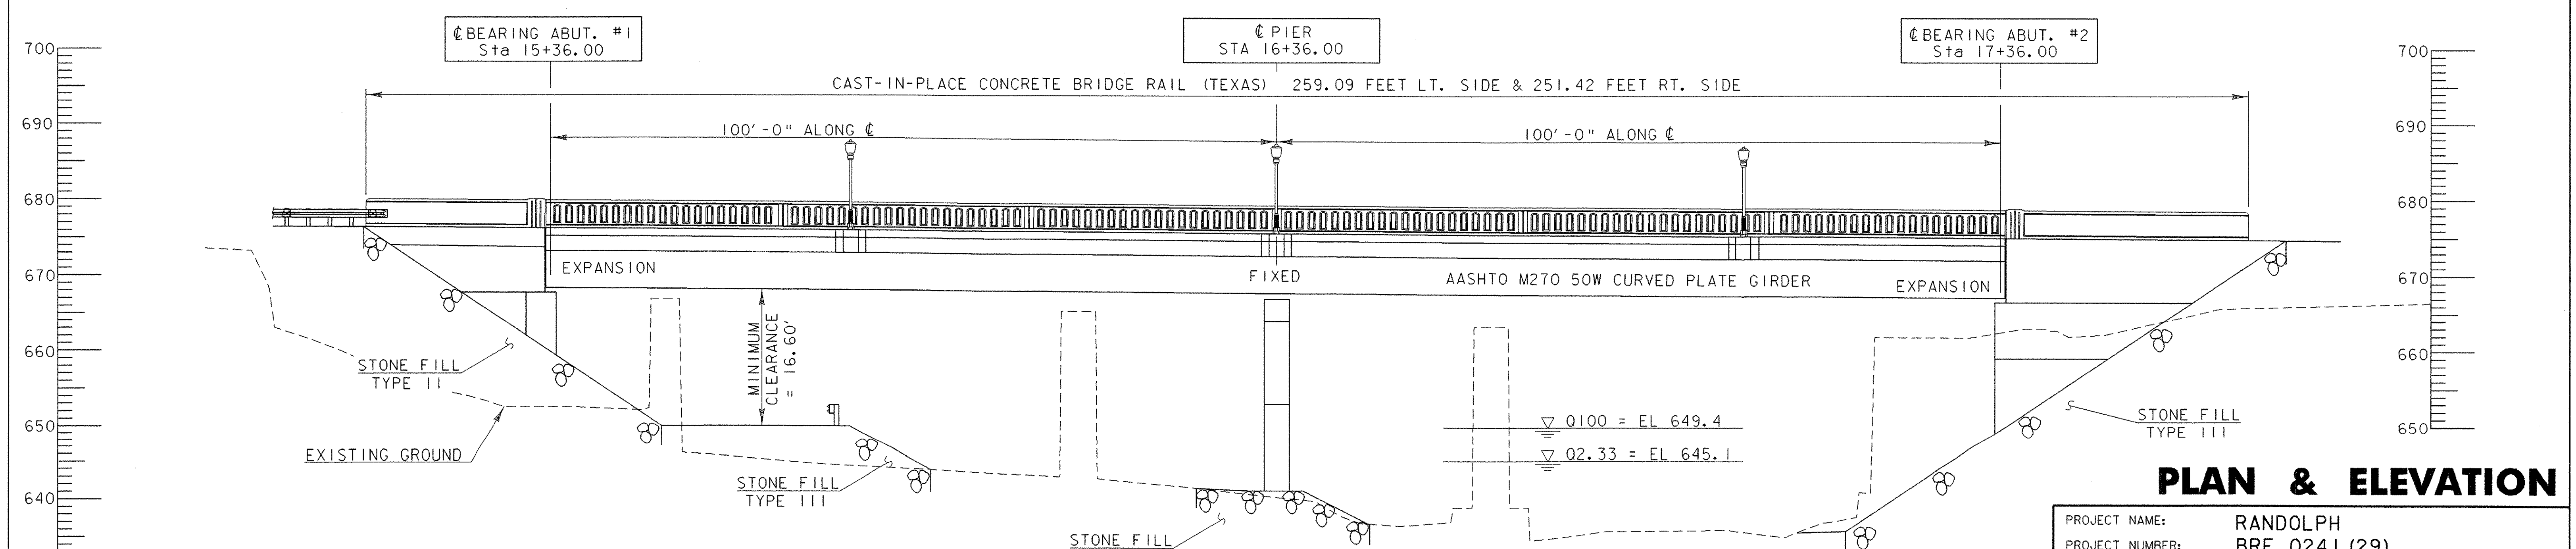

ELEVATION

SCALE 1" = 10'-0"

PLAN & ELEVATION

PROJECT NAME:	RANDOLPH	PLOT DATE:	29-AUG-2006
PROJECT NUMBER:	BRF 0241 (29)	DRAWN BY:	G. SHANGRAW
FILE NAME:	/s/r5/88j096/sj096pe.dgn	DESIGNED BY:	W. B. SYMONDS
		CHECKED BY:	T. SUMNER
			SHEET 52 OF 135