



TOP FLANGE SPLICE PLATE DETAIL

SCALE 1/2" = 1'-0"
 1 9 6 3 0

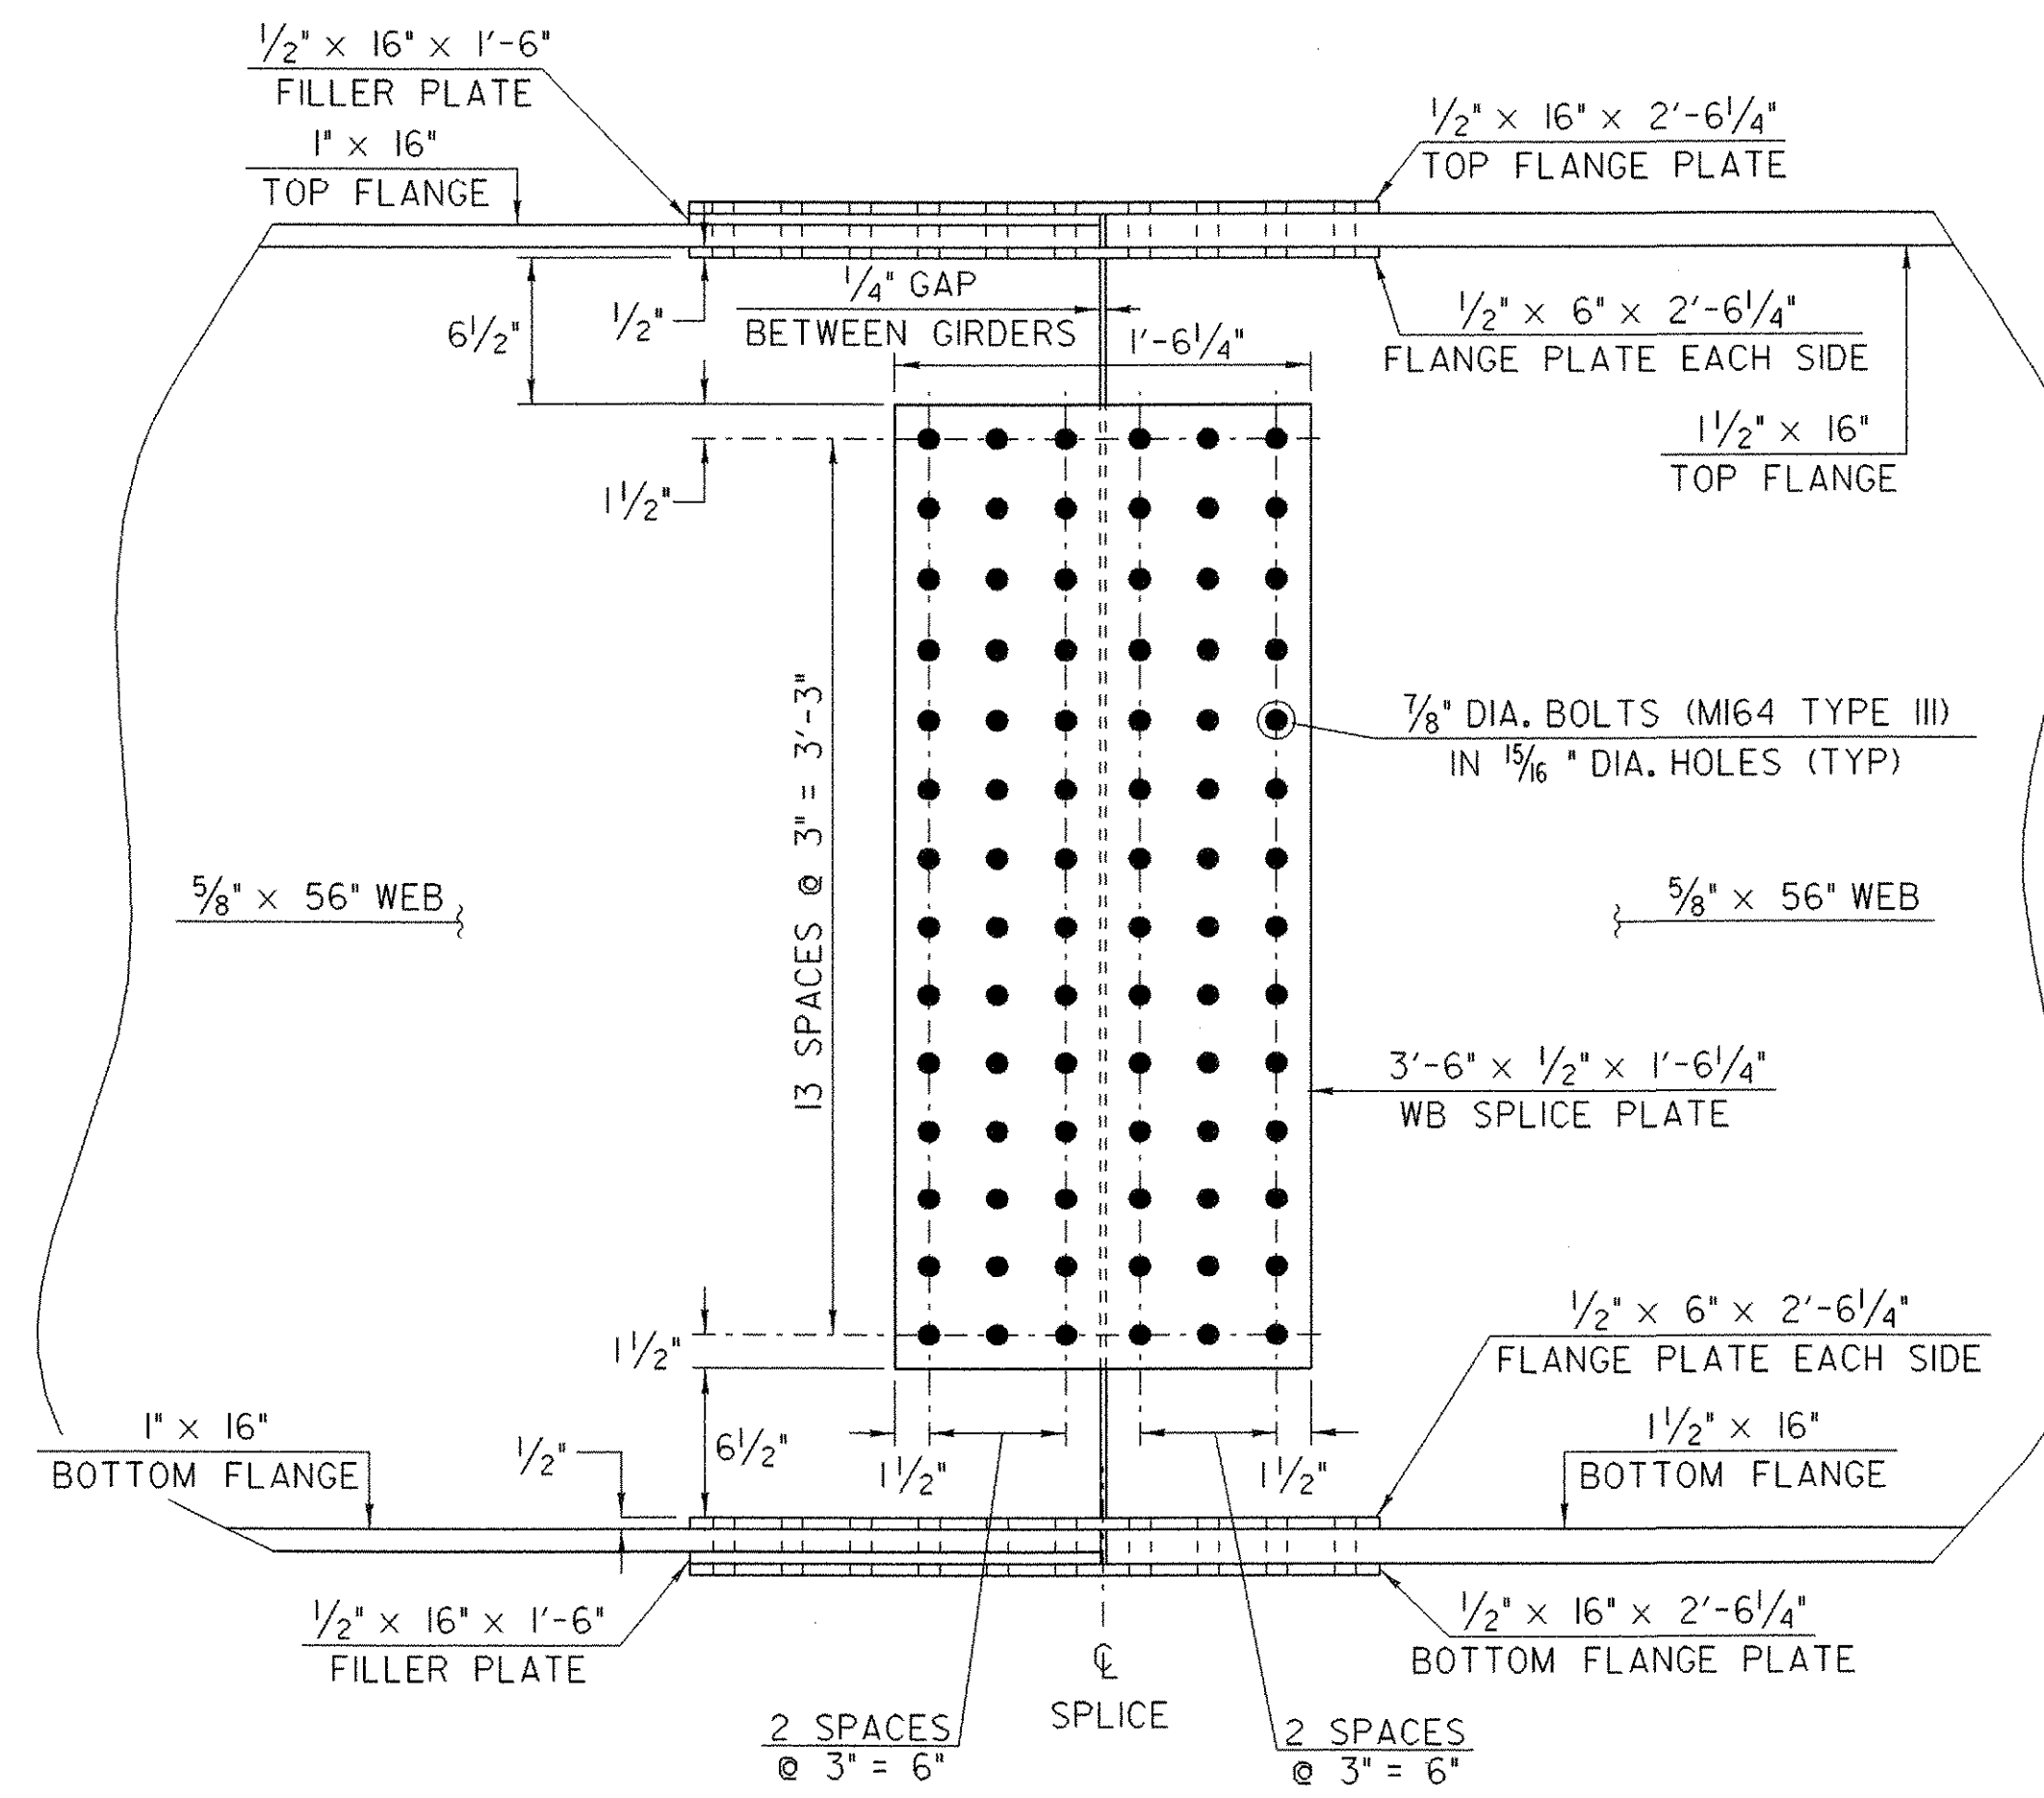

WEB SPLICE PLATE DETAIL


SCALE 1/2" = 1'-0"
 1 9 6 3 0

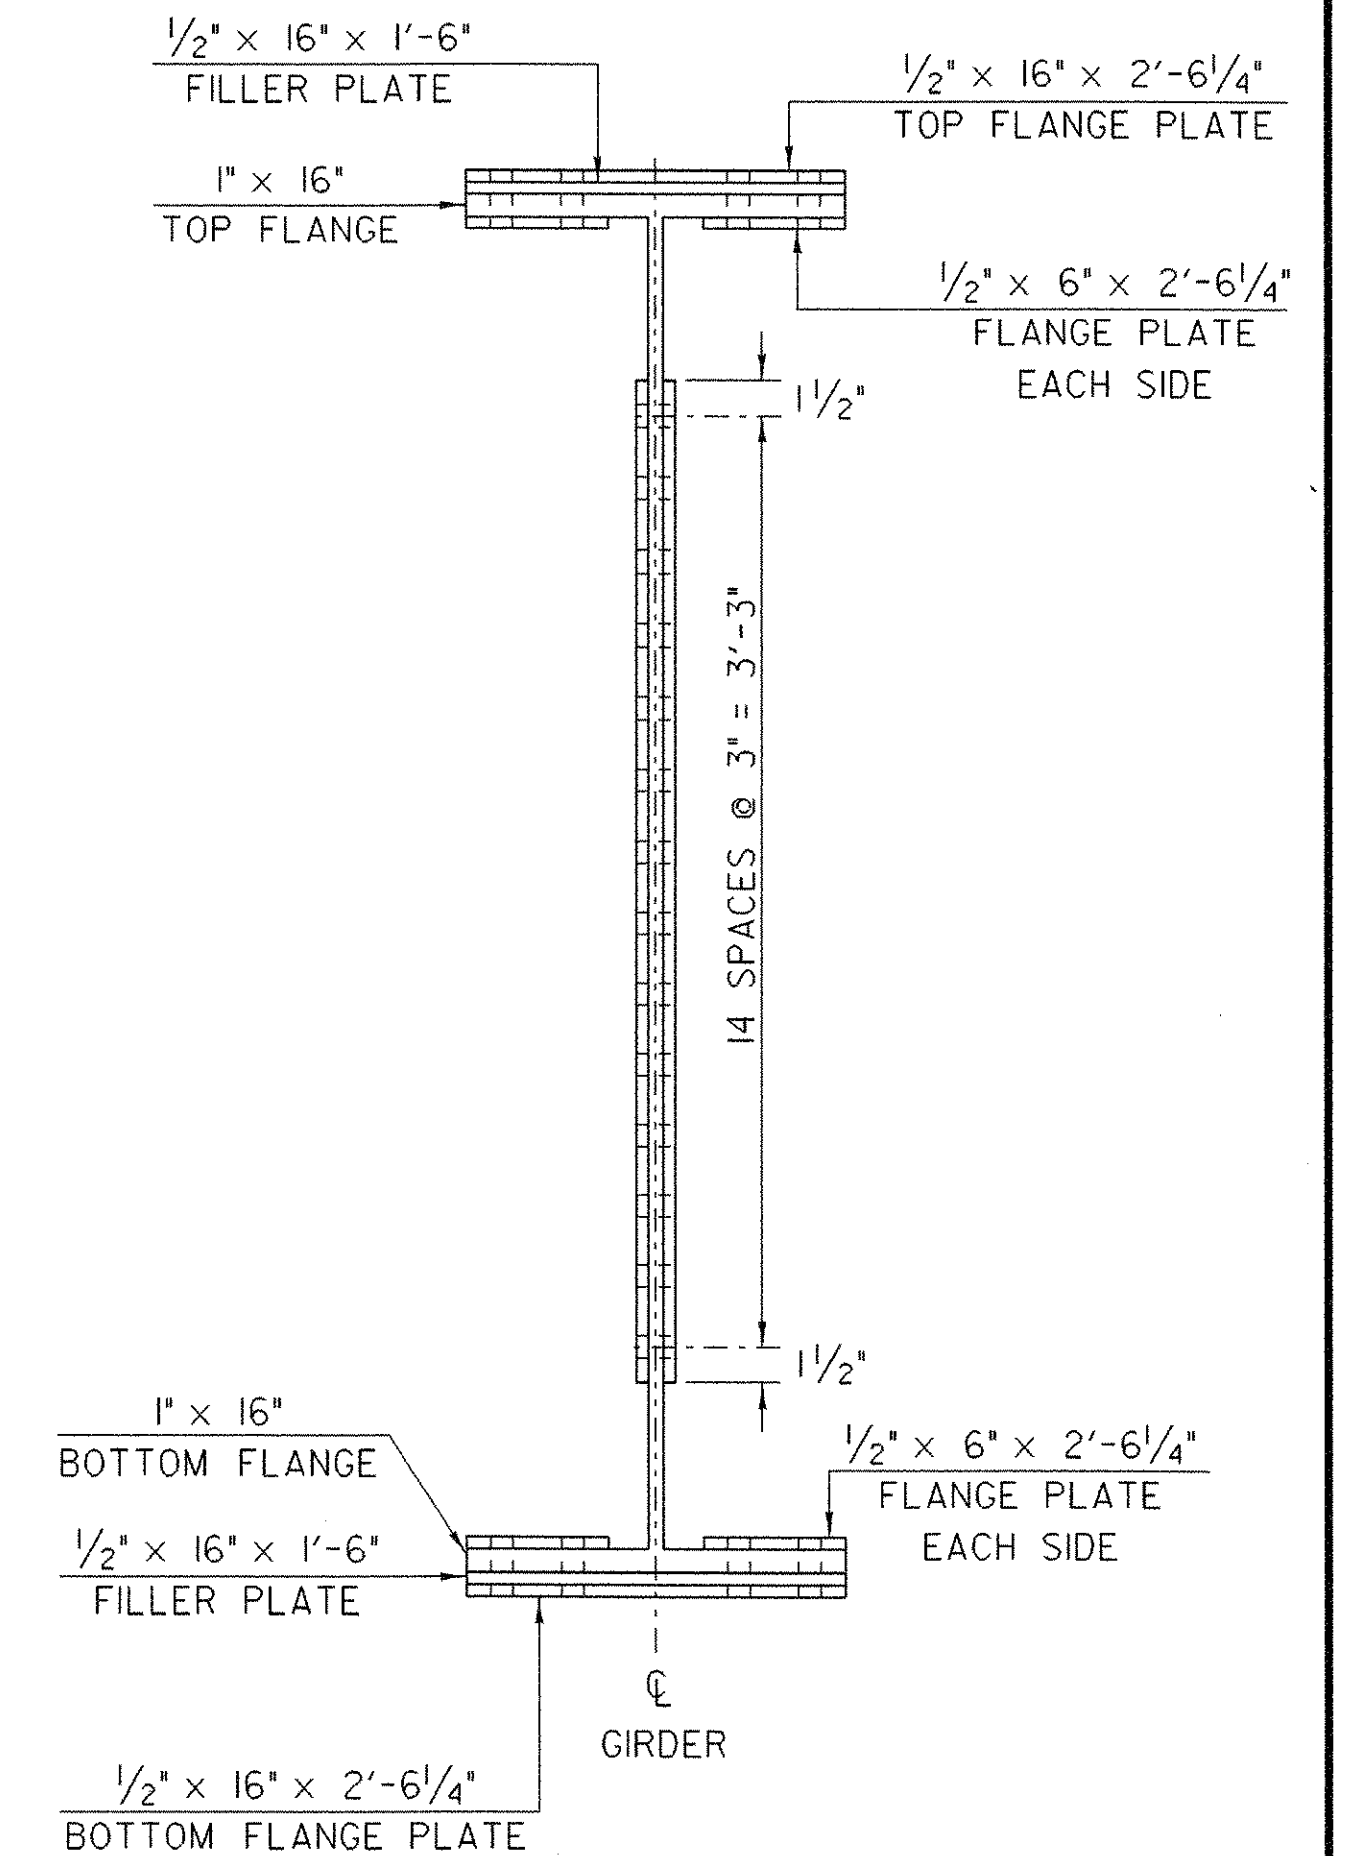

GIRDER SECTION

SCALE 1/2" = 1'-0"
 1 9 6 3 0

ALL SECTIONS OF THE SPLICE SHALL BE CVN (CHARPY V-NOTCH)

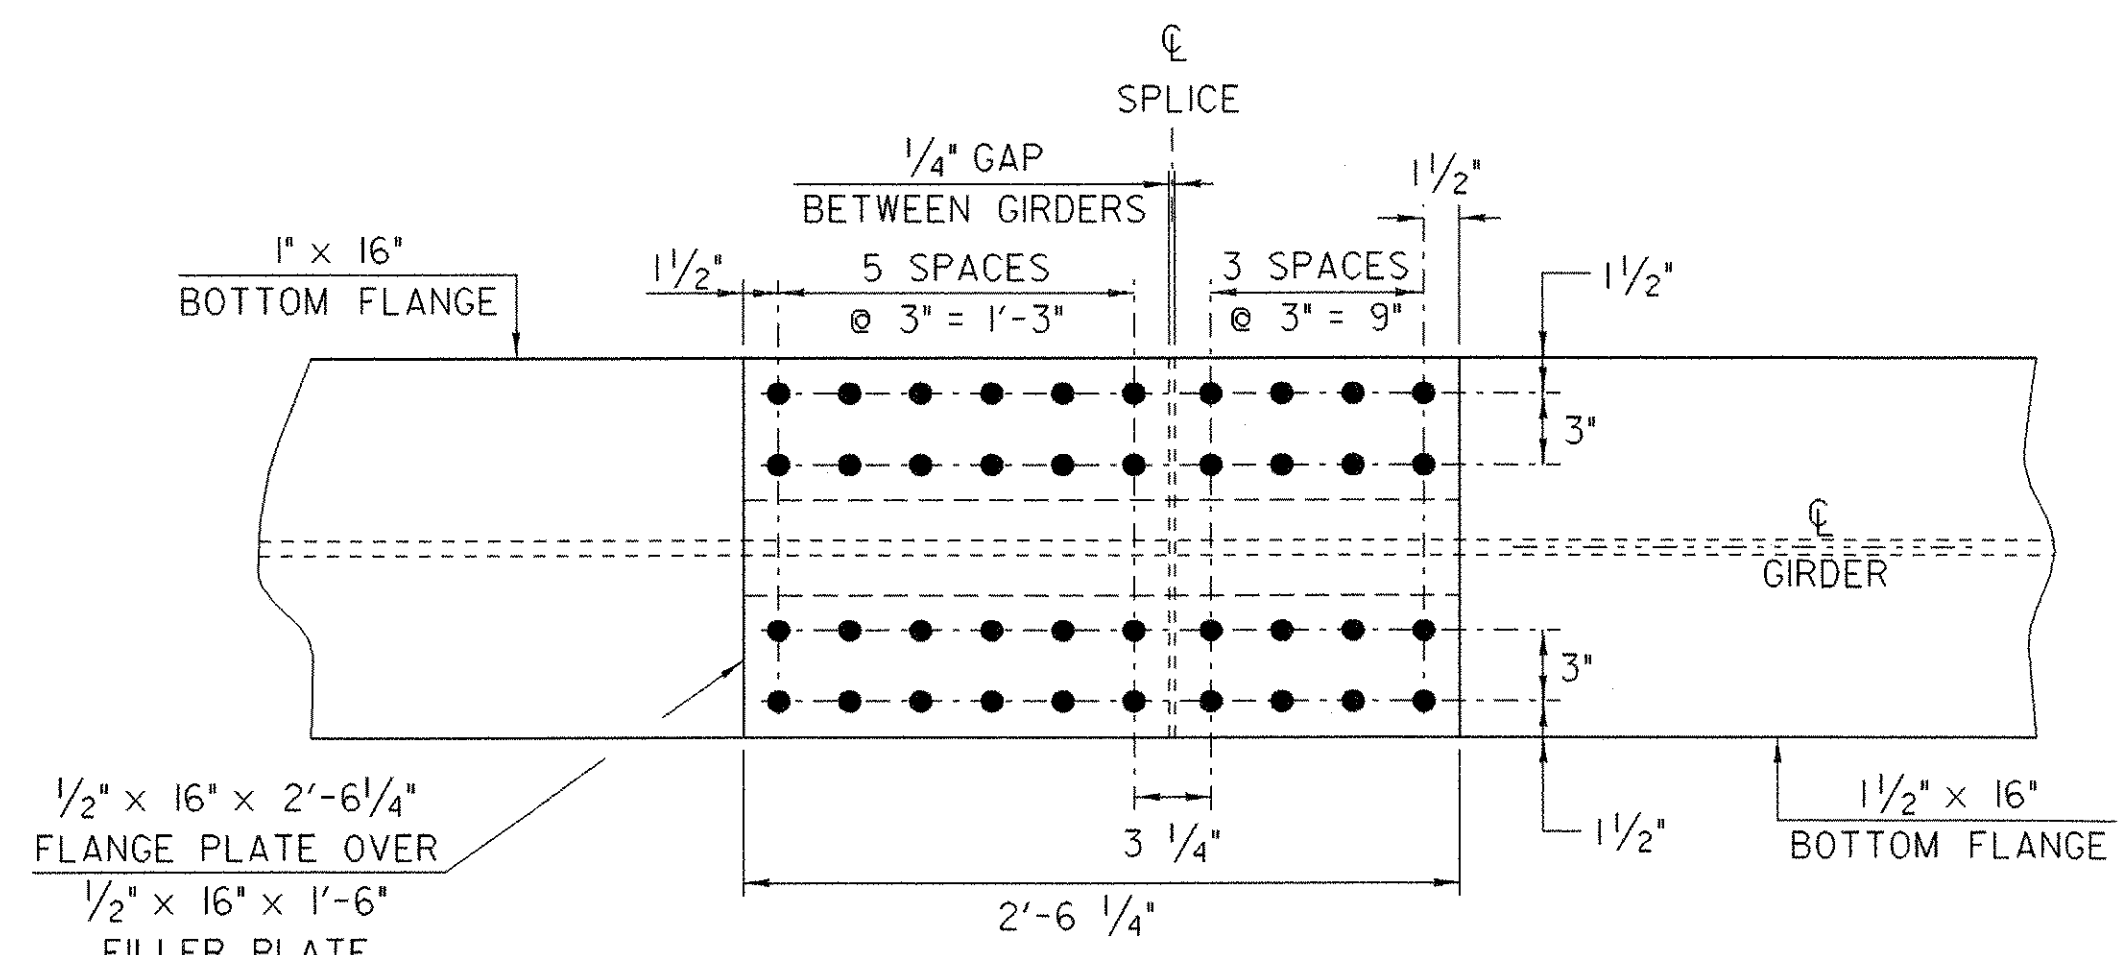

BOTTOM FLANGE SPLICE PLATE DETAIL

SCALE 1/2" = 1'-0"
 1 9 6 3 0

ALL SECTIONS OF THE SPLICE SHALL BE CVN (CHARPY V-NOTCH)

SPLICE DETAILS GIRDERS 3, 4, & 5

PROJECT NAME:	RANDOLPH	
PROJECT NUMBER:	BRF 0241 (29)	
FILE NAME: /str5/88j096/sj096sup.dgn	PLOT DATE:	29-AUG-2006
PROJECT LEADER: W. SYMONDS	DRAWN BY: G. SHANGRAW	
DESIGNED BY: T. SUMNER	CHECKED BY: T. FILLBACH	
sj096sd2.i	SHEET 58 OF 135	