



**APPROACH SLAB #1**

SCALE 1/4" = 1'-0"  
 1 0 2 4 6

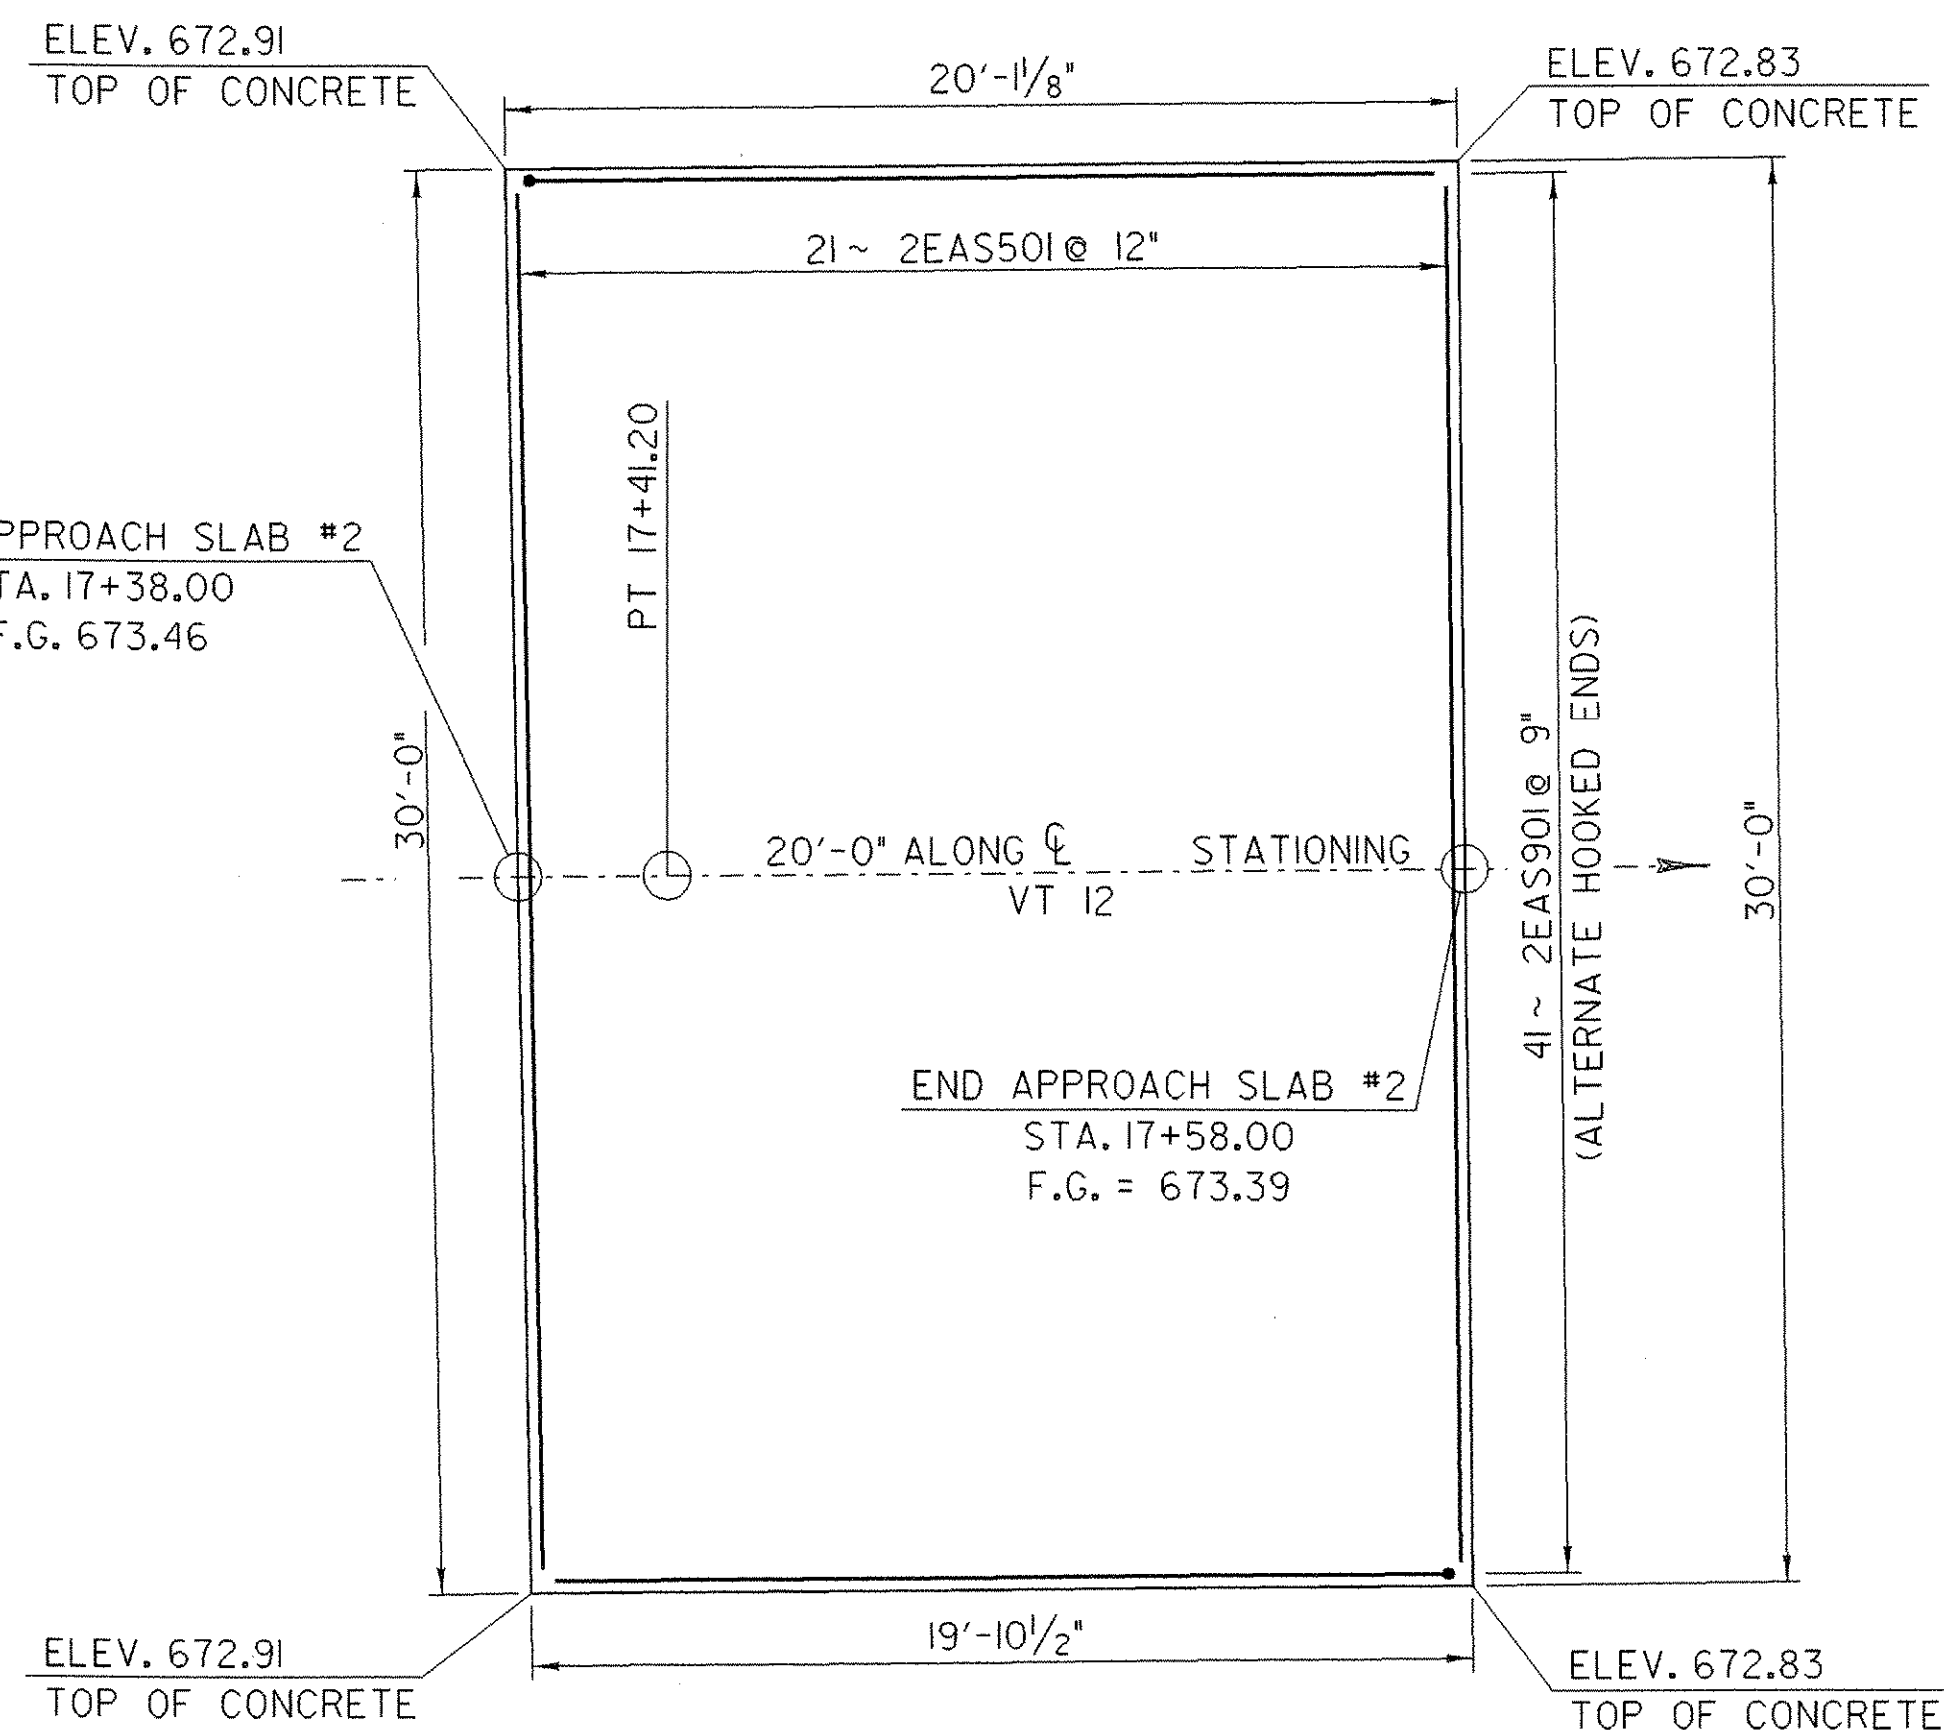

**APPROACH SLAB #2**

SCALE 1/4" = 1'-0"  
 1 0 2 4 6

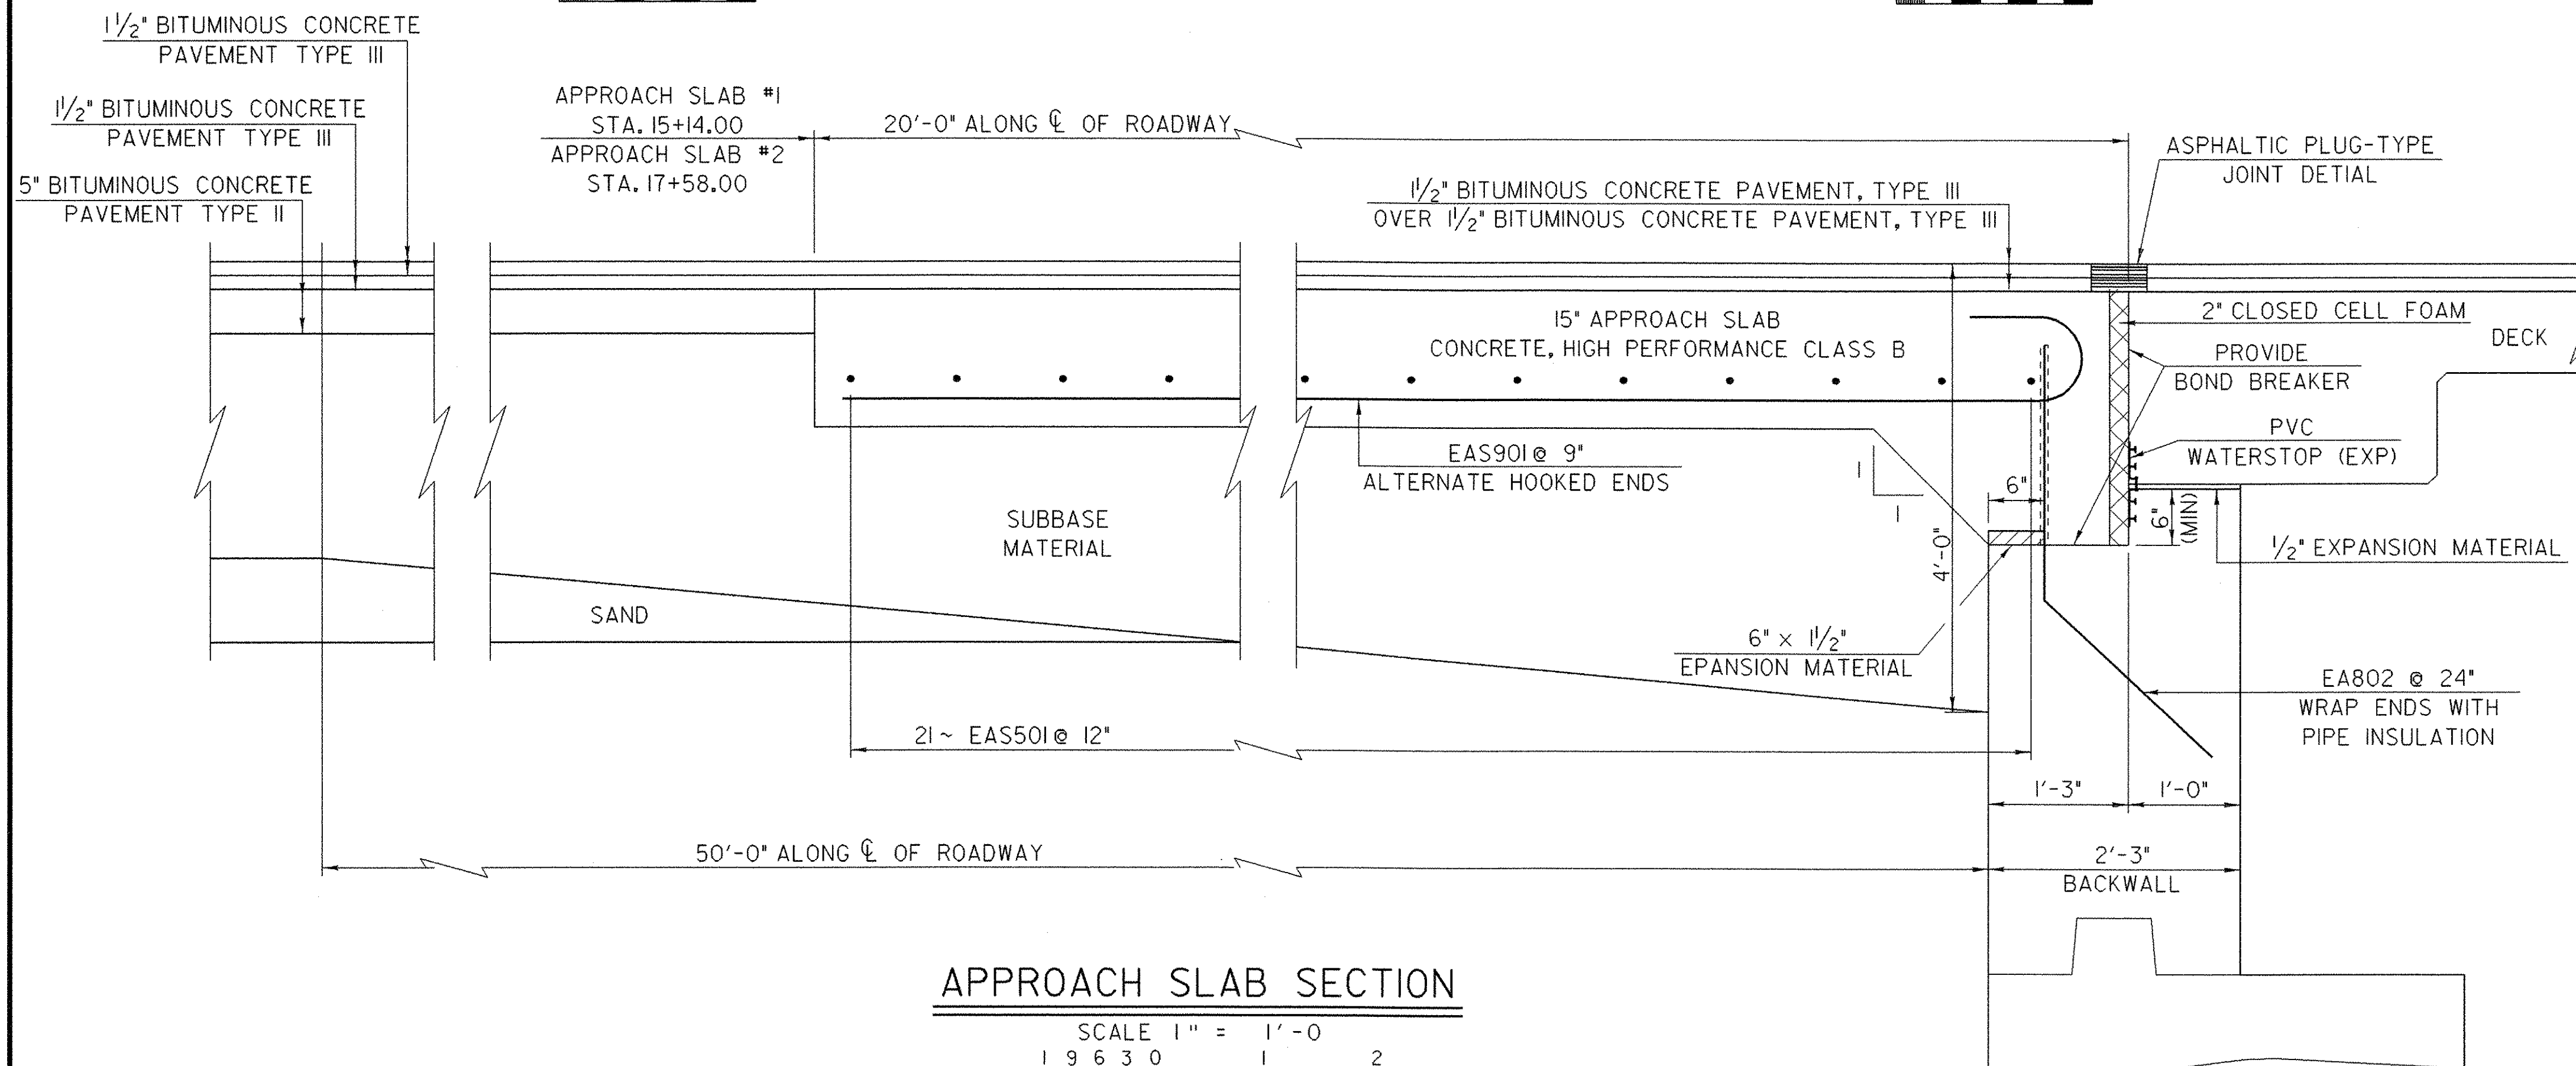

**APPROACH SLAB SECTION**

SCALE 1" = 1'-0"  
 1 9 6 3 0 2

**APPROACH SLABS**

PROJECT NAME:	RANDOLPH		PLOT DATE:	29-AUG-2006	
PROJECT NUMBER:	BRF 0241 (29)		DRAWN BY:	G. SHANGRAW	
FILE NAME:	/s1r5/88j096/sj096sup.dgn	DESIGNED BY:	T. SUMNER	CHECKED BY:	T. FILLBACH
PROJECT LEADER:	W. SYMONDS			SHEET	62 OF 135