


ABUTMENT #1 PLAN


SCALE 1/4" = 1'-0"
1 0 2 4 6

* APPROXIMATE ELEVATIONS. ACTUAL ELEVATIONS TO BE DETERMINED IN THE FIELD AFTER BEAM PROFILES ARE TAKEN

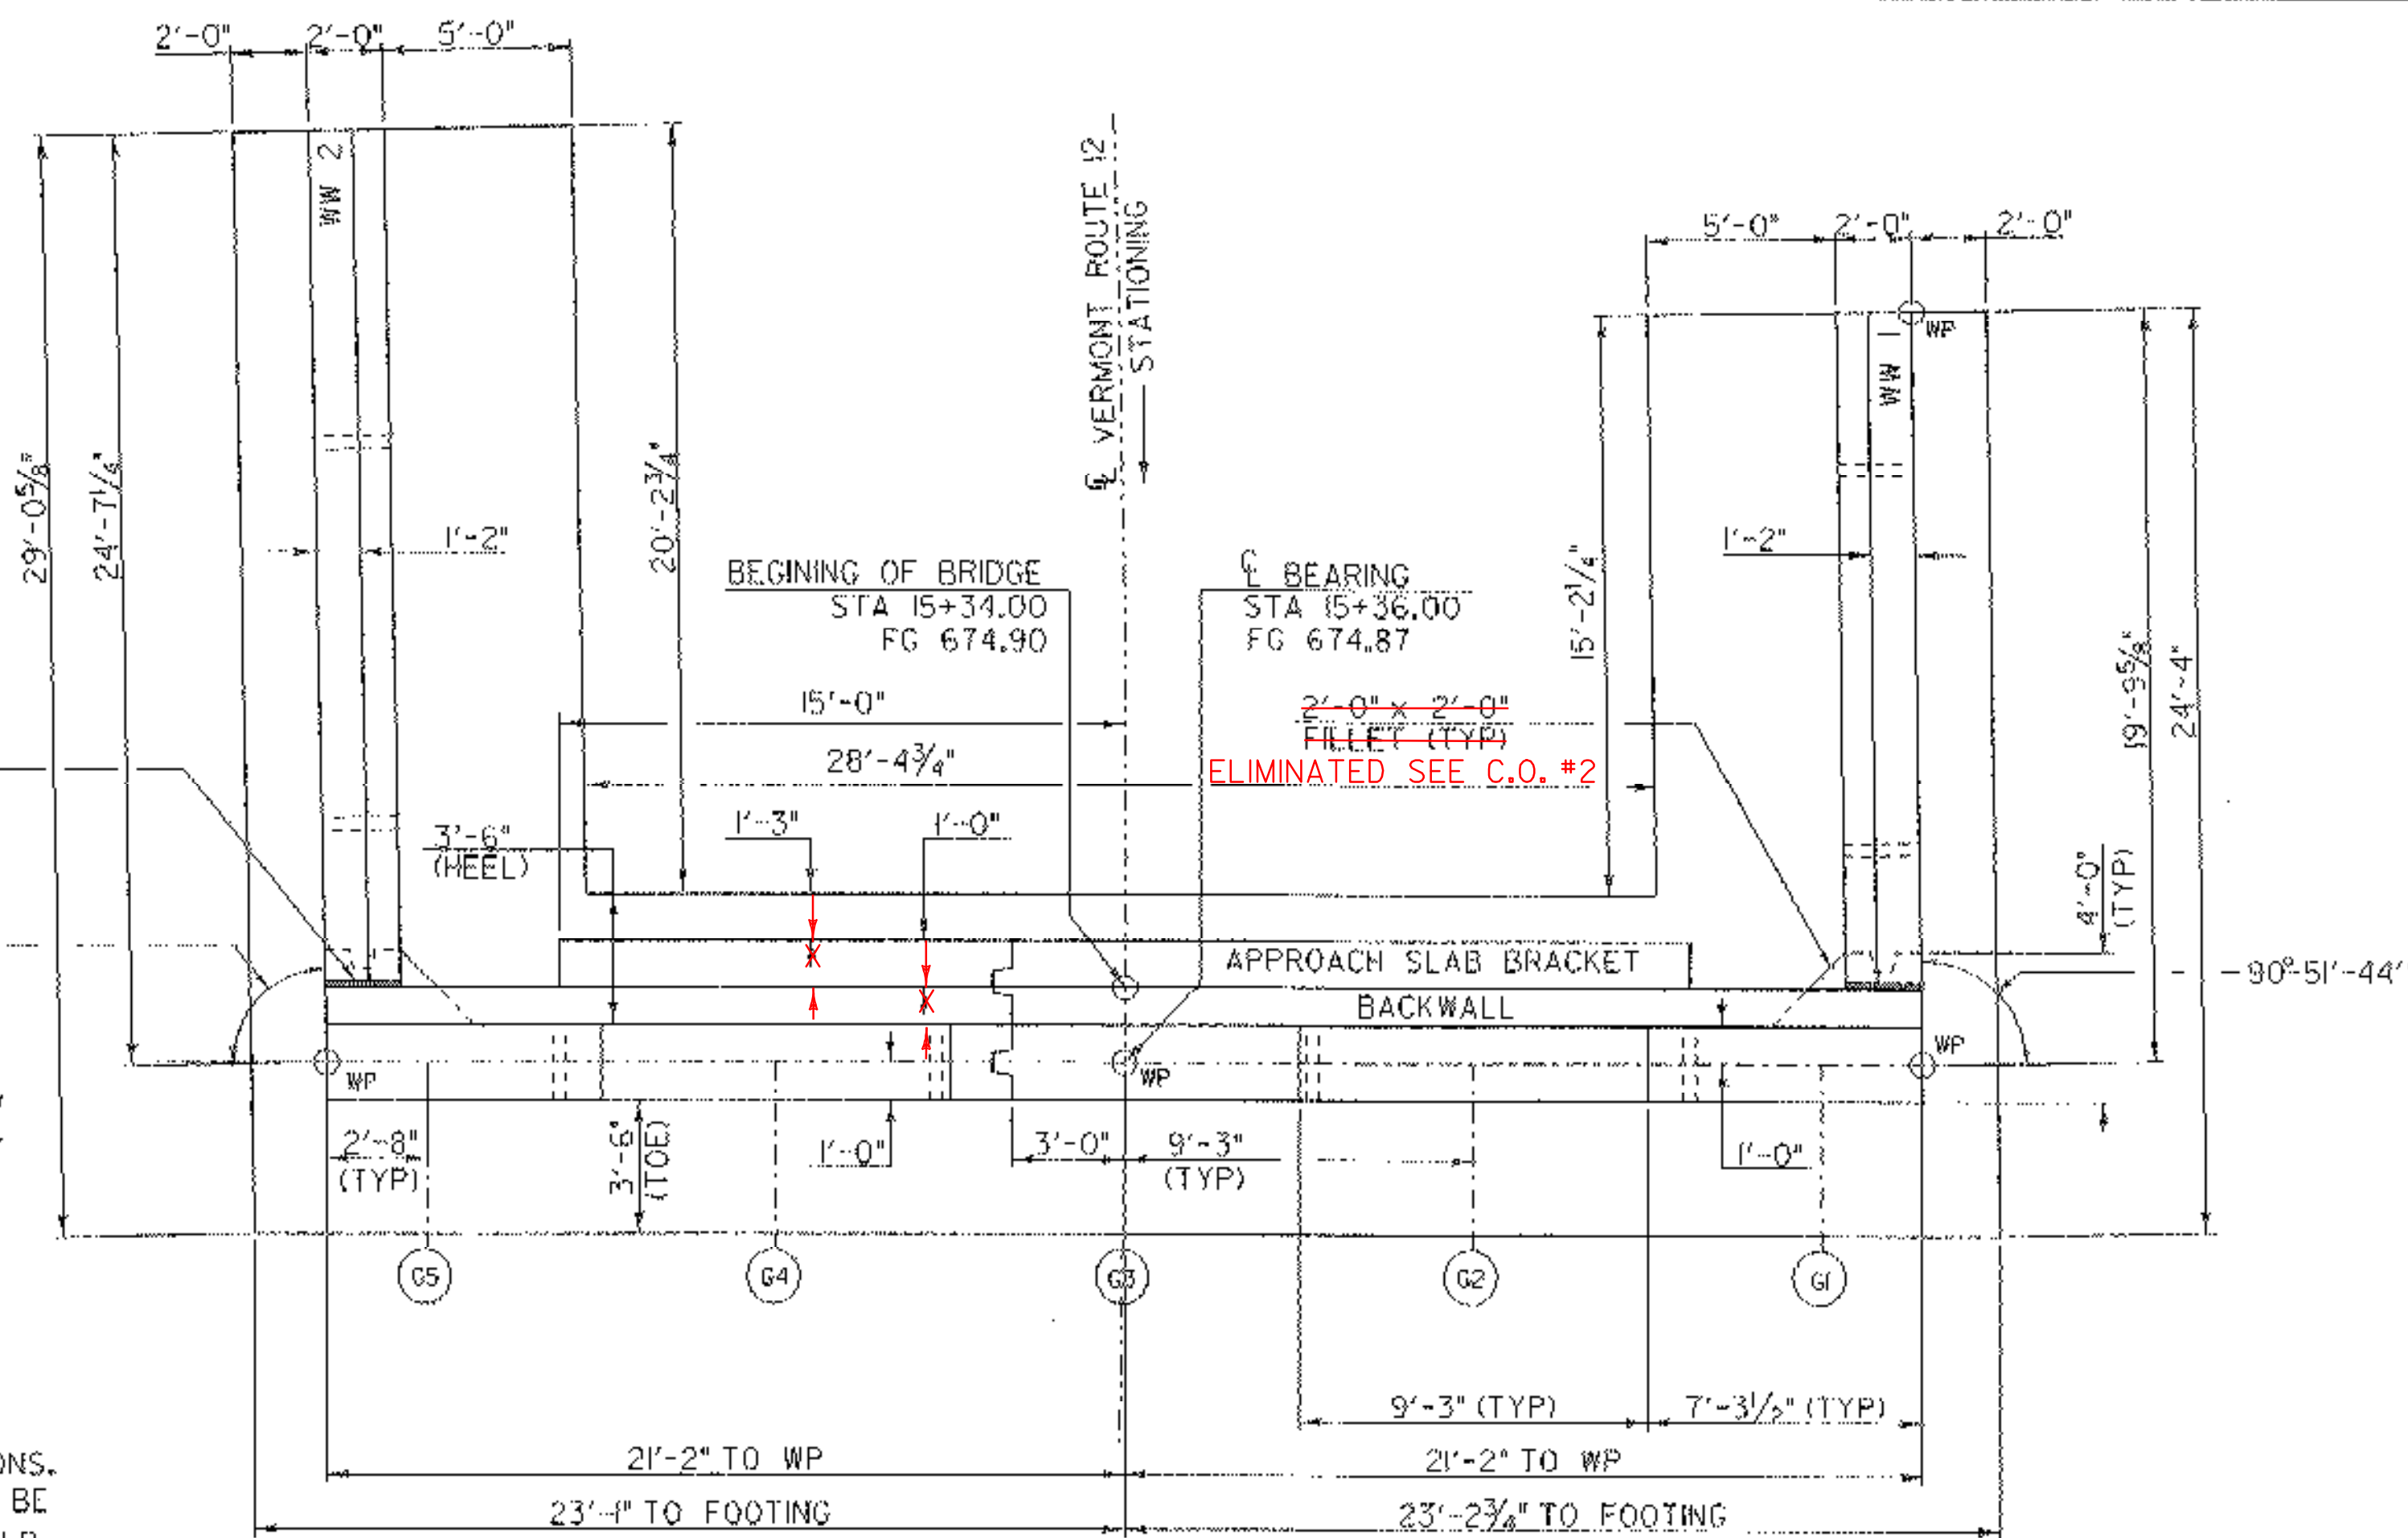


ABUTMENT #1 ELEVATION

SCALE 1/4" = 1'-0"
1 0 2 4 6

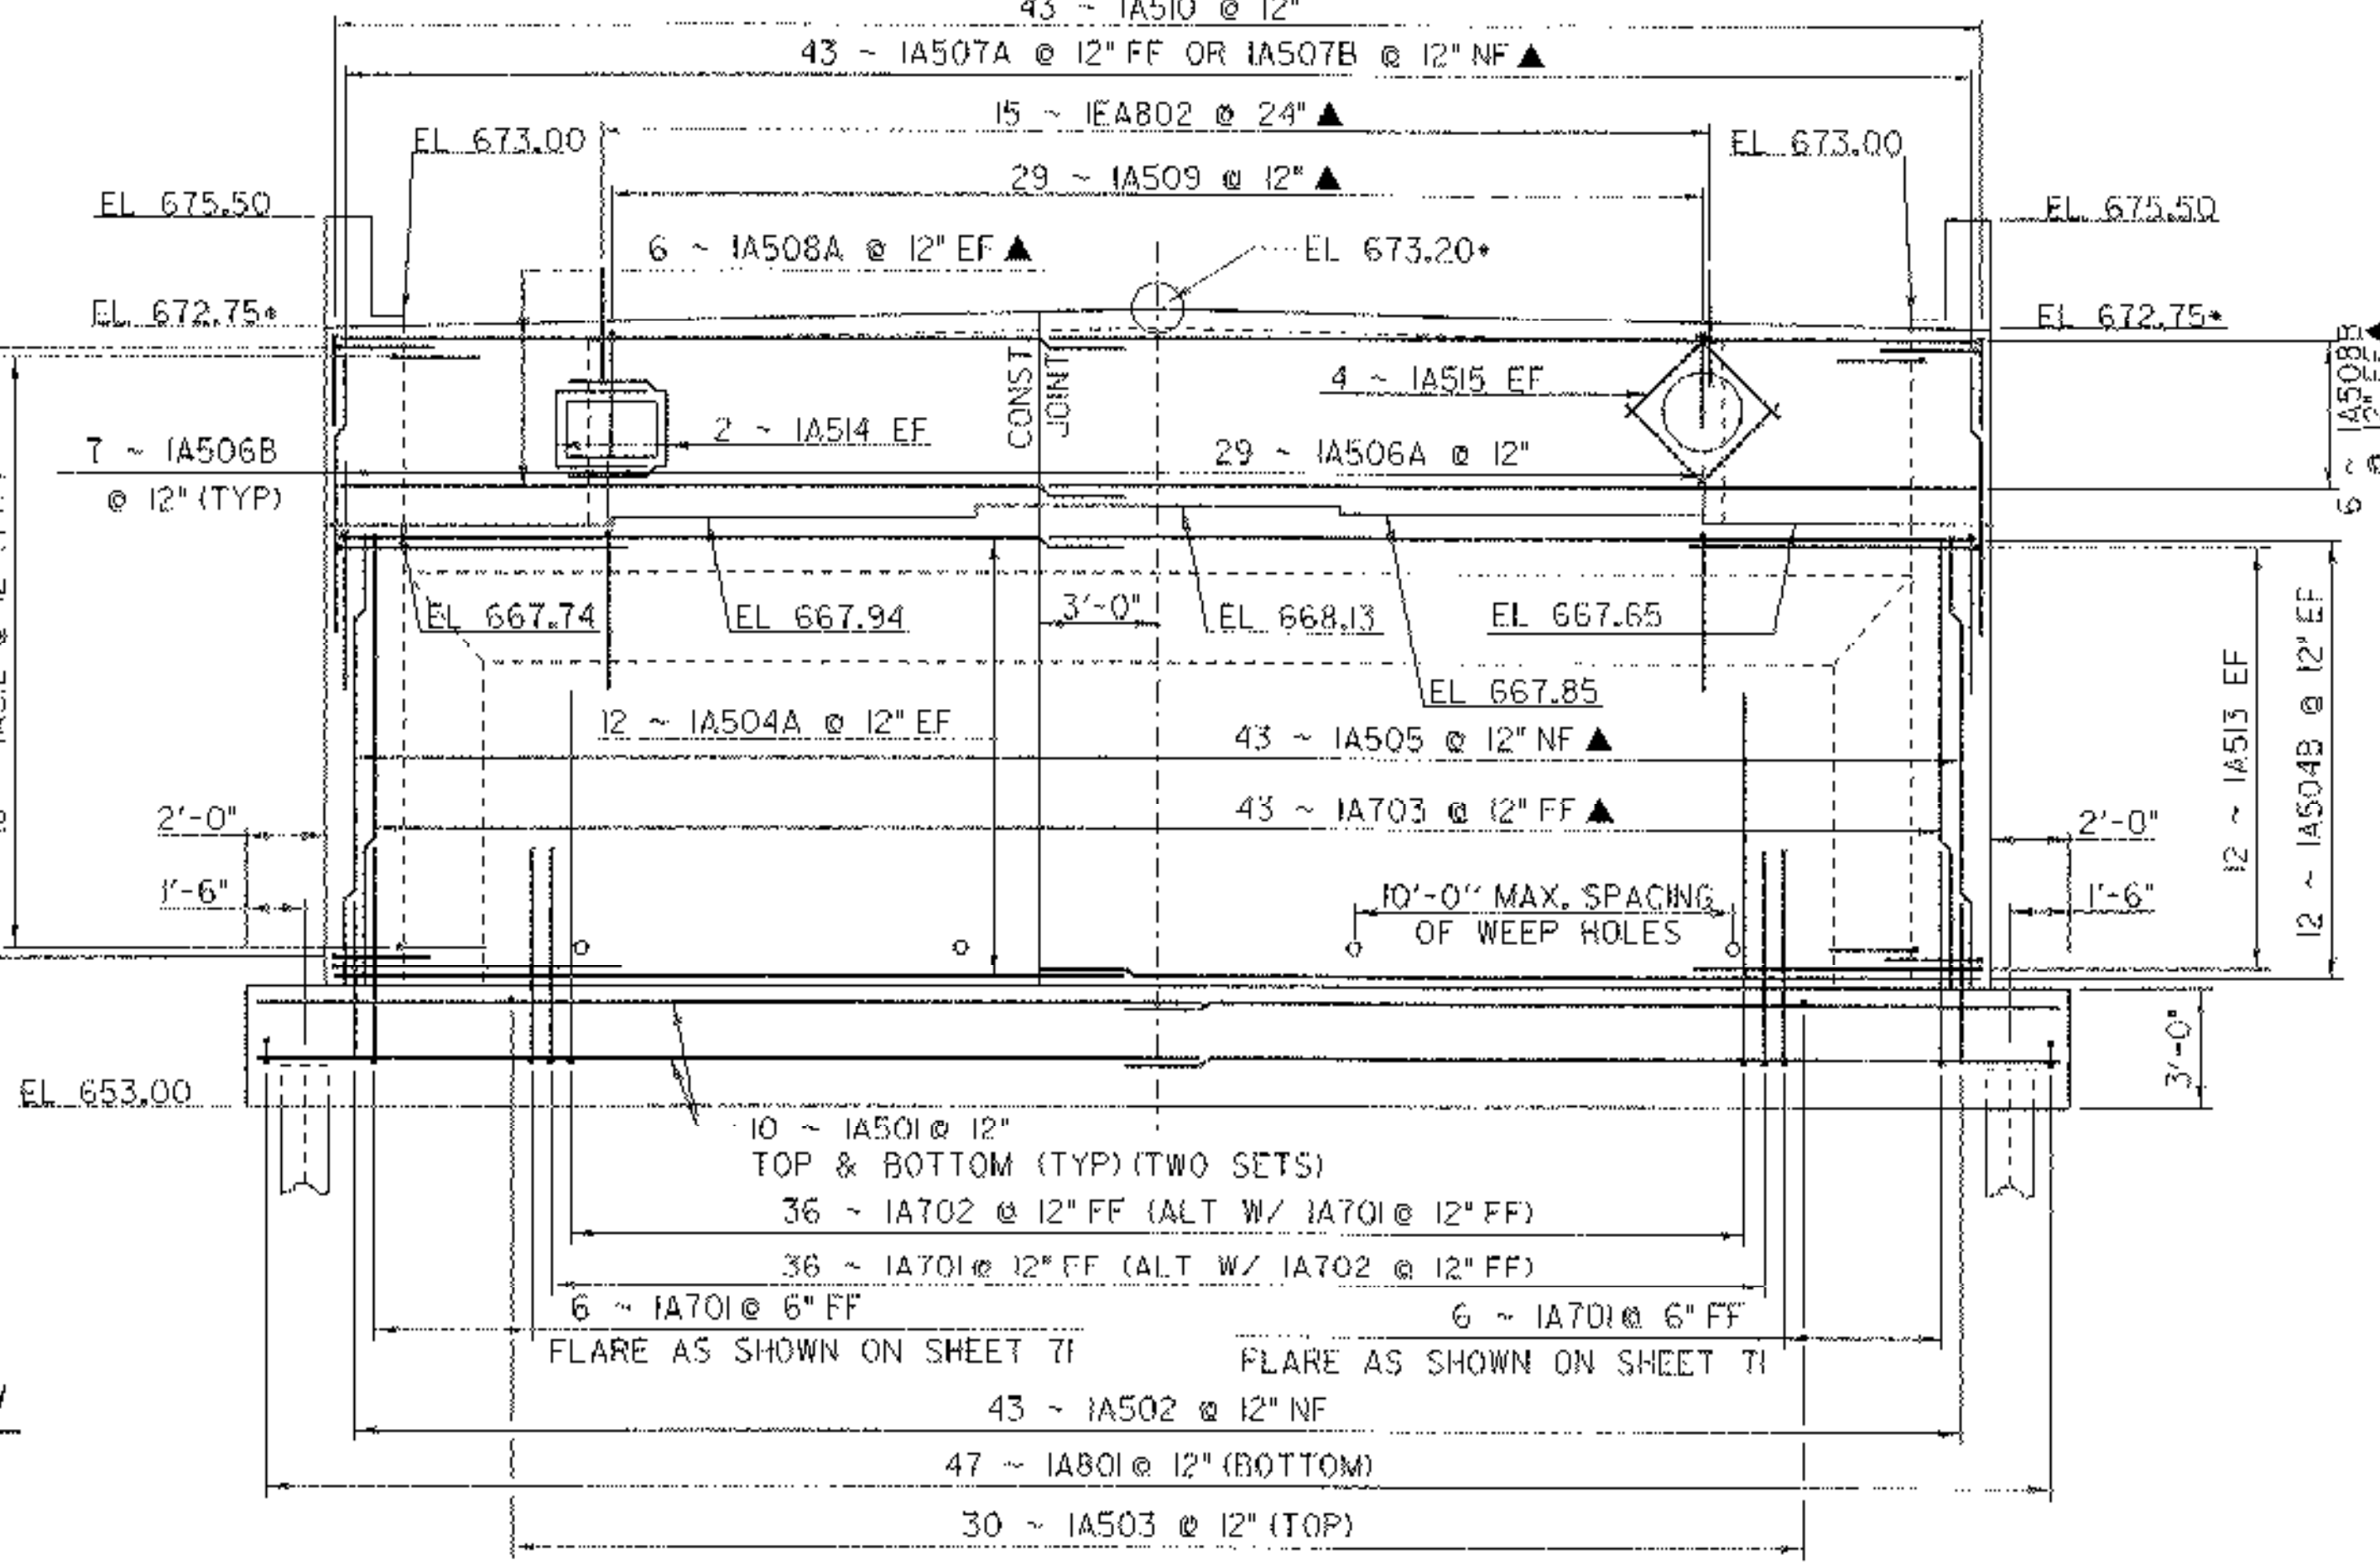

ABUTMENT #1 TYPICAL SECTION

SCALE 1/2" = 1'-0"
1 0 1 2

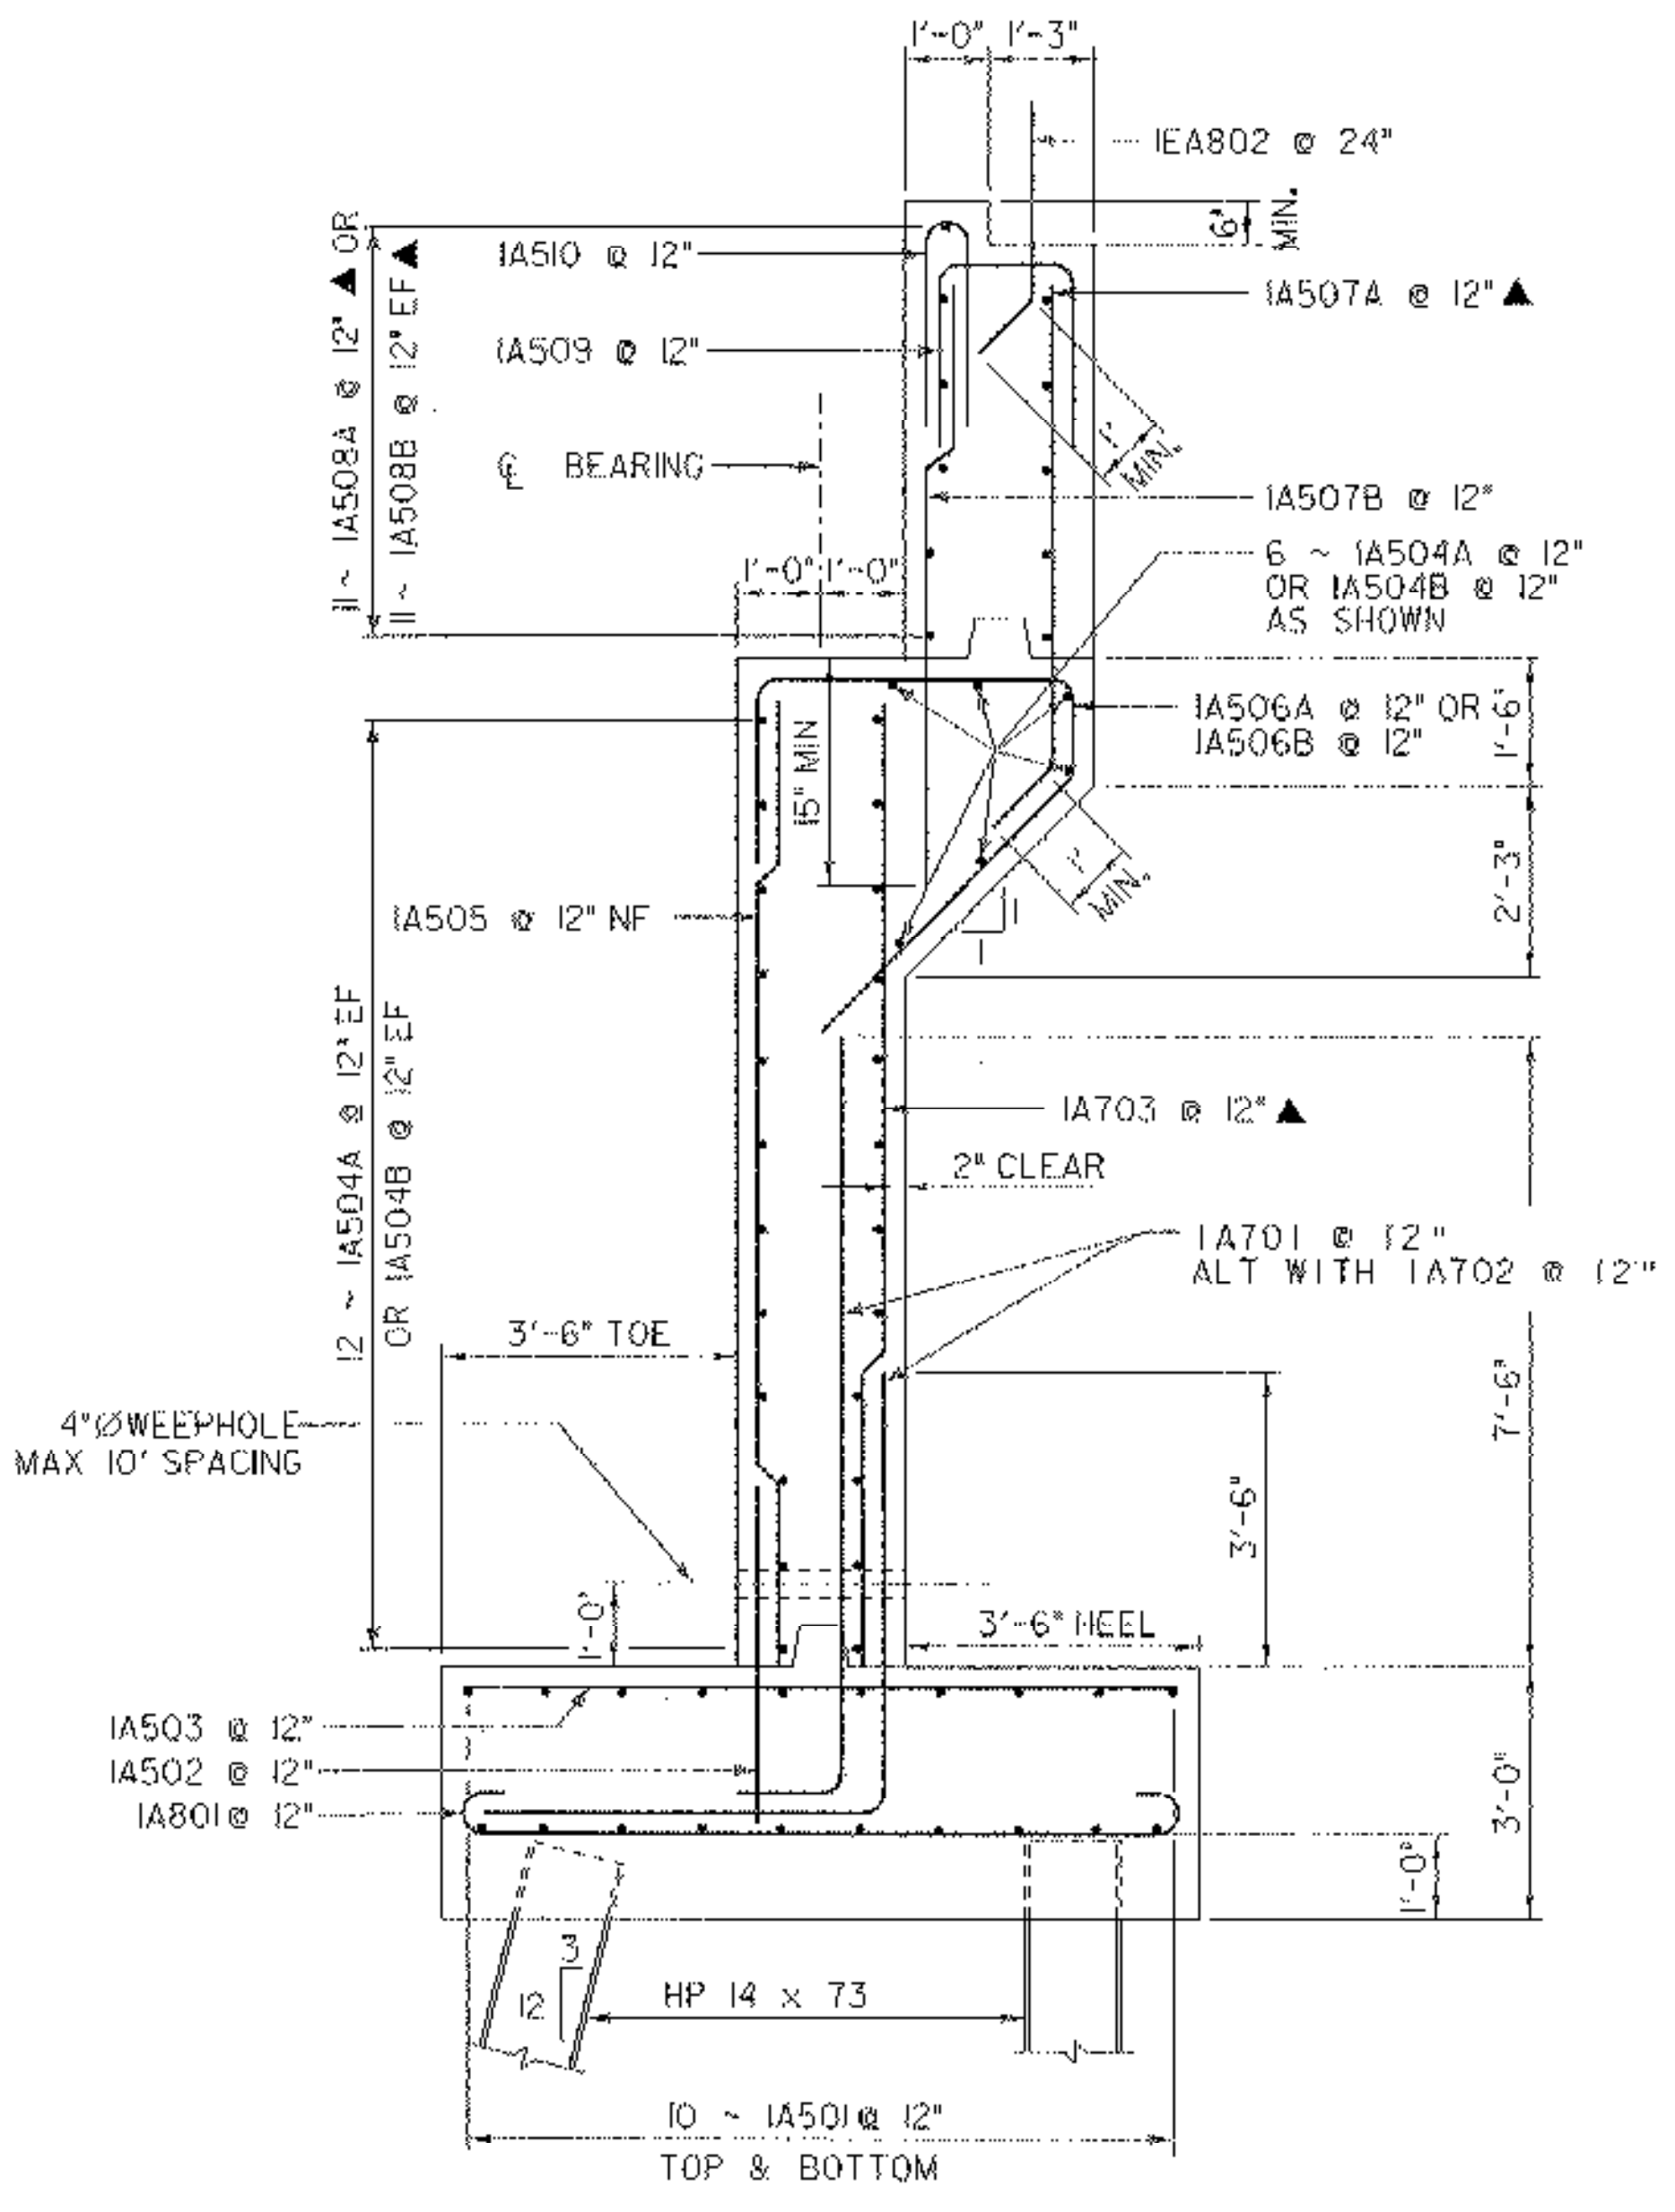

NOTE:
NF - NEAR FACE
FF - FAR FACE
EF - EACH FACE
▲ - CUT TO FIT IN FIELD
3" CLR. UNLESS OTHERWISE NOTED
2'-2" BAR LAP UNLESS OTHERWISE NOTED

ABUTMENT #1 PLAN & ELEVATION

PROJECT NAME:	RANDOLPH
PROJECT NUMBER:	BRF 0241 (29)
FILE NAME:	/sfr5/88j096/s88j096sub.dgn
PLOT DATE:	29-AUG-2006
PROJECT LEADER:	W. SYMONDS
DRAWN BY:	G. SHANGRAW
DESIGNED BY:	T. SUMNER
CHECKED BY:	T. FILLBACH
SHEET:	70 OF 135