



PIER PLAN
SCALE 3/8" = 1'-0"
0 1 2 3 4

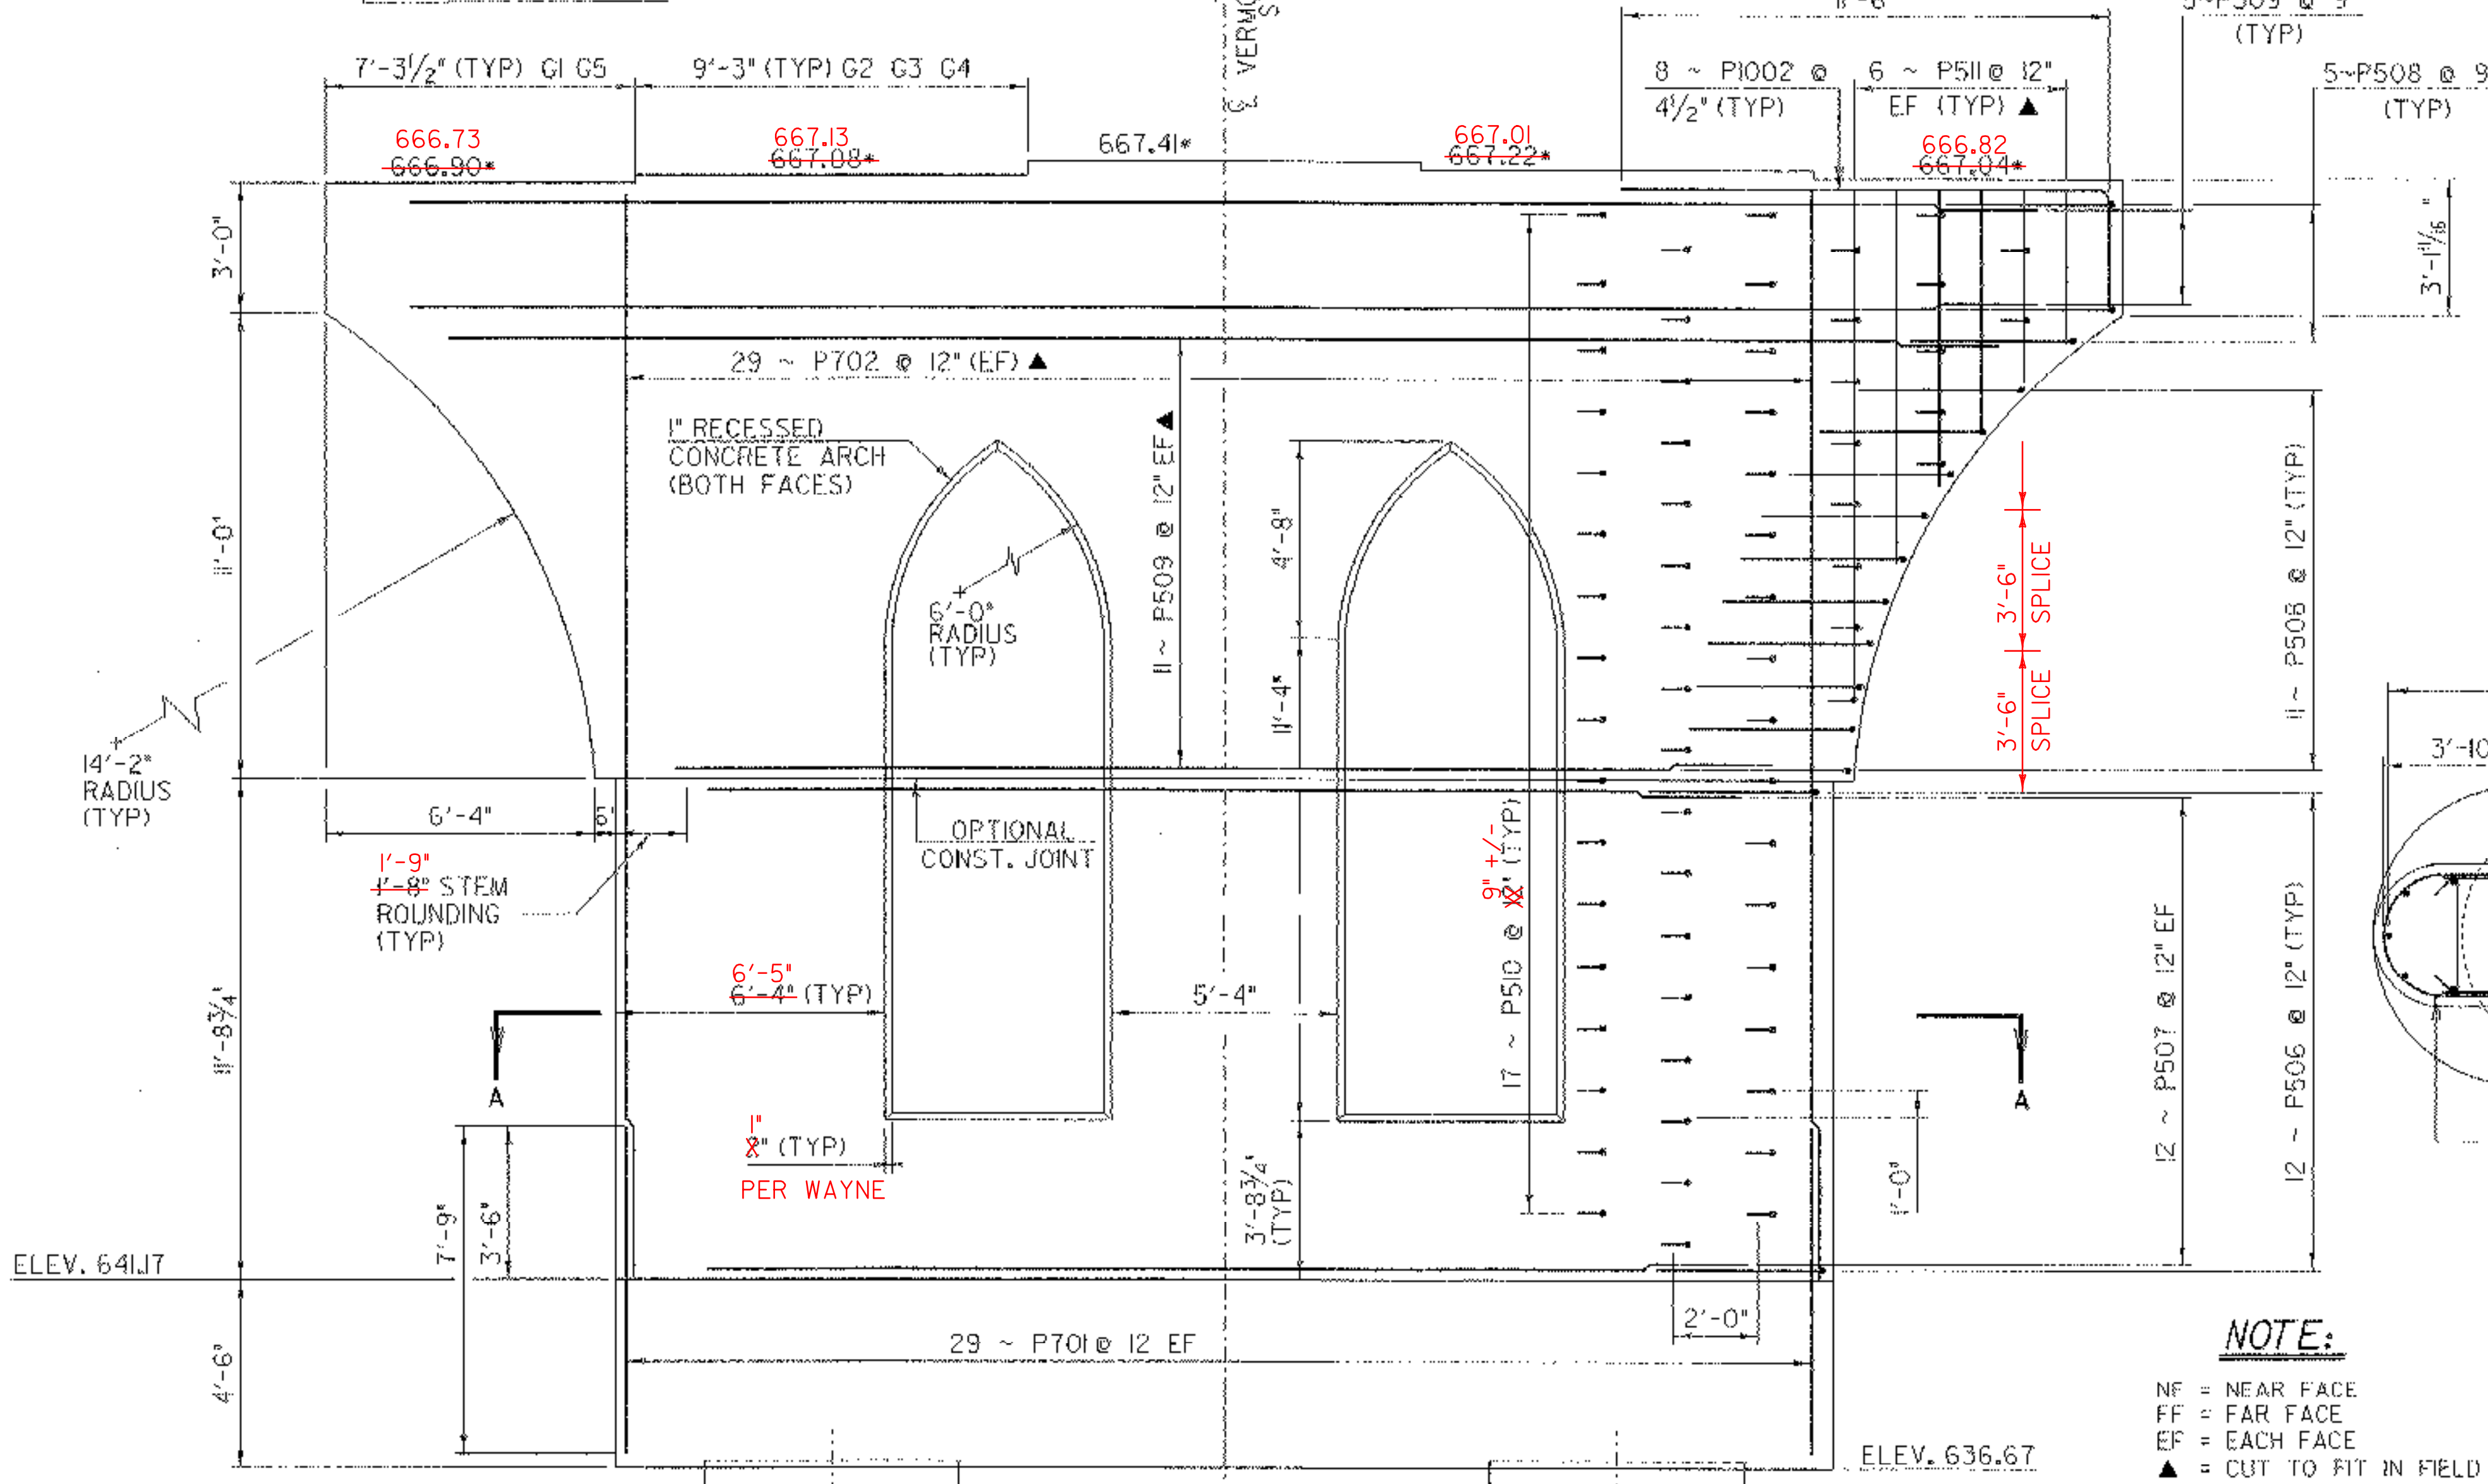

PIER ELEVATION
SCALE 3/8" = 1'-0"
0 1 2 3 4

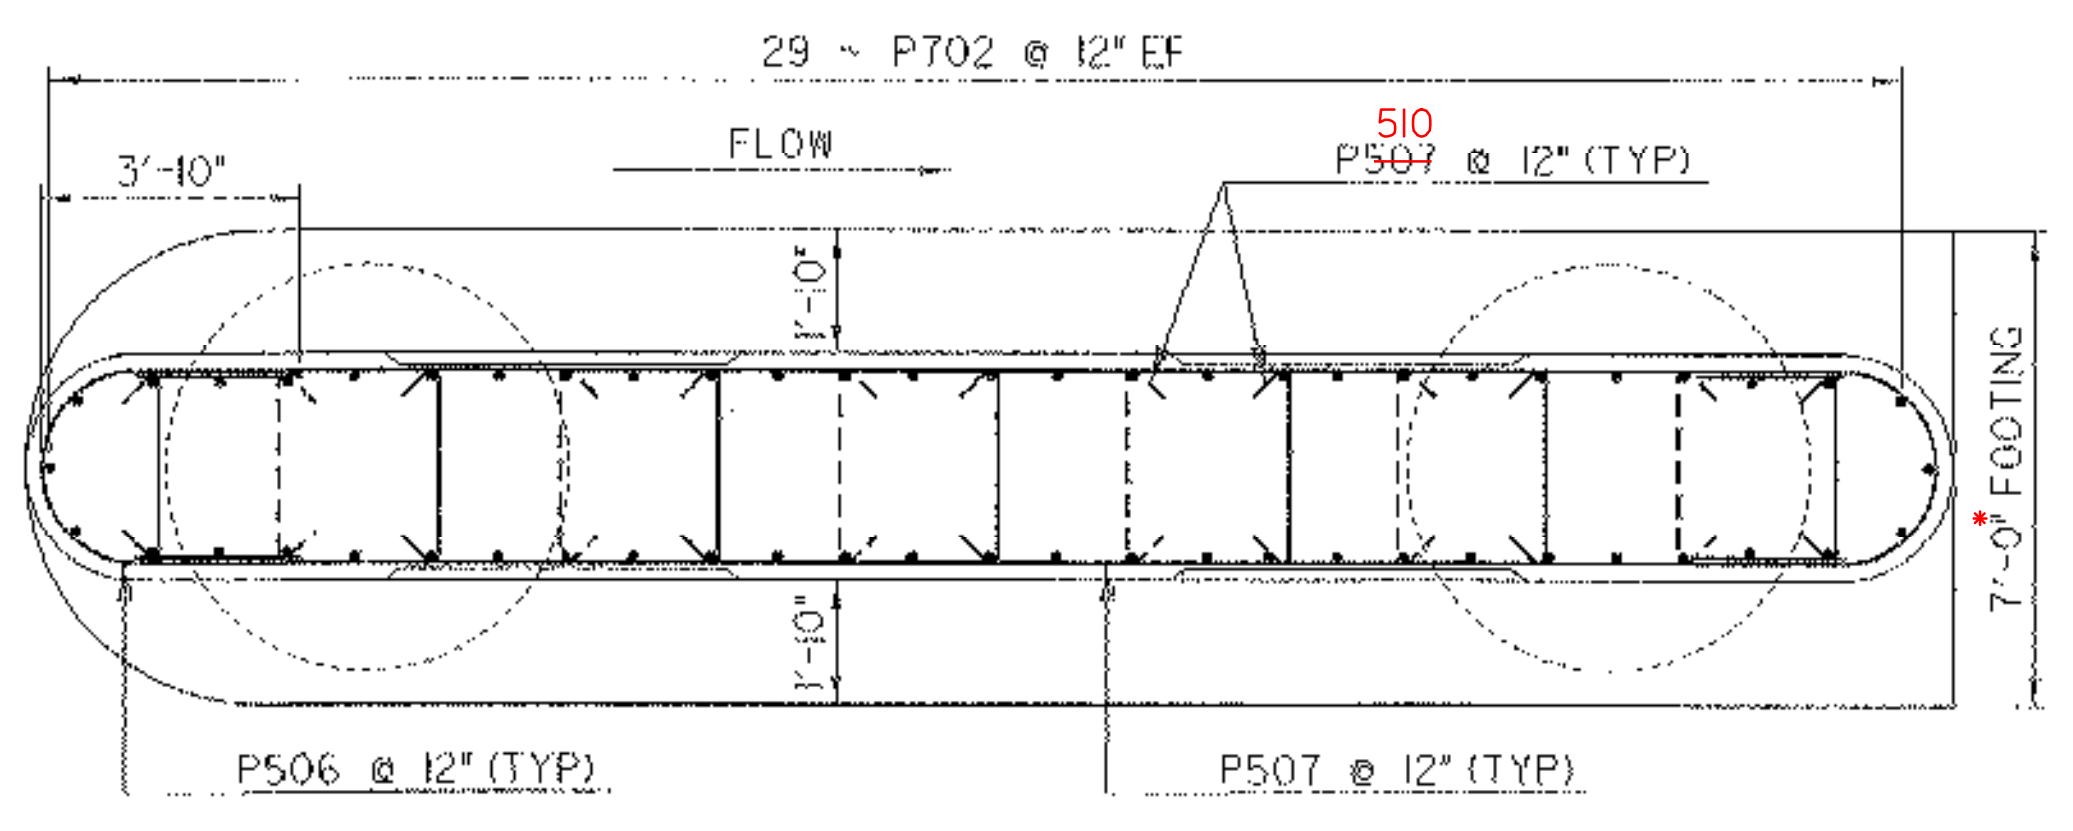

SECTION A-A
SCALE 3/8" = 1'-0"
0 1 2 3 4

• SEE C.O. #1
ALL ADDITIONAL CONCRETE
FOR THE LARGER FOOTING
IS INCLUDED IN C.O.#1

NOTE:
NF = NEAR FACE
FF = FAR FACE
EF = EACH FACE
▲ = CUT TO FIT IN FIELD
3" CLR. UNLESS OTHERWISE NOTED
2'-2" BAR LAP UNLESS OTHERWISE NOTED
• BRIDGE SEATS MAY NEED ADJUSTMENT BASED
ON FINAL PIER BEARING SHOP DRAWING APPROVAL

PIER PLAN & ELEVATION

PROJECT NAME:	RANDOLPH
PROJECT NUMBER:	BRF 0241 (29)
FILE NAME:	/s1r5/88j096/s88j096sub.dgn
PLOT DATE:	29-AUG-2006
PROJECT LEADER:	W. SYMONDS
DRAWN BY:	G. SHANGRAW
DESIGNED BY:	T. SUMNER
CHECKED BY:	T. FILLBACH
SHEET	74 OF 135