


NOTE: ATTACHMENT OF WT-CONNECTION PLATE TO GIRDER SHALL BE ACCOMPLISHED THROUGH FIELD DRILLING AND BOLTING.

ALL CONNECTIONS SHALL BE MADE WITH 7/8" DIA. AASHTO M164 TYPE 3 BOLTS.

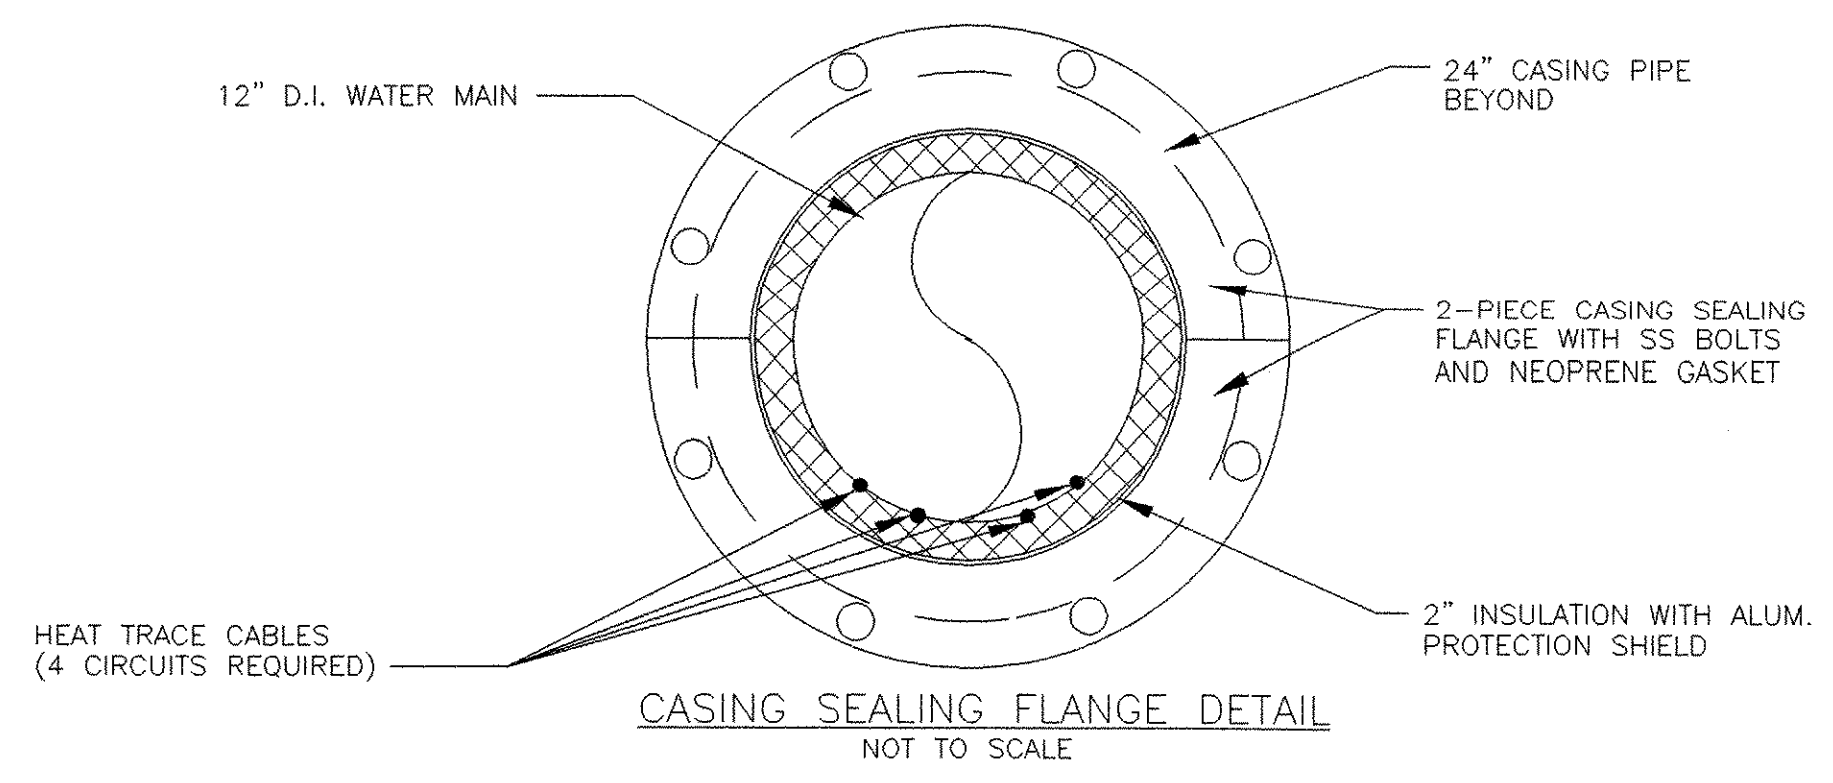

NOTE: INFORMATION ON THIS SHEET IS FOR THE WATER MAIN AND DETAILS ONLY. REFER TO OTHER DRAWINGS FOR BRIDGE AND ROADWAY DETAILS.

### WATER MAIN DETAIL SHEET 1

PROJECT NAME:	RANDOLPH	PLOT DATE:	29-AUG-2006
PROJECT NUMBER:	BRF 024(129)	DRAWN BY:	
FILE NAME:	s88j096water3.dgn	DESIGNED BY:	Dubois & King, Inc.
PROJECT LEADER:	W. Symonds	CHECKED BY:	
DESIGNED BY:	Dubois & King, Inc.	SHEET	91 OF 135
s88j096water4.i			