



PROJ # 7AA08E

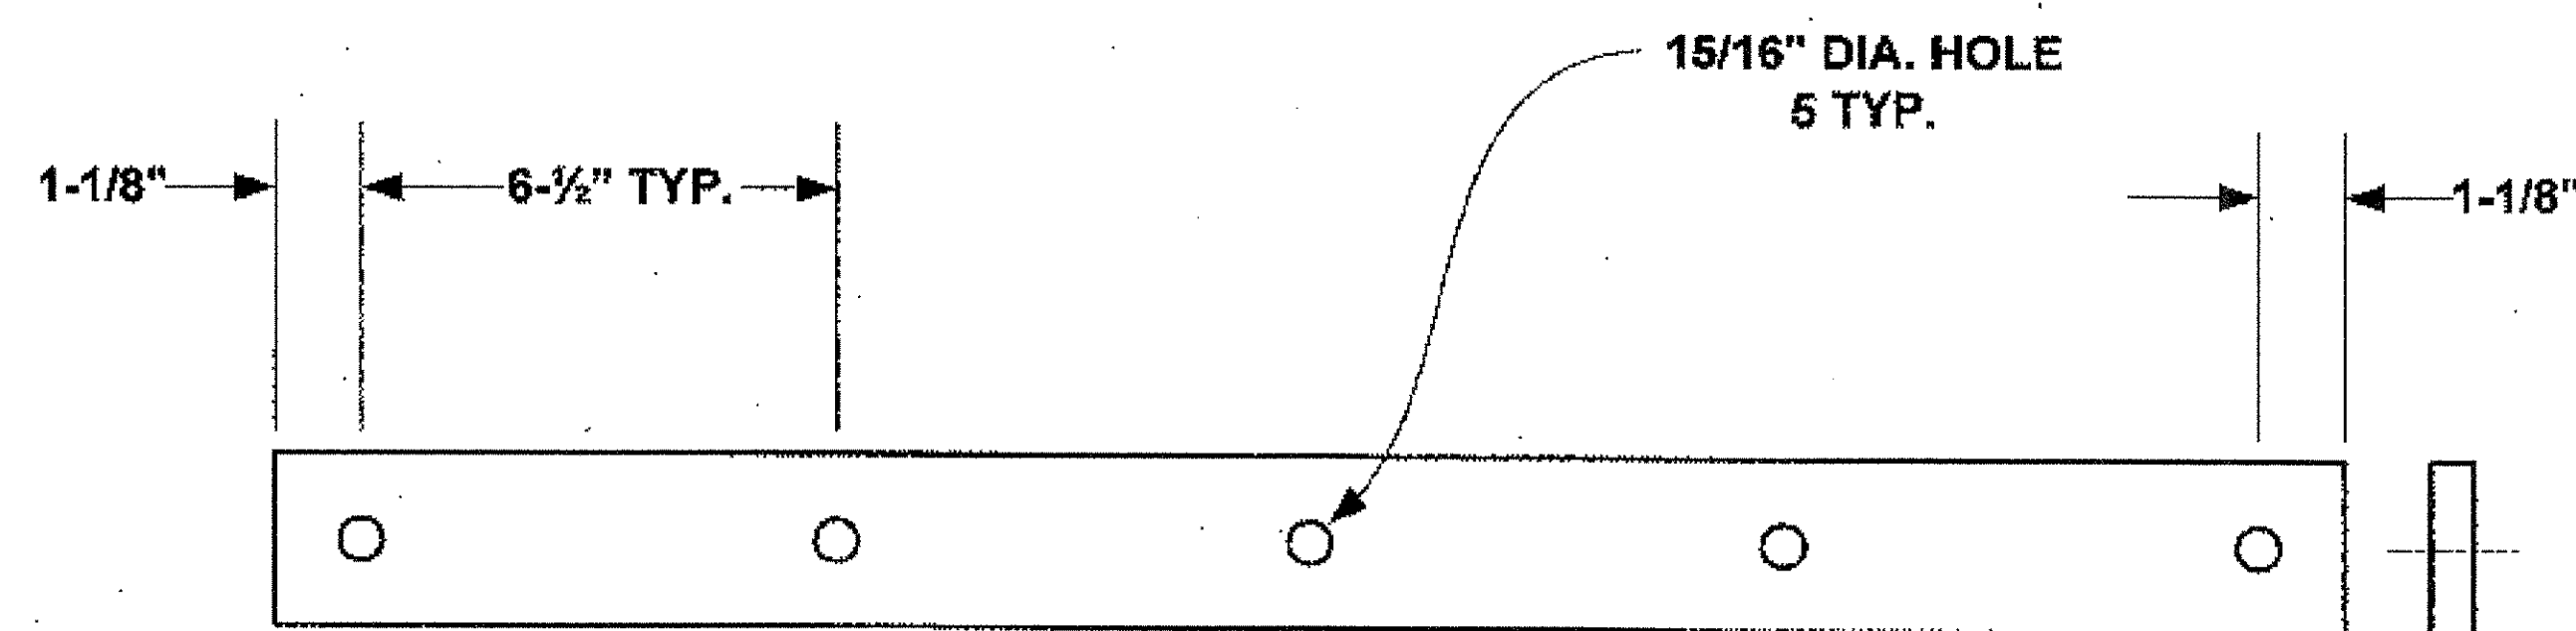

**FLAT CROSSBAR
HOLE DETAIL**
FLAT CROSSBAR (1/2" X 2")

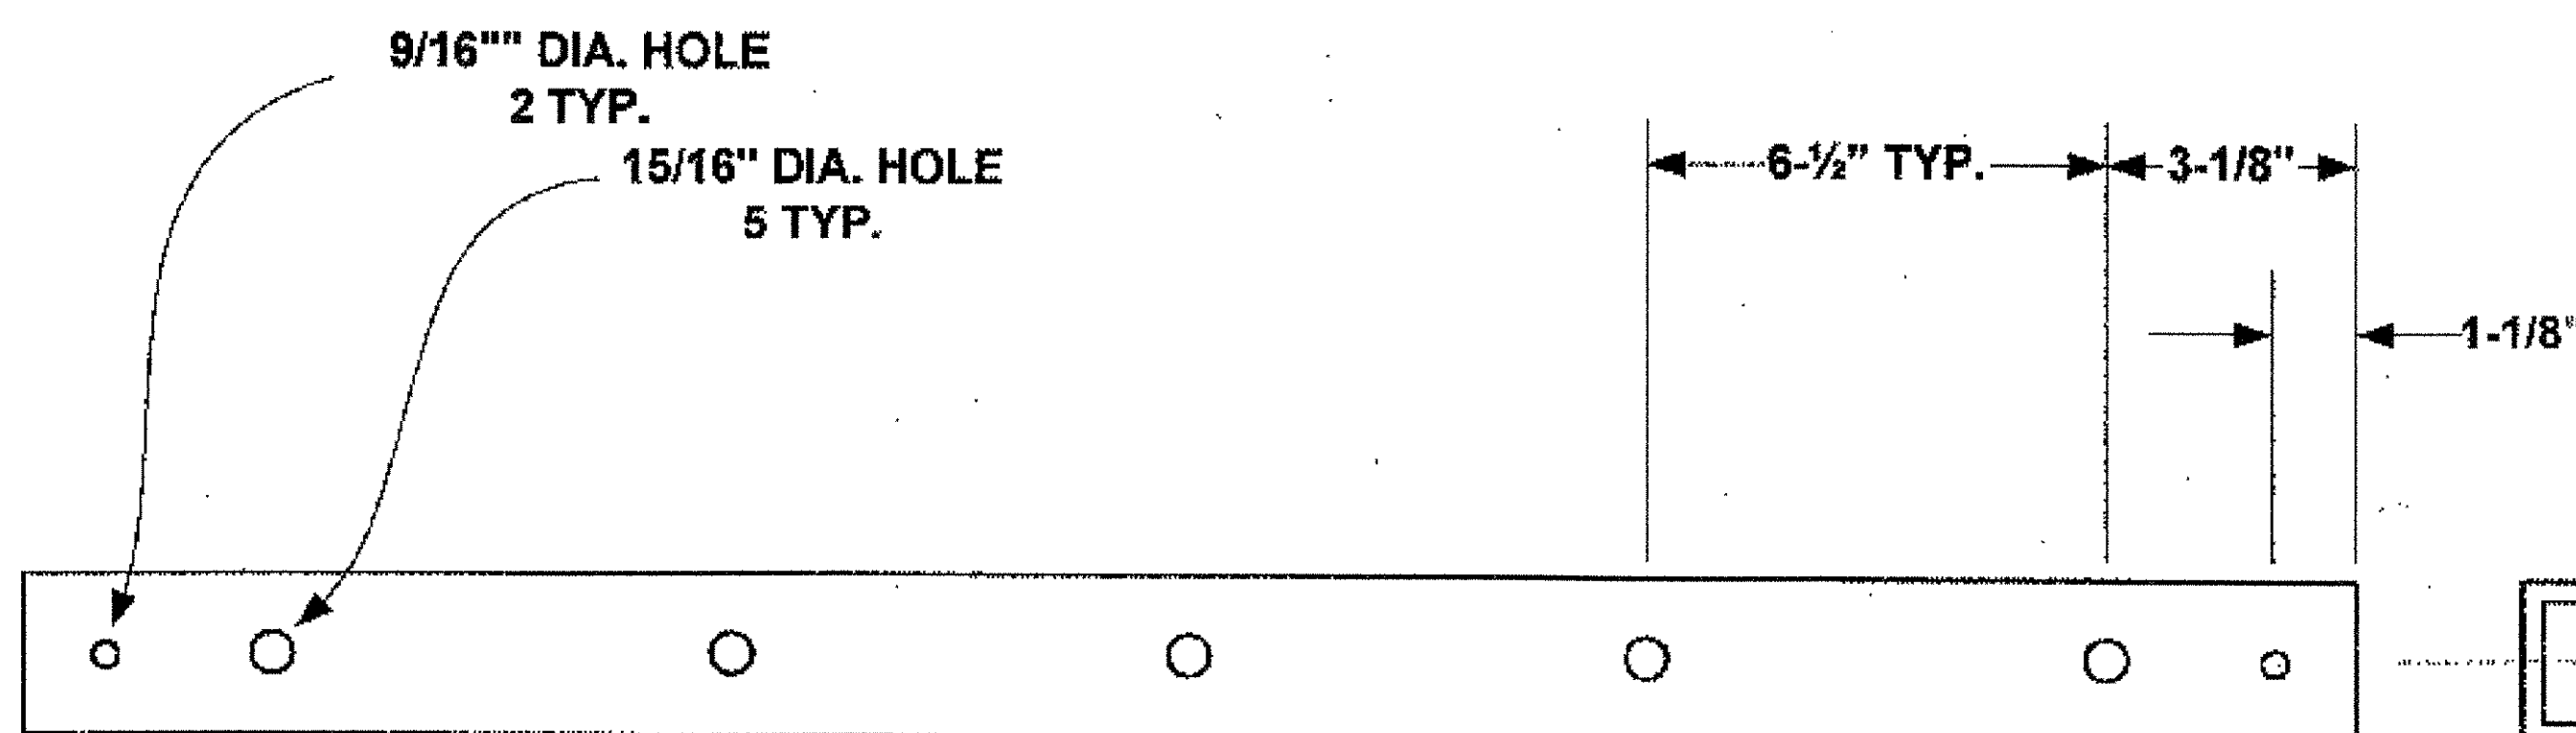

**SQUARE CROSSBAR
HOLE DETAIL**
SQUARE CROSSTUBE (1/8" X 2" X 2")

	SAFETY NOTES:		MOD/REV NO	DATE	EWO NO.
	HEAVY TRAFFIC				PRINT 6 OF 0
SIGNATURE: <i>T.H. Bushey</i>					PREPARED BY: T.H. BUSHEY
DATE: 2/10/2006					C. O. /EXCHANGE NAME: RNDH
ELCO	PRE CT	YES <input checked="" type="checkbox"/> NO <input checked="" type="checkbox"/>	UNDERGROUND		4873
	PRIMARY VOLTAGE TO GROUND	7.2 KV MGN SYSTEM	BLOCK (NYT)		MUNICIPALITY: Randolph
CABLE PRESS	UNDER PRESS	YES <input type="checkbox"/> NO <input checked="" type="checkbox"/>	BUFFER	YES <input type="checkbox"/> NO <input checked="" type="checkbox"/>	MANIFOLD LOCATION MH# NA
TRANSMISSION	26 GA LIMIT	YES <input type="checkbox"/> NO <input checked="" type="checkbox"/>	AMT. BRIDGE TAP		NA KF

26 GA AREA, 24 GA. CABLE USED DUE TO DISTRICT POLICY

REVISED 2/24/2006

**UTILITY - TELEPHONE
DUCTS ON BRIDGE**

PROJECT NAME:	RANDOLPH
PROJECT NUMBER:	BRF 024I(29)
FILE NAME: /88J096/SJ096UTILITYRASTERS.DGN	PLOT DATE: 29-AUG-2006
PROJECT LEADER: W. SYMONDS	DRAWN BY: G. SHANGRAW
DESIGNED BY: VERIZON, INC.	CHECKED BY: T. SUMNER
sj096verizon3.i	SHEET 95 OF 135