
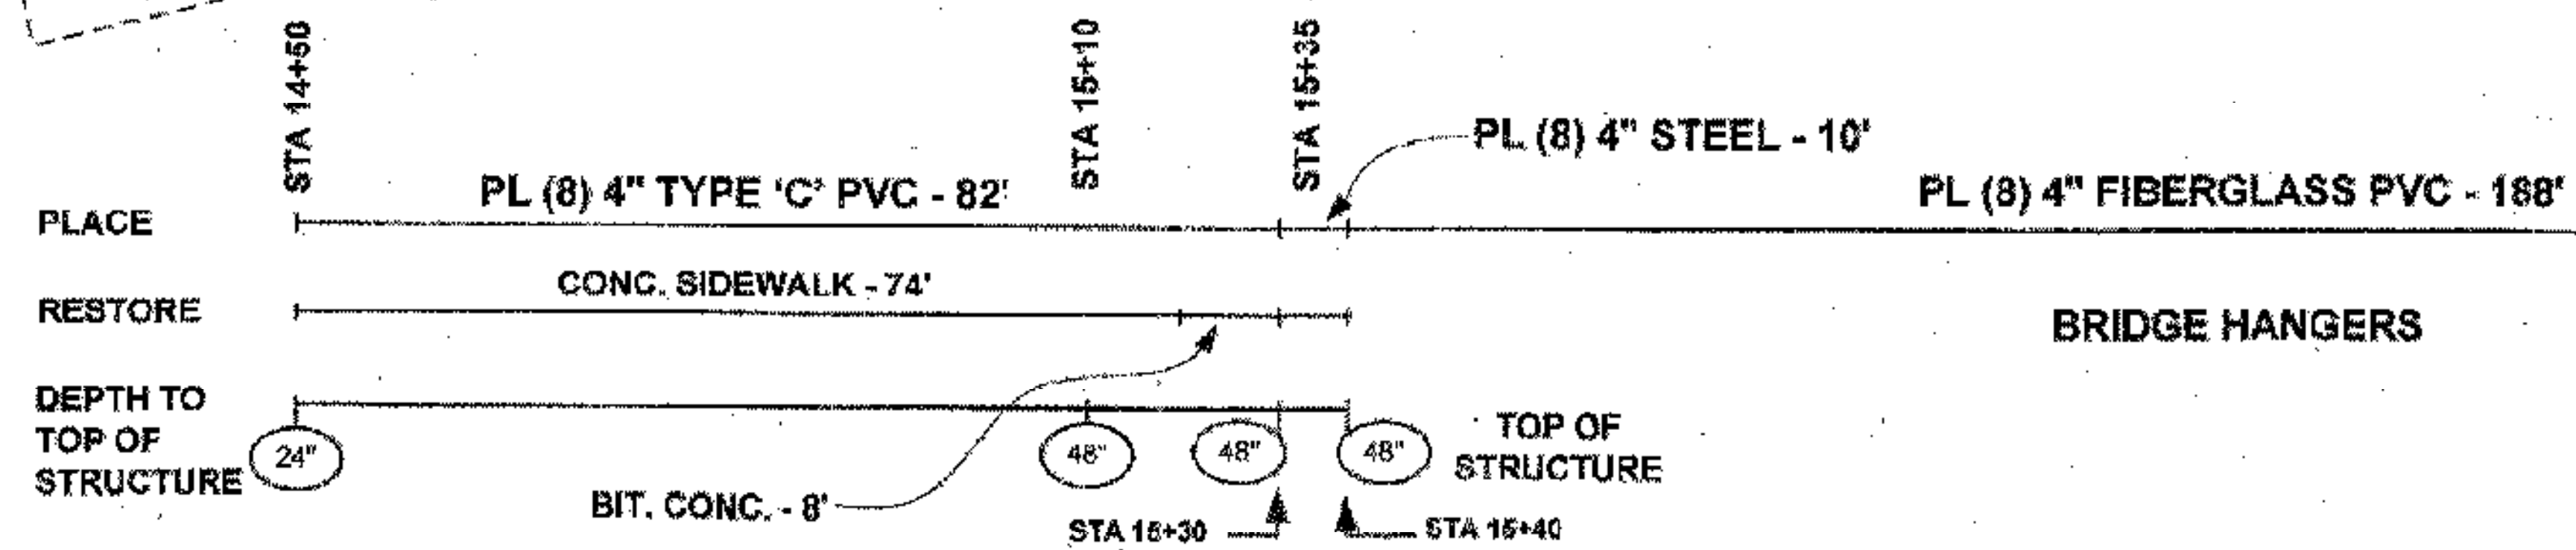


PROJ# 7AA08E
VERIZON'S CONTACT
CONTRACT ENGINEER
THOMAS H BUSHEY
1-802-483-2973

| | | | | |
|-----------------------------|---|-----------------|---------------------|-----------------------------|
| | SAFETY NOTES: | MOD/REV NO | DATE | EWG NO. 0 |
| | Heavy Traffic | | | PRINT 1 OF 0 |
| SIGNATURE: <i>T. Bushey</i> | | | | PREPARED BY: T.H. BUSHEY |
| DATE: 2/10/2006 | | | | C. O. / EXCHANGE NAME: RNDH |
| CVP'S | PRE CT YES <input checked="" type="checkbox"/> NO <input checked="" type="checkbox"/> | TYPE AERIAL | RECORD REF: 1 & 1-1 | C. O. / EXCHANGE CODE: 4873 |
| | PRIMARY VOLTAGE TO GROUND 7.2 KV MGN SYSTEM | UNDERGROUND | BLOCK (NYT) 3 & 5 | MUNICIPALITY: Randolph |
| | CONDUIT | CONDUIT | | MANIFOLD LOCATION MH# NA |
| CABLE PRESS | UNDER PRESS YES <input type="checkbox"/> NO <input checked="" type="checkbox"/> | AMT. BRIDGE TAP | | NA KF |
| TRANSMISSION | 26 GA LIMIT YES <input type="checkbox"/> NO <input checked="" type="checkbox"/> | | | |

REVISED 2/24/2006

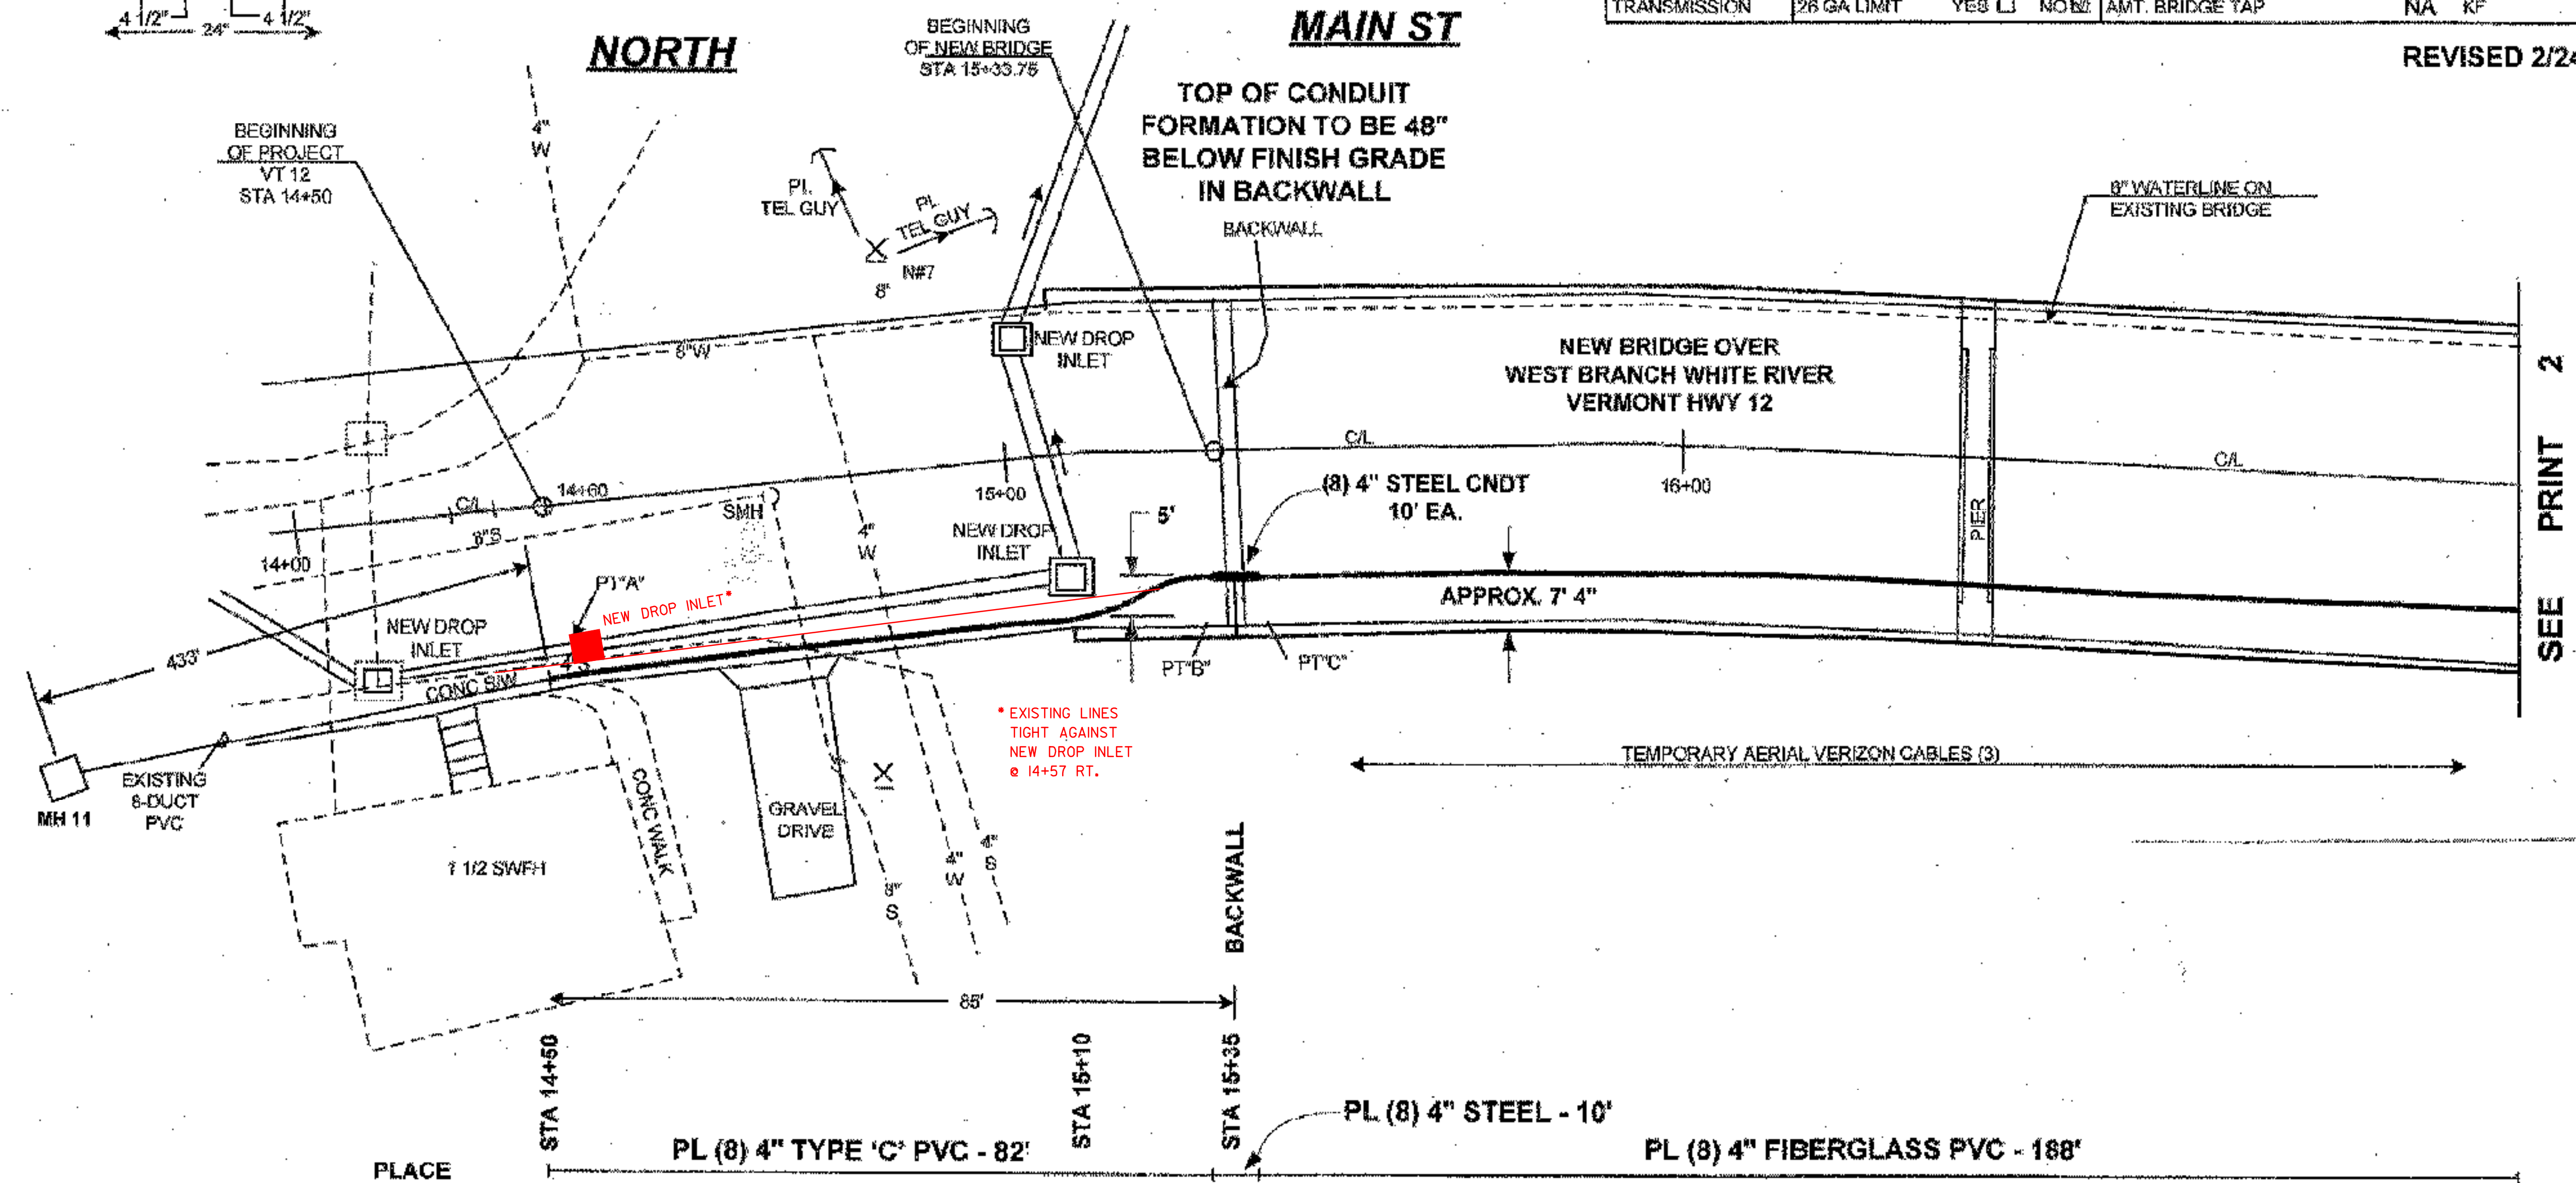

UTILITY - TELEPHONE DUCTS ON BRIDGE

| | |
|---|------------------------|
| PROJECT NAME: | RANDOLPH |
| PROJECT NUMBER: | BRF 024(29) |
| FILE NAME: /88J096/SJ096UTILTYRASTERS.DGN | PL01 DATE: 29-AUG-2006 |
| PROJECT LEADER: W. SYMONDS | DRAWN BY: C. SHANCRAM |
| DESIGNED BY: VERIZON, INC. | CHECKED BY: T. SUMNER |
| sj096verizon5j | SHEET 97 OF 135 |

SEE PRINT 2