




13+50
BEGIN
APPROACH

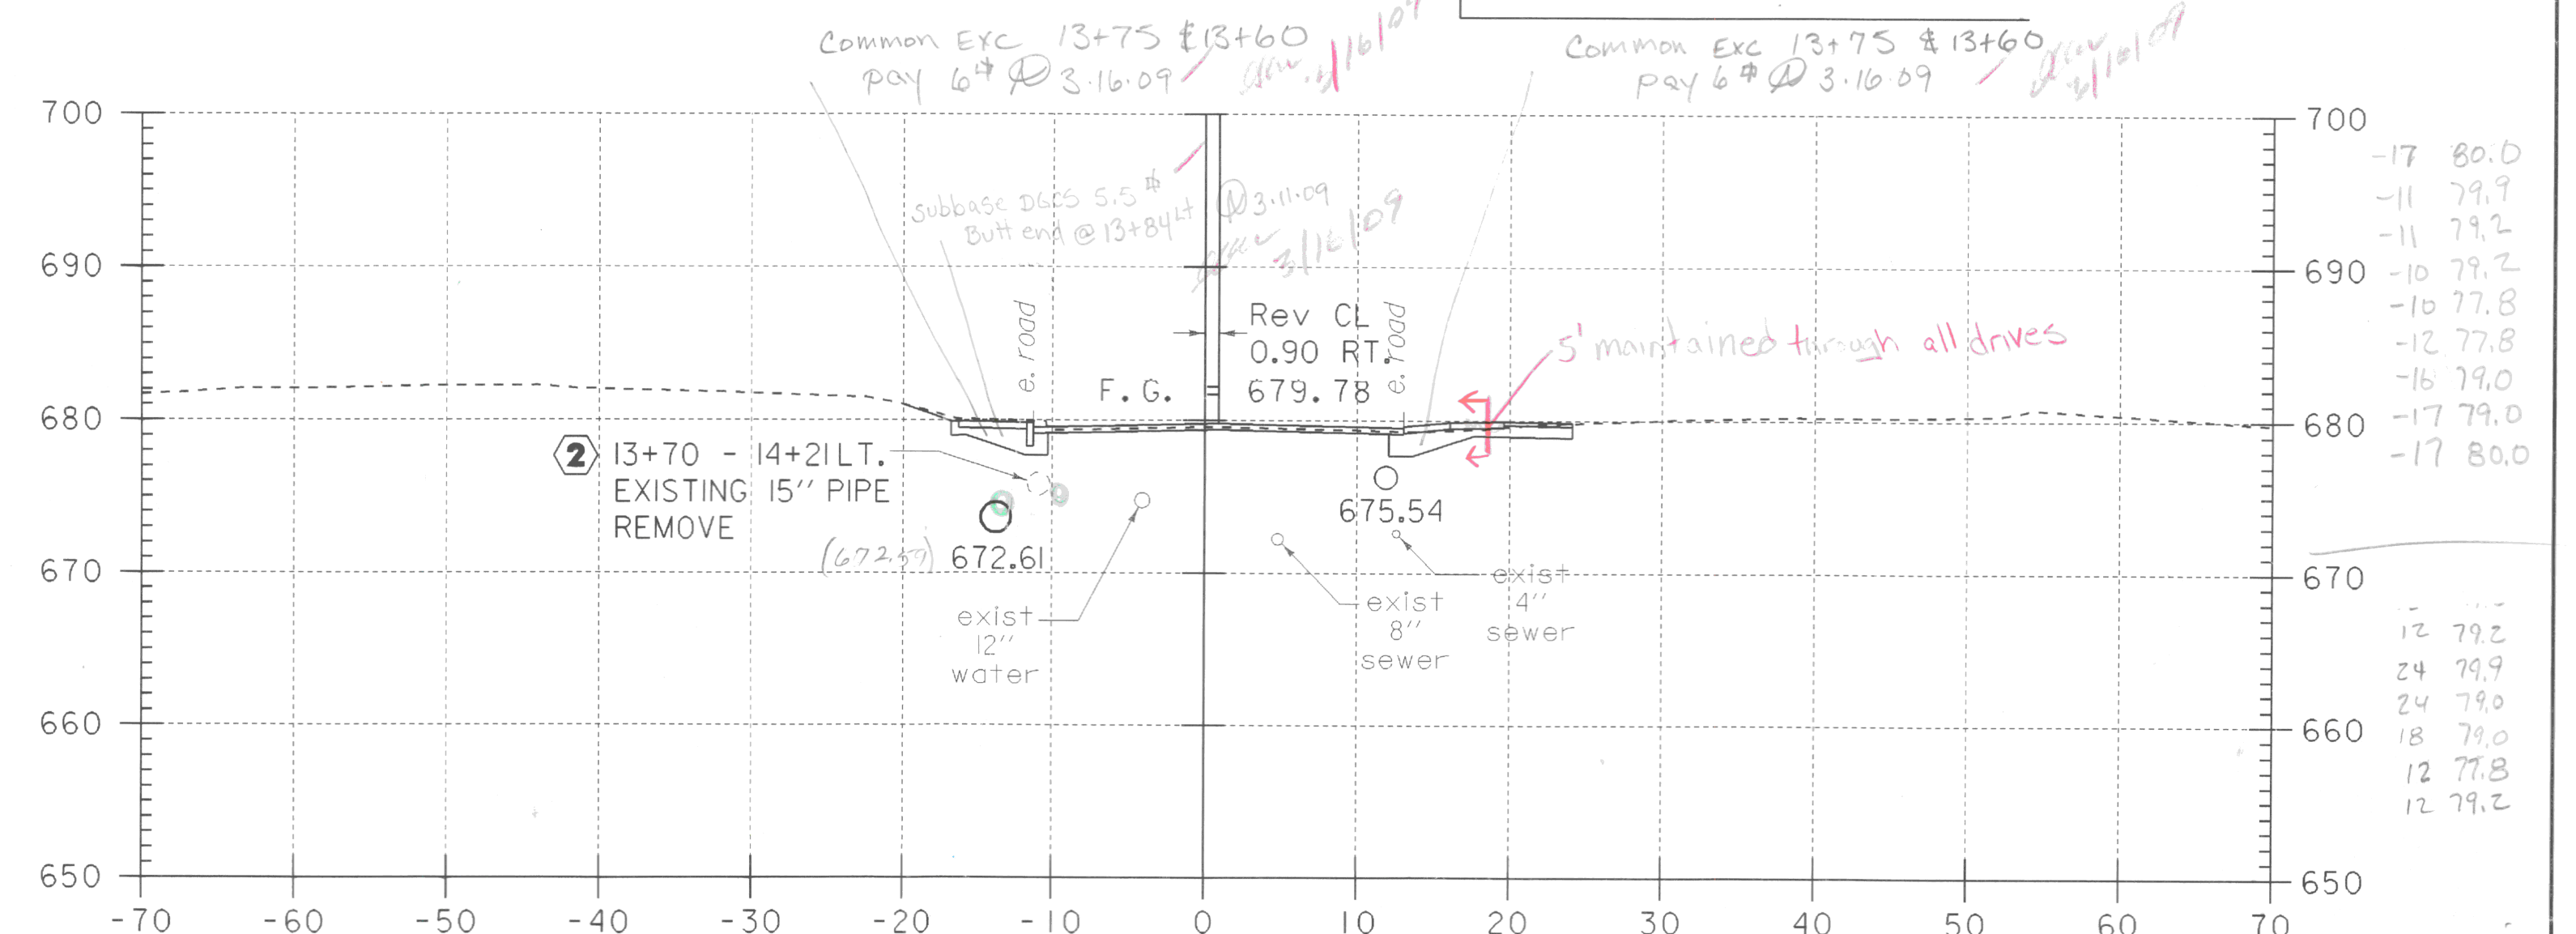

13+75

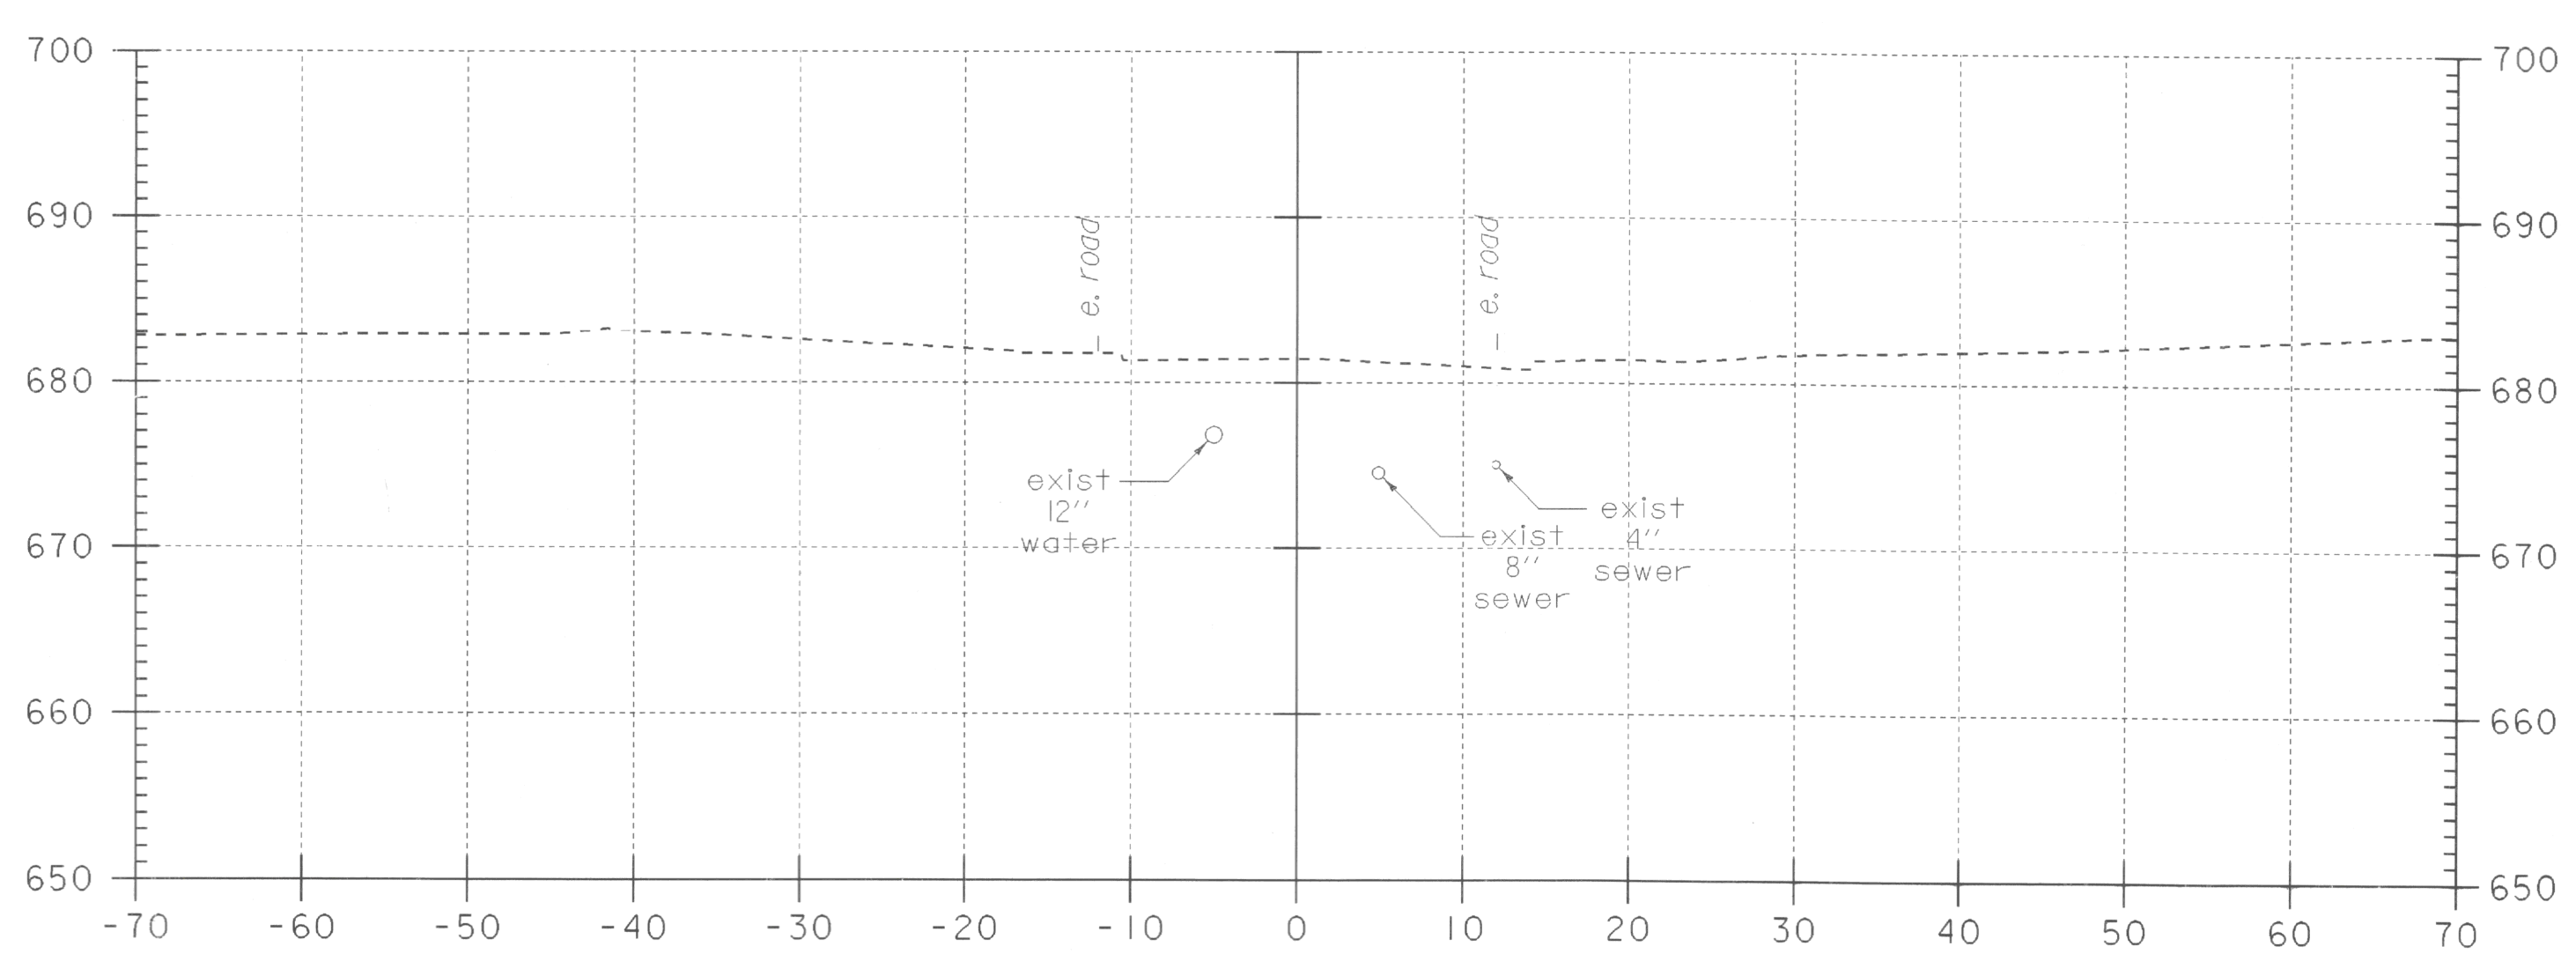


13+25

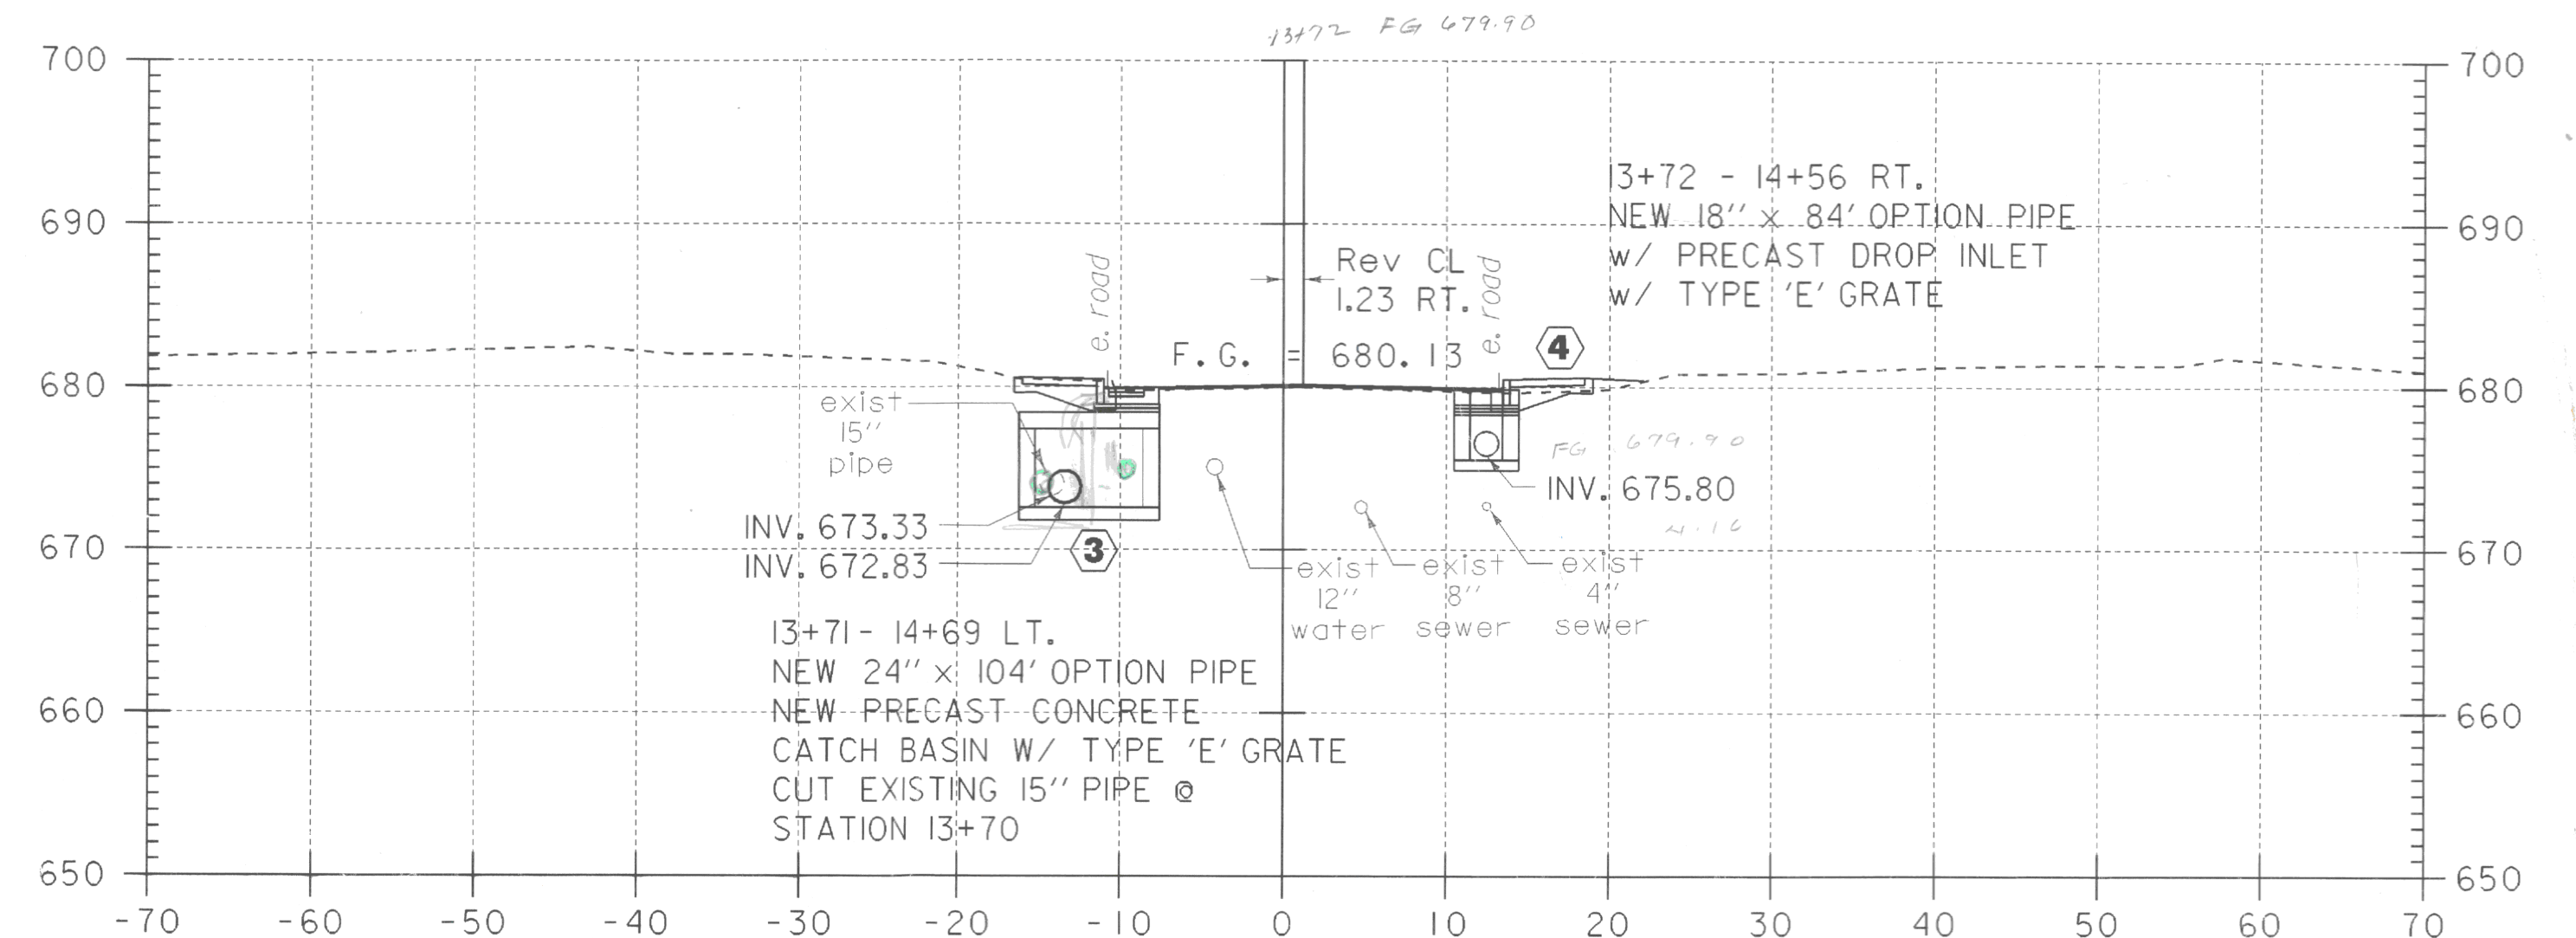

13+66

**MAINLINE SECTIONS
STA. 13+25 - STA. 13+75**

PROJECT NAME:	RANDOLPH
PROJECT NUMBER:	BRF 0241 (29)
FILE NAME:	/st+5/88j096/sj096m1x.dgn
PROJECT LEADER:	W. SYMONDS
DESIGNED BY:	W. B. SYMONDS
DRAWN BY:	G. SHANGRAW
CHECKED BY:	T. SUMNER
SHEET	110 OF 135

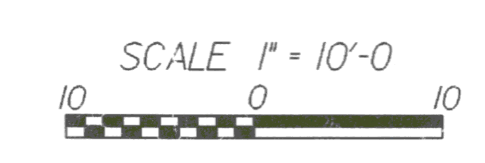

146.5
1571