

Subbase DGCS deduct Approach slab


15" slab minus 8" pavement = 7" into subbase

slab width = 30' slab length = 15+14 to 15+32.75 = 18.75'

0.58' x 30' x 18.75' / 27 = 12.15 CY

2/24/09

3/16/09

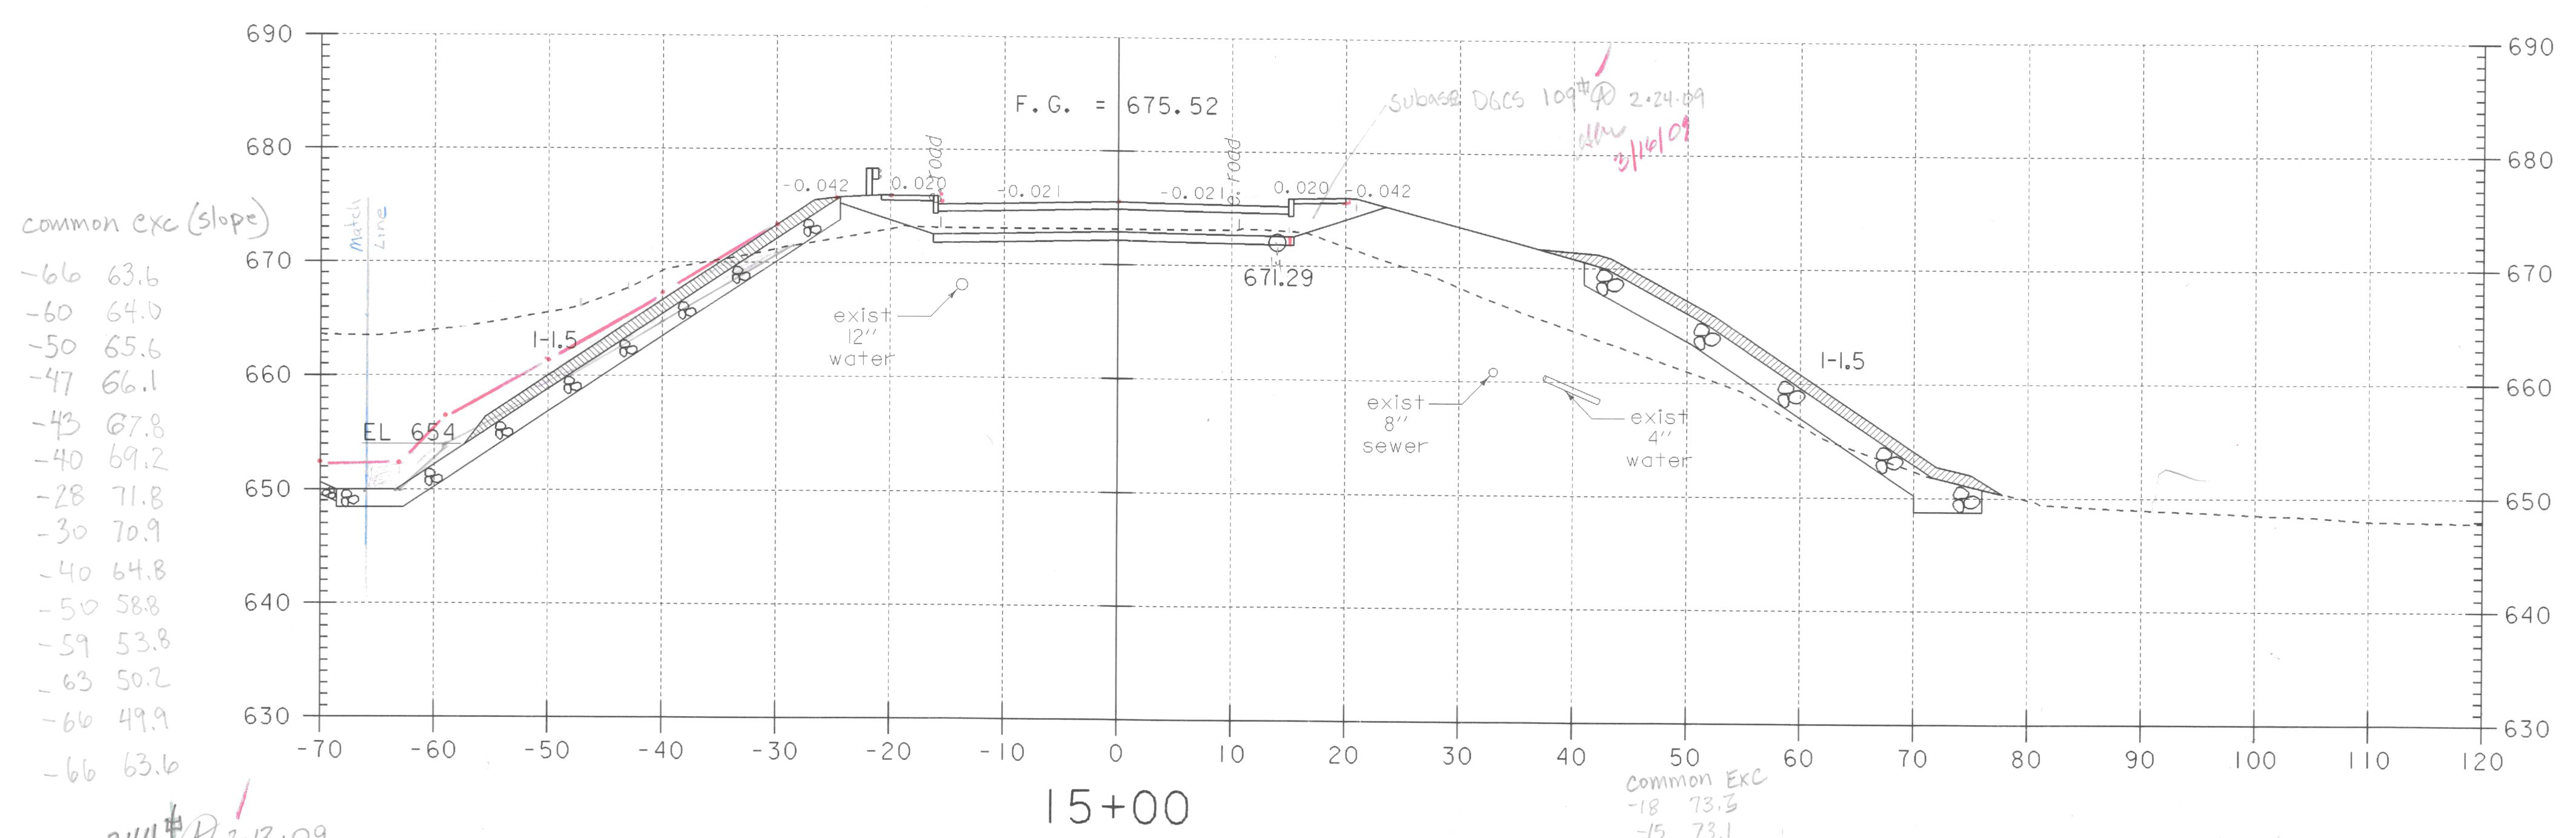

Common Exc

-18	73.3
-15	73.1
0	73.1
10	73.1
11	74.4
15	73.0
17	72.9
15	72.7
15	71.8
0	72.1
-16	71.8
-16	72.5
-18	73.3

MAINLINE SECTIONS STA. 15+00 - STA. 15+11

PROJECT NAME:	RANDOLPH
PROJECT NUMBER:	BRF 0241 (29)
FILE NAME:	/str5/88j096/sj096m1x.dgn
PROJECT LEADER:	W. SYMONDS
DESIGNED BY:	W. B. SYMONDS
sj096m13.i	
PLOT DATE:	29-AUG-2006
DRAWN BY:	G. SHANGRAW
CHECKED BY:	T. SUMNER
SHEET	112 OF 135

