
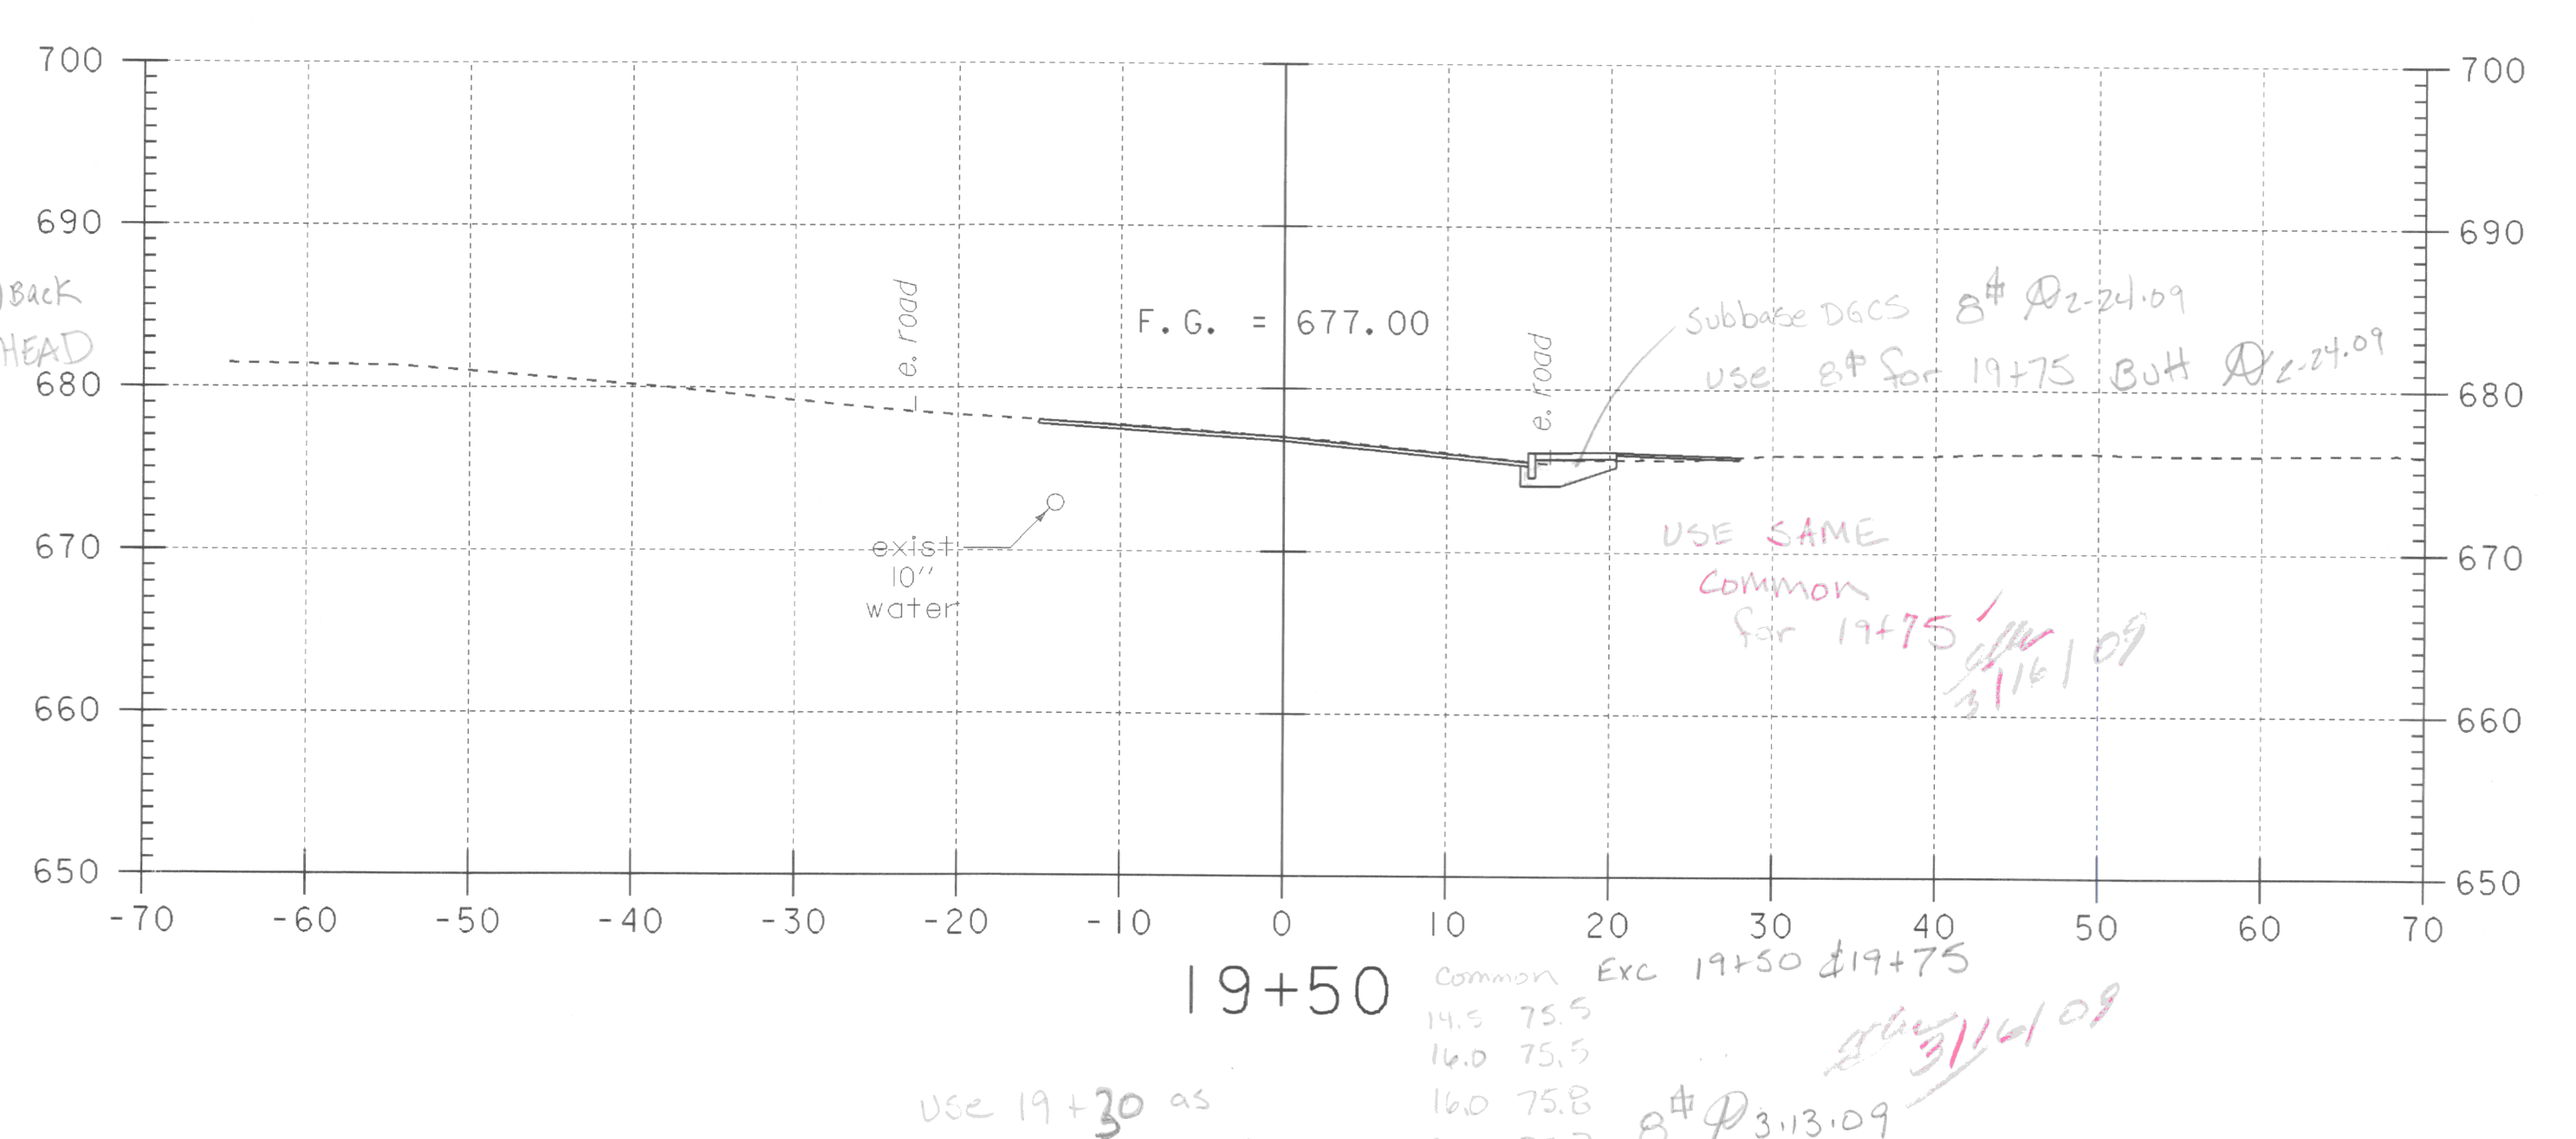
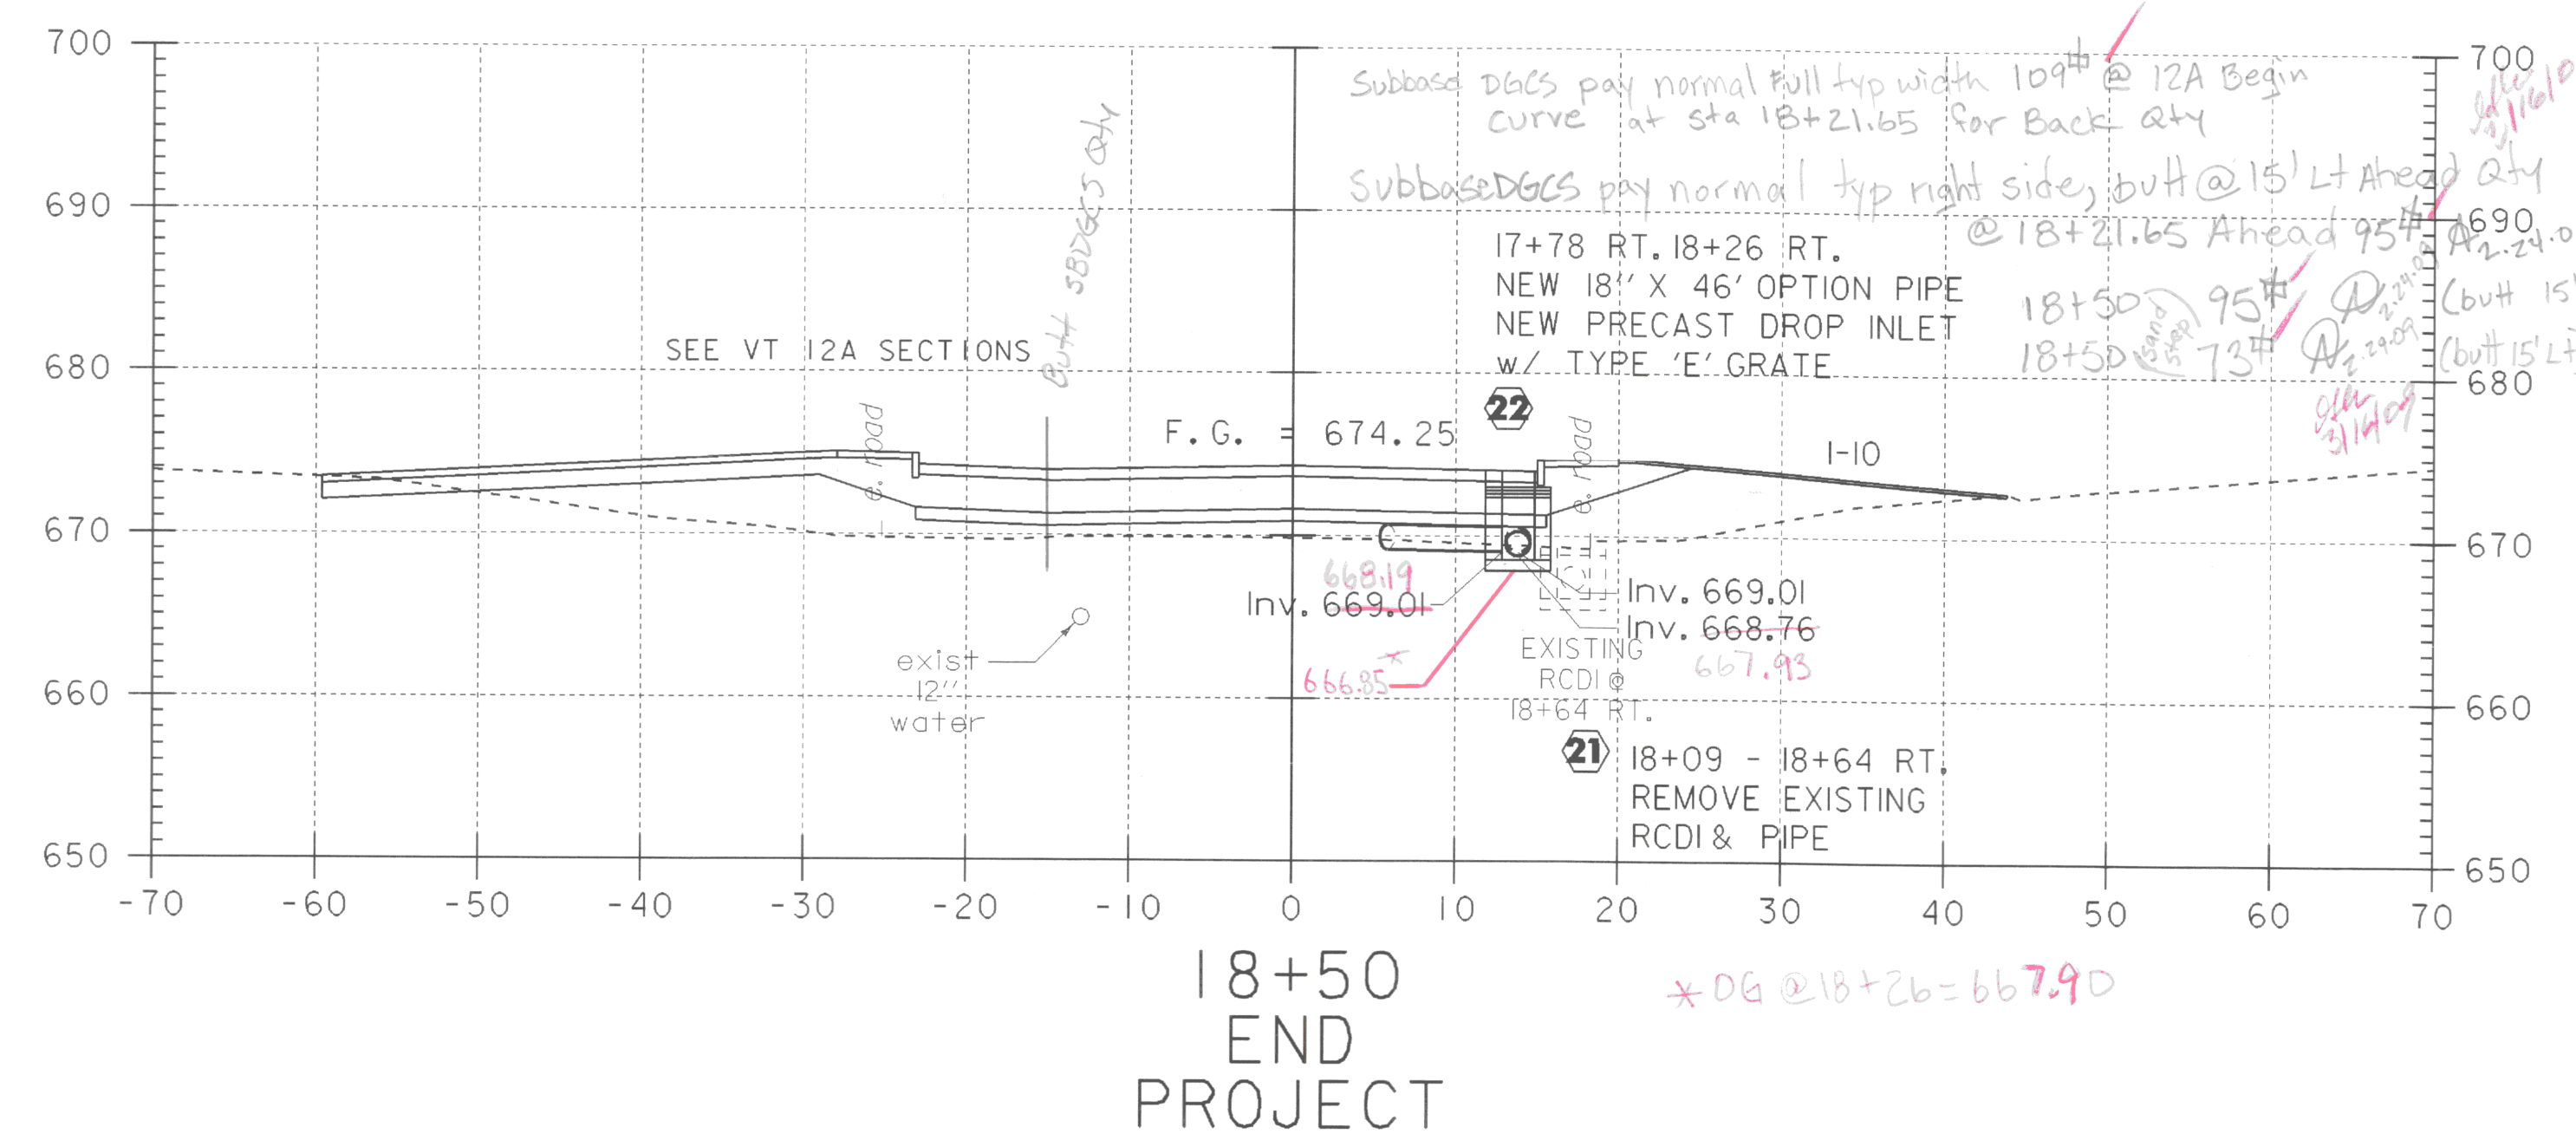
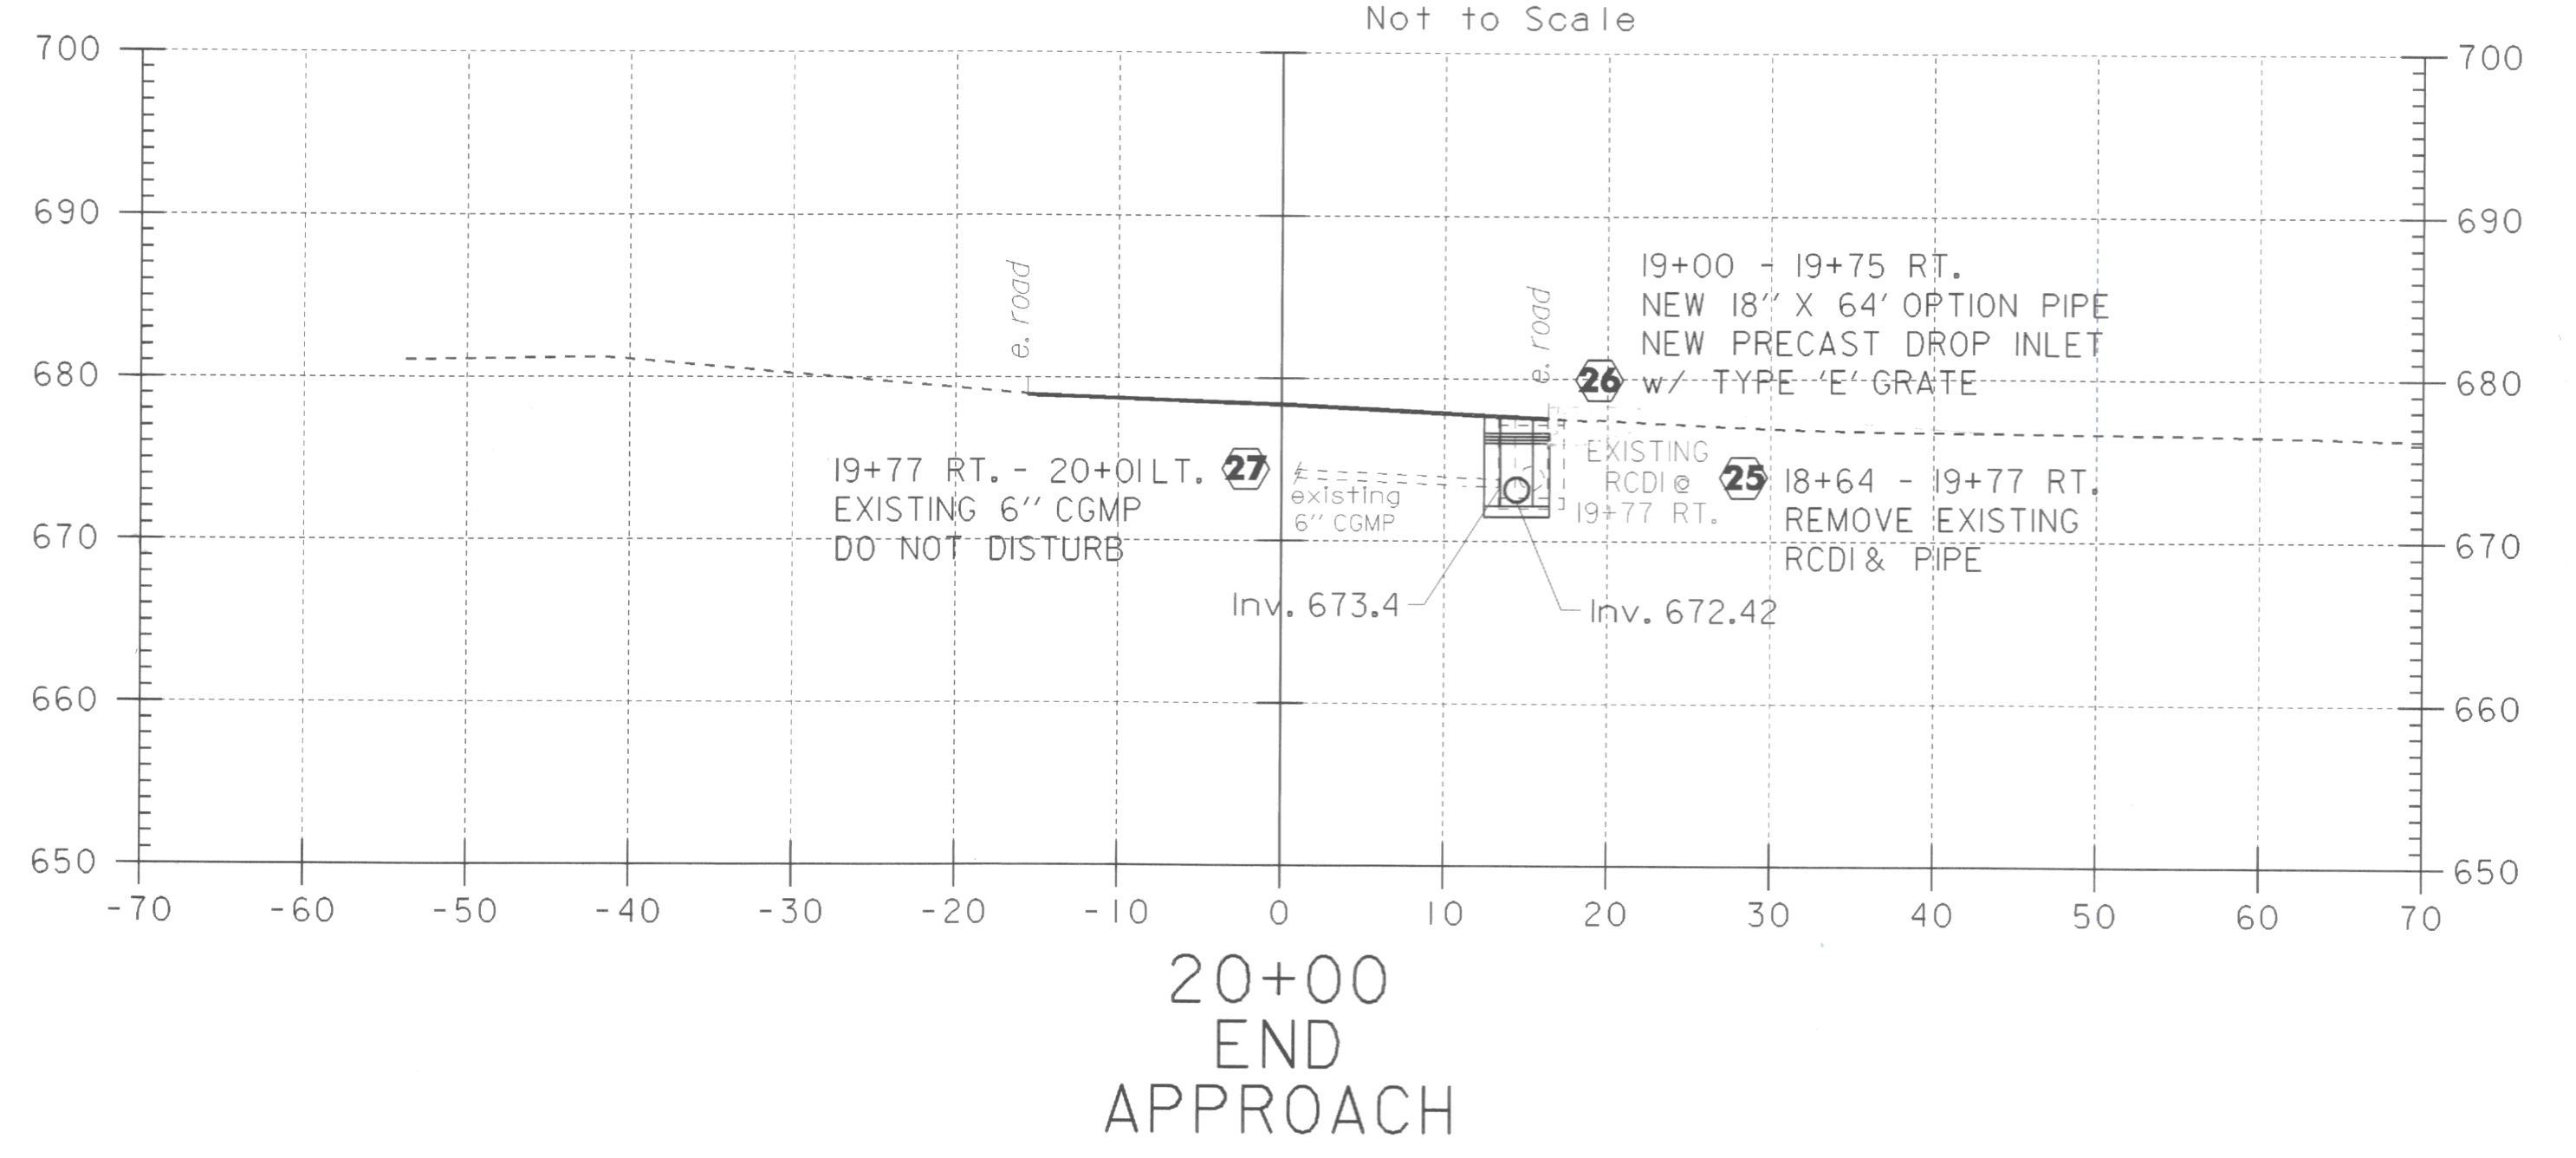


TYPICAL ROADWAY MATERIALS TRANSITION DETAIL FOR VT 12

Not to Scale

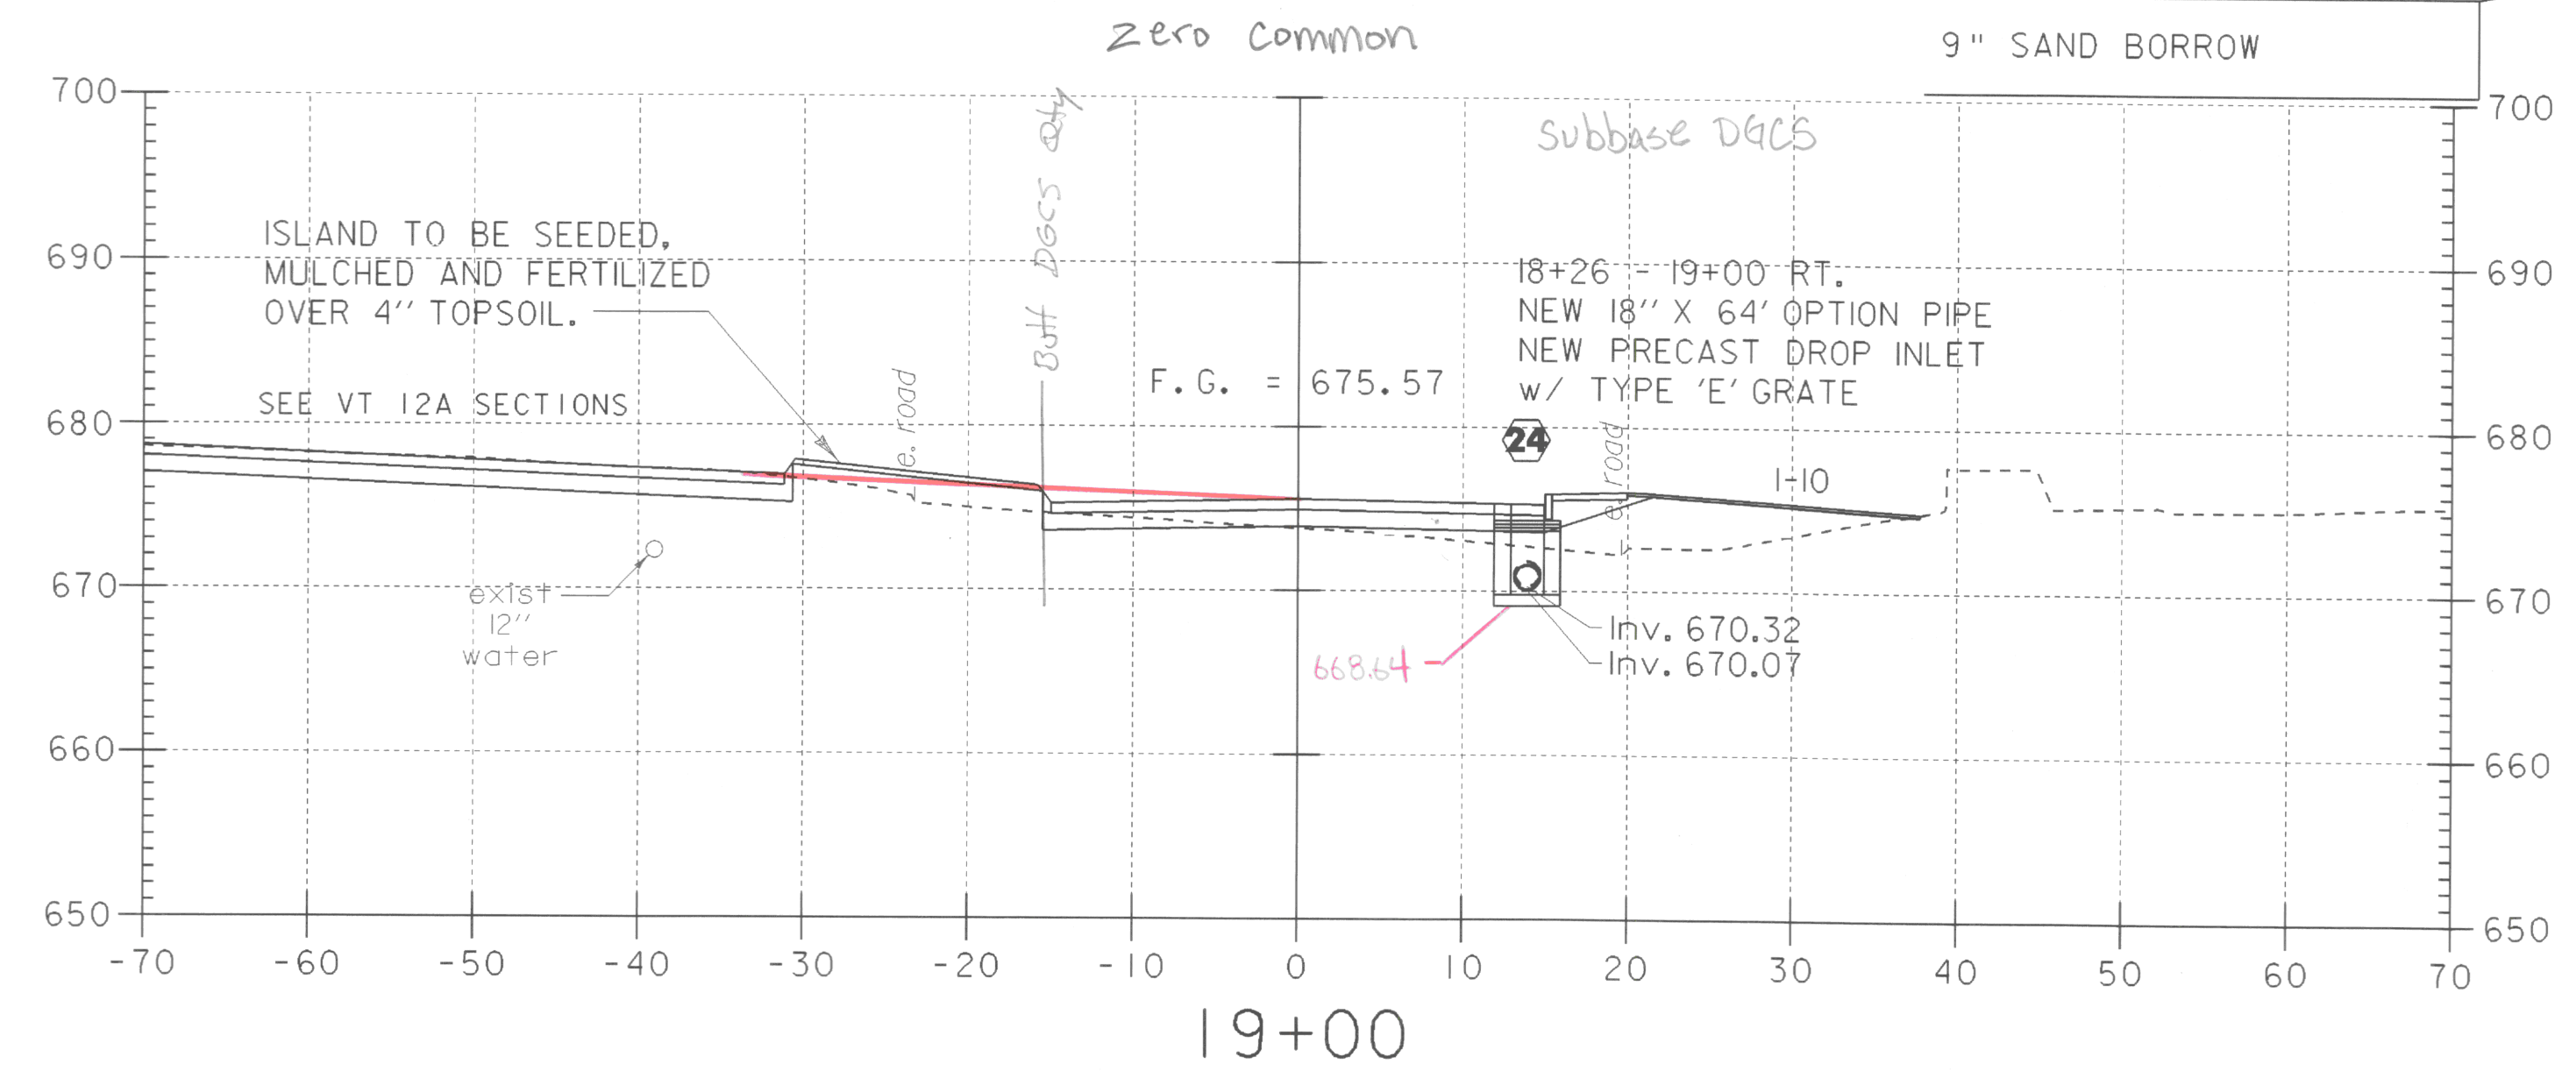

**MAINLINE SECTIONS STA. 18+50 - STA. 20+00**

PROJECT NAME:	RANDOLPH
PROJECT NUMBER:	BRF 0241 (29)
FILE NAME:	/str5/88j096/sj096mix.dgn
PROJECT LEADER:	W. SYMONDS
DESIGNED BY:	W. B. SYMONDS
sj096m16.i	
PLOT DATE:	29-AUG-2006
DRAWN BY:	G. SHANGRAW
CHECKED BY:	T. SUMNER
SHEET	115 OF 135

