
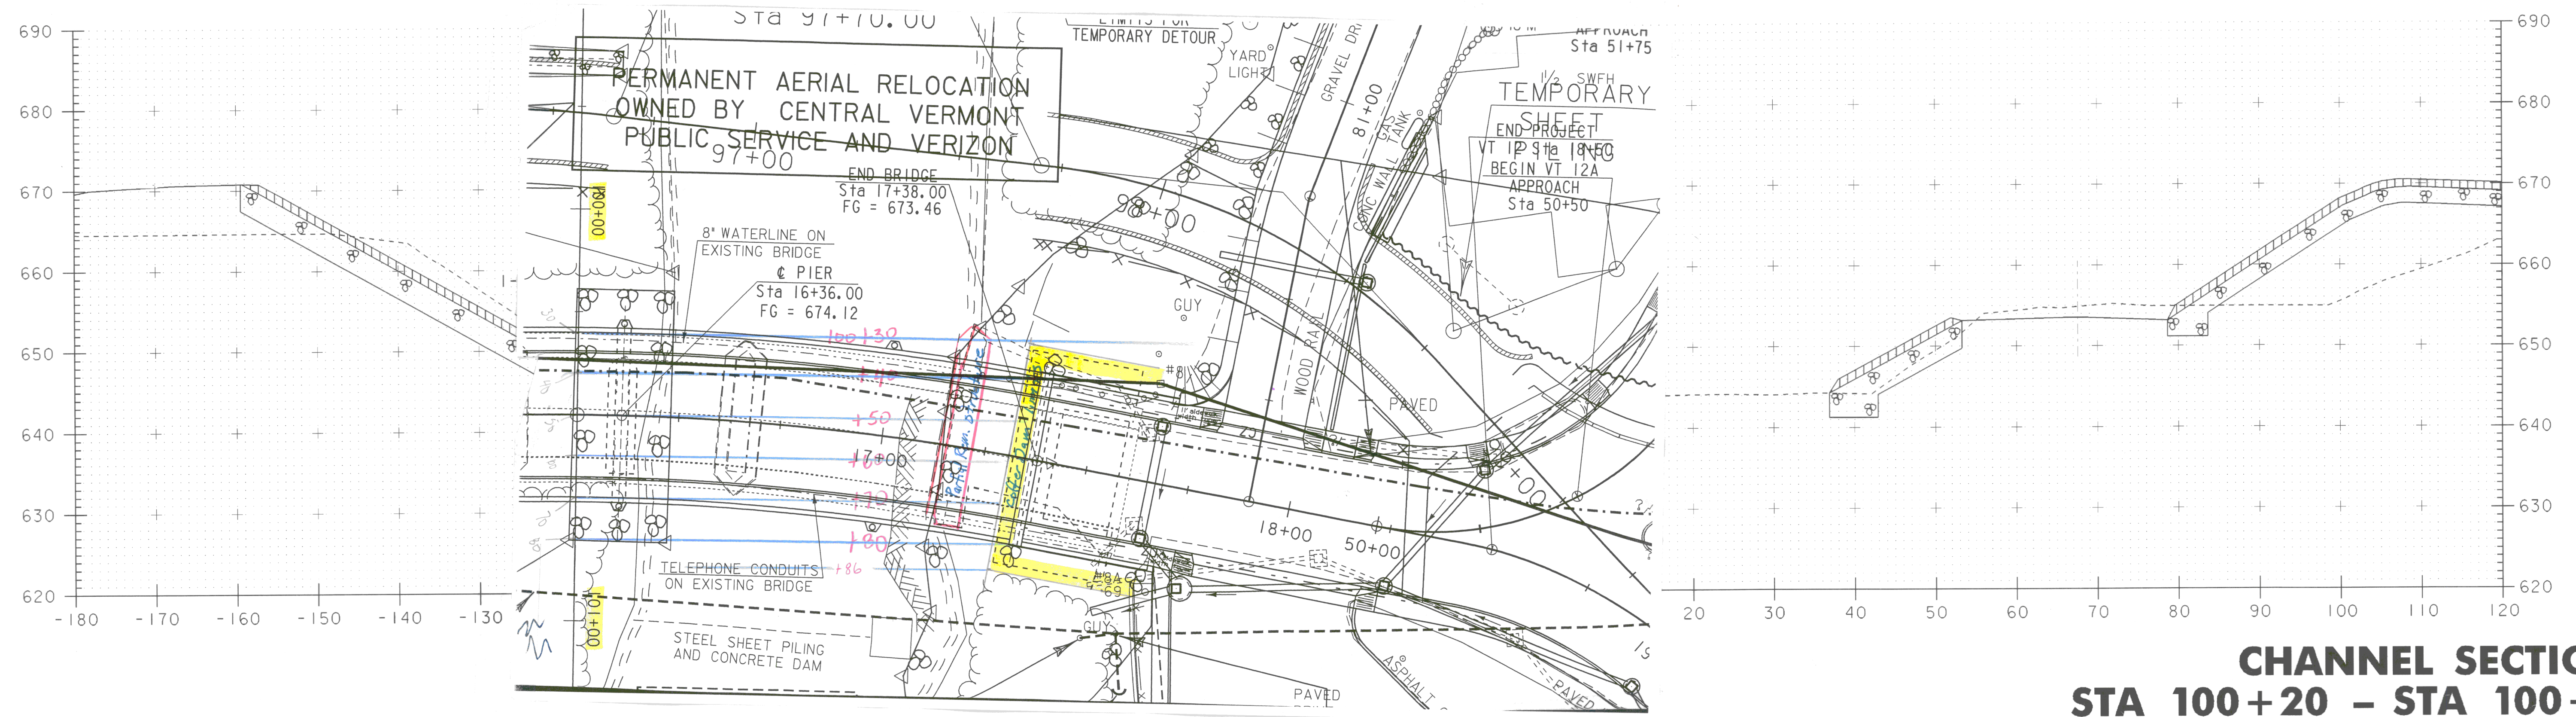


undclassified excav
 USE 100+30 as butt Area* 260# 6-29-07

*NOTE All excavation before 100+30 see Drive Sections - Paid a common EXC.
 CL 100+30 = Drive Sta. 80+28

sta	Dist	Area	CY
100+30	10	260	86.67
+40	10	208	77.04
+50	10	208	81.85
+60	7	234	64.04
+67		260	
+67	11	11	2.65
+80	13	0	
		312.24	86.29-07
			3/19/09

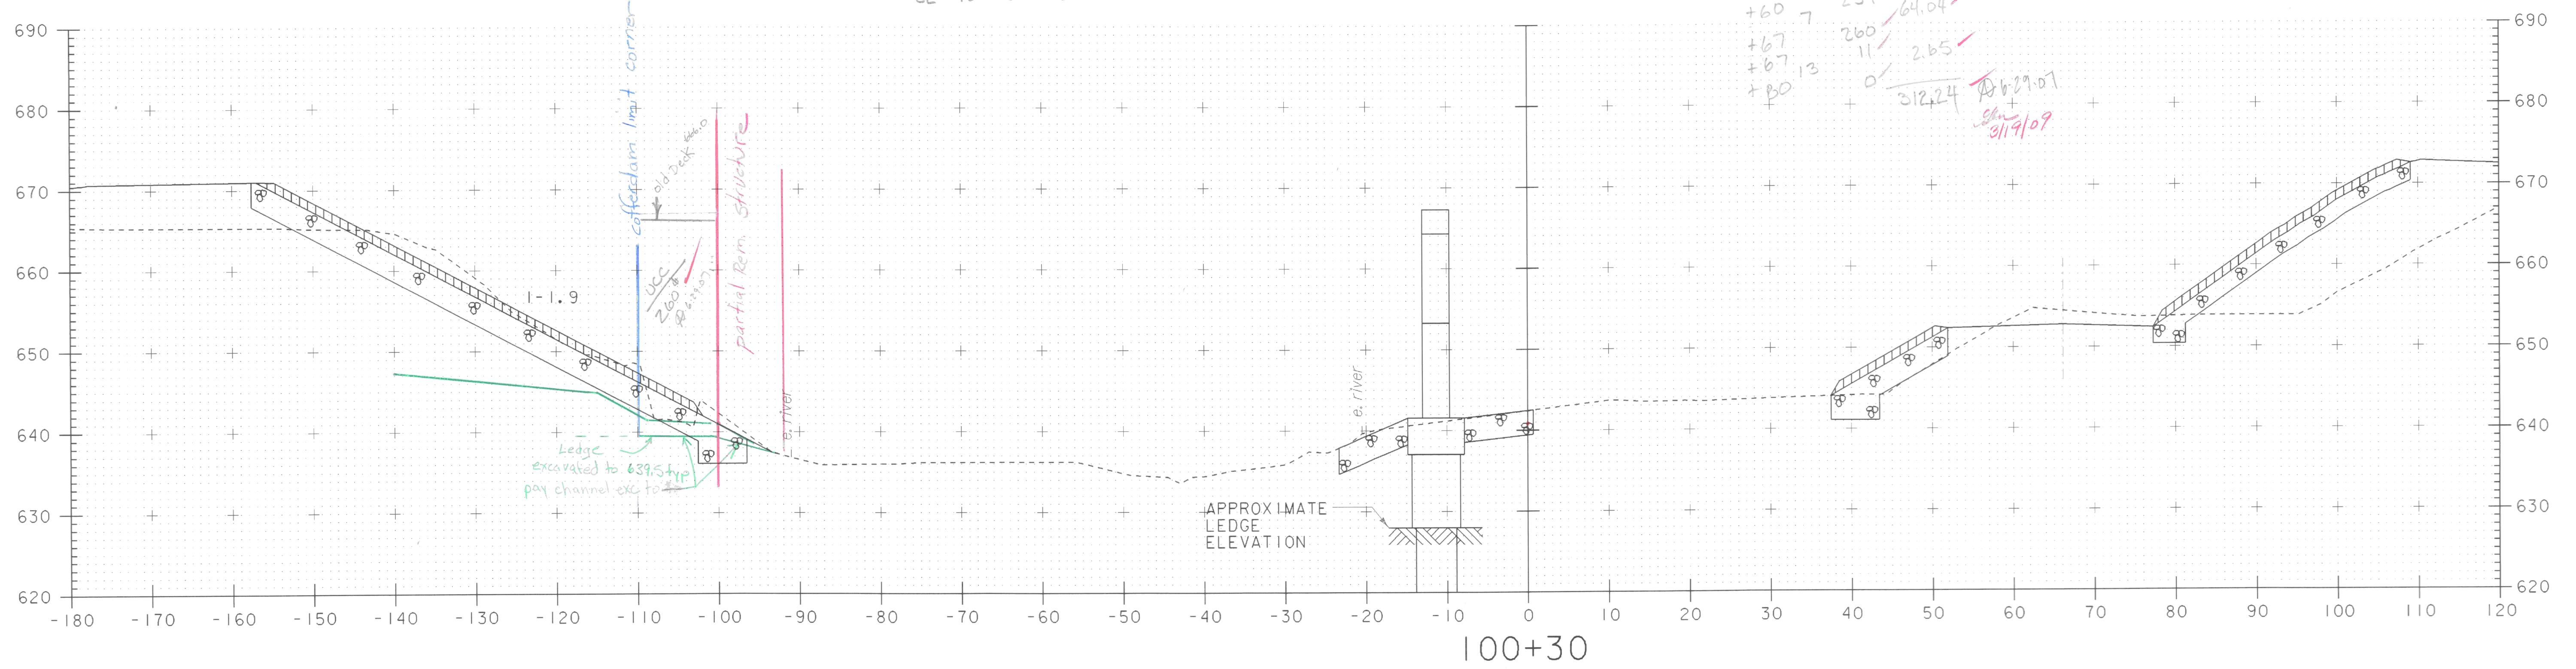

CHANNEL SECTIONS STA 100+20 - STA 100+30

PROJECT NAME: RANDOLPH
 PROJECT NUMBER: BRF 0241 (29)

FILE NAME: /str5/88j096/sj096chx.dgn PLOT DATE: 29-AUG-2006
 PROJECT LEADER: W. SYMONDS DRAWN BY: G. SHANGRAW
 DESIGNED BY: W.B. SYMONDS CHECKED BY: T. SUMNER
 sj096cs4.i SHEET 119 OF 135

