

Prince Street Geotextile fabric

202+75	27	84.72
203+00	34	166.87
+50	26	68.06
+75	23	62.50
204+00	22	54.17
+25	17	





Prince Street Stone Fill TYPE III

202+75	25	63	70.37
203+00	50	89	146.30
+50	25	69	58.80
+75	25	58	45.83
204+00	25	41	35.65
+25	36		
Total			356.95 CY @ 3.24.09

Prince Street Undersized Channel Exc.

202+75 But	22	31.94
203+00	50	75.00
+50	25	24.07
+75	18	16.67
204+00	25	17.59
+25 But	20	
Total		165.27 @ 3.17.09

Common Exc	4	45.6
10.5	48.9	
13	49.3	
28	49.7	
38	49.5	
33	48.9	
23	48.3	
23	47.3	
19	46.7	
155	47.1	
15	46.4	
4	46.6	

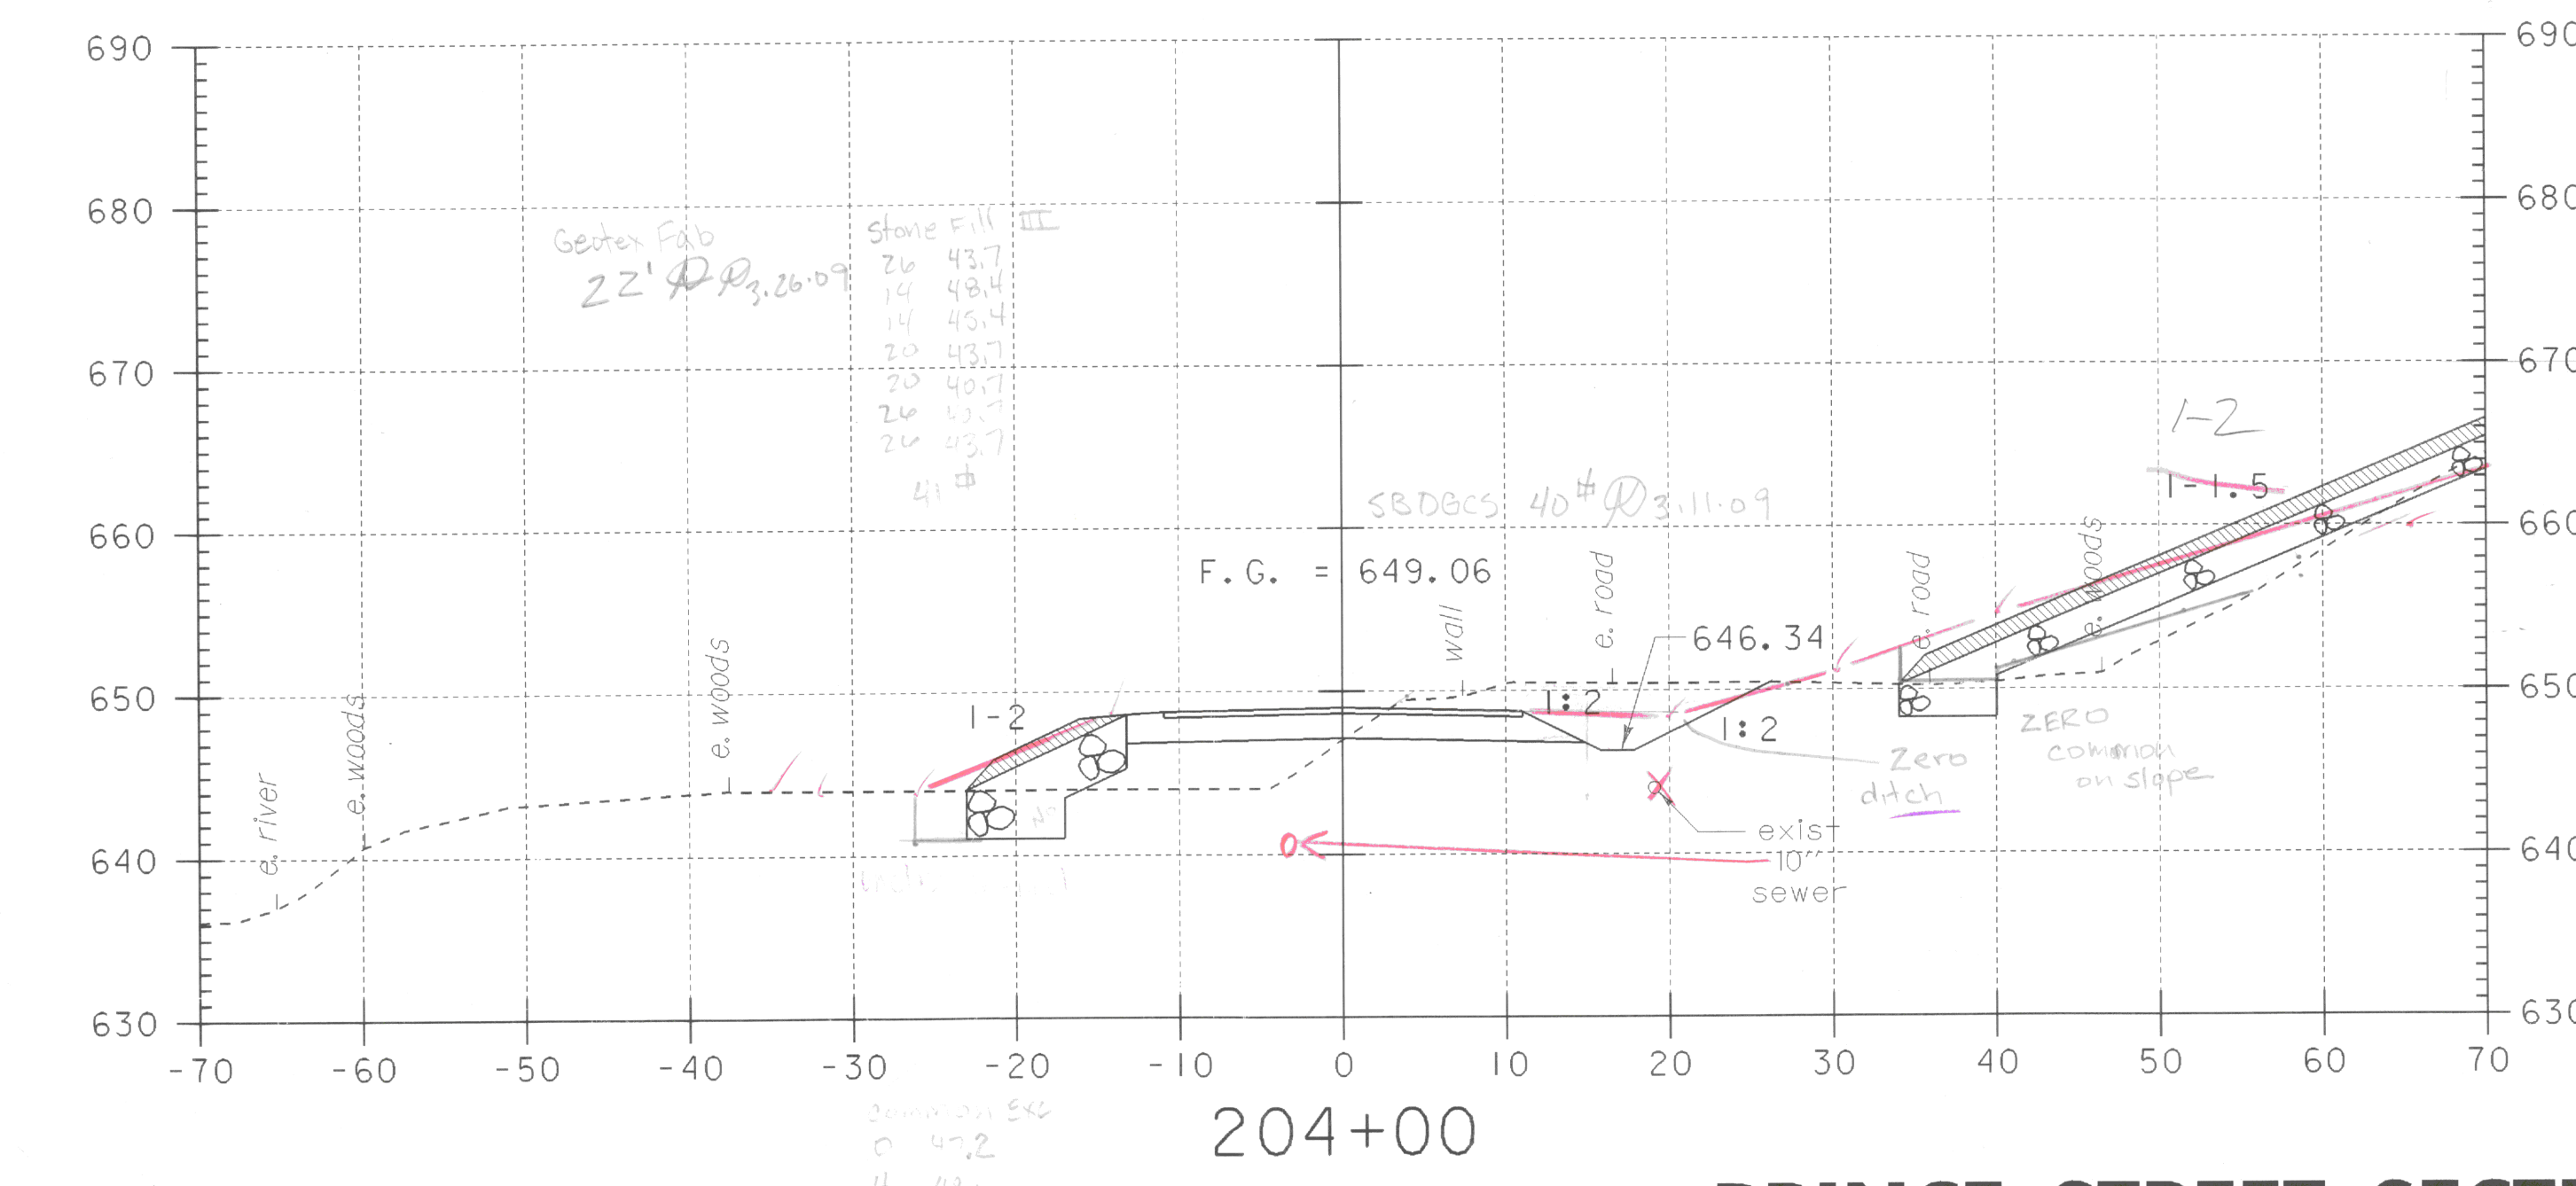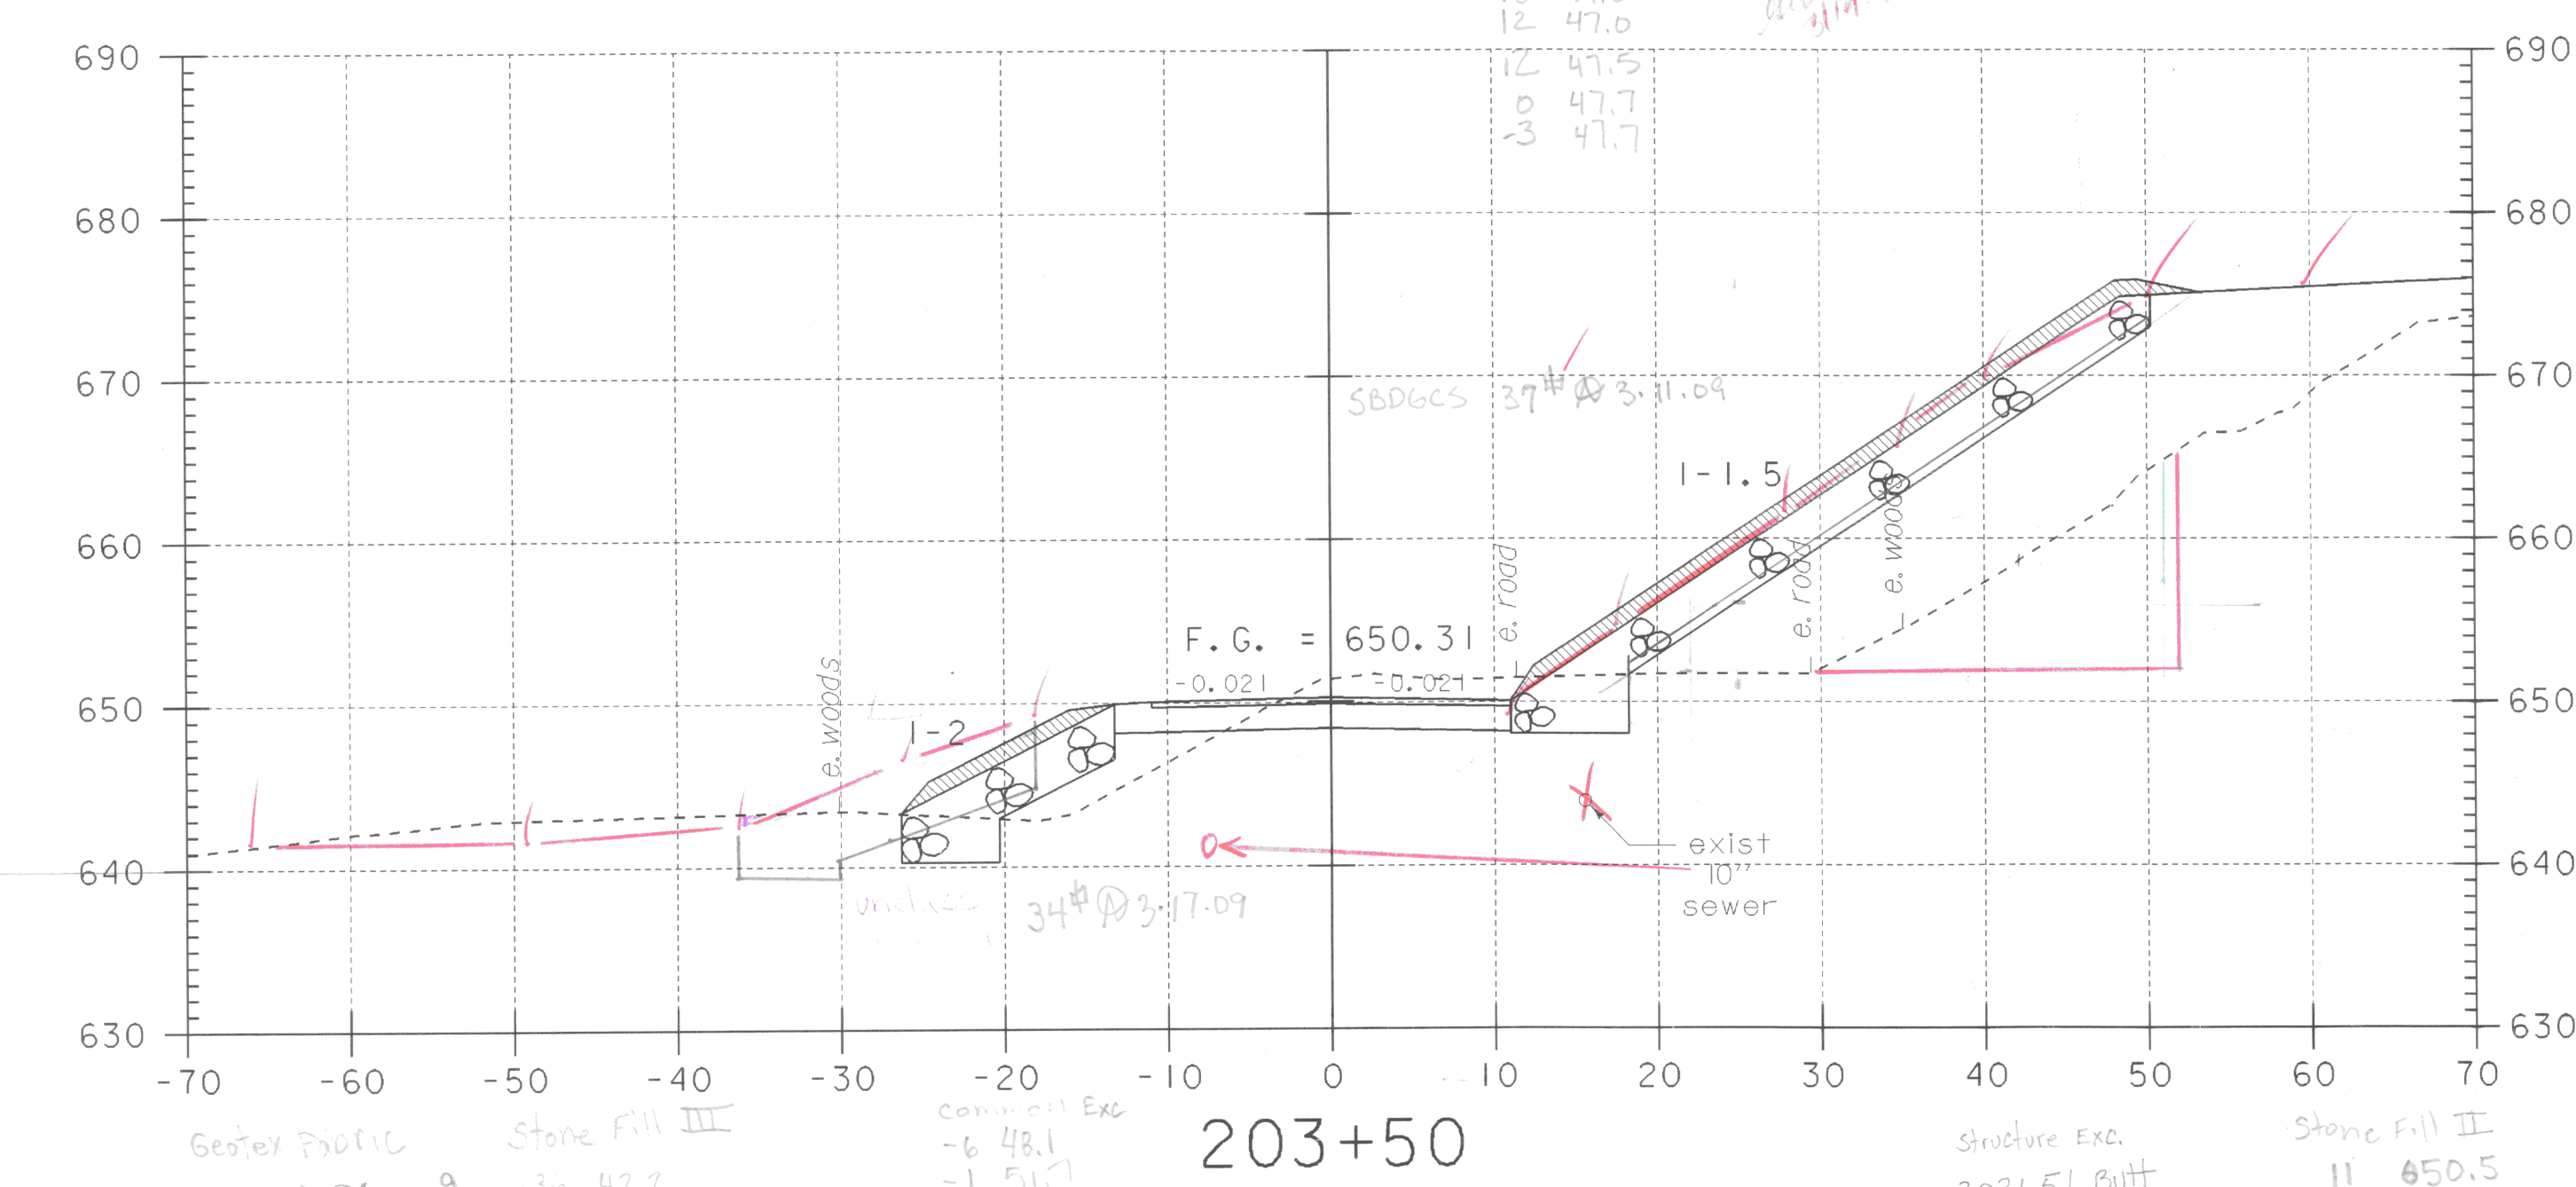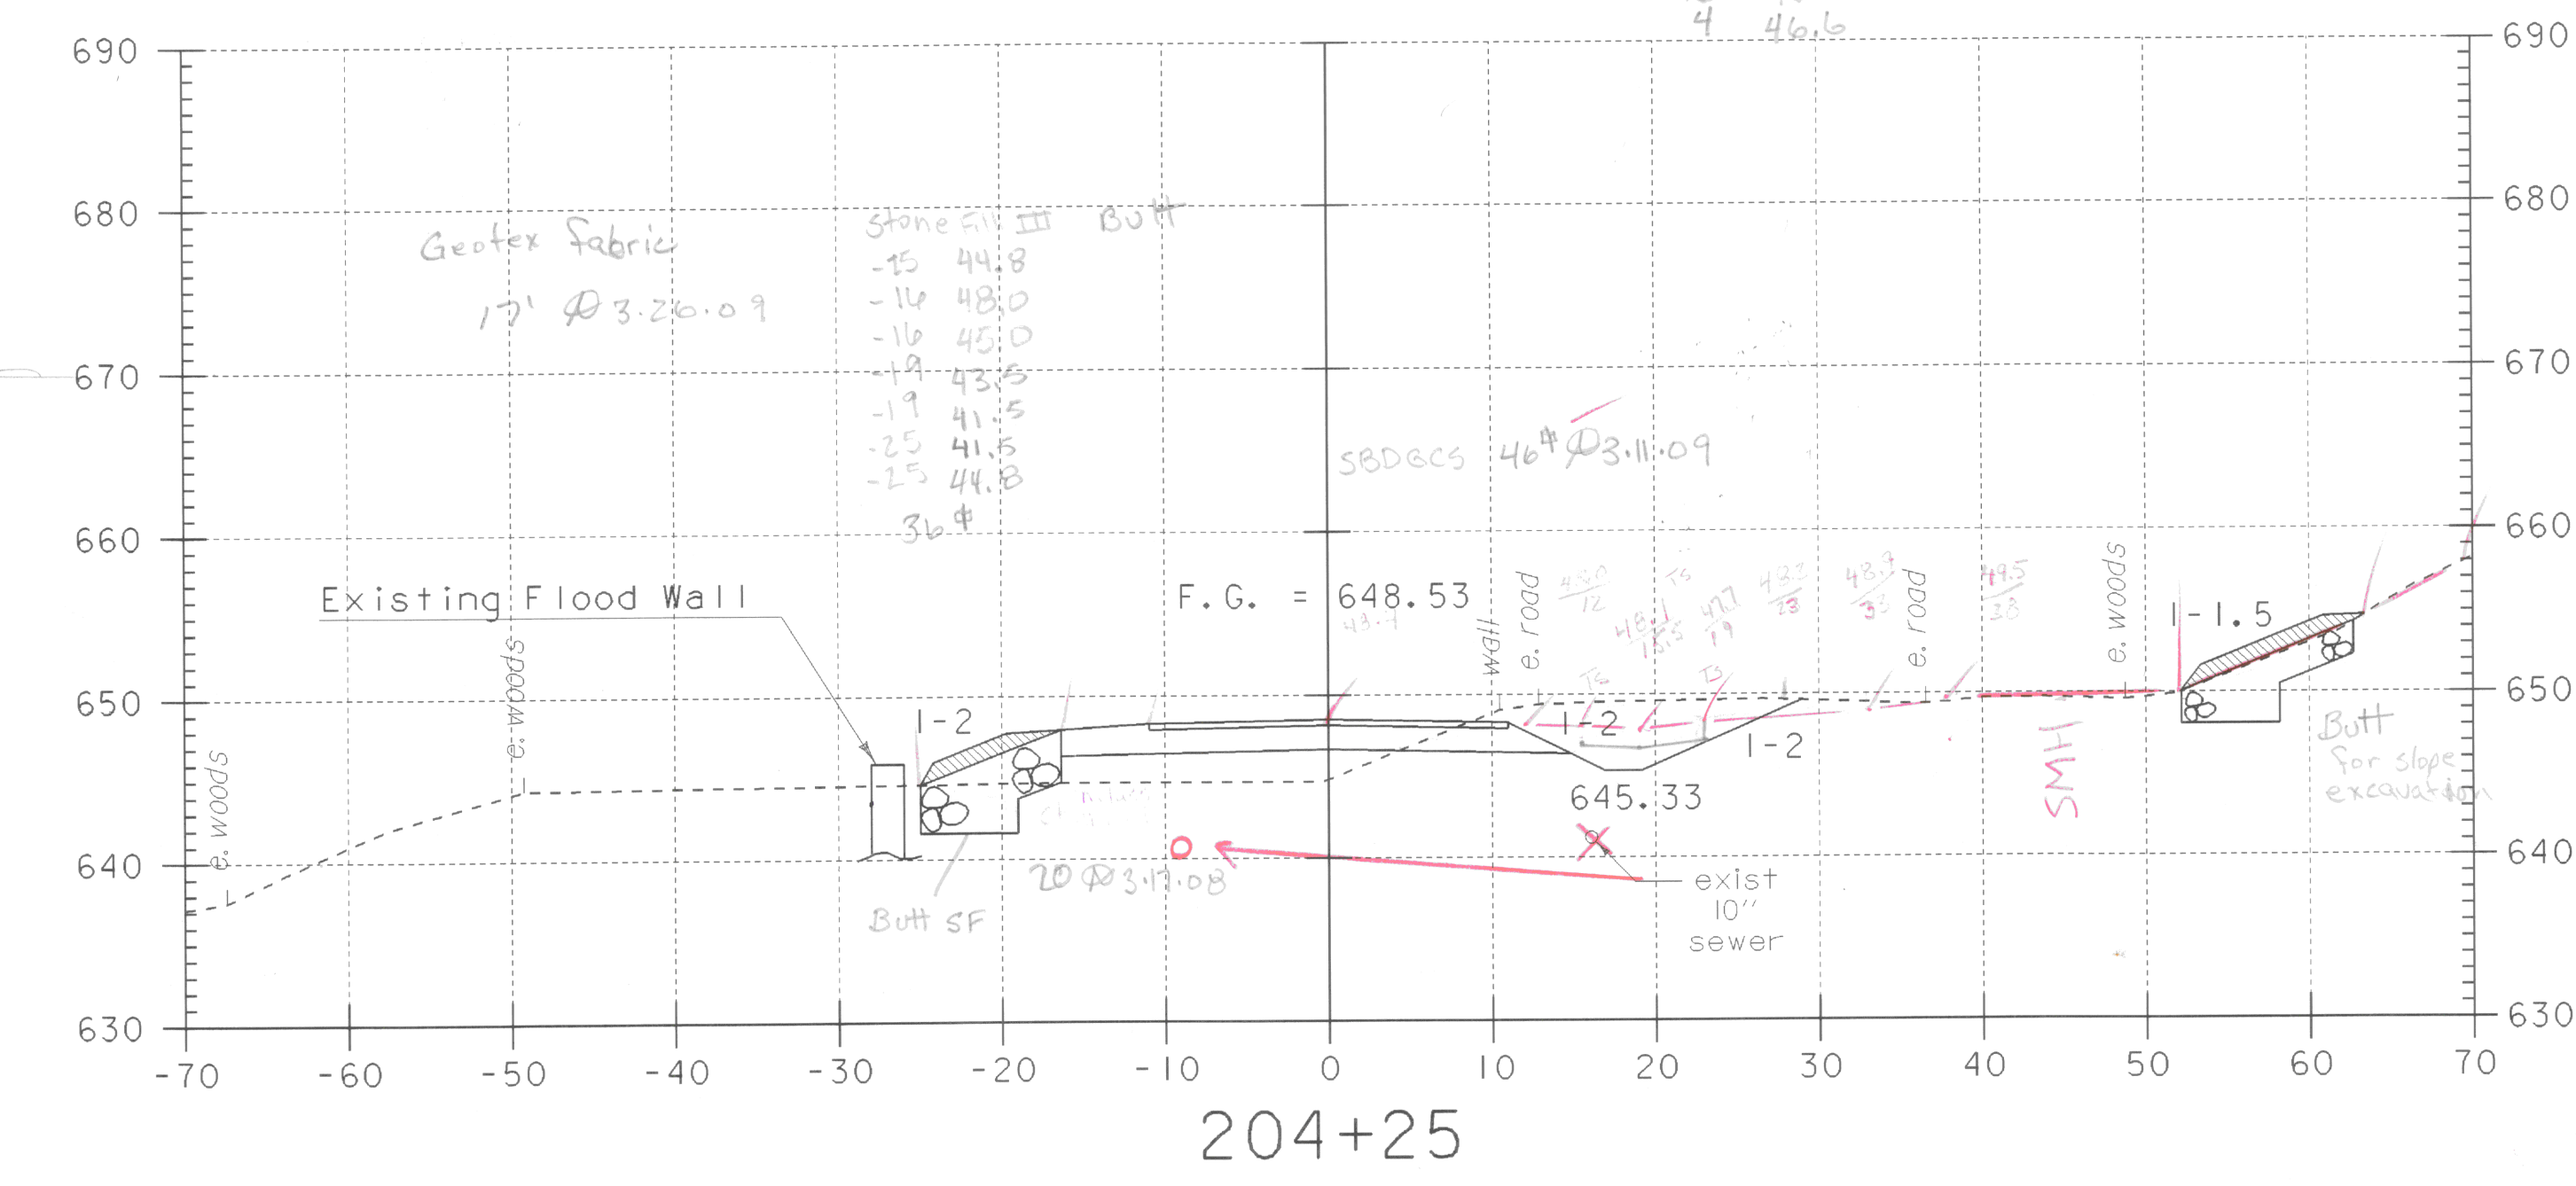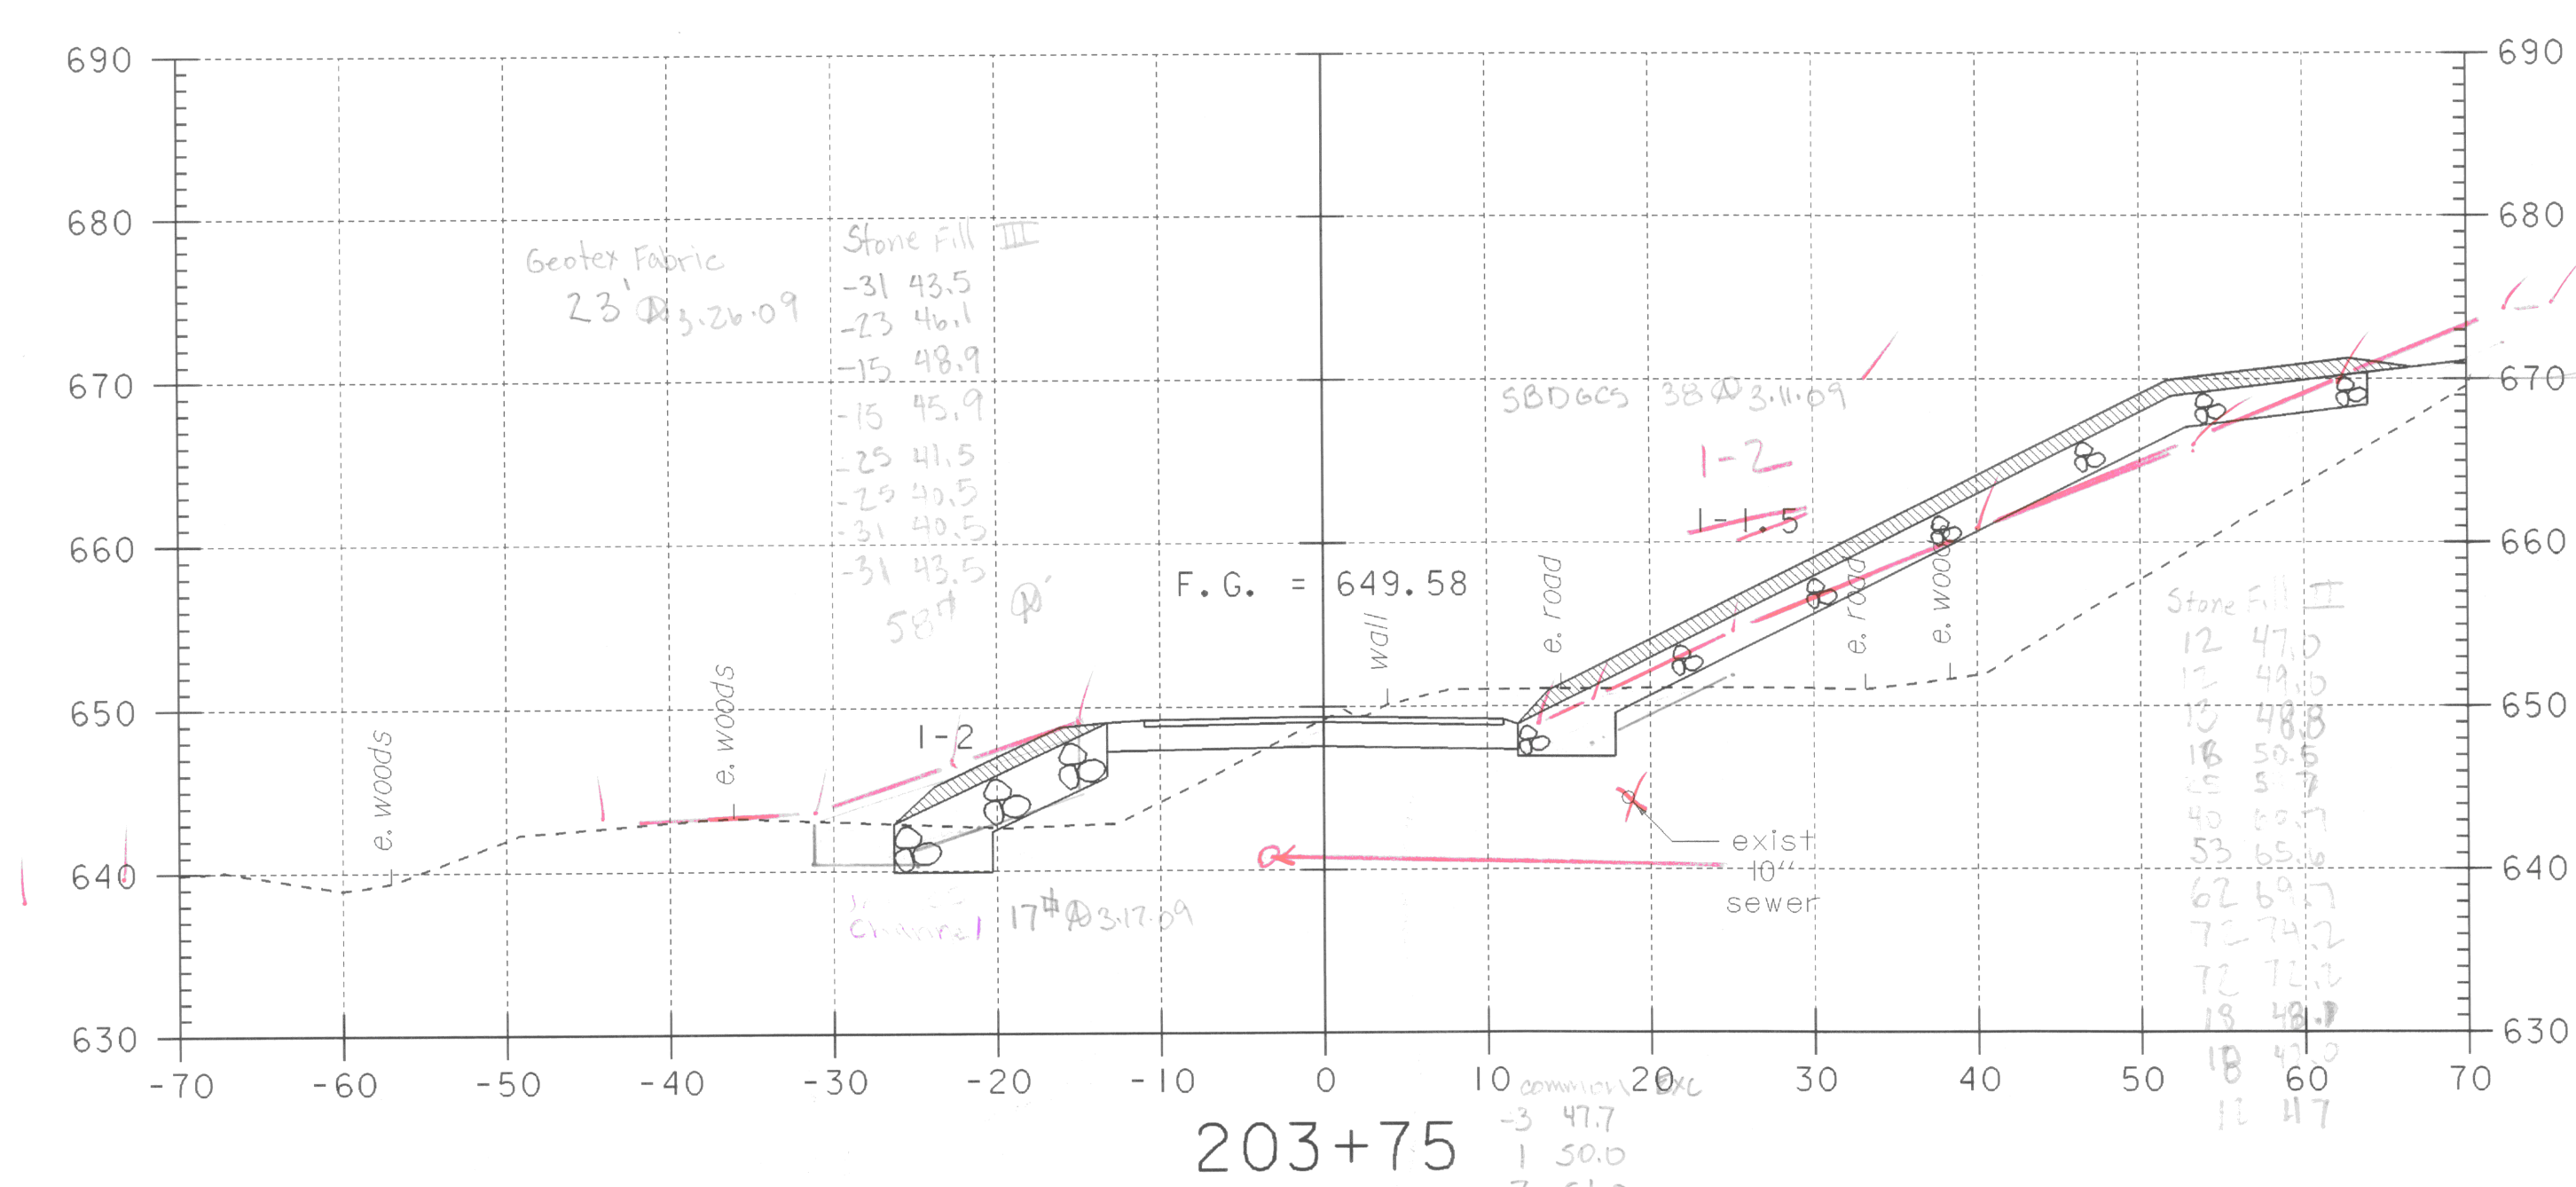

Geotextile fabric	26'	3.26.09
Stone Fill III	-30	42.2
	-26	40.7
	-13	47.3
	-13	46.3
	-30	40.3
	-30	39.2
	-36	39.2
	-36	42.2
	69'	

Common Exc	-6	48.1
	-1	51.7
	18	51.9
	18	48.1
	0	48.5
	-6	48.1
	75'	10.13.08

Structure Exc	203+51 But	11	650.5
	30.0	62.0	
	35'	65.5	
	42'	65.5	
	48'	62.0	
	51	66.1	
	51	65.0	
	30	652.0	
	133'		
	11	48.1	
	11	50.5	
	48'	10.13.08	

Common Exc	0	47.2
	4	47.6
	7	49.7
	12	52.5
	21	50.4
	20	48.5
	15	48.5
	15	46.9
	0	47.2

**PRINCE STREET SECTIONS  
STA. 203+50 - STA. 204+25**

PROJECT NAME: RANDOLPH  
 PROJECT NUMBER: BRF 0241 (29)  
 FILE NAME: /s/tr5/88j096/sj096prx.dgn PLOT DATE: 29-AUG-2006  
 PROJECT LEADER: W. SYMONDS DRAWN BY: G. SHANGRAW  
 DESIGNED BY: W.B. SYMONDS CHECKED BY: T. SUMNER  
 sj096p5.i SHEET 129 OF 135