
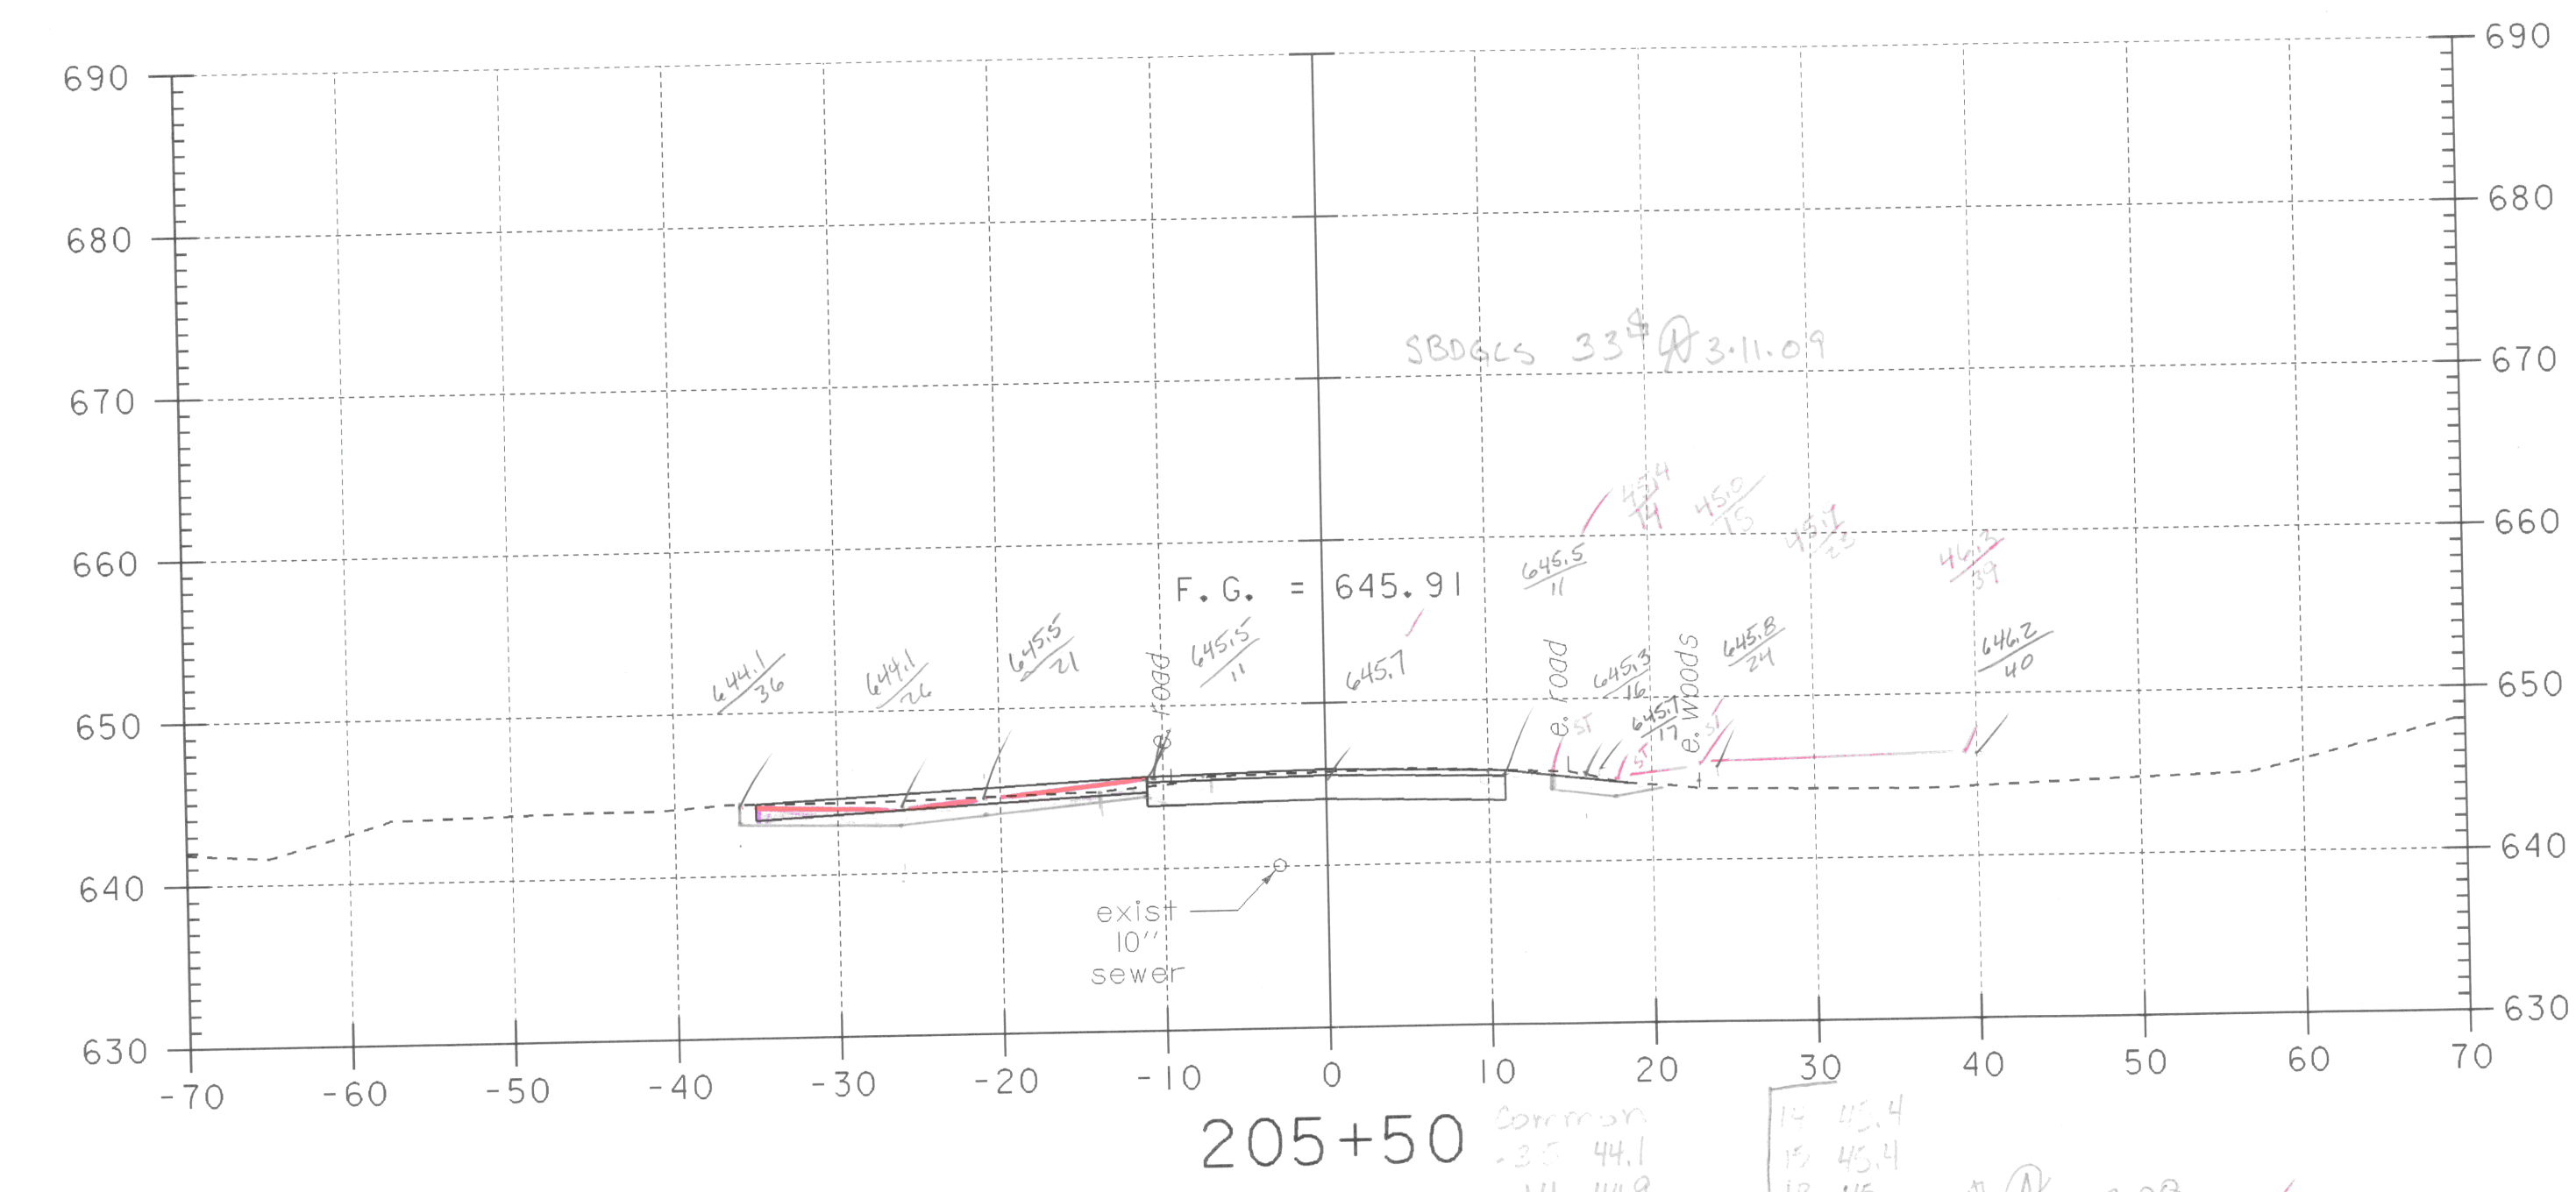
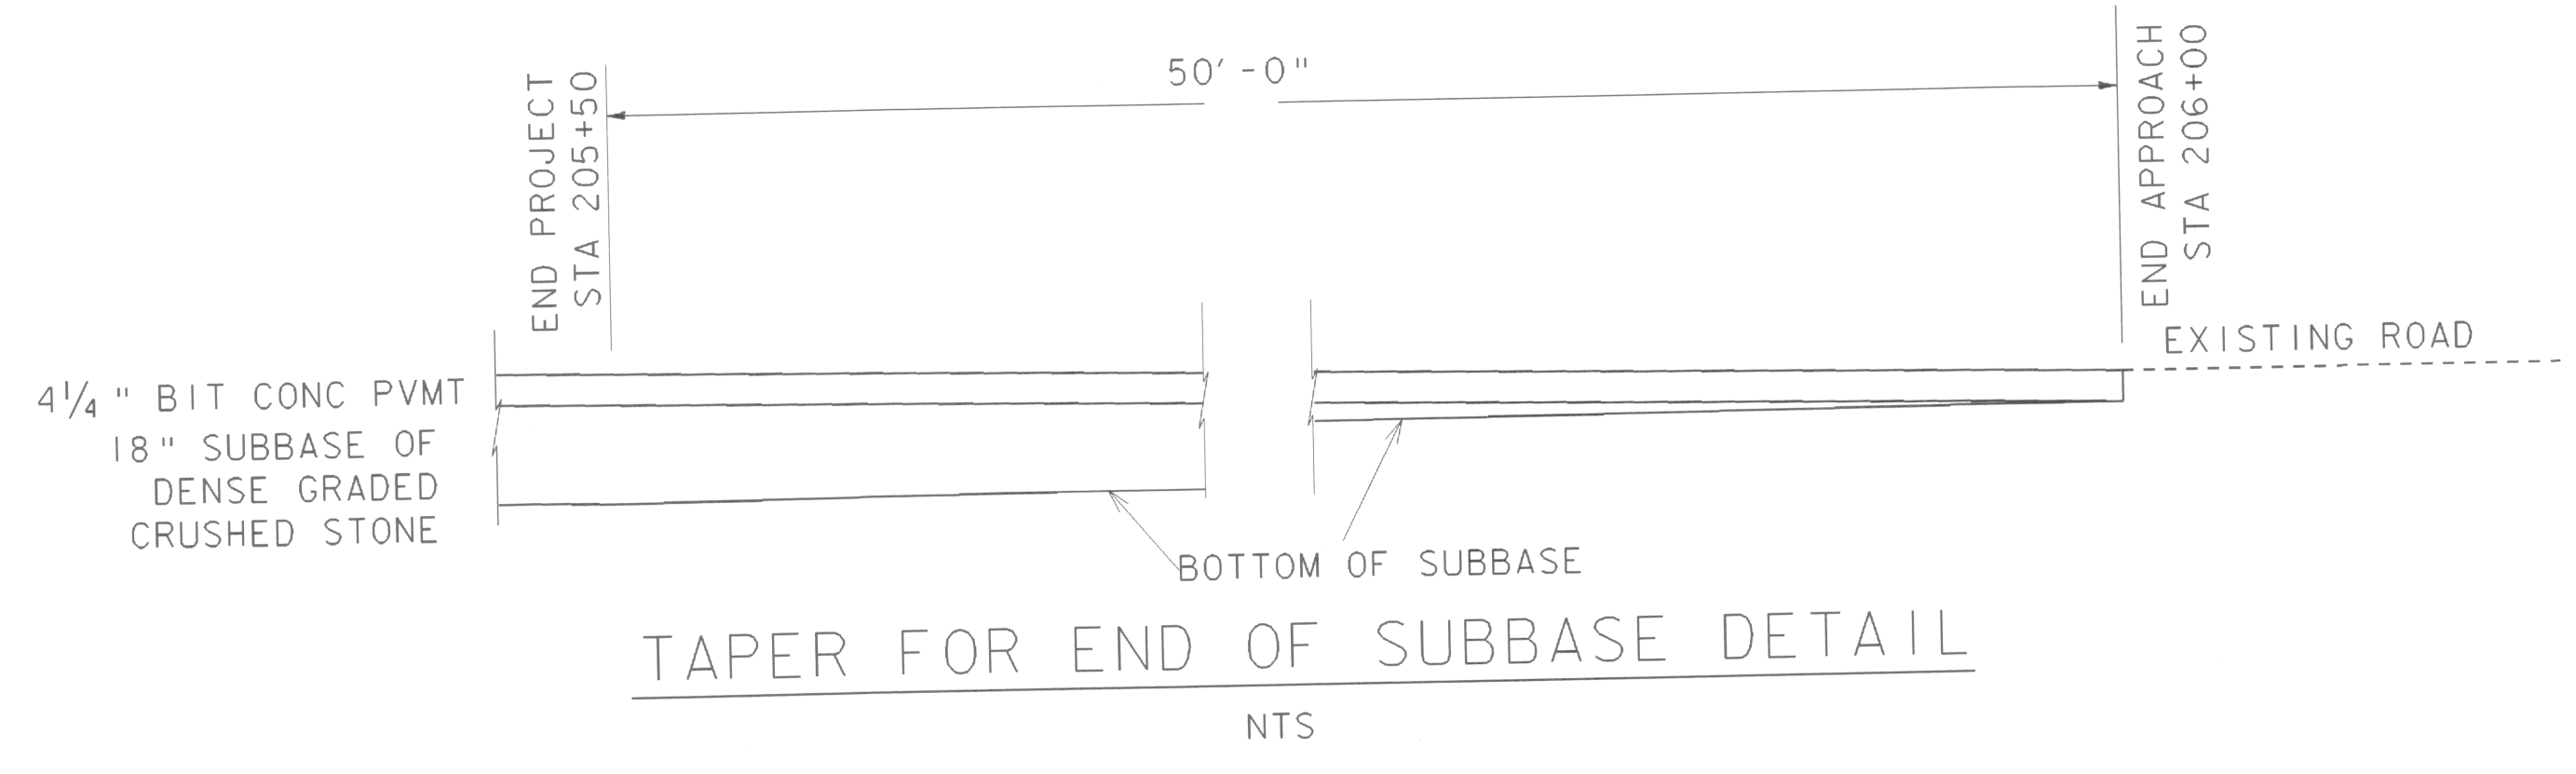


205+75

COMMON EYE	
-11	44.8
0	45.2
11	45.0
11	43.8
0	44.2
-11	43.8

20' ϕ 10-13-08
3/11/09


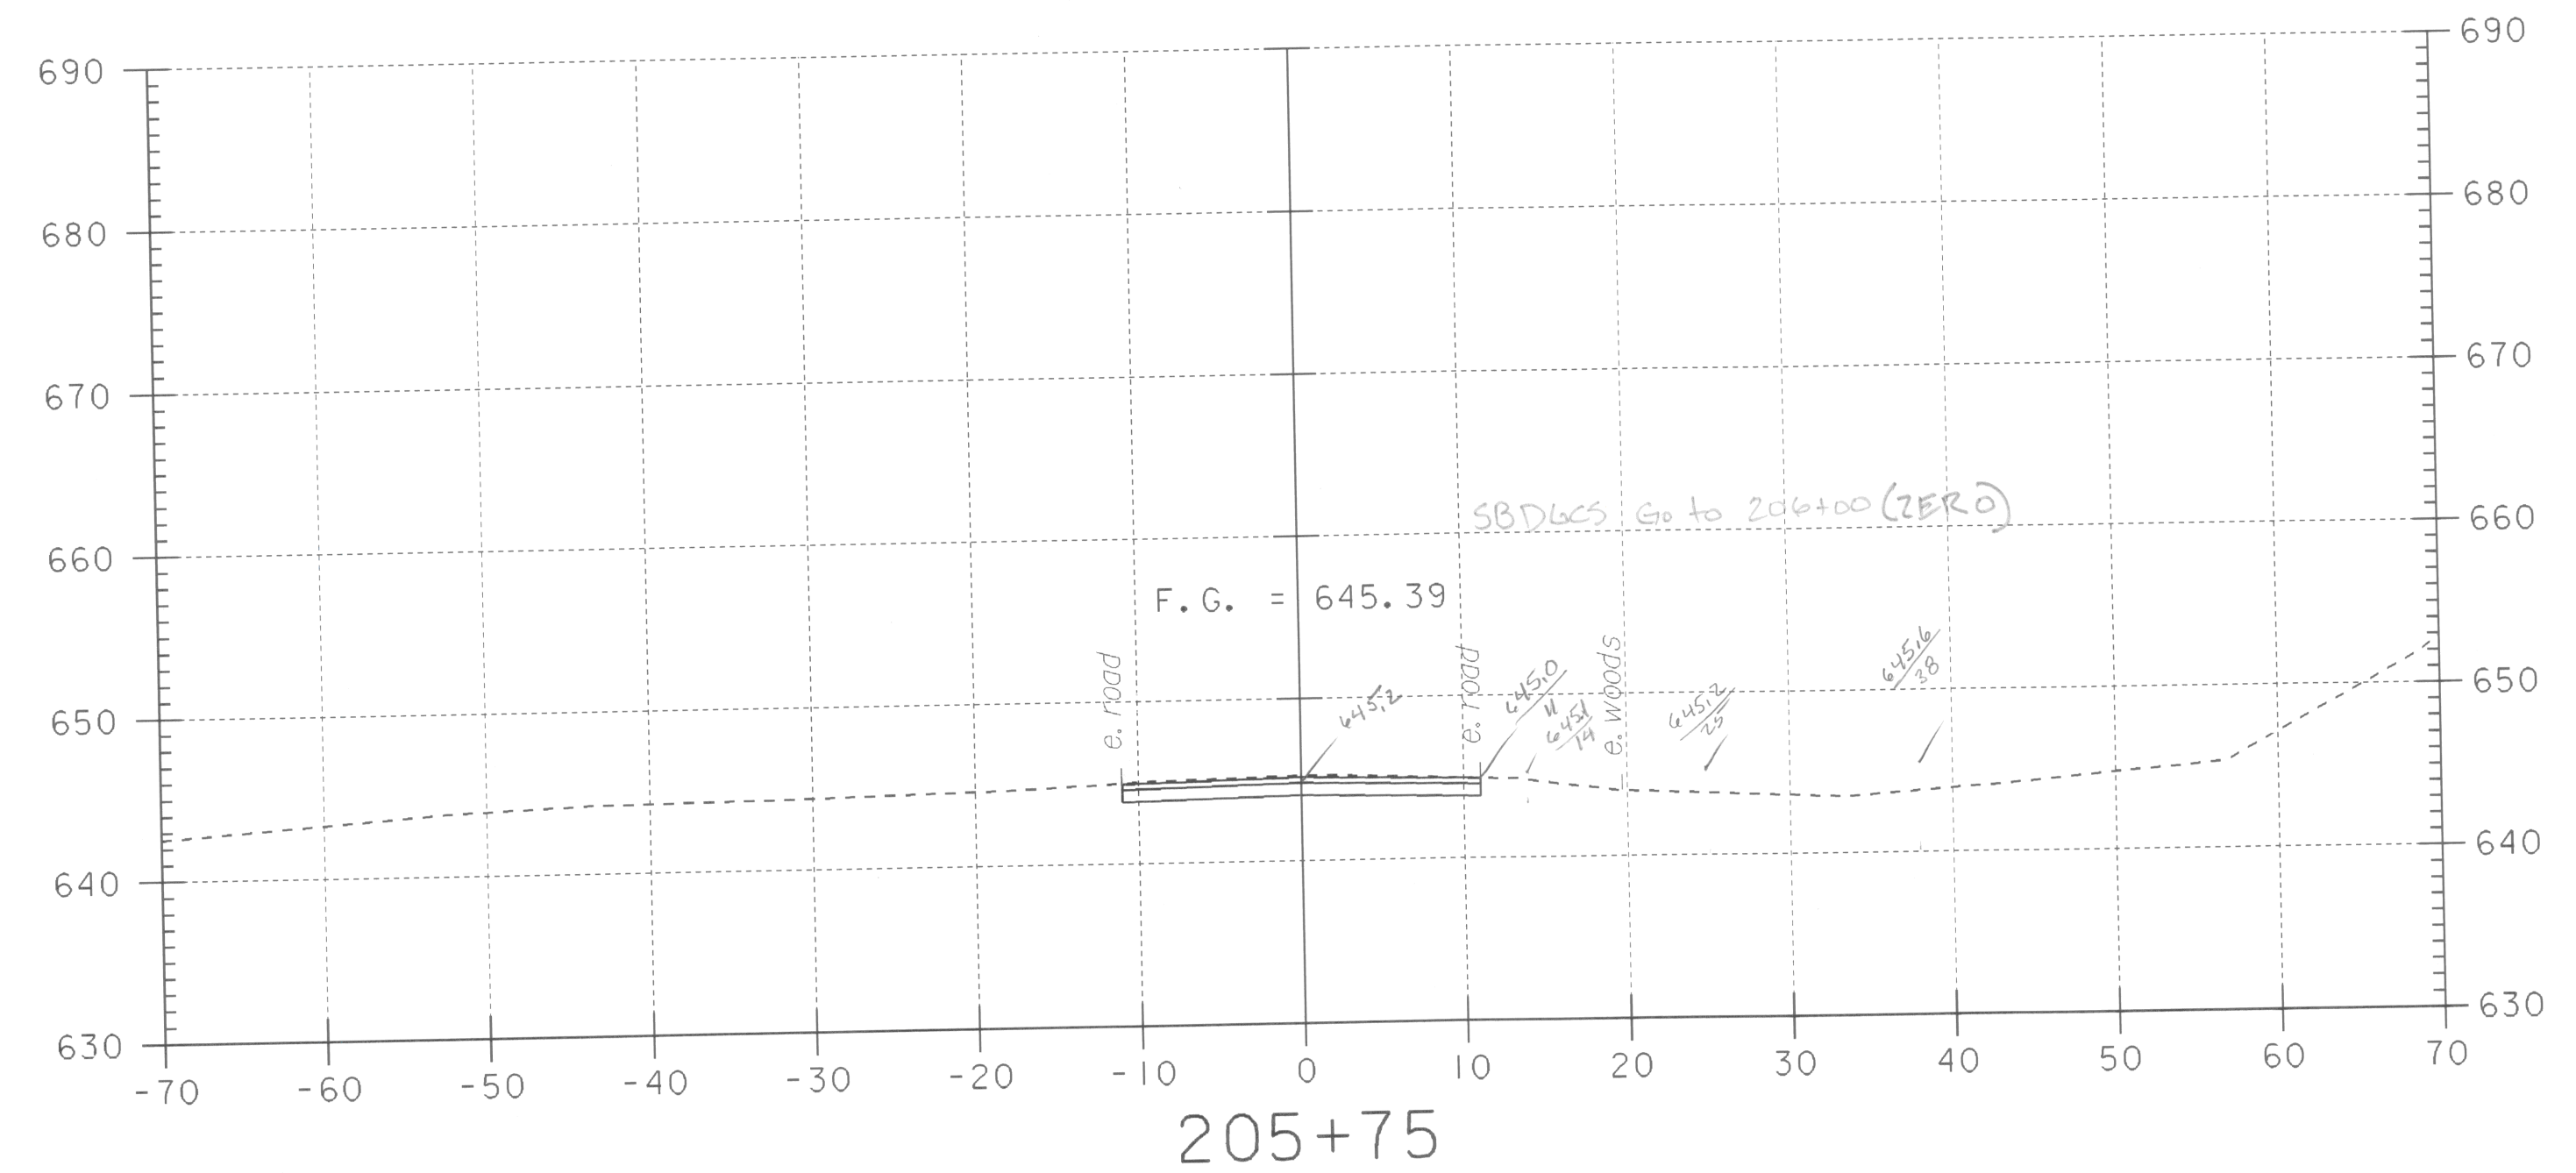


Common

-3	44.1
-14	44.9
-7	45.8
0	45.3
11	45.6
11	43.8
0	44.0
-11	43.8
-11	44.7
-21	44.5
-20	45.1
-35	43.1
-35	44.1

11 45.4
15 45.4
18 45.0
21 44.8
13 44.0
14 44.4
14 45.4

pay 63' for 205+50 & 205+66
Butt 63' for 205+66 back 57' ahead ϕ 10-13-08
3/11/09

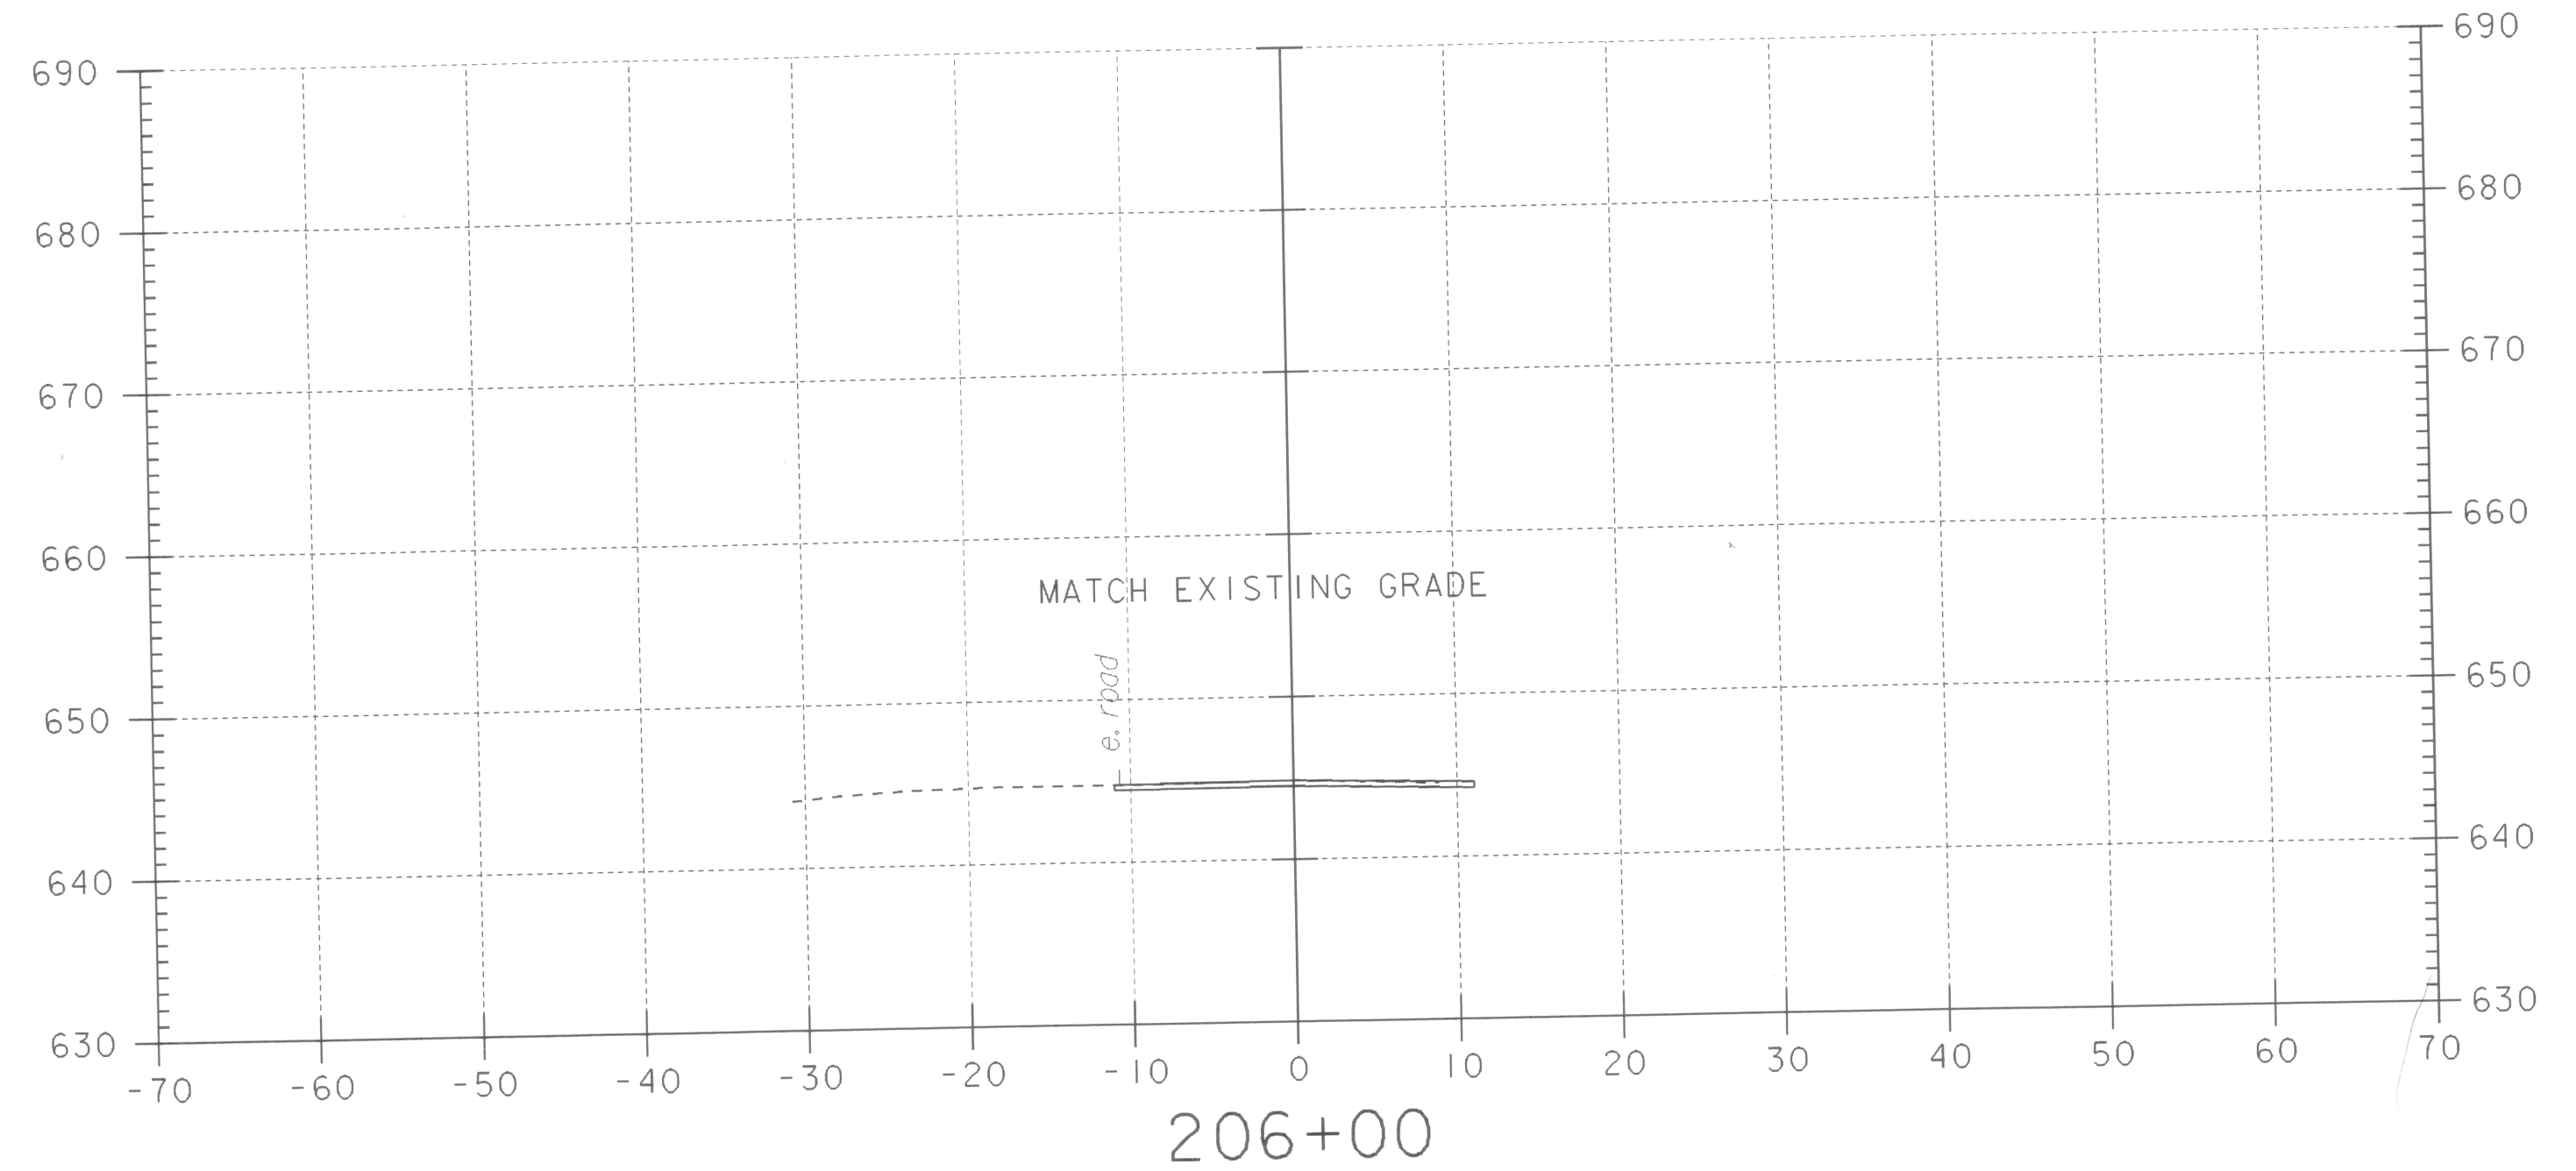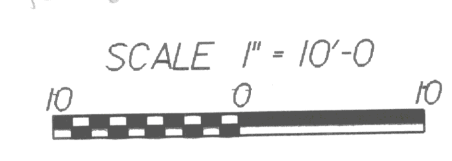

PRINCE STREET SECTIONS STA. 205+50 - STA. 206+00

PROJECT NAME:	RANDOLPH	FILE NAME:	/s+r5/88j096/sj096prx.dgn	PLOT DATE:	29-AUG-2006
PROJECT NUMBER:	BRF 0241 (29)	PROJECT LEADER:	W. SYMONDS	DRAWN BY:	G. SHANGRAW
		DESIGNED BY:	W. B. SYMONDS	CHECKED BY:	T. SUMNER
			sj096p7.i	SHEET	131 OF 135

STA 206+00
END APPROACH