

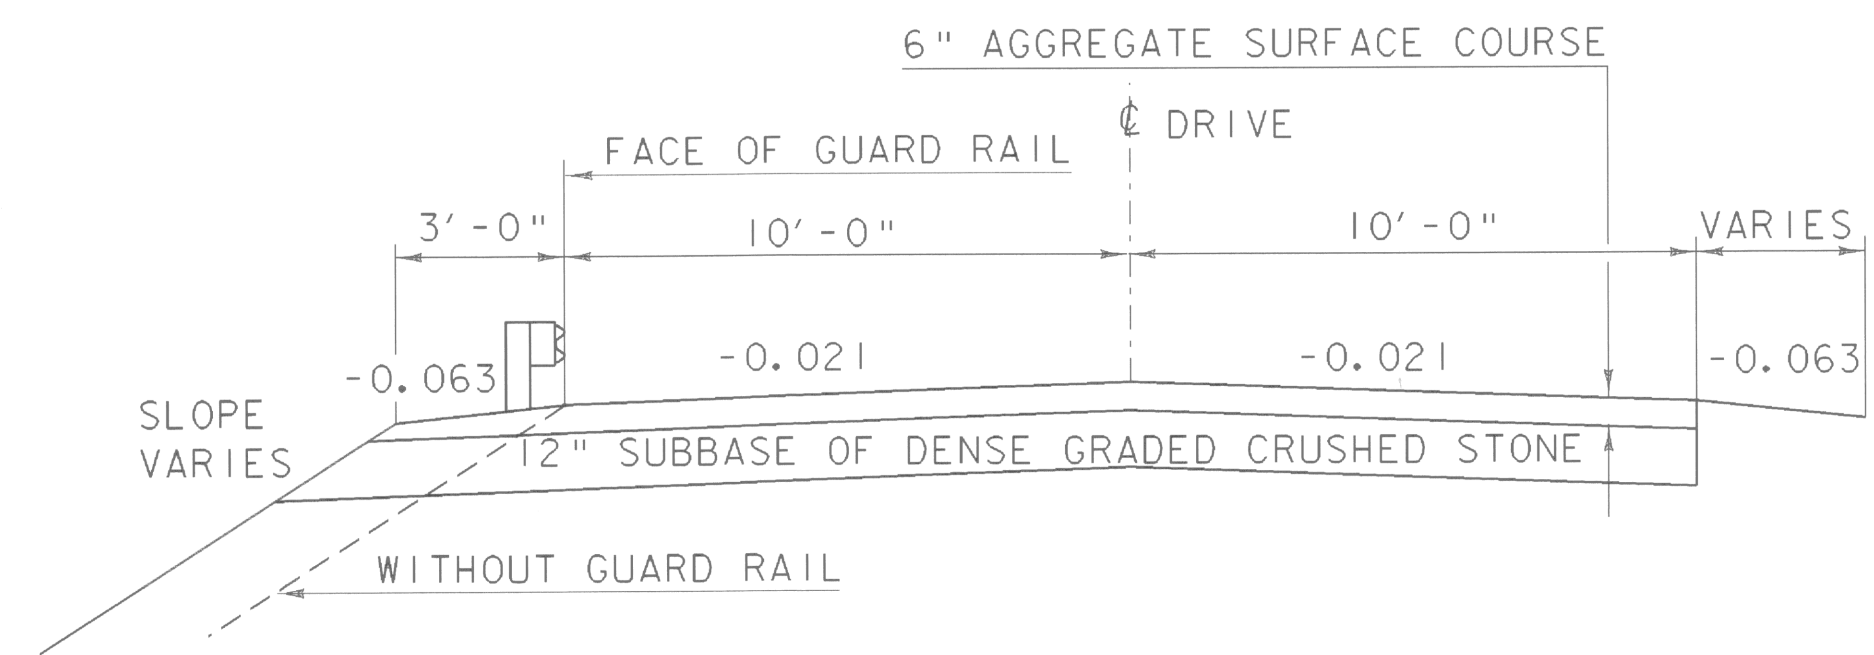
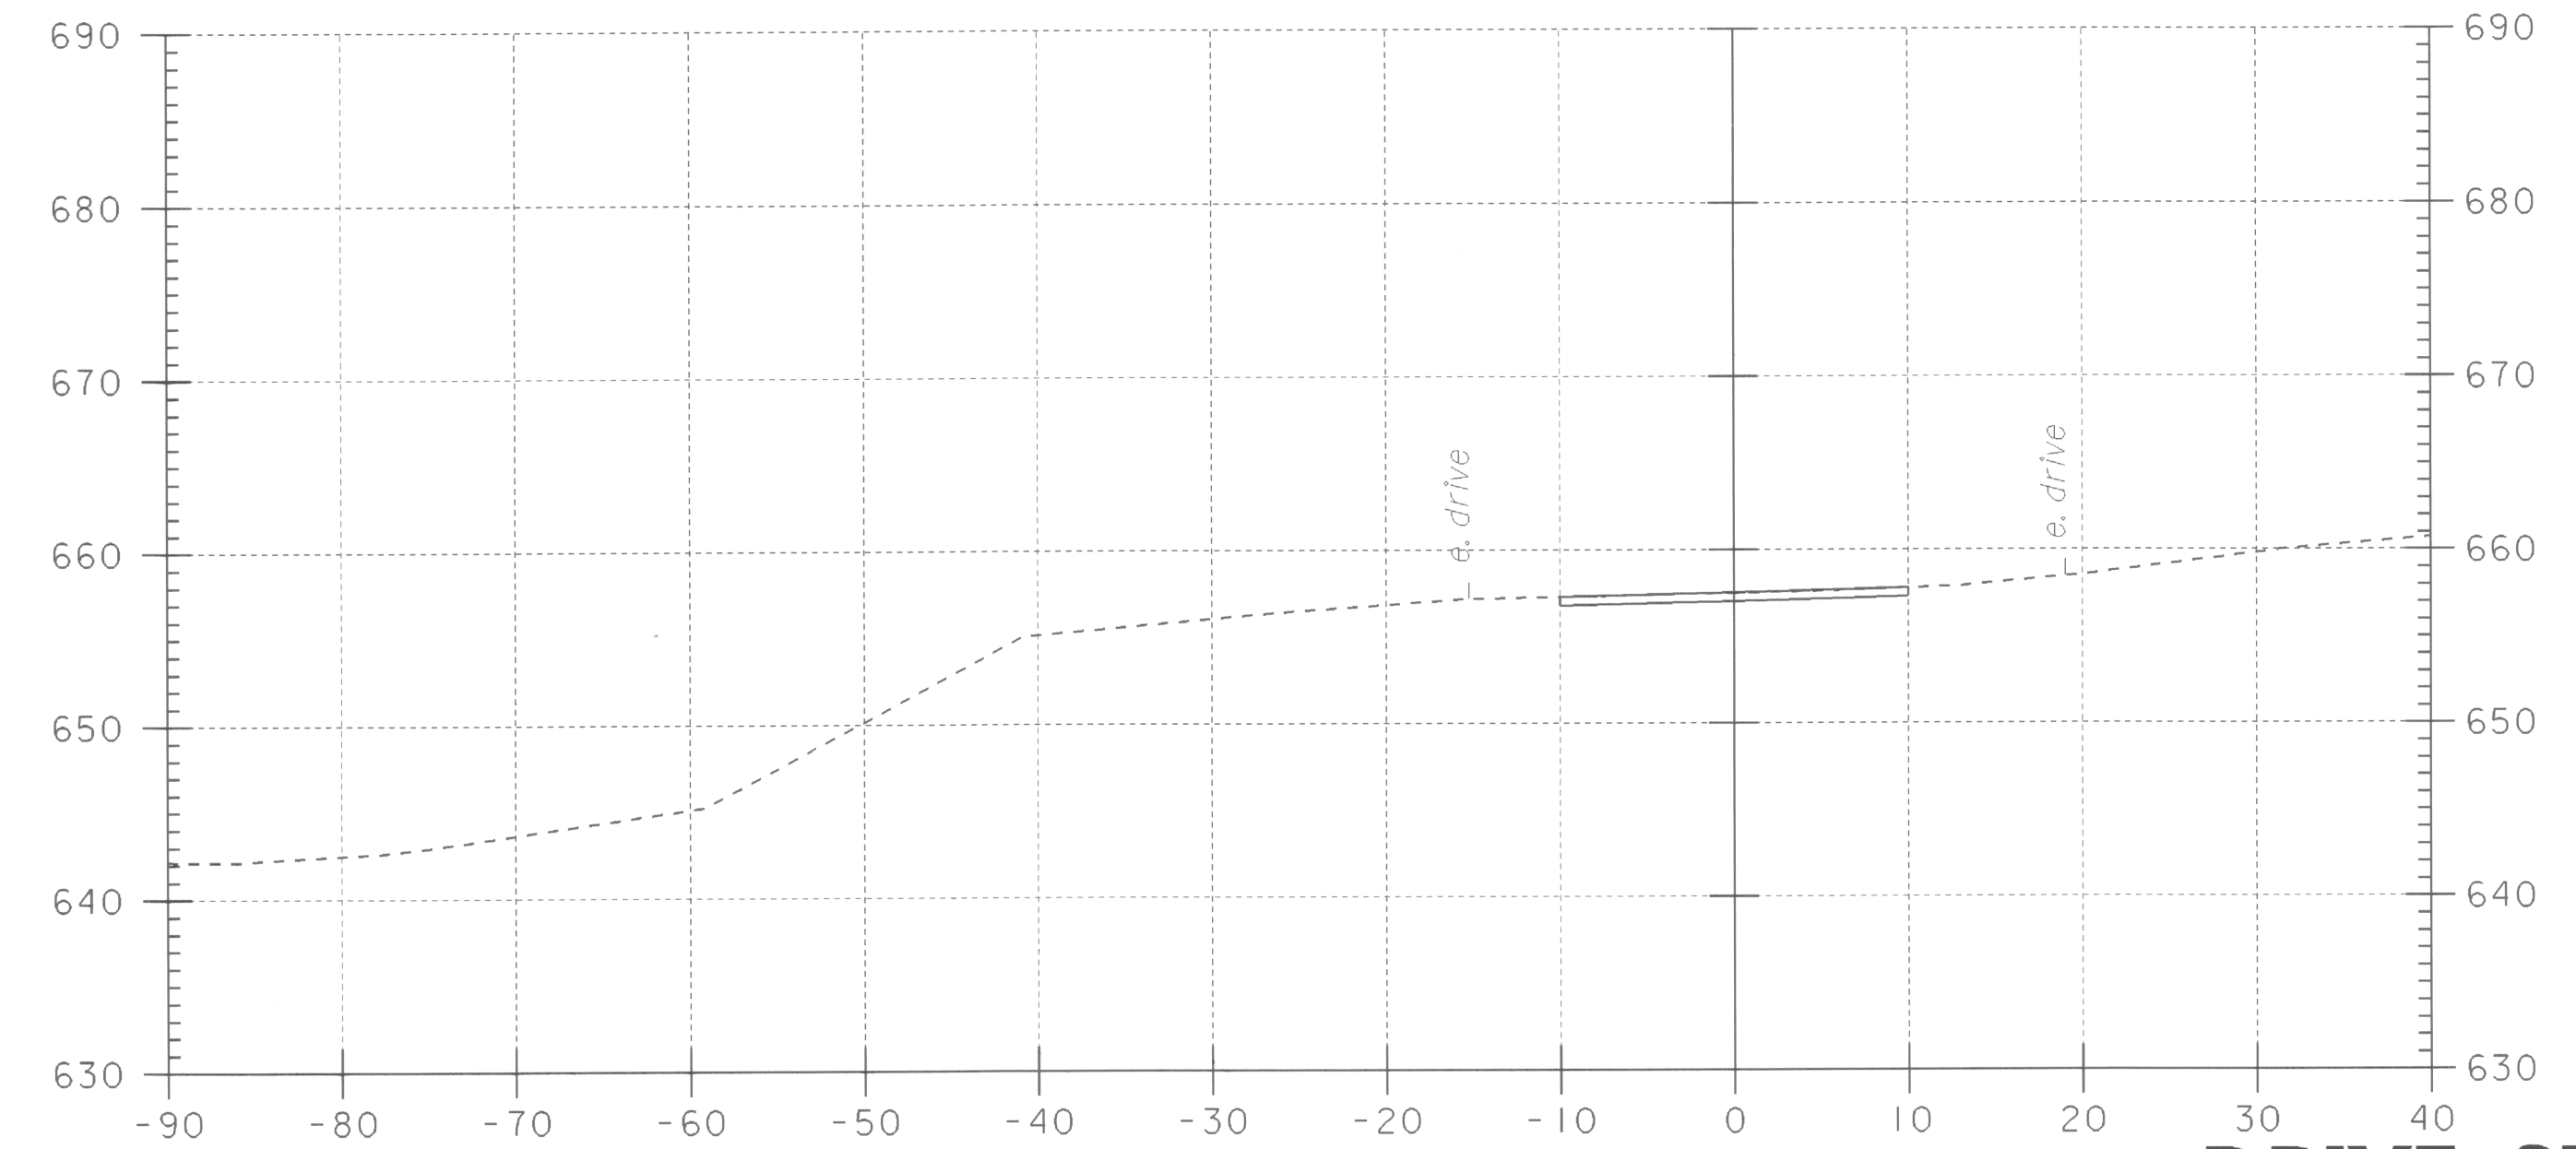
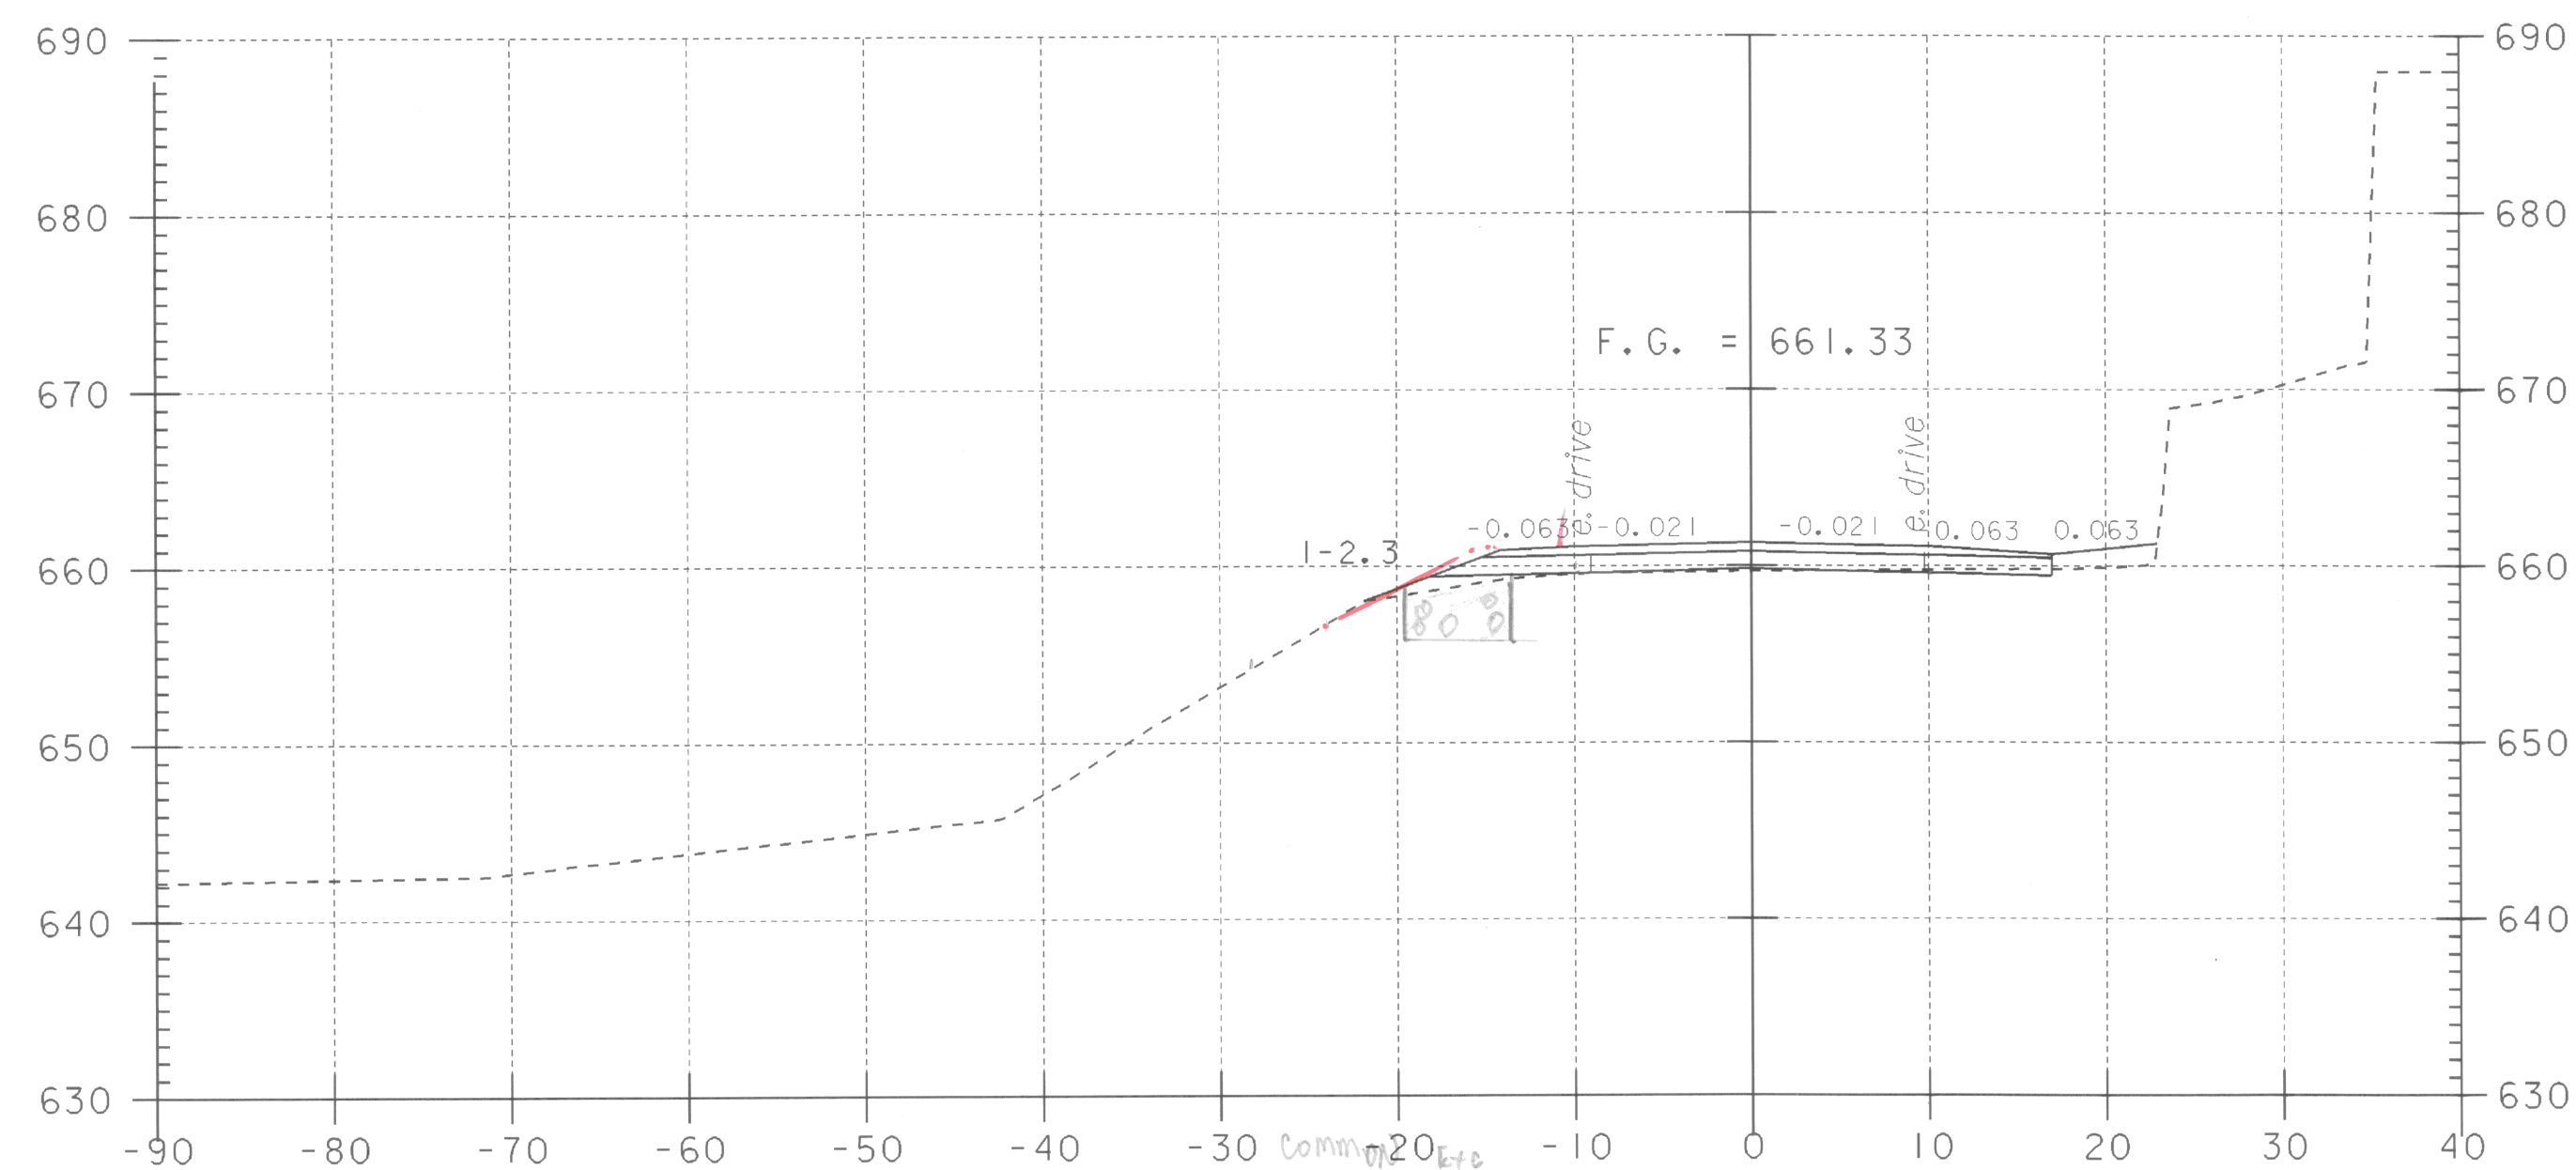


SUBBASE TAPER AT END OF DRIVE

nts

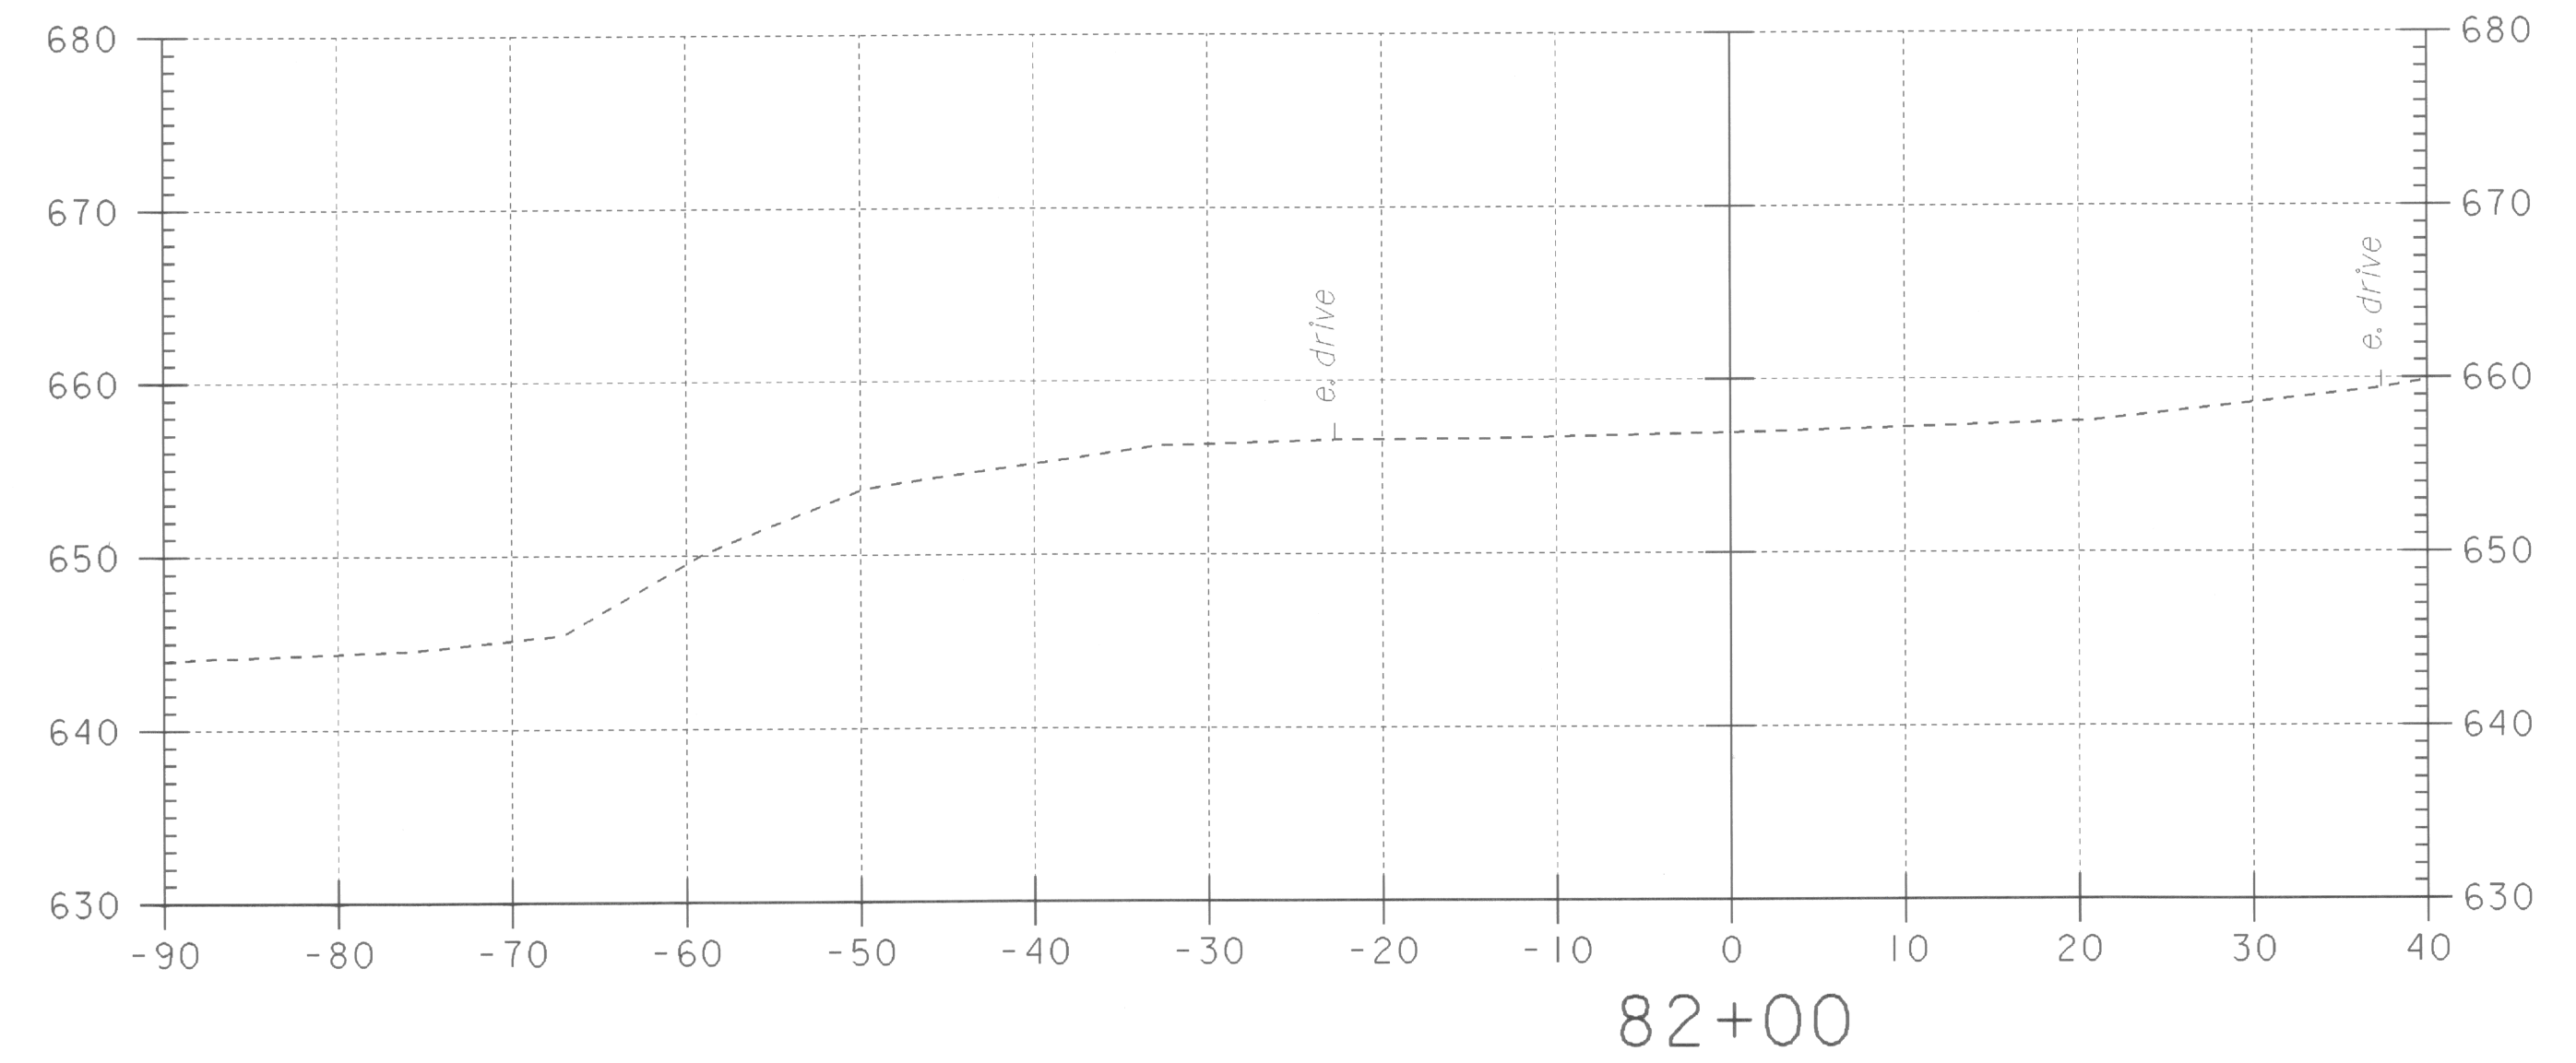

TYPICAL SECTION DRIVE
LT OF VT12 STA 17+90

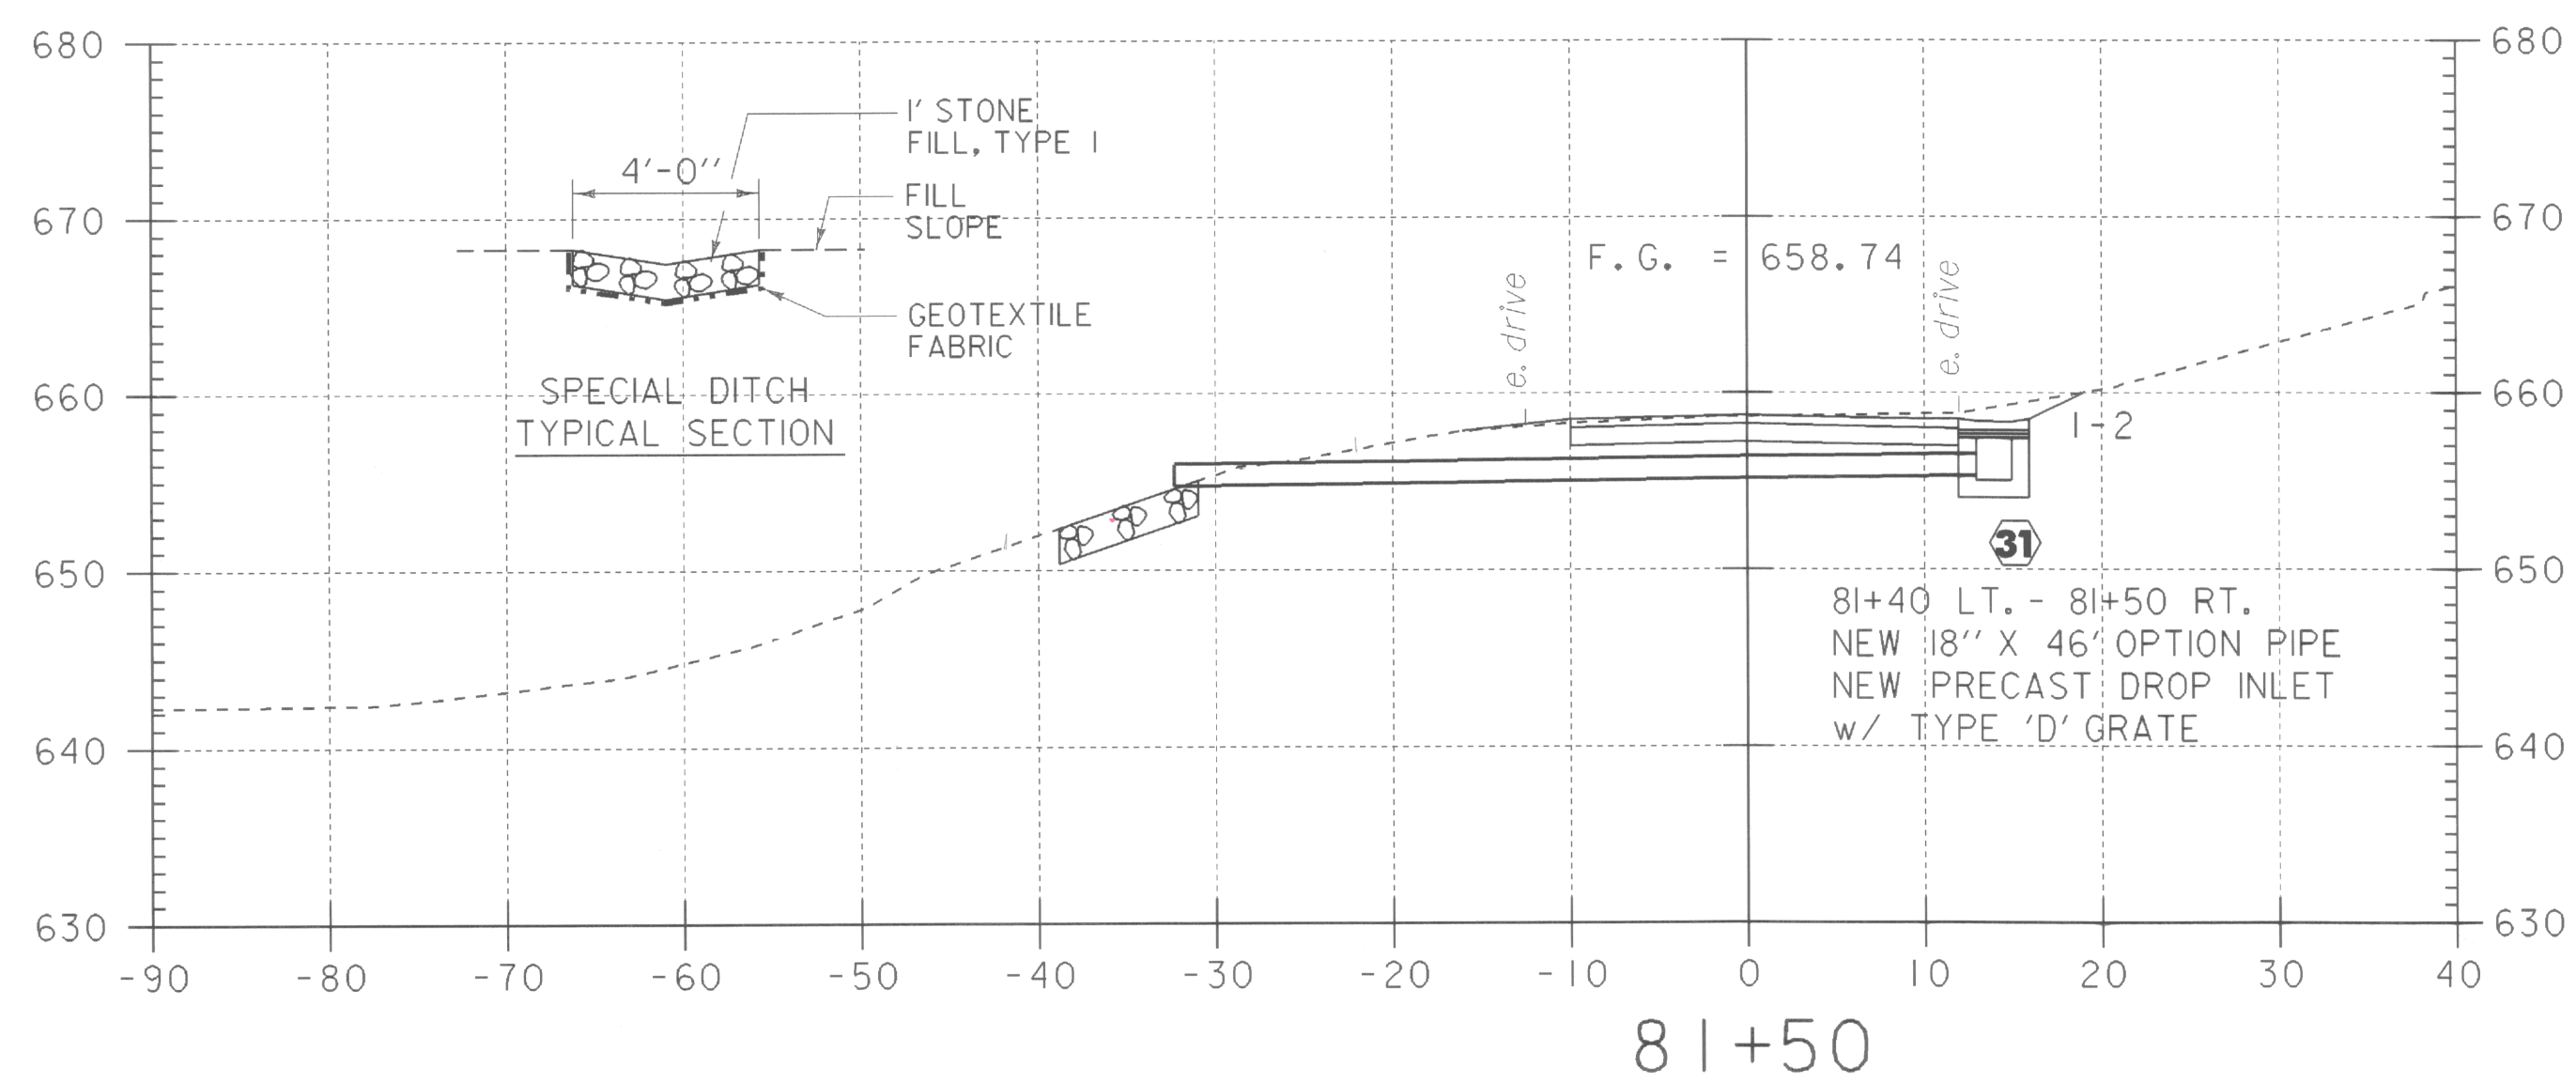

Stone Fill III

17.5	58.2
18	59.6
13.5	59.6
13.5	56.0
19.5	56.0
19.5	58.2

24" @ 17.5-08

81+25

17' @ 10-13-08

132-833-70

**DRIVE SECTIONS
STA 81+25 - STA 82+00**

PROJECT NAME:	RANDOLPH
PROJECT NUMBER:	BRF 0241 (29)
FILE NAME:	/s+r/5/88/096/sj096m1x.dgn
PROJECT LEADER:	W. SYMONDS
DESIGNED BY:	W. B. SYMONDS
sj096dr2.i	
PLOT DATE:	29-AUG-2006
DRAWN BY:	G. SHANGRAW
CHECKED BY:	T. SUMNER
SHEET	135 OF 135

