


BORING DATA

NO	NO 1	NO 2	NO 3	NO 4
60	CLAY & GRAVEL	CLAY & GRAVEL	CLAY & GRAVEL	SHALE GRAVEL
55	HARD PAN	SAND	SAND & CLAY	SHALE GRAVEL, SOME CLAY
50	CLAY & SHALE	RUNNING SAND	GRAVEL	CLAY & SAND
45	SHALE LEDGE	FINE SAND	CONCRETE	SAND, CLAY & GRAVEL
40		CLAY & SHALE	GRAVEL	SAND & CLAY
35		HARD PAN	CLAY & GRAVEL	SAND, CLAY & GRAVEL
30		LEDGE	CLAY & GRAVEL	SAND & CLAY
25			CLAY & GRAVEL	GRAVEL, SAND
20			CLAY & GRAVEL	CLAY
15			CLAY & GRAVEL	AMARENT LEDGE
10			CLAY & GRAVEL	
5			CLAY & GRAVEL	

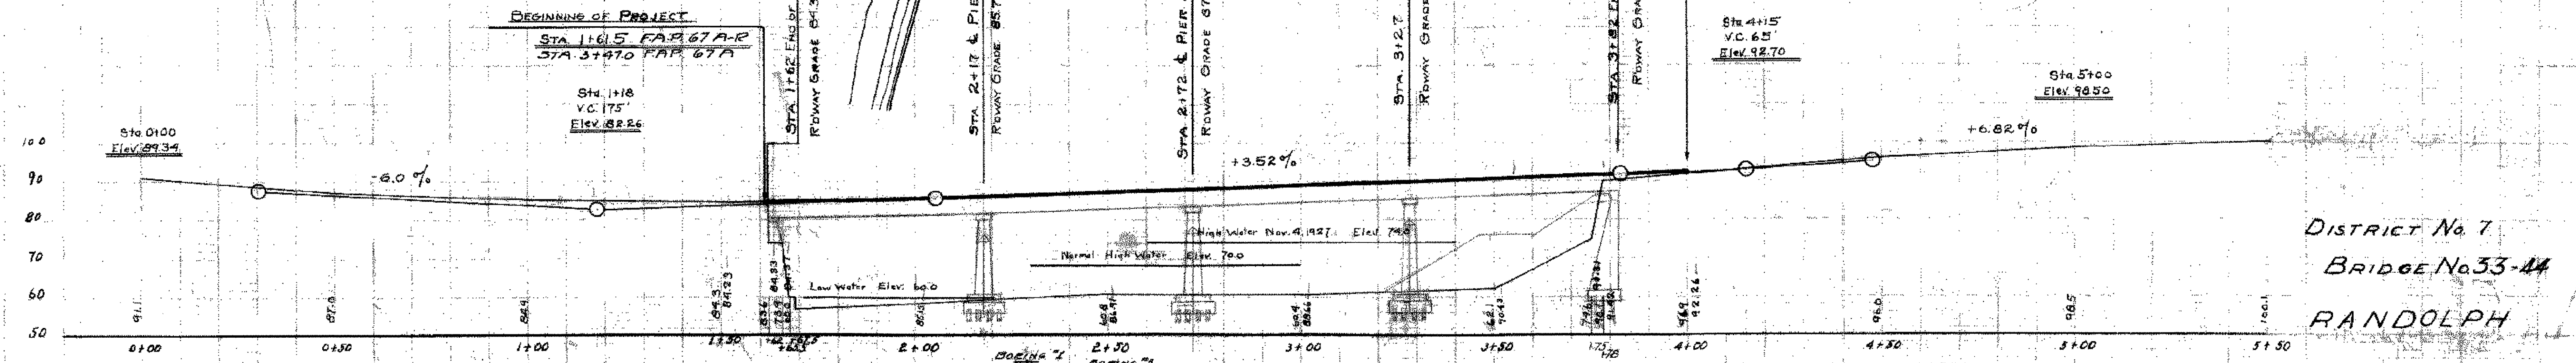

BM. No. 1 TOP OF HYDRANT AT INTERSECTION ELEV. 100.00
 BM. No. 2 RIGHT STA. 4+35 ELEV. 99.03

CORRECT
 A. D. Bishop
 BRIDGE ENGINEER

DISTRICT No. 7
 BRIDGE No. 33-44
 RANDOLPH
 SERIES F No. 67A(R), FILED 13-44
 SHEET 2 OF 11