


FED. ROAD DIST. NO.		STATE		FED. AID PROJ. NO.									
		VT											
BILL OF MATERIAL													
QTY EA	MARK	COMM	DESCRIPTION	LENGTH	SPEC	GRADE	TEST	REMARKS	GRP	ITEM	GROSS WEIGHT EA	DEDUCTED WEIGHT EA	NET WEIGHT EA
1	G2B		GIRDER								39156.28	3.37	39152.91
1	w1	PL	5/8 x 56	61	11 15/16	M270	50W	T	3	2	7383.41	2.13	7381.28
1	w2	PL	5/8 x 56	68	9	M270	50W	T	3	8	8187.93	1.24	8186.69
1	t1	PL	2 x 16	57	0 3/16	M270	50W	T	4	2	6208.37	0.00	6208.37
1	t2	PL	1 x 16	36	10	M270	50W	T	4	8	2005.37	0.00	2005.37
1	i3	PL	1 x 16	36	10 1/8	M270	50W	T	4	8	2005.94	0.00	2005.94
1	b1	PL	2 x 16	57	0 7/8	M270	50W	T	4	2	6214.61	0.00	6214.61
1	b2	PL	1 1/2 x 16	36	10	M270	50W	T	4	6	3008.06	0.00	3008.06
1	b3	PL	1 1/2 x 16	36	9 7/8	M271	50W	T	4	6	3007.20	0.00	3007.20
4	x2b	PL	3/4 x 7 1/2	4	8	M270	50W	T	7	1	89.32	0.00	89.32
7	x2c	PL	1/2 x 7	4	8	M270	50W	T	7	2	55.58	0.00	55.58
1	x2d	PL	1/2 x 7	4	8	M270	50W	T	7	2	55.58	0.00	55.58
6	x2f	PL	1/2 x 7	4	8	M270	50W	T	7	2	55.58	0.00	55.58
TOTAL WEIGHT THIS SHEET:											39152.91 lbs.		

GIRDER ~ MK. G2B

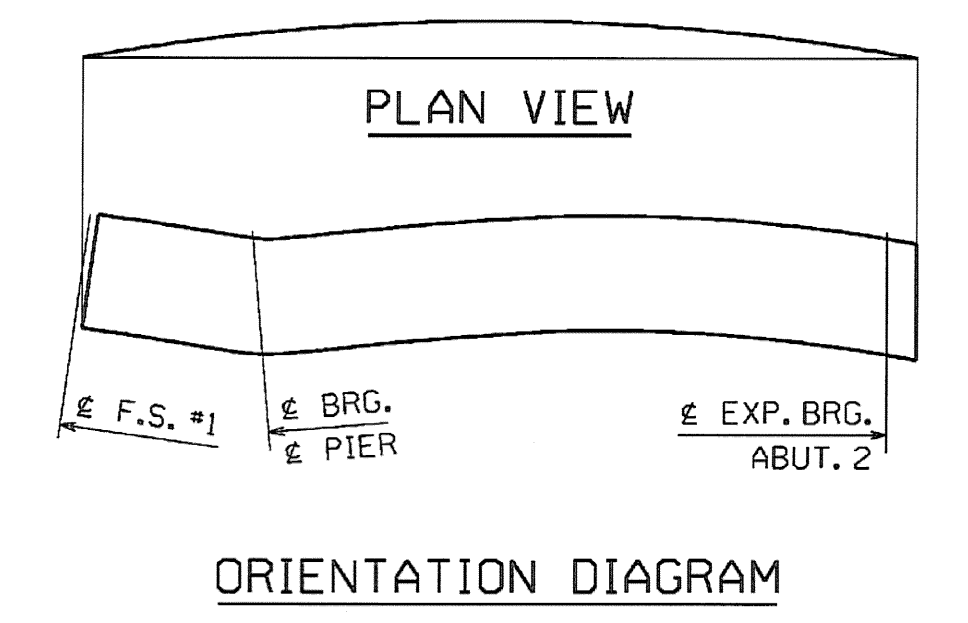

RECEIVED
 CK'D BY: [Signature] OK'D BY: [Signature]
 JAN 30 2007
 RESUBMIT: [Signature] APPROVED: [Signature]
 BY: [Signature] DATE: 1-31-2007

SHOP NOTE
HOLES: 1 5/16" (U.N.)
BOLTS: NONE
PAINT: NONE
 FOR GENERAL SHOP NOTES, SEE DWG. GNI.
 FOR WEB CAMBER DIAGRAM, SEE DWG. WCI.
 FOR HORIZ. CURVE DIAGRAM, SEE DWG. HCI.

1	ADD TIGHT FIT AND CHAMFY TEST NOTES. ADD HOLES AND DIMS. FOR WATER MAIN SUPPORT. REMOVE WELD SYMBOL.	MAF	1-19-07
NO.	REVISION	BY	DATE
HIGH STEEL STRUCTURES, INC.			
1770 Hempstead Road Lancaster, PA 17605-0008 Phone 717/299-5211			
A Division of High Industries, Inc.			
GIRDER		G2B	
VT. 12 (MAIN ST.) OVER THIRD BRANCH OF THE WHITE RIVER			
VT. 12 STA. 15+36.00 TO STA. 17+36.00			
TOWN OF RANDOLPH, ORANGE COUNTY, VT. BRIDGE NO. 42			
STATE OF VERMONT			
AGENCY OF TRANSPORTATION			
STATE CONTRACT OR REF. NO. PROJECT NO. RANDOLPH BR 0241 (29)			
CONTRACTOR: WINTERSET, INC.			
IN CHARGE: BRITIGAN (IH)	MADE BY: MAF	CHK'D BY: GS	DATE: 11-10-06
CONTRACT NUMBER: VT-06215-1		DRAWING NUMBER: 11 OF 14	