



**INDEX OF SHEETS**

SEE SHEET 2

STATE OF VERMONT  
AGENCY OF TRANSPORTATION

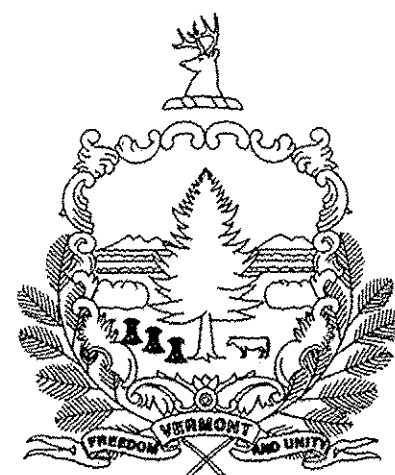

PROPOSED IMPROVEMENT  
BRIDGE PROJECT  
TOWN OF GRANVILLE  
COUNTY OF ADDISON  
PROJECT STP 013 - 4(38)

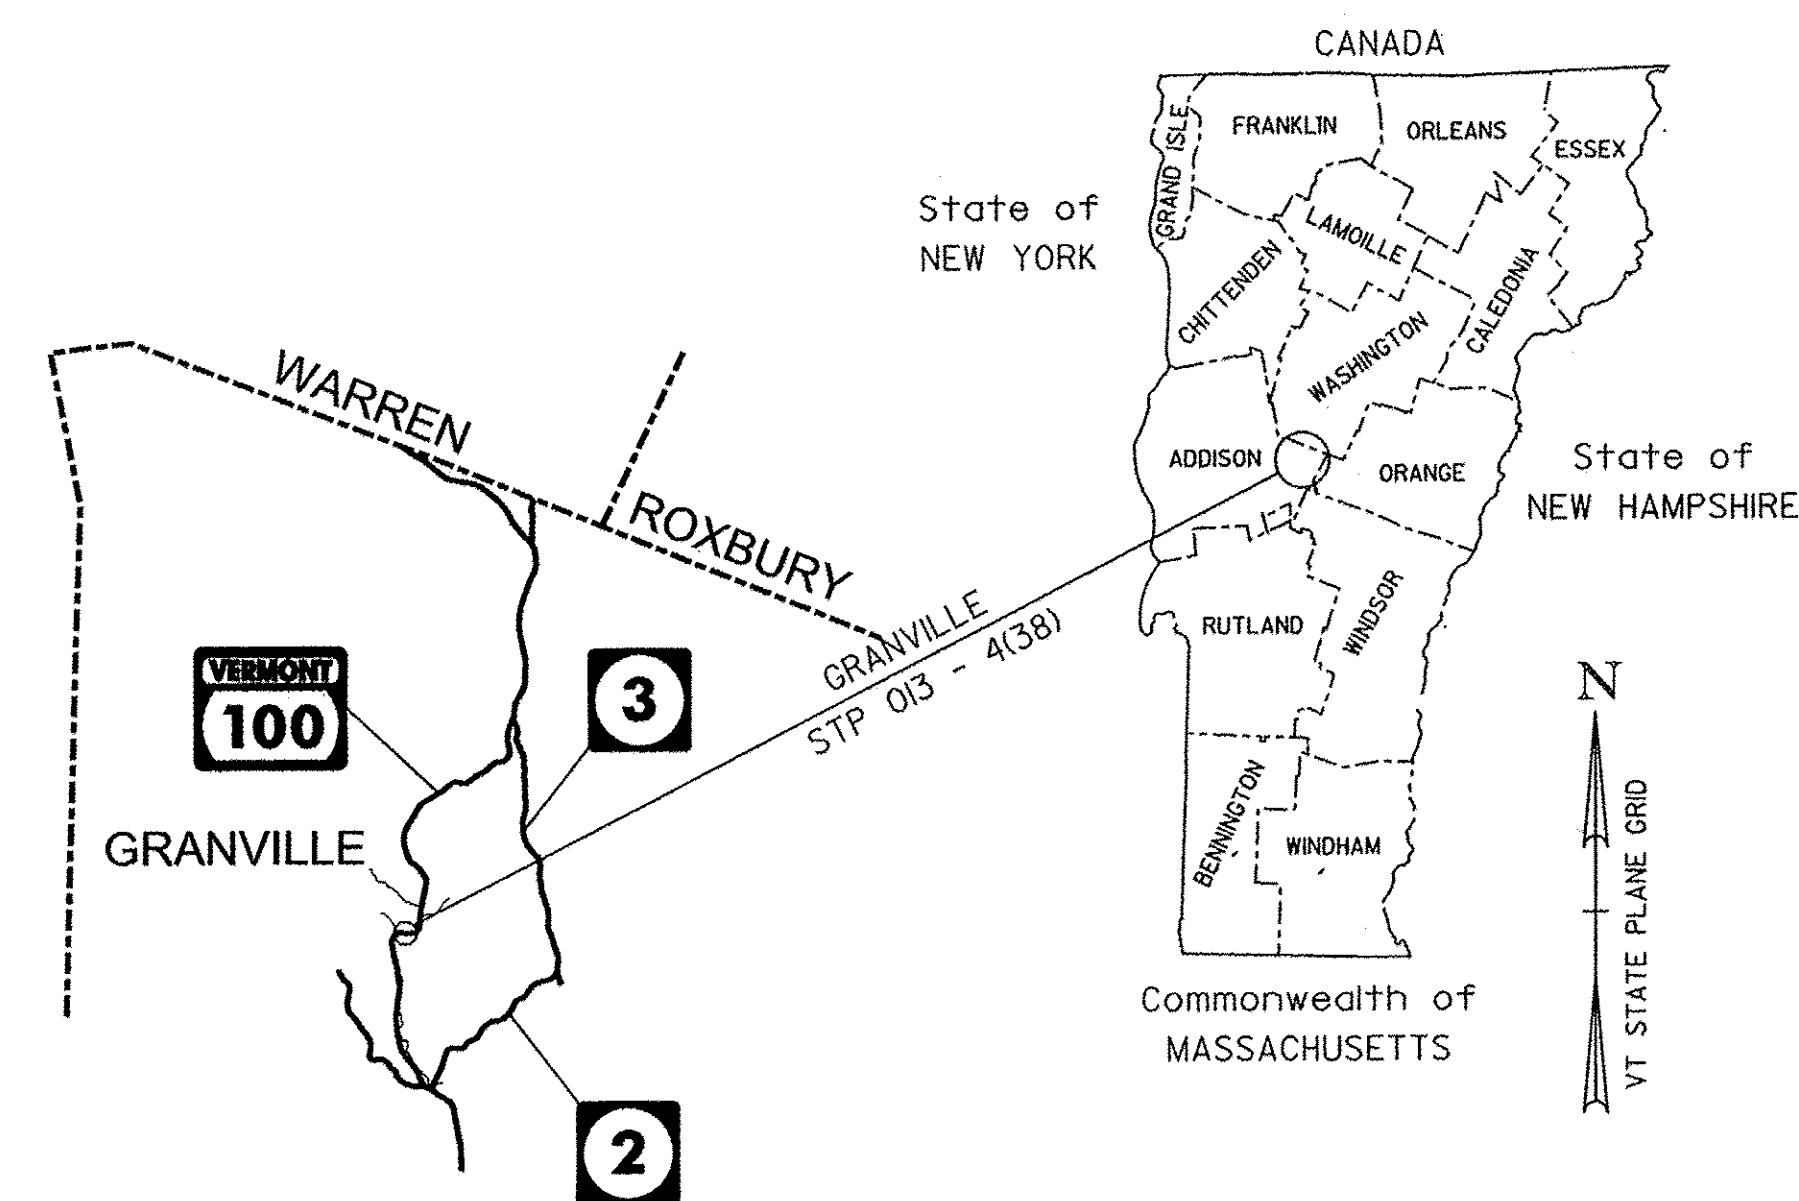

ROUTE NO.: VT 100  
BRIDGE NO.: 155  
PROJECT LOCATION: BR 155 OVER ALDER MEADOW BROOK  
APPROXIMATELY 5.7 MILES NORTH OF  
JUNCTION WITH VT 125

PROJECT DESCRIPTION: THIS PROJECT INVOLVES REMOVING AND REPLACING THE SHEET  
MEMBRANE WATERPROOFING AND BITUMINOUS CONCRETE  
PAVEMENT ON THE BRIDGE AND ITS APPROACHES ALONG WITH  
MINOR RELATED WORK.

LENGTH OF STRUCTURE: BR 155 32.10'


QUALITY ASSURANCE PROGRAM: LEVEL I

SURVEYED BY : N/A  
SURVEYED DATE : N/A

DATUM  
VERTICAL N/A  
HORIZONTAL N/A

**CONVENTIONAL SYMBOLS**

COUNTY LINE	
TOWN LINE	
LIMITS OF ACCESS	
POINT OF ACCESS	
FENCE LINE	
STONE WALL	
TRAVELED WAY	
GUARD RAIL	
RAILROAD	
SURVEY LINE	
CULVERT	
POWER POLE	
TELEPHONE POLE	
TREES	
CONTROL OF ACCESS	
PROPERTY LINE	
R.O.W. TAKING LINE	
SLOPE RIGHTS	
TOP OF CUT	
TOE OF SLOPE	

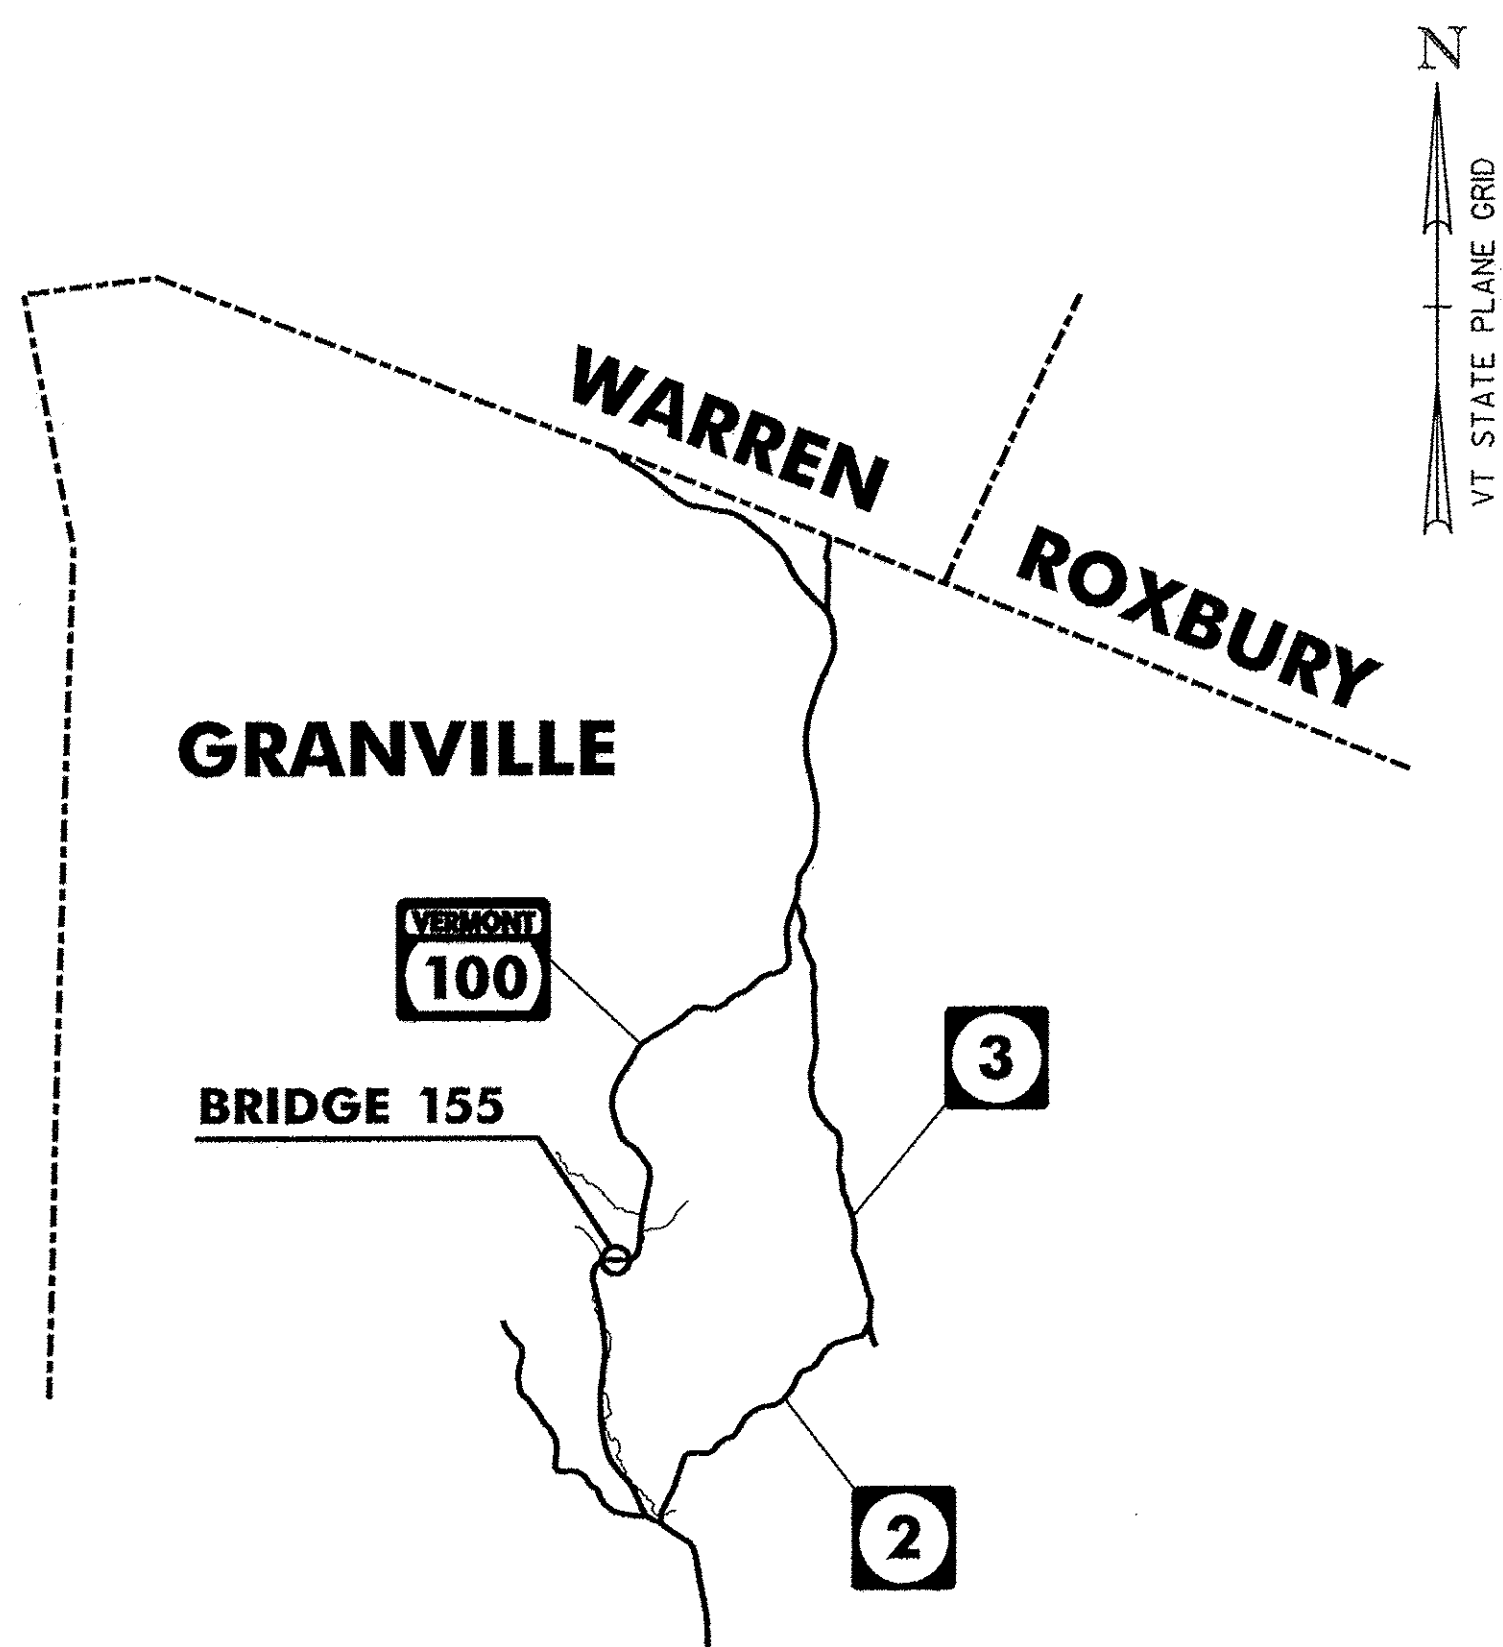

**RECORD PLANS**

CONTRACTOR: J.P. SICARD, INC. - BARTON, V.T.  
RESIDENT ENGINEER: CHRIS LAVALET  
CONSTRUCTION BEGAN: FEBRUARY 1, 2011  
CONSTRUCTION COMPLETE: JANUARY 19, 2012  
RECORD PLANS BY: CHRIS LAVALET & NICK GARBACIK

I HEREBY CERTIFY THAT ALL THE CONSTRUCTION REQUIRED BY THIS SET OF DRAWINGS HAS BEEN ACCOMPLISHED AS INDICATED HEREIN.

BY *Chris Lavalet* RESIDENT ENGINEER  
DATE 6/2/14

NOTE: Any further information concerning final quantities, amounts or other details relative to this project may be found at Central Files in the electronic archives.

THESE PLANS ARE SUBJECT TO SUCH ENGINEERING CHANGES AS MAY BE REQUIRED BY THE FEDERAL HIGHWAY ADMINISTRATION OR THE DIRECTOR OF PROGRAM DEVELOPMENT.

CONSTRUCTION IS TO BE CARRIED ON IN ACCORDANCE WITH THESE PLANS AND THE STANDARD SPECIFICATIONS FOR CONSTRUCTION DATED 2006, AS APPROVED BY THE FEDERAL HIGHWAY ADMINISTRATION ON JUNE 15, 2006 FOR USE ON THIS PROJECT, INCLUDING ALL SUBSEQUENT REVISIONS AND SUCH REVISED SPECIFICATIONS AND SPECIAL PROVISIONS AS ARE INCORPORATED IN THESE PLANS.

PLANS PREPARED BY:

540 Commercial Street Manchester, NH 03101  
(603) 668-8223 • Fax: (603) 668-8802  
email: cld@cldeengineers.com • www.cldengineers.com  
Maine • New Hampshire • Vermont

DIRECTOR OF PROGRAM DEVELOPMENT  
APPROVED *[Signature]* DATE 4-15-13  
PROJECT MANAGER : DOUGLAS BONNEAU  
PROJECT NAME : GRANVILLE  
PROJECT NUMBER : STP 013 - 4(38)  
SHEET 1 OF 11 SHEETS