
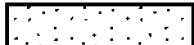


THIS BRIDGE DOES NOT HAVE APPROACH SLABS. THEREFORE, ALL PAVEMENT REMOVAL BEHIND ABUTMENTS SHALL BE PAID FOR UNDER ITEM 210.10, "COLD PLANING, BITUMINOUS PAVEMENT".

-  COLD PLANE - 1/2"
-  COLD PLANE - 3"
-  REMOVE BIT. CONC. PAV'T - TO THE TOP OF THE CONCRETE BRIDGE DECK AND REMOVE THE BARRIER MEMBRANE.

NOTE:

1. COLD PLANING WILL BE PAID FOR UNDER ITEM 210.10 EXCEPT AS OTHERWISE SPECIFIED IN NOTE II ON SHEET 2.
2. REMOVAL OF THE BIT. CONC. PAV'T. WILL BE PAID FOR UNDER ITEM 529.10.
3. REMOVAL OF THE BARRIER MEMBRANE WILL BE PAID FOR UNDER ITEM 580.16.

BITUMINOUS CONCRETE REMOVAL & REPLACEMENT PLAN

NOT TO SCALE

SEE PAGE 4A

PROJECT NAME: GRANVILLE	
PROJECT NUMBER: STP 013 - 4(38)	
FILE NAME: 88b192-removal.dgn	PLOT DATE: 4/11/2013
PROJECT LEADER: JPB	DRAWN BY: MWS
DESIGNED BY: PJM	CHECKED BY: SRB
BITUMINOUS CONCRETE REMOVAL PLAN SHEET 5 OF 11	