



PLAN

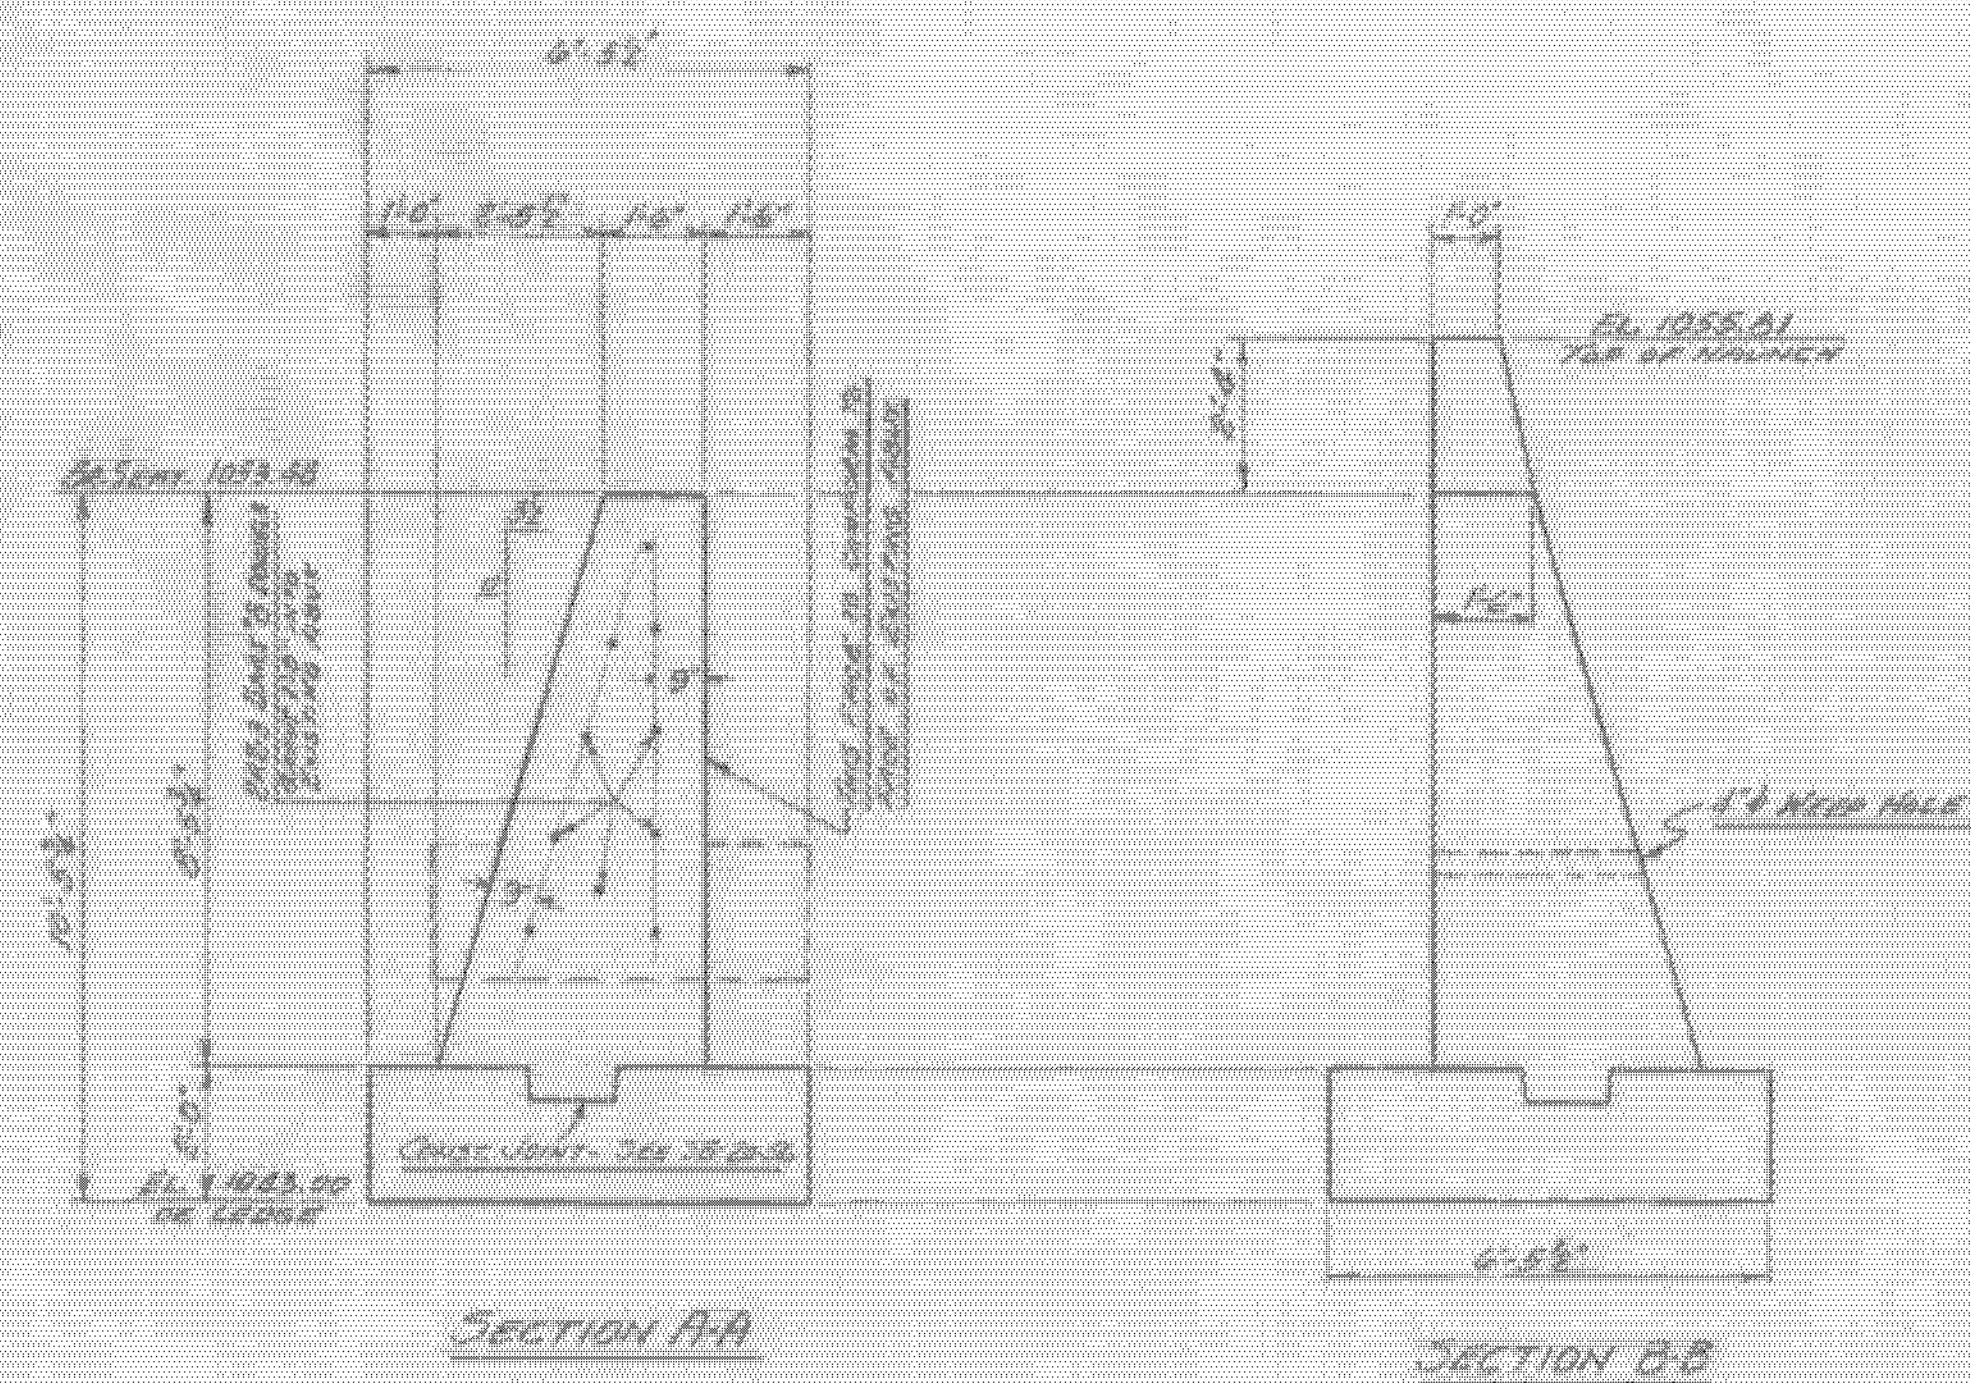


SECTION A-A

SECTION B-B

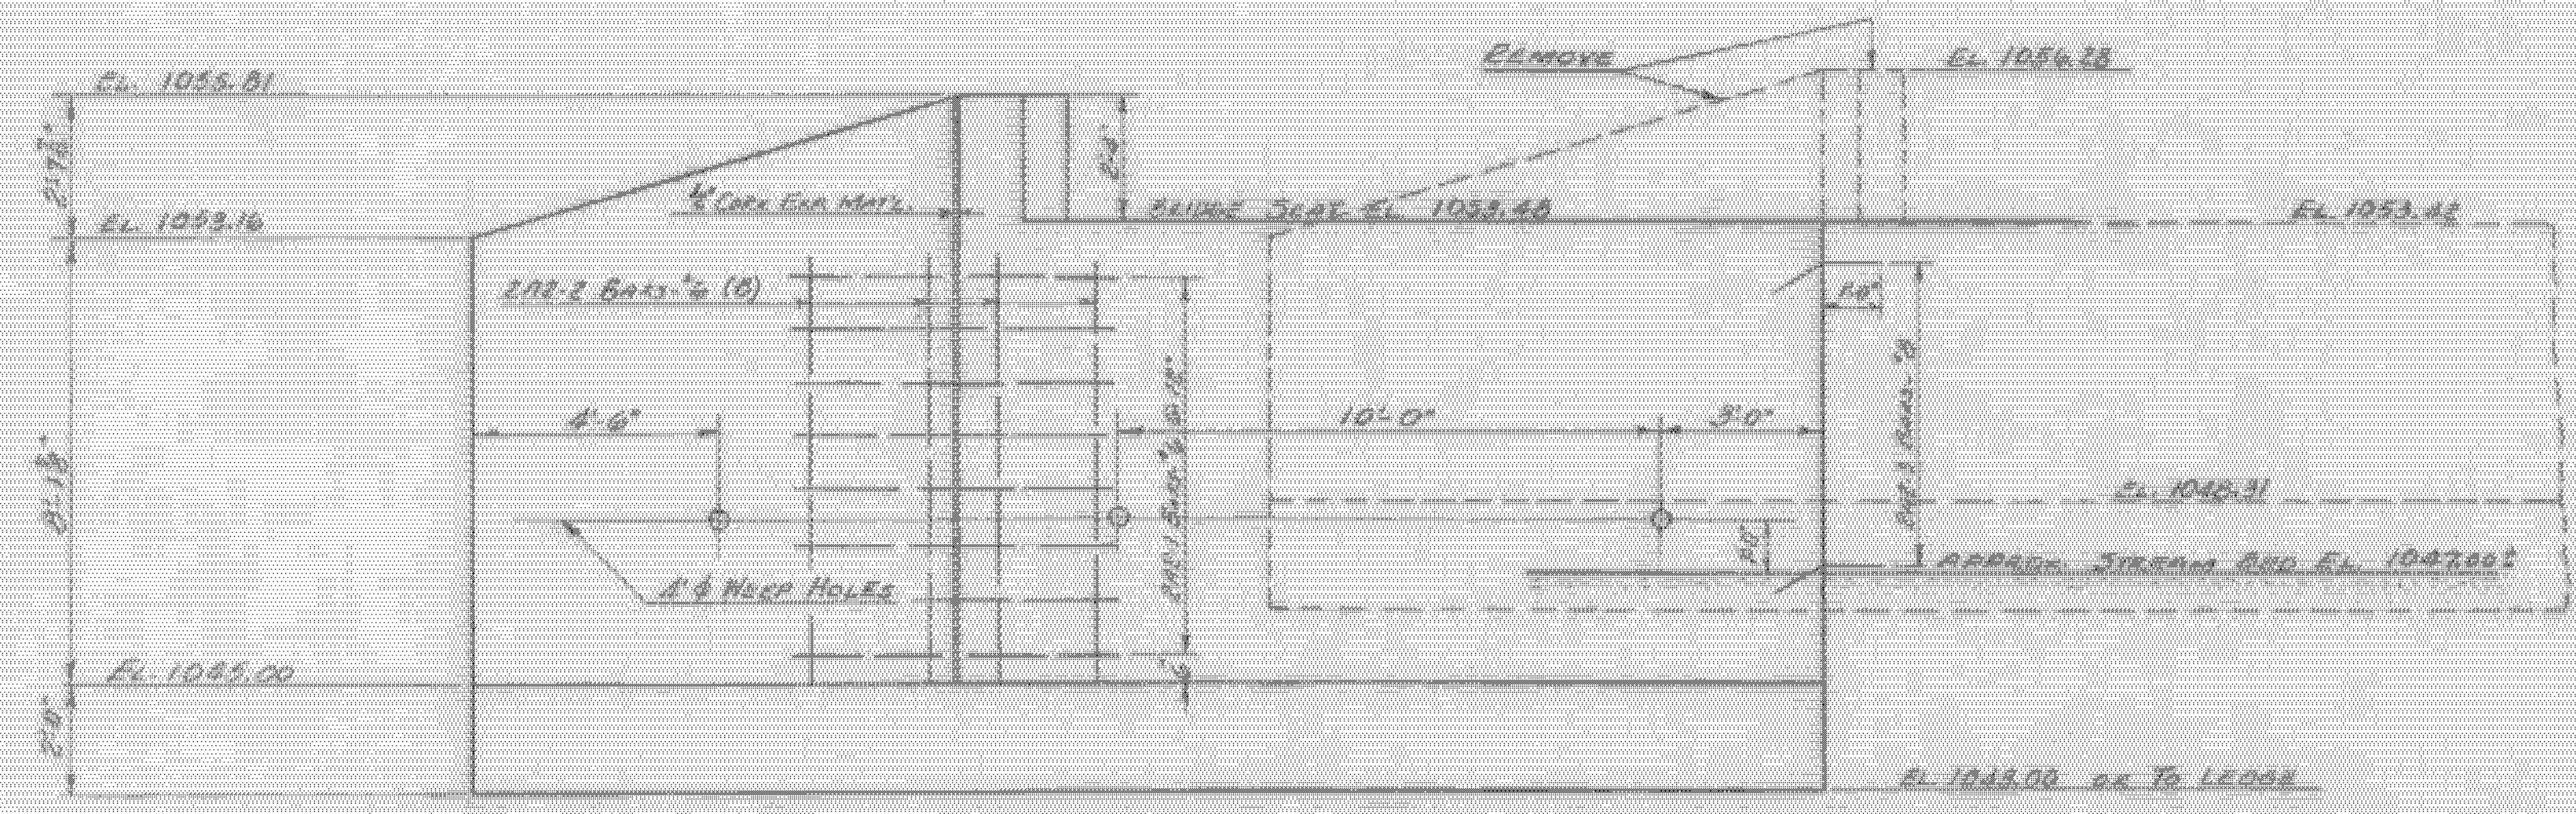

ELEVATION

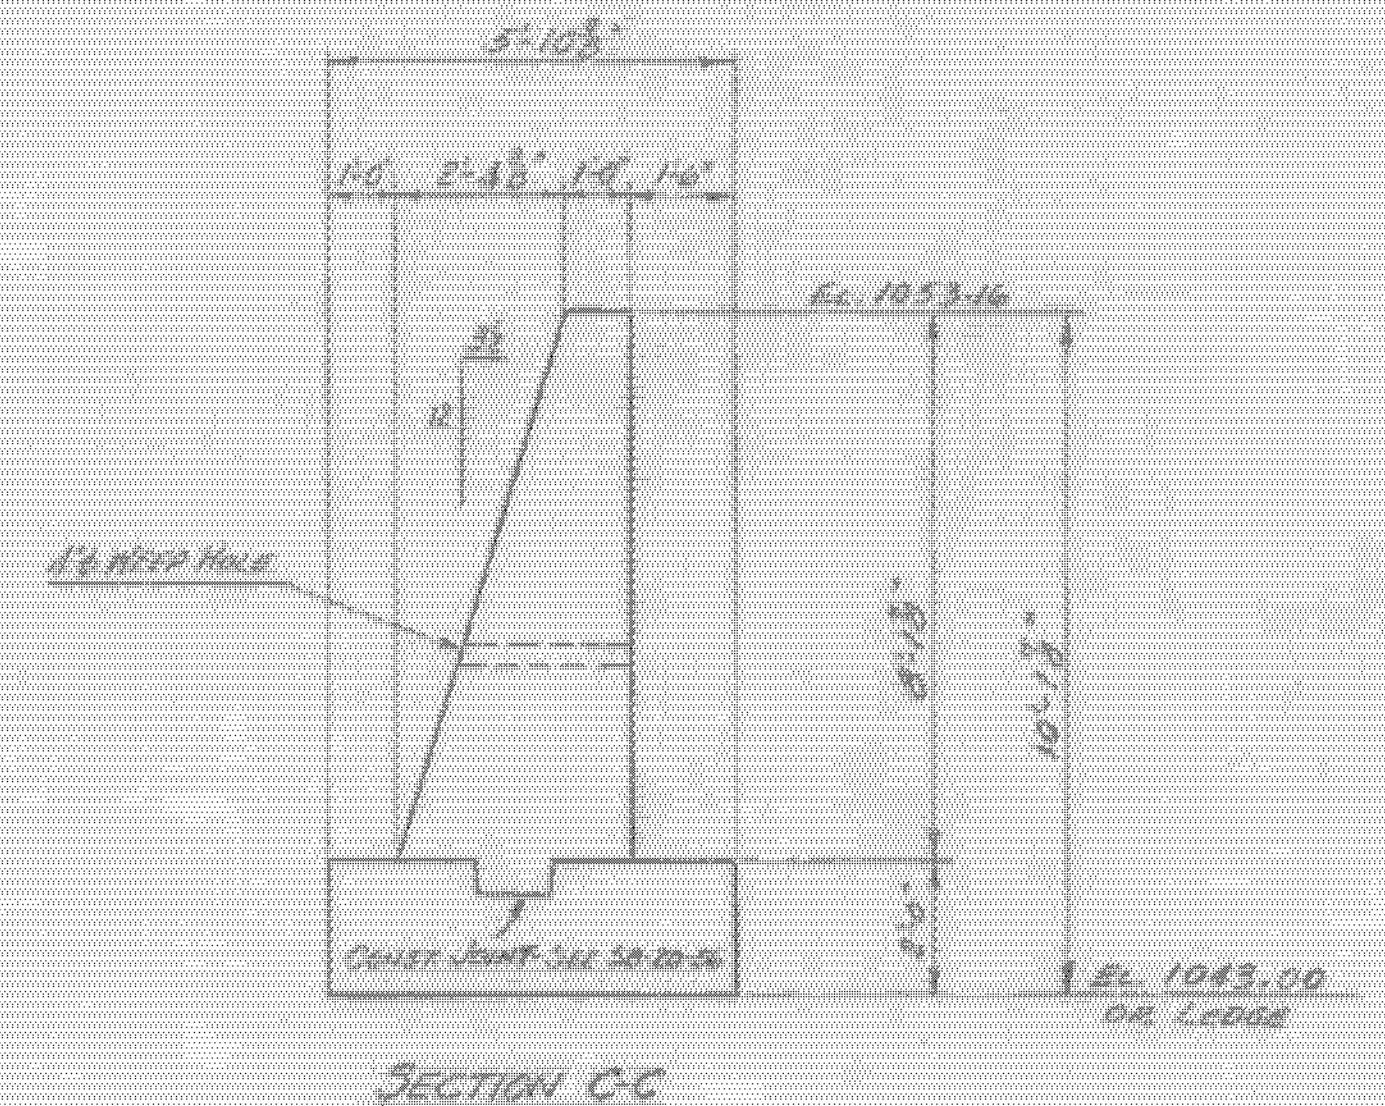

SECTION C-C

GRANVILLE
STP 013-4(38)
SHEET 11 OF 11
FOR REFERENCE ONLY

QUANTITIES					
ITEM	DESCRIPTION	UNIT	NET	GRAN	FINN
101-B	SOLID ROCK EXCAVATION	CY	8	1	9
107	STRUCTURE EXCAVATION	CY	58	6	58
101-B	CONCRETE CLASS B (MOD.)	CY	53	2	55
102	REINFORCING STEEL (5000 REINF. STEEL GRADE)	LB			418
522	STONE FILL FOR SLOPE PROTECTION	CY		5	0

STATE OF VERMONT
DEPARTMENT OF HIGHWAYS

TOWN OF GRANVILLE

ROUTE No. 100 LOG STA. 233+78

DETAILS OF ABUTMENT No. 2

BRIDGE No. 2

SCALE 3/4" = 1'-0"

SURVEYED BY PALMER & BURLEY

DRAWN BY R.C.B. CHECKED BY J.B.M.

PROJECT No. 5-109(78)

SHEET 45 OF 202