


BRIDGE TYPICAL SECTION

SCALE $\frac{3}{8}'' = 1' - 0''$

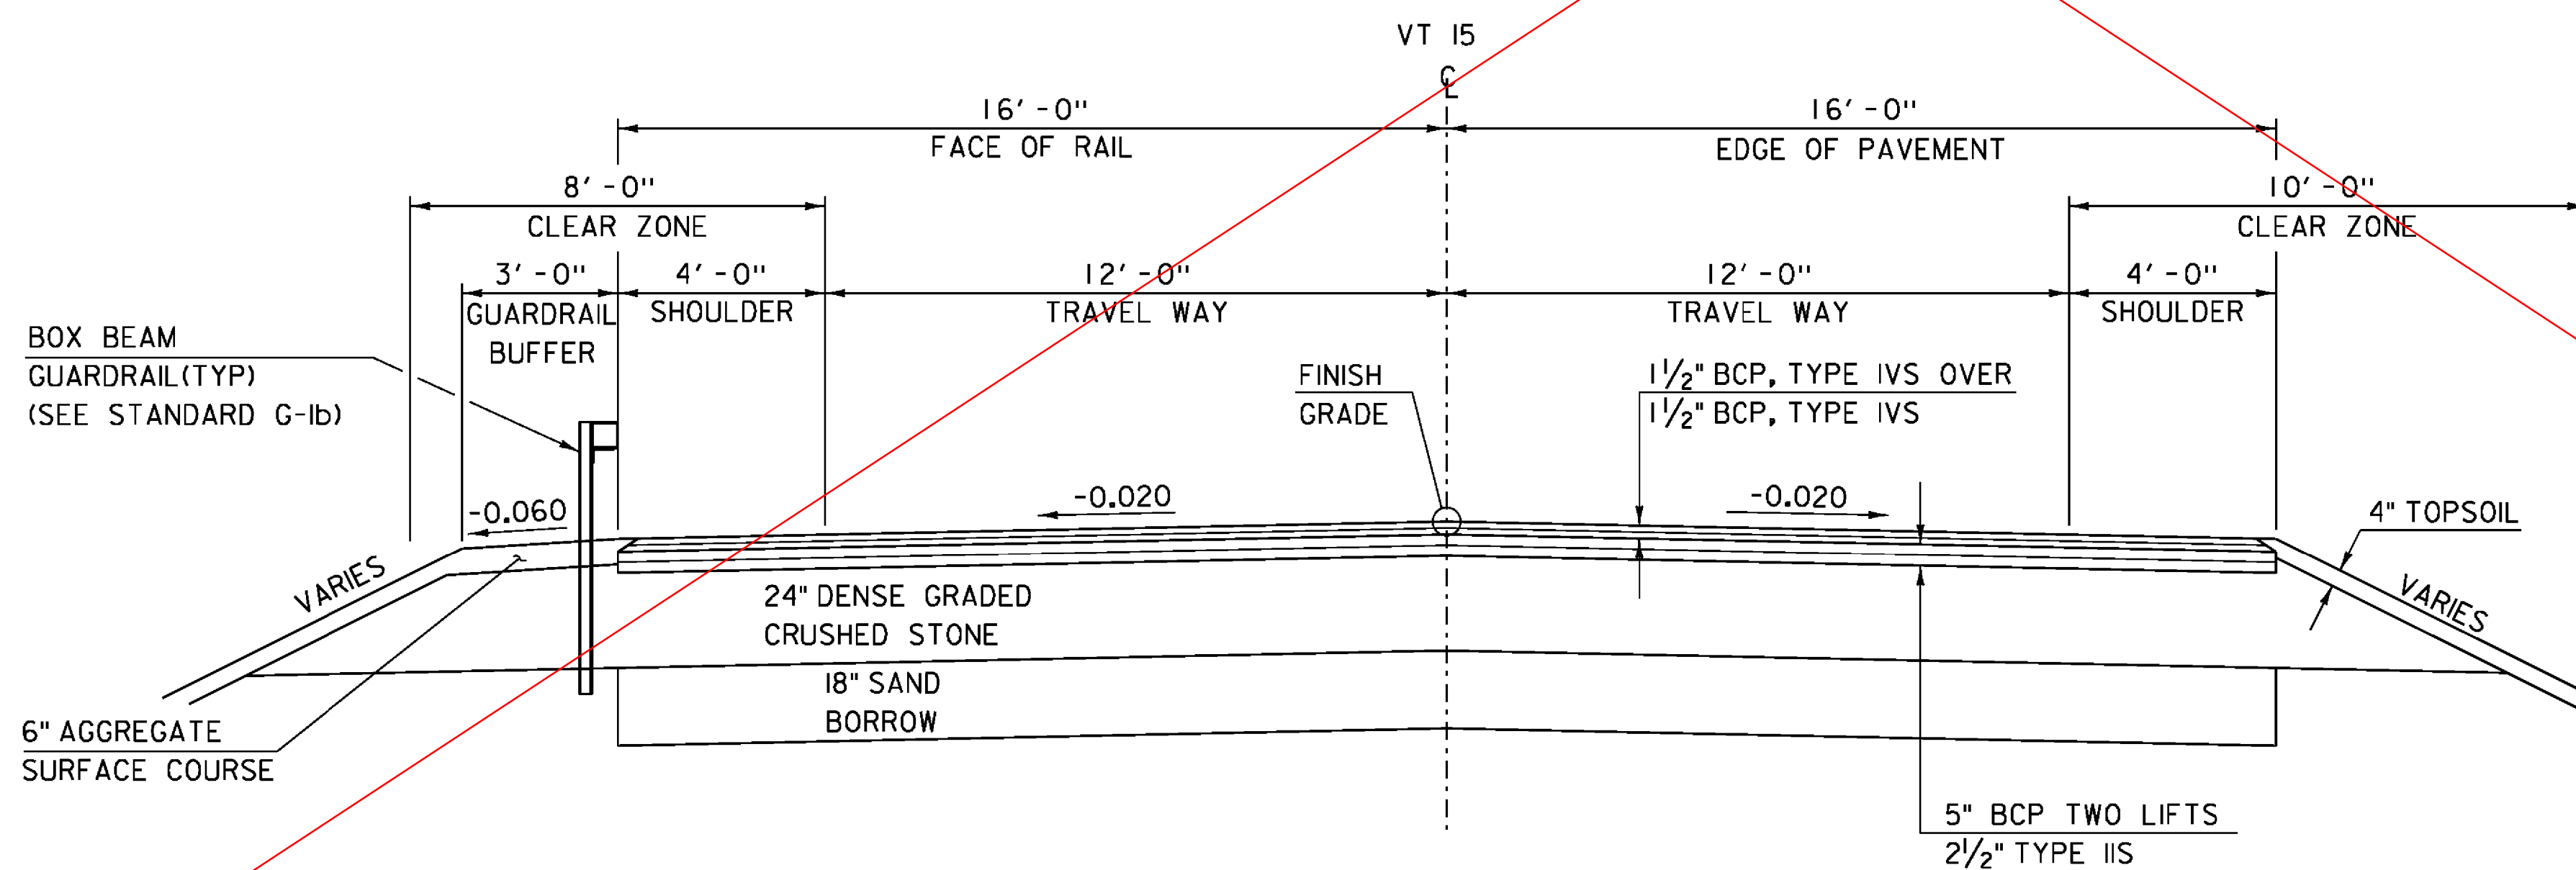

ROADWAY TYPICAL SECTION

SCALE $\frac{3}{8}'' = 1' - 0''$

*BCP: BITUMINOUS CONCRETE PAVEMENT PAID FOR UNDER ITEM 900.680 "SPECIAL PROVISION (BITUMINOUS CONCRETE PAVEMENT, SMALL QUANTITY)".

MATERIAL TOLERANCES (IF USED ON PROJECT)	
SURFACE	
- PAVEMENT (TOTAL THICKNESS)	+/- $\frac{1}{4}''$
- AGGREGATE SURFACE COURSE	+/- $\frac{1}{2}''$
SUBBASE	+/- 1"
SAND BORROW	+/- 1"

SEE REVISION: OCT-28-2014

PROJECT NAME: JOHNSON
PROJECT NUMBER: BRF 030-2(26)

FILE NAME: s88bi93+yp.dgn
PROJECT LEADER: C. CARLSON
DESIGNED BY: H. SALLS
TYPICAL SECTIONS (1)

PLOT DATE: 10-JUN-2014
DRAWN BY: R. PELLET
CHECKED BY: H. SALLS
SHEET 4 OF 69