


BRIDGE TYPICAL SECTION

SCALE 3/8" = 1'-0"

REMOVE
LONGITUDINAL DECK GROOVING

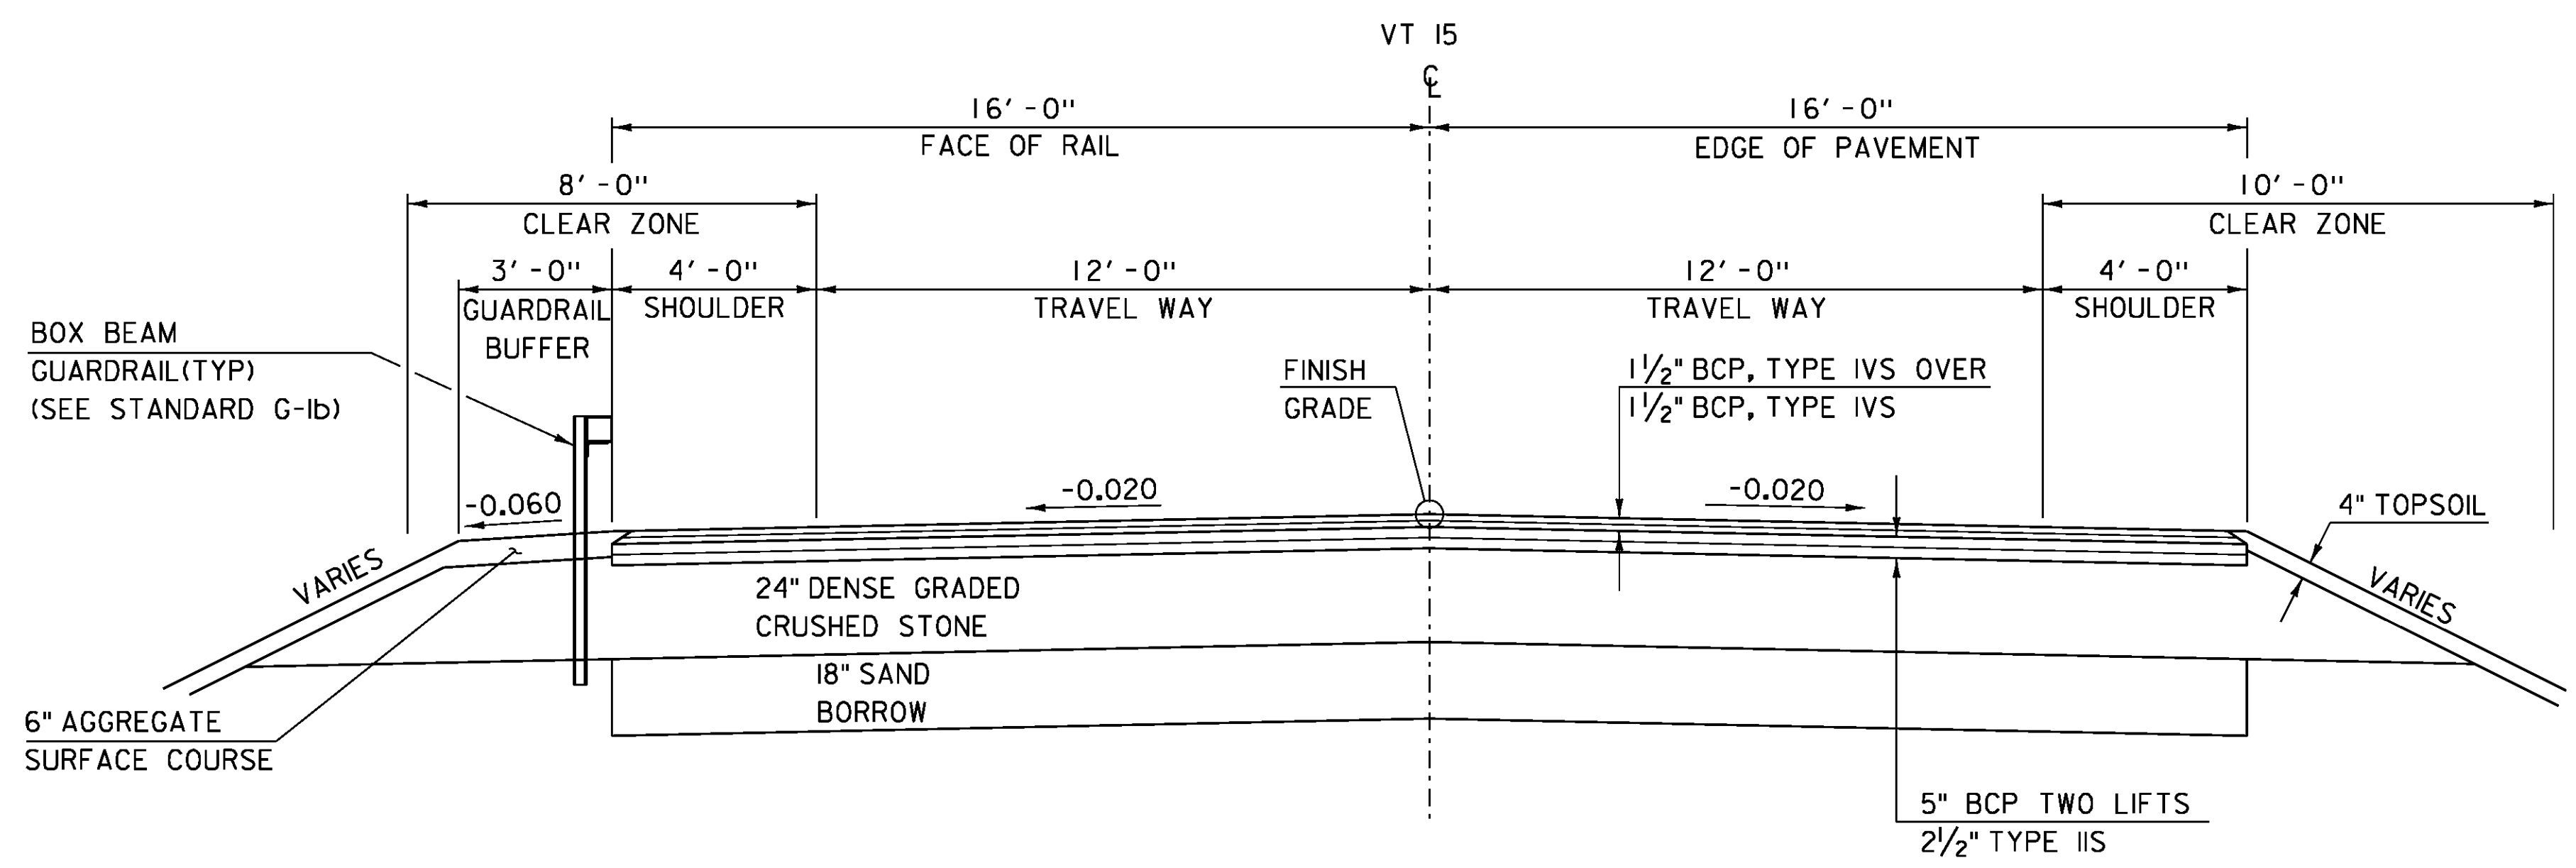

ROADWAY TYPICAL SECTION

SCALE 3/8" = 1'-0"

*BCP: BITUMINOUS CONCRETE PAVEMENT PAID FOR UNDER ITEM 900.680 "SPECIAL PROVISION (BITUMINOUS CONCRETE PAVEMENT, SMALL QUANTITY)".

REVISION	DATE	DESCRIPTION	BY
1	OCT-28-2014	ADD 3" PAYMENT, LOWER BRIDGE SEAT, ADD 3" CONCRETE PEDESTAL	GNR

MATERIAL TOLERANCES (IF USED ON PROJECT)	
SURFACE	
- PAVEMENT (TOTAL THICKNESS)	+/- 1/4"
- AGGREGATE SURFACE COURSE	+/- 1/2"
SUBBASE	
	+/- 1"
SAND BORROW	
	+/- 1"

PROJECT NAME:	JOHNSON
PROJECT NUMBER:	BRF 030-2(26)
FILE NAME:	s88bl93typ.dgn
PROJECT LEADER:	C. CARLSON
DESIGNED BY:	H. SALLS
TYPICAL SECTIONS (1)	
PLOT DATE:	05-NOV-2014
DRAWN BY:	R. PELLETT
CHECKED BY:	H. SALLS
SHEET	4 OF 69