



**CONSTRUCT STONE FILL, TYPE II BANK SLOPE**  
 VT 15 STA 89+00.0 LT - VT 15 STA 92+00.0 LT

**CONSTRUCT GRASS-LINED DITCH**  
 VT 15 STA 89+00.0 LT - VT 15 STA 92+00.0 LT

**HD STEEL BEAM GUARDRAIL, GALVANIZED**  
 VT 15 STA ~~89+59.8~~ RT - VT 15 STA 92+00.0 RT  
 89+40.0

**REMOVAL AND DISPOSAL OF GUARDRAIL**  
 VT 15 STA ~~89+59.8~~ RT - VT 15 STA 92+00.00 RT  
 89+40.0

① VT 15 STA 89+00.0 LT - VT 15 STA 92+00.0 LT  
 NEW 8 INCH UNDERDRAIN PIPE W/ UNDERDRAIN FLUSHING  
 BASIN AND YIELDING MARKER POST AT INLET

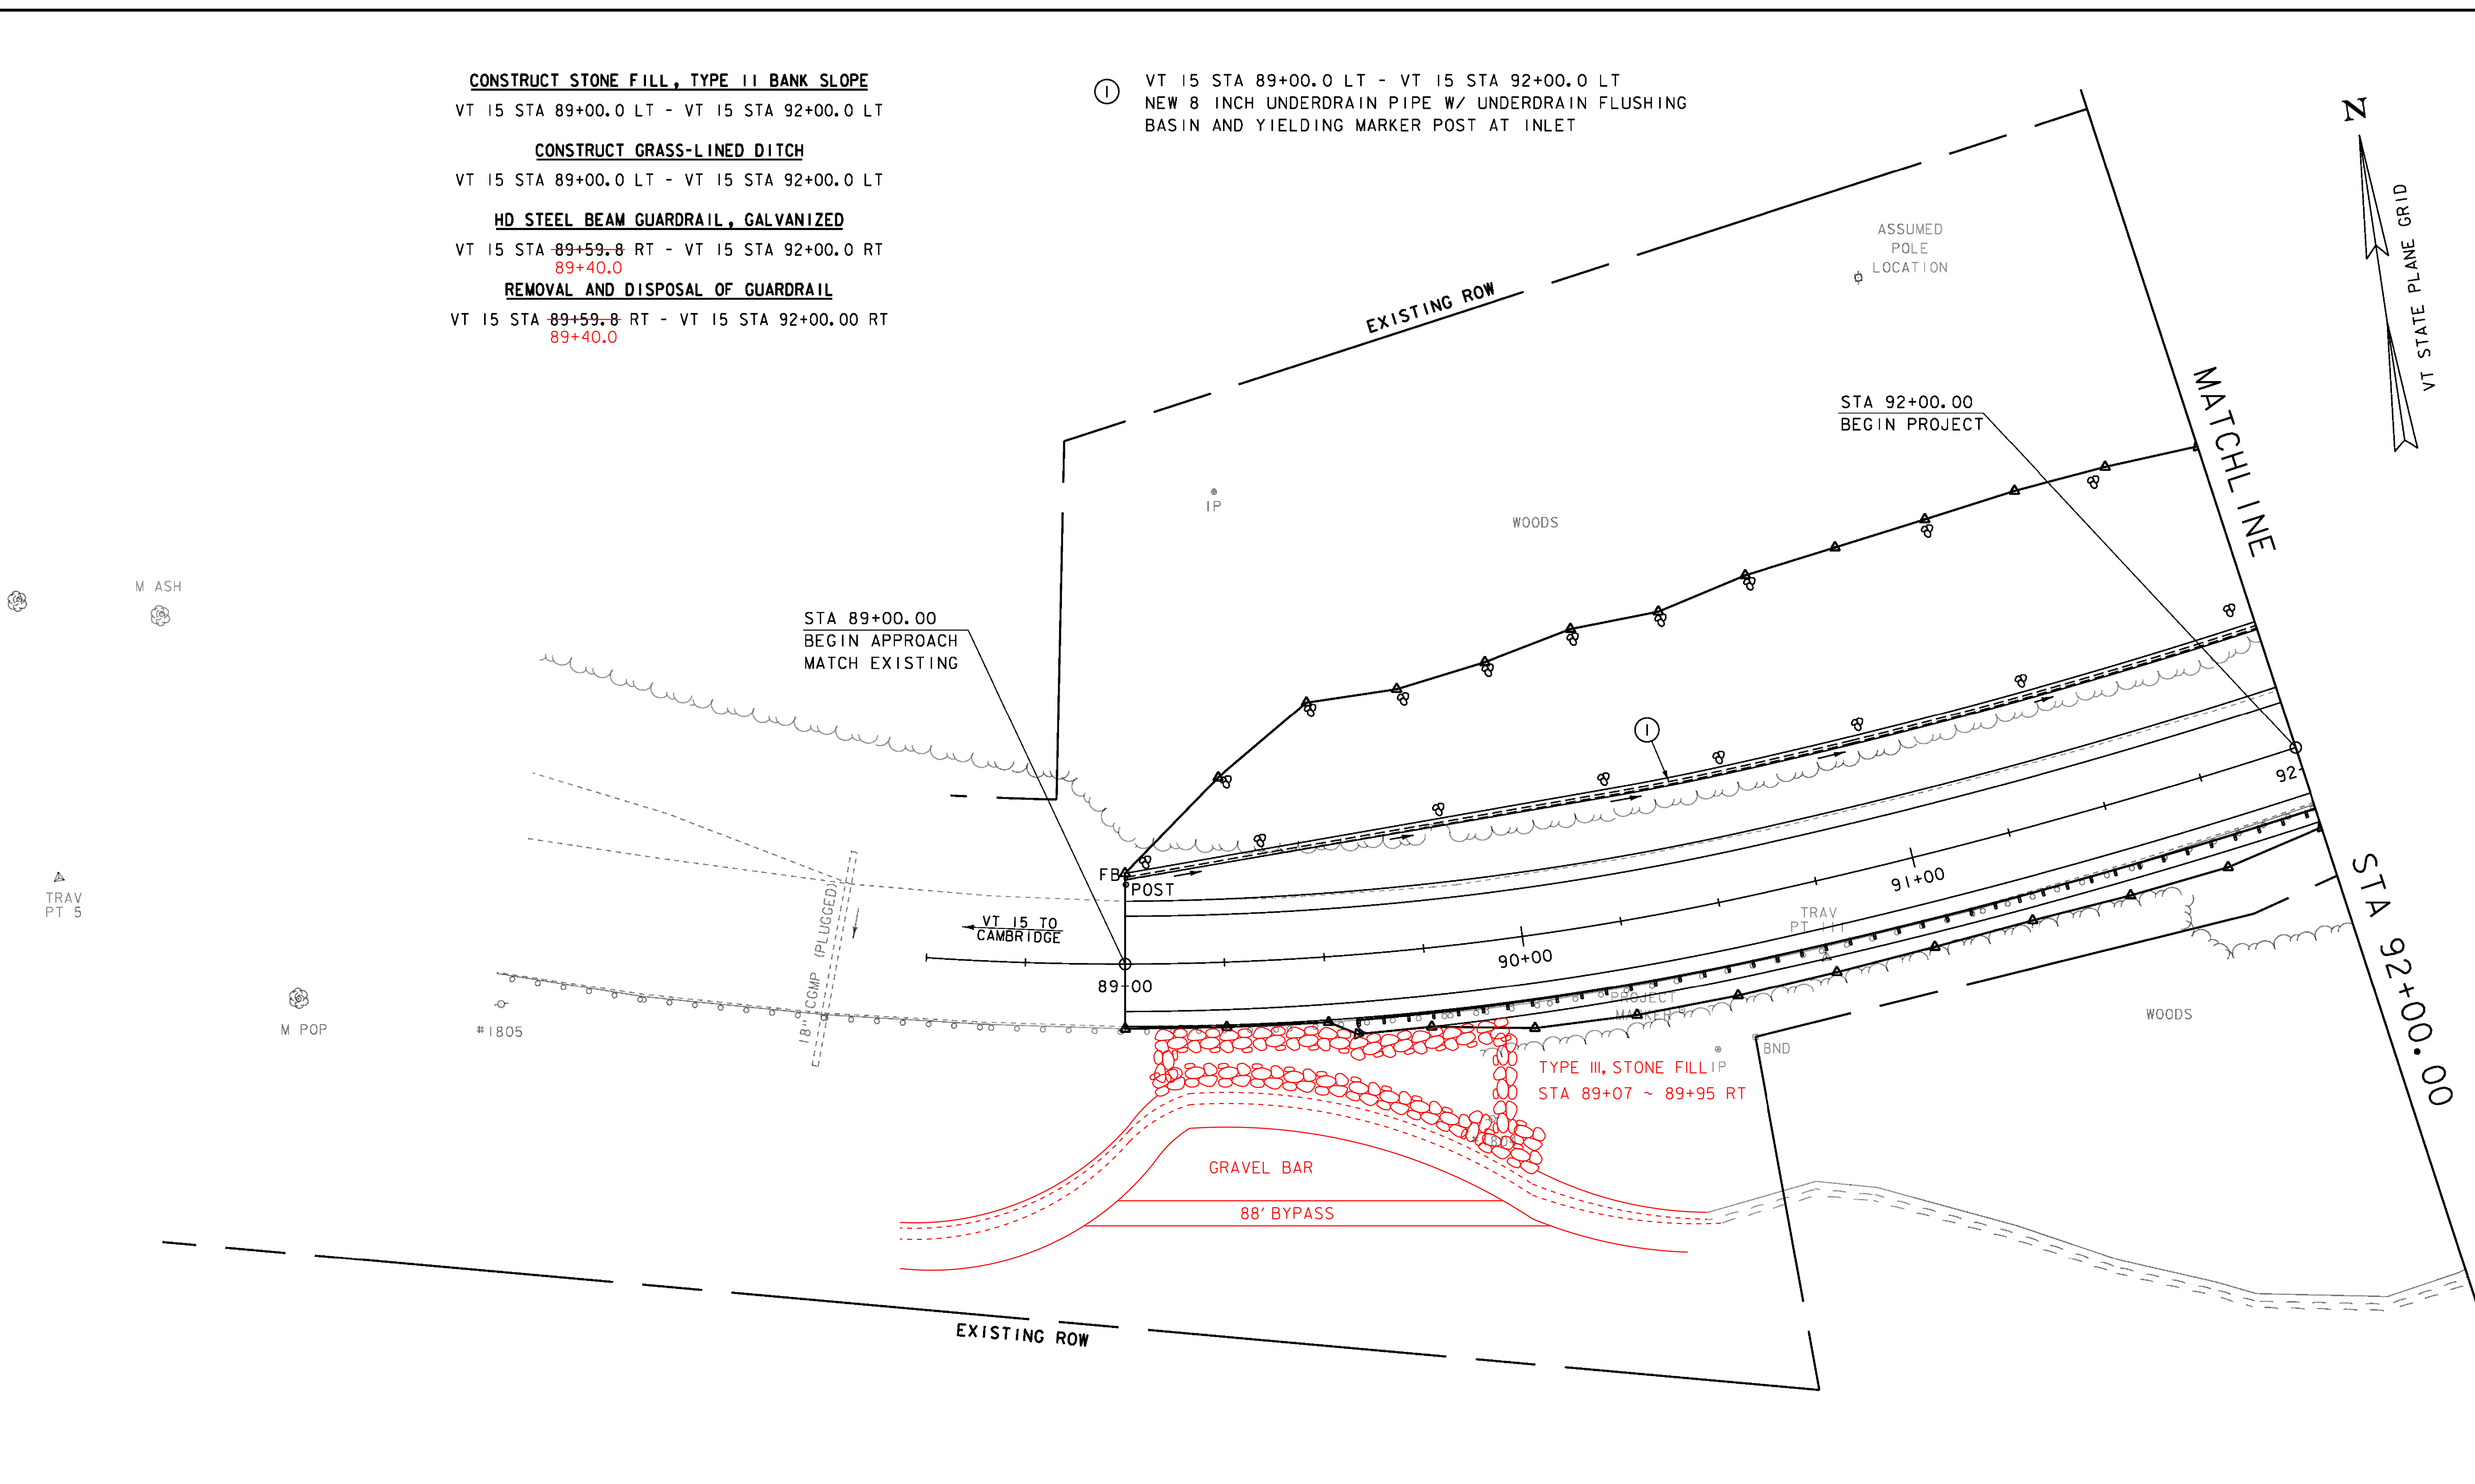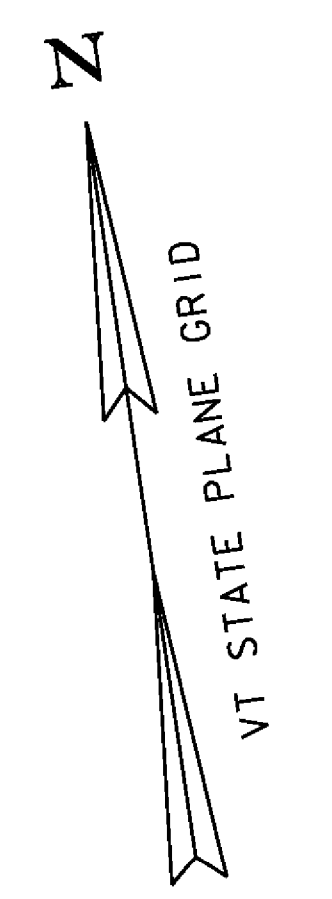

20 0 20  
 SCALE: 1" = 20'-0"

PROJECT NAME:	JOHNSON	PLOT DATE:	10-JUN-2014
PROJECT NUMBER:	BRF 030-2(26)	DRAWN BY:	G. ROY
FILE NAME:	s88bi93bdr.dgn	CHECKED BY:	H. SALLS
PROJECT LEADER:	C. CARLSON	SHEET	13 OF 69
DESIGNED BY:	G. ROY		
LAYOUT (1)			