


- ② VT 15 STA 92+00.0 LT - VT 15 STA 92+58.0 LT
NEW 8 INCH UNDERDRAIN PIPE
- ③ VT 15 STA 92+58.0 LT - VT 15 STA 93+34.1 LT
NEW 8 INCH UNDERDRAIN CARRIER PIPE W/ YIELDING
MARKER POST AT OUTLET

- ① TH 71 STA 30+32.23 LT - TH 71 STA 30+32.23 RT
NEW 18" X 74' CAAP (.060), PCCSP (.064) OR CPEP (SL)
- ② TH 43 STA 40+45.50 LT - TH 43 STA 40+54.49 RT
NEW 18" X 54' CAAP (.060), PCCSP (.064) OR CPEP (SL)
W/ 5'-6" X 13' STONE FILL, TYPE I PAD AT OUTLET
- ◇ REMOVE EXISTING 12" CGMP
- ◇ REMOVE EXISTING 15" CGMP

EXISTING BRIDGE DATA
 SINGLE SPAN CONCRETE T-BEAMS WITH
 ROLLED BEAMS ALONG FASCIAS
 ABUTMENTS ARE CONCRETE ON TIMBER PILES
 BUILT 1926, REHABILITATED 1969
 OVERALL LENGTH: 24'-0"
 SPAN LENGTH: 22'-6"
 FASCIA TO FASCIA WIDTH: 33'-0"
 ROADWAY WIDTH: 30'-10"

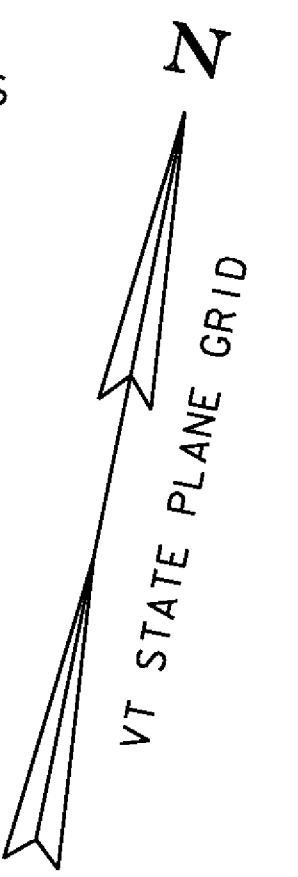

CONSTRUCT STONE FILL, TYPE II BANK SLOPE

VT 15 STA 92+00.0 LT - VT 15 STA 92+52.7 LT
 TH 71 STA 30+33.3 LT - TH 71 STA 30+75.0 LT

CONSTRUCT GRASS-LINED DITCH

VT 15 STA 92+00.0 LT - VT 15 STA 92+52.7 LT

CONSTRUCT STONE-LINED DITCH, TYPE I

TH 71 STA 30+29.2 LT - TH 71 STA 30+75.0 LT
 TH 43 STA 40+45.6 LT - TH 43 STA 41+00.0 LT
 VT 15 STA 94+46.9 RT - VT 15 STA 95+06.0 RT
~~VT 15 STA 95+52.3 LT - VT 15 STA 96+00.0 LT~~

BRIDGE RAILING, GALVANIZED 3 RAIL BOX BEAM

VT 15 STA 93+08.6 RT - VT 15 STA 93+69.2 RT
 VT 15 STA 93+20.8 LT - VT 15 STA 93+81.4 LT

HD STEEL BEAM GUARDRAIL, GALVANIZED

VT 15 STA 92+00.0 RT - VT 15 STA 92+03.5 RT

BOX BEAM GUARDRAIL

TH 71 STA 30+33.2 RT - TH 71 STA 30+42.6 RT
~~VT 15 STA 92+73.2 RT - VT 15 STA 92+76.6 RT~~
 VT 15 STA 94+00.4 RT - TH 43 STA 40+71.7 RT
 VT 15 STA 94+13.4 LT - VT 15 STA 95+83.9 LT

**GUARDRAIL APPROACH SECTION,
GALVANIZED 3 RAIL BOX BEAM**

VT 15 STA 92+76.6 RT - VT 15 STA 93+08.6 RT
 TH 71 STA 30+33.2 RT - VT 15 STA 93+20.8 LT
 VT 15 STA 93+69.2 RT - VT 15 STA 94+00.4 RT
 VT 15 STA 93+81.4 LT - VT 15 STA 94+13.4 LT

REMOVAL AND DISPOSAL OF GUARDRAIL

VT 15 STA 92+00.0 RT - VT 15 STA 93+22.4 RT
 VT 15 STA 93+03.4 LT - VT 15 STA 93+33.2 LT
 VT 15 STA 93+54.5 RT - VT 15 STA 94+08.1 RT
 VT 15 STA 93+69.2 LT - VT 15 STA 95+88.3 LT

**SPECIAL PROVISION (GUARDRAIL TRANSITION,
STEEL BEAM TO BOX BEAM)**

VT 15 STA 92+03.5 RT - VT 15 STA 92+73.2 RT

RETAINING WALL

VT 15 STA 92+83.1 RT - VT 15 STA 92+98.1 RT

PROJECT NAME: JOHNSON	PLOT DATE: 11-JUL-2014
PROJECT NUMBER: BRF 030-2(26)	DRAWN BY: G. ROY
FILE NAME: s88bi93bdr.dgn	CHECKED BY: H. SALLS
PROJECT LEADER: C. CARLSON	SHEET 14 OF 69
DESIGNED BY: G. ROY	
LAYOUT (2)	

