



PROFILE ALONG TH 71

HORIZONTAL SCALE: 1" = 20'-0"
 VERTICAL SCALE: 1" = 10'-0"

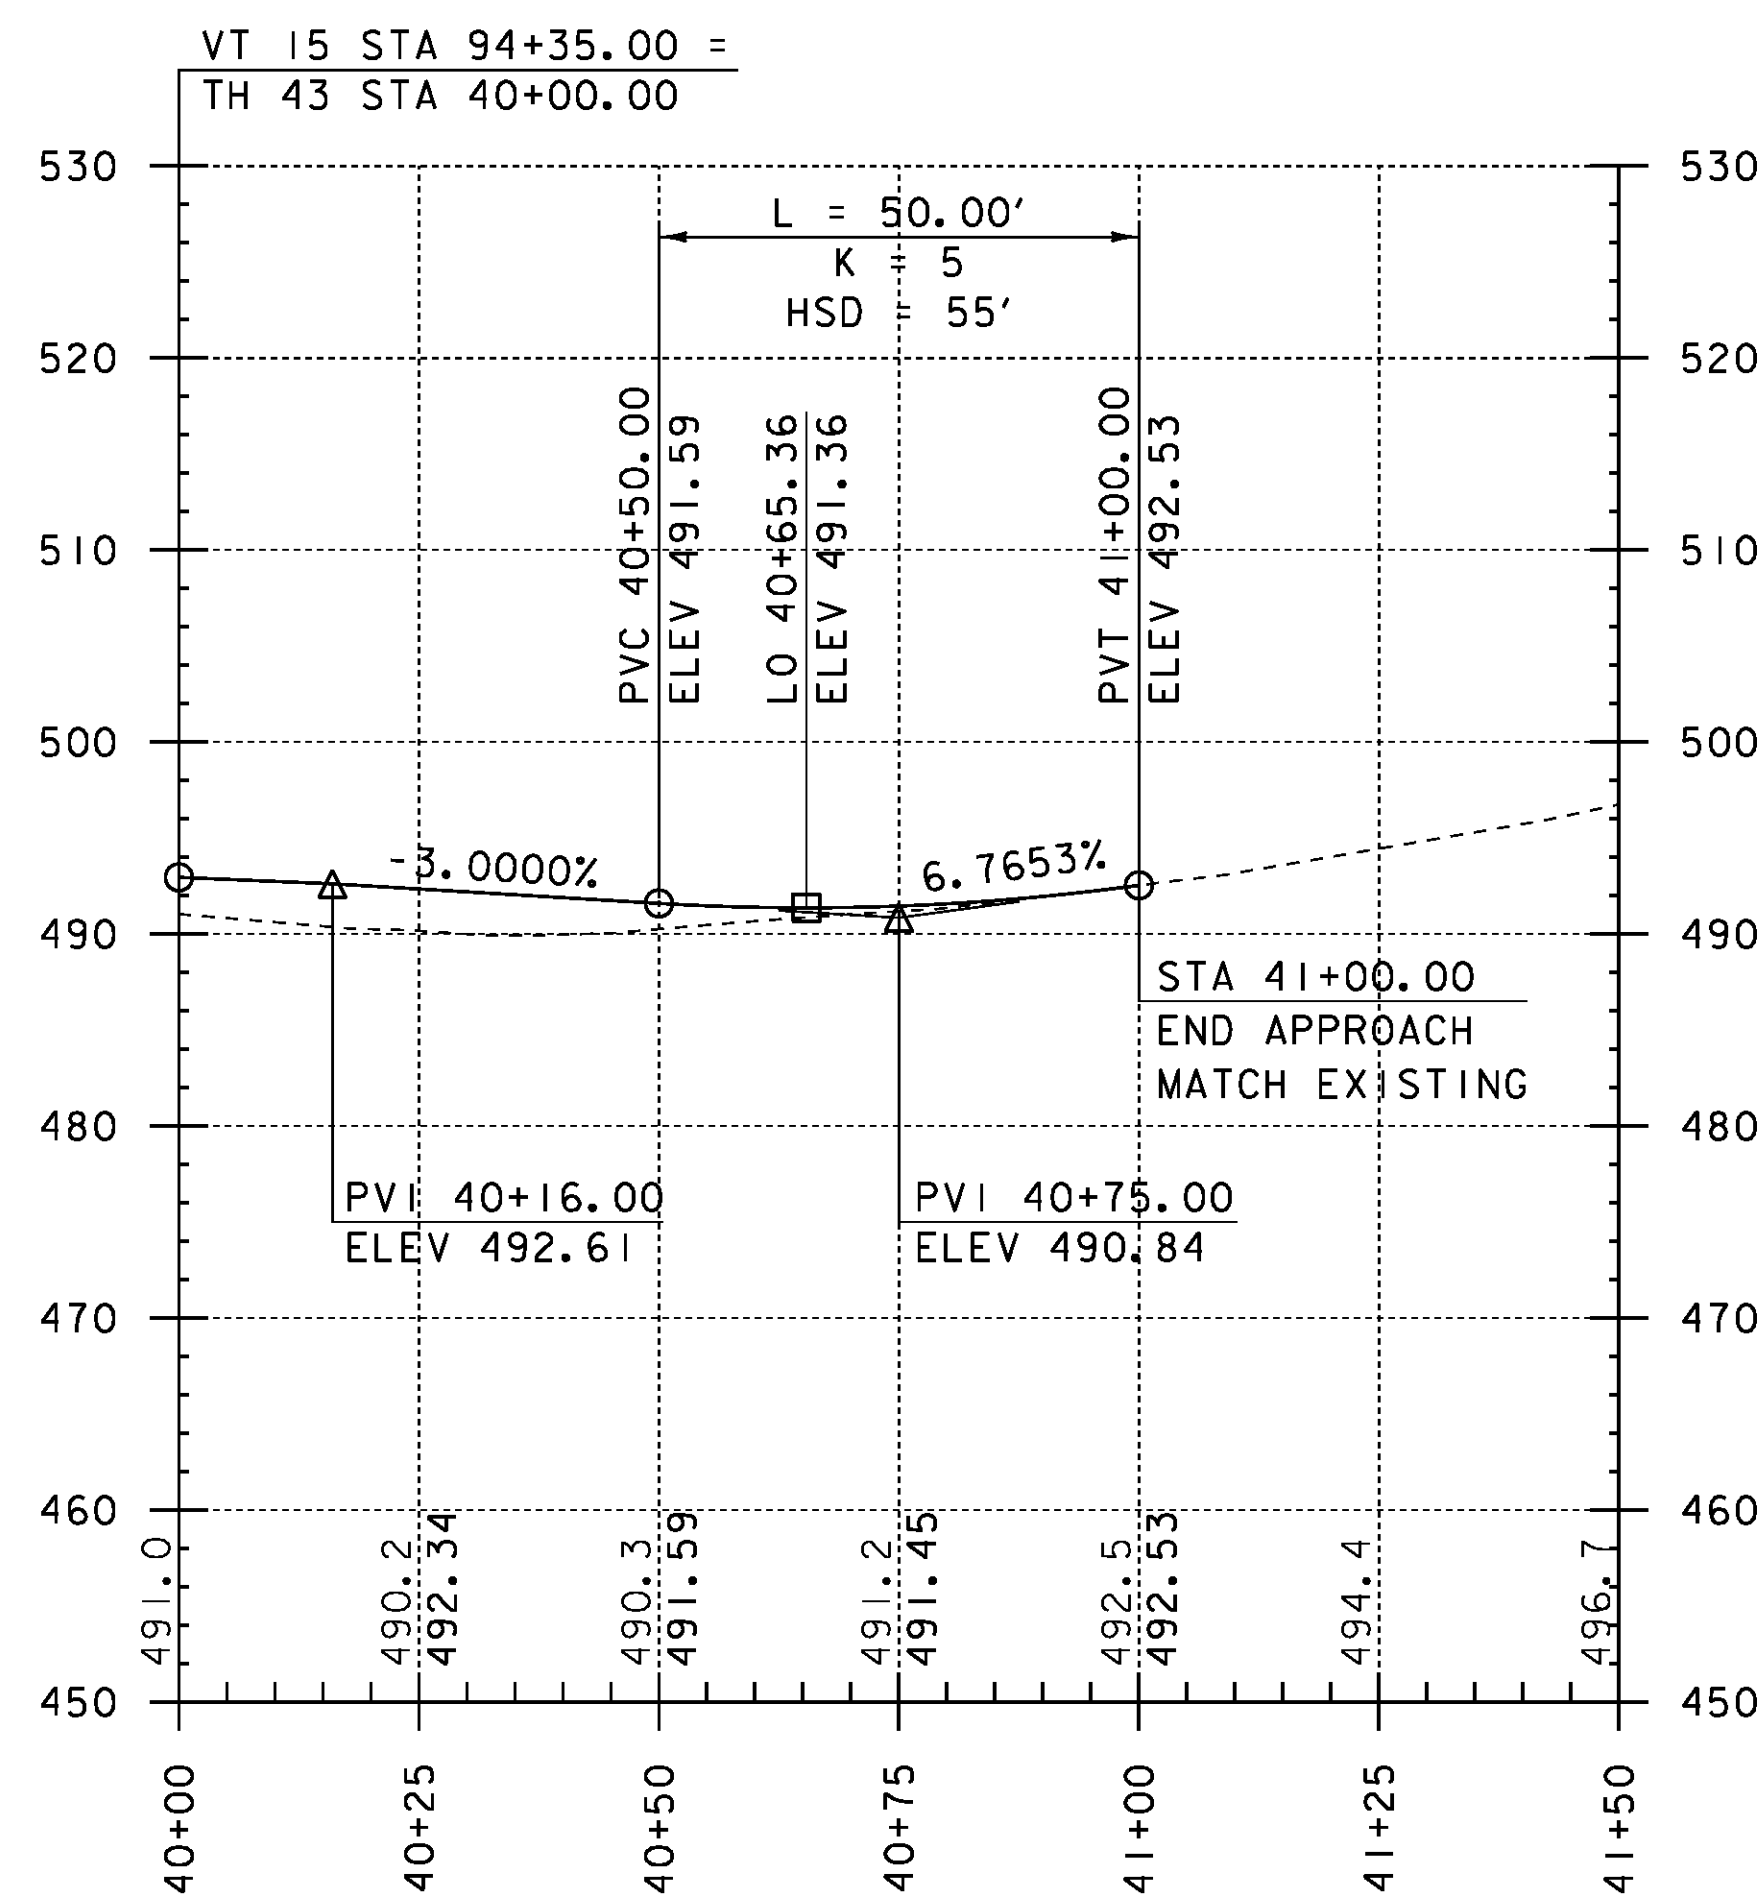

PROFILE ALONG TH 43


HORIZONTAL SCALE: 1" = 20'-0"
 VERTICAL SCALE: 1" = 10'-0"

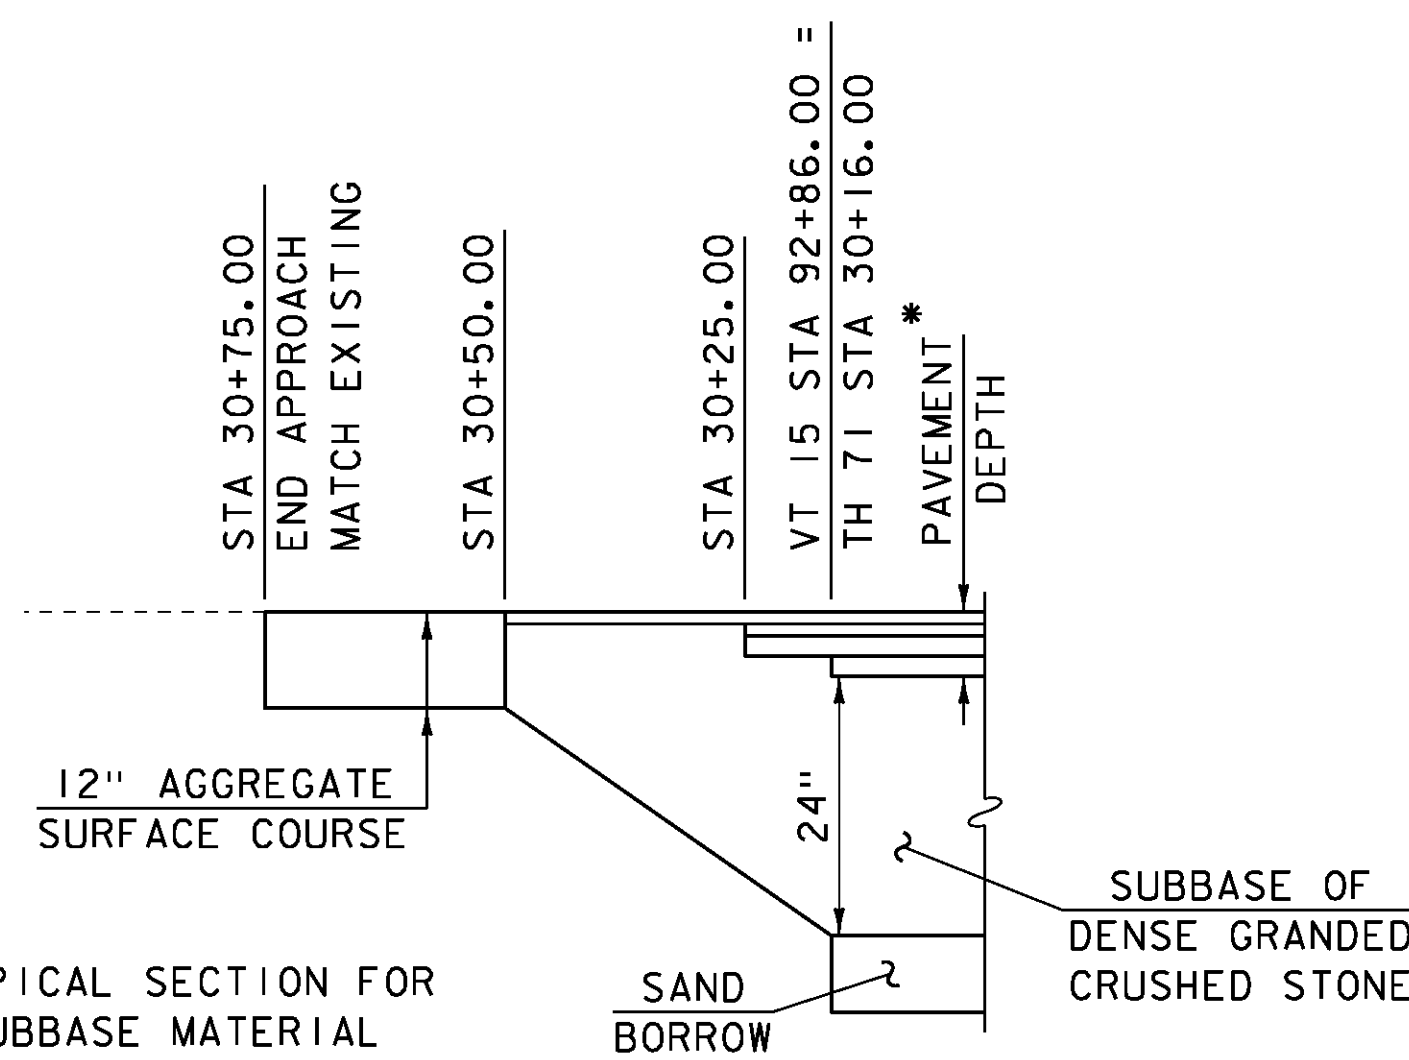

*SEE ROADWAY TYPICAL SECTION FOR PAVEMENT AND SUBBASE MATERIAL DESIGN INFORMATION.

TH 71 MATERIAL TRANSITION

HORIZONTAL SCALE: 1" = 20'-0"
 VERTICAL SCALE: 1" = 2'-0"

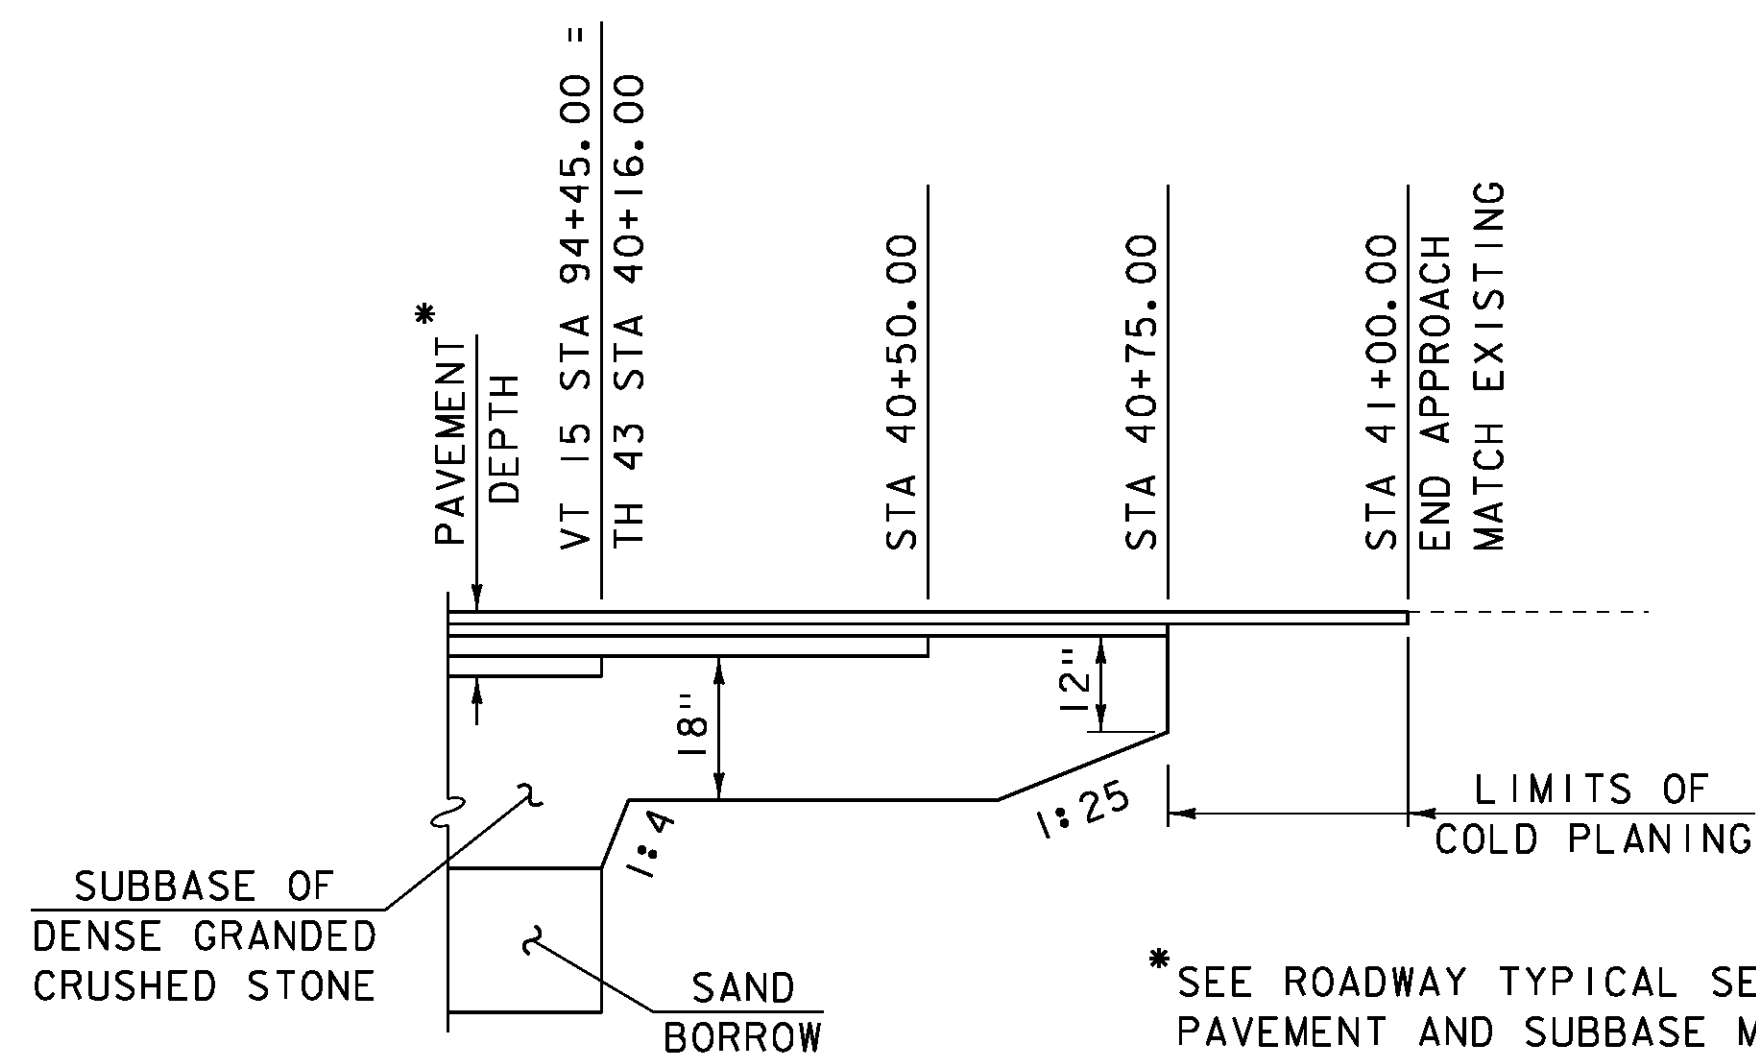

*SEE ROADWAY TYPICAL SECTION FOR PAVEMENT AND SUBBASE MATERIAL DESIGN INFORMATION.

TH 43 MATERIAL TRANSITION

HORIZONTAL SCALE: 1" = 20'-0"
 VERTICAL SCALE: 1" = 2'-0"

PROJECT NAME: JOHNSON
 PROJECT NUMBER: BRF 030-2(26)

FILE NAME: s88bl93pro.dgn PLOT DATE: 10-JUN-2014
 PROJECT LEADER: C. CARLSON DRAWN BY: G. ROY
 DESIGNED BY: H. SALLS CHECKED BY: H. SALLS
 TH 71 AND TH 43 PROFILES AND MATERIAL TRANSITIONS SHEET 17 OF 69