


APPROXIMATE LOCATION OF EXISTING AERIAL UTILITY FACILITY OWNED BY JOHNSON VILLAGE AND TELEPHONE OPERATING COMPANY OF VERMONT, L.L.C.

APPROXIMATE RELOCATION OF AERIAL UTILITY FACILITIES OWNED BY TELEPHONE OPERATING COMPANY OF VERMONT, L.L.C. AND COMCAST

APPROXIMATE LOCATION OF AERIAL UTILITY FACILITIES OWNED BY TELEPHONE OPERATING COMPANY OF VERMONT, L.L.C. AND COMCAST

APPROXIMATE LOCATION OF EXISTING AERIAL FACILITIES OWNED BY COMCAST & VERMONT ELECTRIC COOPERATIVE, INC. (NOTE: VERMONT ELECTRIC COOPERATIVE, INC. WILL REMOVE THE SINGLE PHASE POWER LINE AND NEUTRAL LINE DURING CONSTRUCTION AND REATTACH AFTER CONSTRUCTION)

APPROXIMATE RELOCATION OF AERIAL UTILITY FACILITIES OWNED BY COMCAST (TO BE DONE BY OTHERS)

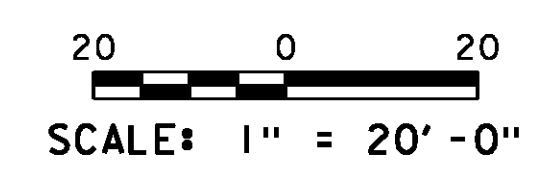

NOTE: SEE THE UTILITY SPECIAL PROVISIONS FOR ADDITIONAL INFORMATION AND REQUIREMENTS.

PROJECT NAME:	JOHNSON	PLOT DATE:	10-JUN-2014
PROJECT NUMBER:	BRF 030-2(26)	DRAWN BY:	G. ROY
FILE NAME:	s88b193bdr_util.dgn	CHECKED BY:	H. SALLS
PROJECT LEADER:	C. CARLSON	UTILITY LAYOUT (2)	SHEET 19 OF 69
DESIGNED BY:	G. ROY		