
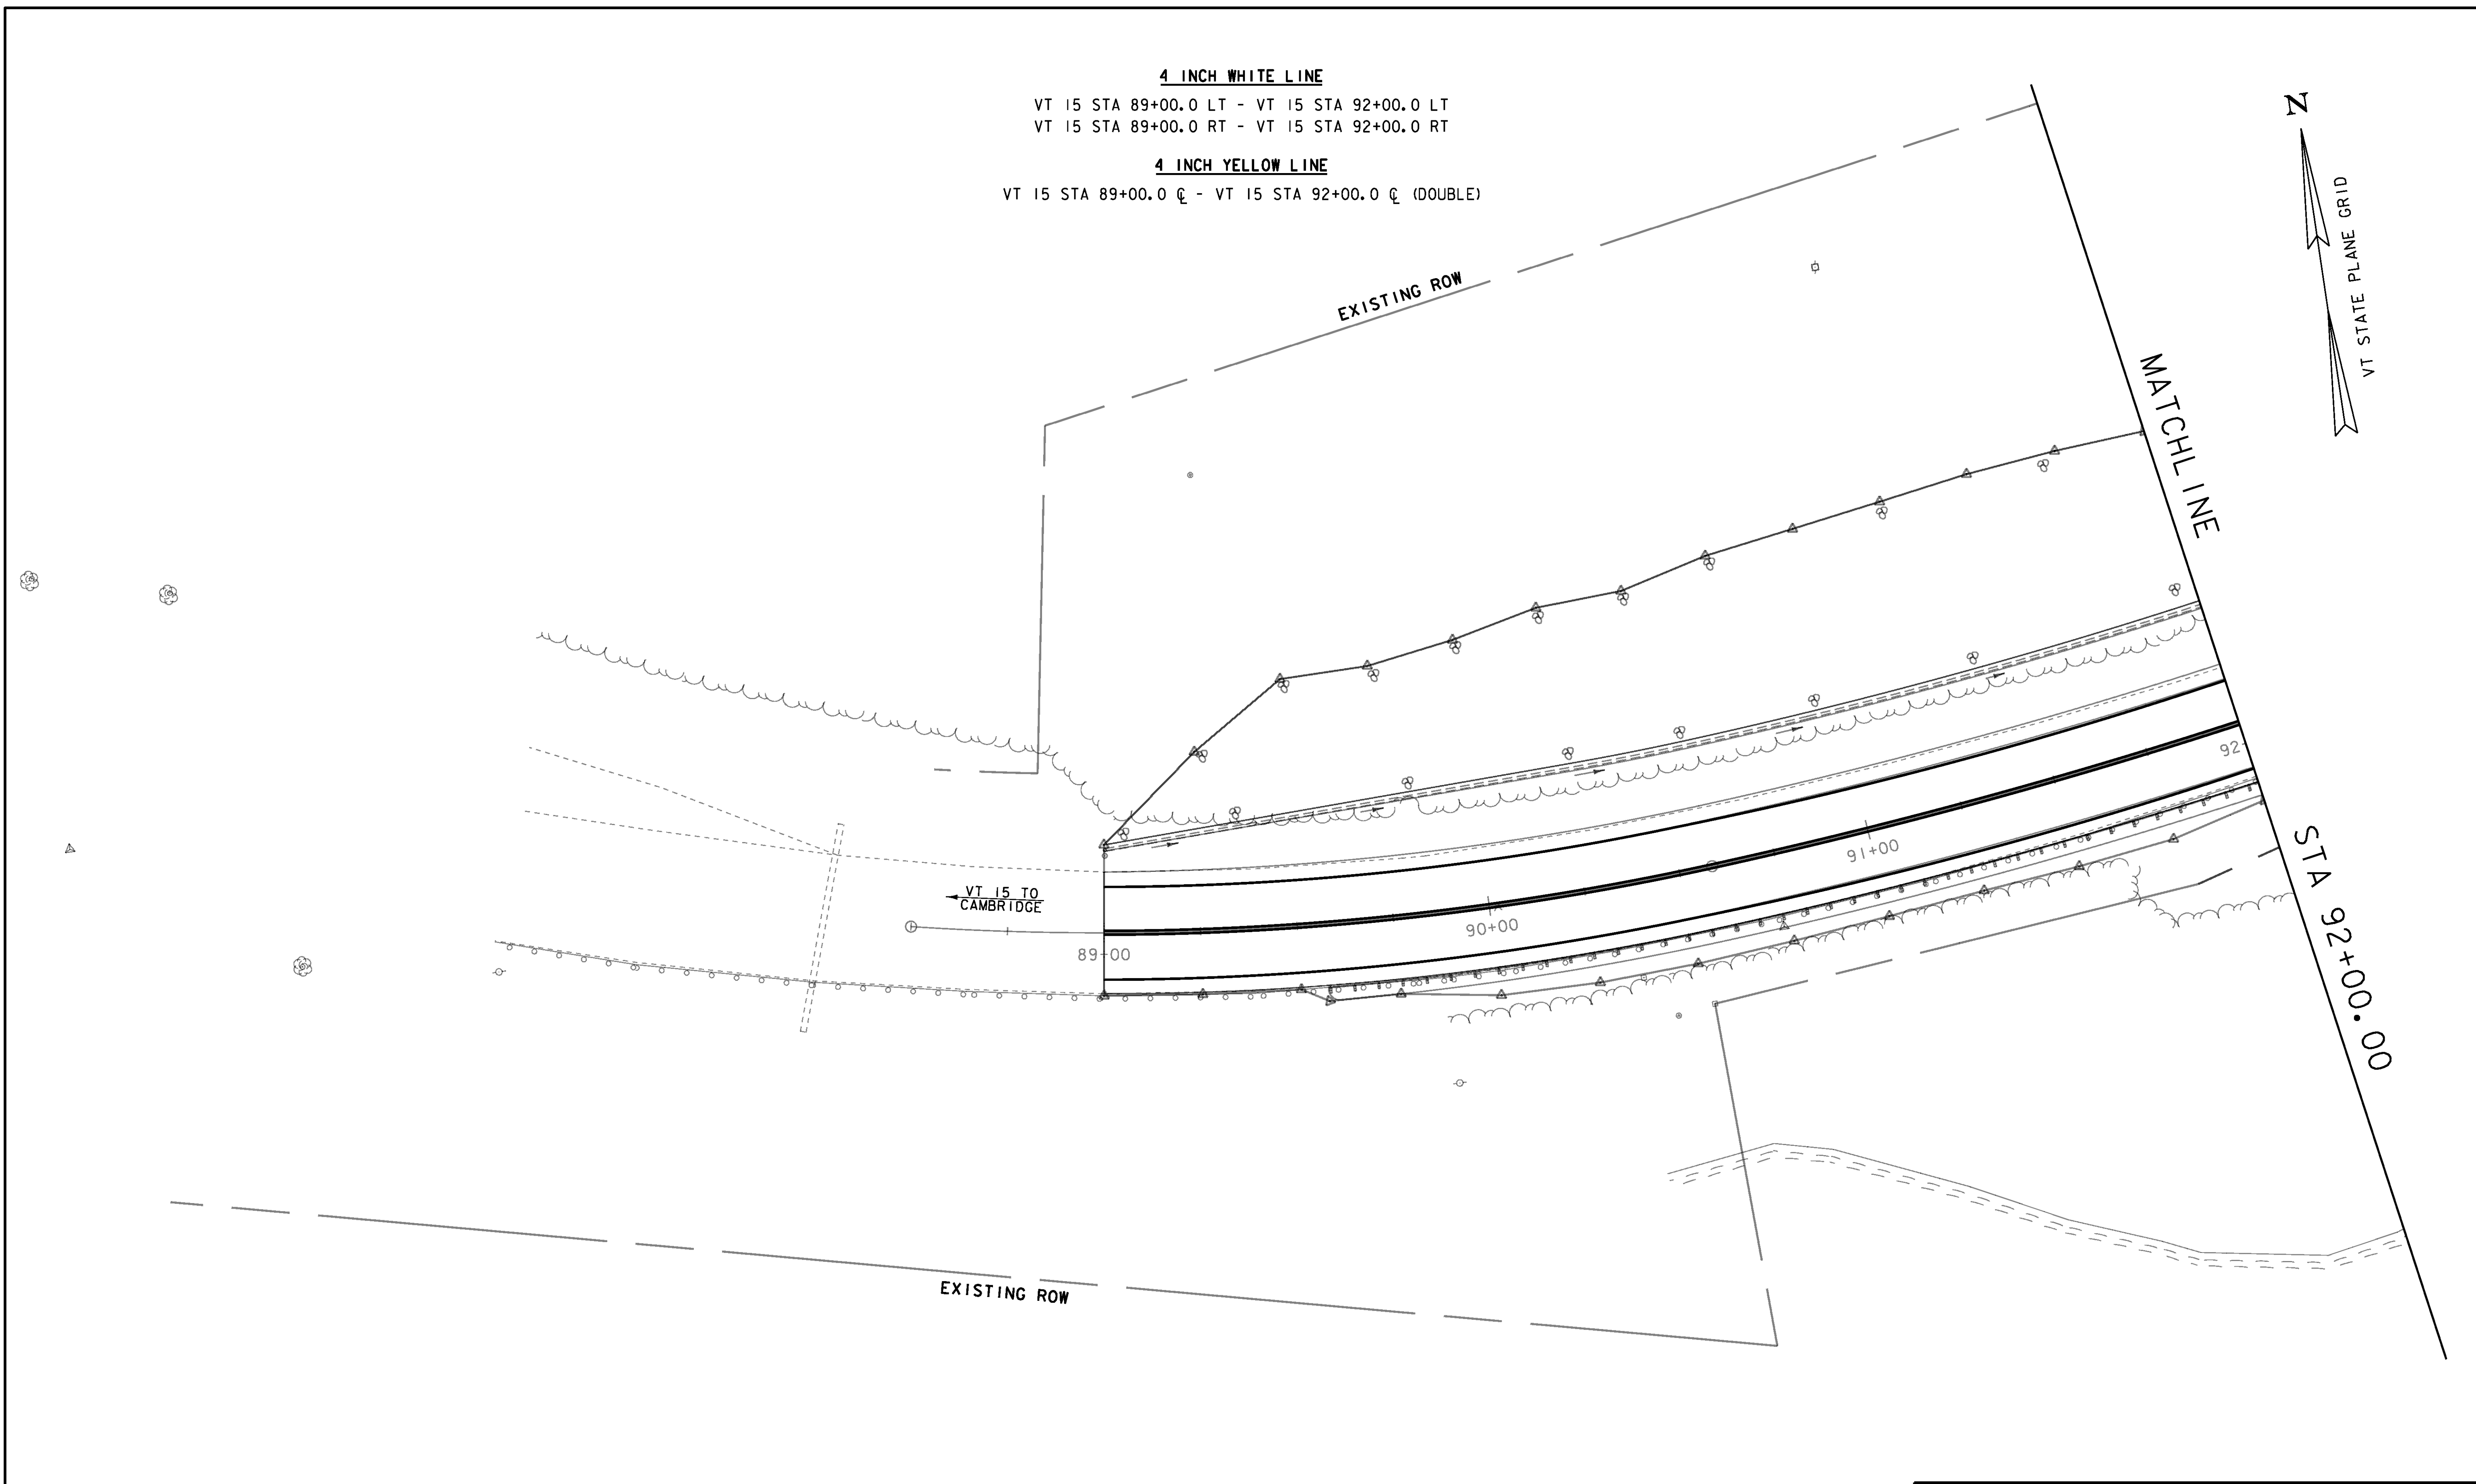


**4 INCH WHITE LINE**

VT 15 STA 89+00.0 LT - VT 15 STA 92+00.0 LT  
VT 15 STA 89+00.0 RT - VT 15 STA 92+00.0 RT

**4 INCH YELLOW LINE**

VT 15 STA 89+00.0 C - VT 15 STA 92+00.0 C (DOUBLE)

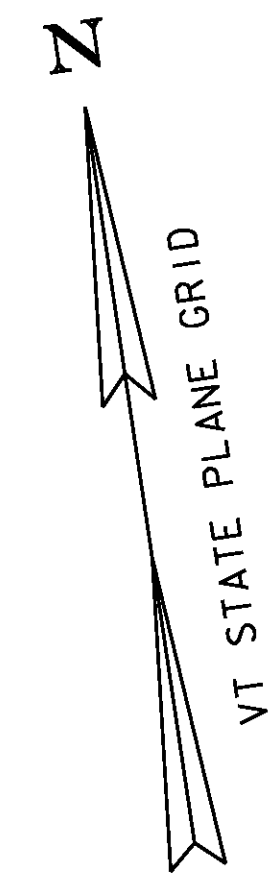

20 0 20  
SCALE: 1" = 20'-0"

PROJECT NAME: JOHNSON	PLOT DATE: 10-JUN-2014
PROJECT NUMBER: BRF 030-2(26)	DRAWN BY: R. PELLETT
FILE NAME: s88b193sign.dgn	CHECKED BY: H. SALLS
PROJECT LEADER: C. CARLSON	SHEET 20 OF 69
DESIGNED BY: H. SALLS	
SIGNS & PAVEMENT MARKINGS (I)	