



4 INCH WHITE LINE
 VT 15 STA 92+00.0 LT - TH 71 STA 30+32.0 LT
 VT 15 STA 92+00.0 RT - TH 43 STA 40+32.0 RT
 TH 71 STA 30+32.0 RT - VT 15 STA 96+00.0 LT
 TH 43 STA 40+32.0 LT - VT 15 STA 96+00.0 RT

4 INCH YELLOW LINE
 VT 15 STA 92+00.0 C - VT 15 STA 92+66.0 C (DOUBLE)
 TH 71 STA 30+20.0 C - TH 71 STA 30+32.0 C (DOUBLE)
 VT 15 STA 93+06.0 C - VT 15 STA 94+19.0 C (DOUBLE)
 TH 43 STA 40+20.0 C - TH 43 STA 40+32.0 C (DOUBLE)
 VT 15 STA 94+65.0 C - VT 15 STA 96+00.0 C (DOUBLE)

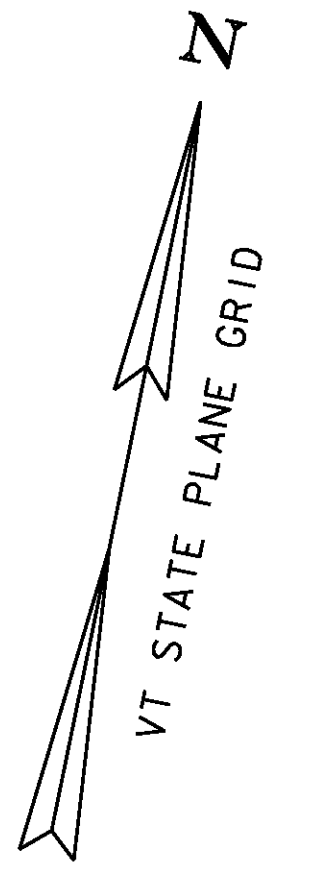

MATCHLINE

STA 92+00.00

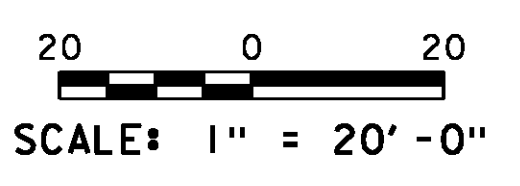

TRAFFIC SIGNS, TYPE A
 TH 71 STA 30+20.0 LT (2 EA)
 TH 71 STA 30+35.0 RT (1 EA)
 TH 71 STA 30+40.0 RT (1 EA)
 TH 43 STA 40+20.0 LT (2 EA)
 TH 43 STA 40+32.0 RT (1 EA)
 TH 43 STA 40+89.0 RT (1 EA)

REMOVING SIGNS
 TH 71 STA 30+34.9 RT (1 EA)
 TH 71 STA 30+39.3 RT (1 EA)
 TH 71 STA 30+40.7 LT (2 EA)
 TH 43 STA 40+40.6 LT (2 EA)
 TH 43 STA 40+47.8 RT (1 EA)
 TH 43 STA 40+89.8 RT (1 EA)

LEGEND
 R: REMOVE
 R&S: REMOVE AND SALVAGE
 RET: RETAIN
 N: NEW
 S: SALVAGE

PROJECT NAME: JOHNSON
 PROJECT NUMBER: BRF 030-2(26)
 FILE NAME: s88bl93sign.dgn
 PROJECT LEADER: C. CARLSON
 DESIGNED BY: H. SALLS
 SIGNS & PAVEMENT MARKINGS (2)

PLOT DATE: 10-JUN-2014
 DRAWN BY: R. PELLET
 CHECKED BY: H. SALLS
 SHEET 21 OF 69