


PLAN

SCALE 1" = 10'-0"  
 10 0 10

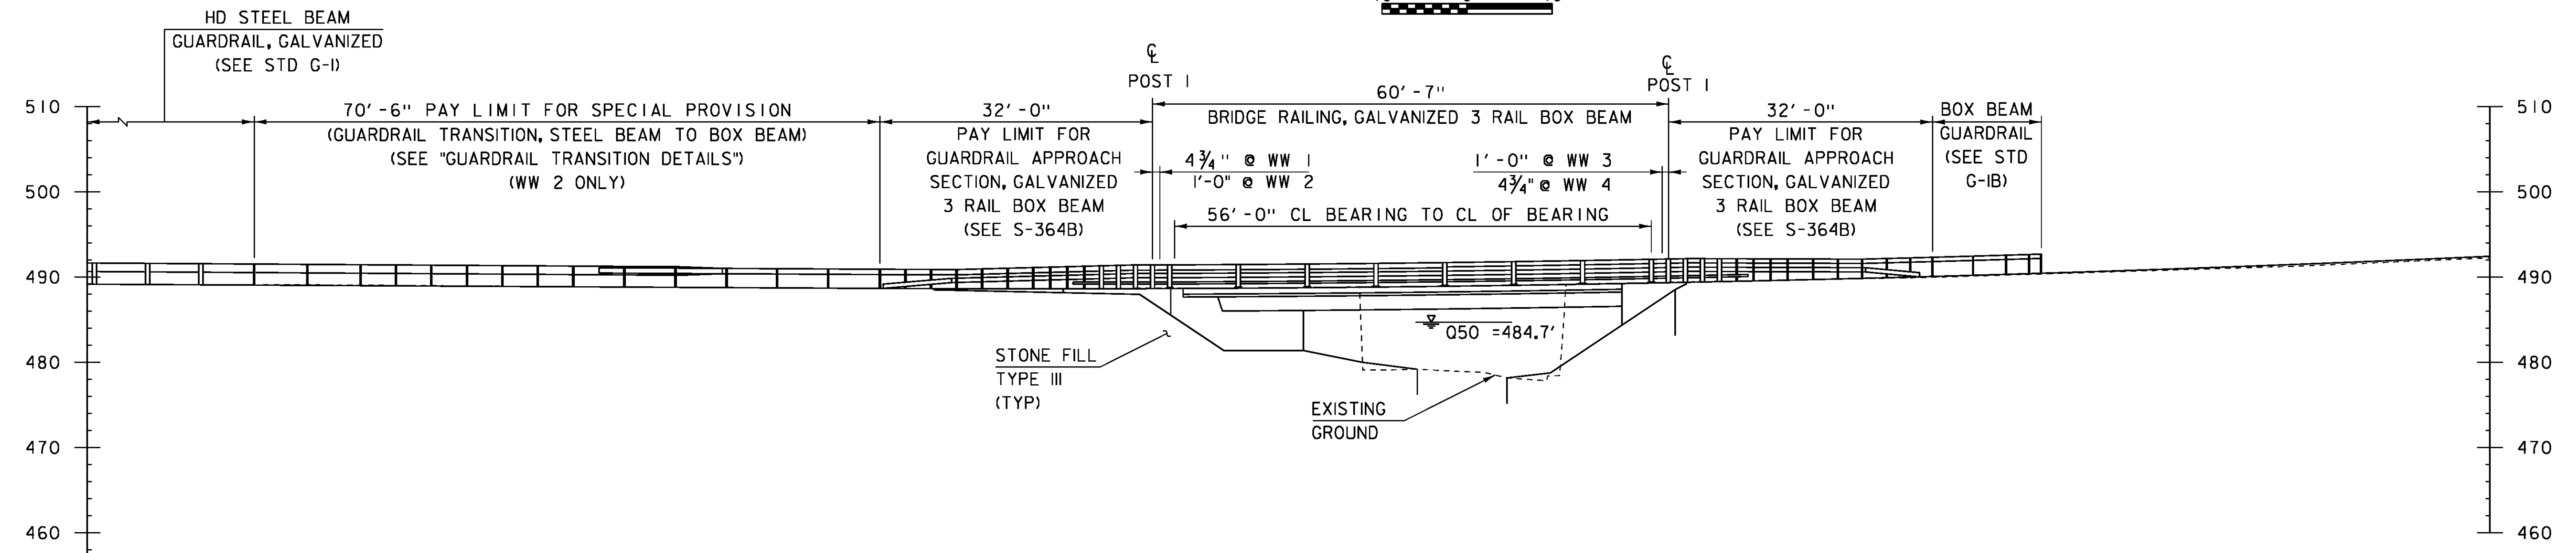

ELEVATION

SCALE 1" = 10'-0"  
 10 0 10

PROJECT NAME: JOHNSON	PLOT DATE: 10-JUN-2014
PROJECT NUMBER: BRF 030-2(26)	DRAWN BY: R. PELLETT
FILE NAME: s88b193pe.dgn	CHECKED BY: H. SALLS
PROJECT LEADER: C. CARLSON	SHEET 26 OF 69
DESIGNED BY: H. SALLS	