


BRIDGE TYPICAL SECTION

SCALE: 1/2" = 1'-0"

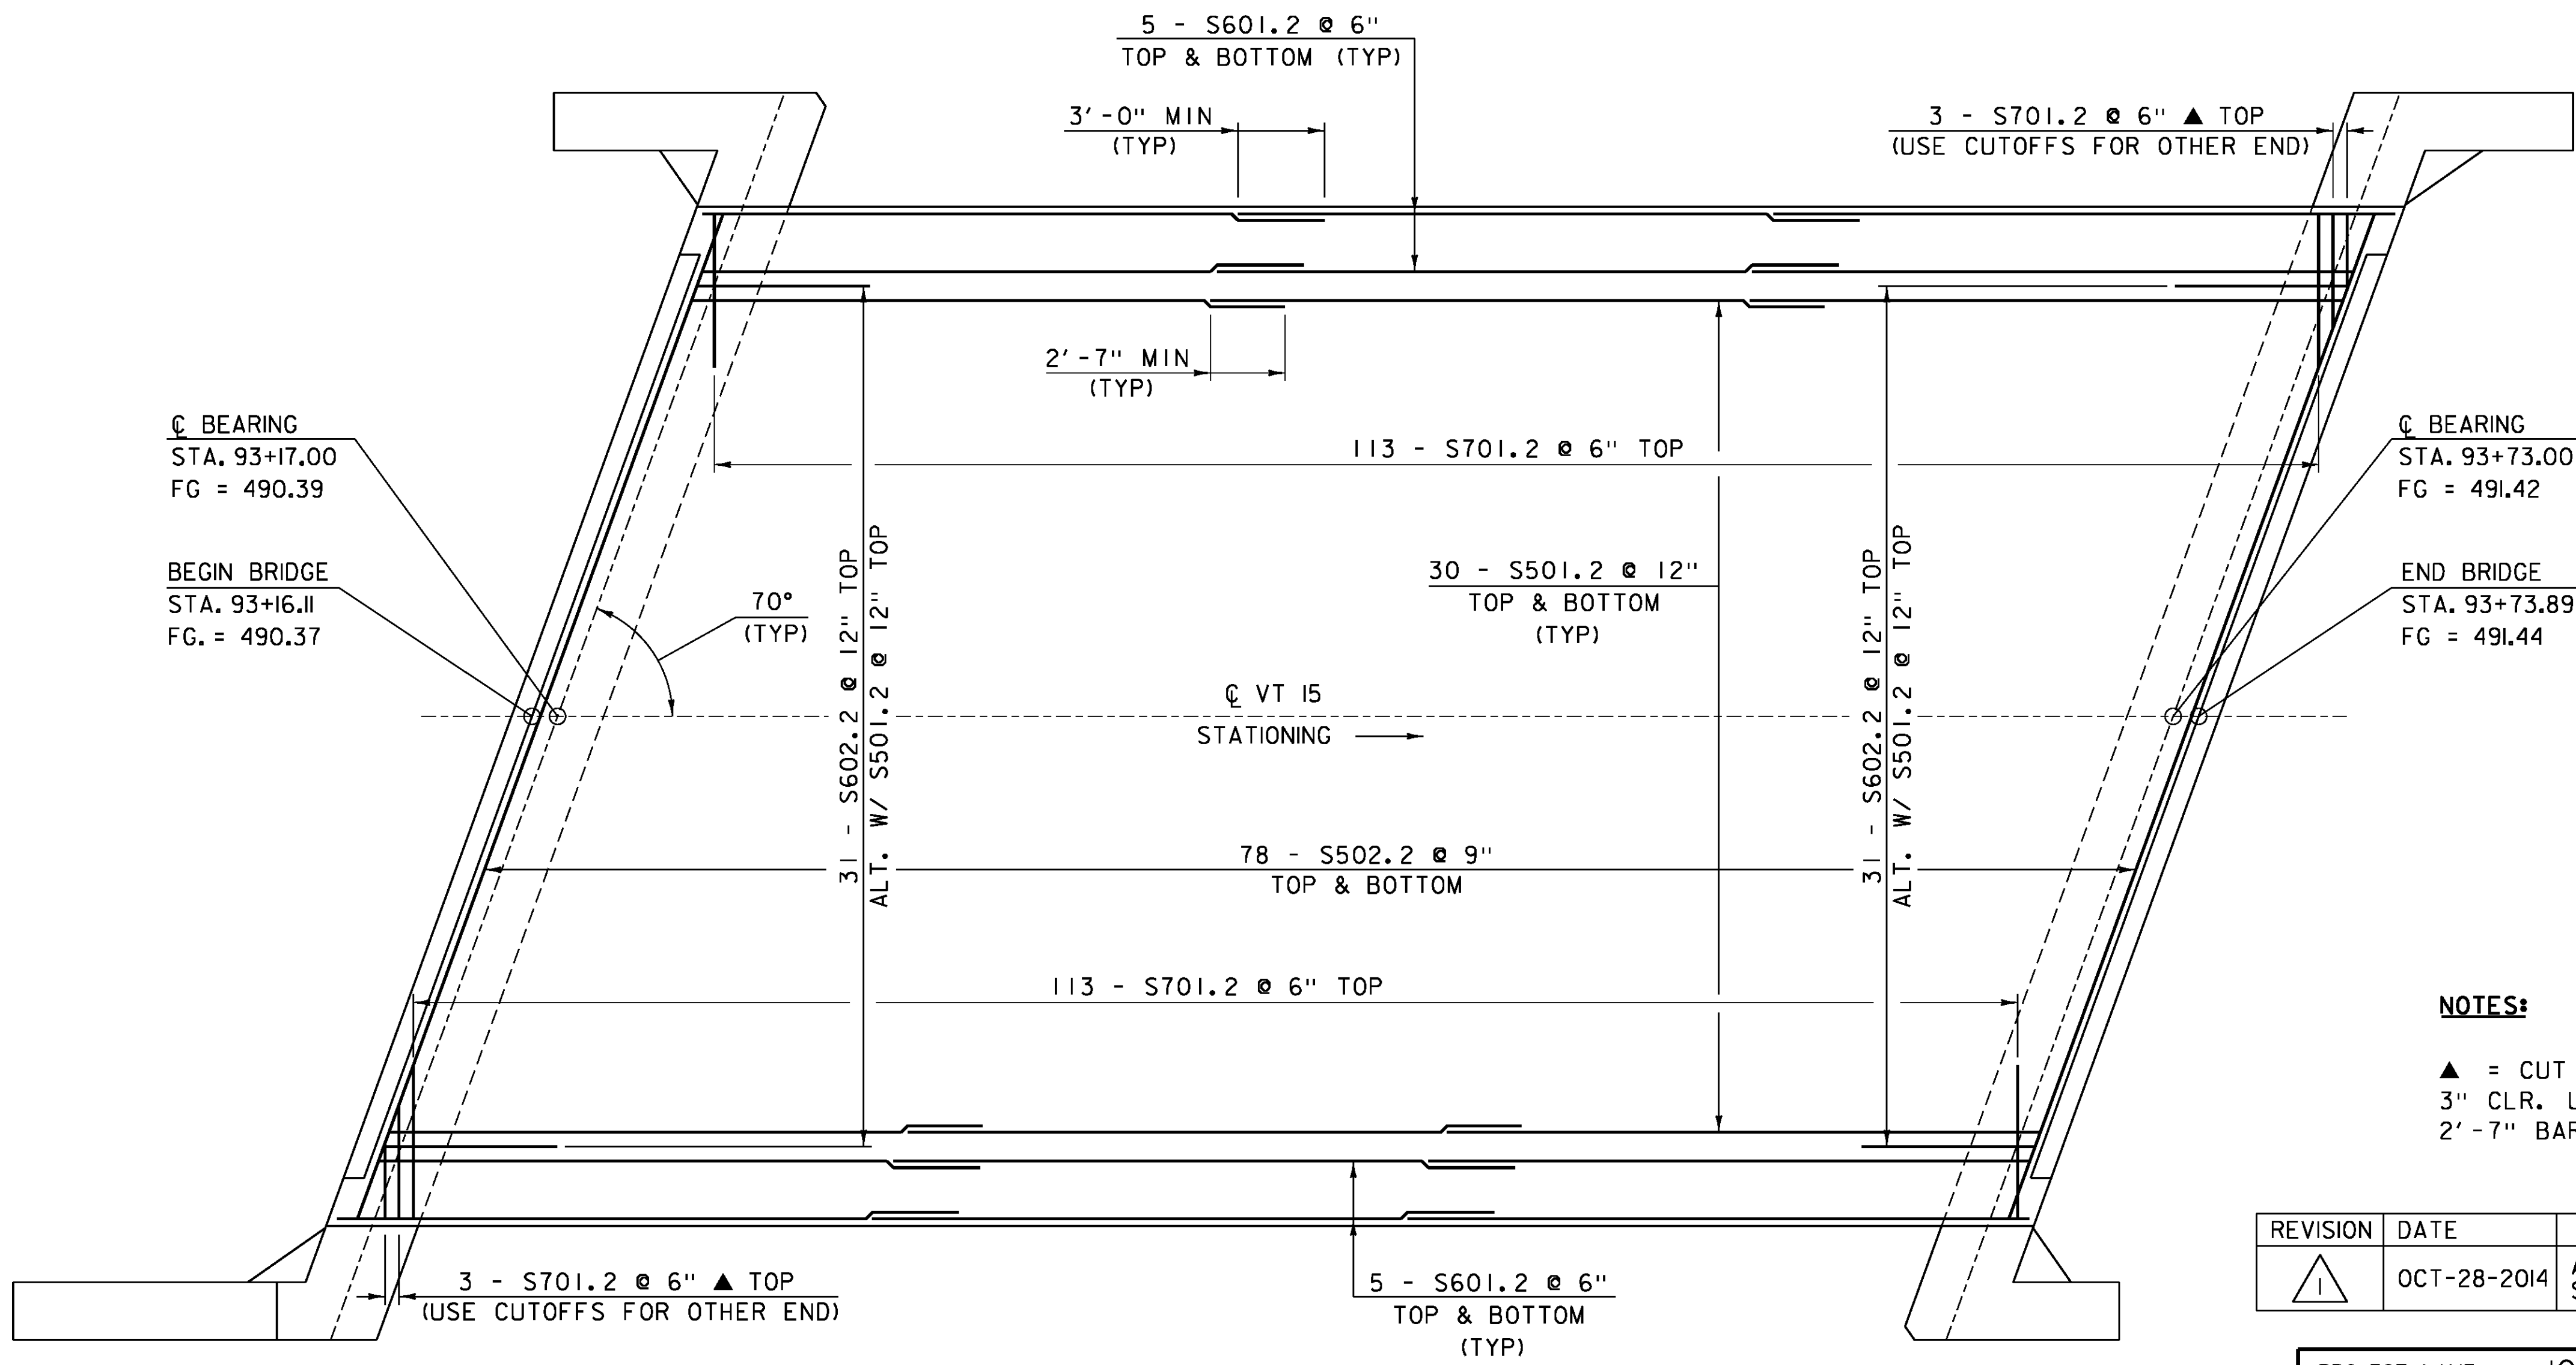

OVERLAY REINFORCING PLAN

SCALE: 1/4" = 1'-0"

NOTES:

- ▲ = CUT TO FIT IN FIELD
- 3" CLR. UNLESS OTHERWISE NOTED
- 2'-7" BAR LAP UNLESS OTHERWISE NOTED

REVISION	DATE	DESCRIPTION	BY
1	OCT-28-2014	ADD 3" PAYMENT, LOWER BRIDGE SEAT, ADD 3" CONCRETE PEDESTAL	GNR

PROJECT NAME:	JOHNSON
PROJECT NUMBER:	BRF 030-2(26)
FILE NAME:	s88bl93sup.dgn
PROJECT LEADER:	C. CARLSON
DESIGNED BY:	H. SALLS
BRIDGE DECK DETAILS	
PLOT DATE:	05-NOV-2014
DRAWN BY:	G. ROKES
CHECKED BY:	H. SALLS
SHEET	27 OF 69