




STEM END - SIDE ELEVATION
SCALE: 1" = 1'-0"

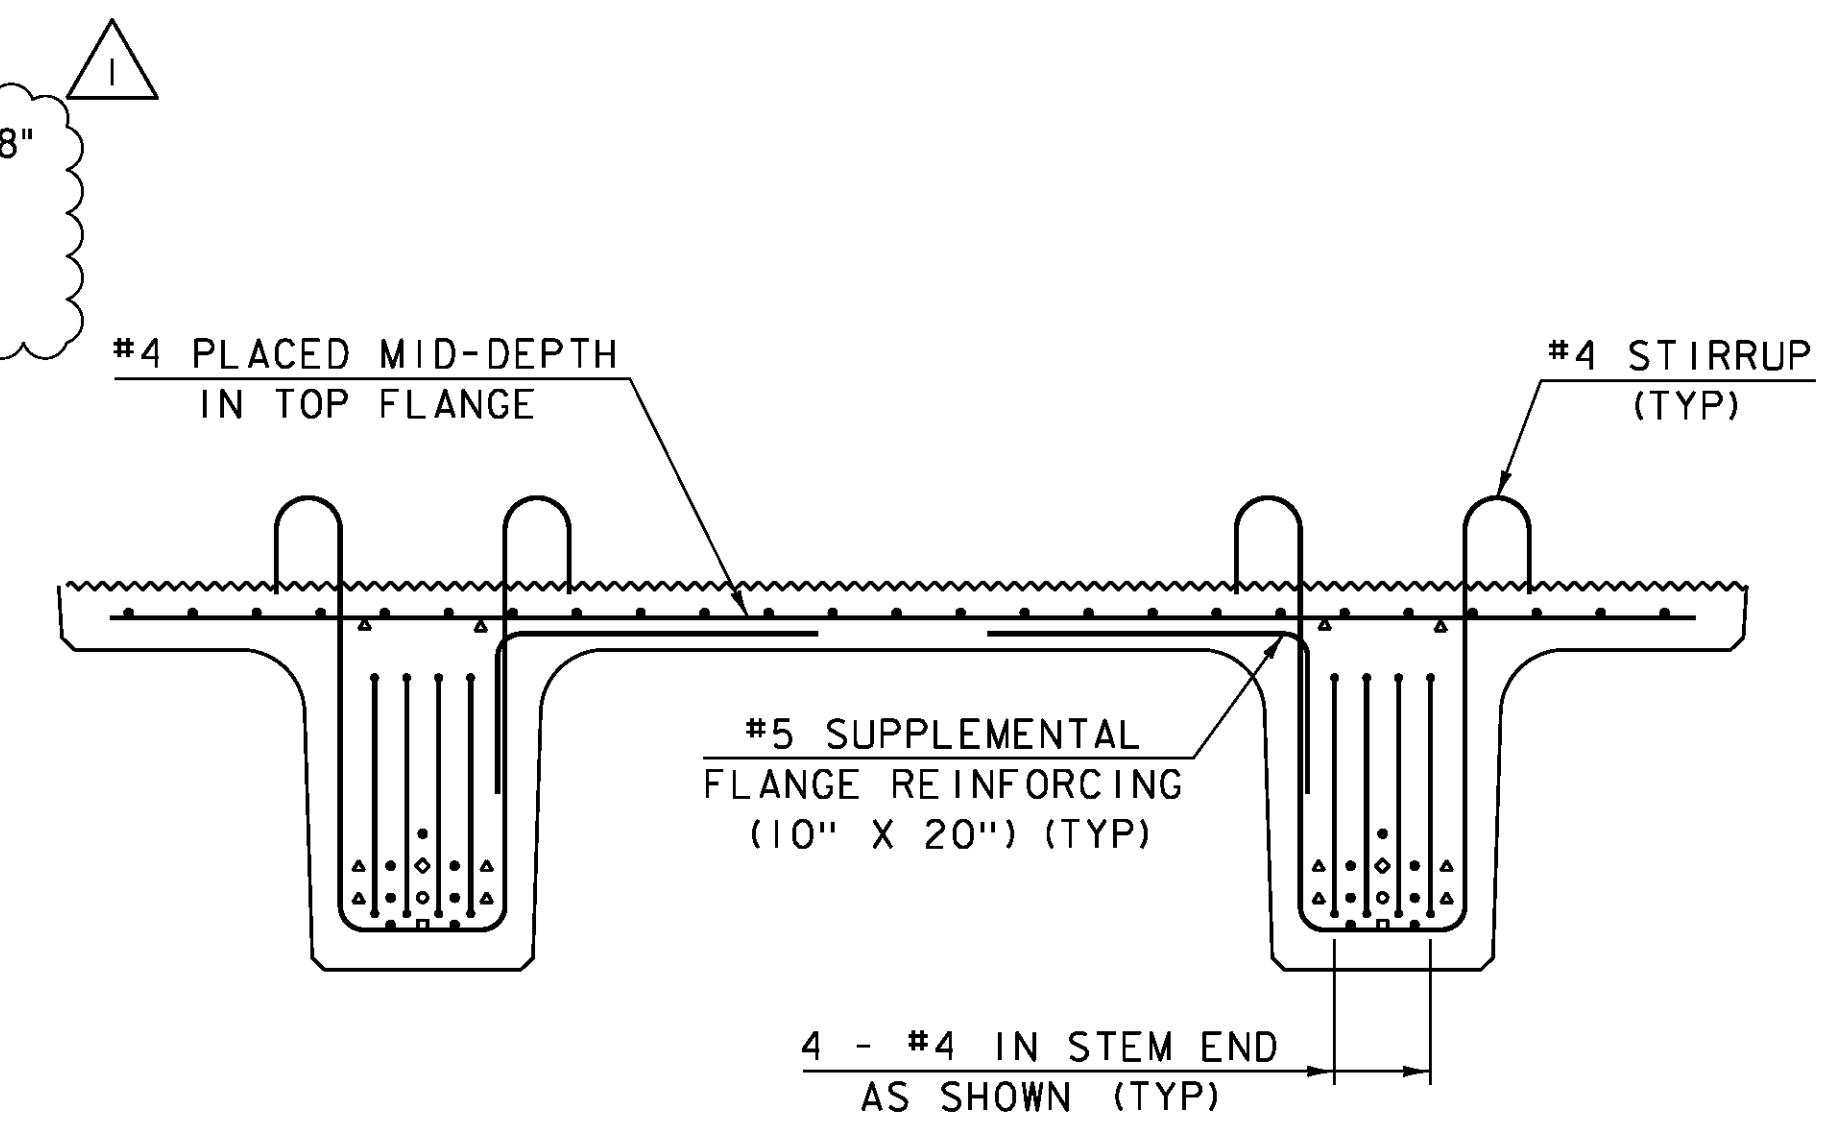


STEM END - END ELEVATION
SCALE: 1" = 1'-0"

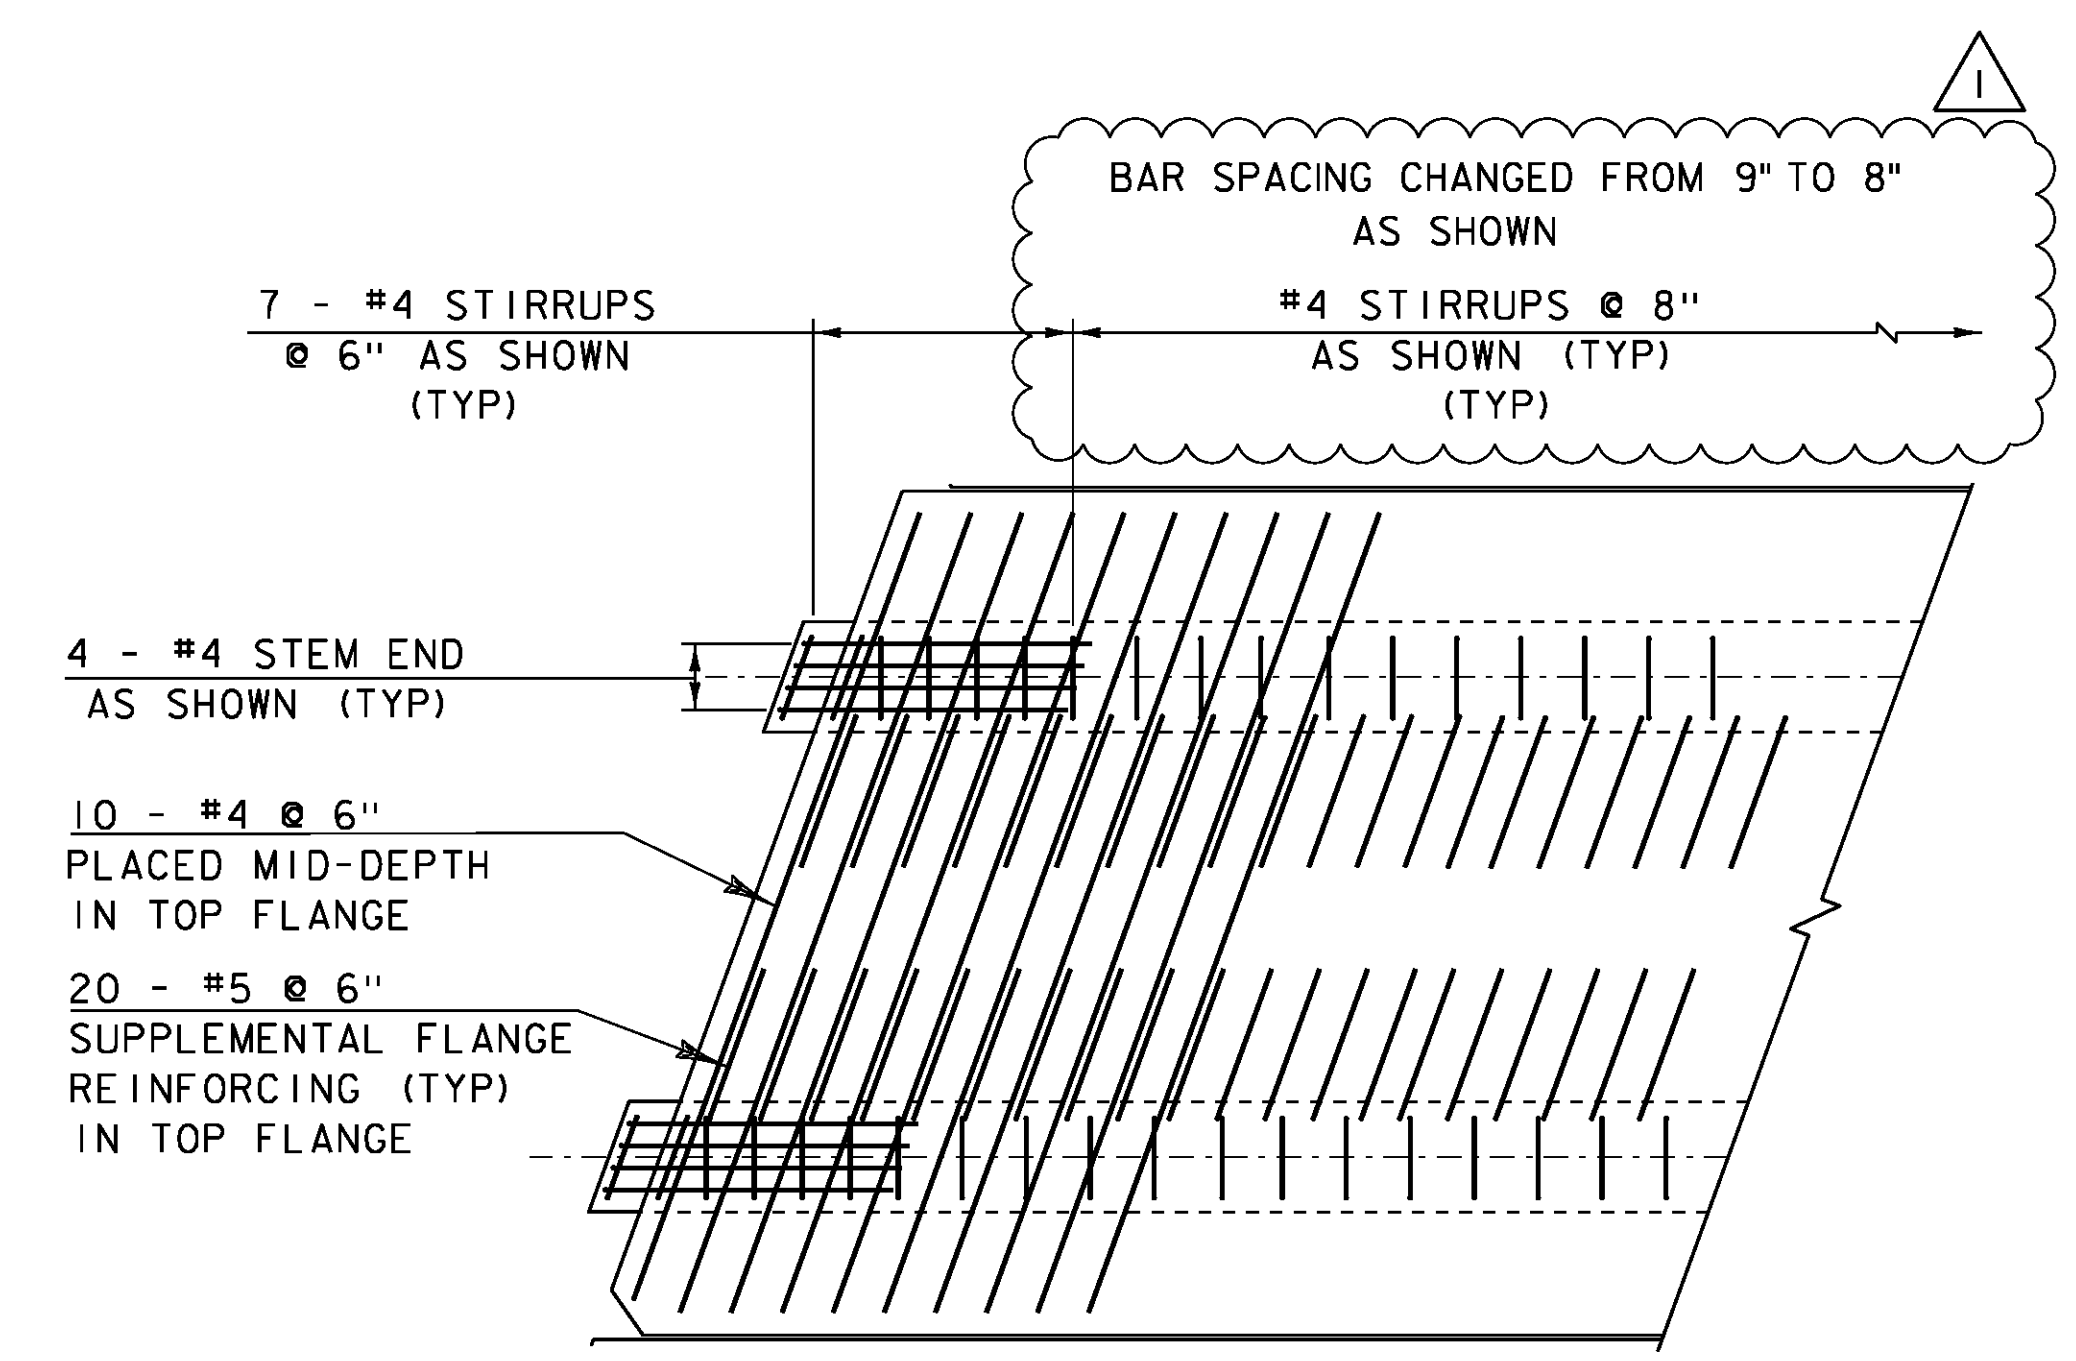

STEM END - PLAN
SCALE: 1/2" = 1'-0"

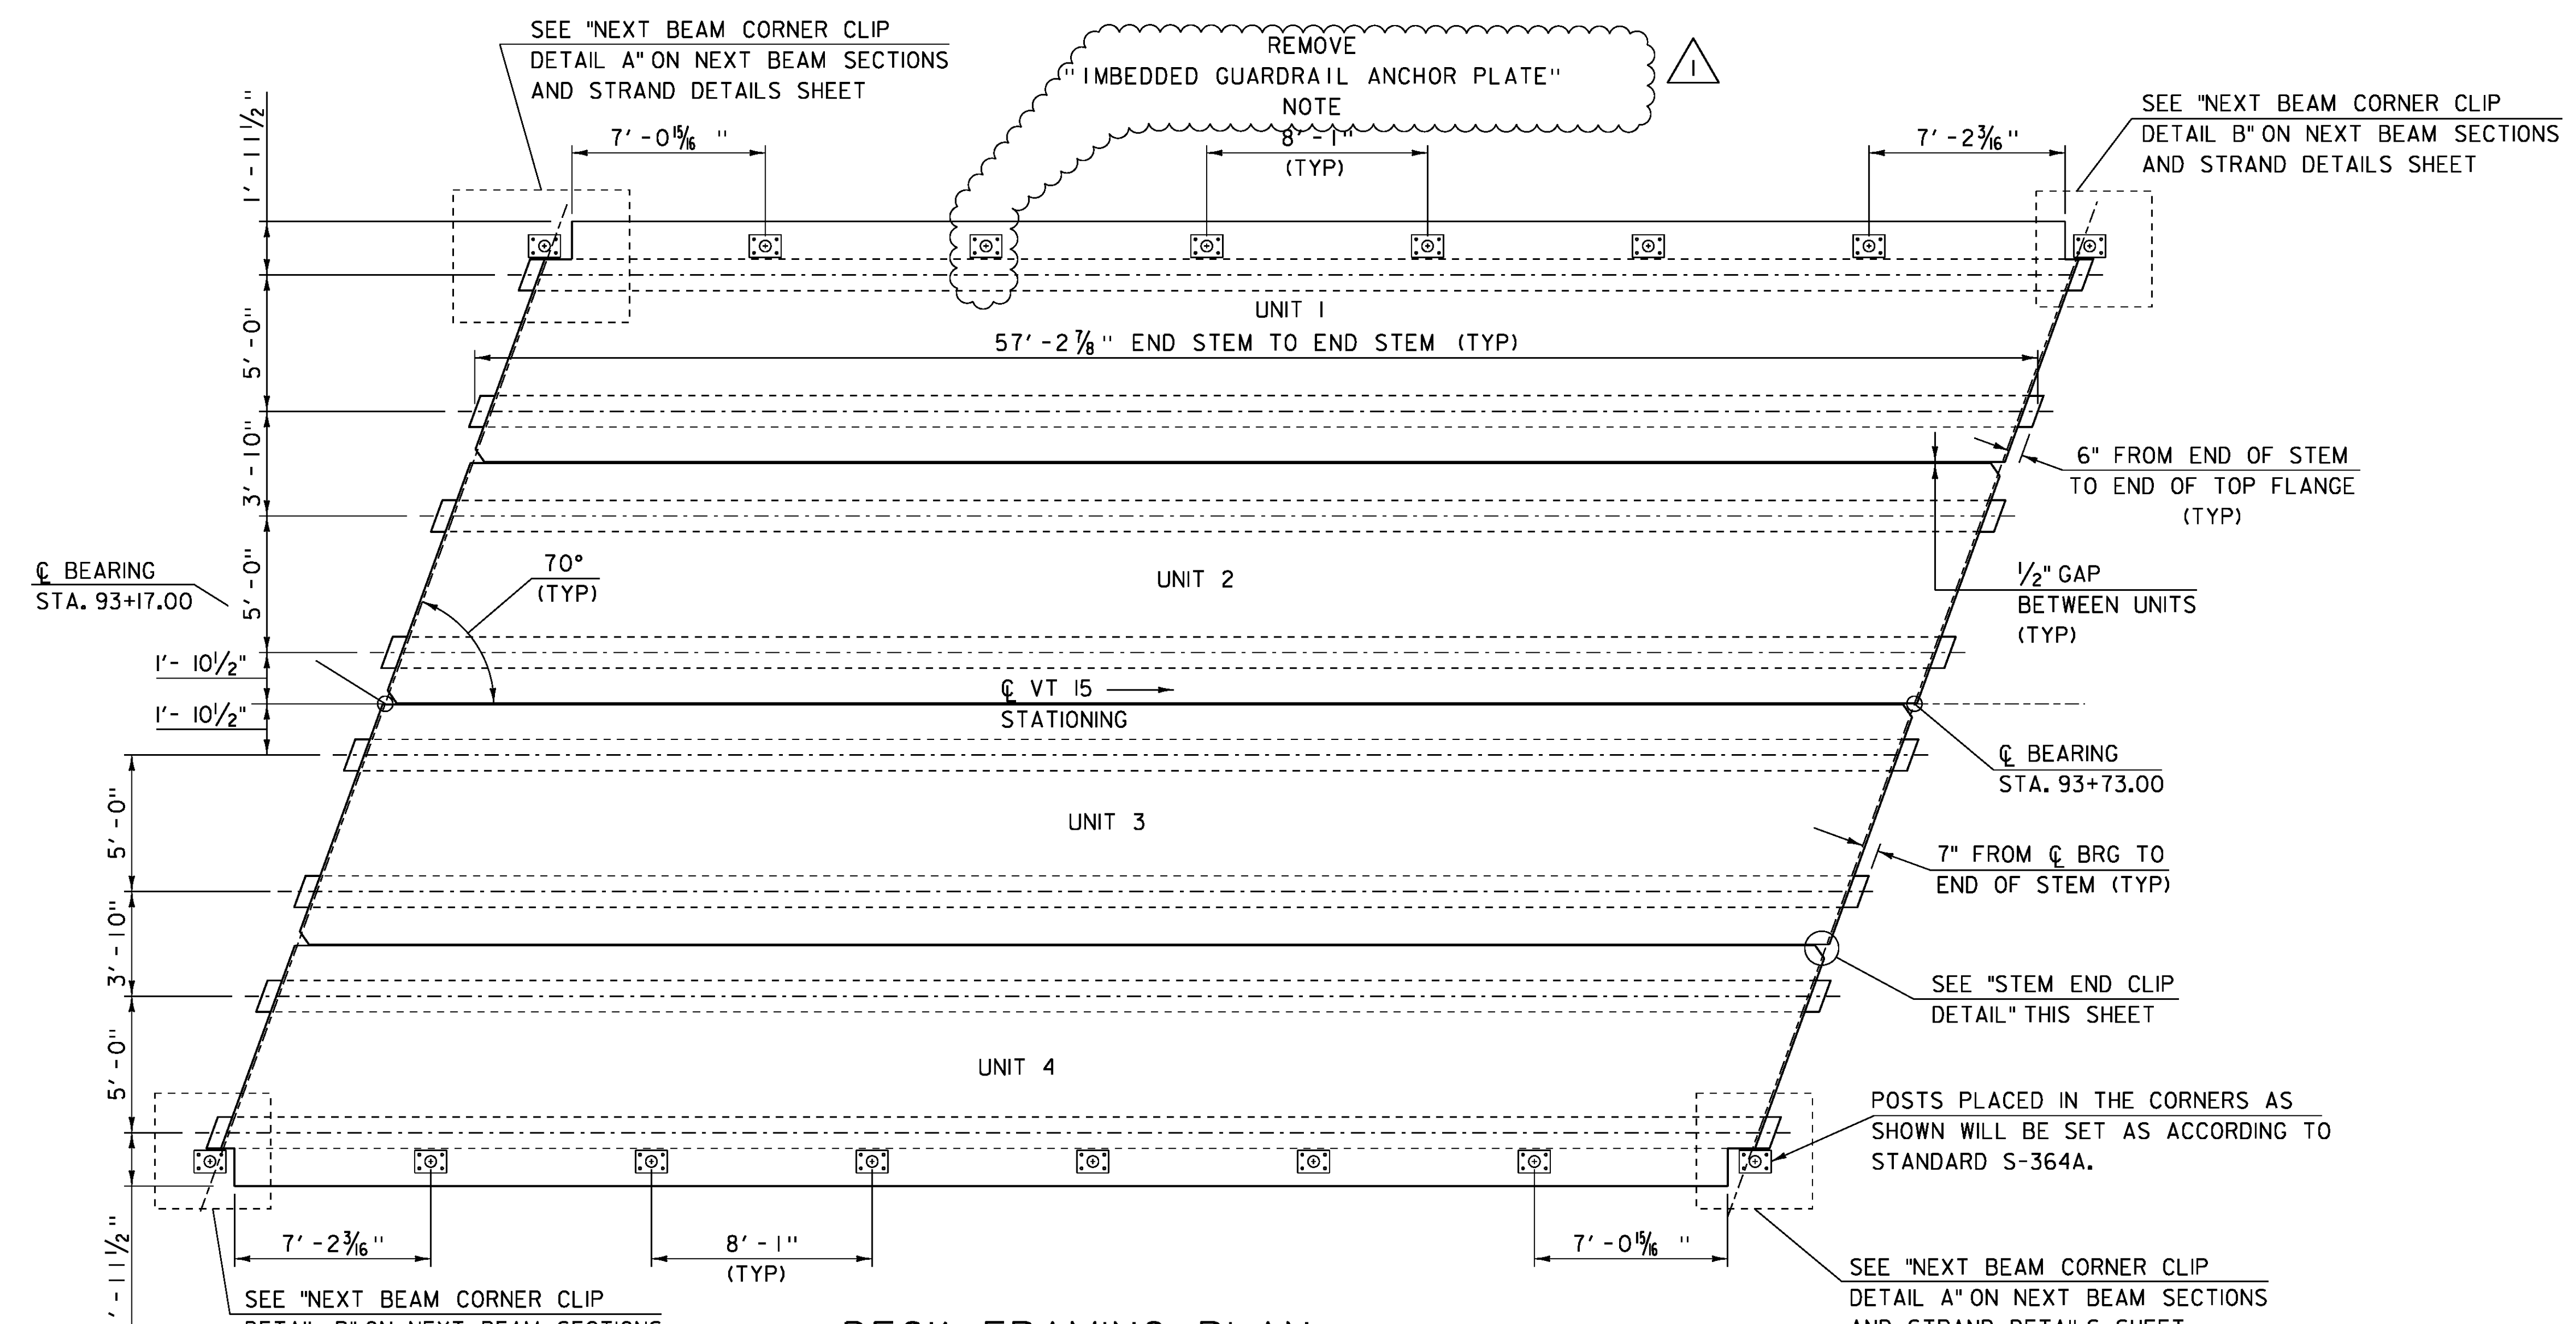

DECK FRAMING PLAN
SCALE: 1/4" = 1'-0"

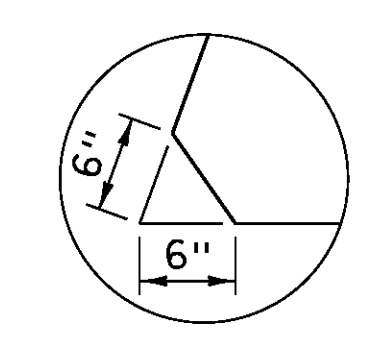

TOP FLANGE CLIP DETAIL
SCALE: 1" = 1'-0"

REVISION	DATE	DESCRIPTION	BY
1	OCT-28-2014	ADD 3" PAYMENT, LOWER BRIDGE SEAT, ADD 3" CONCRETE PEDESTAL	GNR

PROJECT NAME:	JOHNSON	PLOT DATE:	05-NOV-2014
PROJECT NUMBER:	BRF 030-2(26)	DRAWN BY:	G. ROKES
FILE NAME:	s88bl93sup.dgn	CHECKED BY:	H. SALLS
PROJECT LEADER:	C. CARLSON	FRAMING PLAN AND STEM END DETAILS	SHEET 28 OF 69
DESIGNED BY:	H. SALLS		