


- 2 - 1/4" EXTERIOR LAYERS OF ELASTOMER
- 3 - 3/4" INTERIOR LAYERS OF ELASTOMER
- 4 - 1/16" STEEL REINFORCING PLATES

**FRONT VIEW**

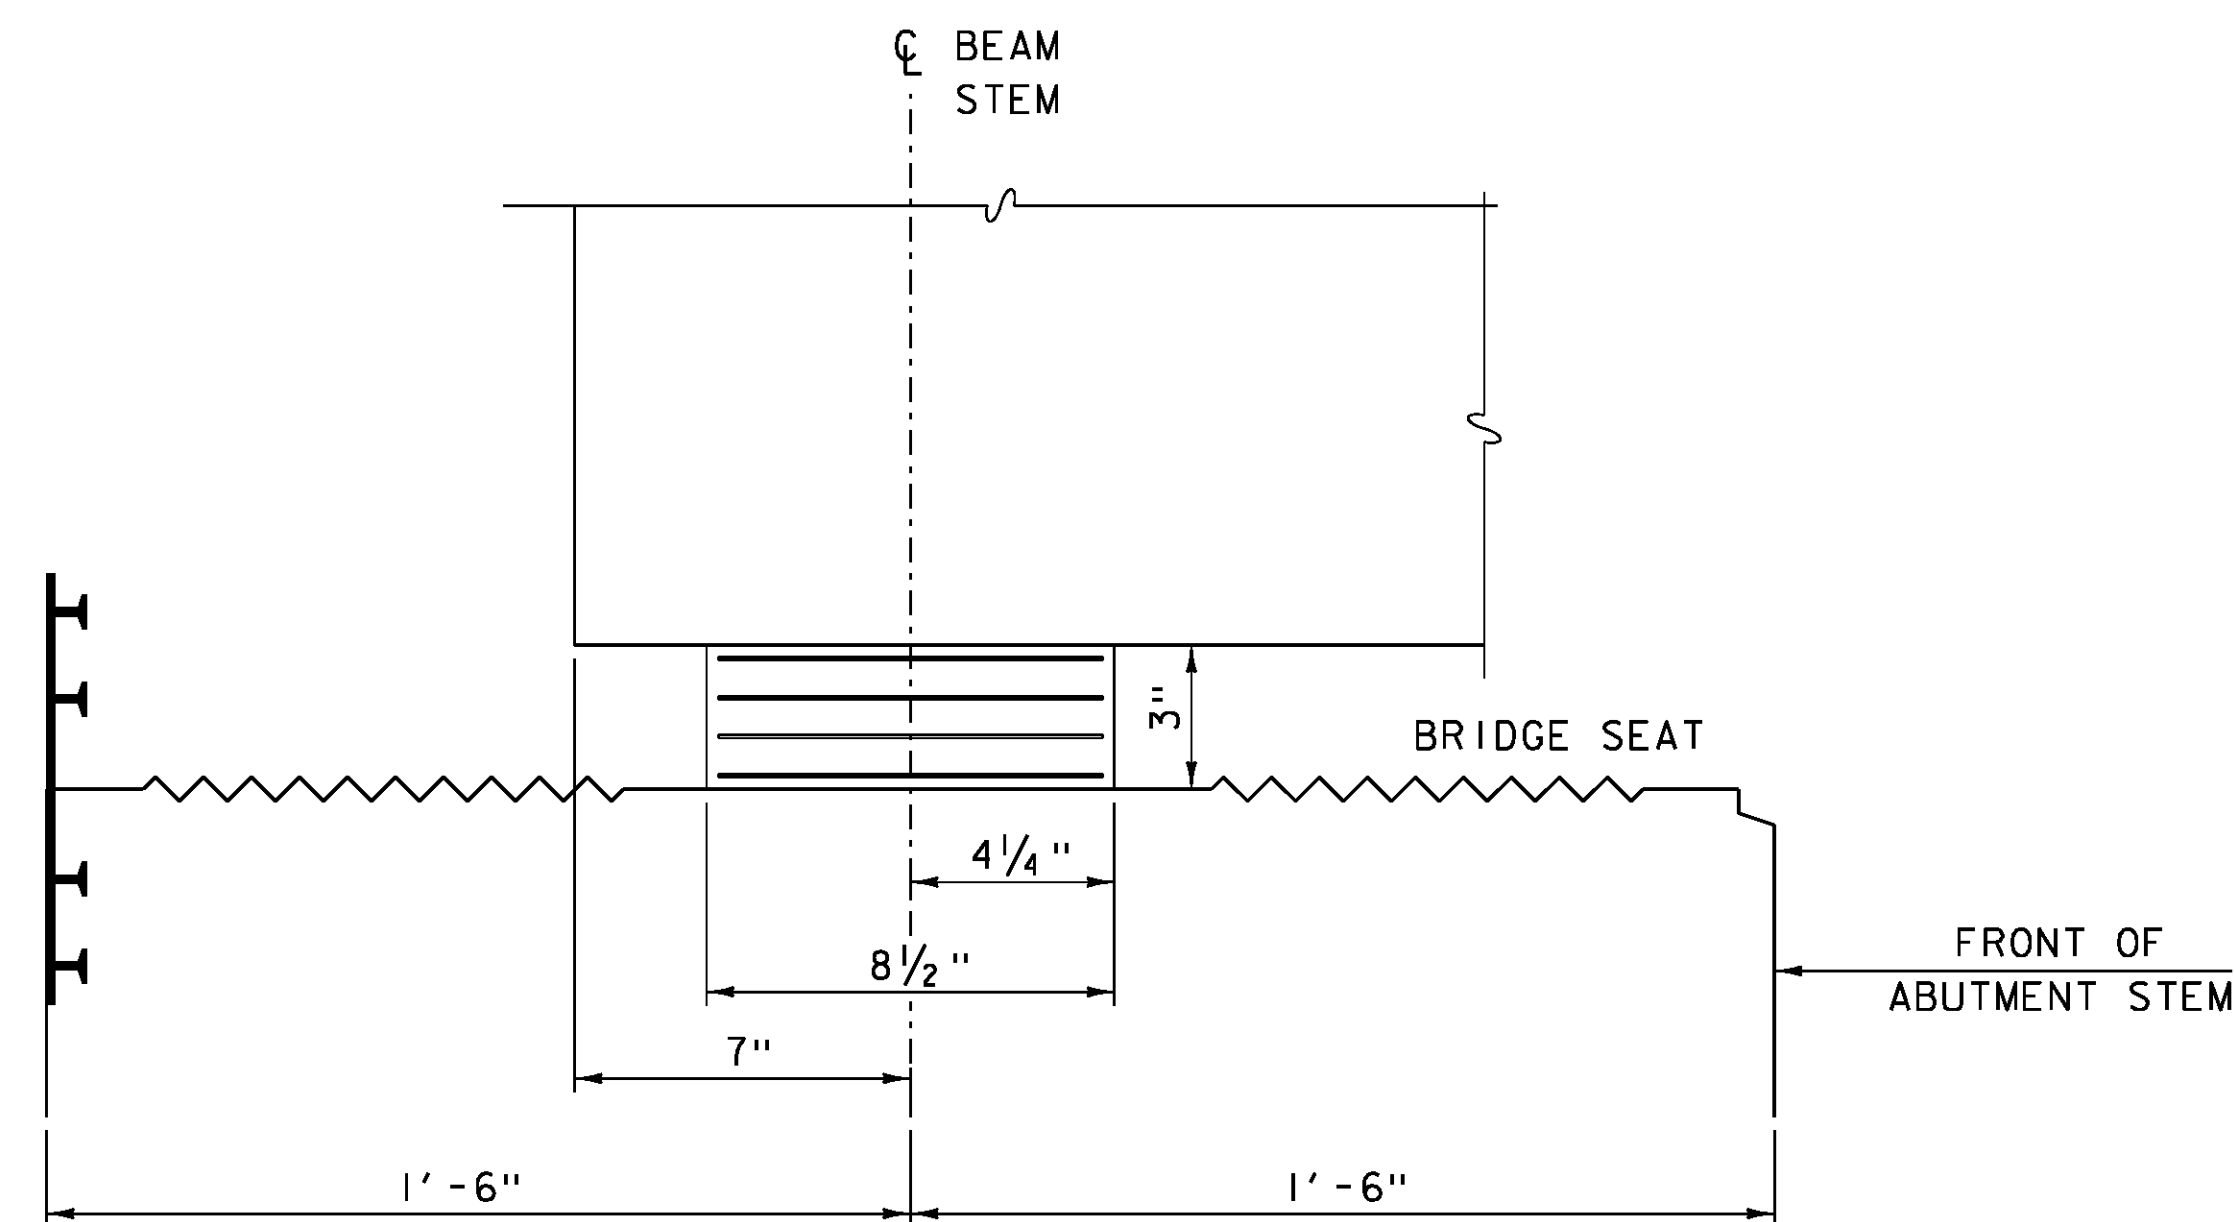

**SIDE VIEW**

**ELASTOMERIC BEARING DETAILS**

SCALE: 3" = 1'-0"

**BEARING NOTES**

1. BEARINGS SHALL CONFORM TO THE APPLICABLE SUBSECTIONS OF STANDARD SPECIFICATIONS SECTIONS 531 AND 731.
2. ALL REINFORCEMENT BETWEEN LAYERS OF ELASTOMER SHALL BE STEEL AASHTO M270M/M270 GRADE 36. ALL INTERNAL STEEL PLATES SHALL BE SAND BLASTED AND FREE OF COATINGS, RUST AND MILL SCALE. THE PLATES SHALL BE FREE OF SHARP EDGES AND BURRS.
3. STEEL REINFORCED ELASTOMERIC BEARINGS SHALL HAVE A MINIMUM 1/8" EDGE SEAL OF ELASTOMER INTEGRAL WITH BEARING OVER ALL INTERNAL PLATES.
4. THE ELASTOMER WAS DESIGNED WITH A SHEAR MODULUS OF 100 PSI +/- 15%
5. THE CONTRACTOR IS ADVISED TO HAVE SHIMS AVAILABLE FOR USE FOR ELEVATION ADJUSTMENTS UPON THE SETTING OF THE SUPERSTRUCTURE UNITS. THE SHIMS SHALL BE FABRICATED ACCORDING TO SECTION 531 AND SHALL BE INCLUDED UNDER ITEM 531.17, "BEARING DEVICE ASSEMBLY, STEEL REINFORCED ELASTOMERIC PAD".

PROJECT NAME: JOHNSON	PLOT DATE: 10-JUN-2014
PROJECT NUMBER: BRF 030-2(26)	DRAWN BY: G. ROKES
FILE NAME: s88bl93sub.dgn	CHECKED BY: H. SALLS
PROJECT LEADER: C. CARLSON	SHEET 30 OF 69
DESIGNED BY: H. SALLS	
BEARING DETAILS	