



APPROACH SLAB # 1 PLAN
SCALE: 1/4" = 1'-0"

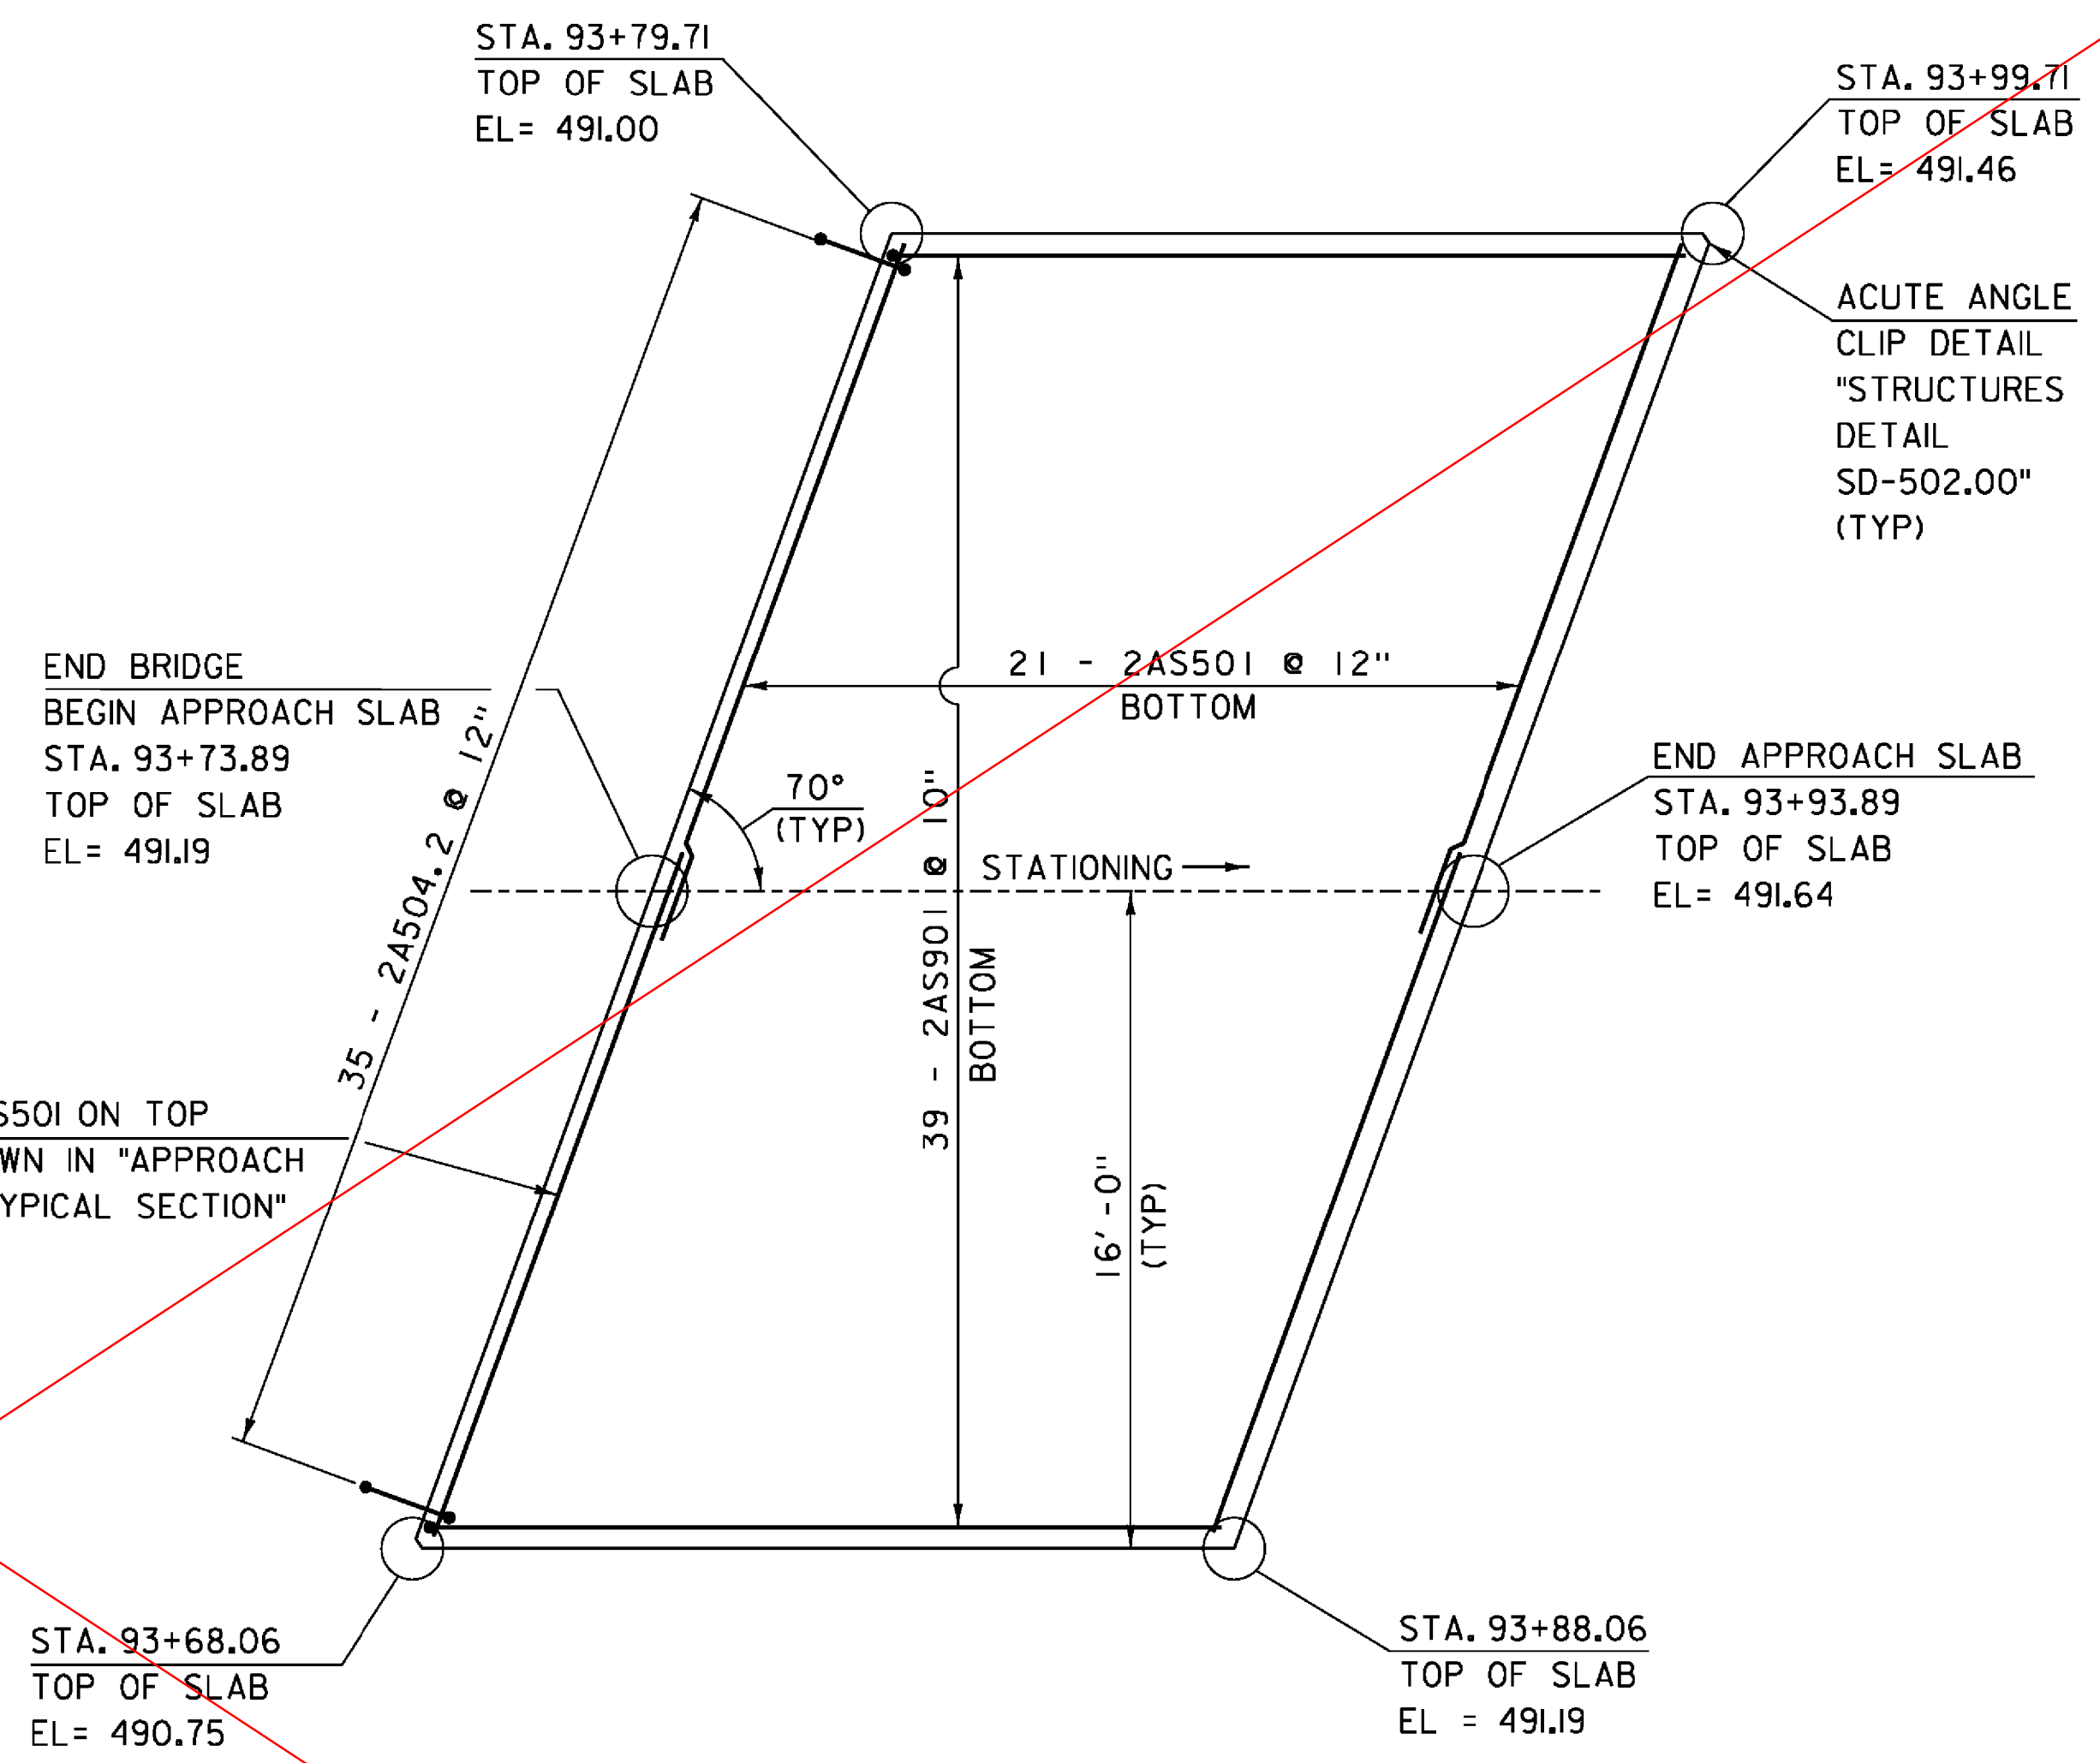

APPROACH SLAB # 2 PLAN
SCALE: 1/4" = 1'-0"

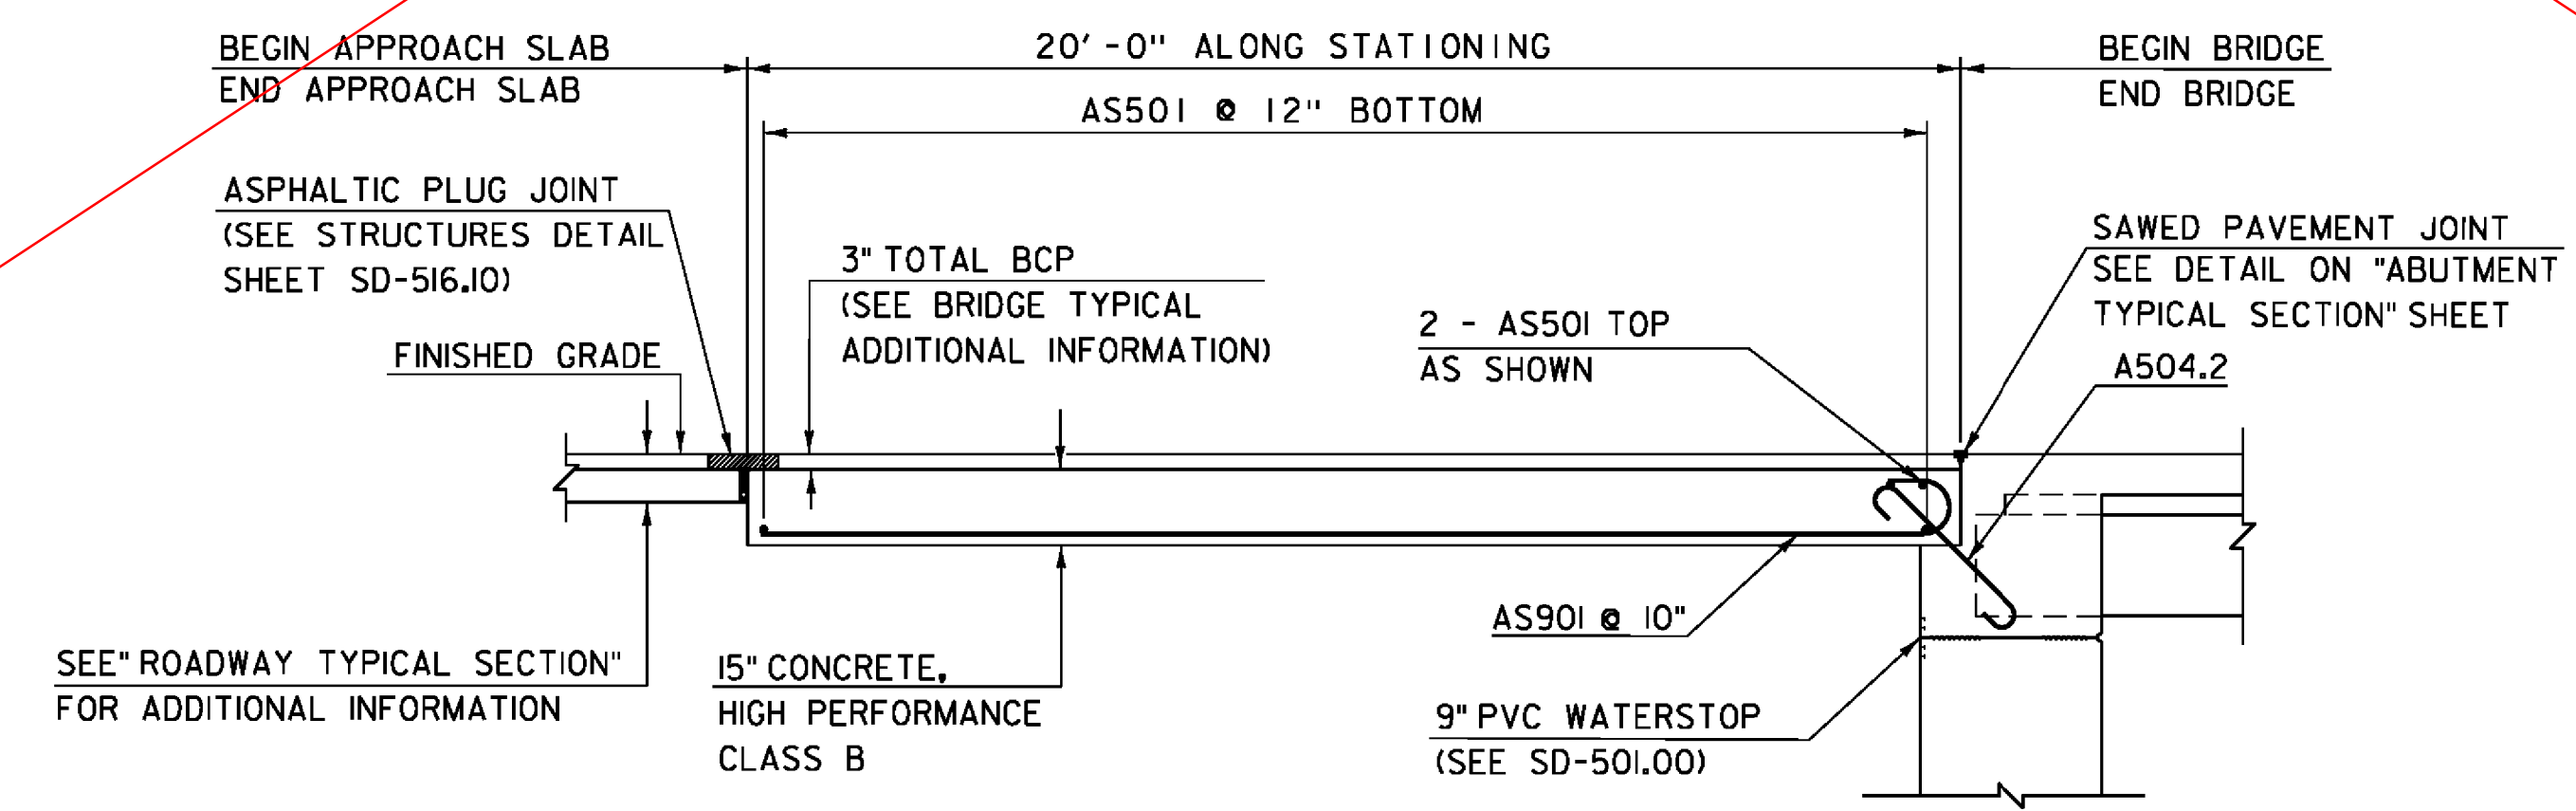

APPROACH SLAB TYPICAL SECTION
SCALE: 3/8" = 1'-0"

NOTE:
NF = NEAR FACE
FF = FAR FACE
EF = EACH FACE
▲ = CUT TO FIT IN FIELD
3" CLEAR, UNLESS OTHERWISE
SPECIFIED ON THE PLANS.
2'-2" BAR LAP UNLESS OTHERWISE
SPECIFIED ON THE PLANS.

SEE REVISION: OCT-28-2014

PROJECT NAME:	JOHNSON	PLOT DATE:	10-JUN-2014
PROJECT NUMBER:	BRF 030-2(26)	DRAWN BY:	G. ROKES
FILE NAME:	s88bi93sub.dgn	CHECKED BY:	H. SALLS
PROJECT LEADER:	C. CARLSON	SHEET	31 OF 69
DESIGNED BY:	H. SALLS		