


ABUTMENT #1 PLAN

SCALE: 3/8" = 1'-0"

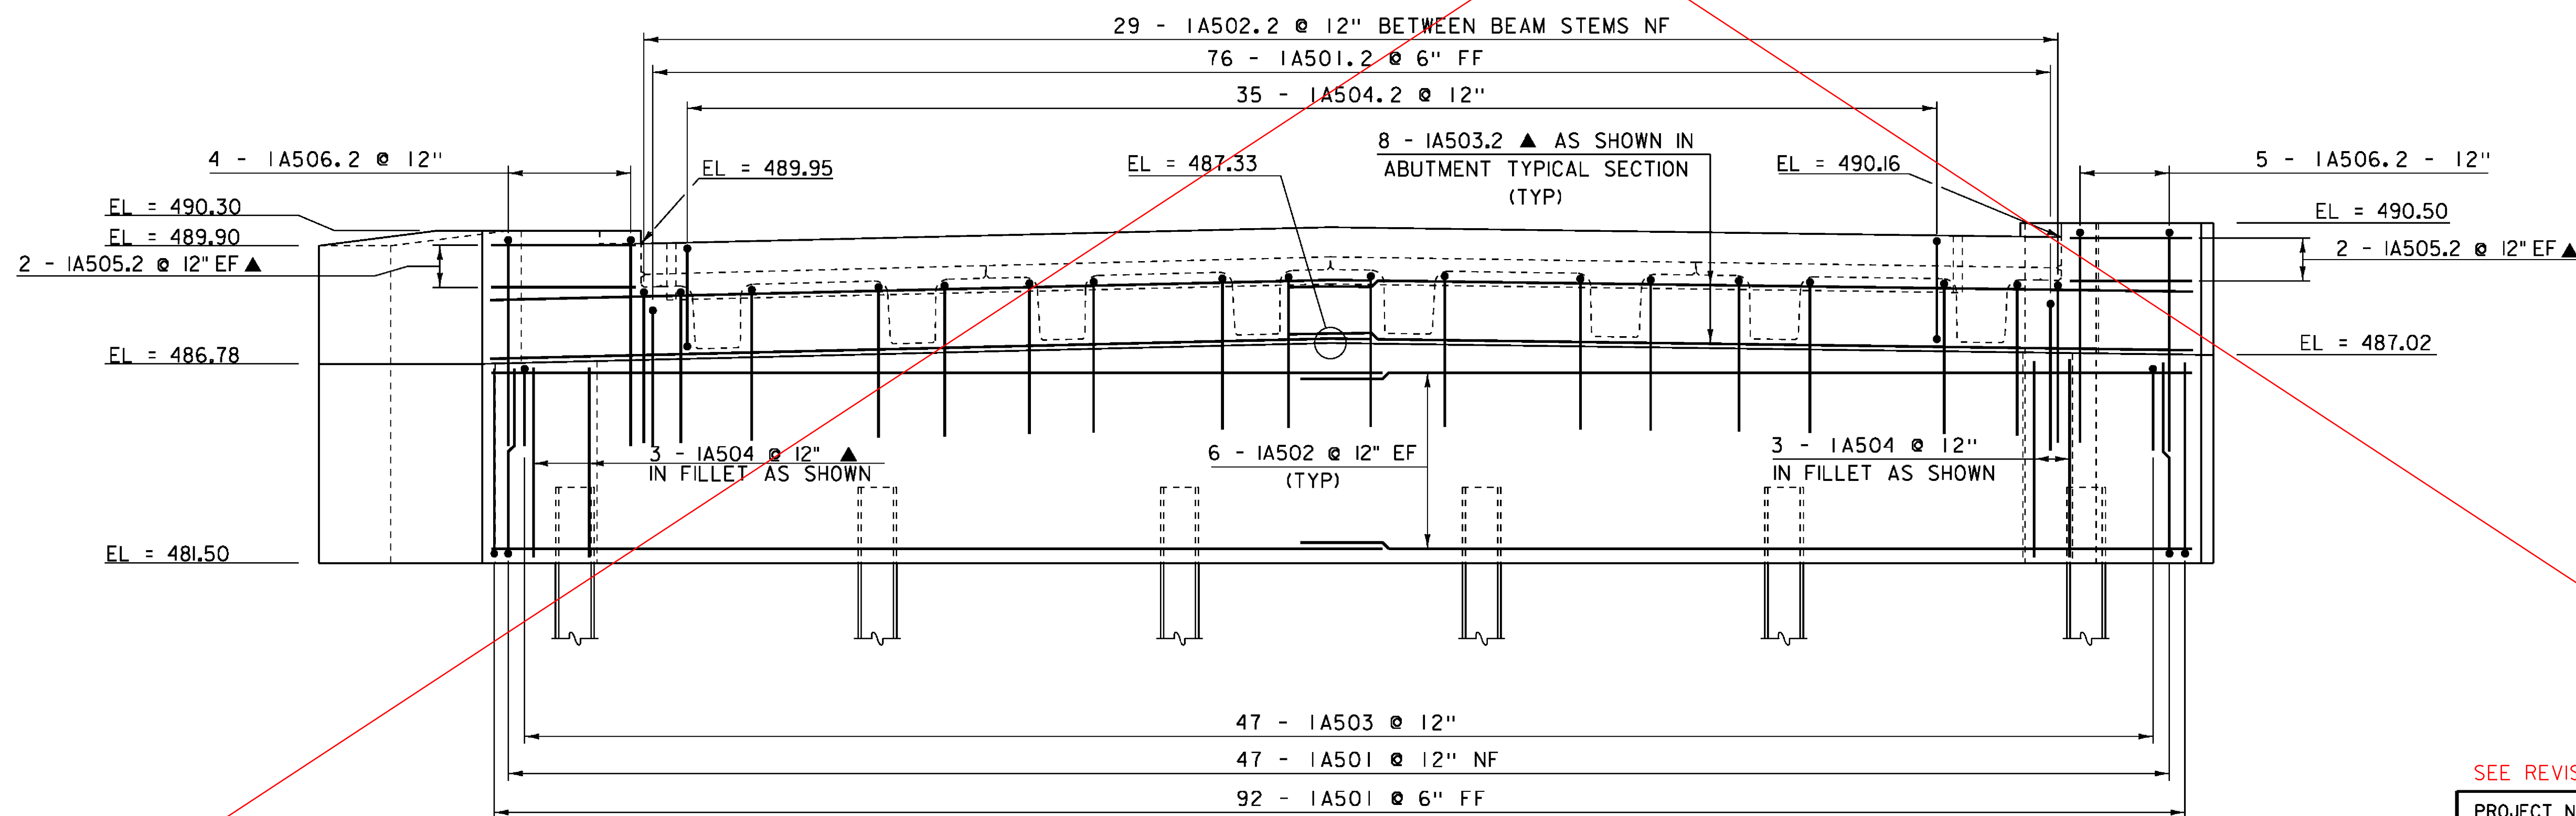

ABUTMENT #1 ELEVATION

SCALE: 3/8" = 1'-0"

NOTE:

- NF = NEAR FACE
- FF = FAR FACE
- EF = EACH FACE
- ▲ = CUT TO FIT IN FIELD
- 3" CLEAR, UNLESS OTHERWISE SPECIFIED ON THE PLANS.
- 2'-2" BAR LAP UNLESS OTHERWISE SPECIFIED ON THE PLANS.

SEE REVISION: OCT-28-2014

PROJECT NAME: JOHNSON
PROJECT NUMBER: BRF 030-2(26)

FILE NAME: s88bi93sub.dgn	PLOT DATE: 10-JUN-2014
PROJECT LEADER: C. CARLSON	DRAWN BY: G. ROKES
DESIGNED BY: H. SALLS	CHECKED BY: H. SALLS
ABUTMENT #1 PLAN AND ELEVATION	SHEET 32 OF 69