


ABUTMENT #1 PLAN

SCALE: 3/8" = 1'-0"

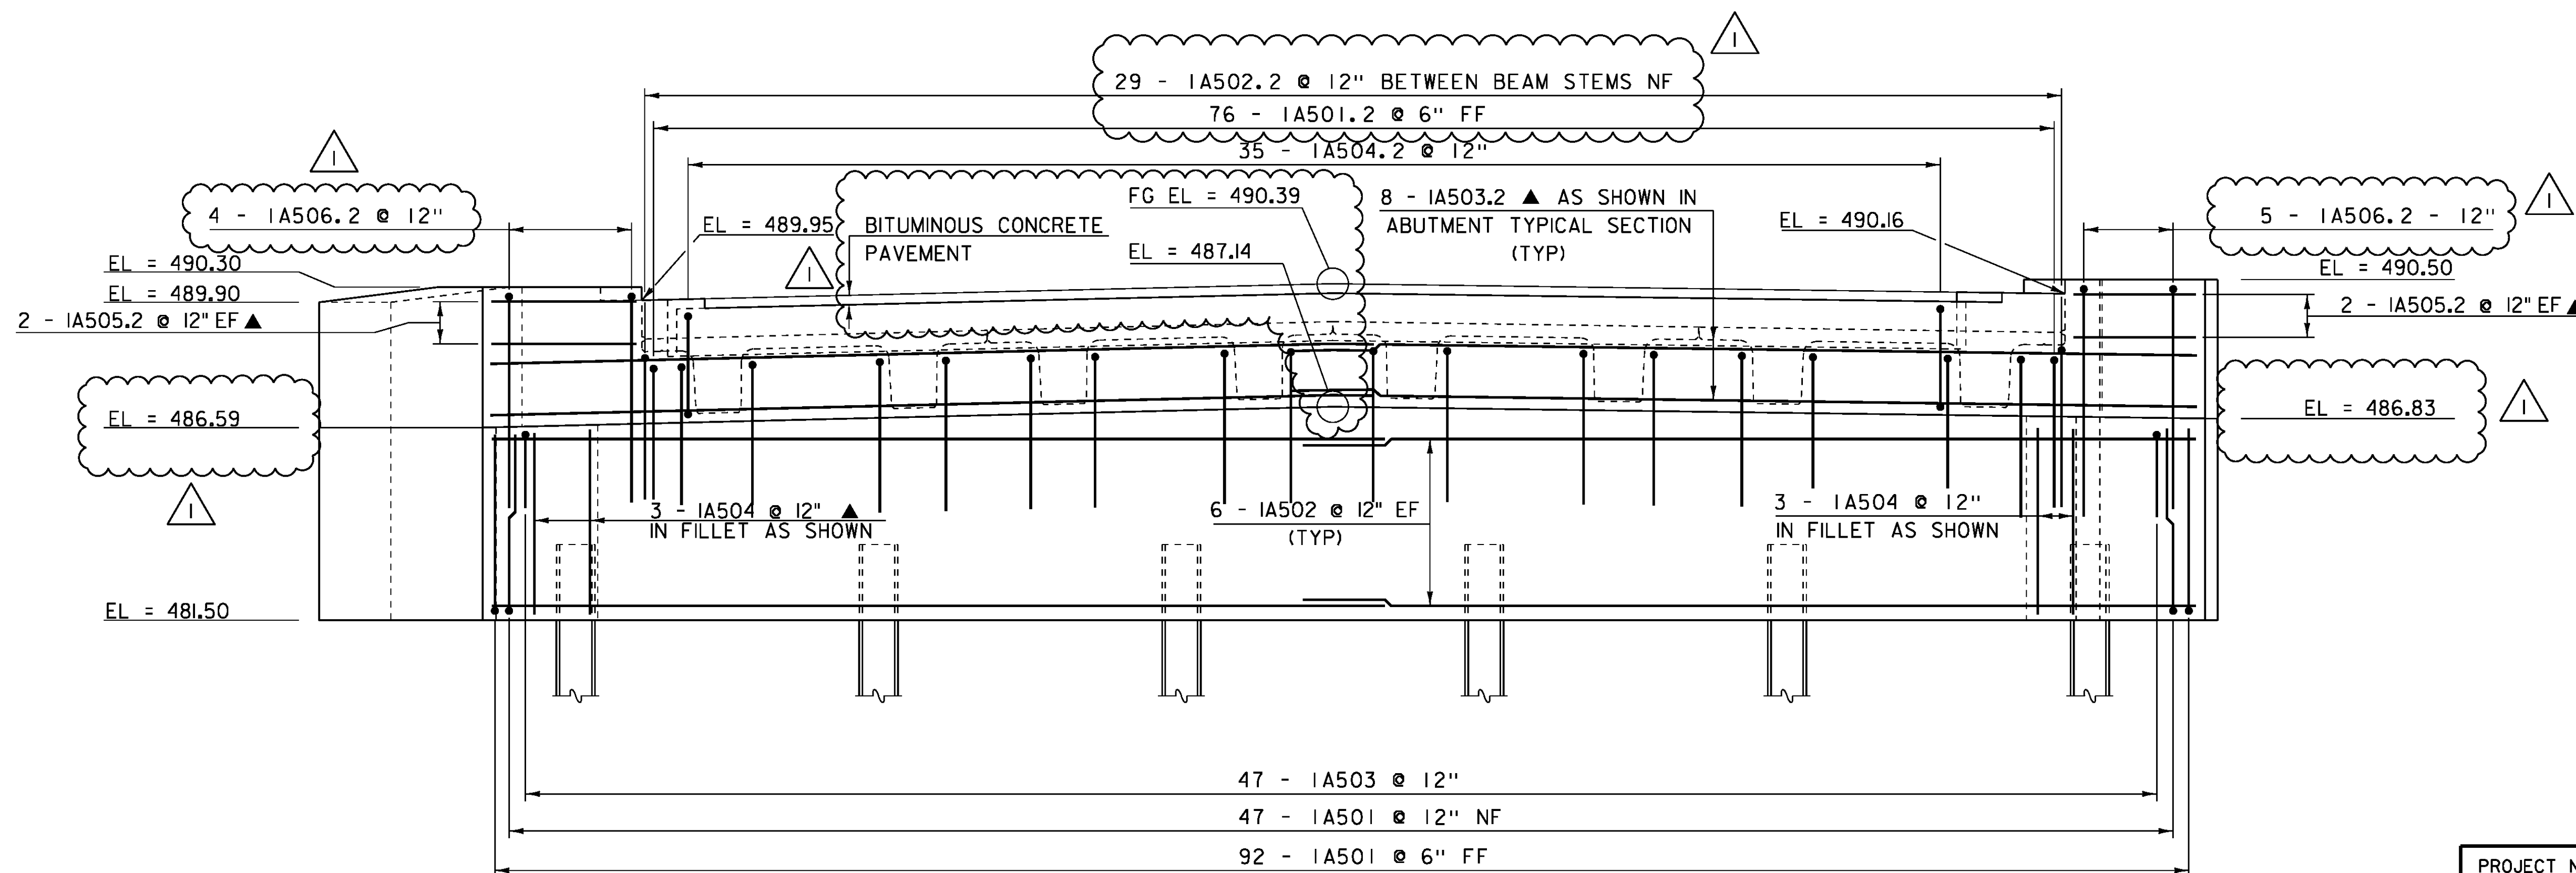

ABUTMENT #1 ELEVATION

SCALE: 3/8" = 1'-0"

NOTE:

- NF = NEAR FACE
- FF = FAR FACE
- EF = EACH FACE
- ▲ = CUT TO FIT IN FIELD
- 3" CLEAR, UNLESS OTHERWISE SPECIFIED ON THE PLANS.
- 2'-2" BAR LAP UNLESS OTHERWISE SPECIFIED ON THE PLANS.

REVISION	DATE	DESCRIPTION	BY
1	OCT-28-2014	ADD 3" PAYMENT, LOWER BRIDGE SEAT, ADD 3" CONCRETE PEDESTAL	GNR

PROJECT NAME: JOHNSON
PROJECT NUMBER: BRF 030-2(26)

FILE NAME: s88bl93sub.dgn
PROJECT LEADER: C. CARLSON
DESIGNED BY: H. SALLS
ABUTMENT #1 PLAN AND ELEVATION

PLOT DATE: 05-NOV-2014
DRAWN BY: G. ROKES
CHECKED BY: H. SALLS
SHEET 32 OF 69