


ABUTMENT #2 PLAN
SCALE: 3/8" = 1'-0"

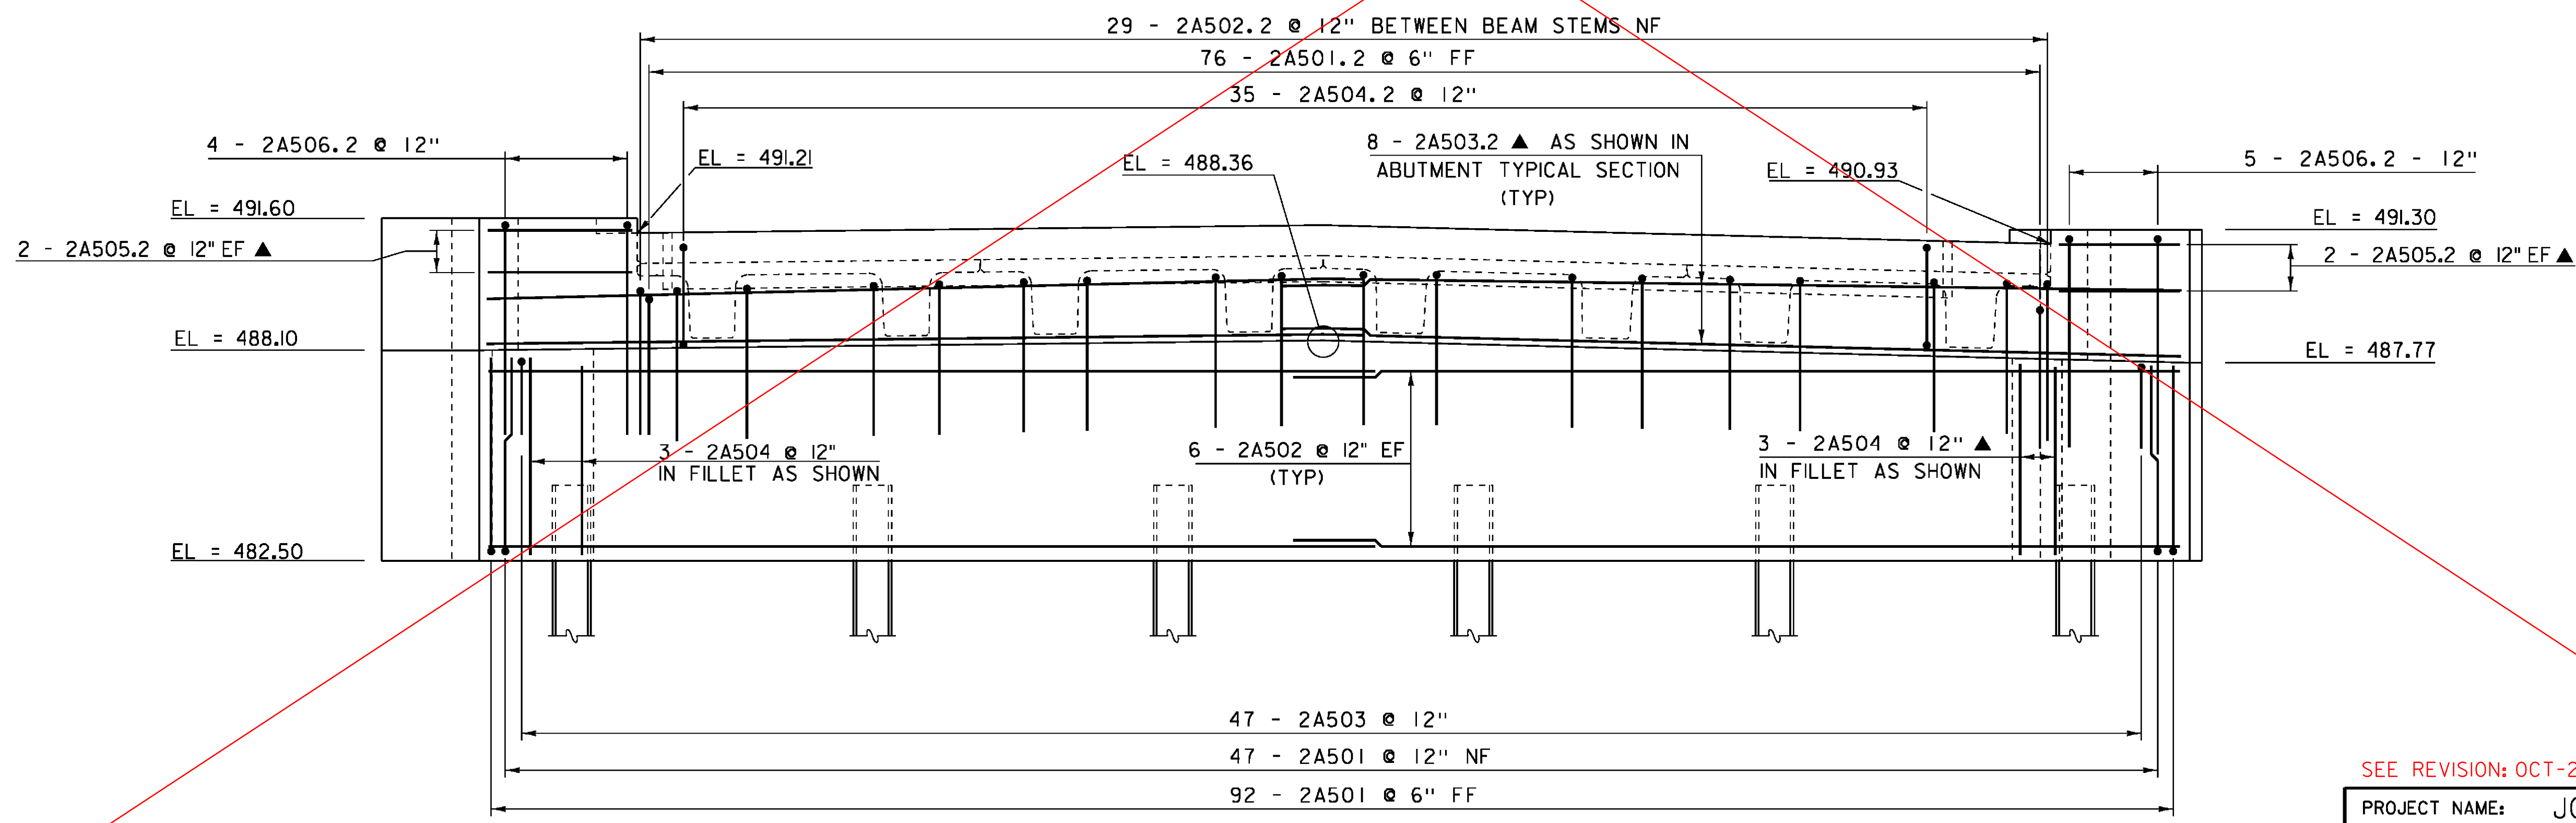

ABUTMENT #2 ELEVATION
SCALE: 3/8" = 1'-0"

NOTE:
 NF = NEAR FACE
 FF = FAR FACE
 EF = EACH FACE
 ▲ = CUT TO FIT IN FIELD
 3" CLEAR, UNLESS OTHERWISE SPECIFIED ON THE PLANS.
 2'-2" BAR LAP UNLESS OTHERWISE SPECIFIED ON THE PLANS.

SEE REVISION: OCT-28-2014

PROJECT NAME:	JOHNSON	PLOT DATE:	10-JUN-2014
PROJECT NUMBER:	BRF 030-2(26)	DRAWN BY:	G. ROKES
FILE NAME:	s88bi93sub.dgn	CHECKED BY:	H. SALLS
PROJECT LEADER:	C. CARLSON	SHEET	33 OF 69
DESIGNED BY:	H. SALLS		
ABUTMENT #2 PLAN AND ELEVATION			