


**ABUTMENT #2 PLAN**

SCALE: 3/8" = 1'-0"

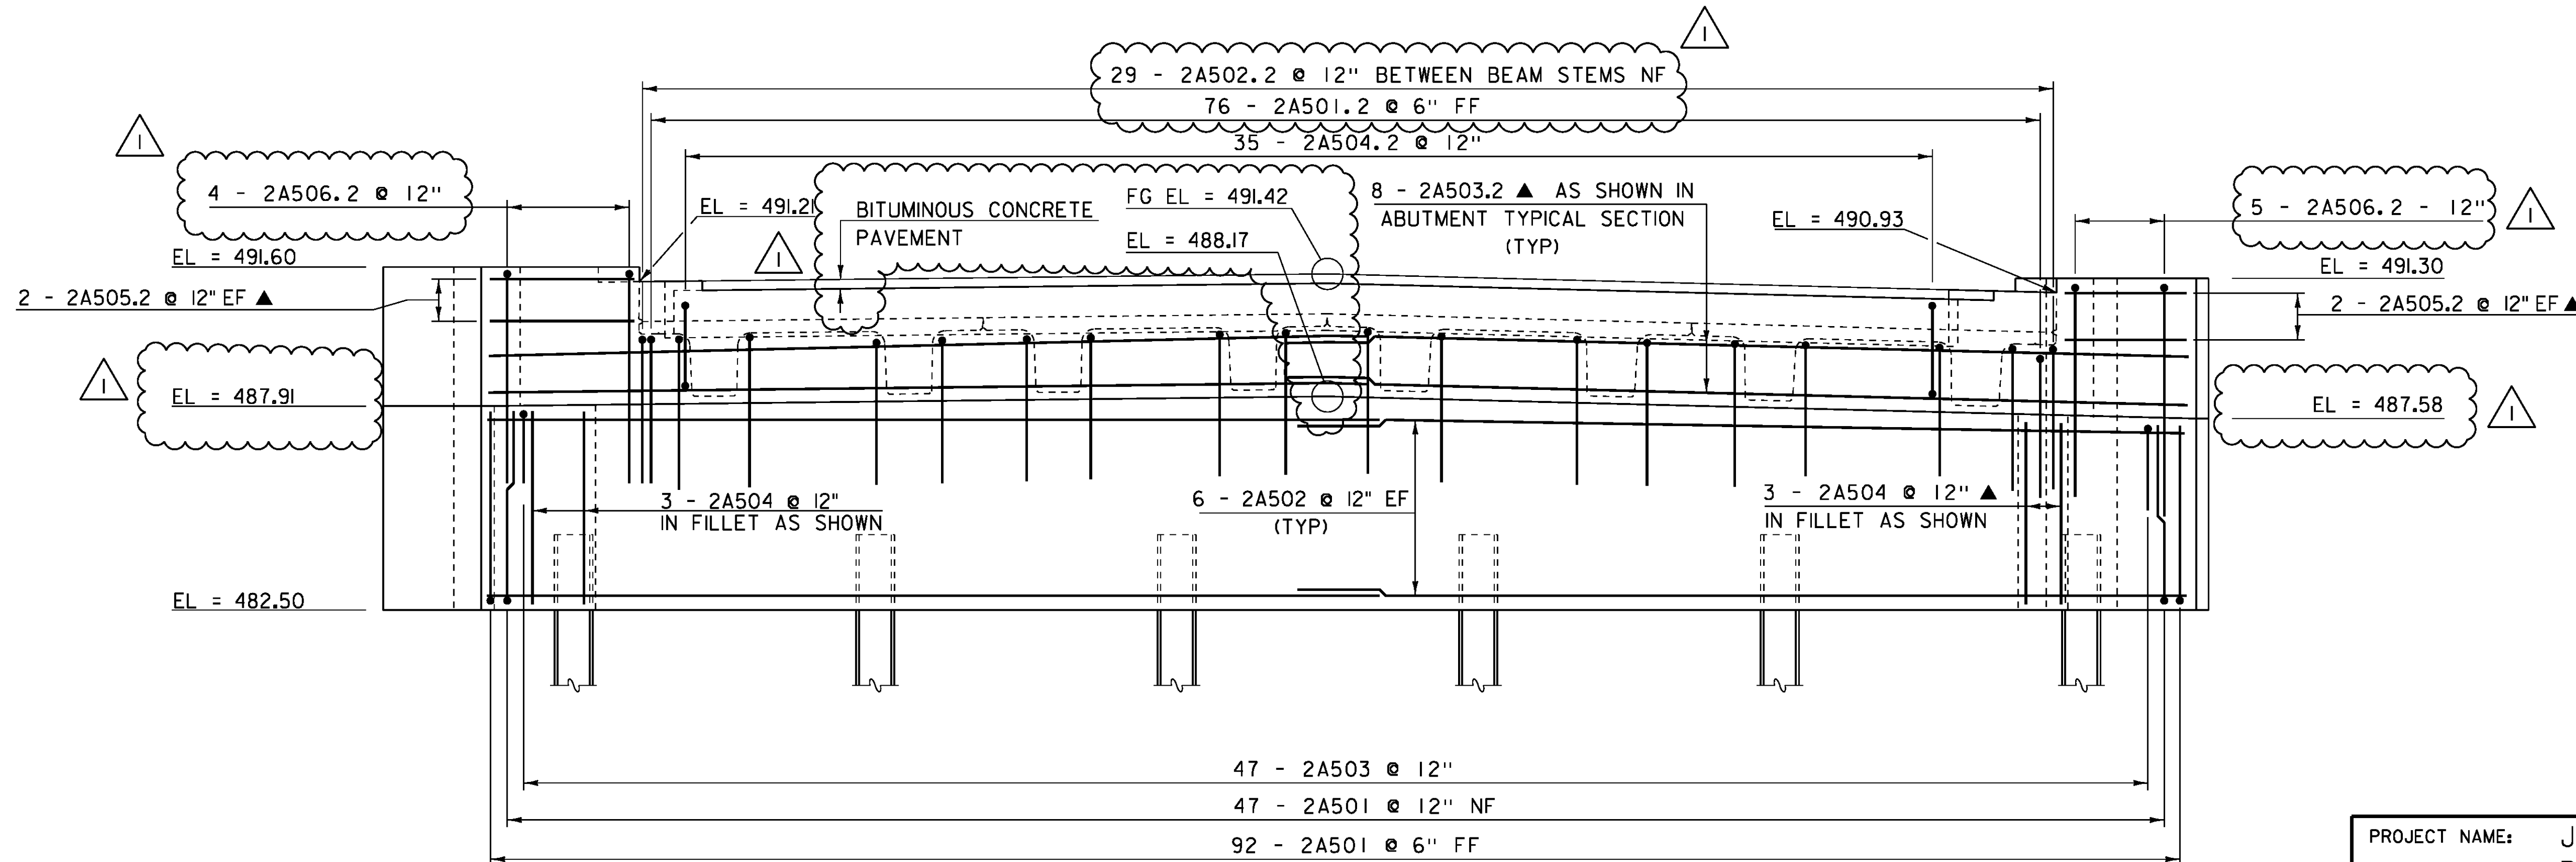

**ABUTMENT #2 ELEVATION**

SCALE: 3/8" = 1'-0"

**NOTE:**

- NF = NEAR FACE
- FF = FAR FACE
- EF = EACH FACE
- ▲ = CUT TO FIT IN FIELD
- 3" CLEAR, UNLESS OTHERWISE SPECIFIED ON THE PLANS.
- 2'-2" BAR LAP UNLESS OTHERWISE SPECIFIED ON THE PLANS.

PROJECT NAME: JOHNSON  
PROJECT NUMBER: BRF 030-2(26)

FILE NAME: s88bl93sub.dgn  
PROJECT LEADER: C. CARLSON  
DESIGNED BY: H. SALLS  
ABUTMENT #2 PLAN AND ELEVATION

PLOT DATE: 05-NOV-2014  
DRAWN BY: G. ROKES  
CHECKED BY: H. SALLS  
SHEET 33 OF 69

REVISION	DATE	DESCRIPTION	BY
1	OCT-28-2014	ADD 3" PAYMENT, LOWER BRIDGE SEAT, ADD 3" CONCRETE PEDESTAL	GNR