


VT 15 BANKING DIAGRAM

HORIZONTAL SCALE: 1" = 30'-0"
VERTICAL SCALE: 1" = 0.030' /'

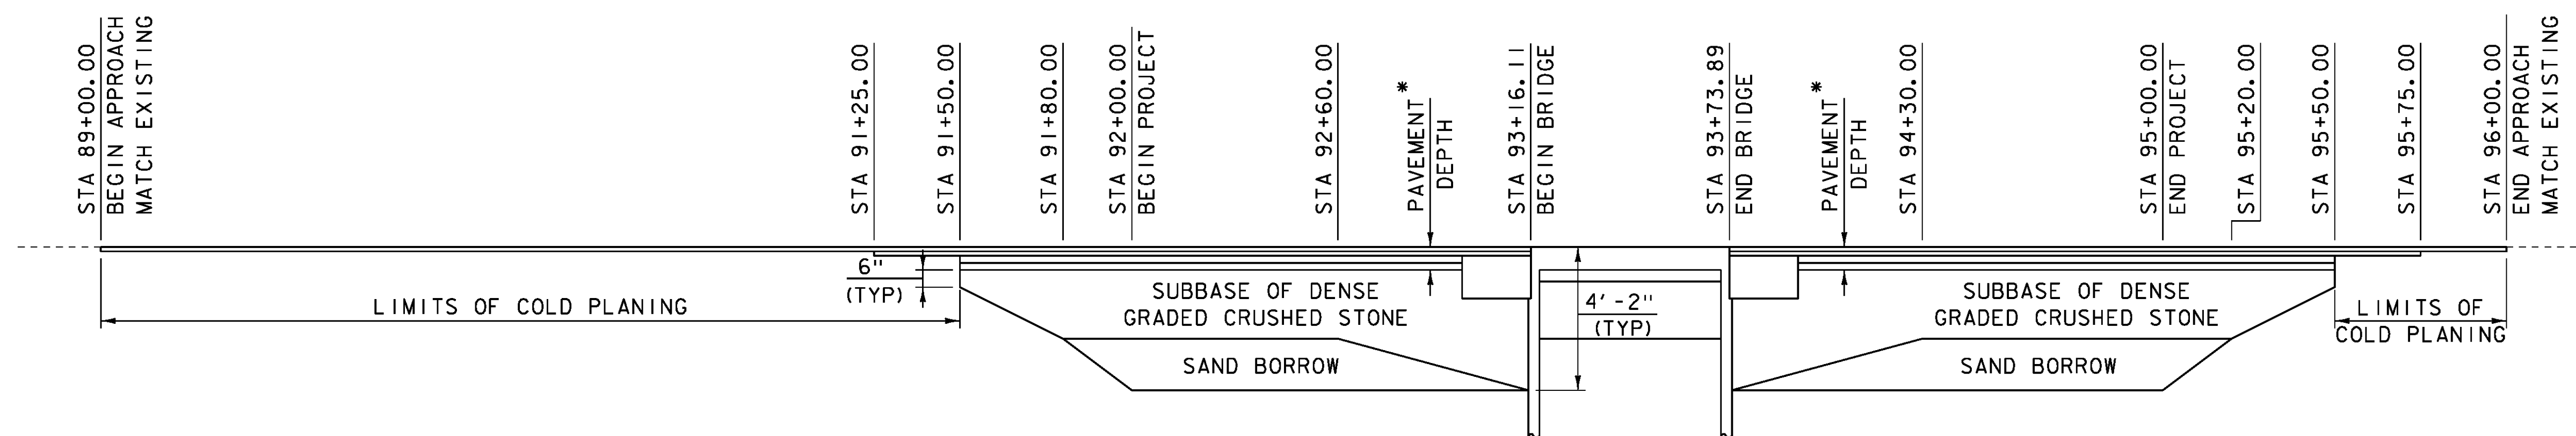

VT 15 MATERIAL TRANSITION

HORIZONTAL SCALE: 1" = 30'-0"
VERTICAL SCALE: 1" = 3'-0"

* SEE ROADWAY TYPICAL SECTION FOR PAVEMENT AND SUBBASE MATERIAL DESIGN INFORMATION.

PROJECT NAME: JOHNSON
PROJECT NUMBER: BRF 030-2(26)

FILE NAME: s88bl93pro.dgn
PROJECT LEADER: C. CARLSON
DESIGNED BY: H. SALLS
VT 15 BANKING DIAGRAM AND MATERIAL TRANSITION

PLOT DATE: 10-JUN-2014
DRAWN BY: G. ROY
CHECKED BY: H. SALLS
SHEET 41 OF 69