



93+75


STA 93+73.89
END BRIDGE
RESUME ROADWAY

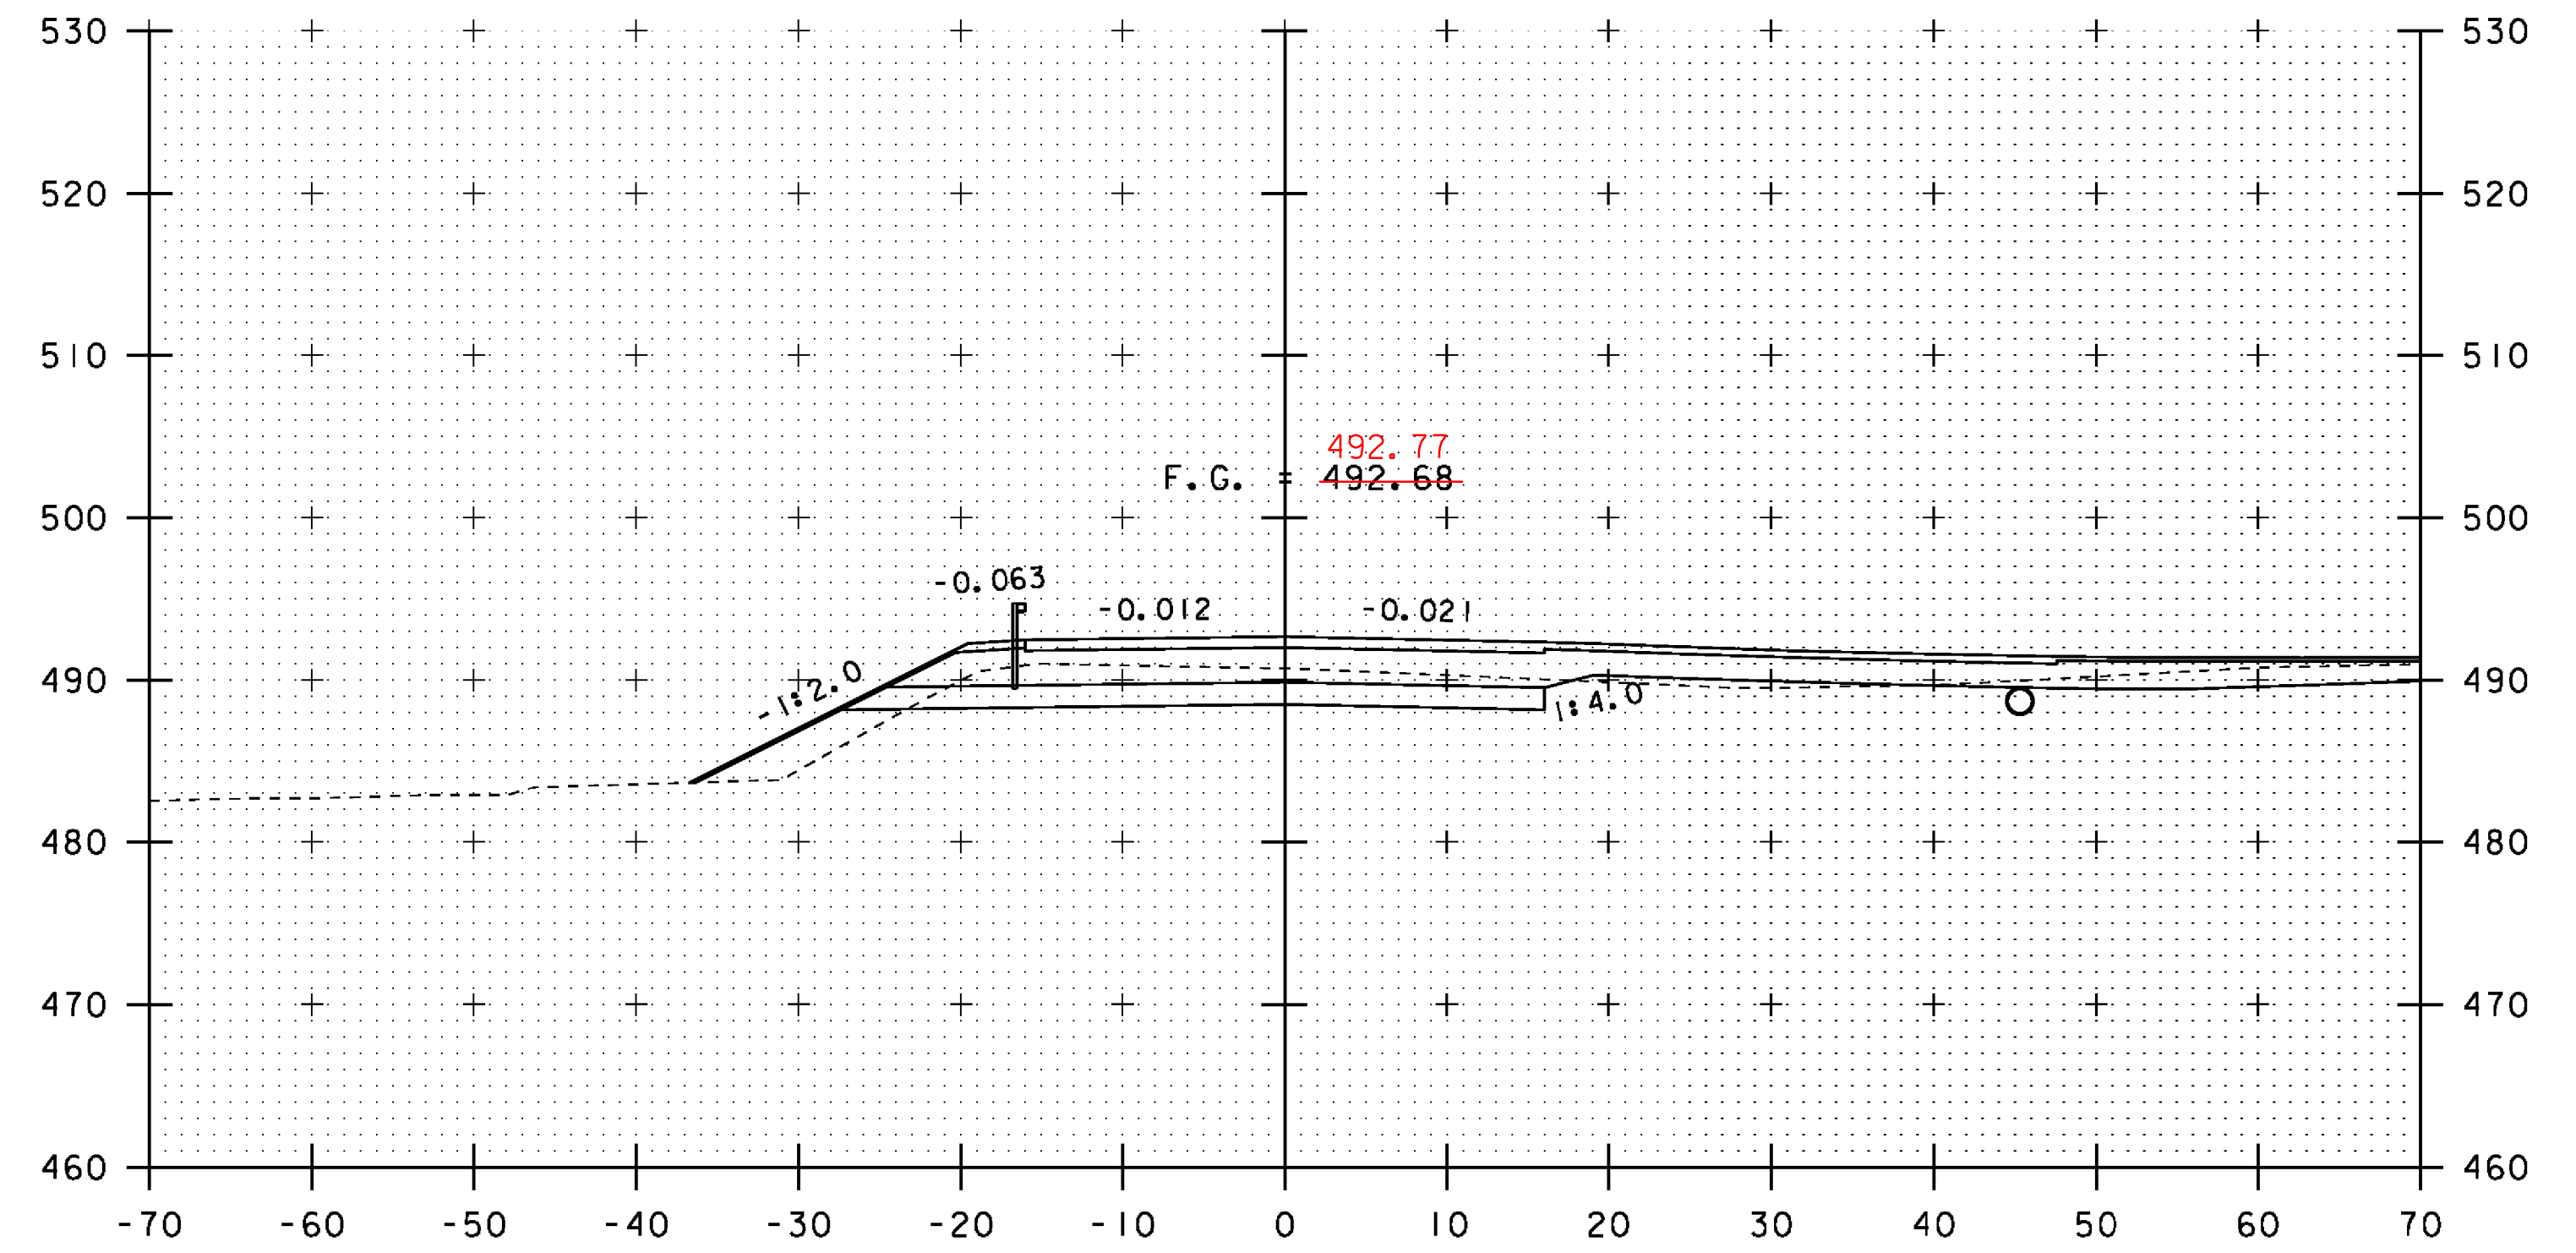

94+25

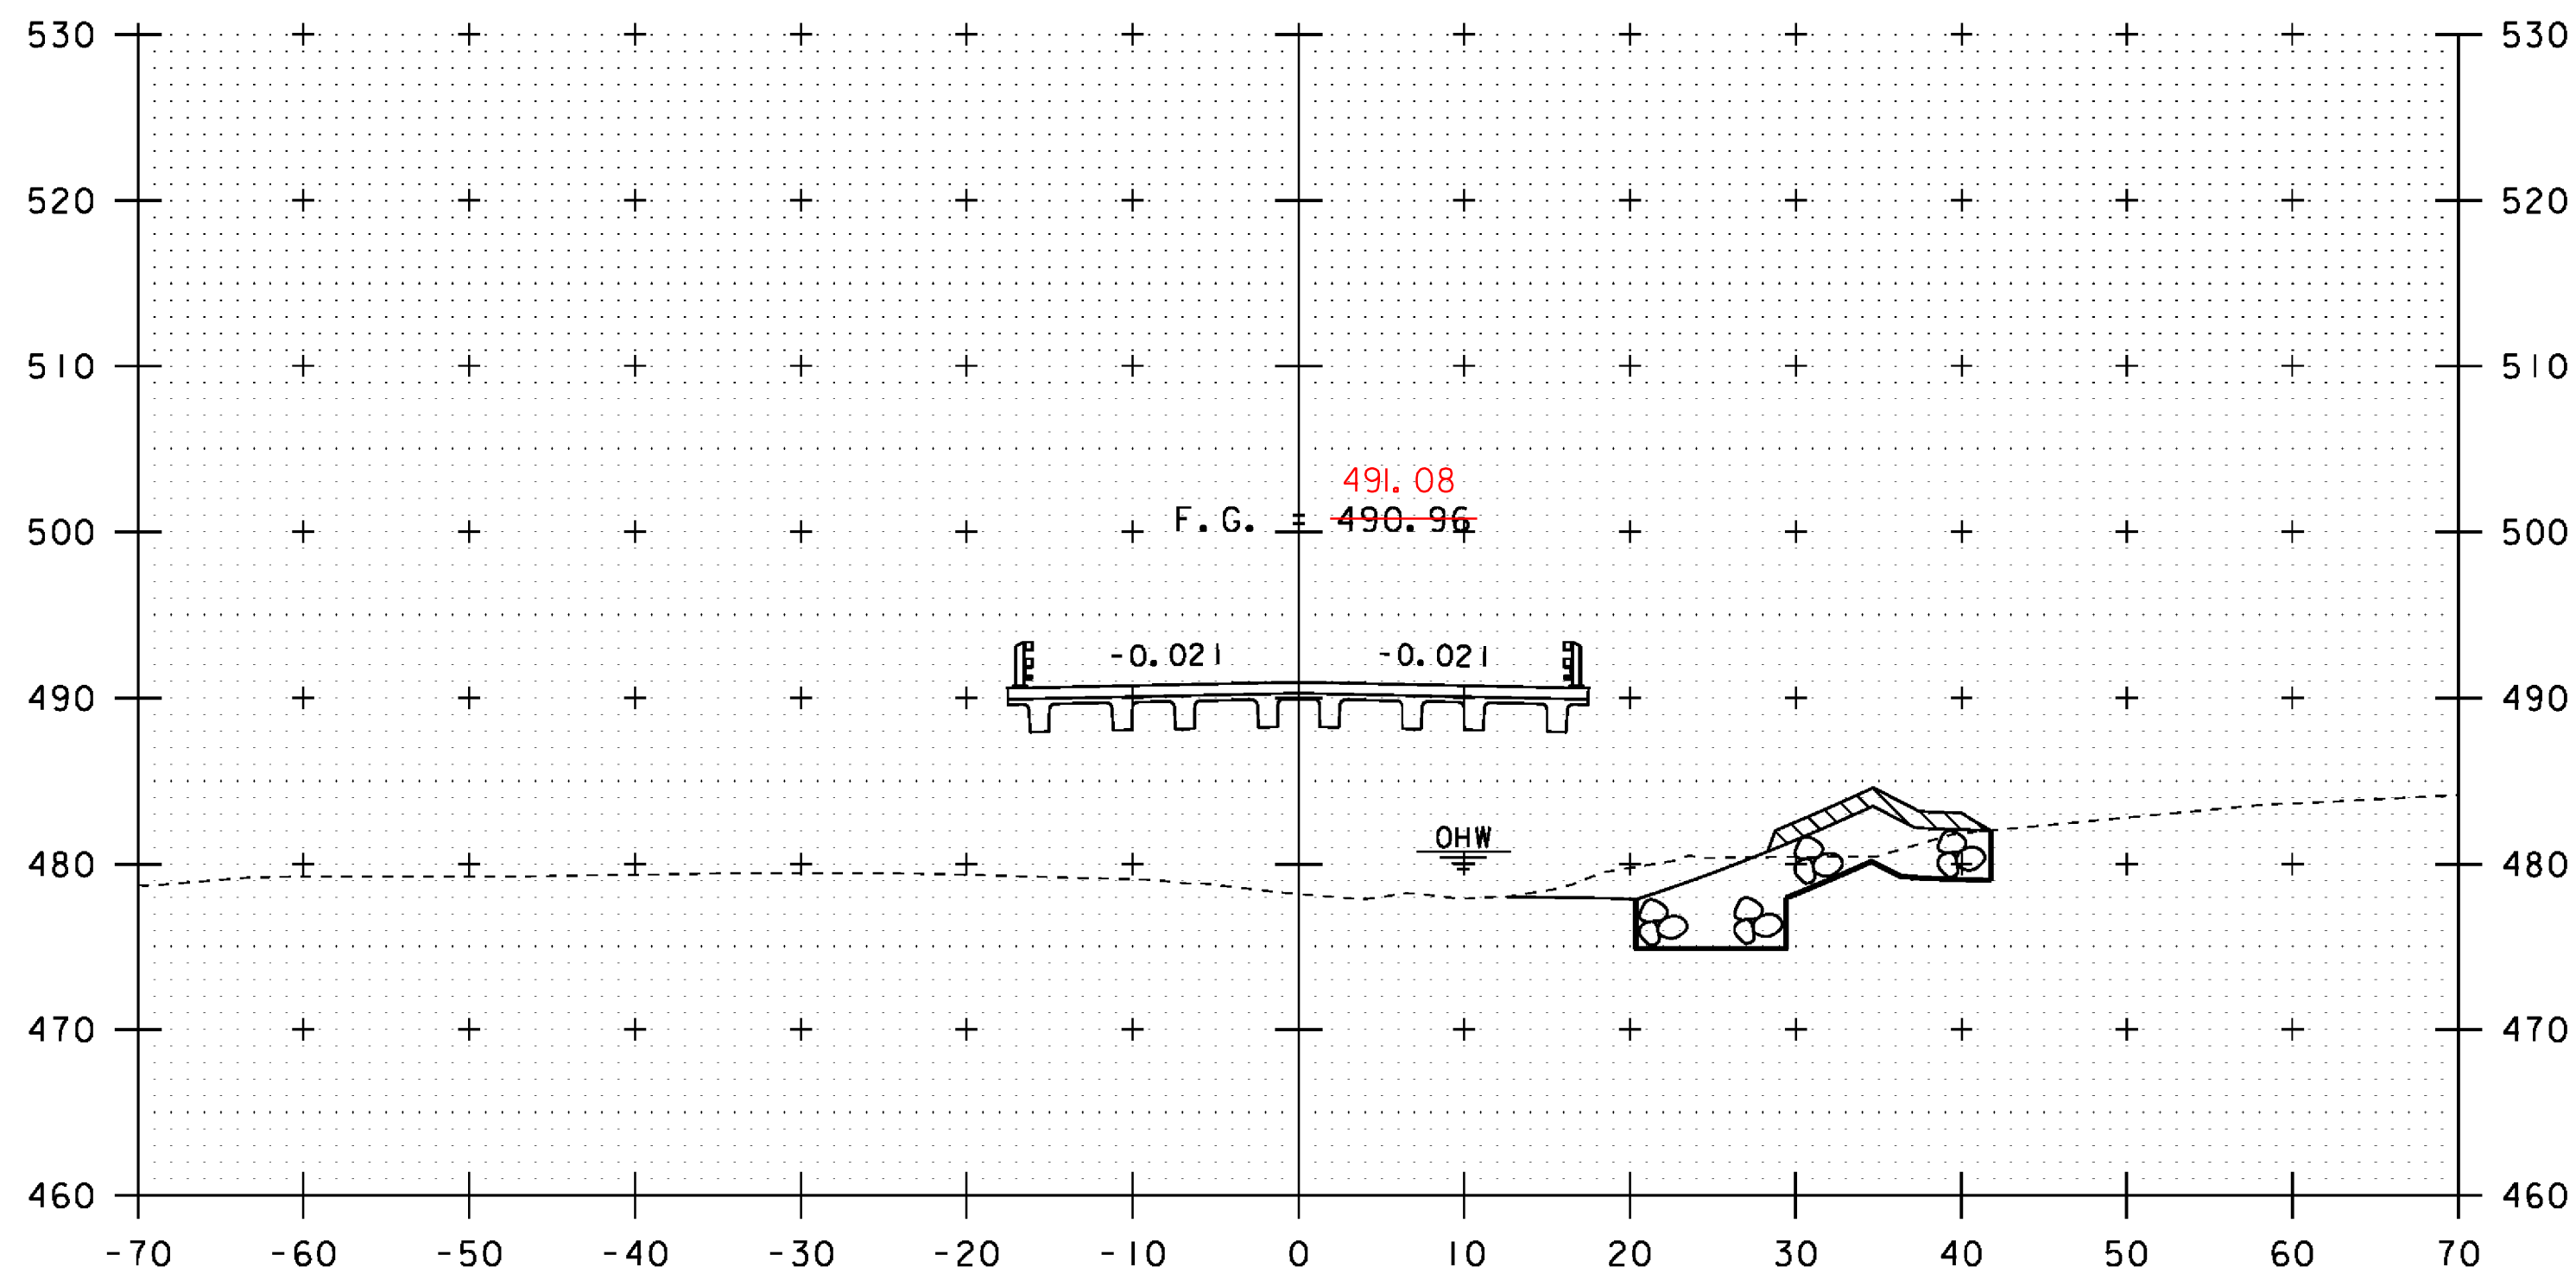

93+50

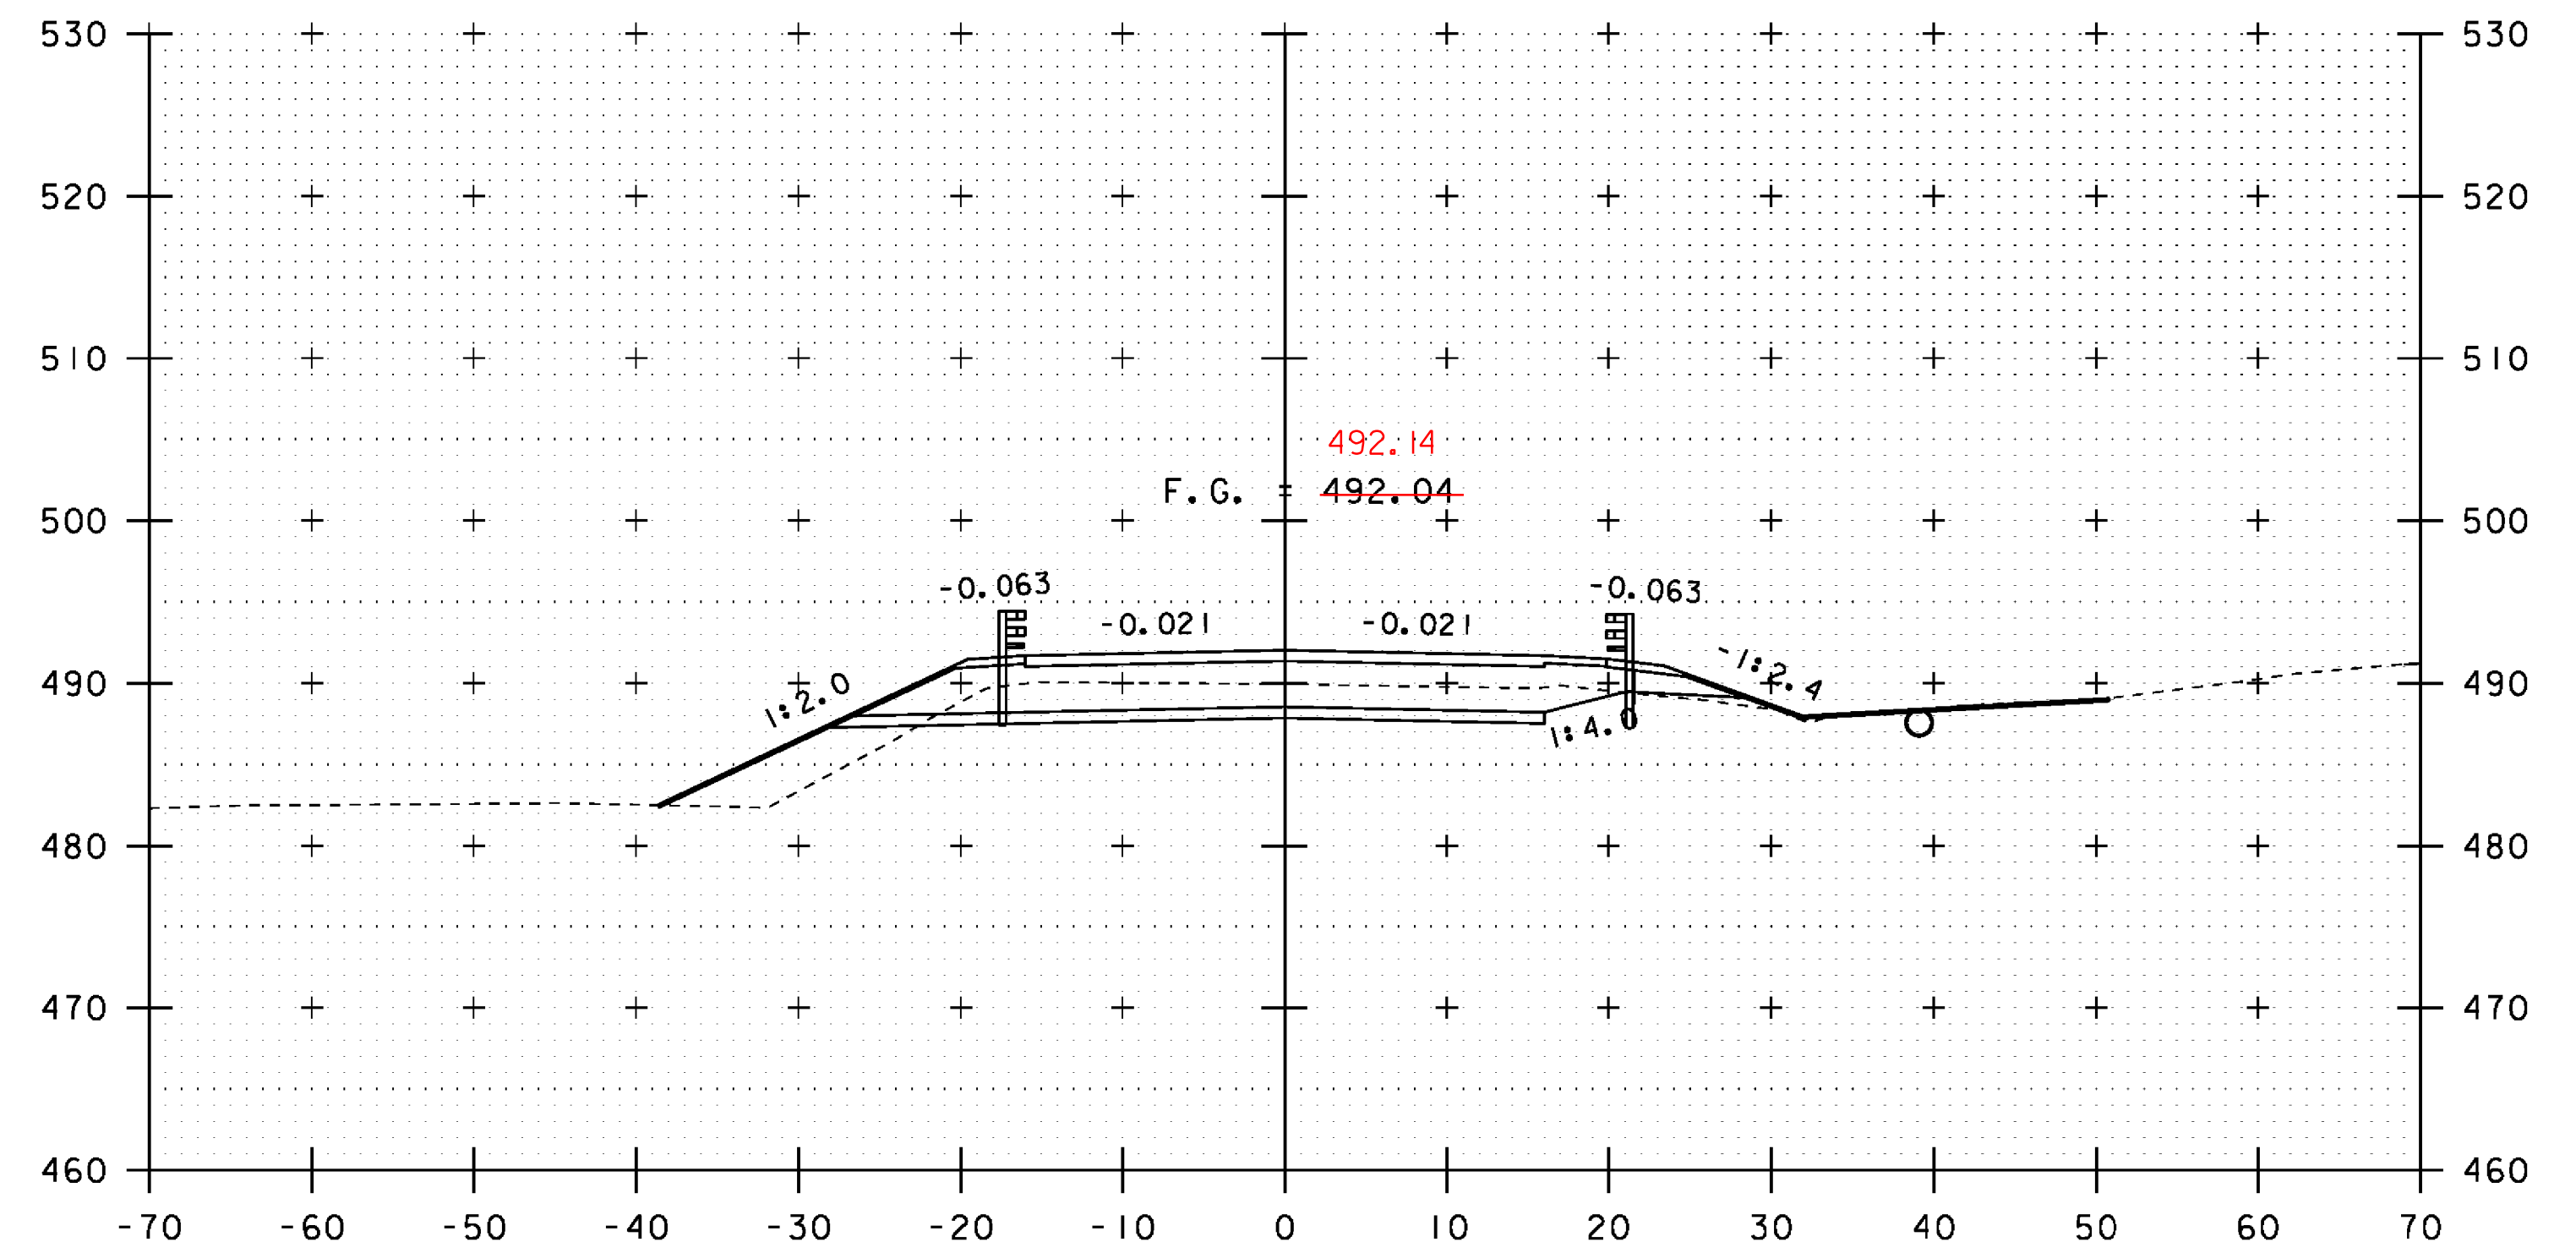

94+00

SCALE: 1" = 10'-0"
10 0 10

STA. 93+50 TO STA. 94+25

PROJECT NAME: JOHNSON
PROJECT NUMBER: BRF 030-2(26)

FILE NAME: s88bi93xsl.dgn
PROJECT LEADER: C. CARLSON
DESIGNED BY: H. SALLS
VT 15 CROSS SECTIONS (6)

PLOT DATE: 10-JUN-2014
DRAWN BY: G. ROY
CHECKED BY: H. SALLS
SHEET 47 OF 69