



94+75

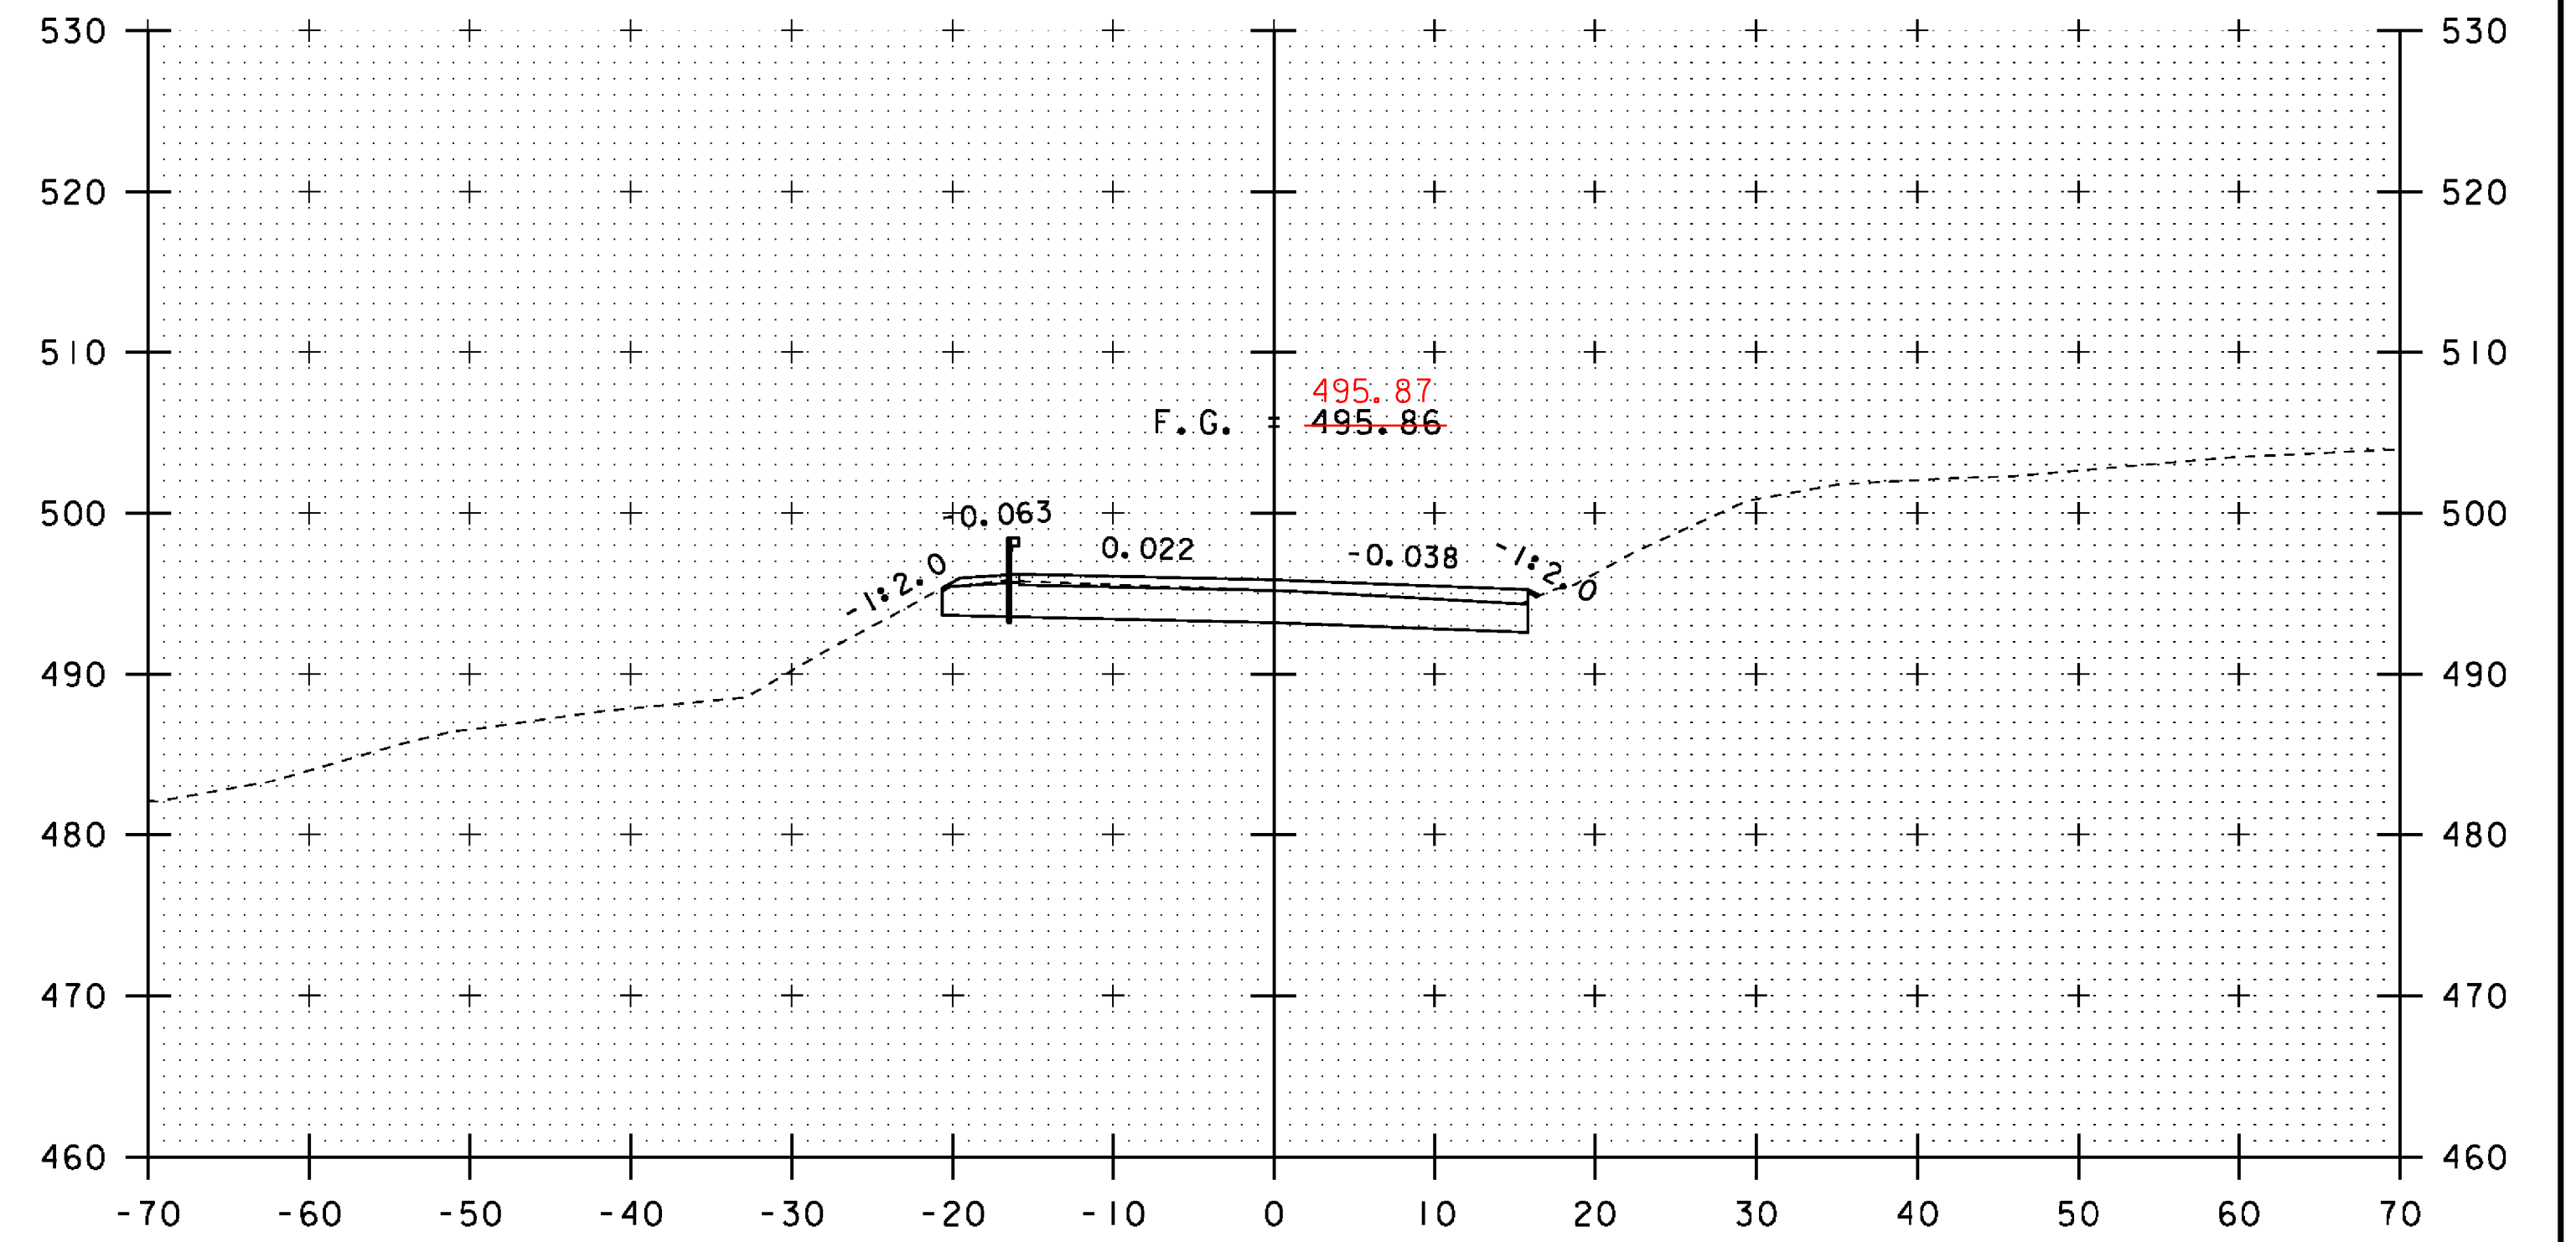


95+25

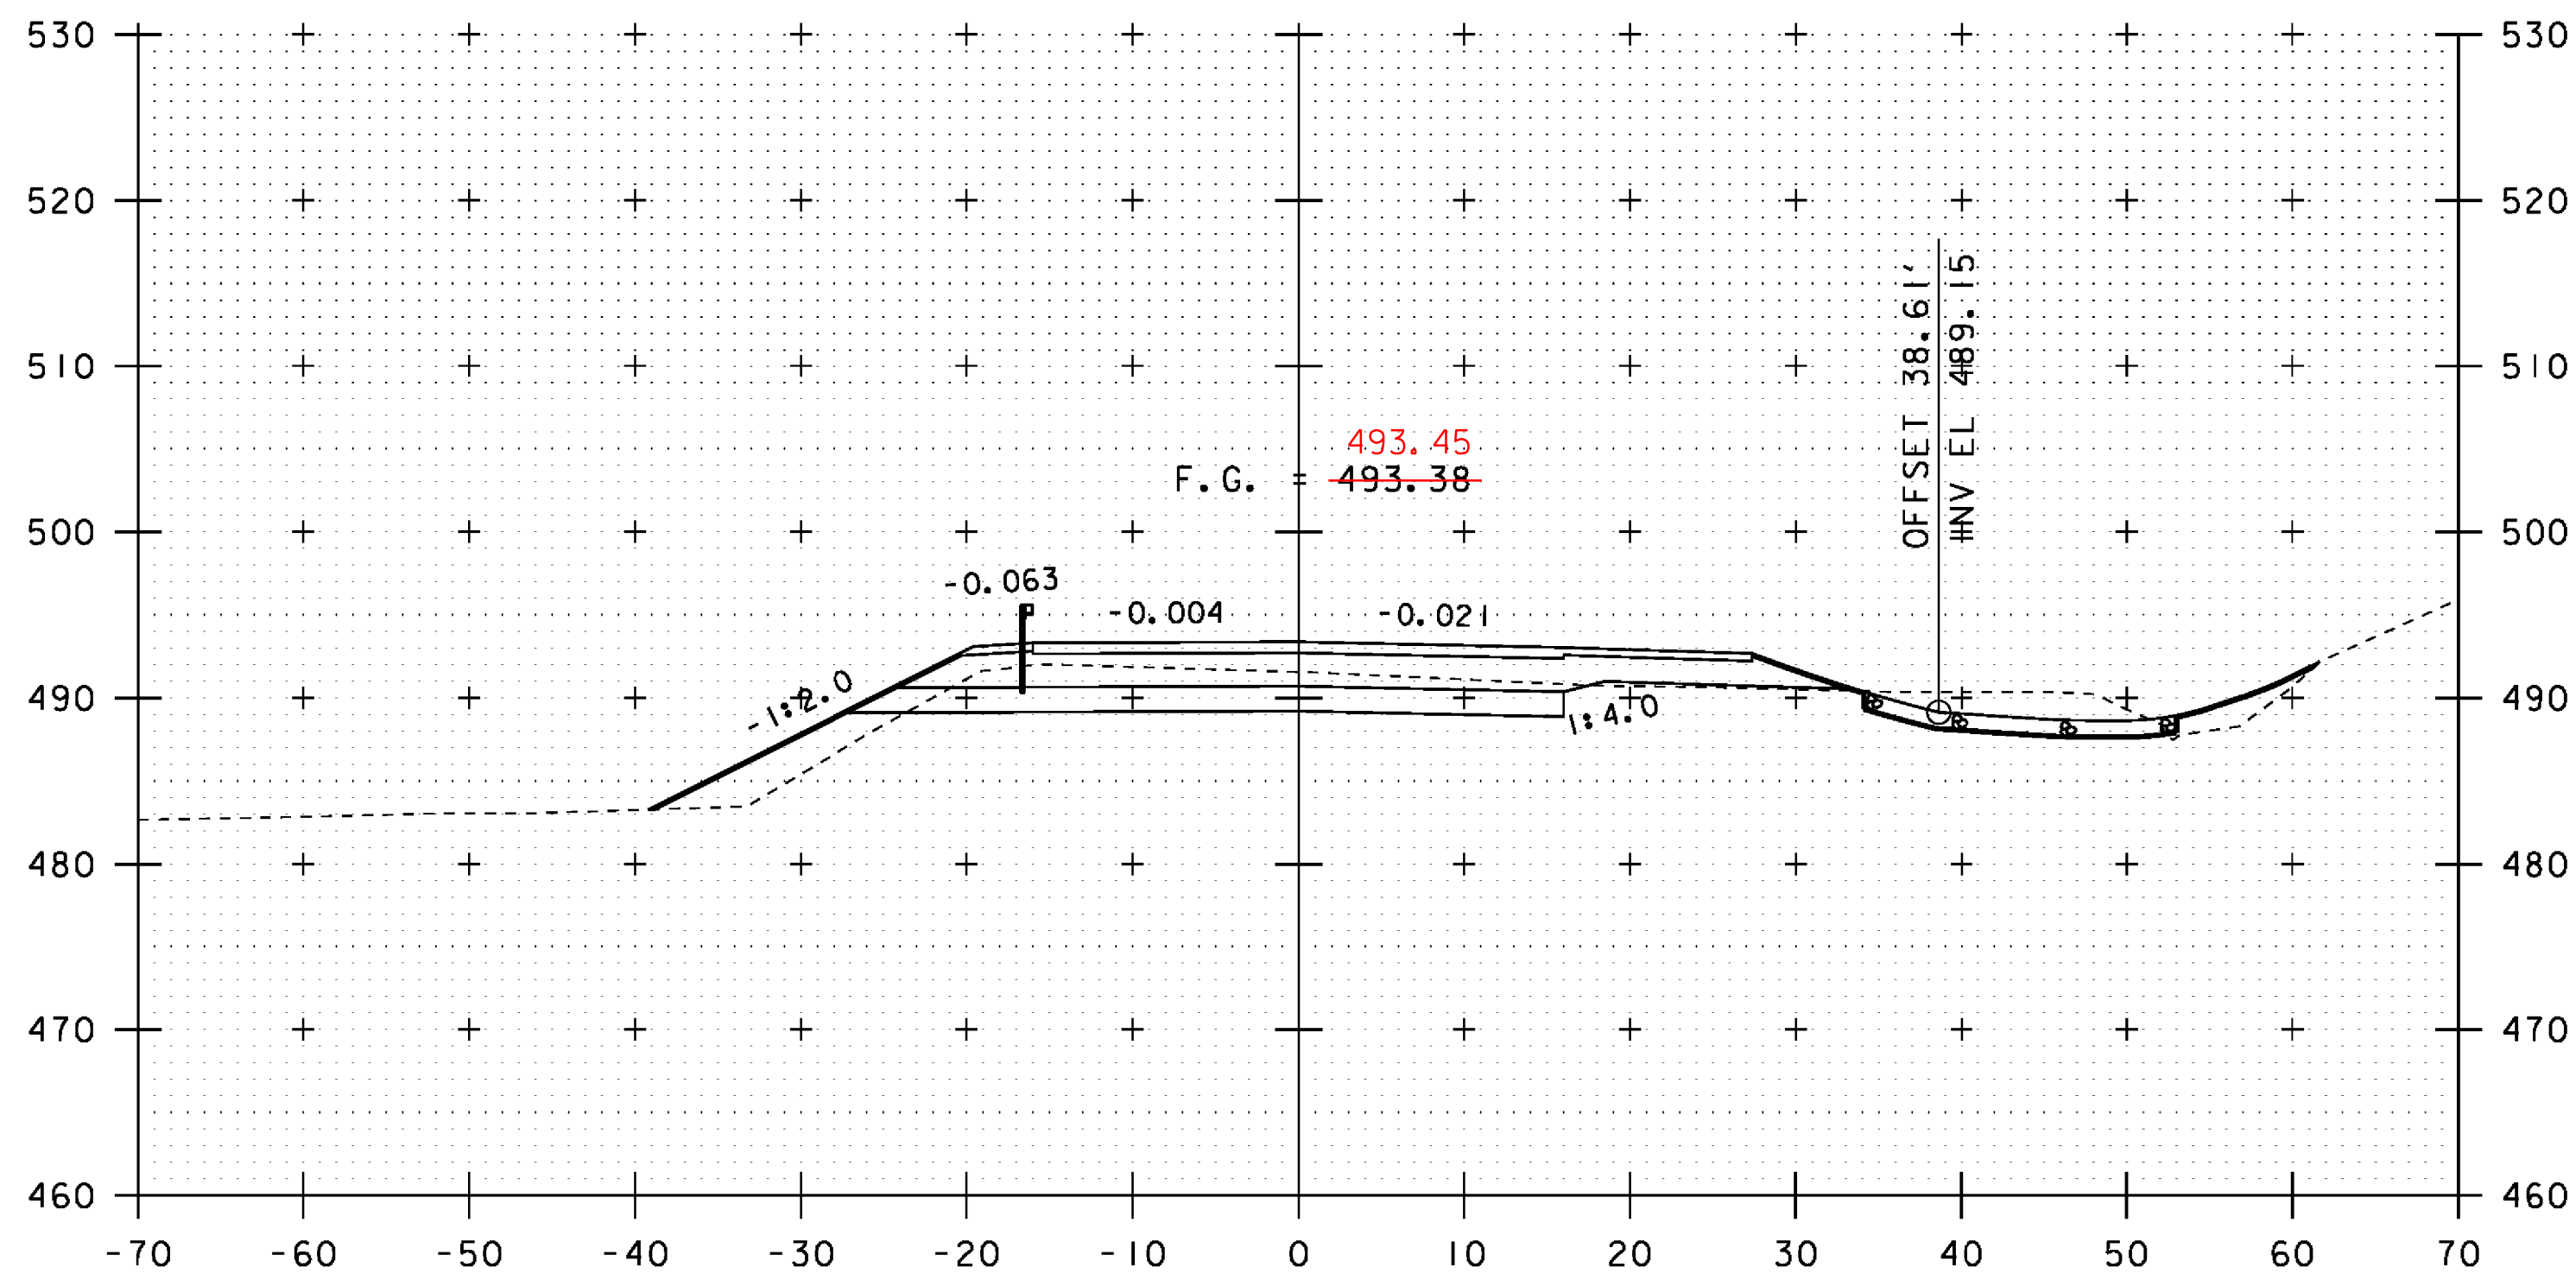


94+50

STA 94+47.0 RT - STA 95+06.0 RT  
CONSTRUCT STONE-LINED DITCH, TYPE I

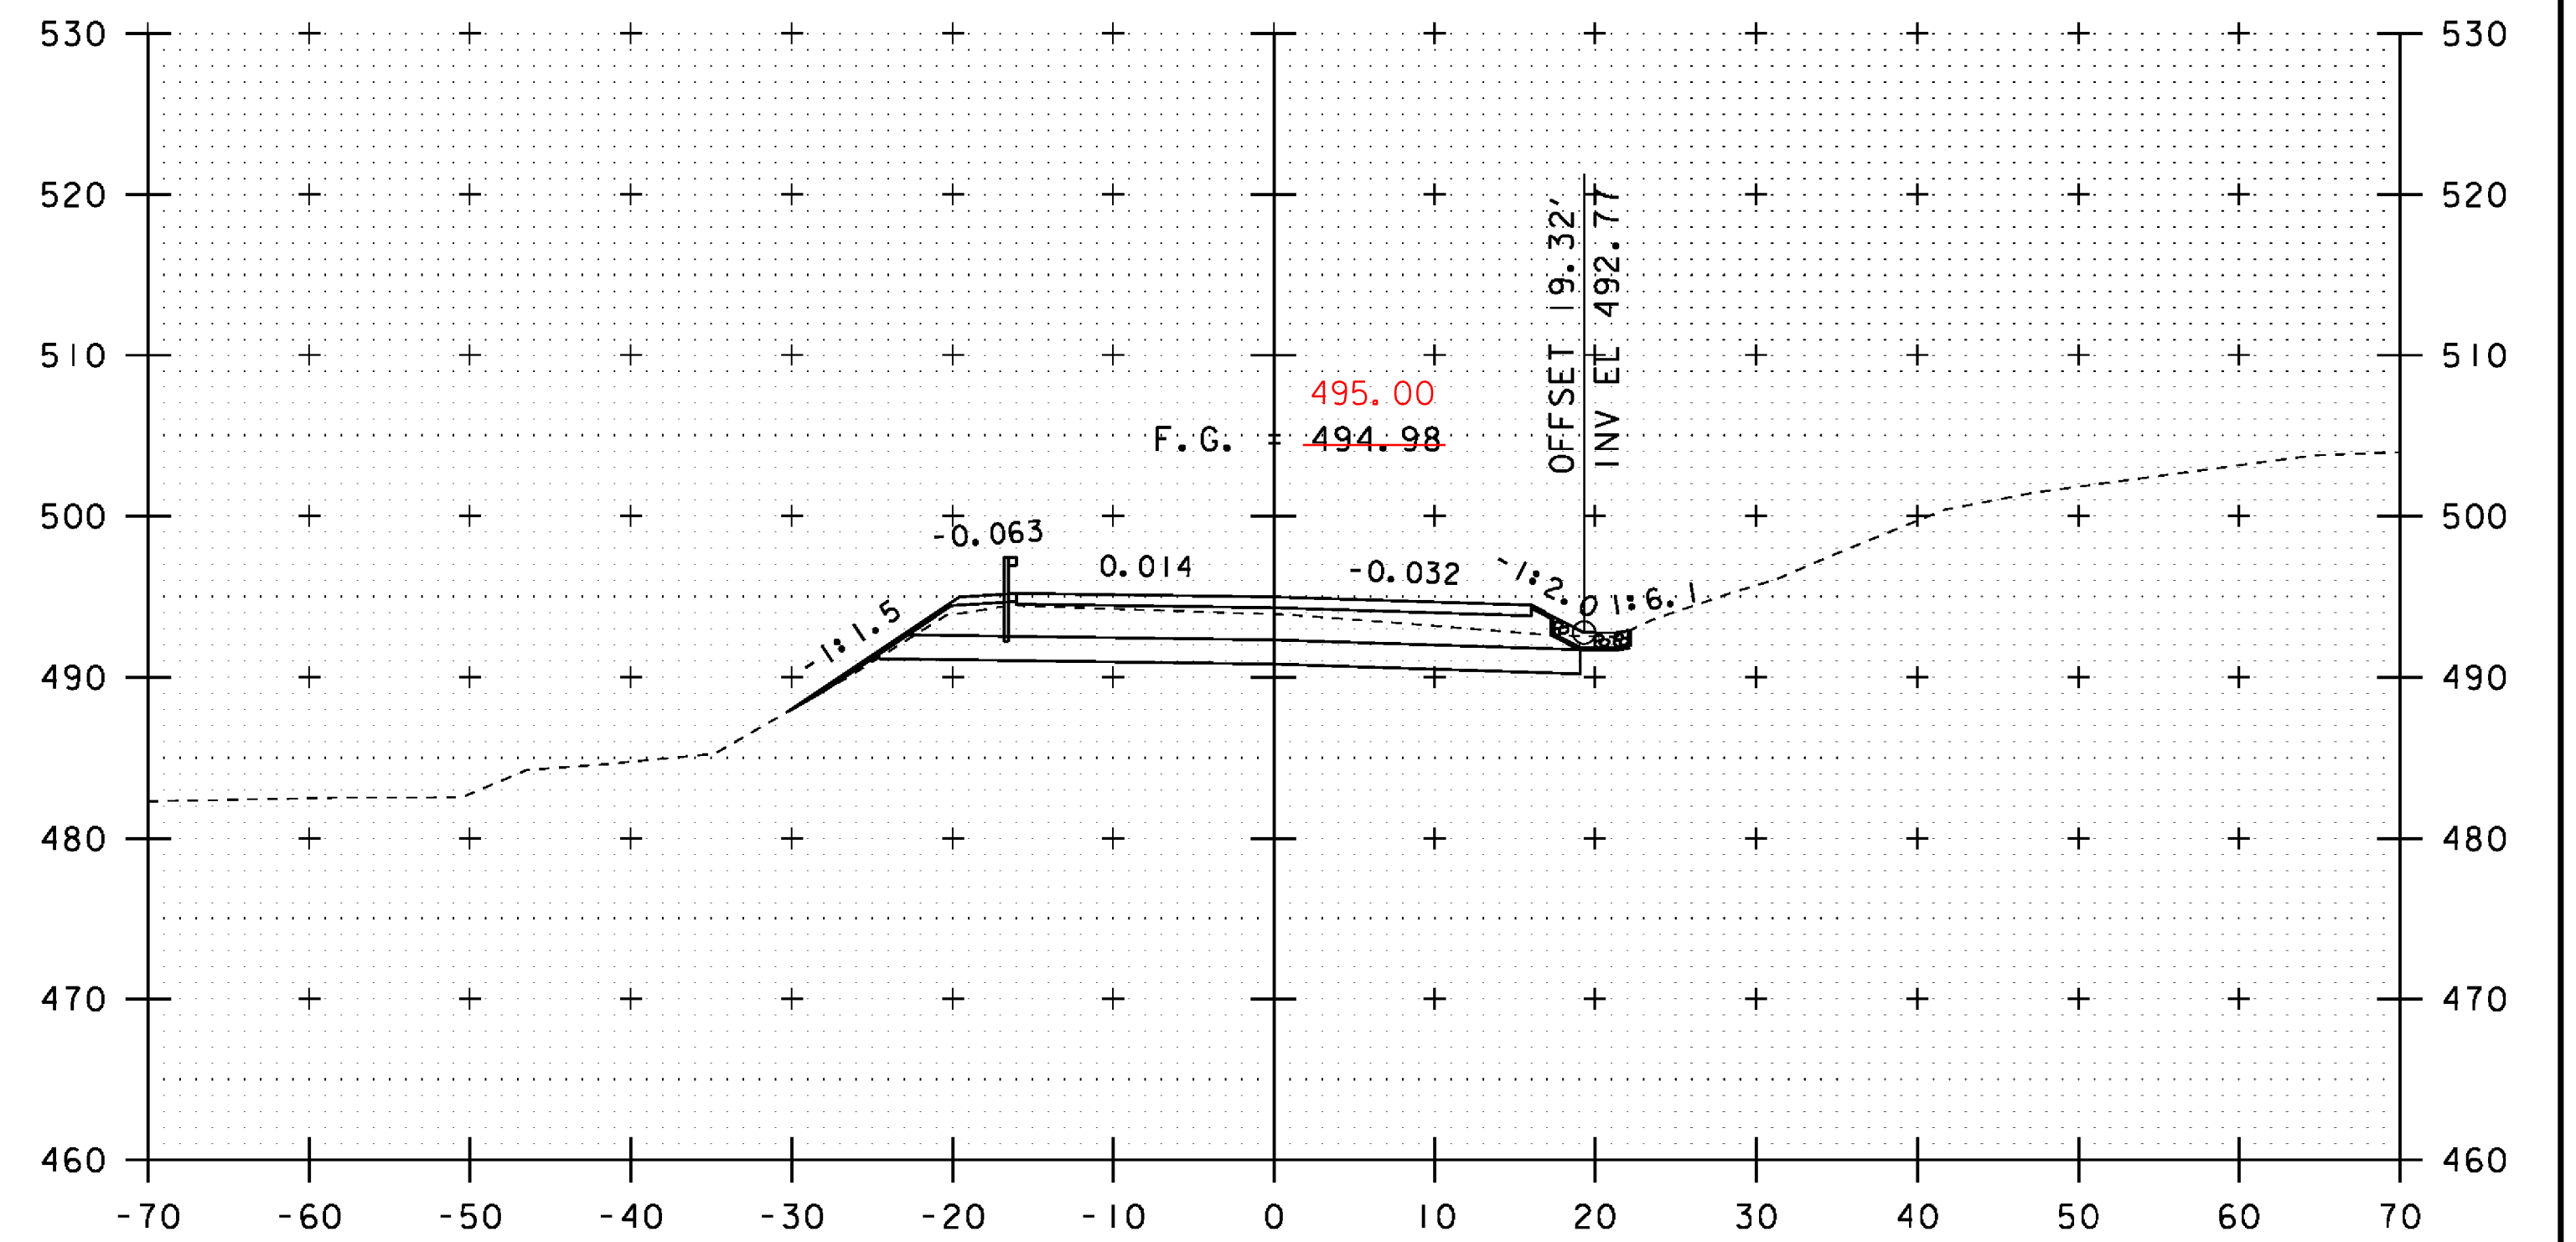

95+00

STA 95+00.00  
END PROJECT  
BEGIN APPROACH

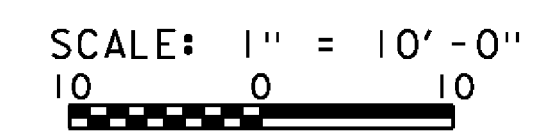

STA. 94+50 TO STA. 95+25

PROJECT NAME: JOHNSON  
PROJECT NUMBER: BRF 030-2(26)

FILE NAME: s88bi93xsl.dgn  
PROJECT LEADER: C. CARLSON  
DESIGNED BY: H. SALLS  
VT 15 CROSS SECTIONS (7)

PLOT DATE: 10-JUN-2014  
DRAWN BY: G. ROY  
CHECKED BY: H. SALLS  
SHEET 48 OF 69