


PIPE NO. 1 PROFILE

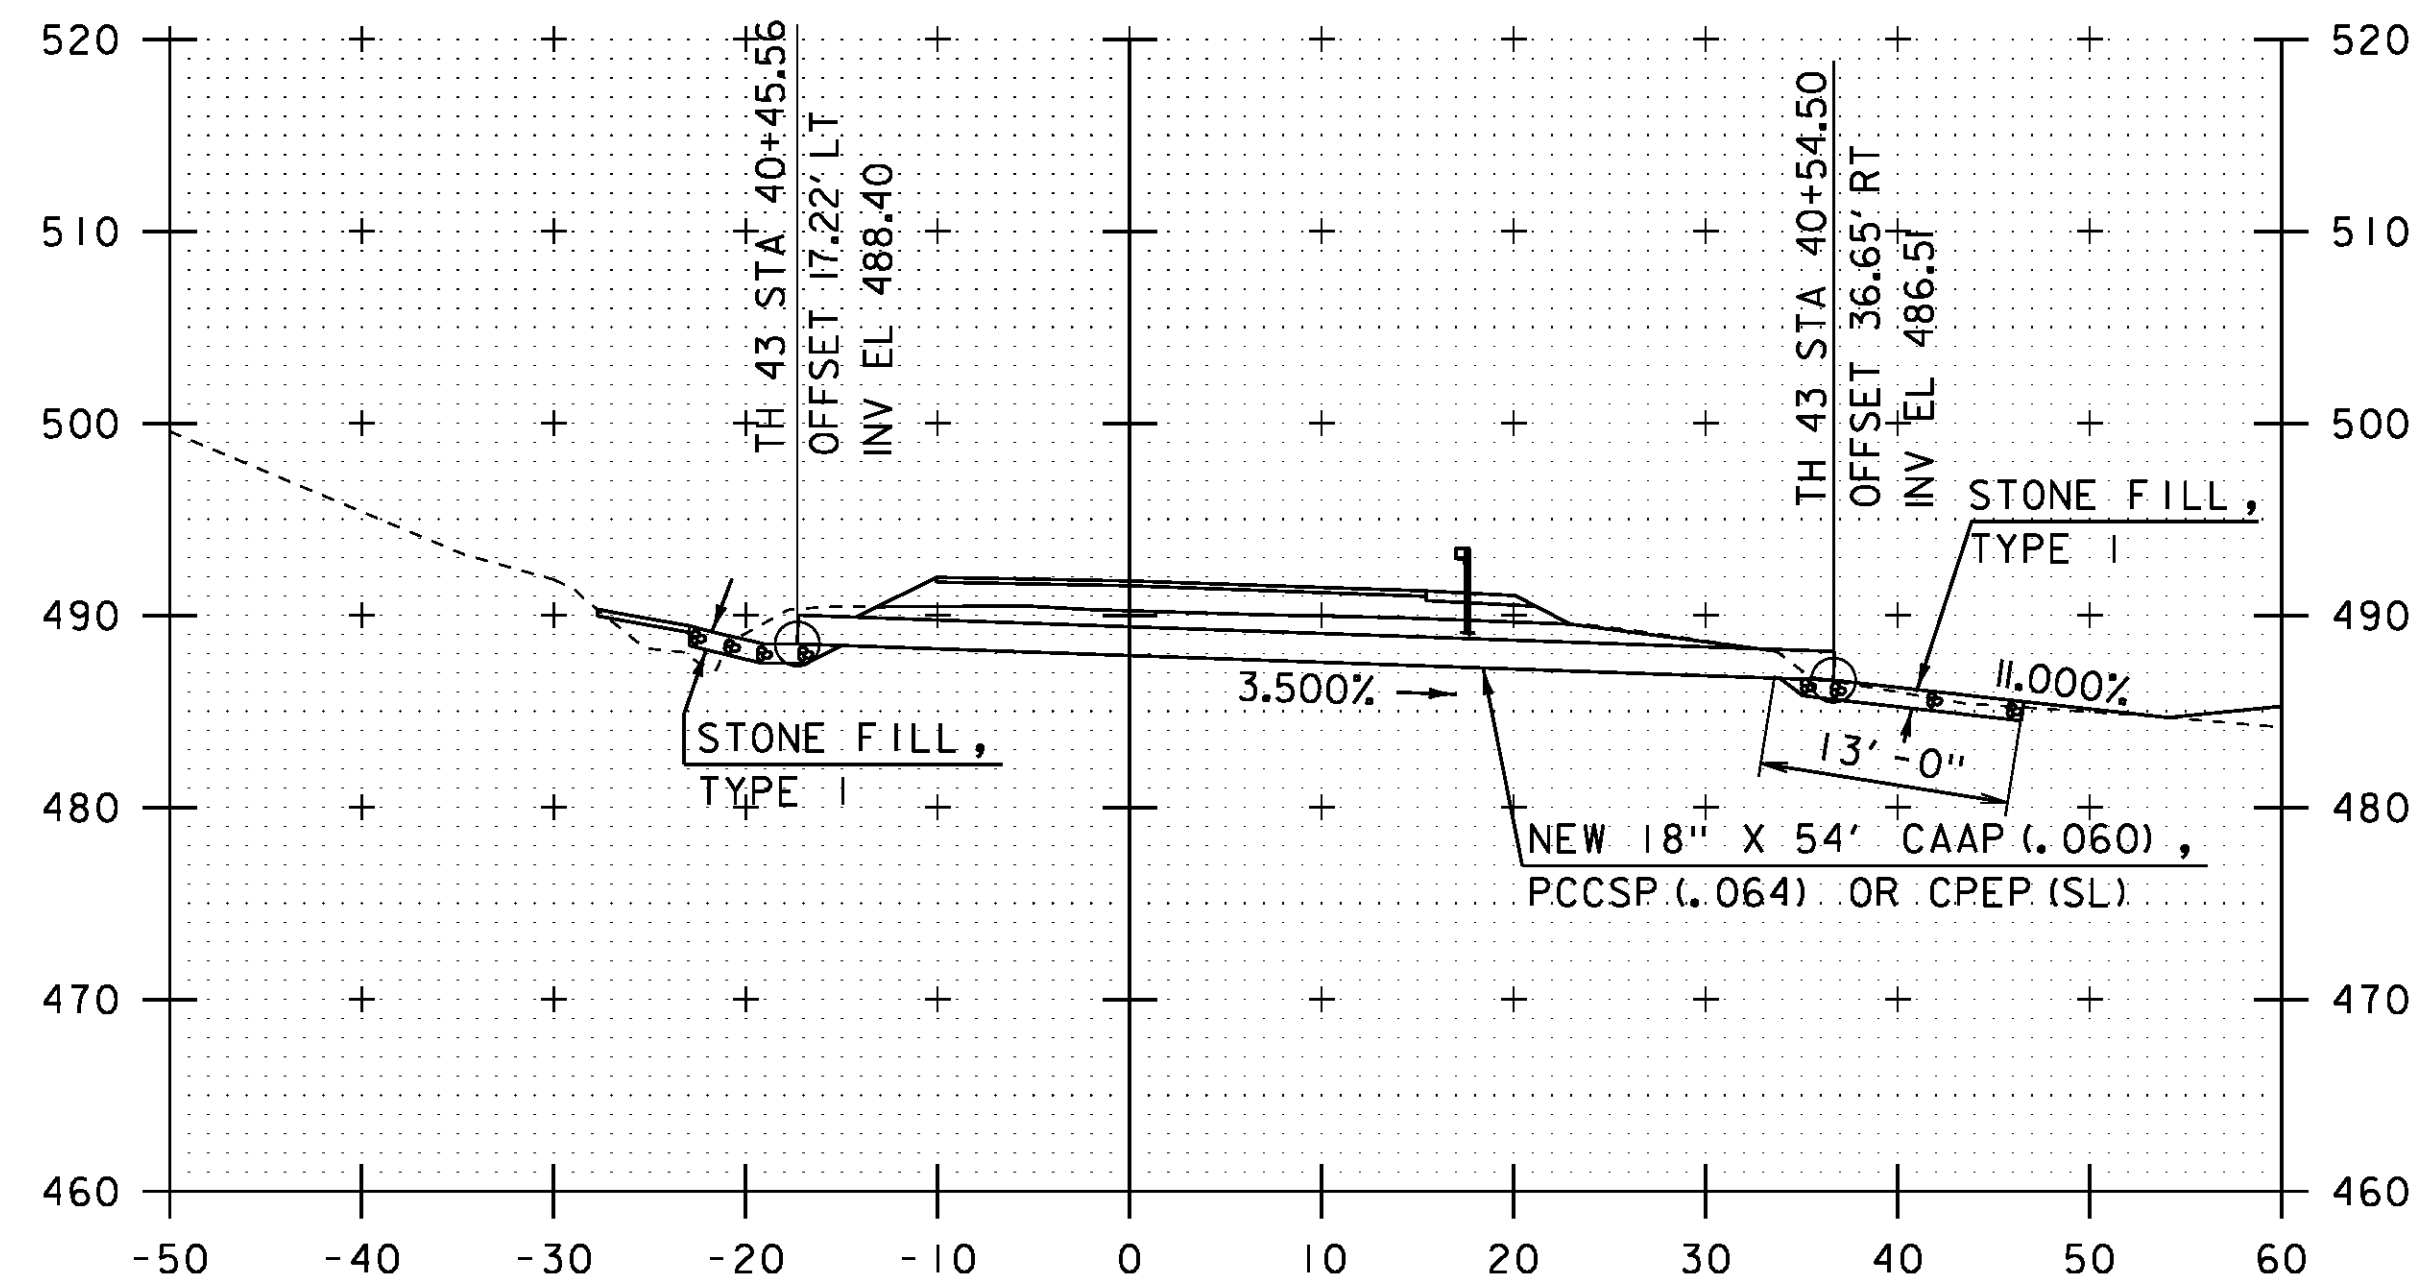

PIPE NO. 2 PROFILE

SCALE: 1" = 10'-0"

PROJECT NAME: JOHNSON	PLOT DATE: 10-JUN-2014
PROJECT NUMBER: BRF 030-2(26)	DRAWN BY: G. ROY
FILE NAME: s88b193xsl.dgn	CHECKED BY: H. SALLS
PROJECT LEADER: C. CARLSON	SHEET 52 OF 69
DESIGNED BY: H. SALLS	
PIPE PROFILES	