


21+30

CHANNEL STA 21+25.0 LT  
 END UNCLASSIFIED CHANNEL EXCAVATION  
 GEOTEXTILE UNDER STONE FILL  
 STONE FILL, TYPE III  
 GRUBBING MATERIAL

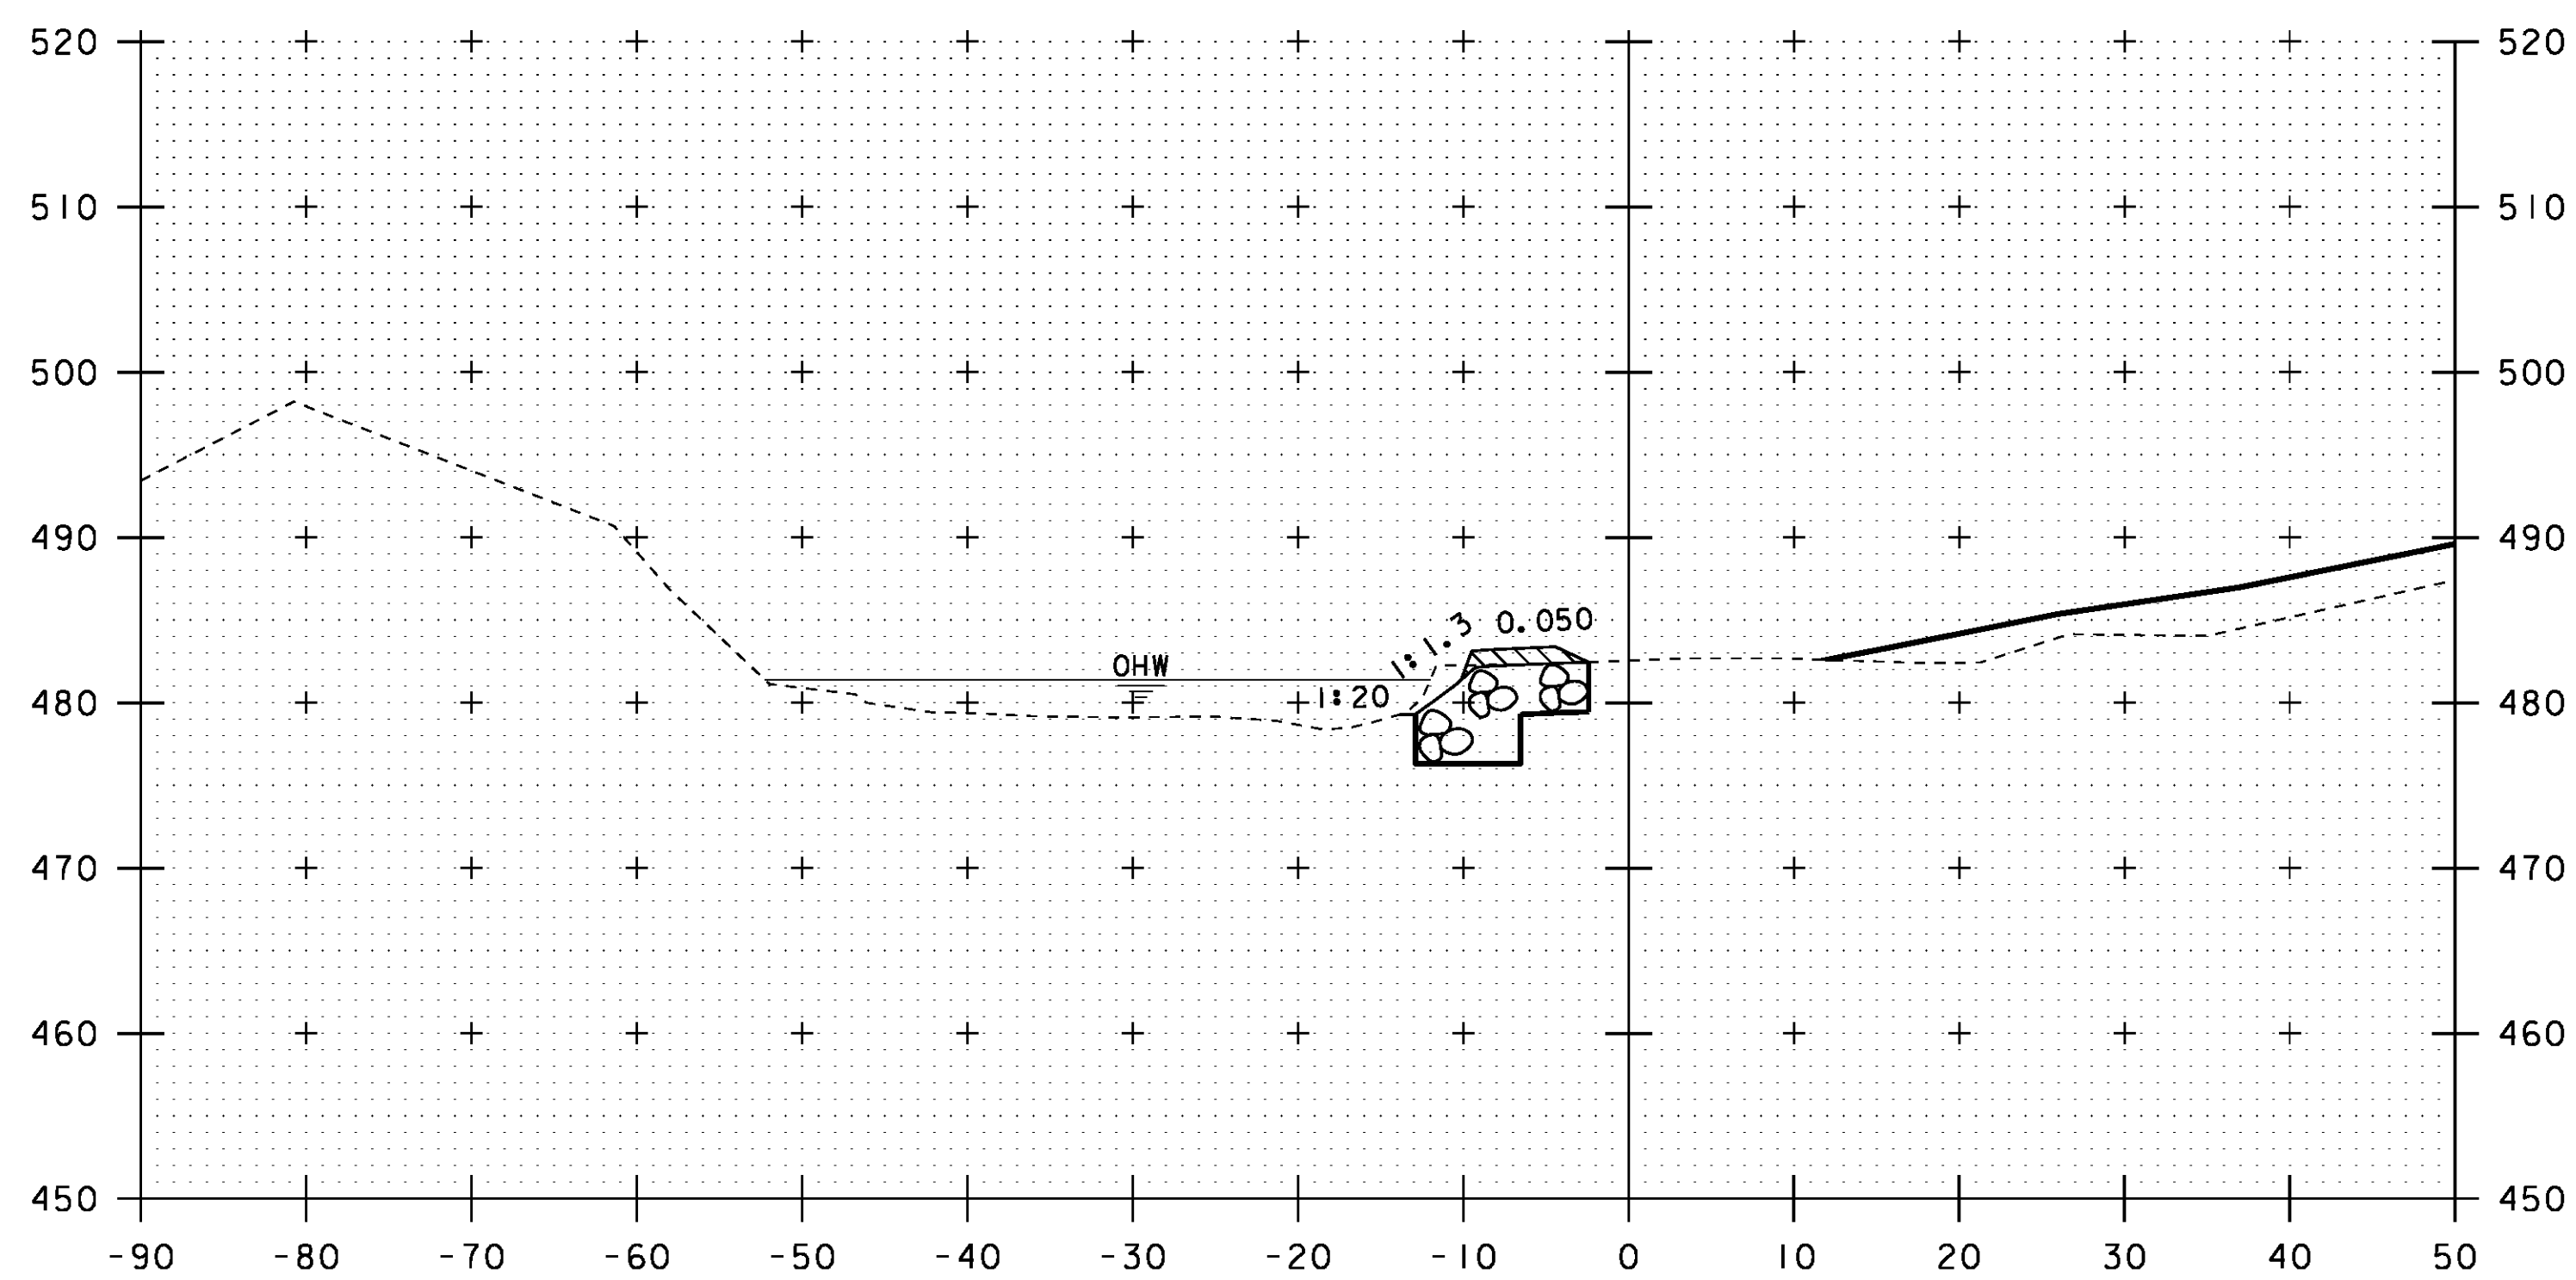

21+20

SCALE: 1" = 10'-0"

STA. 21+20 TO STA. 21+30

PROJECT NAME: JOHNSON  
 PROJECT NUMBER: BRP 030-2(26)

FILE NAME: s88bl93xsl.dgn  
 PROJECT LEADER: C. CARLSON  
 DESIGNED BY: H. SALLS  
 CHANNEL CROSS SECTIONS (4)

PLOT DATE: 10-JUN-2014  
 DRAWN BY: G. ROY  
 CHECKED BY: H. SALLS  
 SHEET 56 OF 69