

STATE OF VERMONT AGENCY OF TRANSPORTATION



PROPOSED IMPROVEMENT BRIDGE PROJECT


TOWN OF JOHNSON
COUNTY OF LAMOILLE

ROUTE NO : VT 15 (MINOR ARTERIAL) BRIDGE NO : 32


PROJECT LOCATION : BEGINNING AT A POINT ON VT. ROUTE 15, APPROXIMATELY 1.75 MILES EASTERLY OF THE CAMBRIDGE/JOHNSON TOWN LINE, AND EXTENDING 0.057 MILES EASTERLY.

PROJECT DESCRIPTION : REPLACEMENT OF EXISTING BRIDGE ALONG WITH RELATED APPROACH ROADWAY AND CHANNEL WORK.

LENGTH OF STRUCTURE : 57.78 FEET
LENGTH OF ROADWAY : 242.22 FEET
LENGTH OF PROJECT : 300.00 FEET

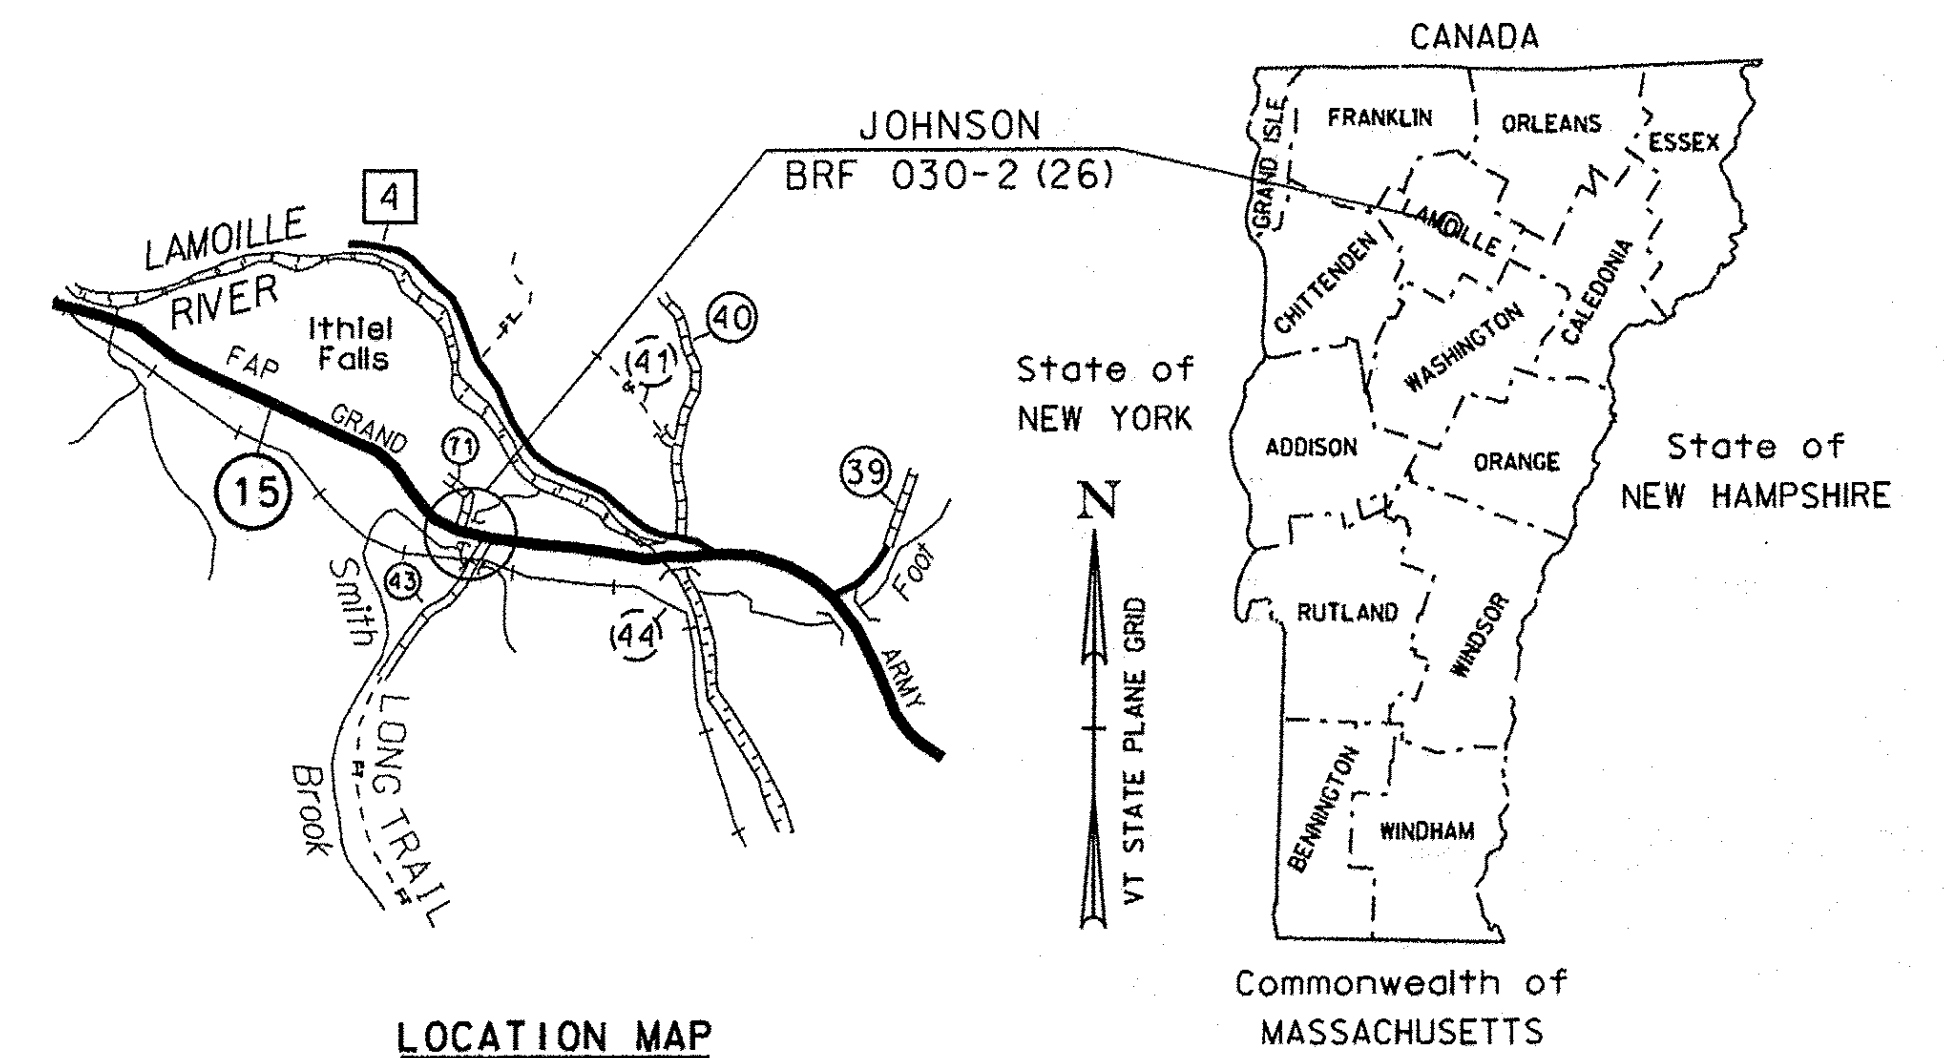


RECORD PLANS	
CONTRACTOR:	A.L. ST. ONGE CONTRACTOR, INC. - MONTGOMERY, VT.
RESIDENT ENGINEER:	JEFF COTA
CONSTRUCTION BEGAN:	OCTOBER 20, 2014
CONSTRUCTION COMPLETE:	AUGUST 26, 2015
RECORD PLANS BY:	JEFF COTA & KEVIN KING
I HEREBY CERTIFY THAT ALL THE CONSTRUCTION REQUIRED BY THIS SET OF DRAWINGS HAS BEEN ACCOMPLISHED AS INDICATED HEREIN.	
BY	RESIDENT ENGINEER
DATE	7/11/16
NOTE: Any further information concerning final quantities, amounts or other details relative to this project may be found at Central Files in the electronic archives.	

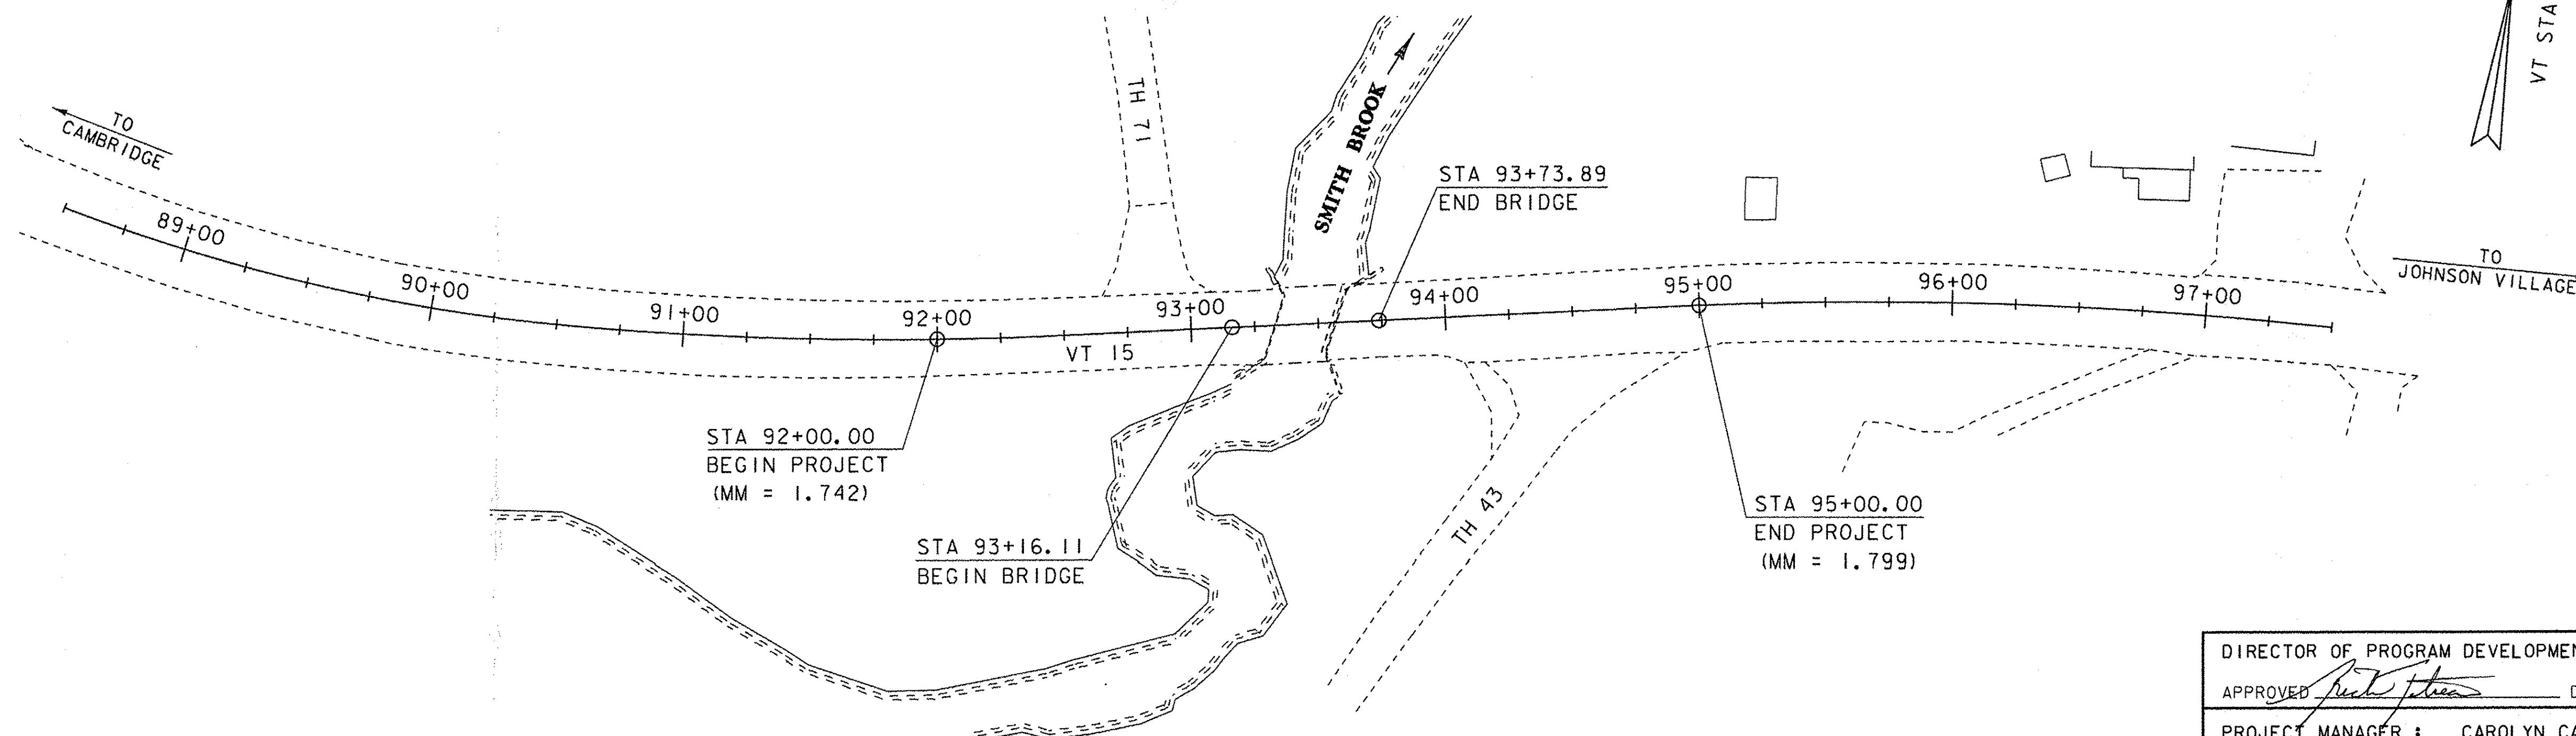

THESE PLANS ARE SUBJECT TO SUCH ENGINEERING CHANGES AS MAY BE REQUIRED BY THE FEDERAL HIGHWAY ADMINISTRATION OR THE DIRECTOR OF PROGRAM DEVELOPMENT.
CONSTRUCTION IS TO BE CARRIED ON IN ACCORDANCE WITH THESE PLANS AND THE STANDARD SPECIFICATIONS FOR CONSTRUCTION DATED 2011, AS APPROVED BY THE FEDERAL HIGHWAY ADMINISTRATION ON JULY 20, 2011 FOR USE ON THIS PROJECT, INCLUDING ALL SUBSEQUENT REVISIONS AND SUCH REVISED SPECIFICATIONS AND SPECIAL PROVISIONS AS ARE INCORPORATED IN THESE PLANS.

QUALITY ASSURANCE PROGRAM : LEVEL 2	
SURVEYED BY :	R. GILMAN
SURVEYED DATE :	10/28/09
DATUM	
VERTICAL	NAVD88
HORIZONTAL	NAD83 (96)

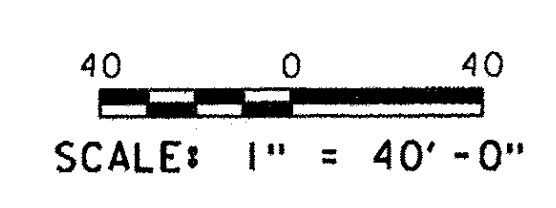

DIRECTOR OF PROGRAM DEVELOPMENT	
APPROVED	DATE 6-11-14
PROJECT MANAGER :	CAROLYN CARLSON, P.E.
PROJECT NAME :	JOHNSON
PROJECT NUMBER :	BRF 030-2 (26)
SHEET 1	OF 69 SHEETS

PRELIMINARY INFORMATION SHEET (BRIDGE)

INDEX OF SHEETS

FINAL HYDRAULIC REPORT

PLAN SHEETS

1	TITLE
2	PRELIMINARY INFORMATION SHEET
3	CONVENTIONAL SYMBOLS - LEGEND
4 - 5	TYPICAL SECTIONS
6	PROJECT NOTES
7 - 9	QUANTITY SHEETS
10	BRIDGE QUANTITY SHEET
11	TIE SHEET
12	ALIGNMENT
13 - 14	LAYOUTS
15 - 16	VT 15 PROFILES
17	TH 71 AND TH 43 PROFILES AND MATERIAL TRANSITIONS
18 - 19	UTILITY LAYOUTS
20 - 21	SIGNS & PAVEMENT MARKINGS
22	TRAFFIC SIGN SUMMARY
23	BORING INFORMATION
24 - 25	BORING LOGS
26	PLAN AND ELEVATION
27	BRIDGE DECK DETAILS
28	FRAMING PLAN AND STEM END DETAILS
29	NEXT BEAM SECTIONS AND STRAND DETAILS
30	BEARING DETAILS
31	APPROACH SLAB PLAN AND TYPICAL SECTION
32	ABUTMENT #1 PLAN AND ELEVATION
33	ABUTMENT #2 PLAN AND ELEVATION
34	ABUTMENT TYPICAL SECTION
35	WINGWALL ELEVATIONS AND TYPICAL SECTION
36	ABUTMENT #1 AND #2 PILE LAYOUT
37	RETAINING WALL ELEVATION AND TYPICAL SECTION
38	REINFORCING STEEL SCHEDULE
39 - 40	GUARDRAIL TRANSITION DETAILS
41	VT 15 BANKING DIAGRAM AND MATERIAL TRANSITION
42 - 49	VT 15 CROSS SECTIONS
50	TH 71 CROSS SECTIONS
51	TH 43 CROSS SECTIONS
52	PIPE PROFILES
53 - 56	CHANNEL CROSS SECTIONS
57	EPSC NARRATIVE
58 - 59	EPSC EXISTING CONDITIONS
60 - 61	EPSC CONSTRUCTION CONDITIONS
62 - 63	EPSC FINAL CONDITIONS
64 - 66	EPSC DETAILS
67	R.O.W. DETAIL SHEET #1
68 - 69	R.O.W. LAYOUTS

STANDARDS LIST

D-30	UNDERDRAIN CONSTRUCTION DETAILS	08-13-2007
E-121	STANDARD SIGN PLACEMENT - CONVENTIONAL ROAD	08-08-1995
E-141	REGULATORY SIGN DETAILS	09-20-1995
E-191	PAVEMENT MARKING DETAILS	02-01-1999
E-193	PAVEMENT MARKING DETAILS	08-18-1995
G-1	STEEL BEAM GUARDRAIL DETAILS (POST, DELINEATOR, TYPICALS)	02-10-2014
G-1B	BOX BEAM GUARD RAIL	08-01-1994
S-364A	BRIDGE RAILING, GALVANIZED 3 RAIL BOX BEAM	04-23-2012
S-364B	GUARDRAIL APPROACH SECTION, GALVANIZED 3 RAIL BOX BEAM	04-23-2012
S-364C	GUARDRAIL APPROACH SECTION, GALVANIZED 3 RAIL BOX BEAM	04-23-2012
S-364D	GUARDRAIL APPROACH SECTION, GALVANIZED 3 RAIL BOX BEAM	04-23-2012
T-1	TRAFFIC CONTROL GENERAL NOTES	08-06-2012
T-10	CONVENTIONAL ROADS CONSTRUCTION APPROACH SIGNING	08-06-2012
T-28	CONSTRUCTION SIGN DETAILS	08-06-2012
T-30	CONSTRUCTION SIGN DETAILS	08-06-2012
T-31	CONSTRUCTION SIGN DETAILS	08-06-2012
T-35	CONSTRUCTION ZONE LONGITUDINAL DROP-OFFS	08-06-2012
T-44	MILEMARKER DETAILS STATE AND TOWN HIGHWAYS	04-09-2014
T-45	SQUARE TUBE SIGN POST AND ANCHOR	01-02-2013

STRUCTURES DETAIL SHEETS

SD-501.00	CONCRETE DETAILS AND NOTES	2/9/2012
SD-502.00	CONCRETE DETAILS AND NOTES	10/10/2012
SD-516.10	BRIDGE JOINT ASPHALTIC PLUG	8/29/2011
SD-601.00	STRUCTURAL STEEL DETAILS AND NOTES	6/4/2010

HYDROLOGIC DATA

Date: November 2013

DRAINAGE AREA : 4.3 sq. mi.
 CHARACTER OF TERRAIN : Mostly forested, mountainous
 STREAM CHARACTERISTICS : Sinuous, steep and probably incised
 NATURE OF STREAMBED : Mostly gravel and sand, some cobbles

PEAK FLOW DATA

Q 2.33 =	325 cfs	Q 50 =	1025 cfs
Q 10 =	650 cfs	Q 100 =	1200 cfs
Q 25 =	850 cfs	Q 500 =	1700 cfs

DATE OF FLOOD OF RECORD : Unknown
 ESTIMATED DISCHARGE : Unknown
 WATER SURFACE ELEV. : Unknown
 NATURAL STREAM VELOCITY : @ Q50 = 5.0 fps
 ICE CONDITIONS : Moderate
 DEBRIS : Moderate
 DOES THE STREAM REACH MAXIMUM HIGHWATER ELEV. RAPIDLY? No
 IS ORDINARY RISE RAPID? No
 IS STAGE AFFECTED BY UPSTREAM OR DOWNSTREAM CONDITIONS? Possibly
 IF YES, DESCRIBE : Backwater from Lamoille River

PROPOSED STRUCTURE

STRUCTURE TYPE : Single span concrete bridge NEX I 24F

CLEAR SPAN(NORMAL TO STREAM): 50'
 VERTICAL CLEARANCE ABOVE STREAMBED: ~9'
 WATERWAY OF FULL OPENING: 360 sq. ft.

WATER SURFACE ELEVATIONS AT:

Q2.33 =	482.2'	VELOCITY =	5.0 fps
Q10 =	483.6'	"	6.2 fps
Q25 =	484.3'	"	6.7 fps
Q50 =	484.7'	"	7.1 fps
Q100 =	485.1'	"	7.6 fps

IS THE ROADWAY OVERTOPPED BELOW Q100: No
 FREQUENCY: N/A
 RELIEF ELEVATION: 489.3'
 DISCHARGE OVER ROAD @Q100: N/A

AVERAGE LOW ELEVATION OF SUPERSTRUCTURE: 487.8'
 VERTICAL CLEARANCE: @ Q50 = 3.1'

SCOUR: Contraction scour is 0' up to Q50.

REQUIRED CHANNEL PROTECTION: Stone Fill, Type III

PERMIT INFORMATION

AVERAGE DAILY FLOW: 10 cfs DEPTH OR ELEVATION:
 ORDINARY LOW WATER: 5 cfs 0.5'
 ORDINARY HIGH WATER: 140 cfs 3.0'

TEMPORARY BRIDGE REQUIREMENTS

STRUCTURE TYPE: Single span bridge
 CLEAR SPAN (NORMAL TO STREAM): 35'
 VERTICAL CLEARANCE ABOVE STREAMBED: Low beam elevation 484.5'
 WATERWAY AREA OF FULL OPENING: 160 sq. ft.

ADDITIONAL INFORMATION

TRAFFIC MAINTENANCE NOTES

1. MAINTAIN TWO-WAY TRAFFIC ON A TEMPORARY BRIDGE.
2. TRAFFIC SIGNALS ARE NOT NECESSARY.
3. SIDEWALKS ARE NOT NECESSARY
4. THE APPROACHES FOR THE TEMPORARY BRIDGE SHALL BE PAVED.

DESIGN VALUES

1. DESIGN LIVE LOAD	HL-93
2. FUTURE PAVEMENT	d _p : 3.0 INCH
3. DESIGN SPAN	L: 56.00 FT
4. MIN. MID-SPAN POS. CAMBER @ RELEASE (PRESTRESSED UNITS)	Δ: 1.51 INCH
5. PRESTRESSING STRAND (0.60 INCH DIAMETER - LOW RELAX)	f _y : 270 KSI
6. PRESTRESSED CONCRETE STRENGTH	f' _c : 8.0 KSI
7. PRESTRESSED CONCRETE RELEASE STRENGTH	f' _c : 6.5 KSI
8. CONCRETE, HIGH PERFORMANCE CLASS AA	f' _c : ---
9. CONCRETE, HIGH PERFORMANCE CLASS A	f' _c : 4.0 KSI
10. CONCRETE, HIGH PERFORMANCE CLASS B	f' _c : 3.5 KSI
11. CONCRETE, CLASS C	f' _c : ---
12. REINFORCING STEEL	f _y : 60 KSI
13. STRUCTURAL STEEL AASHTO M270	f _y : ---
14. NOMINAL BEARING RESISTANCE OF SOIL	q _n : 4.0 KSF
15. SOIL BEARING RESISTANCE FACTOR (REFER TO AASHTO LRFD)	φ: ---
16. NOMINAL BEARING RESISTANCE OF ROCK	q _n : 10.0 KSF
17. ROCK BEARING RESISTANCE FACTOR (REFER TO AASHTO LRFD)	φ: ---
18. PILE RESISTANCE FACTOR	φ: 0.65
19. LATERAL PILE DEFLECTION	Δ: 0.16 INCH
20. BASIC WIND SPEED	V _{3s} : ---
21. MINIMUM GROUND SNOW LOAD	p _g : ---
22. EST. PILE LENGTHS (TWO SUBSTRUCTURES)	S _s : ---
(ABUTMENT 1 = 50 AND ABUTMENT 2 = 48) FT	
6 PILES PER ABUTMENT	

SEE REVISION: OCT-28-2014

PROJECT NAME: JOHNSON

PROJECT NUMBER: BRF 030-2(26)

FILE NAME: s88b193pi.dgn PLOT DATE: 7/11/2014

PROJECT LEADER: C. CARLSON DRAWN BY: G. ROY

DESIGNED BY: H. SALLS CHECKED BY: H. SALLS

PRELIMINARY INFORMATION SHEET SHEET 2 OF 69

EXISTING STRUCTURE INFORMATION

STRUCTURE TYPE: Single span concrete T-beam
 YEAR BUILT: 1926, Reconstructed in 1969
 CLEAR SPAN(NORMAL TO STREAM): 22'
 VERTICAL CLEARANCE ABOVE STREAMBED: 6.8'
 WATERWAY OF FULL OPENING: 140 sq. ft.
 DISPOSITION OF STRUCTURE: Replace
 TYPE OF MATERIAL UNDER SUBSTRUCTURE: See borings

WATER SURFACE ELEVATIONS AT:

Q2.33 =	482.4'	VELOCITY =	6.0 fps
Q10 =	484.1'	"	8.2 fps
Q25 =	484.9'	"	9.7 fps
Q50 =	486.4'	"	9.9 fps
Q100 =	486.7'	"	11.0 fps

LONG TERM STREAMBED CHANGES: None noted

IS THE ROADWAY OVERTOPPED BELOW Q100: No
 FREQUENCY: N/A
 RELIEF ELEVATION: 488.7'
 DISCHARGE OVER ROAD @Q100: N/A

UPSTREAM STRUCTURE

TOWN: Johnson DISTANCE: 2047'
 HIGHWAY #: Lamoille Valley Rail Trail STRUCTURE #:
 CLEAR SPAN: CLEAR HEIGHT:
 YEAR BUILT: FULL WATERWAY:
 STRUCTURE TYPE:

DOWNSTREAM STRUCTURE

TOWN: Johnson DISTANCE: 1000'
 HIGHWAY #: STRUCTURE #:
 CLEAR SPAN: CLEAR HEIGHT:
 YEAR BUILT: FULL WATERWAY:
 STRUCTURE TYPE: Confluence with Lamoille River


LRFR LOAD RATING FACTORS

LOADING LEVELS	TRUCK						
	H-20	HL-93	3S2	6 AXLE	3A. STR.	4A. STR.	5A. SEMI
TONNAGE	20	36	36	66	30	34.5	38
INVENTORY	2.39	1.32					
POSTING							
OPERATING	3.15	1.73	3.08	1.74	2.26	2.05	2.39
COMMENTS:							

AS BUILT "REBAR" DETAIL

LEVEL I	LEVEL II	LEVEL III
TYPE:	TYPE:	TYPE:
GRADE:	GRADE:	GRADE:

TEMPORARY BRIDGE PROFILE ALONG TEMP CL

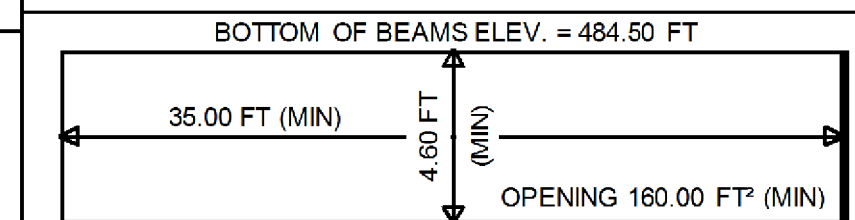

TRAFFIC DATA

YEAR	ADT	DHV	% D	% T	ADTT	20 year ESAL for flexible pavement from 2012 to 2032 : 4615000
2012	5000	560	56	4	510	40 year ESAL for flexible pavement from 2012 to 2052 : 11448000
2032	5700	640	56	5.7	830	Design Speed : 50 mph

PRELIMINARY INFORMATION SHEET (BRIDGE)

INDEX OF SHEETS

FINAL HYDRAULIC REPORT

PLAN SHEETS

1	TITLE
2	PRELIMINARY INFORMATION SHEET
3	CONVENTIONAL SYMBOLOLOGY - LEGEND
4 - 5	TYPICAL SECTIONS
6	PROJECT NOTES
7 - 9	QUANTITY SHEETS
10	BRIDGE QUANTITY SHEET
11	TIE SHEET
12	ALIGNMENT
13 - 14	LAYOUTS
15 - 16	VT 15 PROFILES
17	TH 71 AND TH 43 PROFILES AND MATERIAL TRANSITIONS
18 - 19	UTILITY LAYOUTS
20 - 21	SIGNS & PAVEMENT MARKINGS
22	TRAFFIC SIGN SUMMARY
23	BORING INFORMATION
24 - 25	BORING LOGS
26	PLAN AND ELEVATION
27	BRIDGE DECK DETAILS
28	FRAMING PLAN AND STEM END DETAILS
29	NEXT BEAM SECTIONS AND STRAND DETAILS
30	BEARING DETAILS
31	APPROACH SLAB PLAN AND TYPICAL SECTION
32	ABUTMENT #1 PLAN AND ELEVATION
33	ABUTMENT #2 PLAN AND ELEVATION
34	ABUTMENT TYPICAL SECTION
35	WINGWALL ELEVATIONS AND TYPICAL SECTION
36	ABUTMENT #1 AND #2 PILE LAYOUT
37	RETAINING WALL ELEVATION AND TYPICAL SECTION
38	REINFORCING STEEL SCHEDULE
39 - 40	GUARDRAIL TRANSITION DETAILS
41	VT 15 BANKING DIAGRAM AND MATERIAL TRANSITION
42 - 49	VT 15 CROSS SECTIONS
50	TH 71 CROSS SECTIONS
51	TH 43 CROSS SECTIONS
52	PIPE PROFILES
53 - 56	CHANNEL CROSS SECTIONS
57	EPSC NARRATIVE
58 - 59	EPSC EXISTING CONDITIONS
60 - 61	EPSC CONSTRUCTION CONDITIONS
62 - 63	EPSC FINAL CONDITIONS
64 - 66	EPSC DETAILS
67	R.O.W. DETAIL SHEET #1
68 - 69	R.O.W. LAYOUTS

STANDARDS LIST

D-30	UNDERDRAIN CONSTRUCTION DETAILS	08-13-2007
E-121	STANDARD SIGN PLACEMENT - CONVENTIONAL ROAD	08-08-1995
E-141	REGULATORY SIGN DETAILS	09-20-1995
E-191	PAVEMENT MARKING DETAILS	02-01-1999
E-193	PAVEMENT MARKING DETAILS	08-18-1995
G-1	STEEL BEAM GUARDRAIL DETAILS (POST, DELINEATOR, TYPICALS)	02-10-2014
G-1B	BOX BEAM GUARD RAIL	06-01-1994
S-364A	BRIDGE RAILING, GALVANIZED 3 RAIL BOX BEAM	04-23-2012
S-364B	GUARDRAIL APPROACH SECTION, GALVANIZED 3 RAIL BOX BEAM	04-23-2012
S-364C	GUARDRAIL APPROACH SECTION, GALVANIZED 3 RAIL BOX BEAM	04-23-2012
S-364D	GUARDRAIL APPROACH SECTION, GALVANIZED 3 RAIL BOX BEAM	04-23-2012
T-1	TRAFFIC CONTROL GENERAL NOTES	08-06-2012
T-10	CONVENTIONAL ROADS CONSTRUCTION APPROACH SIGNING	08-06-2012
T-28	CONSTRUCTION SIGN DETAILS	08-06-2012
T-30	CONSTRUCTION SIGN DETAILS	08-06-2012
T-31	CONSTRUCTION SIGN DETAILS	08-06-2012
T-35	CONSTRUCTION ZONE LONGITUDINAL DROP-OFFS	08-06-2012
T-44	MILEMARKER DETAILS STATE AND TOWN HIGHWAYS	04-09-2014
T-45	SQUARE TUBE SIGN POST AND ANCHOR	01-02-2013

STRUCTURES DETAIL SHEETS

SD-501.00	CONCRETE DETAILS AND NOTES	2/9/2012
SD-502.00	CONCRETE DETAILS AND NOTES	10/10/2012
SD-516.10	BRIDGE JOINT ASPHALTIC PLUG	8/29/2011
SD-601.00	STRUCTURAL STEEL DETAILS AND NOTES	6/4/2010

HYDROLOGIC DATA

Date: November 2013

DRAINAGE AREA : 4.3 sq. mi.
CHARACTER OF TERRAIN : Mostly forested, mountainous
STREAM CHARACTERISTICS : Sinuous, steep and probably incised
NATURE OF STREAMBED : Mostly gravel and sand, some cobbles

PEAK FLOW DATA

Q 2.33 =	325 cfs	Q 50 =	1025 cfs
Q 10 =	650 cfs	Q 100 =	1200 cfs
Q 25 =	850 cfs	Q 500 =	1700 cfs

DATE OF FLOOD OF RECORD : Unknown
ESTIMATED DISCHARGE : Unknown
WATER SURFACE ELEV. : Unknown
NATURAL STREAM VELOCITY : @ Q50 = 5.0 fps
ICE CONDITIONS : Moderate
DEBRIS : Moderate
DOES THE STREAM REACH MAXIMUM HIGHWATER ELEV. RAPIDLY? No
IS ORDINARY RISE RAPID? No
IS STAGE AFFECTED BY UPSTREAM OR DOWNSTREAM CONDITIONS? Possibly
IF YES, DESCRIBE : Backwater from Lamoille River

WATERSHED STORAGE : <1% HEADWATERS :
UNIFORM : X
IMMEDIATELY ABOVE SITE :

EXISTING STRUCTURE INFORMATION

STRUCTURE TYPE : Single span concrete T-beam
YEAR BUILT : 1926, Reconstructed in 1969
CLEAR SPAN(NORMAL TO STREAM): 22'
VERTICAL CLEARANCE ABOVE STREAMBED: 6.8'
WATERWAY OF FULL OPENING: 140 sq. ft.
DISPOSITION OF STRUCTURE: Replace
TYPE OF MATERIAL UNDER SUBSTRUCTURE: See borings

WATER SURFACE ELEVATIONS AT:

Q2.33 =	482.4'	VELOCITY =	6.0 fps
Q10 =	484.1'	"	8.2 fps
Q25 =	484.9'	"	9.7 fps
Q50 =	486.4'	"	9.9 fps
Q100 =	486.7'	"	11.0 fps

LONG TERM STREAMBED CHANGES: None noted

IS THE ROADWAY OVERTOPPED BELOW Q100: No
FREQUENCY: N/A
RELIEF ELEVATION: 488.7'
DISCHARGE OVER ROAD @Q100: N/A

UPSTREAM STRUCTURE

TOWN: Johnson DISTANCE: 2047'
HIGHWAY #: Lamoille Valley Rail Trail STRUCTURE #:
CLEAR SPAN: CLEAR HEIGHT:
YEAR BUILT: FULL WATERWAY:
STRUCTURE TYPE:


DOWNSTREAM STRUCTURE

TOWN: Johnson DISTANCE: 1000'
HIGHWAY #: STRUCTURE #:
CLEAR SPAN: CLEAR HEIGHT:
YEAR BUILT: FULL WATERWAY:
STRUCTURE TYPE: Confluence with Lamoille River

LRFR LOAD RATING FACTORS

LOADING LEVELS	TRUCK						
	H-20	HL-93	3S2	6 AXLE	3A STR.	4A STR.	5A SEMI
TONNAGE	20	36	36	66	30	34.5	38
INVENTORY	2.01	1.18					
POSTING							
OPERATING	2.79	1.53	2.73	1.54	2.00	1.81	1.18

AS BUILT "REBAR" DETAIL		
LEVEL I	LEVEL II	LEVEL III
TYPE:	TYPE:	TYPE:
GRADE:	GRADE:	GRADE:

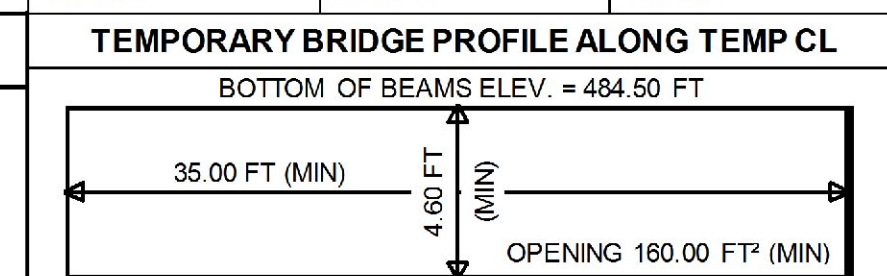

PROPOSED STRUCTURE

STRUCTURE TYPE: Single span concrete bridge NEXT24F
CLEAR SPAN(NORMAL TO STREAM): 50'
VERTICAL CLEARANCE ABOVE STREAMBED: ~9'
WATERWAY OF FULL OPENING: 380 sq. ft.

WATER SURFACE ELEVATIONS AT:

Q2.33 =	482.2'	VELOCITY =	5.0 fps
Q10 =	483.6'	"	6.2 fps
Q25 =	484.3'	"	6.7 fps
Q50 =	484.7'	"	7.1 fps
Q100 =	485.1'	"	7.6 fps

IS THE ROADWAY OVERTOPPED BELOW Q100: No
FREQUENCY: N/A
RELIEF ELEVATION: 489.3'
DISCHARGE OVER ROAD @Q100: N/A

AVERAGE LOW ELEVATION OF SUPERSTRUCTURE: 487.8'
VERTICAL CLEARANCE: @ Q50 = 3.1'

SCOUR: Contraction scour is 0' up to Q500.

REQUIRED CHANNEL PROTECTION: Stone Fill, Type III

PERMIT INFORMATION

AVERAGE DAILY FLOW:	10 cfs	DEPTH OR ELEVATION:	
ORDINARY LOW WATER:	5 cfs		0.5'
ORDINARY HIGH WATER:	140 cfs		3.0'

TEMPORARY BRIDGE REQUIREMENTS

STRUCTURE TYPE: Single span bridge
CLEAR SPAN (NORMAL TO STREAM): 35'
VERTICAL CLEARANCE ABOVE STREAMBED: Low beam elevation 484.5'
WATERWAY AREA OF FULL OPENING: 160 sq. ft.

ADDITIONAL INFORMATION

TRAFFIC MAINTENANCE NOTES

1. MAINTAIN TWO-WAY TRAFFIC ON A TEMPORARY BRIDGE.
2. TRAFFIC SIGNALS ARE NOT NECESSARY.
3. SIDEWALKS ARE NOT NECESSARY.
4. THE APPROACHES FOR THE TEMPORARY BRIDGE SHALL BE PAVED.

DESIGN VALUES

1. DESIGN LIVE LOAD
2. FUTURE PAVEMENT $d_{fs} = 0.0 \text{ INCH}$
 $L = 38.00 \text{ FT}$
3. DESIGN SPAN
4. MIN. MID-SPAN POS. CAMBER @ RELEASE (PRESTRESSED UNITS) Δ : 1.51 INCH
5. PRESTRESSING STRAND (0.60 INCH DIAMETER - LOW RELAX) f_y : 270 KSI
6. PRESTRESSED CONCRETE STRENGTH f'_{ci} : 8.0 KSI
7. PRESTRESSED CONCRETE RELEASE STRENGTH f'_{cr} : 6.5 KSI
8. CONCRETE, HIGH PERFORMANCE CLASS AA f'_{ci} : ---
9. CONCRETE, HIGH PERFORMANCE CLASS A f'_{ci} : 4.0 KSI
10. CONCRETE, HIGH PERFORMANCE CLASS B f'_{ci} : 3.5 KSI
11. CONCRETE, CLASS C f'_{ci} : ---
12. REINFORCING STEEL f_y : 60 KSI
13. STRUCTURAL STEEL AASHTO M270 f_y : ---
14. NOMINAL BEARING RESISTANCE OF SOIL q_n : 4.0 KSF
15. SOIL BEARING RESISTANCE FACTOR (REFER TO AASHTO LRFD) ϕ : ---
16. NOMINAL BEARING RESISTANCE OF ROCK q_n : 10.0 KSF
17. ROCK BEARING RESISTANCE FACTOR (REFER TO AASHTO LRFD) ϕ : ---
18. PILE RESISTANCE FACTOR ϕ : 0.65
19. LATERAL PILE DEFLECTION Δ : 0.16 INCH
20. BASIC WIND SPEED V_{3s} : ---
21. MINIMUM GROUND SNOW LOAD p_g : ---
22. EST. PILE LENGTHS (TWO SUBSTRUCTURES) S_s : ---
(ABUTMENT 1 = 50 AND ABUTMENT 2 = 48) FT
6 PILES PER ABUTMENT

PROJECT NAME: **JOHNSON**
PROJECT NUMBER: **BRF 030-2(26)**

FILE NAME: s88b193pi.dgn PLOT DATE: 11/5/2014
PROJECT LEADER: C. CARLSON DRAWN BY: G. ROY
DESIGNED BY: H. SALLS CHECKED BY: H. SALLS
PRELIMINARY INFORMATION SHEET SHEET 2 OF 69

TRAFFIC DATA

YEAR	ADT	DHV	% D	% T	ADTT	20 year ESAL for flexible pavement from 2012 to 2032 : 4615000
2012	5000	560	56	4	510	40 year ESAL for flexible pavement from 2012 to 2052 : 11448000
2032	5700	640	56	5.7	830	Design Speed : 50 mph

REVISION	DATE	DESCRIPTION	BY
1	OCT-28-2014	ADD 3" PAYMENT, LOWER BRIDGE SEAT, ADD 3" CONCRETE PEDESTAL	GNR

GENERAL INFORMATION

SYMBOLY LEGEND NOTE

THE SYMBOLY ON THIS SHEET IS INTENDED TO COVER STANDARD CONVENTIONAL SYMBOLY. THE SYMBOLY IS USED FOR EXISTING & PROPOSED FEATURES WITH HEAVIER LINEWEIGHT, IN COMBINATION WITH PROJECT ANNOTATION, AS NOTED ON PROJECT PLAN SHEETS. THIS LEGEND SHEET COVERS THE BASICS. SYMBOLY ON PLANS MAY VARY, PLAN ANNOTATIONS AND NOTES SHOULD BE USED TO CLARIFY AS NEEDED.

R.O.W. ABBREVIATIONS (CODES) & SYMBOLS

POINT CODE	DESCRIPTION
CH	CHANNEL EASEMENT
CONST	CONSTRUCTION EASEMENT
CUL	CULVERT EASEMENT
D&C	DISCONNECT & CONNECT
DIT	DITCH EASEMENT
DR	DRAINAGE EASEMENT
DRIVE	DRIVEWAY EASEMENT
EC	EROSION CONTROL
HWY	HIGHWAY EASEMENT
I&M	INSTALL & MAINTAIN EASEMENT
LAND	LANDSCAPE EASEMENT
R&RES	REMOVE & RESET
R&REP	REMOVE & REPLACE
SR	SLOPE RIGHT
UE	UTILITY EASEMENT
(P)	PERMANENT EASEMENT
(T)	TEMPORARY EASEMENT
■	BNDNS BOUND SET
▣	BNDNS BOUND TO BE SET
●	IPNS IRON PIN SET
⊙	IPNS IRON PIN TO BE SET
⊠	CALC EXISTING ROW POINT
○	PROW PROPOSED ROW POINT
[LENGTH]	LENGTH CARRIED ON NEXT SHEET

COMMON TOPOGRAPHIC POINT SYMBOLS

POINT CODE	DESCRIPTION
#	APL BOUND APPARENT LOCATION
◊	BM BENCH MARK
□	BND BOUND
▣	CB CATCH BASIN
⊕	COMB COMBINATION POLE
▣	DITHR DROP INLET THROATED DNC
⊕	EL ELECTRIC POWER POLE
◊	FPOLE FLAGPOLE
○	GASFIL GAS FILLER
○	GP GUIDE POST
*	GSO GAS SHUT OFF
◊	GUY GUY POLE
◊	GUYW GUY WIRE
*	GV GATE VALVE
⊗	H TREE HARDWOOD
△	HCTRL CONTROL HORIZONTAL
▲	HVCTRL CONTROL HORIZ. & VERTICAL
◇	HYD HYDRANT
•	IP IRON PIN
•	IPIPE IRON PIPE
⊕	LI LIGHT - STREET OR YARD
♯	MB MAILBOX
○	MH MANHOLE (MH)
□	MM MILE MARKER
•	PM PARKING METER
□	PMK PROJECT MARKER
•	POST POST STONE/WOOD
⊕	RRSIG RAILROAD SIGNAL
•	RRSL RAILROAD SWITCH LEVER
⊗	S TREE SOFTWOOD
⊕	SAT SATELLITE DISH
⊗	SHRUB SHRUB
⊕	SIGN SIGN
♯	STUMP STUMP
⊕	TEL TELEPHONE POLE
•	TIE TIE
⊕	TSIGN SIGN W/DOUBLE POST
⊕	VCTRL CONTROL VERTICAL
•	WELL WELL
*	WSO WATER SHUT OFF

THESE ARE COMMON VAOT SURVEY POINT SYMBOLS FOR EXISTING FEATURES, ALSO USED FOR PROPOSED FEATURES WITH HEAVIER LINEWEIGHT, IN COMBINATION WITH PROPOSED ANNOTATION.

PROPOSED GEOMETRY CODES

CODE	DESCRIPTION
PC	POINT OF CURVATURE
PI	POINT OF INTERSECTION
CC	CENTER OF CURVE
PT	POINT OF TANGENCY
PCC	POINT OF COMPOUND CURVE
PRC	POINT OF REVERSE CURVE
POB	POINT OF BEGINNING
POE	POINT OF ENDING
STA	STATION PREFIX
AH	AHEAD STATION SUFFIX
BK	BACK STATION SUFFIX
D	CURVE DEGREE OF (100FT)
R	CURVE RADUIS OF
T	CURVE TANGENT LENGTH
L	CURVE LENGTH OF
E	CURVE EXTERNAL DISTANCE

UTILITY SYMBOLY

UNDERGROUND UTILITIES

— UGU —	UTILITY (GENERIC-UNKNOWN)
— UT —	TELEPHONE
— UE —	ELECTRIC
— UC —	CABLE (TV)
— UEC —	ELECTRIC+CABLE
— UET —	ELECTRIC+TELEPHONE
— UCT —	CABLE+TELEPHONE
— UECT —	ELECTRIC+CABLE+TELEP.
— G —	GAS LINE
— W —	WATER LINE
— S —	SANITARY SEWER (SEPTIC)

ABOVE GROUND UTILITIES (AERIAL)

— AGU —	UTILITY (GENERIC-UNKNOWN)
— T —	TELEPHONE
— E —	ELECTRIC
— C —	CABLE (TV)
— EC —	ELECTRIC+CABLE
— ET —	ELECTRIC+TELEPHONE
— AER E&T —	ELECTRIC+TELEPHONE
— CT —	CABLE+TELEPHONE
— ECT —	ELECTRIC+CABLE+TELEP.
—	UTILITY POLE GUY WIRE

PROJECT CONSTRUCTION SYMBOLY

— — — CZ — — —	CLEAR ZONE
— — — — —	PLAN LAYOUT MATCHLINE

PROJECT CONSTRUCTION FEATURES

▲ — — — — —	TOP OF CUT SLOPE
○ — — — — —	TOE OF FILL SLOPE
⊗ — — — — —	STONE FILL
⊕ — — — — —	BOTTOM OF DITCH
— — — — —	CULVERT PROPOSED
— — — — —	STRUCTURE SUBSURFACE
PDF — — — — —	PROJECT DEMARCATION FENCE
BF — — — — —	BARRIER FENCE
XXXXXXXXXXXXXXXX	TREE PROTECTION ZONE (TPZ)
//////	STRIPING LINE REMOVAL
~~~~~	SHEET PILES

**CONVENTIONAL BOUNDARY SYMBOLY**

**BOUNDARY LINES**

— — — — —	TOWN BOUNDARY LINE
— — — — —	COUNTY BOUNDARY LINE
— — — — —	STATE BOUNDARY LINE
— — — — —	PROPOSED STATE R.O.W. (LIMITED ACCESS)
— — — — —	PROPOSED STATE R.O.W.
— — — — —	STATE ROW (LIMITED ACCESS)
— — — — —	STATE ROW
— — — — —	TOWN ROW
— — — — —	PERMANENT EASEMENT LINE (P)
— — — — —	TEMPORARY EASEMENT LINE (T)
— — — — —	SURVEY LINE
P/L — — — — —	PROPERTY LINE (P/L)
SR — — — — —	SLOPE RIGHTS
6f — — — — —	6F PROPERTY BOUNDARY
4f — — — — —	4F PROPERTY BOUNDARY
HAZ — — — — —	HAZARDOUS WASTE

**EPSC LAYOUT PLAN SYMBOLY**

**EPSC MEASURES**

ONNOONNOONNO	FILTER CURTAIN
— — — — —	SILT FENCE
— — — — —	SILT FENCE WOVEN WIRE
— — — — —	CHECK DAM
— — — — —	DISTURBED AREAS REQUIRING RE-VEGETATION
— — — — —	EROSION MATTING

**ENVIRONMENTAL RESOURCES**

— — — — —	WETLAND BOUNDARY
— — — — —	RIPARIAN BUFFER ZONE
— — — — —	WETLAND BUFFER ZONE
— — — — —	SOIL TYPE BOUNDARY
T&E — — — — —	THREATENED & ENDANGERED SPECIES
HAZ — HAZ —	HAZARDOUS WASTE AREA
AG — — — — —	AGRICULTURAL LAND
HABITAT — — — — —	FISH & WILDLIFE HABITAT
FLOOD PLAN — — — — —	FLOOD PLAIN
— — — — —	ORDINARY HIGH WATER (OHW)
— — — — —	STORM WATER
— — — — —	USDA FOREST SERVICE LANDS
— — — — —	WILDLIFE HABITAT SUIT/CONN

**ARCHEOLOGICAL & HISTORIC**

— ARCH — — — — —	ARCHEOLOGICAL BOUNDARY
— HISTORIC DIST — — — — —	HISTORIC DISTRICT BOUNDARY
— HISTORIC — — — — —	HISTORIC AREA
(H)	HISTORIC STRUCTURE


**CONVENTIONAL TOPOGRAPHIC SYMBOLY**

**EXISTING FEATURES**

— — — — —	ROAD EDGE PAVEMENT
— — — — —	ROAD EDGE GRAVEL
— — — — —	DRIVEWAY EDGE
— — — — —	DITCH
— — — — —	FOUNDATION
x — x — x — x —	FENCE (EXISTING)
□ — — — — —	FENCE WOOD POST
○ — — — — —	FENCE STEEL POST
— — — — —	GARDEN
— — — — —	ROAD GUARDRAIL
	RAILROAD TRACKS
— — — — —	CULVERT (EXISTING)
— — — — —	STONE WALL
— — — — —	WALL
— — — — —	WOOD LINE
— — — — —	BRUSH LINE
— — — — —	HEDGE
— — — — —	BODY OF WATER EDGE
— — — — —	LEDGE EXPOSED


PROJECT NAME: JOHNSON  
PROJECT NUMBER: BRF 030-2(26)

FILE NAME: s88bl93legend.dgn PLOT DATE: 10-JUN-2014  
PROJECT LEADER: C. CARLSON DRAWN BY: R. PELLET  
DESIGNED BY: H. SALLS CHECKED BY: H. SALLS  
CONVENTIONAL SYMBOLY-LEGEND SHEET 3 OF 69

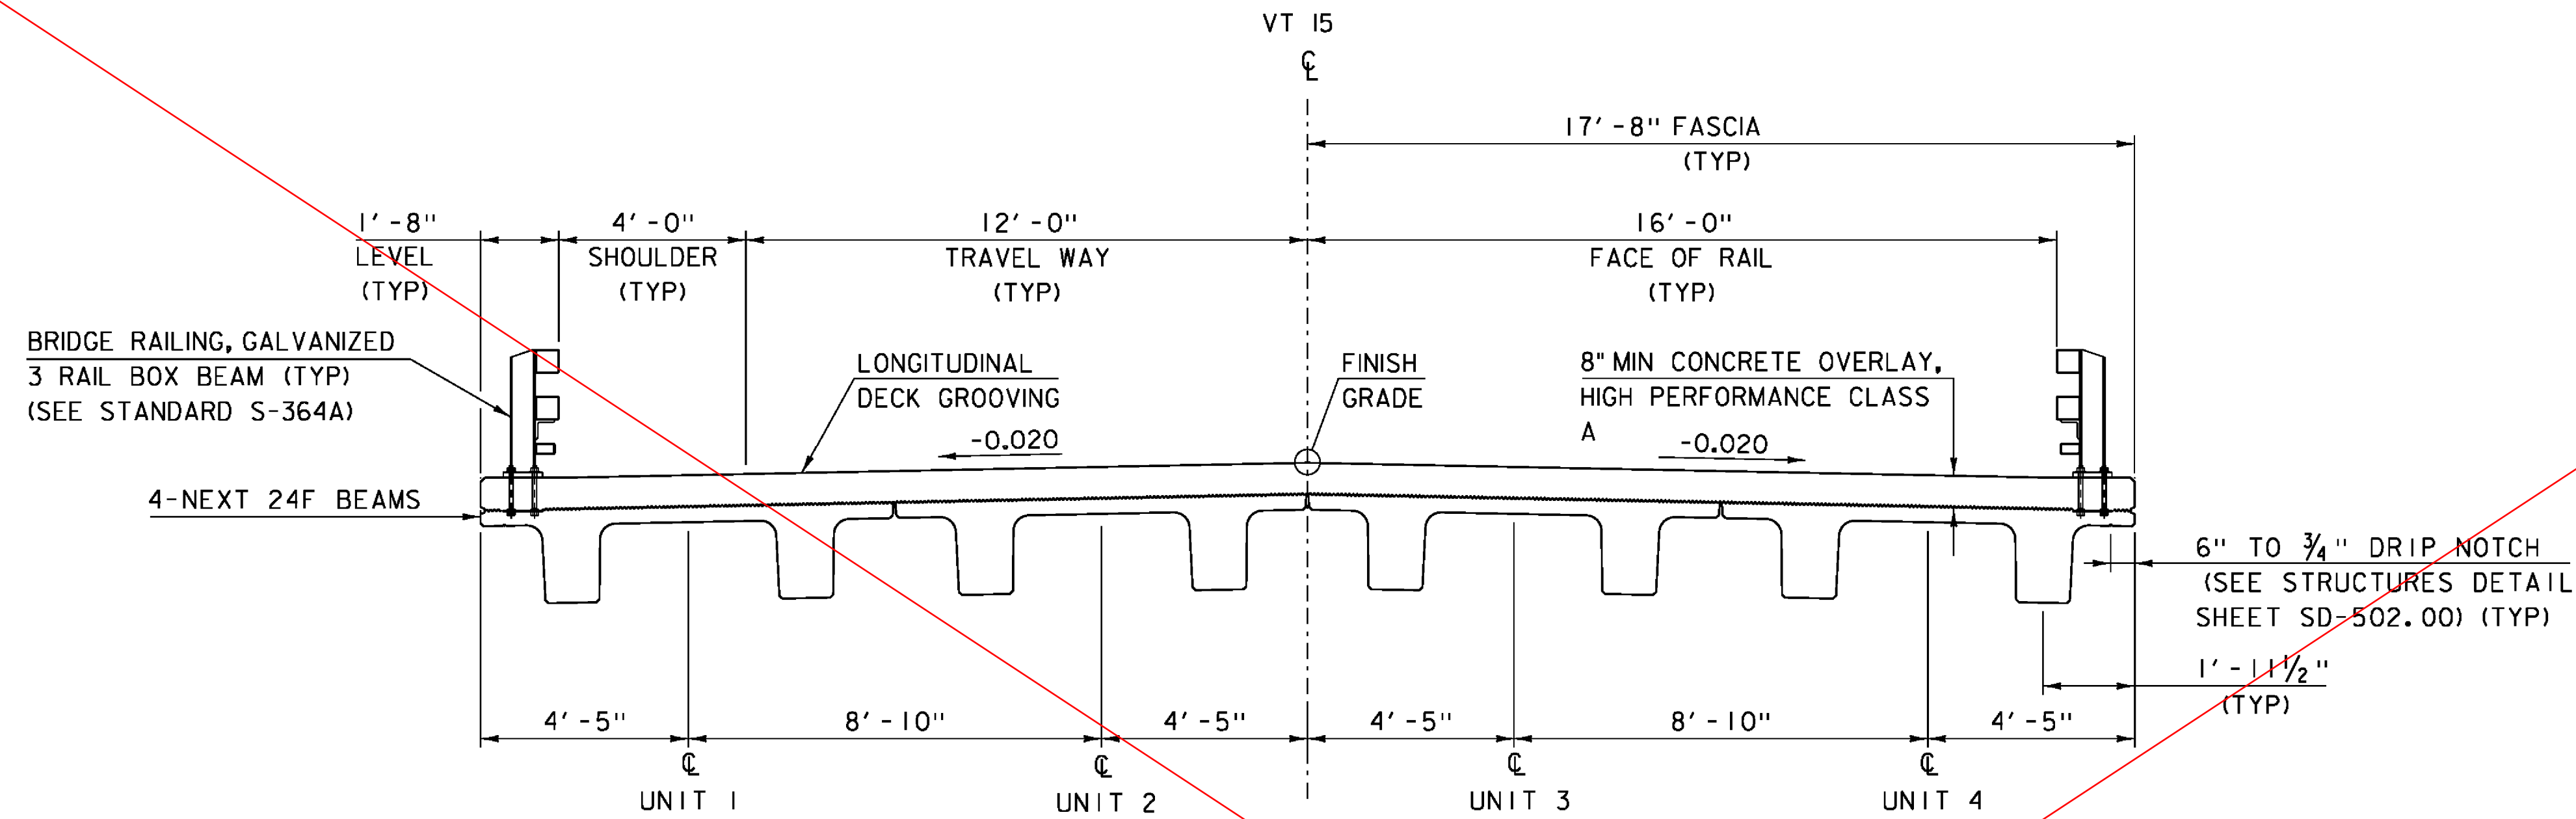

**BRIDGE TYPICAL SECTION**

SCALE 3/8" = 1'-0"

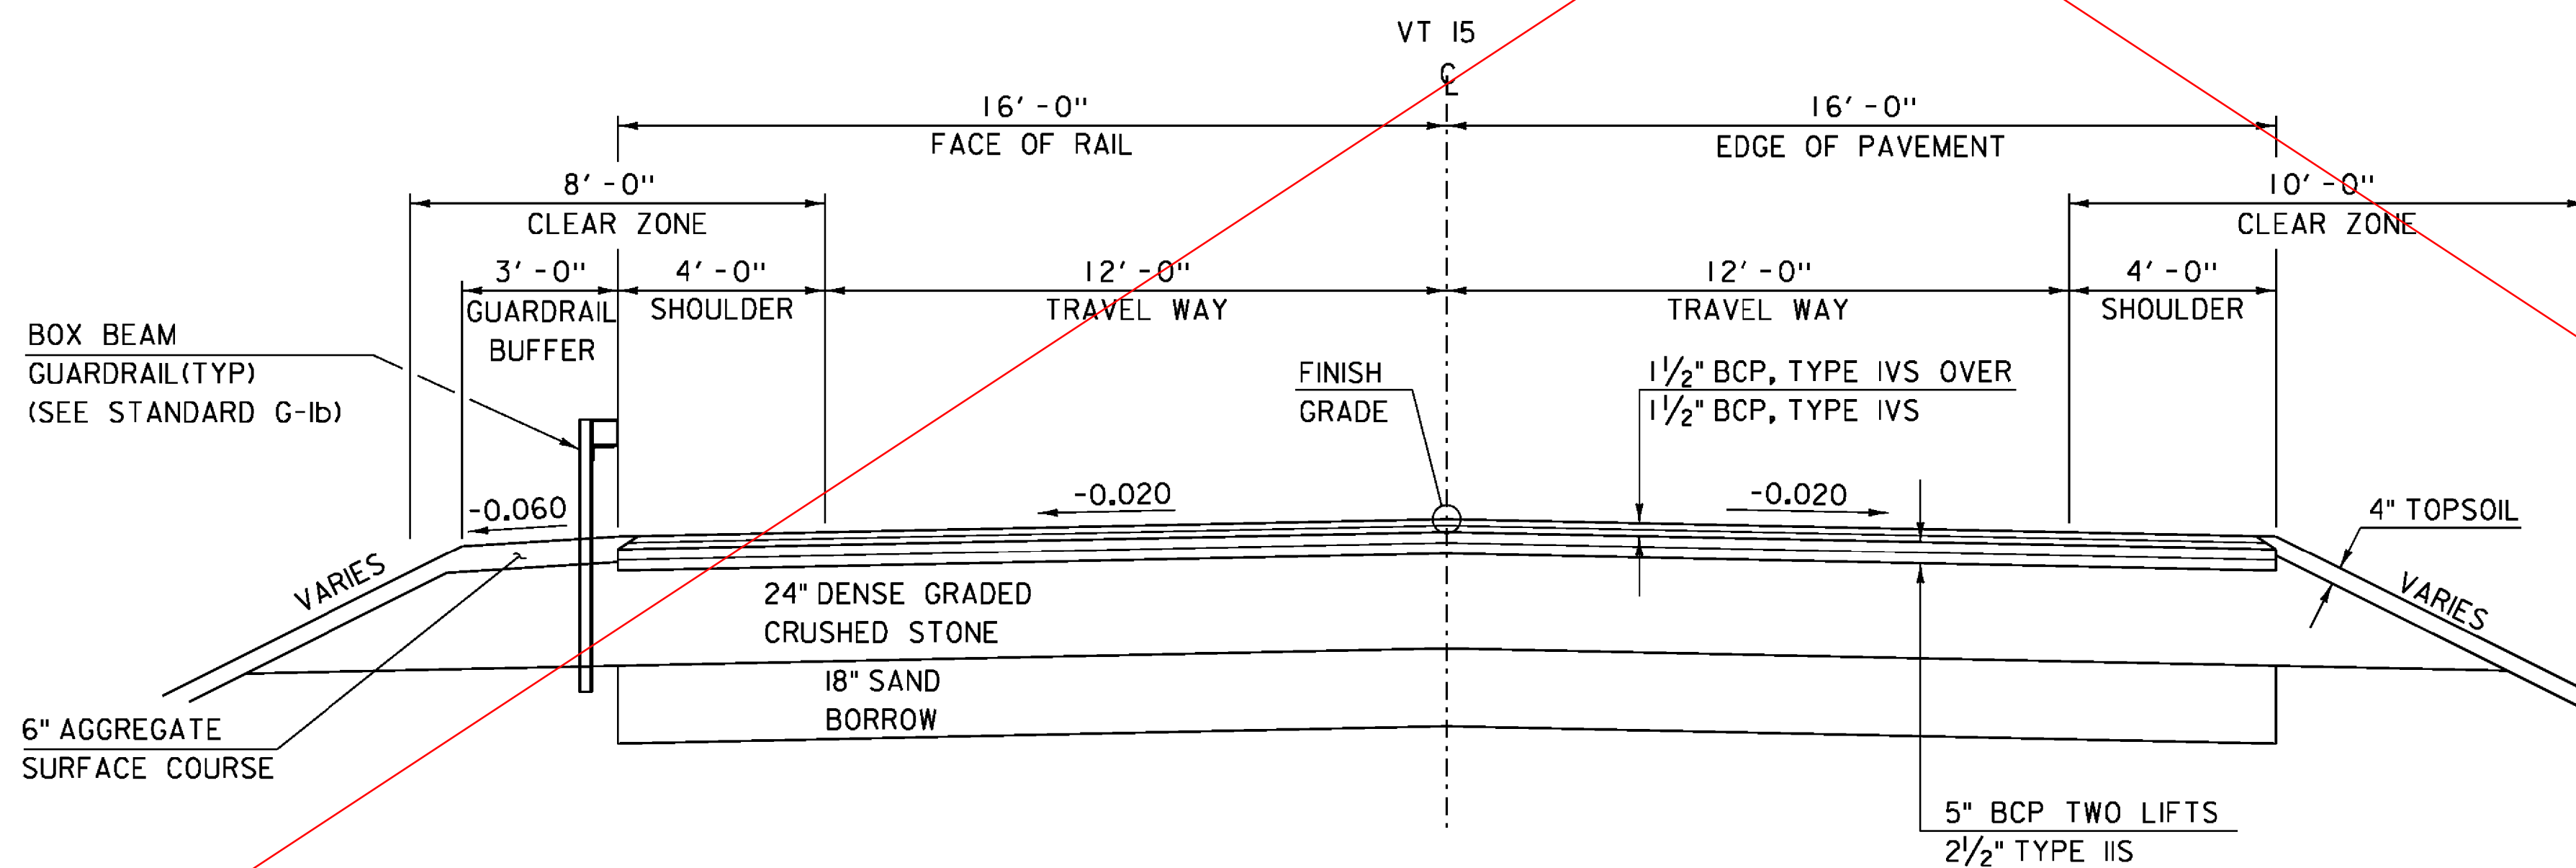

**ROADWAY TYPICAL SECTION**

SCALE 3/8" = 1'-0"


*BCP: BITUMINOUS CONCRETE PAVEMENT PAID FOR UNDER ITEM 900.680 "SPECIAL PROVISION (BITUMINOUS CONCRETE PAVEMENT, SMALL QUANTITY)".

MATERIAL TOLERANCES (IF USED ON PROJECT)	
SURFACE	
- PAVEMENT (TOTAL THICKNESS)	+/- 1/4"
- AGGREGATE SURFACE COURSE	+/- 1/2"
SUBBASE	
	+/- 1"
SAND BORROW	
	+/- 1"

SEE REVISION: OCT-28-2014

PROJECT NAME: JOHNSON  
PROJECT NUMBER: BRF 030-2(26)


FILE NAME: s88bi93+yp.dgn	PLOT DATE: 10-JUN-2014
PROJECT LEADER: C. CARLSON	DRAWN BY: R. PELLETT
DESIGNED BY: H. SALLS	CHECKED BY: H. SALLS
TYPICAL SECTIONS (1)	SHEET 4 OF 69

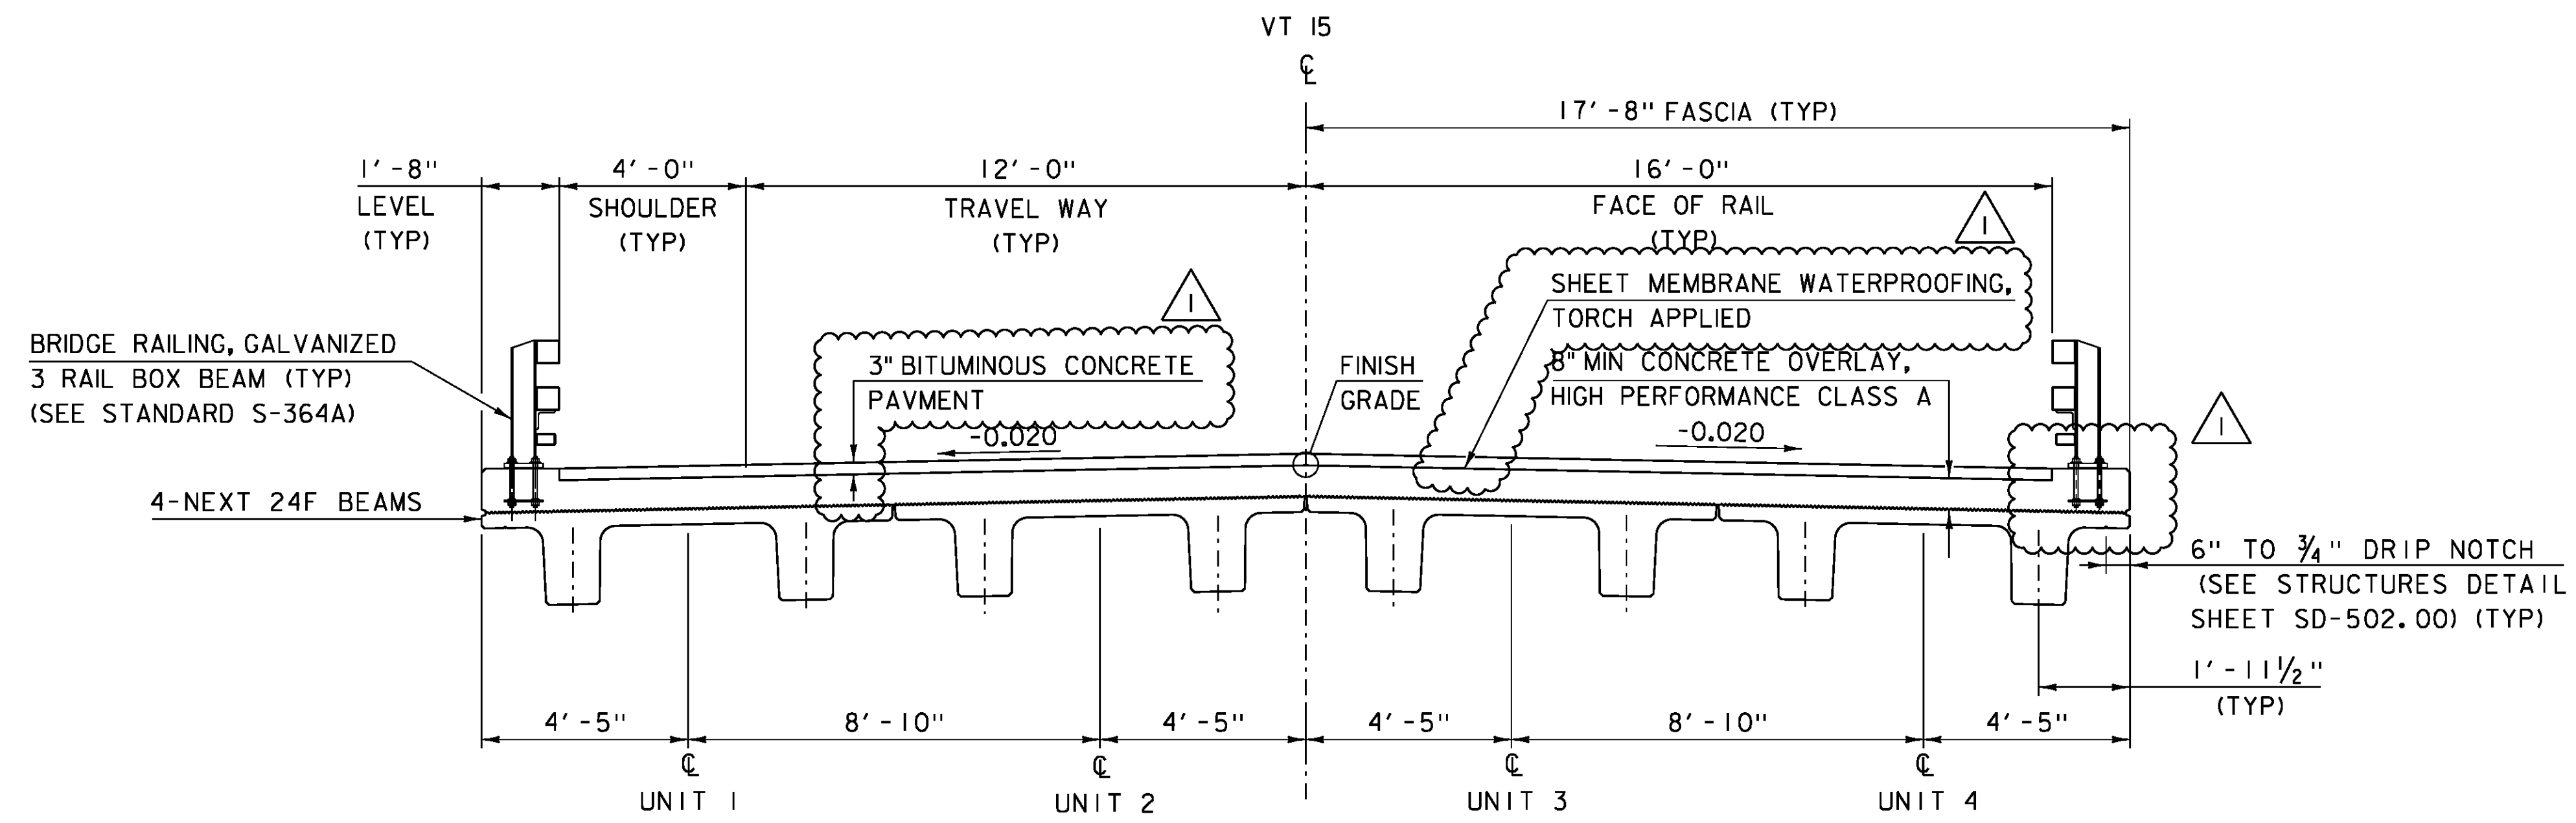

**BRIDGE TYPICAL SECTION**

SCALE 3/8" = 1'-0"

REMOVE  
LONGITUDINAL DECK GROOVING

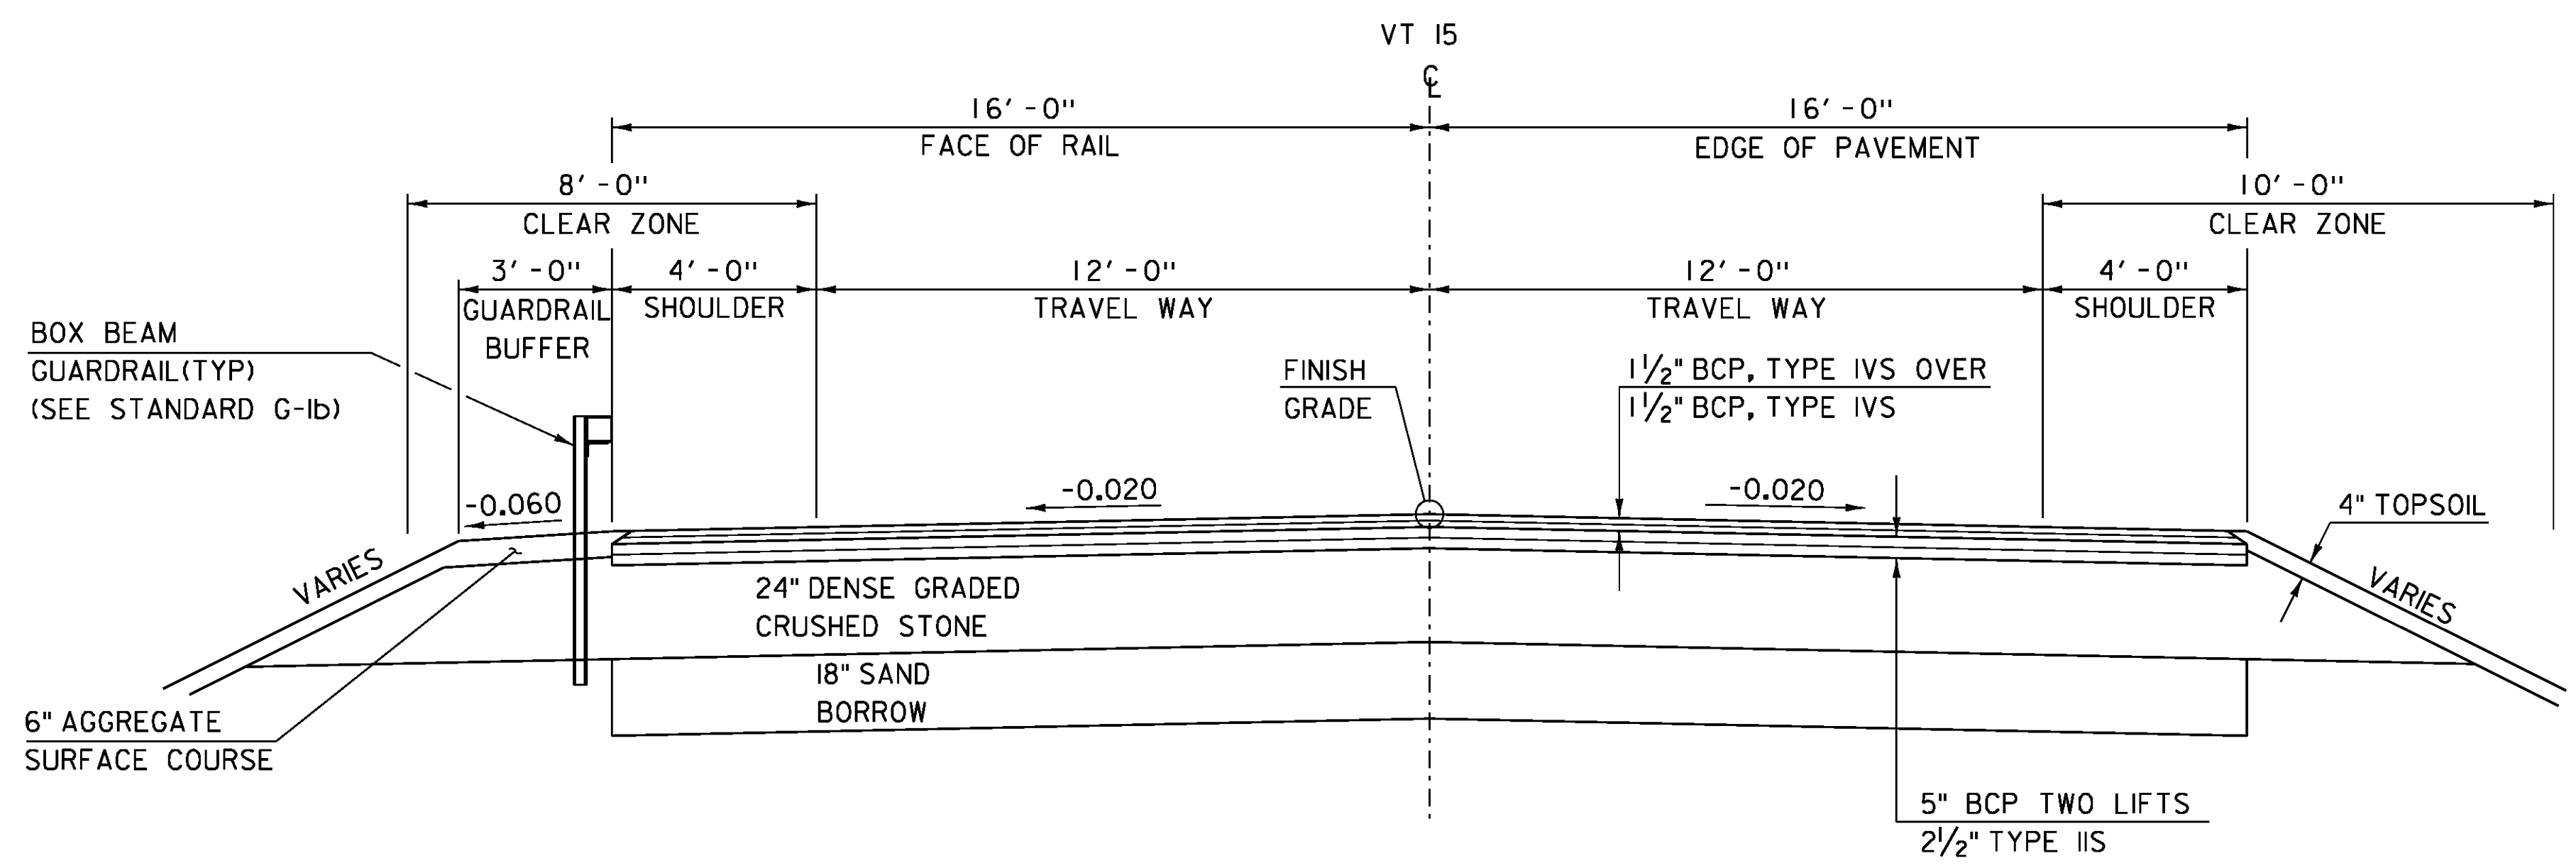

**ROADWAY TYPICAL SECTION**


SCALE 3/8" = 1'-0"

*BCP: BITUMINOUS CONCRETE PAVEMENT PAID FOR UNDER ITEM 900.680 "SPECIAL PROVISION (BITUMINOUS CONCRETE PAVEMENT, SMALL QUANTITY)".


REVISION	DATE	DESCRIPTION	BY
1	OCT-28-2014	ADD 3" PAYMENT, LOWER BRIDGE SEAT, ADD 3" CONCRETE PEDESTAL	GNR

MATERIAL TOLERANCES (IF USED ON PROJECT)	
SURFACE	
- PAVEMENT (TOTAL THICKNESS)	+/- 1/4"
- AGGREGATE SURFACE COURSE	+/- 1/2"
SUBBASE	
	+/- 1"
SAND BORROW	
	+/- 1"

PROJECT NAME:	JOHNSON
PROJECT NUMBER:	BRF 030-2(26)
FILE NAME:	s88bl93typ.dgn
PROJECT LEADER:	C. CARLSON
DESIGNED BY:	H. SALLS
TYPICAL SECTIONS (1)	
PLOT DATE:	05-NOV-2014
DRAWN BY:	R. PELLET
CHECKED BY:	H. SALLS
SHEET	4 OF 69

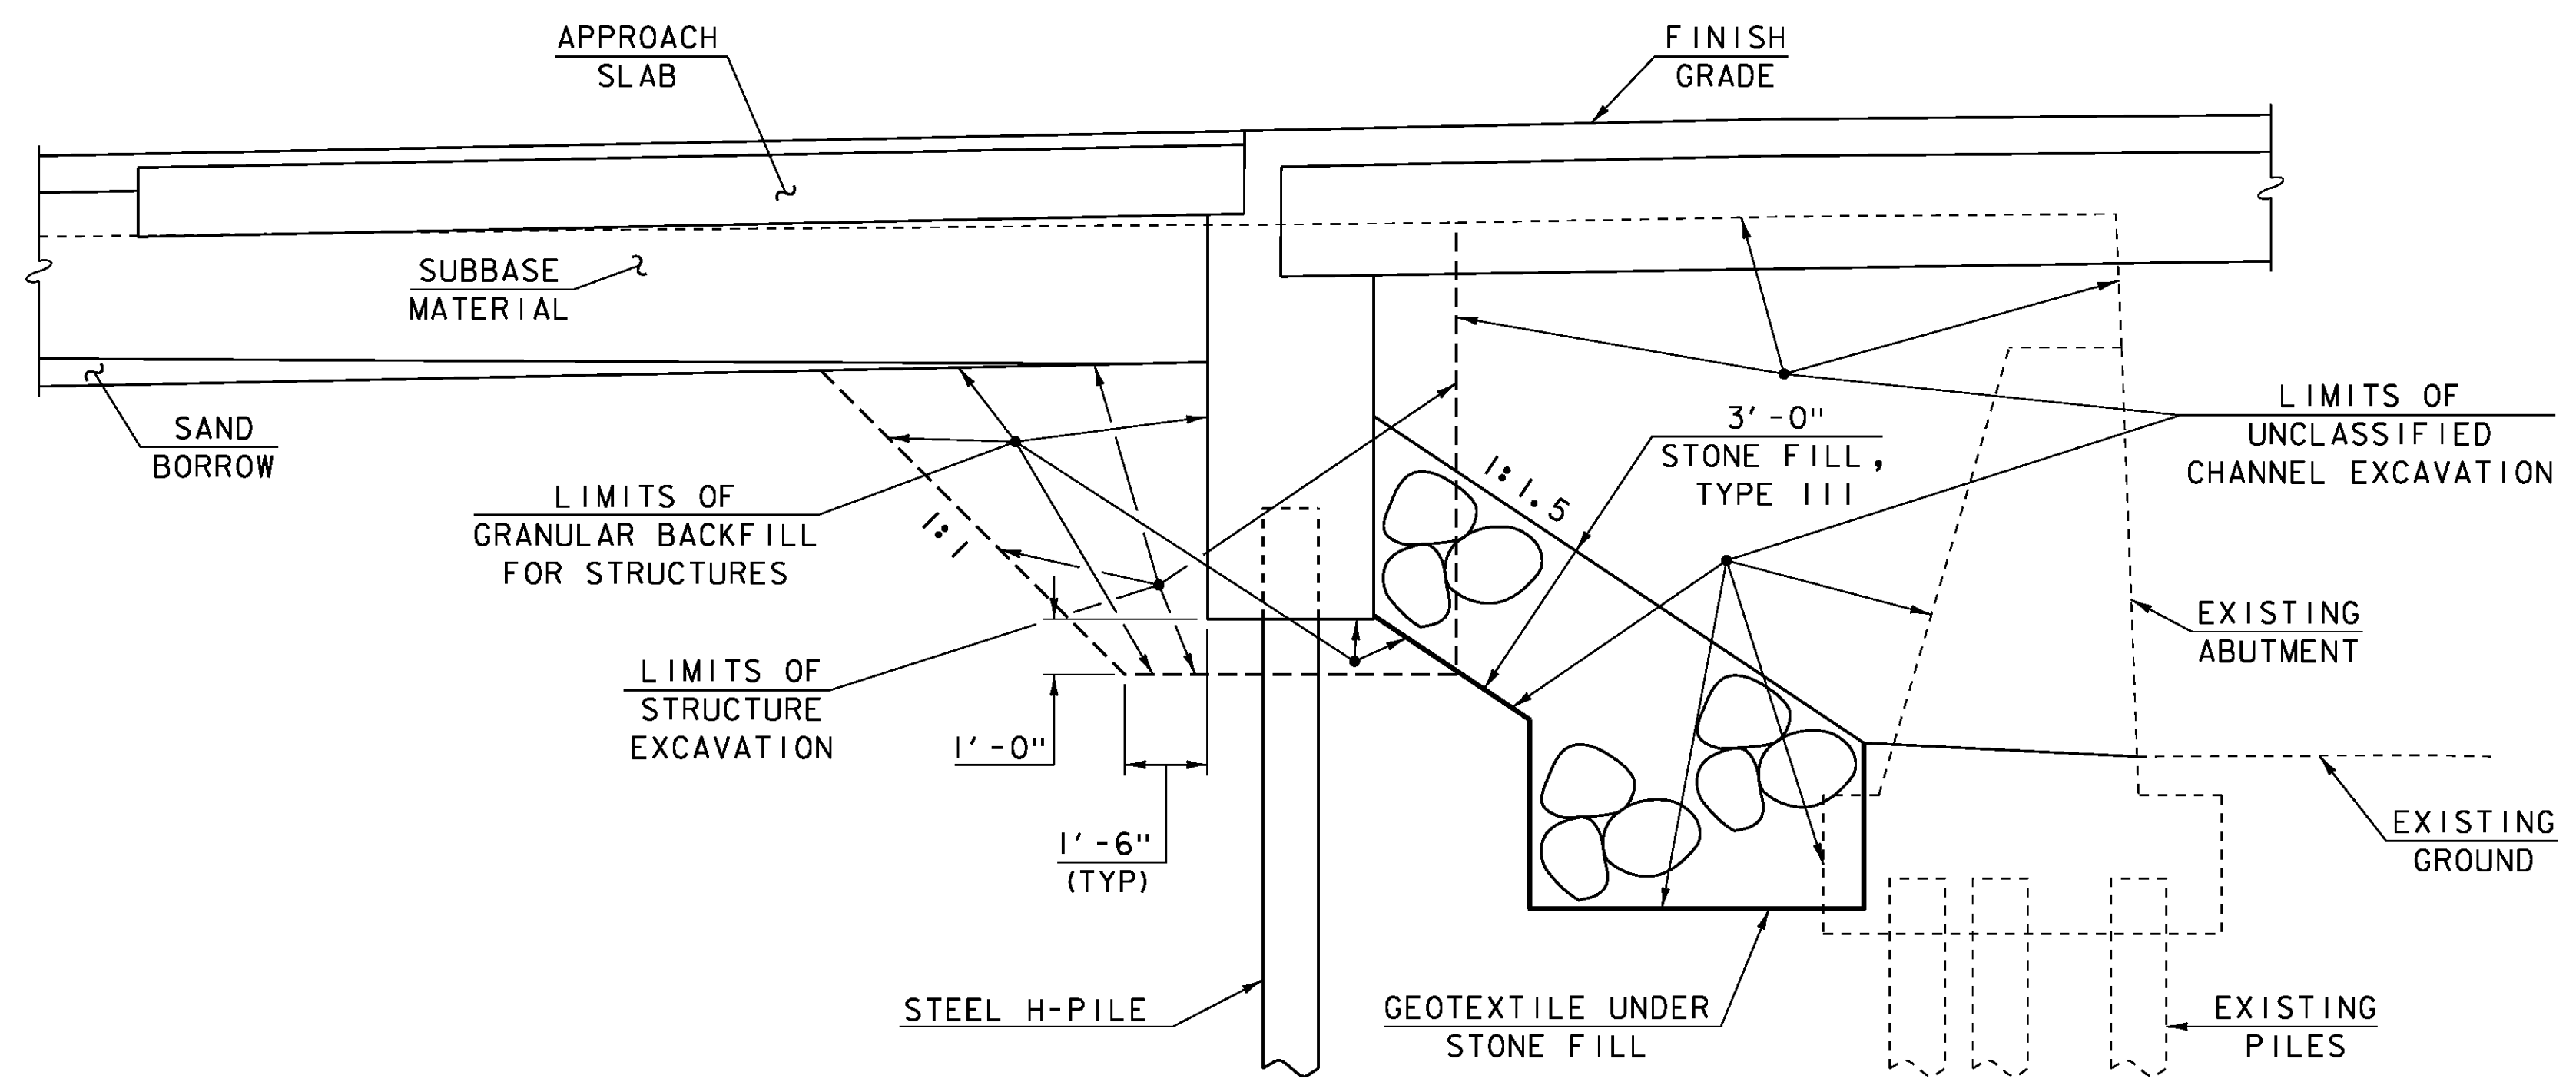


**TYPICAL ABUTMENT SECTION**  
(NOT TO SCALE)

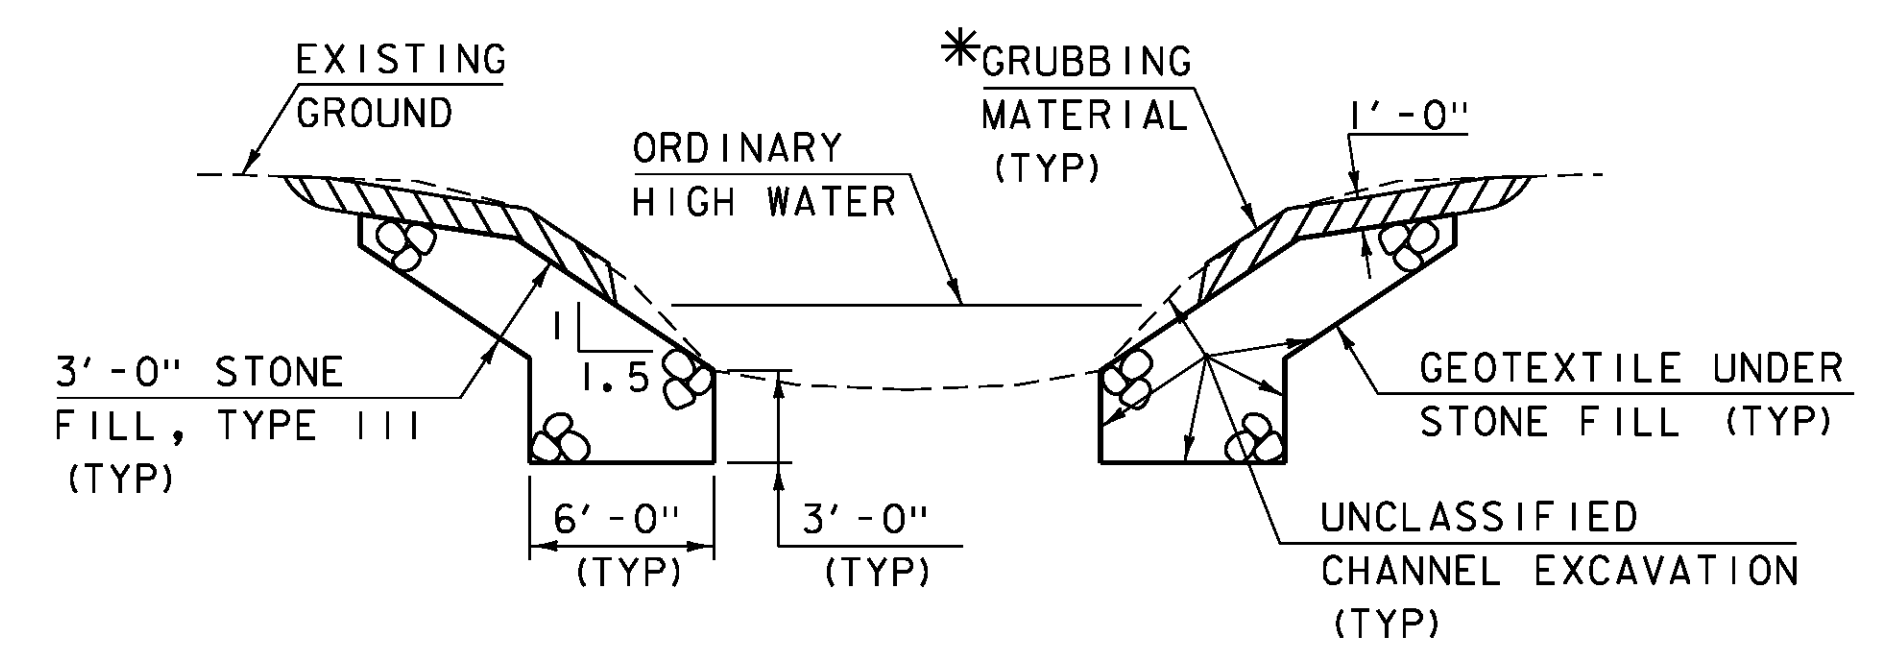


**TYPICAL CHANNEL SECTION**  
(NOT TO SCALE)

*GRUBBING MATERIAL SHALL NOT BE PLACED ON THE STONE FILL IN THE AREA UNDER THE BRIDGE. WHENEVER CHANNEL SLOPE INTERSECTS ROADWAY SUBBASE, GRUBBING MATERIAL SHALL BEGIN AT THE BOTTOM OF SUBBASE.

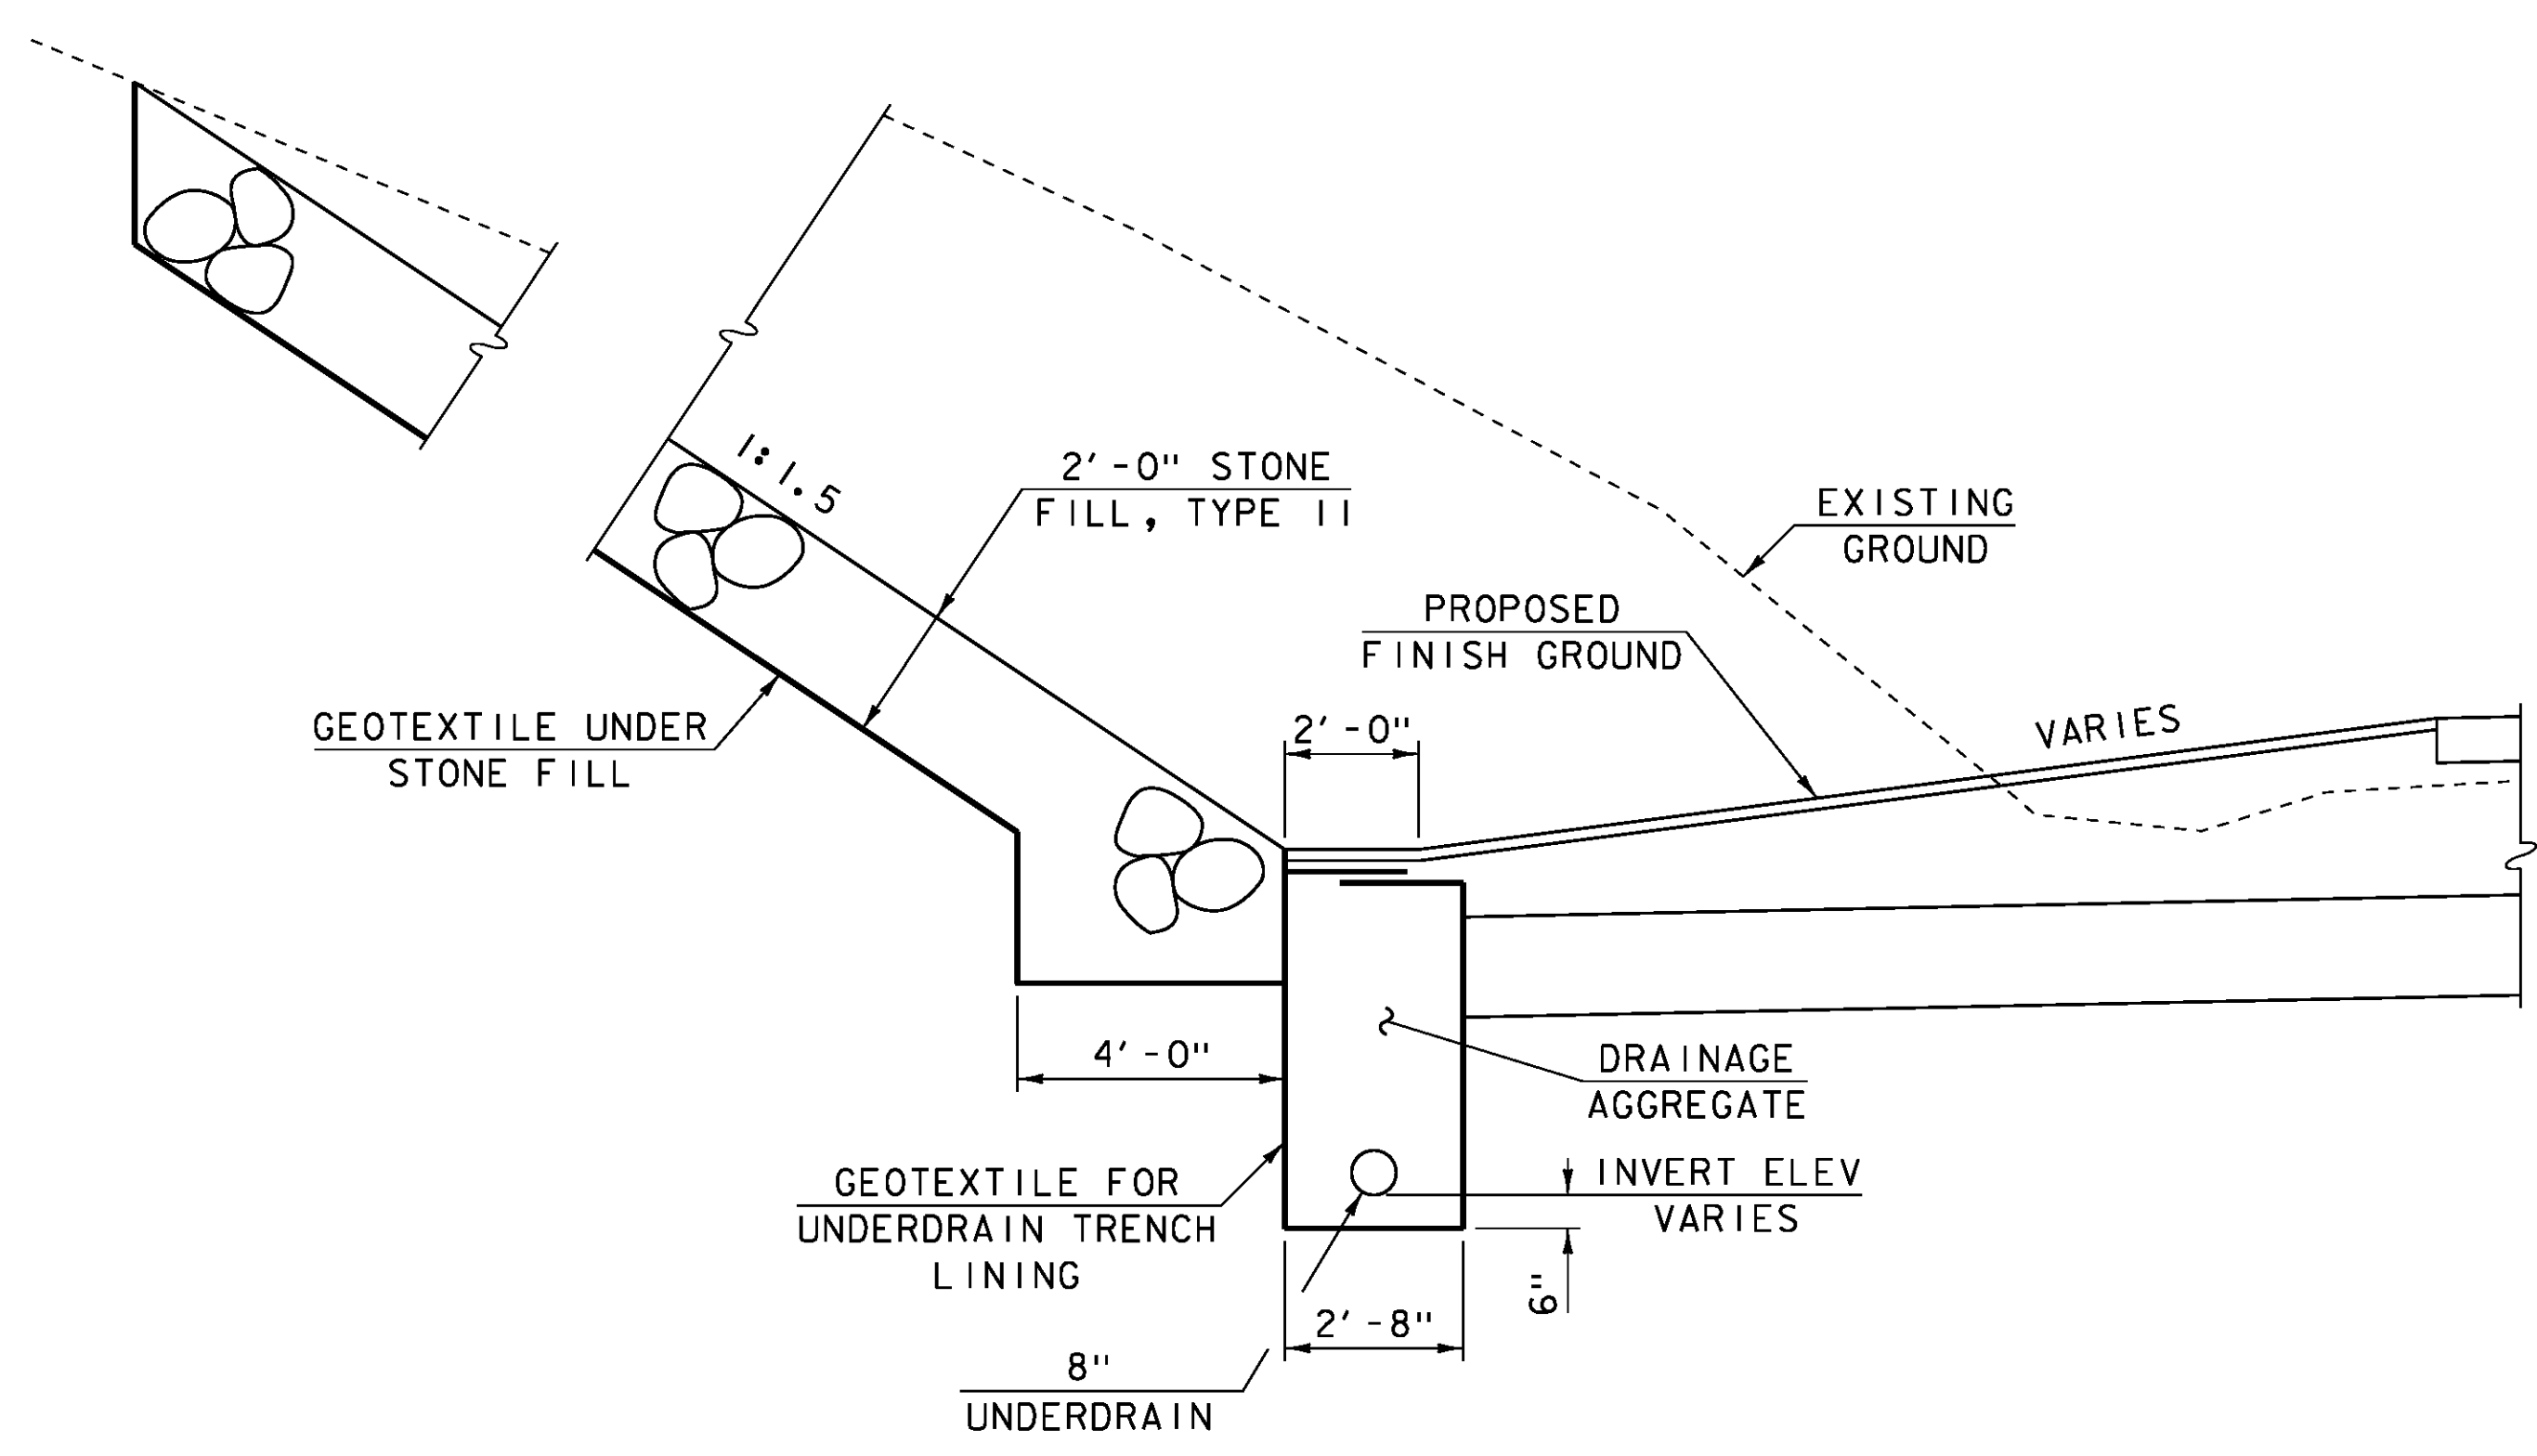

**BANK CUT AND UNDERDRAIN TYPICAL SECTION**  
(NOT TO SCALE)

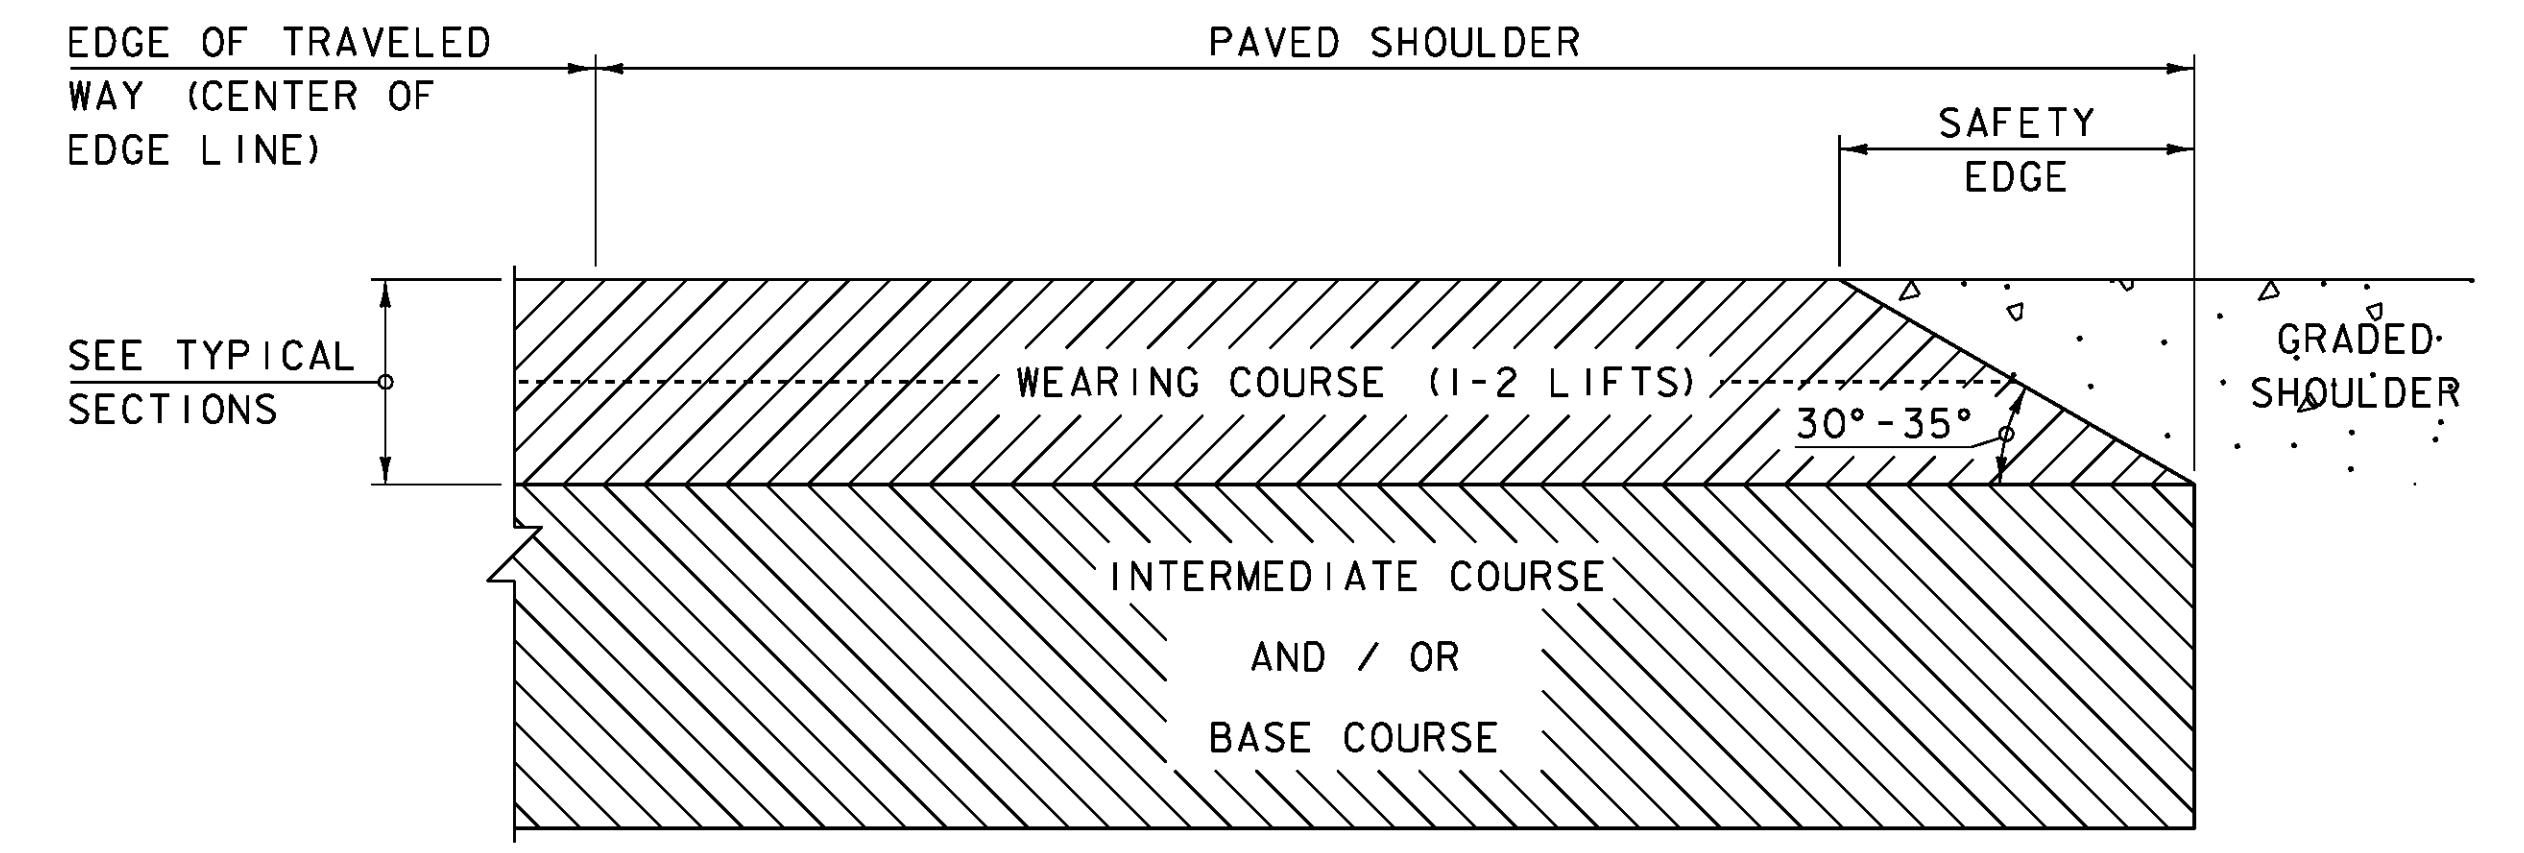

**SAFETY EDGE DETAIL**  
NOT TO SCALE

1. LEVELING COURSE MAY INCLUDE THE "SAFETY EDGE" AT THE CONTRACTOR'S CHOICE.
2. THE EDGE OF PAVEMENT SHALL BE FORMED IN SUCH A WAY THAT THE BITUMINOUS CONCRETE PAVEMENT IS EXTRUDED OR COMPRESSED TO FORM THE 30 TO 35 DEGREE ANGLE. DEVICES THAT SIMPLY STRIKE-OFF THE MIX WITHOUT PROVIDING ANY COMPACTIVE EFFORT WILL NOT BE ALLOWED.
3. THE PAVED SHOULDER EXTENDS FROM THE EDGE OF TRAVELED WAY TO THE EDGE OF THE WEARING COURSE, INCLUDING THE "SAFETY EDGE".

PROJECT NAME: JOHNSON	PLOT DATE: 10-JUN-2014
PROJECT NUMBER: BRF 030-2(26)	DRAWN BY: R. PELLETT
FILE NAME: s88bl93+yp.dgn	CHECKED BY: H. SALLS
PROJECT LEADER: C. CARLSON	SHEET 5 OF 69
DESIGNED BY: C. MOONEY	
TYPICAL SECTIONS (2)	

**GENERAL**

- 1. ALL MATERIALS AND CONSTRUCTION SHALL CONFORM TO THE STATE OF VERMONT AGENCY OF TRANSPORTATION STANDARD SPECIFICATIONS FOR CONSTRUCTION DATED 2011 AND ITS LATEST REVISIONS, THE AASHTO LRFD BRIDGE DESIGN SPECIFICATIONS SIXTH EDITION, DATED 2012 AND ITS LATEST REVISIONS AND THE AASHTO LRFD BRIDGE CONSTRUCTION SPECIFICATIONS THIRD EDITION, DATED 2010 AND ITS LATEST REVISIONS.
- 2. THE BRIDGE WAS DESIGNED FOR THE HL-93 LIVE LOADS.
- 3. ITEM 529.15 "REMOVAL OF STRUCTURE" SHALL BE USED FOR THE REMOVAL OF THE EXISTING STRUCTURE INCLUDING THE SUPERSTRUCTURE, ALONG WITH THE ABUTMENTS AND WINGWALLS OUTSIDE THE LIMITS OF STRUCTURE EXCAVATION OR UNCLASSIFIED CHANNEL EXCAVATION. THE EXISTING CONCRETE ABUTMENTS SHALL BE COMPLETELY REMOVED.
- 4. ALL DIMENSIONS SHOWN IN THE PLANS ARE HORIZONTAL OR VERTICAL AND ARE GIVEN AT 68 DEGREES FAHRENHEIT, UNLESS OTHERWISE NOTED.

**EARTHWORK AND RELATED ITEMS**

- 5. THE TEMPORARY BRIDGE AND ITS APPROACHES SHALL BE CONSTRUCTED AND PAID FOR IN ACCORDANCE WITH ITEM 528.11 "TWO-WAY TEMPORARY BRIDGE". THE APPROACHES TO THE TEMPORARY BRIDGE SHALL BE PAVED WITH 2 INCHES OF PAVEMENT.
- 6. TEMPORARY CONSTRUCTION FILLS WITHIN THE WATERCOURSE FOR ANY PURPOSE SHALL CONSIST OF CLEAN STONE FILL ONLY. NO OTHER FILLING IN THE STREAM SHALL OCCUR WITHOUT THE APPROVAL OF THE STREAM ALTERATION ENGINEER.
- 7. THE BACKFILL BEHIND THE ABUTMENTS SHALL NOT BE PLACED HIGHER THAN THE BRIDGE SEATS UNTIL THE ABUTMENTS AND DECK CONSTRUCTION IS COMPLETED.
- 8. THE "STONE FILL, TYPE III" UNDER THE BRIDGE AS SHOWN IN THE PLANS SHALL BE PLACED BEFORE THE NEXT BEAMS ARE SET.

**PILES**

- 9. TO PREVENT DAMAGE TO THE PILES, PILE SHOES ARE REQUIRED AND SHALL CONFORM TO SUBSECTION 505.04(f).
- 10. THE PILES SHALL BE DRIVEN TO A NOMINAL PILE DRIVING RESISTANCE OF 285 KIPS.
- 11. TO ENSURE THAT THE NOMINAL CAPACITY HAS BEEN ATTAINED AND TO PREVENT THE OVERSTRESSING OF THE PILE DURING DRIVING OPERATIONS, DYNAMIC PILE TESTING SHALL BE PERFORMED IN ACCORDANCE WITH SUBSECTION 505.04 OF THE STANDARD SPECIFICATIONS. PAYMENT FOR PILE TESTING SHALL BE MADE UNDER ITEM 505.45 "DYNAMIC PILE LOADING TEST". A MINIMUM OF ONE DYNAMIC PILE TEST SHALL BE CONDUCTED ON THE FIRST PILE AT EACH ABUTMENT FOR A TOTAL OF 2 TESTS. MORE TESTS MAY BE ORDERED BY THE ENGINEER. ADDITIONAL TESTS ORDERED BY THE ENGINEER WILL BE PAID FOR AT THE UNIT PRICE FOR CONTRACT ITEM 505.45.
- 12. FOR ESTIMATING PURPOSES, THE PILE TIP ELEVATIONS WERE ASSUMED AS SHOWN ON THE BORING LOGS. THE ACTUAL IN PLACE LENGTHS MAY VARY.
- 13. THE PILES SHALL BE HP 12 X 63.
- 14. ALL MATERIAL, LABOR, EQUIPMENT AND INCIDENTALS NECESSARY TO ITEM 505.155 "STEEL PILEING, HP 12 X 63". THE CONTRACTOR MAY SUBMIT AN ALTERNATIVE METHOD OF DRIVING FOR APPROVAL BY THE ENGINEER.

**CONCRETE**

- 15. SUBSTRUCTURE (INCLUDING RETAINING WALL) AND APPROACH SLAB CONCRETE SHALL BE HIGH PERFORMANCE CLASS B AND SHALL BE PAID FOR UNDER ITEM 501.34, "CONCRETE, HIGH PERFORMANCE CLASS B". THE OVERLAY AND ALL CONCRETE PLACED INTEGRALLY WITH THE SUPERSTRUCTURE SHALL BE ITEM 501.33 "CONCRETE, HIGH PERFORMANCE CLASS A".
- 16. THE ABUTMENT AND WINGWALL CONCRETE ABOVE THE HORIZONTAL CONSTRUCTION JOINTS SHALL BE PLACED MONOLITHICALLY WITH THE DECK POUR.

17. INDIVIDUAL POURED SEGMENTS ARE TO BE PLACED IN ONE CONTINUOUS POUR WITH A MAXIMUM DURATION OF EIGHT HOURS. IF CIRCUMSTANCES BEYOND THE CONTRACTOR'S CONTROL PREVENT THIS FROM BEING ACCOMPLISHED, A CONSTRUCTION JOINT SHALL BE USED BETWEEN ADJACENT POURS. A MINIMUM 96 HOUR DELAY BETWEEN ADJACENT POURS SHALL BE OBSERVED.

18. WATER REPELLENT, SILANE SHALL BE APPLIED TO ALL EXPOSED CONCRETE SURFACES, EXCEPT THE UNDERSIDE OF THE DECK BETWEEN DRIP NOTCHES.

19. JOINTS AND SCORE MARKS IN CONCRETE SHALL BE CONSTRUCTED AS SHOWN IN THE PLANS OR AS DIRECTED BY THE RESIDENT ENGINEER.

20. EXCLUDING REINFORCING STEEL IN WINGWALLS, ALL REINFORCING STEEL ABOVE THE CONSTRUCTION JOINT SHALL BE CORROSION PROTECTION LEVEL II AND ALL REINFORCING STEEL BELOW THE CONSTRUCTION JOINT, IN WINGWALLS AND IN THE APPROACH SLABS SHALL BE CORROSION PROTECTION LEVEL I. PAYMENT WILL BE MADE UNDER THE APPROPRIATE SECTION 507 CONTRACT ITEM. OVERLAY REINFORCING SHEEL SHALL MEET THE REQUIREMENTS OF SECTION 507 FOR LEVEL II REINFORCING AND WILL BE PAID FOR UNDER CONTRACT ITEM 507.12. F BEAM REINFORCING SHALL MEET THE REQUIREMENTS OF SECTION 507 FOR LEVEL II REINFORCING AND WILL BE PAID FOR UNDER CONTRACT ITEM 900.640 SPECIAL PROVISION (PRESTRESSED CONCRETE NEXT F BEAM).

21. LEVEL I REINFORCING STEEL IN THE ABUTMENTS SHALL BE EPOXY COATED.

**TRAFFIC CONTROL**

22. FULL ACCESS TO ALL SIDE ROADS AND DRIVES WITHIN THE PROJECT LIMITS SHALL BE MAINTAINED AT ALL TIMES. THIS WORK SHALL BE CONSIDERED INCIDENTAL TO ITEM 900.645 "SPECIAL PROVISION (TRAFFIC CONTROL, ALL-INCLUSIVE)".

23. ANY TEMPORARY MEANS OF SUPPORTING FILL SHALL BE INCIDENTAL TO THE ITEM 528.11 "TWO-WAY TEMPORARY BRIDGE". TEMPORARY PAVEMENT MARKINGS ON APPROACHES TO THE TEMPORARY BRIDGE WILL BE INCLUDED FOR PAYMENT UNDER CONTRACT ITEM 528.11.

24. THE CONTRACTOR SHALL ADD SIGN G20-5AP TO THE TOP OF ALL TEMPORARY SPEED LIMIT SIGNS AS DETAILED IN THE MUTCD.

25. THE CONTRACTOR SHALL BE RESPONSIBLE FOR THE DESIGN AND INSTALLATION OF A SITE SPECIFIC TRAFFIC CONTROL PLAN. THE CONTRACTOR SHALL SUBMIT TO THE ENGINEER FOR APPROVAL A DETAILED TRAFFIC CONTROL PLAN FOR ALL STAGES OF CONSTRUCTION. NO WORK SHALL BEGIN UNTIL THE TRAFFIC CONTROL PLAN HAS BEEN APPROVED.

26. PAYMENT FOR ALL ON AND OFF-PROJECT CONSTRUCTION SIGNING AND TRAFFIC CONTROL DEVICES, INCLUDING DRUMS, TRAFFIC DIVIDERS AND BARRICADES, AND FOR ALL COSTS RELATED TO TRAFFIC CONTROL NOT OTHERWISE PAID UNDER A SEPARATE CONTRACT ITEM(S), INCLUDING PREPARATION OF AND IF NECESSARY REVISION(S) TO THE SITE-SPECIFIC TRAFFIC CONTROL PLAN, WILL BE INCLUDED IN THE UNIT PRICE BID FOR CONTRACT ITEM 900.645 "SPECIAL PROVISION (TRAFFIC CONTROL, ALL-INCLUSIVE)".

**NEXT F BEAMS**

27. THE NEXT F BEAMS ARE A NON-PROPRIETARY SHAPE DEVELOPED BY PCI NORTHEAST (PCINE). STANDARDIZED SECTION PROPERTIES AND DETAILS MAY BE FOUND AT [HTTP://WWW.PCINE.ORG](http://www.pcine.org).

**DESIGN VALUES**

- a. CONCRETE COMPRESSIVE STRENGTH:  $f'c = 10,000$  PSI
- b. CONCRETE COMPRESSIVE STRENGTH AT RELEASE:  $f'c = 6,500$  PSI
- c. PRESTRESSING STRANDS: 0.6 INCH DIAMETER, 270 KSI, LOW-RELAXATION 7-WIRE STRANDS
- d. ASSUMED MODULUS OF ELASTICITY = 28,500 KSI
- e. JACKING FORCE PER STRAND = 47 KIPS
- f. SERVICE LOADS:
 

MEMBER MOMENT:	406 K-FT
SUPERIMPOSED DEAD LOAD MOMENT:	368 K-FT
LIVE LOAD AND IMPACT MOMENT:	1077 K-FT
DEAD LOAD REACTION:	58 K
LIVE LOAD AND IMPACT REACTION:	119 K
TOTAL REACTION:	184 K
FINAL CAMBER:	1.15 INCHES

SEE REVISION: OCT-28-2014

PROJECT NAME: JOHNSON  
PROJECT NUMBER: BRF 030-2(26)

FILE NAME: s88bi93gnotes.dgn	PLOT DATE: 11-JUL-2014
PROJECT LEADER: C. CARLSON	DRAWN BY: R. PELLETT
DESIGNED BY: H. SALLS	CHECKED BY: H. SALLS
PROJECT NOTES	SHEET 6 OF 69

**GENERAL**

1. ALL MATERIALS AND CONSTRUCTION SHALL CONFORM TO THE STATE OF VERMONT AGENCY OF TRANSPORTATION STANDARD SPECIFICATIONS FOR CONSTRUCTION DATED 2011 AND ITS LATEST REVISIONS, THE AASHTO LRFD BRIDGE DESIGN SPECIFICATIONS SIXTH EDITION, DATED 2012 AND ITS LATEST REVISIONS AND THE AASHTO LRFD BRIDGE CONSTRUCTION SPECIFICATIONS THIRD EDITION, DATED 2010 AND ITS LATEST REVISIONS.
2. THE BRIDGE WAS DESIGNED FOR THE HL-93 LIVE LOADS.
3. ITEM 529.15 "REMOVAL OF STRUCTURE" SHALL BE USED FOR THE REMOVAL OF THE EXISTING STRUCTURE INCLUDING THE SUPERSTRUCTURE, ALONG WITH THE ABUTMENTS AND WINGWALLS OUTSIDE THE LIMITS OF STRUCTURE EXCAVATION OR UNCLASSIFIED CHANNEL EXCAVATION. THE EXISTING CONCRETE ABUTMENTS SHALL BE COMPLETELY REMOVED.
4. ALL DIMENSIONS SHOWN IN THE PLANS ARE HORIZONTAL OR VERTICAL AND ARE GIVEN AT 68 DEGREES FAHRENHEIT, UNLESS OTHERWISE NOTED.

**EARTHWORK AND RELATED ITEMS**

5. THE TEMPORARY BRIDGE AND ITS APPROACHES SHALL BE CONSTRUCTED AND PAID FOR IN ACCORDANCE WITH ITEM 528.11 "TWO-WAY TEMPORARY BRIDGE". THE APPROACHES TO THE TEMPORARY BRIDGE SHALL BE PAVED WITH 2 INCHES OF PAVEMENT.
6. TEMPORARY CONSTRUCTION FILLS WITHIN THE WATERCOURSE FOR ANY PURPOSE SHALL CONSIST OF CLEAN STONE FILL ONLY. NO OTHER FILLING IN THE STREAM SHALL OCCUR WITHOUT THE APPROVAL OF THE STREAM ALTERATION ENGINEER.
7. THE BACKFILL BEHIND THE ABUTMENTS SHALL NOT BE PLACED HIGHER THAN THE BRIDGE SEATS UNTIL THE ABUTMENTS AND DECK CONSTRUCTION IS COMPLETED.
8. THE "STONE FILL, TYPE III" UNDER THE BRIDGE AS SHOWN IN THE PLANS SHALL BE PLACED BEFORE THE NEXT BEAMS ARE SET.

**PILES**

9. TO PREVENT DAMAGE TO THE PILES, PILE SHOES ARE REQUIRED AND SHALL CONFORM TO SUBSECTION 505.04(f).
10. THE PILES SHALL BE DRIVEN TO A NOMINAL PILE DRIVING RESISTANCE OF 285 KIPS.
11. TO ENSURE THAT THE NOMINAL CAPACITY HAS BEEN ATTAINED AND TO PREVENT THE OVERSTRESSING OF THE PILE DURING DRIVING OPERATIONS, DYNAMIC PILE TESTING SHALL BE PERFORMED IN ACCORDANCE WITH SUBSECTION 505.04 OF THE STANDARD SPECIFICATIONS. PAYMENT FOR PILE TESTING SHALL BE MADE UNDER ITEM 505.45 "DYNAMIC PILE LOADING TEST". A MINIMUM OF ONE DYNAMIC PILE TEST SHALL BE CONDUCTED ON THE FIRST PILE AT EACH ABUTMENT FOR A TOTAL OF 2 TESTS. MORE TESTS MAY BE ORDERED BY THE ENGINEER. ADDITIONAL TESTS ORDERED BY THE ENGINEER WILL BE PAID FOR AT THE UNIT PRICE FOR CONTRACT ITEM 505.45.
12. FOR ESTIMATING PURPOSES, THE PILE TIP ELEVATIONS WERE ASSUMED AS SHOWN ON THE BORING LOGS. THE ACTUAL IN PLACE LENGTHS MAY VARY.
13. THE PILES SHALL BE HP 12 X 63.
14. ALL MATERIAL, LABOR, EQUIPMENT AND INCIDENTALS NECESSARY TO ITEM 505.155 "STEEL PILING, HP 12 X 63". THE CONTRACTOR MAY SUBMIT AN ALTERNATIVE METHOD OF DRIVING FOR APPROVAL BY THE ENGINEER.

**CONCRETE**

15. SUBSTRUCTURE (INCLUDING RETAINING WALL) AND APPROACH SLAB CONCRETE SHALL BE HIGH PERFORMANCE CLASS B AND SHALL BE PAID FOR UNDER ITEM 501.34, "CONCRETE, HIGH PERFORMANCE CLASS B". THE OVERLAY AND ALL CONCRETE PLACED INTEGRALLY WITH THE SUPERSTRUCTURE SHALL BE ITEM 501.33 "CONCRETE, HIGH PERFORMANCE CLASS A".
16. THE ABUTMENT AND WINGWALL CONCRETE ABOVE THE HORIZONTAL CONSTRUCTION JOINTS SHALL BE PLACED MONOLITHICALLY WITH THE DECK POUR.

17. INDIVIDUAL POURED SEGMENTS ARE TO BE PLACED IN ONE CONTINUOUS POUR WITH A MAXIMUM DURATION OF EIGHT HOURS. IF CIRCUMSTANCES BEYOND THE CONTRACTOR'S CONTROL PREVENT THIS FROM BEING ACCOMPLISHED, A CONSTRUCTION JOINT SHALL BE USED BETWEEN ADJACENT POURS. A MINIMUM 96 HOUR DELAY BETWEEN ADJACENT POURS SHALL BE OBSERVED.
18. WATER REPELLENT, SILANE SHALL BE APPLIED TO ALL EXPOSED CONCRETE SURFACES, EXCEPT THE UNDERSIDE OF THE DECK BETWEEN DRIP NOTCHES.
19. JOINTS AND SCORE MARKS IN CONCRETE SHALL BE CONSTRUCTED AS SHOWN IN THE PLANS OR AS DIRECTED BY THE RESIDENT ENGINEER.
20. EXCLUDING REINFORCING STEEL IN WINGWALLS, ALL REINFORCING STEEL ABOVE THE CONSTRUCTION JOINT SHALL BE CORROSION PROTECTION LEVEL II AND ALL REINFORCING STEEL BELOW THE CONSTRUCTION JOINT, IN WINGWALLS AND IN THE APPROACH SLABS SHALL BE CORROSION PROTECTION LEVEL I. PAYMENT WILL BE MADE UNDER THE APPROPRIATE SECTION 507 CONTRACT ITEM. OVERLAY REINFORCING SHEEL SHALL MEET THE REQUIREMENTS OF SECTION 507 FOR LEVEL II REINFORCING AND WILL BE PAID FOR UNDER CONTRACT ITEM 507.12. F BEAM REINFORCING SHALL MEET THE REQUIREMENTS OF SECTION 507 FOR LEVEL II REINFORCING AND WILL BE PAID FOR UNDER CONTRACT ITEM 900.640 SPECIAL PROVISION (PRESTRESSED CONCRETE NEXT F BEAM).
21. LEVEL I REINFORCING STEEL IN THE ABUTMENTS SHALL BE EPOXY COATED.


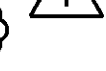

**TRAFFIC CONTROL**

22. FULL ACCESS TO ALL SIDE ROADS AND DRIVES WITHIN THE PROJECT LIMITS SHALL BE MAINTAINED AT ALL TIMES. THIS WORK SHALL BE CONSIDERED INCIDENTAL TO ITEM 900.645 "SPECIAL PROVISION (TRAFFIC CONTROL, ALL-INCLUSIVE)".
23. ANY TEMPORARY MEANS OF SUPPORTING FILL SHALL BE INCIDENTAL TO THE ITEM 528.11 "TWO-WAY TEMPORARY BRIDGE". TEMPORARY PAVEMENT MARKINGS ON APPROACHES TO THE TEMPORARY BRIDGE WILL BE INCLUDED FOR PAYMENT UNDER CONTRACT ITEM 528.11.
24. THE CONTRACTOR SHALL ADD SIGN G20-5AP TO THE TOP OF ALL TEMPORARY SPEED LIMIT SIGNS AS DETAILED IN THE MUTCD.
25. THE CONTRACTOR SHALL BE RESPONSIBLE FOR THE DESIGN AND INSTALLATION OF A SITE SPECIFIC TRAFFIC CONTROL PLAN. THE CONTRACTOR SHALL SUBMIT TO THE ENGINEER FOR APPROVAL A DETAILED TRAFFIC CONTROL PLAN FOR ALL STAGES OF CONSTRUCTION. NO WORK SHALL BEGIN UNTIL THE TRAFFIC CONTROL PLAN HAS BEEN APPROVED.
26. PAYMENT FOR ALL ON AND OFF-PROJECT CONSTRUCTION SIGNING AND TRAFFIC CONTROL DEVICES, INCLUDING DRUMS, TRAFFIC DIVIDERS AND BARRICADES, AND FOR ALL COSTS RELATED TO TRAFFIC CONTROL NOT OTHERWISE PAID UNDER A SEPARATE CONTRACT ITEM(S), INCLUDING PREPARATION OF AND IF NECESSARY REVISION(S) TO THE SITE-SPECIFIC TRAFFIC CONTROL PLAN, WILL BE INCLUDED IN THE UNIT PRICE BID FOR CONTRACT ITEM 900.645 "SPECIAL PROVISION (TRAFFIC CONTROL, ALL-INCLUSIVE)".

**NEXT F BEAMS**


27. THE NEXT F BEAMS ARE A NON-PROPRIETARY SHAPE DEVELOPED BY PCI NORTHEAST (PCINE). STANDARDIZED SECTION PROPERTIES AND DETAILS MAY BE FOUND AT [HTTP://WWW.PCINE.ORG](http://www.pcine.org).

**DESIGN VALUES**

- a. CONCRETE COMPRESSIVE STRENGTH:  $f'c = 10,000$  PSI
- b. CONCRETE COMPRESSIVE STRENGTH AT RELEASE:  $f'c = 6,500$  PSI
- c. PRESTRESSING STRANDS: 0.6 INCH DIAMETER, 270 KSI, LOW-RELAXATION 7-WIRE STRANDS
- d. ASSUMED MODULUS OF ELASTICITY = 28,500 KSI
- e. JACKING FORCE PER STRAND = 47 KIPS
- f. SERVICE LOADS:
  - MEMBER MOMENT: 406 K-FT
  - SUPERIMPOSED DEAD LOAD MOMENT: 368 K-FT
  - LIVE LOAD AND IMPACT MOMENT: 1077 K-FT 
  - DEAD LOAD REACTION: 66.1 K 
  - LIVE LOAD AND IMPACT REACTION: 119 K
  - TOTAL REACTION: 184 K
  - FINAL CAMBER: 1.09 INCHES 

PROJECT NAME: JOHNSON  
PROJECT NUMBER: BRF 030-2(26)

FILE NAME: s88bl93gnotes.dgn PLOT DATE: 05-NOV-2014  
PROJECT LEADER: C. CARLSON DRAWN BY: R. PELLET  
DESIGNED BY: H. SALLS CHECKED BY: H. SALLS  
PROJECT NOTES SHEET 6 OF 69

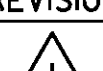REVISION	DATE	DESCRIPTION	BY
	OCT-28-2014	ADD 3" PAYMENT, LOWER BRIDGE SEAT, ADD 3" CONCRETE PEDESTAL	GNR

# QUANTITY SHEET 1

SUMMARY OF ESTIMATED QUANTITIES										TOTALS		DESCRIPTIONS				DETAILED SUMMARY OF QUANTITIES			
							ROADWAY	EROSION CONTROL	BRIDGE	FULL C.E. ITEMS	GRAND TOTAL	FINAL	UNIT	ITEMS	ITEM NUMBER	ROUND	QUANTITIES	UNIT	ITEMS
							1				1		LS	CLEARING AND GRUBBING, INCLUDING INDIVIDUAL TREES AND STUMPS	201.10				<b>EARTHWORKS SUMMARY</b>
							5600				5600		CY	COMMON EXCAVATION	203.15				<b>FILL AVAILABLE</b>
									570		570		CY	UNCLASSIFIED CHANNEL EXCAVATION	203.27				5600 CY COMMON EXCAVATION (5600 x 1.0)
							500				500		CY	SAND BORROW	203.31				171 CY UNCLASSIFIED CHANNEL EXCAVATION (570 x 0.3)
							190				190		CY	TRENCH EXCAVATION OF EARTH	204.20				114 CY TRENCH EXCAVATION OF EARTH (190 x 0.6)
							1				1		CY	TRENCH EXCAVATION OF EARTH, EXPLORATORY (N.A.B.I.)	204.22				87 CY STRUCTURE EXCAVATION (290 x 0.3)
									290		290		CY	STRUCTURE EXCAVATION	204.25				8 CY ROUNDING
									180		180		CY	GRANULAR BACKFILL FOR STRUCTURES	204.30				<b>5980 CY TOTAL FILL AVAILABLE</b>
							1110				1110		SY	COLD PLANING, BITUMINOUS PAVEMENT	210.10				<b>FILL REQUIRED</b>
							1240				1240		CY	SUBBASE OF DENSE GRADED CRUSHED STONE	301.35				265 CY FACTORED FILL (230 x 1.15)
							60				60		CY	AGGREGATE SURFACE COURSE	401.10				5 CY ROUNDING
							19				19		CWT	EMULSIFIED ASPHALT	404.65				<b>270 CY TOTAL FILL REQUIRED</b>
							1				1		LU	PRICE ADJUSTMENT, ASPHALT CEMENT (N.A.B.I.)	406.50				<b>5710 CY TOTAL WASTE</b>
									82		82		CY	CONCRETE, HIGH PERFORMANCE CLASS A	501.33				<b>COMMON EXCAVATION</b>
									154		154		CY	CONCRETE, HIGH PERFORMANCE CLASS B	501.34				5330 CY VT 100
									1		1		LS	FURNISHING EQUIPMENT FOR DRIVING PILING	504.10				220 CY TH 71
									588		588		LF	STEEL PILING, HP 12 X 63	505.155				50 CY TH 43
									2		2		EACH	DYNAMIC PILE LOADING TEST	505.45				<b>SUBBASE OF DENSE GRADED CRUSHED STONE</b>
									16424		16424		LB	REINFORCING STEEL, LEVEL I	507.11				1100 CY VT 100
									17849		17849		LB	REINFORCING STEEL, LEVEL II	507.12				60 CY TH 71
									206		206		SY	LONGITUDINAL DECK GROOVING	509.10				90 CY TH 43
									28		28		GAL	WATER REPELLENT, SILANE	514.10				<b>EMULSIFIED ASPHALT</b>
									68		68		LF	BRIDGE EXPANSION JOINT, ASPHALTIC PLUG	516.10				16 CWT VT 100
									68		68		LF	JOINT SEALER, HOT Poured	524.11				1 CWT TH 71
									122		122		LF	BRIDGE RAILING, GALVANIZED 3 RAIL BOX BEAM	525.335				2 CWT TH 43
									1		1		LS	TWO-WAY TEMPORARY BRIDGE (Ø10 SF - EST.)	528.11				<b>SPECIAL PROVISION (BITUMINOUS CONCRETE PAVEMENT, SMALL QUANTITY)</b>
									1		1		EACH	REMOVAL OF STRUCTURE (755 SF - EST.)	529.15				604 TON VT 100
									16		16		EACH	BEARING DEVICE ASSEMBLY, STEEL REINFORCED ELASTOMERIC PAD	531.17				18 TON TH 71
														BEGIN OPTION AA					58 TON TH 43
							128				128		LF	18" CAAP .060 (2-2/3 X 1/2)	601.0215				
							128				128		LF	18" PCCSP .064 (2-2/3 X 1/2)	601.0415				
							128				128		LF	18" CPEP(SL)	601.2615				
														END OPTION AA					
							348				348		LF	8 INCH UNDERDRAIN PIPE	605.11				
							3				3		LF	6 INCH UNDERDRAIN CARRIER PIPE	605.20				
							78				78		LF	8 INCH UNDERDRAIN CARRIER PIPE	605.21				
							1				1		EACH	UNDERDRAIN FLUSHING BASIN	605.95				
								1			1		TON	DUST AND ICE CONTROL WITH CALCIUM CHLORIDE	609.15				
							60	10			70		CY	STONE FILL, TYPE I	613.10				
							1330				1330		CY	STONE FILL, TYPE II	613.11				

SEE REVISION: OCT-28-2014

PROJECT NAME:	JOHNSON	PLOT DATE:	06/10/2014
PROJECT NUMBER:	BRF 030-2(26)	DRAWN BY:	G. ROY
FILE NAME:	s88193qs.dgn	CHECKED BY:	H. SALLS
PROJECT LEADER:	C. CARLSON	DESIGNED BY:	H. SALLS
QUANTITY SHEET #1		QUANTITY SHEET #1	SHEET 7 OF 69

# QUANTITY SHEET 1

SUMMARY OF ESTIMATED QUANTITIES										TOTALS		DESCRIPTIONS			DETAILED SUMMARY OF QUANTITIES			
						ROADWAY	EROSION CONTROL	BRIDGE	FULL C.E. ITEMS	GRAND TOTAL	FINAL	UNIT	ITEMS	ITEM NUMBER	ROUND	QUANTITIES	UNIT	ITEMS
						1				1		LS	CLEARING AND GRUBBING, INCLUDING INDIVIDUAL TREES AND STUMPS	201.10				
						5600				5600		CY	COMMON EXCAVATION	203.15				
								570		570		CY	UNCLASSIFIED CHANNEL EXCAVATION	203.27				
						500				500		CY	SAND BORROW	203.31				
						190				190		CY	TRENCH EXCAVATION OF EARTH	204.20				
						1				1		CY	TRENCH EXCAVATION OF EARTH, EXPLORATORY (N.A.B.I.)	204.22				
								290		290		CY	STRUCTURE EXCAVATION	204.25				
								180		180		CY	GRANULAR BACKFILL FOR STRUCTURES	204.30				
						1110				1110		SY	COLD PLANING, BITUMINOUS PAVEMENT	210.10				
						1240				1240		CY	SUBBASE OF DENSE GRADED CRUSHED STONE	301.35				
						60				60		CY	AGGREGATE SURFACE COURSE	401.10				
						19				19		CWT	EMULSIFIED ASPHALT	404.65				
						1				1		LU	PRICE ADJUSTMENT, ASPHALT CEMENT (N.A.B.I.)	406.50				
										82		CY	CONCRETE, HIGH PERFORMANCE CLASS A	501.33				
										154		CY	CONCRETE, HIGH PERFORMANCE CLASS B	501.34				
										152		LS	FURNISHING EQUIPMENT FOR DRIVING PILING	504.10				
										588		LF	STEEL PILING, HP 12 X 63	505.155				
								2		2		EACH	DYNAMIC PILE LOADING TEST	505.45				
								16424		16424		LB	REINFORCING STEEL, LEVEL I	507.11				
								17849		17849		LB	REINFORCING STEEL, LEVEL II	507.12				
										206		SY	LONGITUDINAL DECK GROOVING	509.10				
								28		28		GAL	WATER REPELLENT, SILANE	514.10				
								68		68		LF	BRIDGE EXPANSION JOINT, ASPHALTIC PLUG	516.10				
								68		68		LF	JOINT SEALER, HOT Poured	524.11				
								122		122		LF	BRIDGE RAILING, GALVANIZED 3 RAIL BOX BEAM	525.335				
								1		1		LS	TWO-WAY TEMPORARY BRIDGE (910 SF - EST.)	528.11				
								1		1		EACH	REMOVAL OF STRUCTURE (755 SF - EST.)	529.15				
								16		16		EACH	BEARING DEVICE ASSEMBLY, STEEL REINFORCED ELASTOMERIC PAD	531.17				
													BEGIN OPTION AA					
						128				128		LF	18" CAAP .060 (2-2/3 X 1/2)	601.0215				
						128				128		LF	18" PCCSP .064 (2-2/3 X 1/2)	601.0415				
						128				128		LF	18" CPEP(SL)	601.2615				
													END OPTION AA					
						348				348		LF	8 INCH UNDERDRAIN PIPE	605.11				
						3				3		LF	6 INCH UNDERDRAIN CARRIER PIPE	605.20				
						78				78		LF	8 INCH UNDERDRAIN CARRIER PIPE	605.21				
						1				1		EACH	UNDERDRAIN FLUSHING BASIN	605.95				
							1			1		TON	DUST AND ICE CONTROL WITH CALCIUM CHLORIDE	609.15				
						60	10			70		CY	STONE FILL, TYPE I	613.10				
						1330				1330		CY	STONE FILL, TYPE II	613.11				

PROJECT NAME:	JOHNSON
PROJECT NUMBER:	BRF 030-2(26)
FILE NAME:	s88193qs.dgn
PROJECT LEADER:	C. CARLSON
DESIGNED BY:	H. SALLS
QUANTITY SHEET #1	
PLOT DATE:	06/10/2014
DRAWN BY:	G. ROY
CHECKED BY:	H. SALLS
SHEET	7 OF 69

REVISION	DATE	DESCRIPTION	BY
△	OCT-28-2014	ADD 3" PAYMENT, LOWER BRIDGE SEAT, ADD 3" CONCRETE PEDESTAL	GNR

# QUANTITY SHEET 2

SUMMARY OF ESTIMATED QUANTITIES										TOTALS		DESCRIPTIONS				DETAILED SUMMARY OF QUANTITIES			
							ROADWAY	EROSION CONTROL	BRIDGE	FULL C.E. ITEMS	GRAND TOTAL	FINAL	UNIT	ITEMS	ITEM NUMBER	ROUND	QUANTITIES	UNIT	ITEMS
									440		440		CY	STONE FILL, TYPE III	613.12				
							2				2		EACH	YIELDING MARKER POSTS	619.17				
							251				251		LF	HD STEEL BEAM GUARDRAIL, GALVANIZED	621.21				
							232				232		LF	BOX BEAM GUARDRAIL	621.30				
							4				4		EACH	GUARDRAIL APPROACH SECTION, GALVANIZED 3 RAIL BOX BEAM	621.725				
							687				687		LF	REMOVAL AND DISPOSAL OF GUARDRAIL	621.80				
							100				100		HR	UNIFORMED TRAFFIC OFFICERS	630.10				
							1000				1000		HR	FLAGGERS	630.15				
										1	1		LS	FIELD OFFICE, ENGINEERS	631.10				
										1	1		LS	TESTING EQUIPMENT, CONCRETE	631.16				
										1	1		LS	TESTING EQUIPMENT, BITUMINOUS	631.17				
										3000	3000		DL	FIELD OFFICE TELEPHONE (N.A.B.I.)	631.26				
							1				1		LS	MOBILIZATION/DEMobilIZATION	635.11				
							1560				1560		LF	4 INCH WHITE LINE	646.20				
							740				740		LF	4 INCH YELLOW LINE	646.21				
							26				26		LF	24 INCH STOP BAR	646.26				
							730		200		930		SY	GEOTEXTILE UNDER STONE FILL	649.31				
								170			170		SY	GEOTEXTILE FOR SILT FENCE, WOVEN WIRE REINFORCED	649.515				
								107			107		SY	GEOTEXTILE FOR FILTER CURTAIN	649.61				
								30			30		LB	SEED	651.15				
								30			30		LB	SEED, WINTER RYE	651.17				
								190			190		LB	FERTILIZER	651.18				
								1			1		TON	AGRICULTURAL LIMESTONE	651.20				
								1			1		TON	HAY MULCH	651.25				
								100			100		CY	TOPSOIL	651.35				
								190			190		SY	GRUBBING MATERIAL	651.40				
								1			1		LS	EPSC PLAN	652.10				
								50			50		HR	MONITORING EPSC PLAN	652.20				
								1			1		LU	MAINTENANCE OF EPSC PLAN (N.A.B.I.)	652.30				
								1520			1520		SY	TEMPORARY EROSION MATTING	653.20				
								10			10		CY	TEMPORARY STONE CHECK DAM, TYPE I	653.25				
								30			30		CY	VEHICLE TRACKING PAD	653.35				
								2			2		EACH	INLET PROTECTION DEVICE, TYPE I	653.40				
								1630			1630		LF	PROJECT DEMARCATION FENCE	653.55				
							31.34				31.34		SF	TRAFFIC SIGNS, TYPE A	675.20				
								98			98		LF	SQUARE TUBE SIGN POST AND ANCHOR	675.341				
								8			8		EACH	REMOVING SIGNS	675.50				
								1			1		LU	PRICE ADJUSTMENT, FUEL (N.A.B.I.)	690.50				
								6			6		EACH	SPECIAL PROVISION (CPM SCHEDULE)	900.620				
								71			71		LF	SPECIAL PROVISION (GUARDRAIL TRANSITION, STEEL BEAM TO BOX BEAM)	900.640				

PROJECT NAME: **JOHNSON**  
 PROJECT NUMBER: **BRF 030-2(26)**  
 FILE NAME: s88193qs.dgn PLOT DATE: 06/10/2014  
 PROJECT LEADER: C. CARLSON DRAWN BY: G. ROY  
 DESIGNED BY: H. SALLS CHECKED BY: H. SALLS  
 QUANTITY SHEET #2 SHEET 8 OF 69

# QUANTITY SHEET 3

SUMMARY OF ESTIMATED QUANTITIES										TOTALS		DESCRIPTIONS				DETAILED SUMMARY OF QUANTITIES			
							ROADWAY	EROSION CONTROL	BRIDGE	FULL C.E. ITEMS	GRAND TOTAL	FINAL	UNIT	ITEMS	ITEM NUMBER	ROUND	QUANTITIES	UNIT	ITEMS
									229		229		LF	SPECIAL PROVISION (PRESTRESSED CONCRETE NEXT F BEAMS)(NEXT 24 F)	900.640				
							1				1		LS	SPECIAL PROVISION (TRAFFIC CONTROL, ALL-INCLUSIVE)	900.645				
							1				1		LU	SPECIAL PROVISION (MAT DENSITY PAY ADJUSTMENT, SMALL QUANTITY) (N.A.B.I.)	900.650				
							1				1		LU	SPECIAL PROVISION (MIXTURE PAY ADJUSTMENT) (N.A.B.I.)	900.650				
							680				680		TON	SPECIAL PROVISION (BITUMINOUS CONCRETE PAVEMENT, SMALL QUANTITY)	900.680				

SEE REVISION: OCT-28-2014

PROJECT NAME:	<b>JOHNSON</b>	PLOT DATE:	06/10/2014
PROJECT NUMBER:	<b>BRF 030-2(26)</b>	DRAWN BY:	G. ROY
FILE NAME:	s88193qs.dgn	CHECKED BY:	H. SALLS
PROJECT LEADER:	C. CARLSON	DESIGNED BY:	H. SALLS
DESIGNED BY:	H. SALLS	QUANTITY SHEET #3	SHEET 9 OF 69

# QUANTITY SHEET 3

SUMMARY OF ESTIMATED QUANTITIES										TOTALS		DESCRIPTIONS				DETAILED SUMMARY OF QUANTITIES		
						ROADWAY	EROSION CONTROL	BRIDGE	FULL C.E. ITEMS	GRAND TOTAL	FINAL	UNIT	ITEMS	ITEM NUMBER	ROUND	QUANTITIES	UNIT	ITEMS
								229		229		LF	SPECIAL PROVISION (PRESTRESSED CONCRETE NEXT F BEAMS)(NEXT 24 F)	900.640				
						1				1		LS	SPECIAL PROVISION (TRAFFIC CONTROL, ALL-INCLUSIVE)	900.645				
						1				1		LU	SPECIAL PROVISION (MAT DENSITY PAY ADJUSTMENT, SMALL QUANTITY) (N.A.B.I.)	900.650				
						1		△		1	△ 715	LU	SPECIAL PROVISION (MIXTURE PAY ADJUSTMENT) (N.A.B.I.)	900.650				
						680		△ 35		△ 680		TON	SPECIAL PROVISION (BITUMINOUS CONCRETE PAVEMENT, SMALL QUANTITY)	900.680	△			
								△ 219		△ 219		SY	SHEET MEMBRANE WATERPROOFING, TORCH APPLIED	519.20	△			
								△		△								

PROJECT NAME: **JOHNSON**  
 PROJECT NUMBER: **BRF 030-2(26)**  
 FILE NAME: s88193qs.dgn  
 PROJECT LEADER: C. CARLSON  
 DESIGNED BY: H. SALLS  
 QUANTITY SHEET #3

PLOT DATE: 06/10/2014  
 DRAWN BY: G. ROY  
 CHECKED BY: H. SALLS  
 SHEET 9 OF 69

REVISION	DATE	DESCRIPTION	BY
△	OCT-28-2014	ADD 3" PAYMENT, LOWER BRIDGE SEAT, ADD 3" CONCRETE PEDESTAL	GNR

# BRIDGE QUANTITY SHEET 1

SUMMARY OF BRIDGE QUANTITIES											TOTALS		DESCRIPTIONS			DETAILED SUMMARY OF QUANTITIES			
			DECK	APPROACH SLAB #1	APPROACH SLAB #2	ABUTMENT #1	ABUTMENT #2	RETAINING WALL	CHANNEL		BRIDGE TOTAL		UNIT	ITEMS	ITEM NUMBER		QUANTITIES	UNIT	ITEMS
										570	570		CY	UNCLASSIFIED CHANNEL EXCAVATION	203.27				
						205	85				290		CY	STRUCTURE EXCAVATION	204.25				
						130	50				180		CY	GRANULAR BACKFILL FOR STRUCTURES	204.30				
			55			14	13				82		CY	CONCRETE, HIGH PERFORMANCE CLASS A	501.33				
				30	30	36	34	24			154		CY	CONCRETE, HIGH PERFORMANCE CLASS B	501.34				
						0.5	0.5				1		LS	FURNISHING EQUIPMENT FOR DRIVING PILING	504.10				
						300	288				588		LF	STEEL PILING, HP 12 X 63	505.155				
						1	1				2		EACH	DYNAMIC PILE LOADING TEST	505.45				
				3720	3720	3622	3260	2102			16424		LB	REINFORCING STEEL, LEVEL I	507.11				
			15189			1330	1330				17849		LB	REINFORCING STEEL, LEVEL II	507.12				
			206								206		SY	LONGITUDINAL DECK GROOVING	509.10				
			18			5	5				28		GAL	WATER REPELLENT, SILANE	514.10				
				34	34						68		LF	BRIDGE EXPANSION JOINT, ASPHALTIC PLUG	516.10				
				34	34						68		LF	JOINT SEALER, HOT POURED	524.11				
			122								122		LF	BRIDGE RAILING, GALVANIZED 3 RAIL BOX BEAM	525.335				
			1								1		LS	TWO-WAY TEMPORARY BRIDGE (Ø10 SF - EST.)	528.11				
			1								1		EACH	REMOVAL OF STRUCTURE (755 SF - EST.)	529.15				
						8	8				16		EACH	BEARING DEVICE ASSEMBLY, STEEL REINFORCED ELASTOMERIC PAD	531.17				
											440		CY	STONE FILL, TYPE III	613.12				
											200		SY	GEOTEXTILE UNDER STONE FILL	649.31				
			229								229		LF	SPECIAL PROVISION (PRESTRESSED CONCRETE NEXT F BEAMS)(NEXT 24 F)	900.640				

SEE REVISION: OCT-28-2014

PROJECT NAME:	<b>JOHNSON</b>	PLOT DATE:	06/10/2014
PROJECT NUMBER:	<b>BRF 030-2(26)</b>	DRAWN BY:	G. ROY
FILE NAME:	s88193qs.dgn	DESIGNED BY:	H. SALLS
PROJECT LEADER:	C. CARLSON	CHECKED BY:	H. SALLS
BRIDGE QUANTITY SHEET #1		SHEET	10 OF 69

# BRIDGE QUANTITY SHEET 1

SUMMARY OF BRIDGE QUANTITIES										TOTALS		DESCRIPTIONS			DETAILED SUMMARY OF QUANTITIES		
DECK	APPROACH SLAB #1	APPROACH SLAB #2	ABUTMENT #1	ABUTMENT #2	RETAINING WALL	CHANNEL	BRIDGE TOTAL	UNIT	ITEMS	ITEM NUMBER	QUANTITIES	UNIT	ITEMS				
						570	570	CY	UNCLASSIFIED CHANNEL EXCAVATION	203.27							
			205	85			290	CY	STRUCTURE EXCAVATION	204.25							
			130	50			180	CY	GRANULAR BACKFILL FOR STRUCTURES	204.30							
55			14	13	14		82	CY	CONCRETE, HIGH PERFORMANCE CLASS A	501.33							
	30		36	34	24		164	CY	CONCRETE, HIGH PERFORMANCE CLASS B	501.34							
			0.5	0.5	33		1	LS	FURNISHING EQUIPMENT FOR DRIVING PILING	504.10							
			300	288			588	LF	STEEL PILING, HP 12 X 63	505.155							
			1	1			2	EACH	DYNAMIC PILE LOADING TEST	505.45							
	3720	3720	3622	3260	2102		16424	LB	REINFORCING STEEL, LEVEL I	507.11							
15189			1330	1330			17849	LB	REINFORCING STEEL, LEVEL II	507.12							
206							206	SY	LONGITUDINAL DECK GROOVING	509.10							
18			5	5			28	GAL	WATER REPELLENT, SILANE	514.10							
	34	34					68	LF	BRIDGE EXPANSION JOINT, ASPHALTIC PLUG	516.10							
	34	34					68	LF	JOINT SEALER, HOT POURED	524.11							
122							122	LF	BRIDGE RAILING, GALVANIZED 3 RAIL BOX BEAM	525.335							
1							1	LS	TWO-WAY TEMPORARY BRIDGE (910 SF - EST.)	528.11							
1							1	EACH	REMOVAL OF STRUCTURE (755 SF - EST.)	529.15							
			8	8			16	EACH	BEARING DEVICE ASSEMBLY, STEEL REINFORCED ELASTOMERIC PAD	531.17							
						440	440	CY	STONE FILL, TYPE III	613.12							
						200	200	SY	GEOTEXTILE UNDER STONE FILL	649.31							
229							229	LF	SPECIAL PROVISION (PRESTRESSED CONCRETE NEXT F BEAMS)(NEXT 24 F)	900.640							
219							219	SY	SHEET MEMBRANE WATERPROOFING, TORCH APPLIED	519.20							
35							35	TON	SPECIAL PROVISION (BITUMINOUS CONCRETE PAVEMENT, SMALL QUANTITY)	900.680							

PROJECT NAME: JOHNSON  
 PROJECT NUMBER: BRF 030-2(26)  
 FILE NAME: s88193qs.dgn  
 PROJECT LEADER: C. CARLSON  
 DESIGNED BY: H. SALLS  
 BRIDGE QUANTITY SHEET #1  
 PLOT DATE: 06/10/2014  
 DRAWN BY: G. ROY  
 CHECKED BY: H. SALLS  
 SHEET 10 OF 69

REVISION	DATE	DESCRIPTION	BY
△	OCT-28-2014	ADD 3" PAYMENT, LOWER BRIDGE SEAT, ADD 3" CONCRETE PEDESTAL	GNR

GPS CONTROL POINTS

HVCTRL #1

WILLOW JOHNSON  
 NORTH = 783529.516  
 EAST = 1576565.987  
 ELEV. = 468.400

 
 
 


JOHNSON, VT. SET 12 CM (5 INCHES) BELOW GROUND IN THE TOP OF A FENO STYLE MONUMENT. 6.5 M (21.3 FT) SOUTHWEST OF AND ABOUT 0.3 M (1.0 FT) LOWER THAN THE CL OF VT ROUTE 15, 12.7 M (41.7 FT) EAST NORTHEAST OF THE CL OF THE LAMOILLE VALLEY RAILROAD, 8.3 M (27.2 FT) EAST OF AN UNNUMBERED TELEGRAPH POLE, 40.8 M (133.9 FT) NORTHWEST OF POLE NO 1829, 49.4 M (162.1 FT) SOUTHEAST OF POLE NO 320T/1830, AND 0.3 M (1.0 FT) NORTHEAST OF A FIBERGLASS WITNESS. NOTE, MARK IS INTERVISIBLE WITH MARK A99012.

HVCTRL #2

A99012  
 NORTH = 782485.886  
 EAST = 1579355.260  
 ELEV. = 517.970

JOHNSON, VT. THE MARK IS SET 5 CM (2 INCHES) BELOW GROUND, 9.2 M (30.2 FT) SOUTH OF AND ABOUT 0.2 M (0.7 FT) HIGHER THAN THE CENTERLINE OF VT ROUTE 15, 51.7 M (169.6 FT) SOUTHEAST OF POLE NO 1819, 62.2 M (204.1 FT) NORTHEAST OF THE NORTHEAST CORNER OF A ONE STORY HOUSE, AND 41.0 M (134.5 FT) SOUTHWEST OF POLE NO 1818 AND A FIBERGLASS WITNESS. MARK IS INTERVISIBLE WITH MARK LIN DALE (LIN DALE IS NOT GPSABLE WITHOUT MAJOR BRUSH AND TREE CLEARING.) MARK IS INTERVISIBLE WITH MARK WILLOW JOHNSON.

TRAVERSE TIES

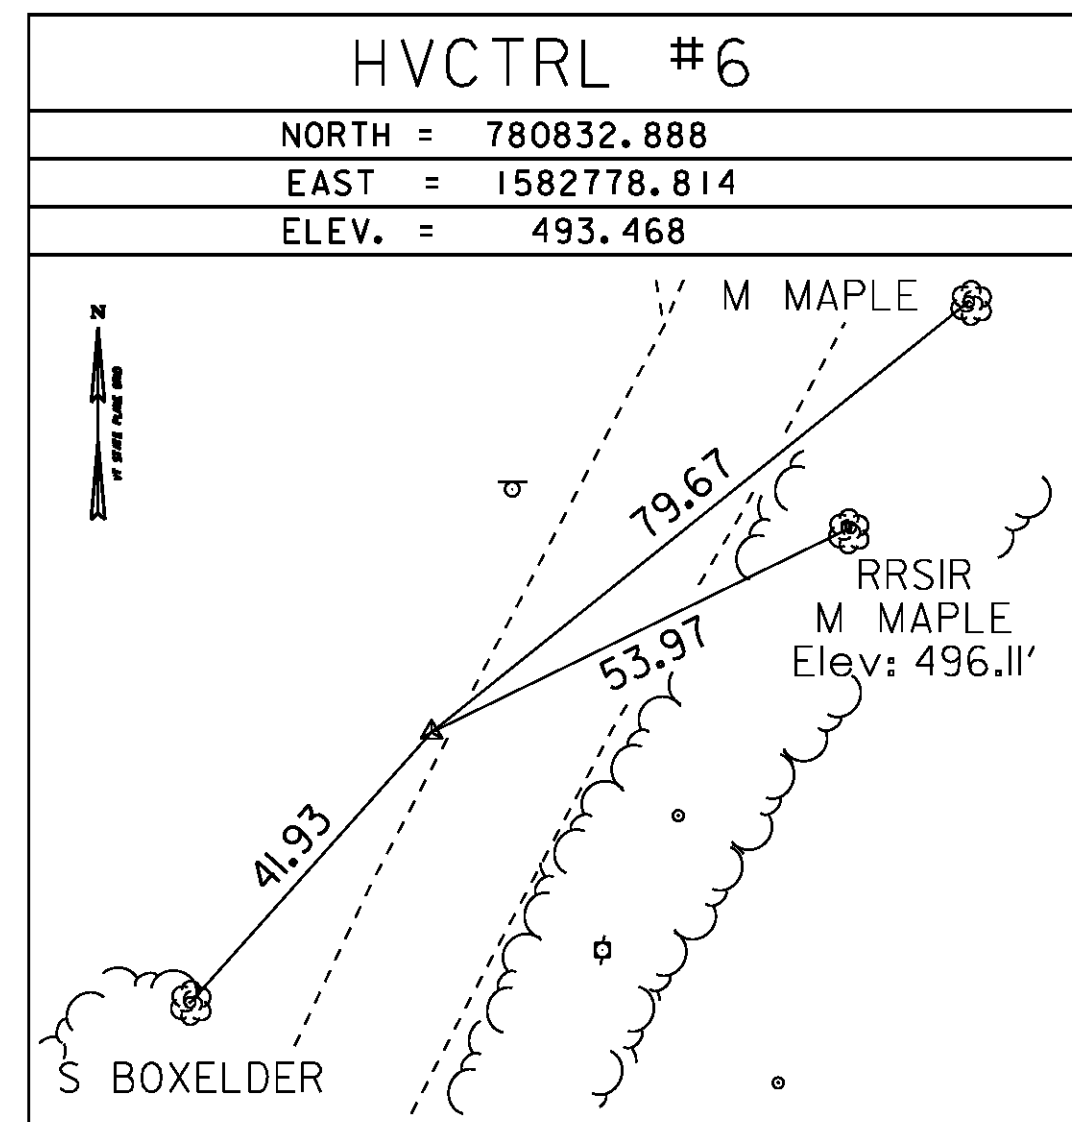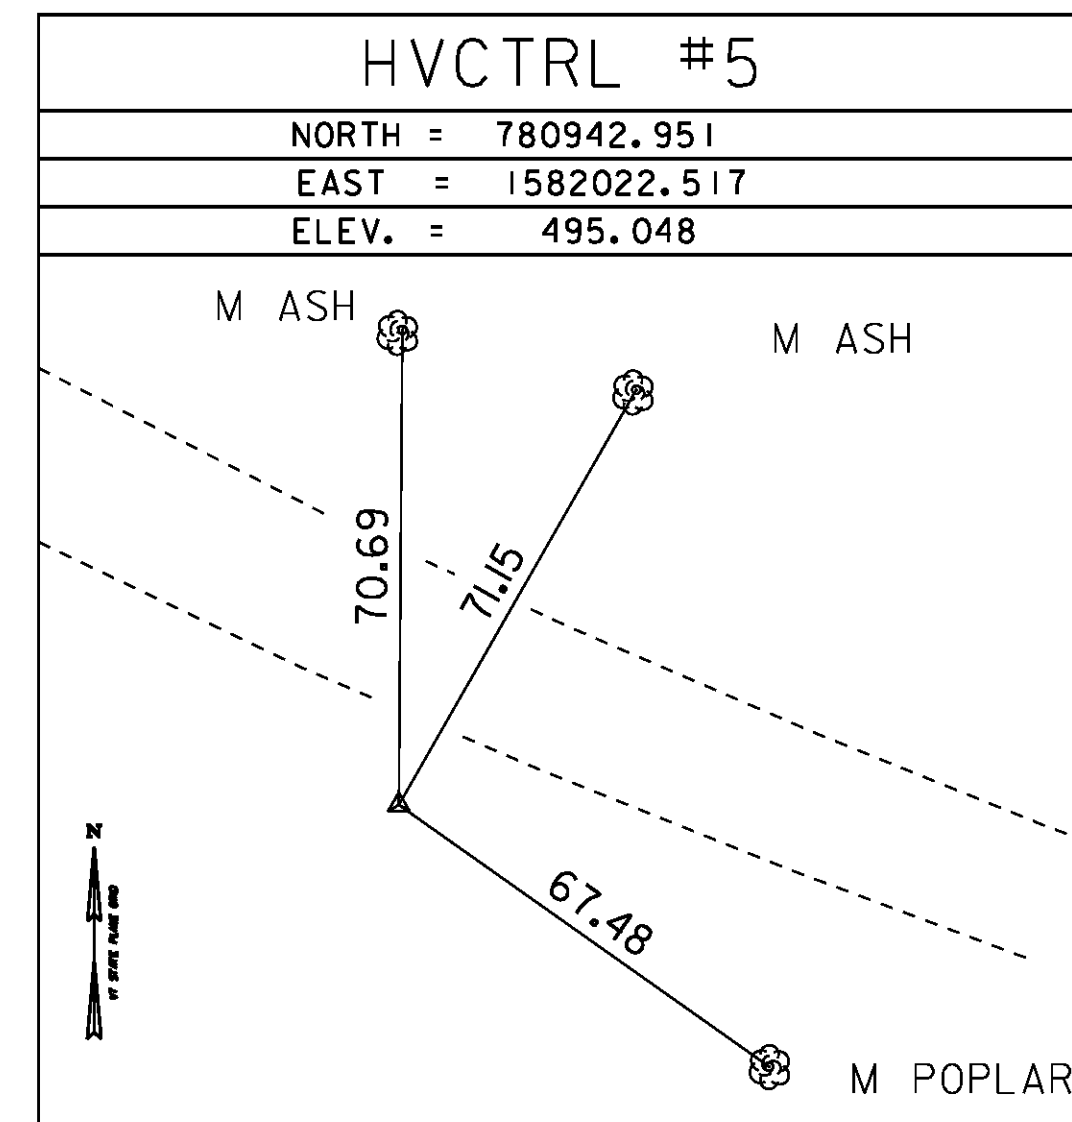

* Main Traverse Completed 10/28/09 by R. Gilman P.C. & P. Winters & T. Parker

ALIGNMENT TIES

VT 15			
	STATION	NORTHING	EASTING
PC	88+50.00	780891.1986	1582234.9167
PI	89+55.01	780868.9766	1582337.5490
PCC	90+58.63	780876.2129	1582442.3100
Delta:	16°10'07"	Left	
Degree of Curve:	7°45'00"		
Radius:	739.30		
Tangent:	105.01		
Length:	208.63		
External:	7.42		
PCC	90+58.63	780876.2129	1582442.3100
PI	91+53.84	780882.7744	1582537.3027
PT	92+48.78	780901.8520	1582630.5911
Delta:	7°36'23"	Left	
Degree of Curve:	4°00'00"		
Radius:	1432.39		
Tangent:	95.22		
Length:	190.16		
External:	3.16		

VT 15 (CONTINUED)			
	STATION	NORTHING	EASTING
PC	94+90.43	780950.2674	1582867.3395
PI	96+09.05	780974.0323	1582983.5486
PT	97+27.25	780980.7966	1583101.9697
Delta:	8°17'19"	Right	
Degree of Curve:	3°30'00"		
Radius:	1637.02		
Tangent:	118.61		
Length:	236.81		
External:	4.29		
POE	97+50.00	780982.0941	1583124.6860

TH 71			
	STATION	NORTHING	EASTING
POB	30+00.00	780909.3084	1582667.0525
PC	30+35.98	780944.5577	1582659.8440
PI	30+68.02	780975.9457	1582653.4251
PT	31+00.00	781006.5307	1582643.8875
Delta:	5°45'43"	Left	
Degree of Curve:	9°00'00"		
Radius:	636.62		
Tangent:	32.04		
Length:	64.02		
External:	0.81		

TH 43			
	STATION	NORTHING	EASTING
POB	40+00.00	780939.1613	1582813.0313
PC	40+18.90	780920.6488	1582816.8171
PI	40+49.08	780891.0749	1582822.8650
PRC	40+76.62	780864.8774	1582807.8690
Delta:	41°20'43"	Right	
Degree of Curve:	71°37'11"		
Radius:	80.00		
Tangent:	30.19		
Length:	57.73		
External:	5.51		
PRC	40+76.62	780864.8774	1582807.8690
PI	41+13.32	780833.0284	1582789.6380
PT	41+50.00	780800.1824	1582773.2714
Delta:	3°18'05"	Left	
Degree of Curve:	4°29'58"		
Radius:	1273.41		
Tangent:	36.70		
Length:	73.38		
External:	0.53		

DATUM	
VERTICAL	NAVD 88
HORIZONTAL	NAD 83 (96)
ADJUSTMENT	Compass

PROJECT NAME: JOHNSON	
PROJECT NUMBER: BRF 030-2(26)	
FILE NAME: s88bl93+1e.dgn	PLOT DATE: 10-JUN-2014
PROJECT LEADER: C. CARLSON	DRAWN BY: R. PELLET
DESIGNED BY: H. SALLS	CHECKED BY: H. SALLS
TIE SHEET	SHEET II OF 69

**VT 15 CURVE DATA NO. 1**

Δ = 16° 10' 07" LT  
 D = 7° 45' 00"  
 R = 739.30'  
 T = 105.01'  
 L = 208.63'  
 E = 7.42'

**VT 15 CURVE DATA NO. 2**

Δ = 7° 36' 23" LT  
 D = 4° 00' 00"  
 R = 1432.39'  
 T = 95.22'  
 L = 190.16'  
 E = 3.16'

**VT 15 CURVE DATA NO. 3**

Δ = 8° 17' 19" RT  
 D = 3° 30' 00"  
 R = 1637.02'  
 T = 118.61'  
 L = 236.81'  
 E = 4.29'

**TH 71 CURVE DATA NO. 1**



Δ = 5° 45' 43" LT  
 D = 9° 00' 00"  
 R = 636.62'  
 T = 32.04'  
 L = 64.02'  
 E = 0.81'

**TH 43 CURVE DATA NO. 1**

Δ = 41° 20' 43" RT  
 D = 71° 37' 11"  
 R = 80.00'  
 T = 30.19'  
 L = 57.73'  
 E = 5.51'

**TH 43 CURVE DATA NO. 2**

Δ = 3° 18' 05" LT  
 D = 4° 29' 58"  
 R = 1273.41'  
 T = 36.70'  
 L = 73.38'  
 E = 0.53'

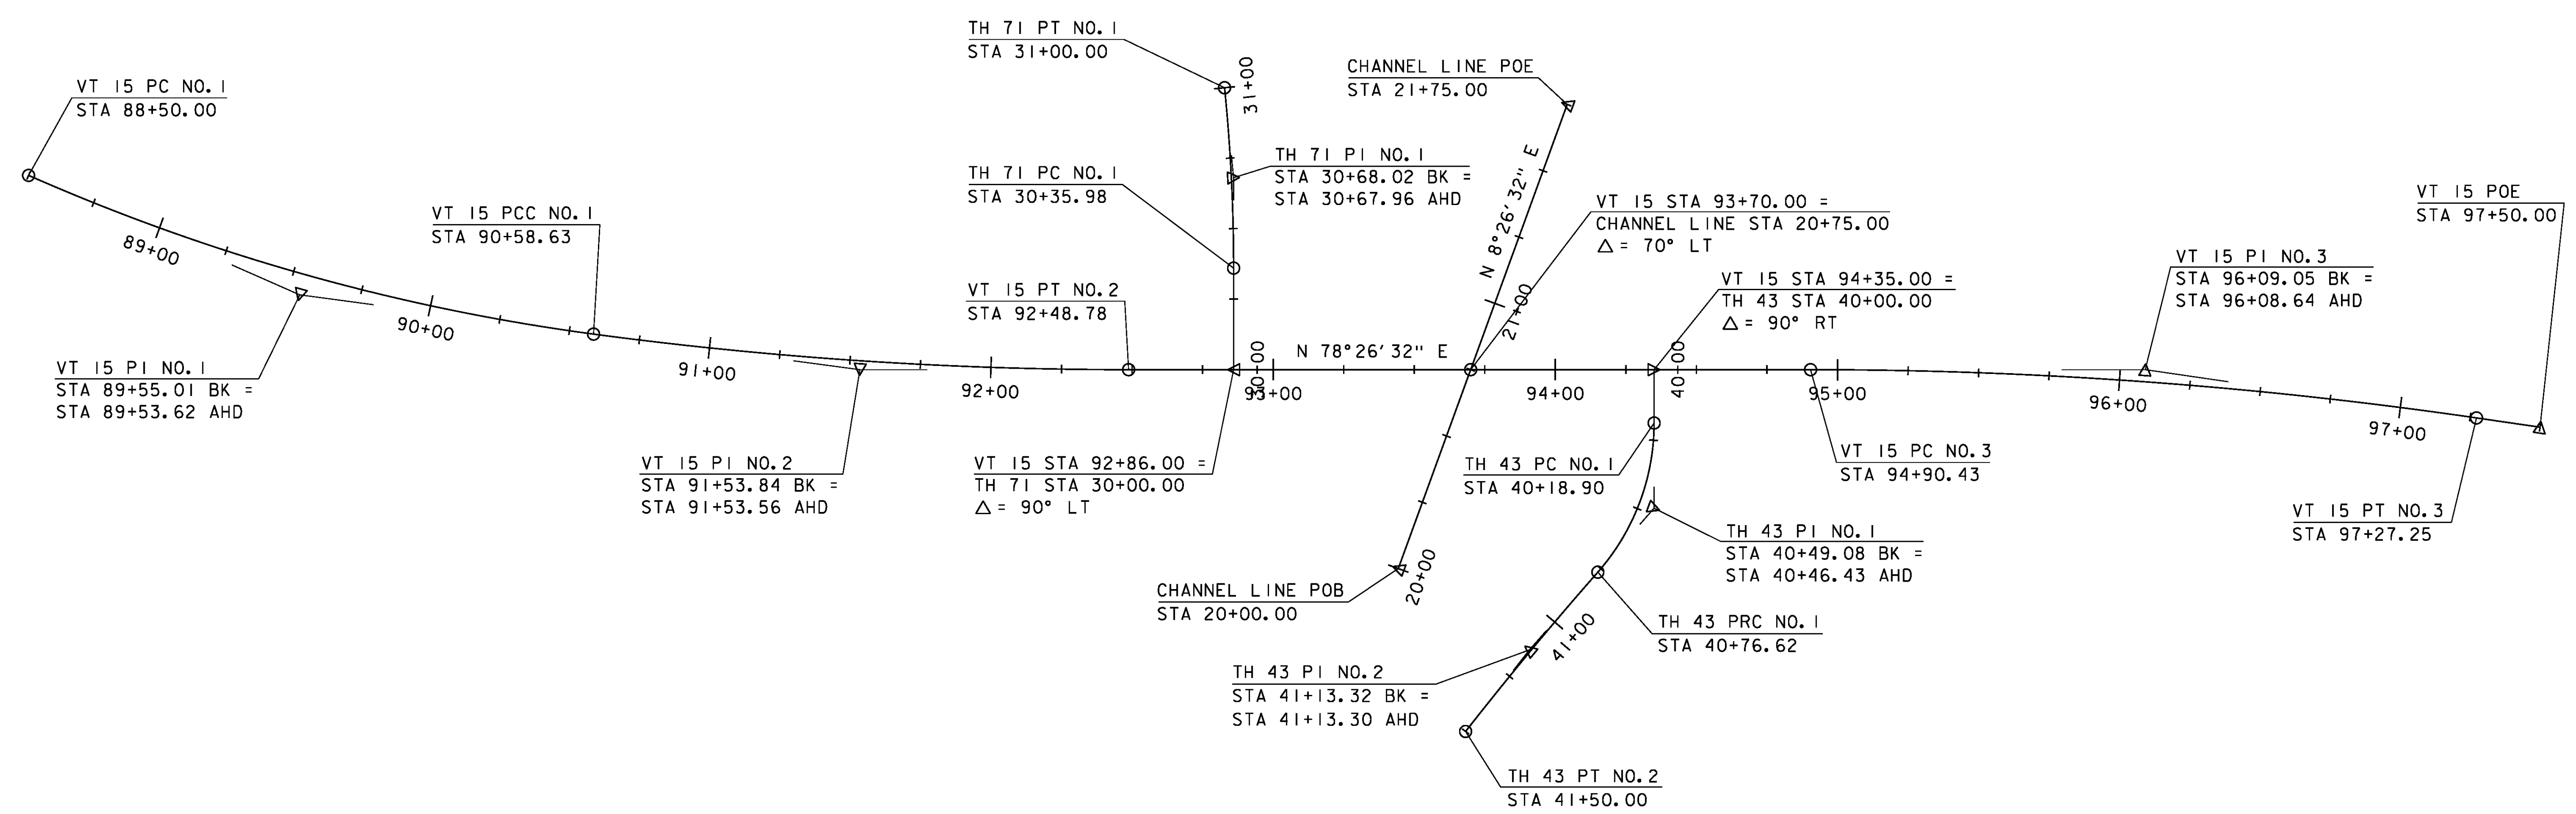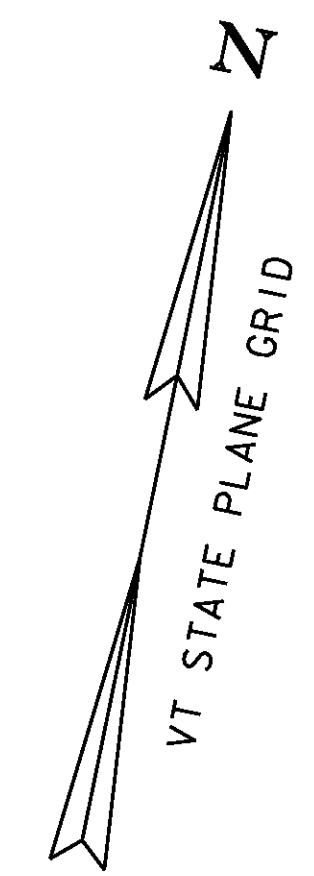

SCALE 1" = 30'-0"  
 30 0 30

PROJECT NAME: JOHNSON	FILE NAME: s88b193d1gn.dgn	PLOT DATE: 10-JUN-2014
PROJECT NUMBER: BRF 030-2(26)	PROJECT LEADER: C. CARLSON	DRAWN BY: R. PELLET
	DESIGNED BY: H. SALLS	CHECKED BY: H. SALLS
	ALIGNMENT	SHEET 12 OF 69



**CONSTRUCT STONE FILL, TYPE II BANK SLOPE**  
 VT 15 STA 89+00.0 LT - VT 15 STA 92+00.0 LT

**CONSTRUCT GRASS-LINED DITCH**  
 VT 15 STA 89+00.0 LT - VT 15 STA 92+00.0 LT

**HD STEEL BEAM GUARDRAIL, GALVANIZED**  
 VT 15 STA ~~89+59.8~~ 89+40.0 RT - VT 15 STA 92+00.0 RT


**REMOVAL AND DISPOSAL OF GUARDRAIL**  
 VT 15 STA ~~89+59.8~~ 89+40.0 RT - VT 15 STA 92+00.00 RT

① VT 15 STA 89+00.0 LT - VT 15 STA 92+00.0 LT  
 NEW 8 INCH UNDERDRAIN PIPE W/ UNDERDRAIN FLUSHING  
 BASIN AND YIELDING MARKER POST AT INLET

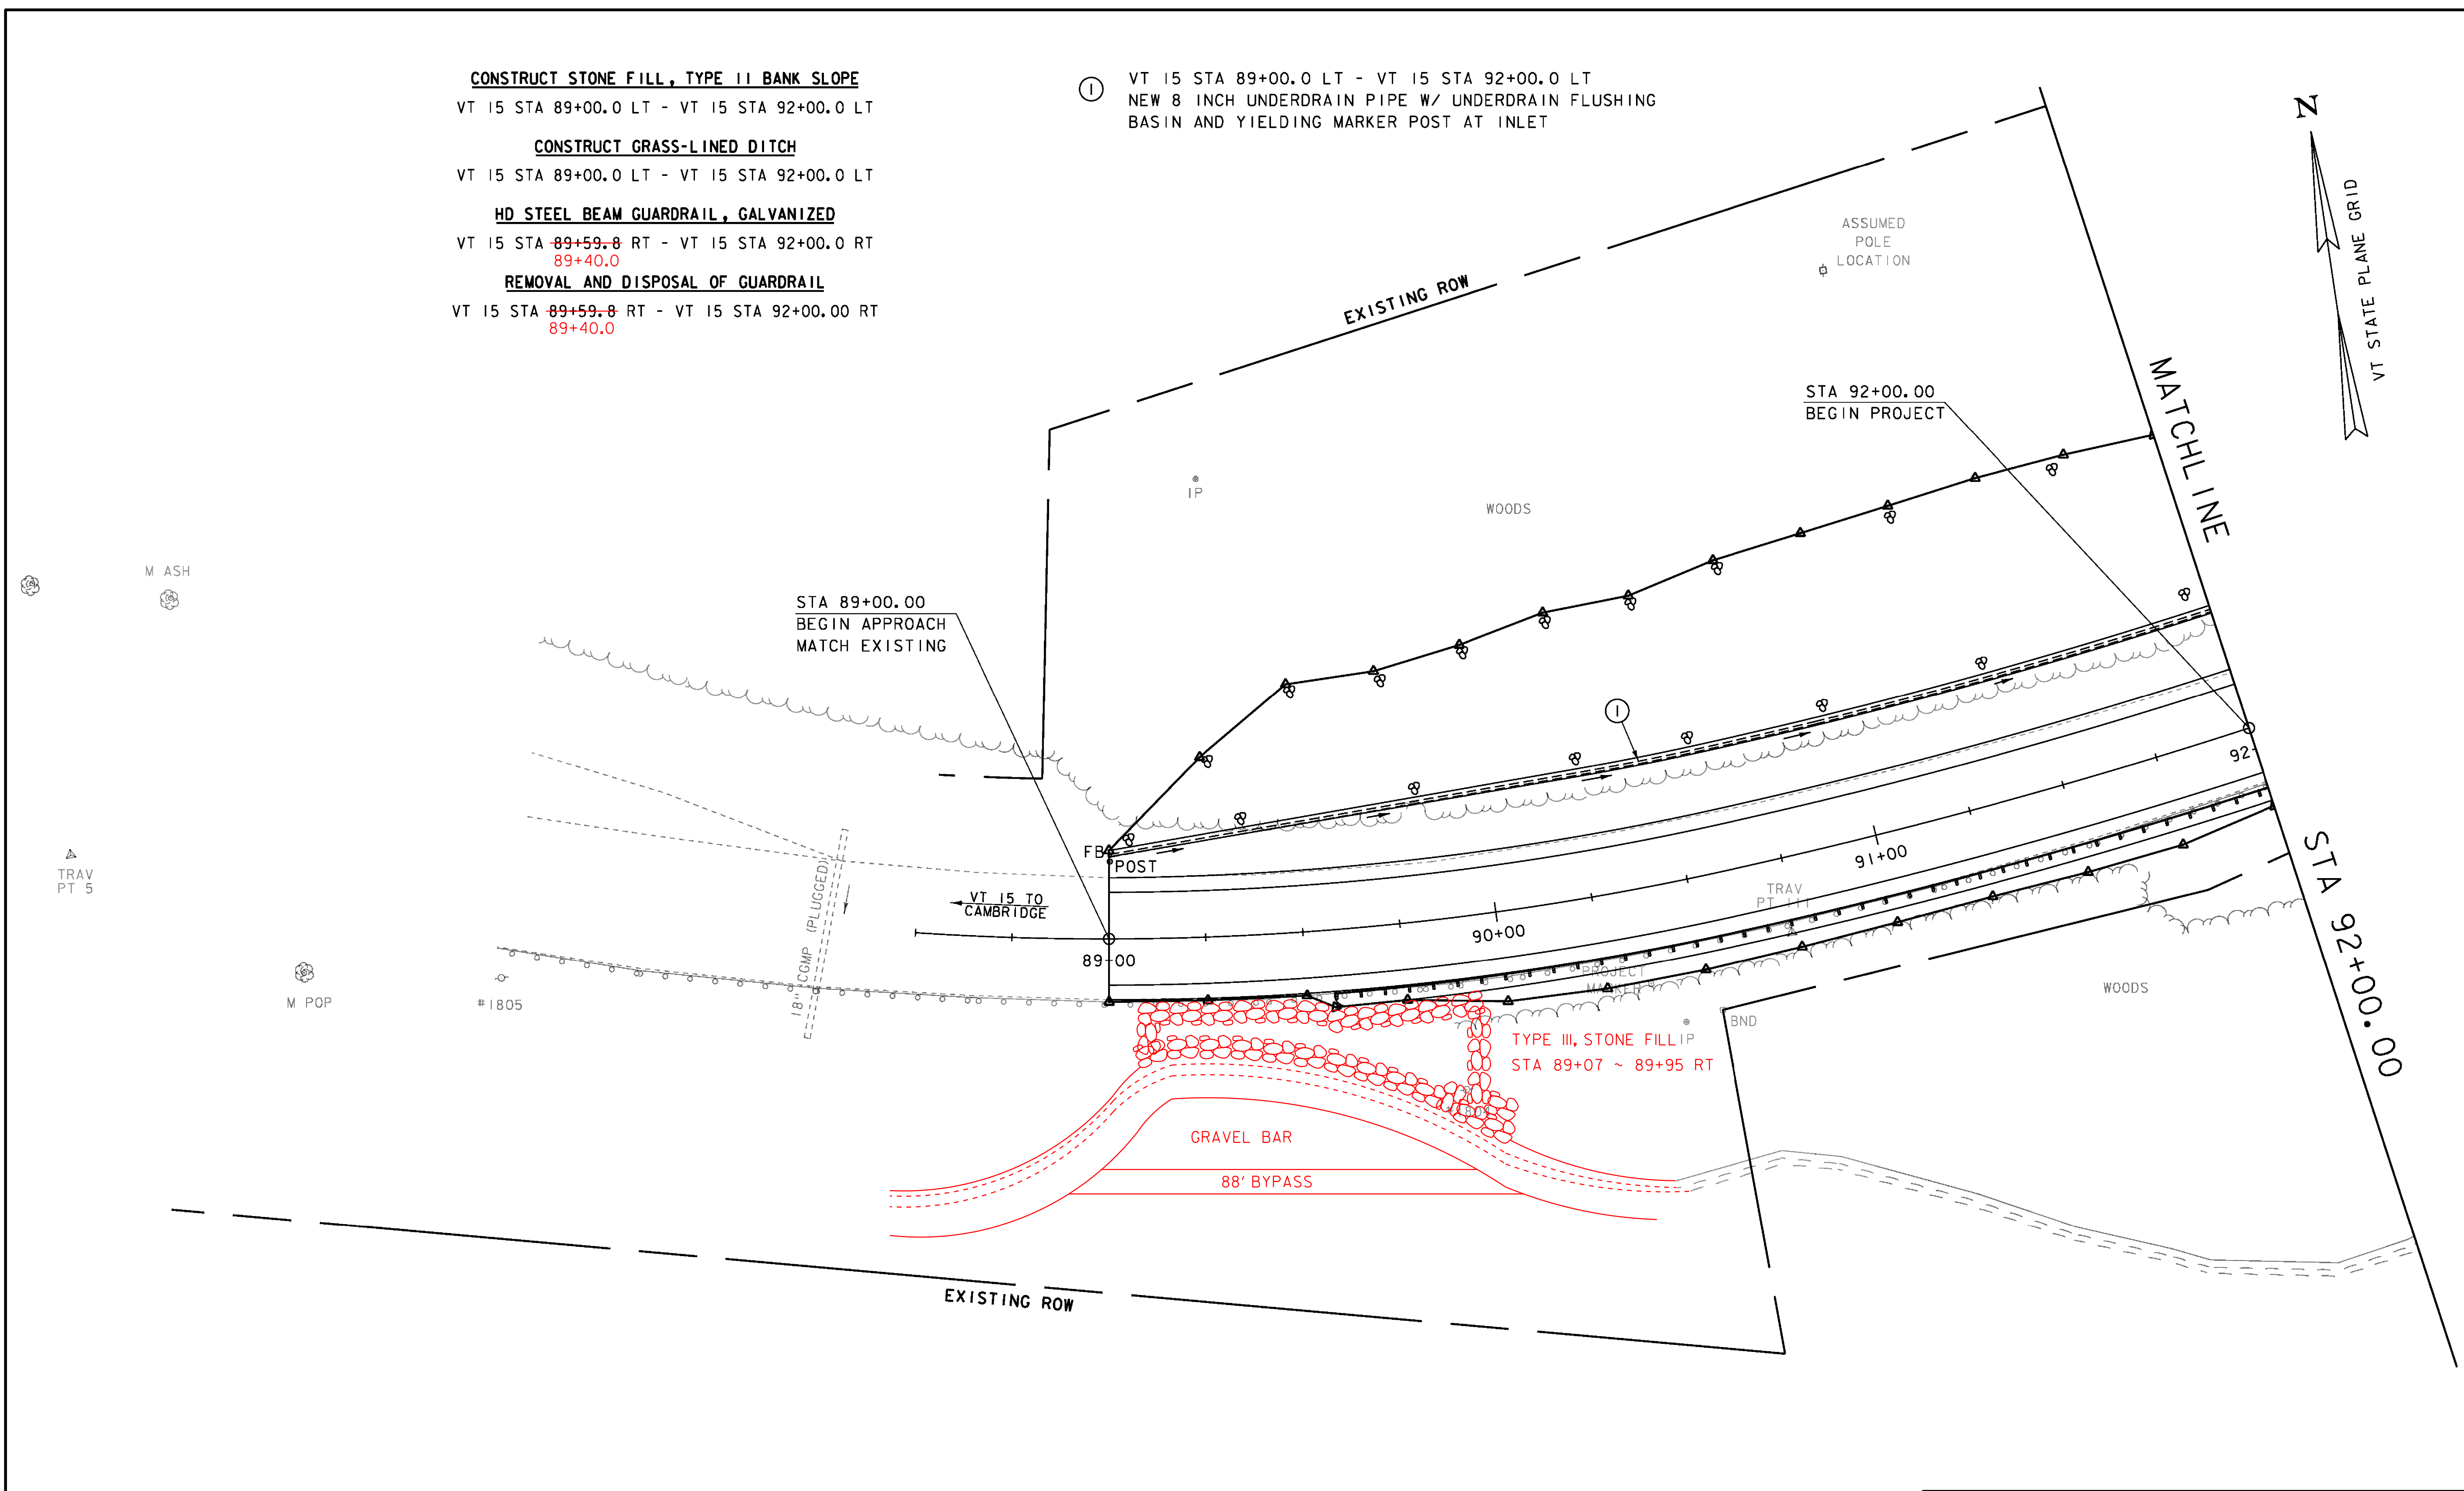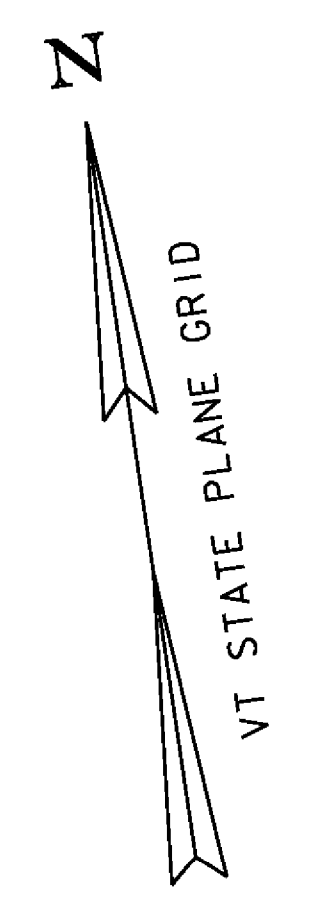

20 0 20  
 SCALE: 1" = 20'-0"


PROJECT NAME: JOHNSON	PLOT DATE: 10-JUN-2014
PROJECT NUMBER: BRF 030-2(26)	DRAWN BY: G. ROY
FILE NAME: s88bi93bdr.dgn	CHECKED BY: H. SALLS
PROJECT LEADER: C. CARLSON	SHEET 13 OF 69
DESIGNED BY: G. ROY	
LAYOUT (1)	

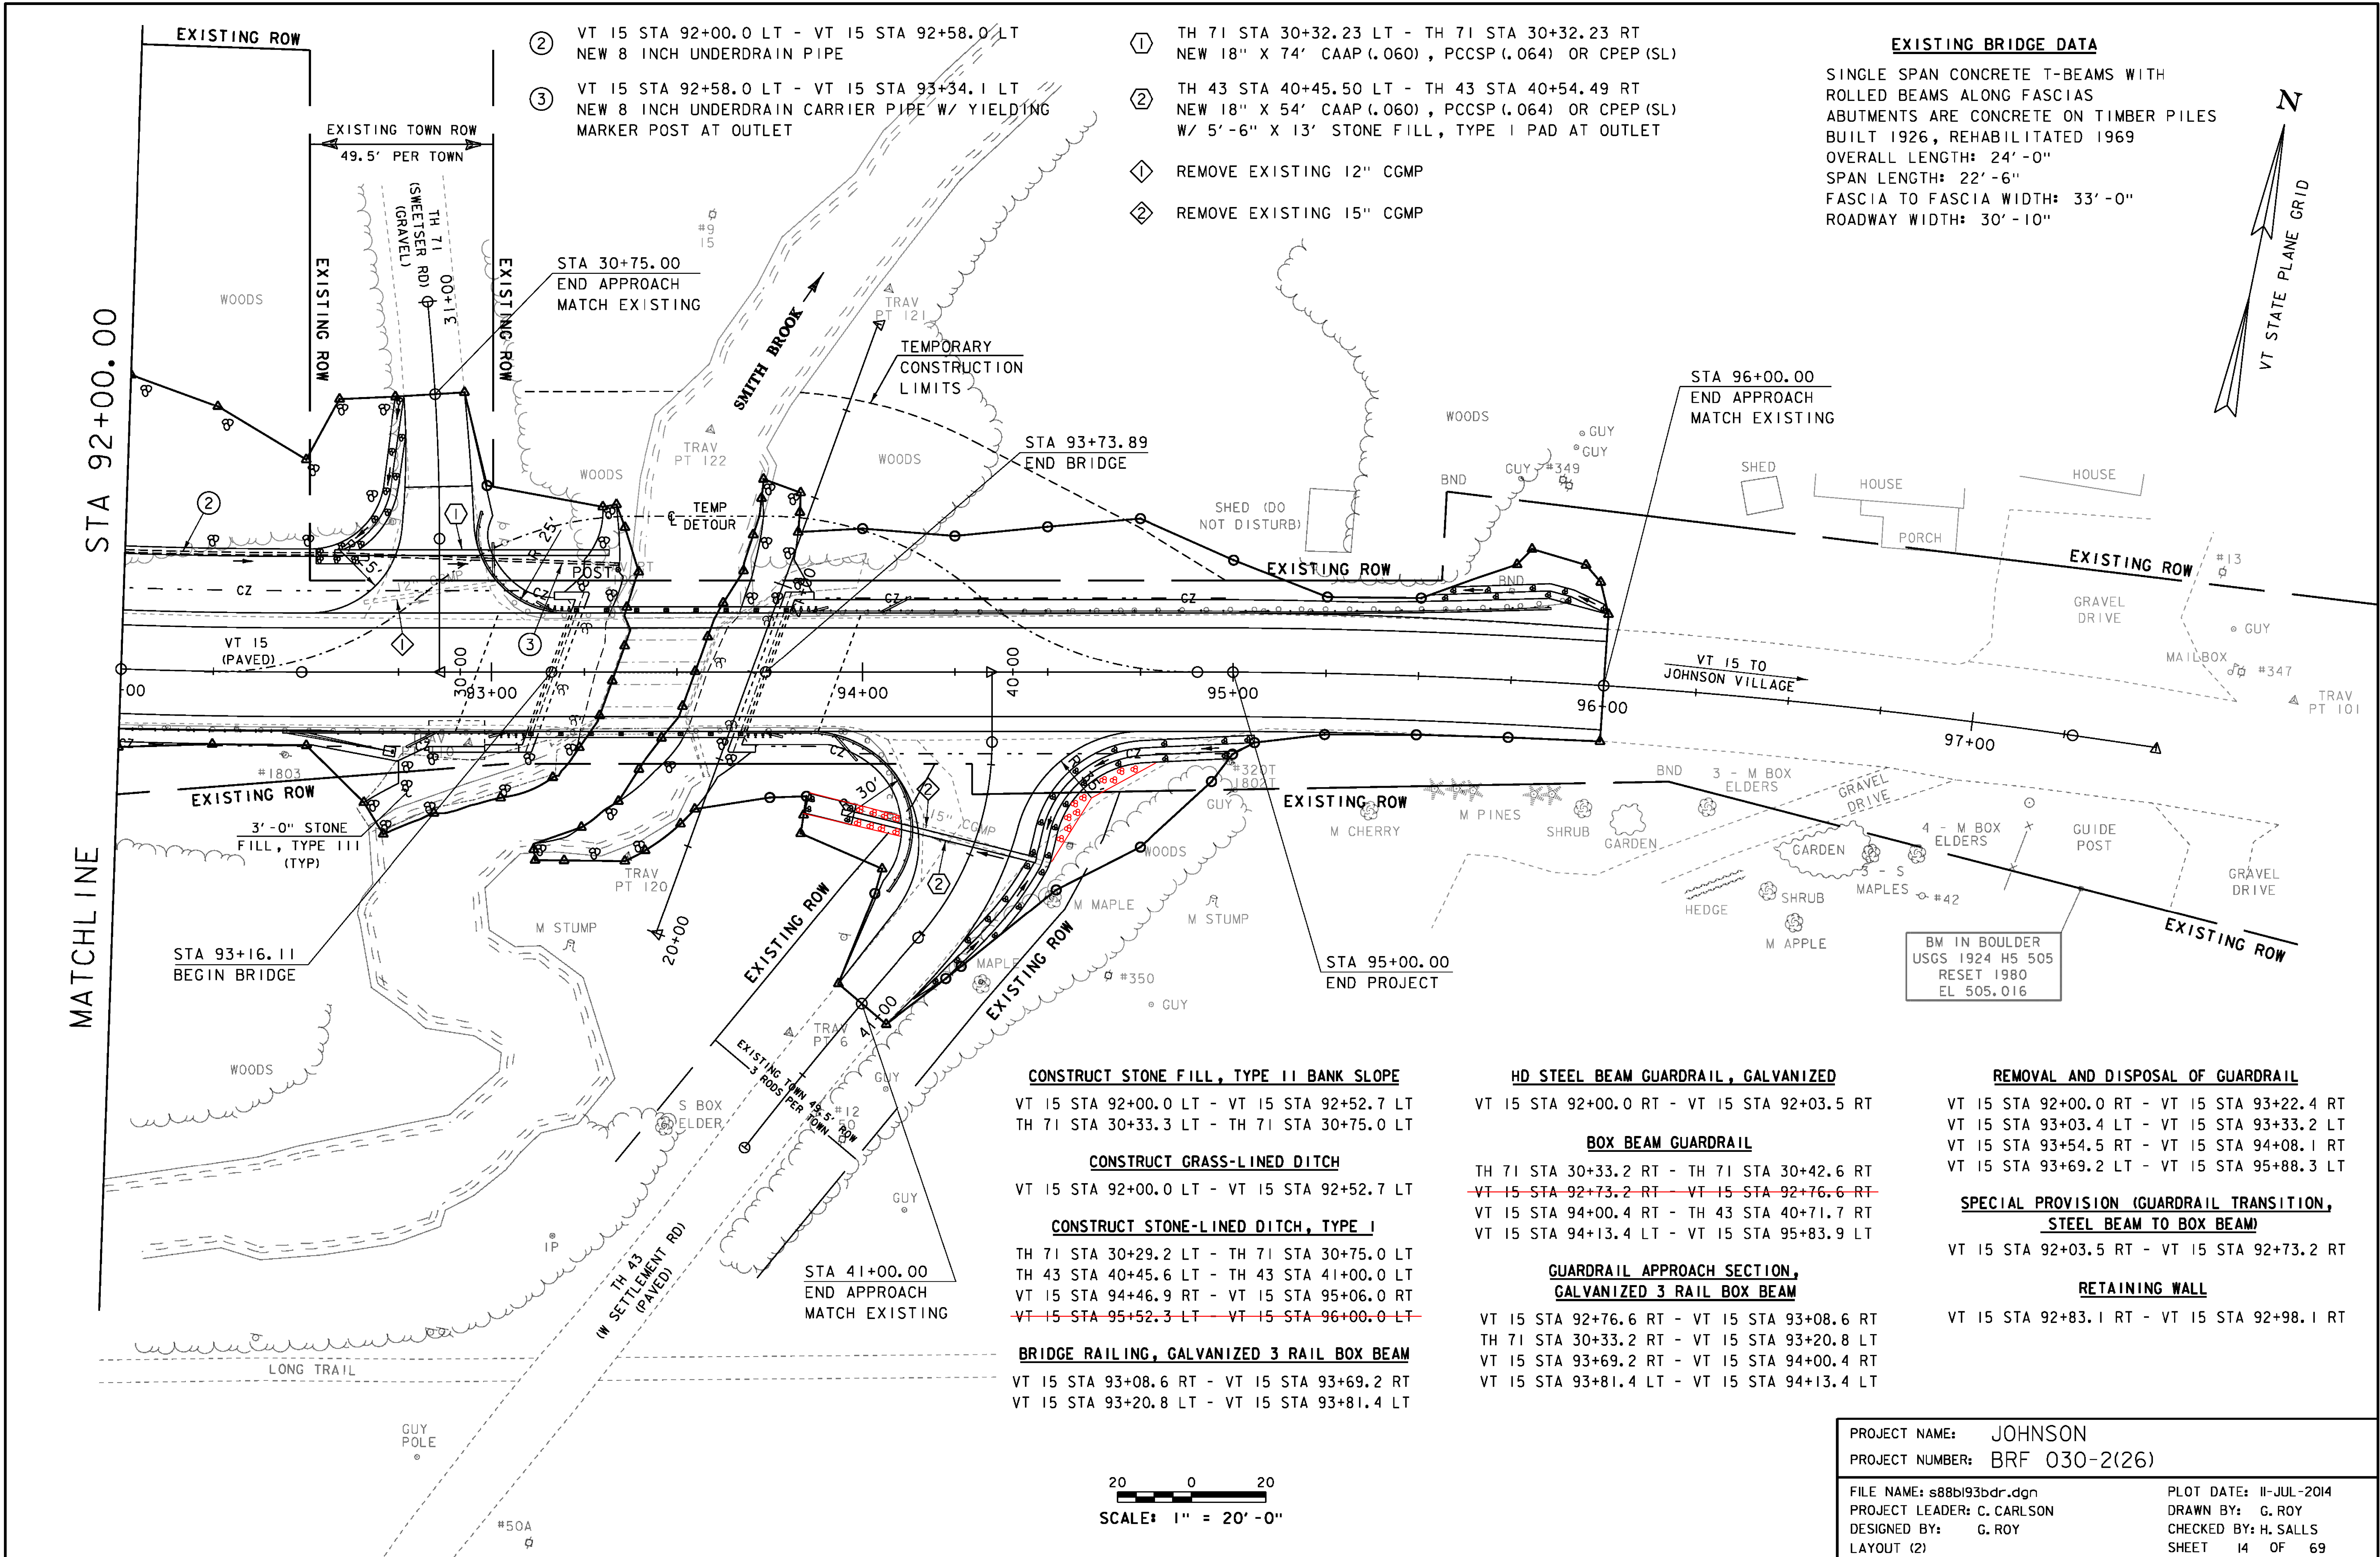

- ② VT 15 STA 92+00.0 LT - VT 15 STA 92+58.0 LT  
NEW 8 INCH UNDERDRAIN PIPE
- ③ VT 15 STA 92+58.0 LT - VT 15 STA 93+34.1 LT  
NEW 8 INCH UNDERDRAIN CARRIER PIPE W/ YIELDING  
MARKER POST AT OUTLET

- ① TH 71 STA 30+32.23 LT - TH 71 STA 30+32.23 RT  
NEW 18" X 74' CAAP (.060), PCCSP (.064) OR CPEP (SL)
- ② TH 43 STA 40+45.50 LT - TH 43 STA 40+54.49 RT  
NEW 18" X 54' CAAP (.060), PCCSP (.064) OR CPEP (SL)  
W/ 5'-6" X 13' STONE FILL, TYPE I PAD AT OUTLET
- ◇ REMOVE EXISTING 12" CGMP
- ◇ REMOVE EXISTING 15" CGMP

**EXISTING BRIDGE DATA**  
 SINGLE SPAN CONCRETE T-BEAMS WITH  
 ROLLED BEAMS ALONG FASCIAS  
 ABUTMENTS ARE CONCRETE ON TIMBER PILES  
 BUILT 1926, REHABILITATED 1969  
 OVERALL LENGTH: 24'-0"  
 SPAN LENGTH: 22'-6"  
 FASCIA TO FASCIA WIDTH: 33'-0"  
 ROADWAY WIDTH: 30'-10"

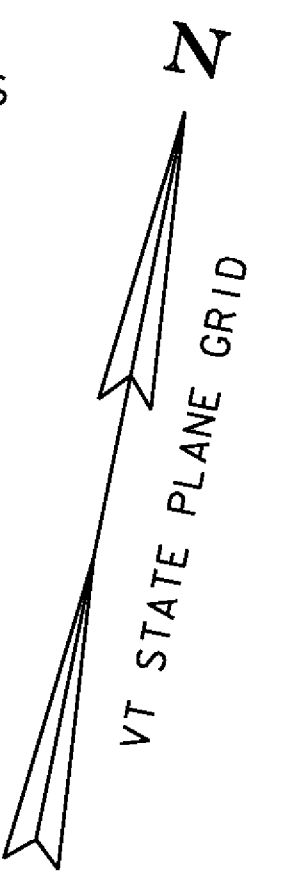

**CONSTRUCT STONE FILL, TYPE II BANK SLOPE**

VT 15 STA 92+00.0 LT - VT 15 STA 92+52.7 LT  
 TH 71 STA 30+33.3 LT - TH 71 STA 30+75.0 LT

**CONSTRUCT GRASS-LINED DITCH**

VT 15 STA 92+00.0 LT - VT 15 STA 92+52.7 LT

**CONSTRUCT STONE-LINED DITCH, TYPE I**

TH 71 STA 30+29.2 LT - TH 71 STA 30+75.0 LT  
 TH 43 STA 40+45.6 LT - TH 43 STA 41+00.0 LT  
 VT 15 STA 94+46.9 RT - VT 15 STA 95+06.0 RT  
~~VT 15 STA 95+52.3 LT - VT 15 STA 96+00.0 LT~~

**BRIDGE RAILING, GALVANIZED 3 RAIL BOX BEAM**

VT 15 STA 93+08.6 RT - VT 15 STA 93+69.2 RT  
 VT 15 STA 93+20.8 LT - VT 15 STA 93+81.4 LT

**HD STEEL BEAM GUARDRAIL, GALVANIZED**

VT 15 STA 92+00.0 RT - VT 15 STA 92+03.5 RT

**BOX BEAM GUARDRAIL**

TH 71 STA 30+33.2 RT - TH 71 STA 30+42.6 RT  
~~VT 15 STA 92+73.2 RT - VT 15 STA 92+76.6 RT~~  
 VT 15 STA 94+00.4 RT - TH 43 STA 40+71.7 RT  
 VT 15 STA 94+13.4 LT - VT 15 STA 95+83.9 LT

**GUARDRAIL APPROACH SECTION,  
GALVANIZED 3 RAIL BOX BEAM**

VT 15 STA 92+76.6 RT - VT 15 STA 93+08.6 RT  
 TH 71 STA 30+33.2 RT - VT 15 STA 93+20.8 LT  
 VT 15 STA 93+69.2 RT - VT 15 STA 94+00.4 RT  
 VT 15 STA 93+81.4 LT - VT 15 STA 94+13.4 LT

**REMOVAL AND DISPOSAL OF GUARDRAIL**


VT 15 STA 92+00.0 RT - VT 15 STA 93+22.4 RT  
 VT 15 STA 93+03.4 LT - VT 15 STA 93+33.2 LT  
 VT 15 STA 93+54.5 RT - VT 15 STA 94+08.1 RT  
 VT 15 STA 93+69.2 LT - VT 15 STA 95+88.3 LT

**SPECIAL PROVISION (GUARDRAIL TRANSITION,  
STEEL BEAM TO BOX BEAM)**


VT 15 STA 92+03.5 RT - VT 15 STA 92+73.2 RT

**RETAINING WALL**

VT 15 STA 92+83.1 RT - VT 15 STA 92+98.1 RT

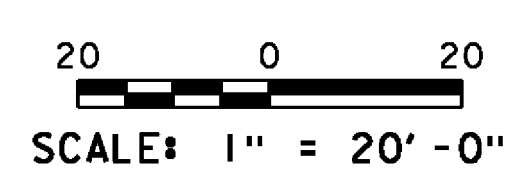

PROJECT NAME:	JOHNSON	FILE NAME:	s88bi93bdr.dgn	PLOT DATE:	11-JUL-2014
PROJECT NUMBER:	BRF 030-2(26)	PROJECT LEADER:	C. CARLSON	DRAWN BY:	G. ROY
		DESIGNED BY:	G. ROY	CHECKED BY:	H. SALLS
		LAYOUT (2)		SHEET	14 OF 69

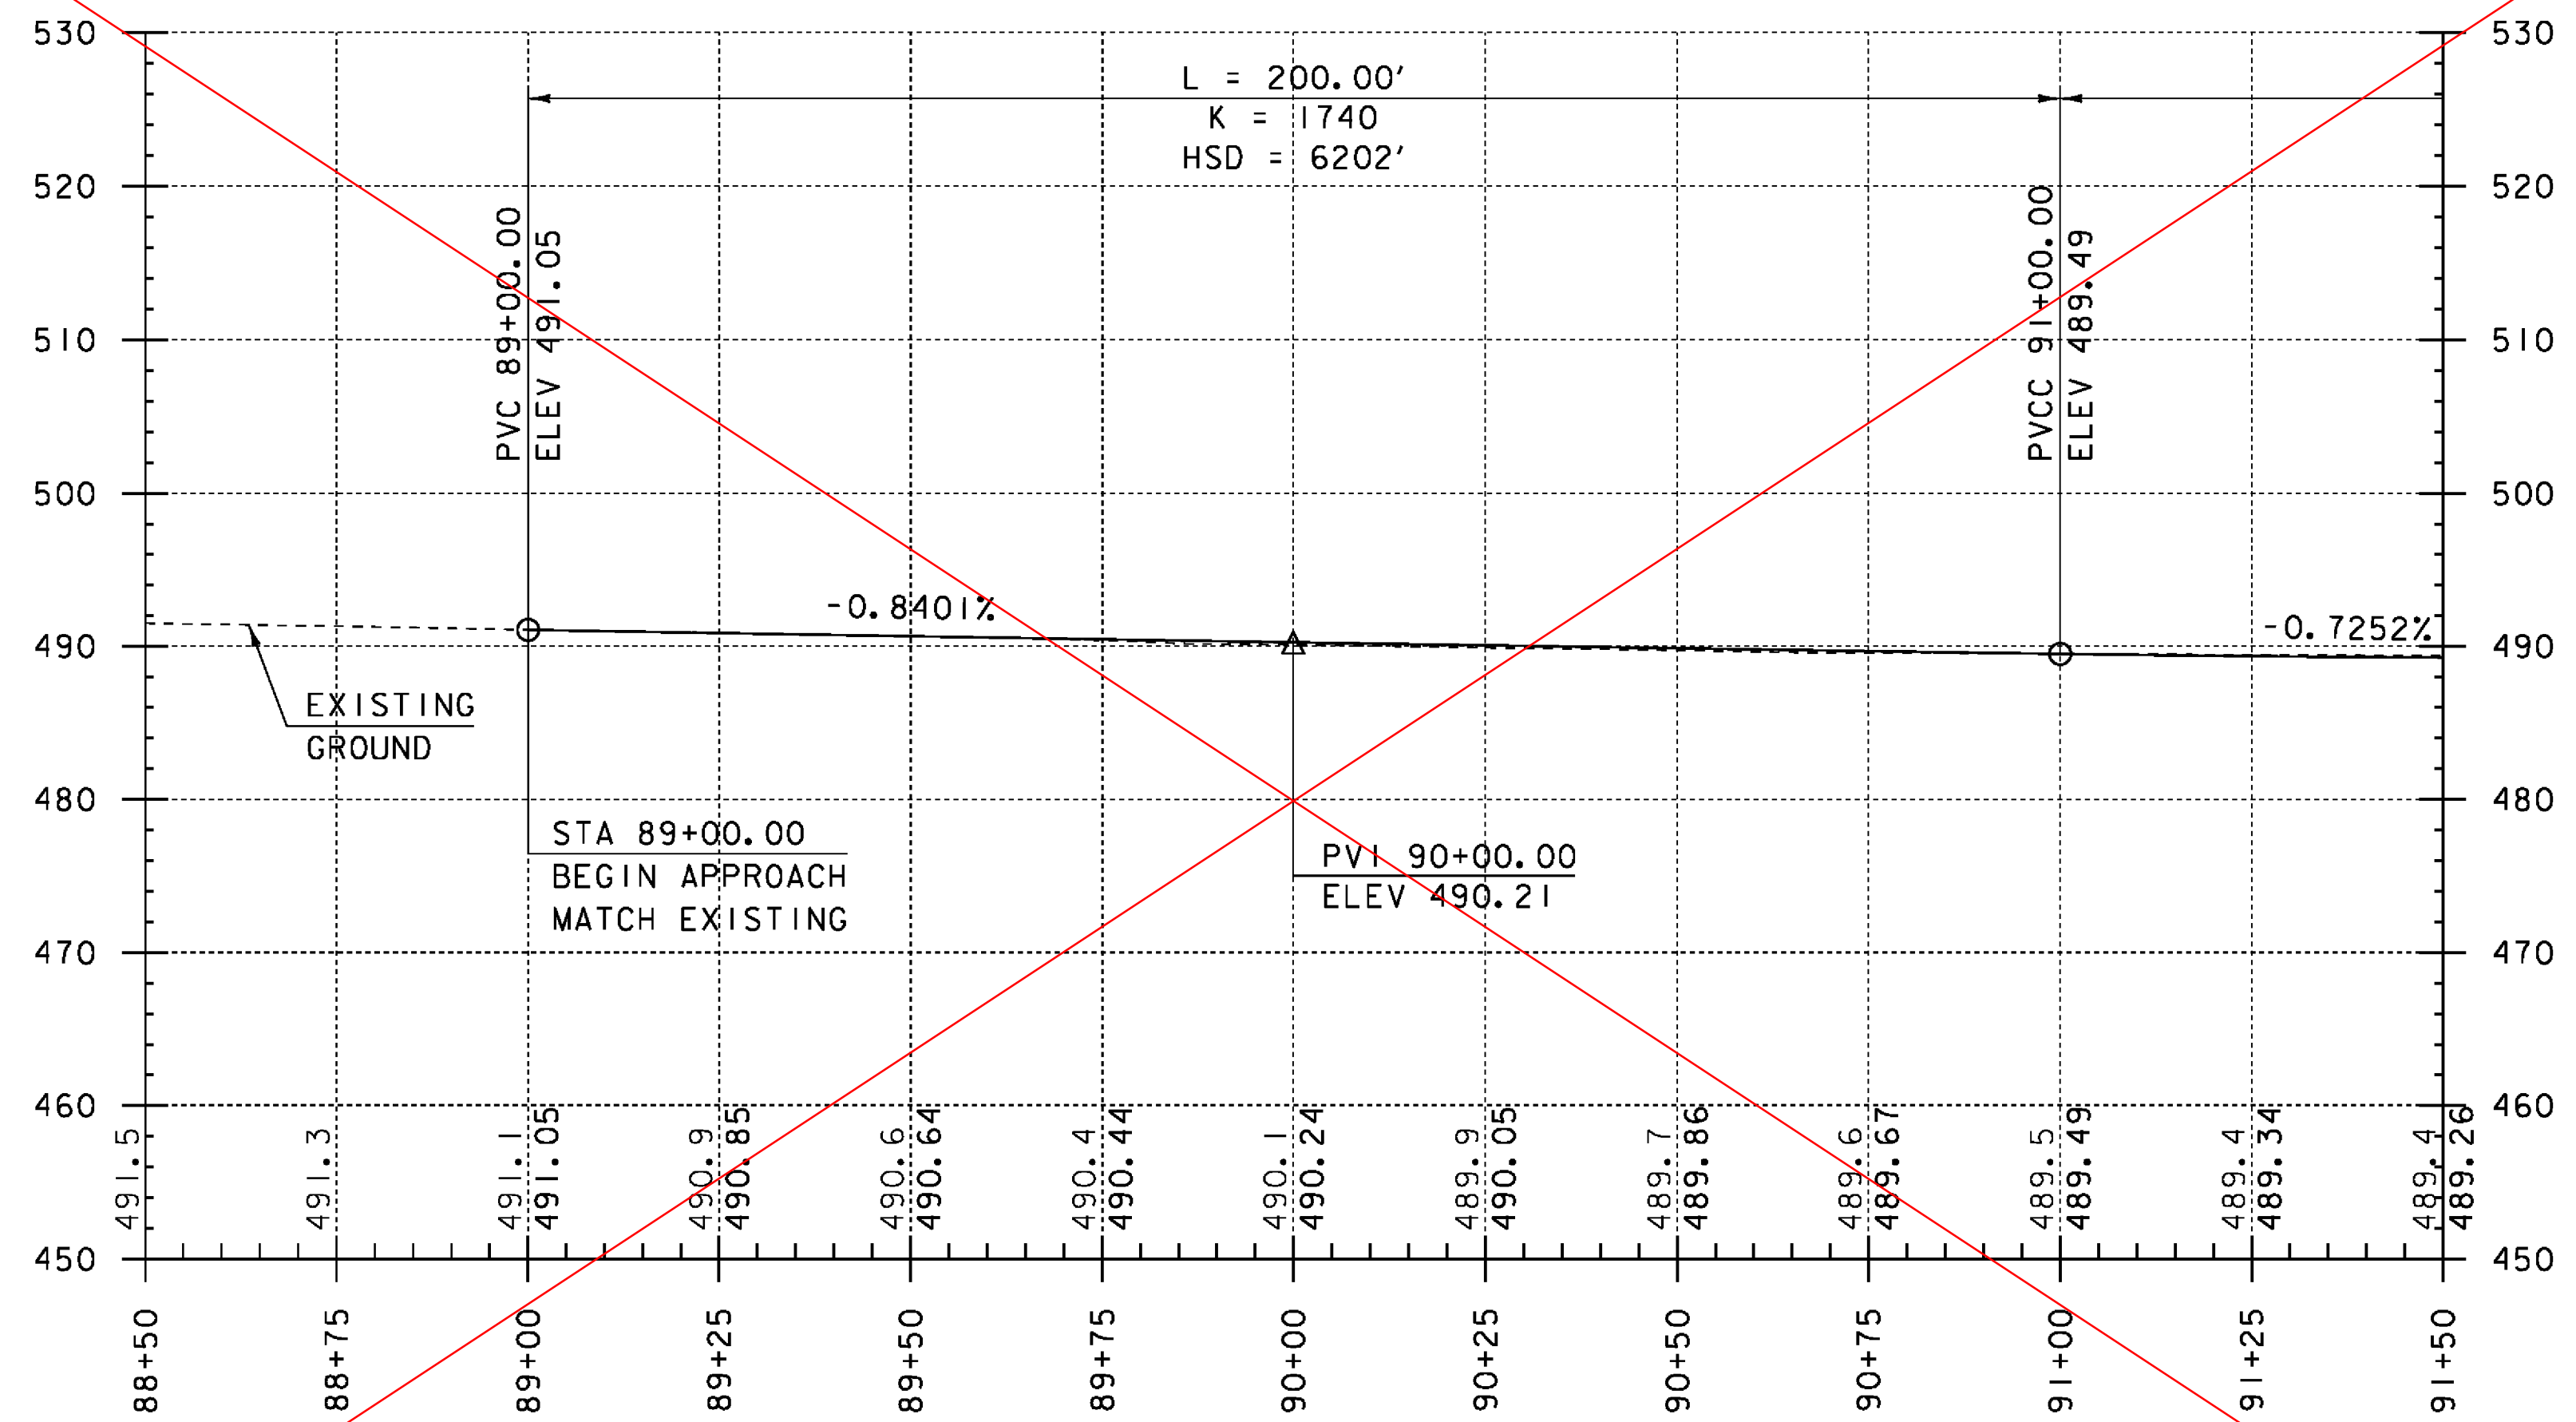

**PROFILE ALONG VT 15**

HORIZONTAL SCALE: 1" = 20'-0"  
 VERTICAL SCALE: 1" = 10'-0"

**NOTE:**


ELEVATIONS SHOWN TO THE NEAREST TENTH ARE EXISTING GROUND ALONG PROPOSED CENTERLINE.

ELEVATIONS SHOWN TO THE NEAREST HUNDREDTH ARE FINISH GRADES ALONG PROPOSED CENTERLINE.

SEE REVISION: OCT-28-2014

PROJECT NAME: JOHNSON  
 PROJECT NUMBER: BRF 030-2(26)

FILE NAME: s88bi93pro.dgn	PLOT DATE: 10-JUN-2014
PROJECT LEADER: C. CARLSON	DRAWN BY: G. ROY
DESIGNED BY: H. SALLS	CHECKED BY: H. SALLS
VT 15 PROFILE (I)	SHEET 15 OF 69

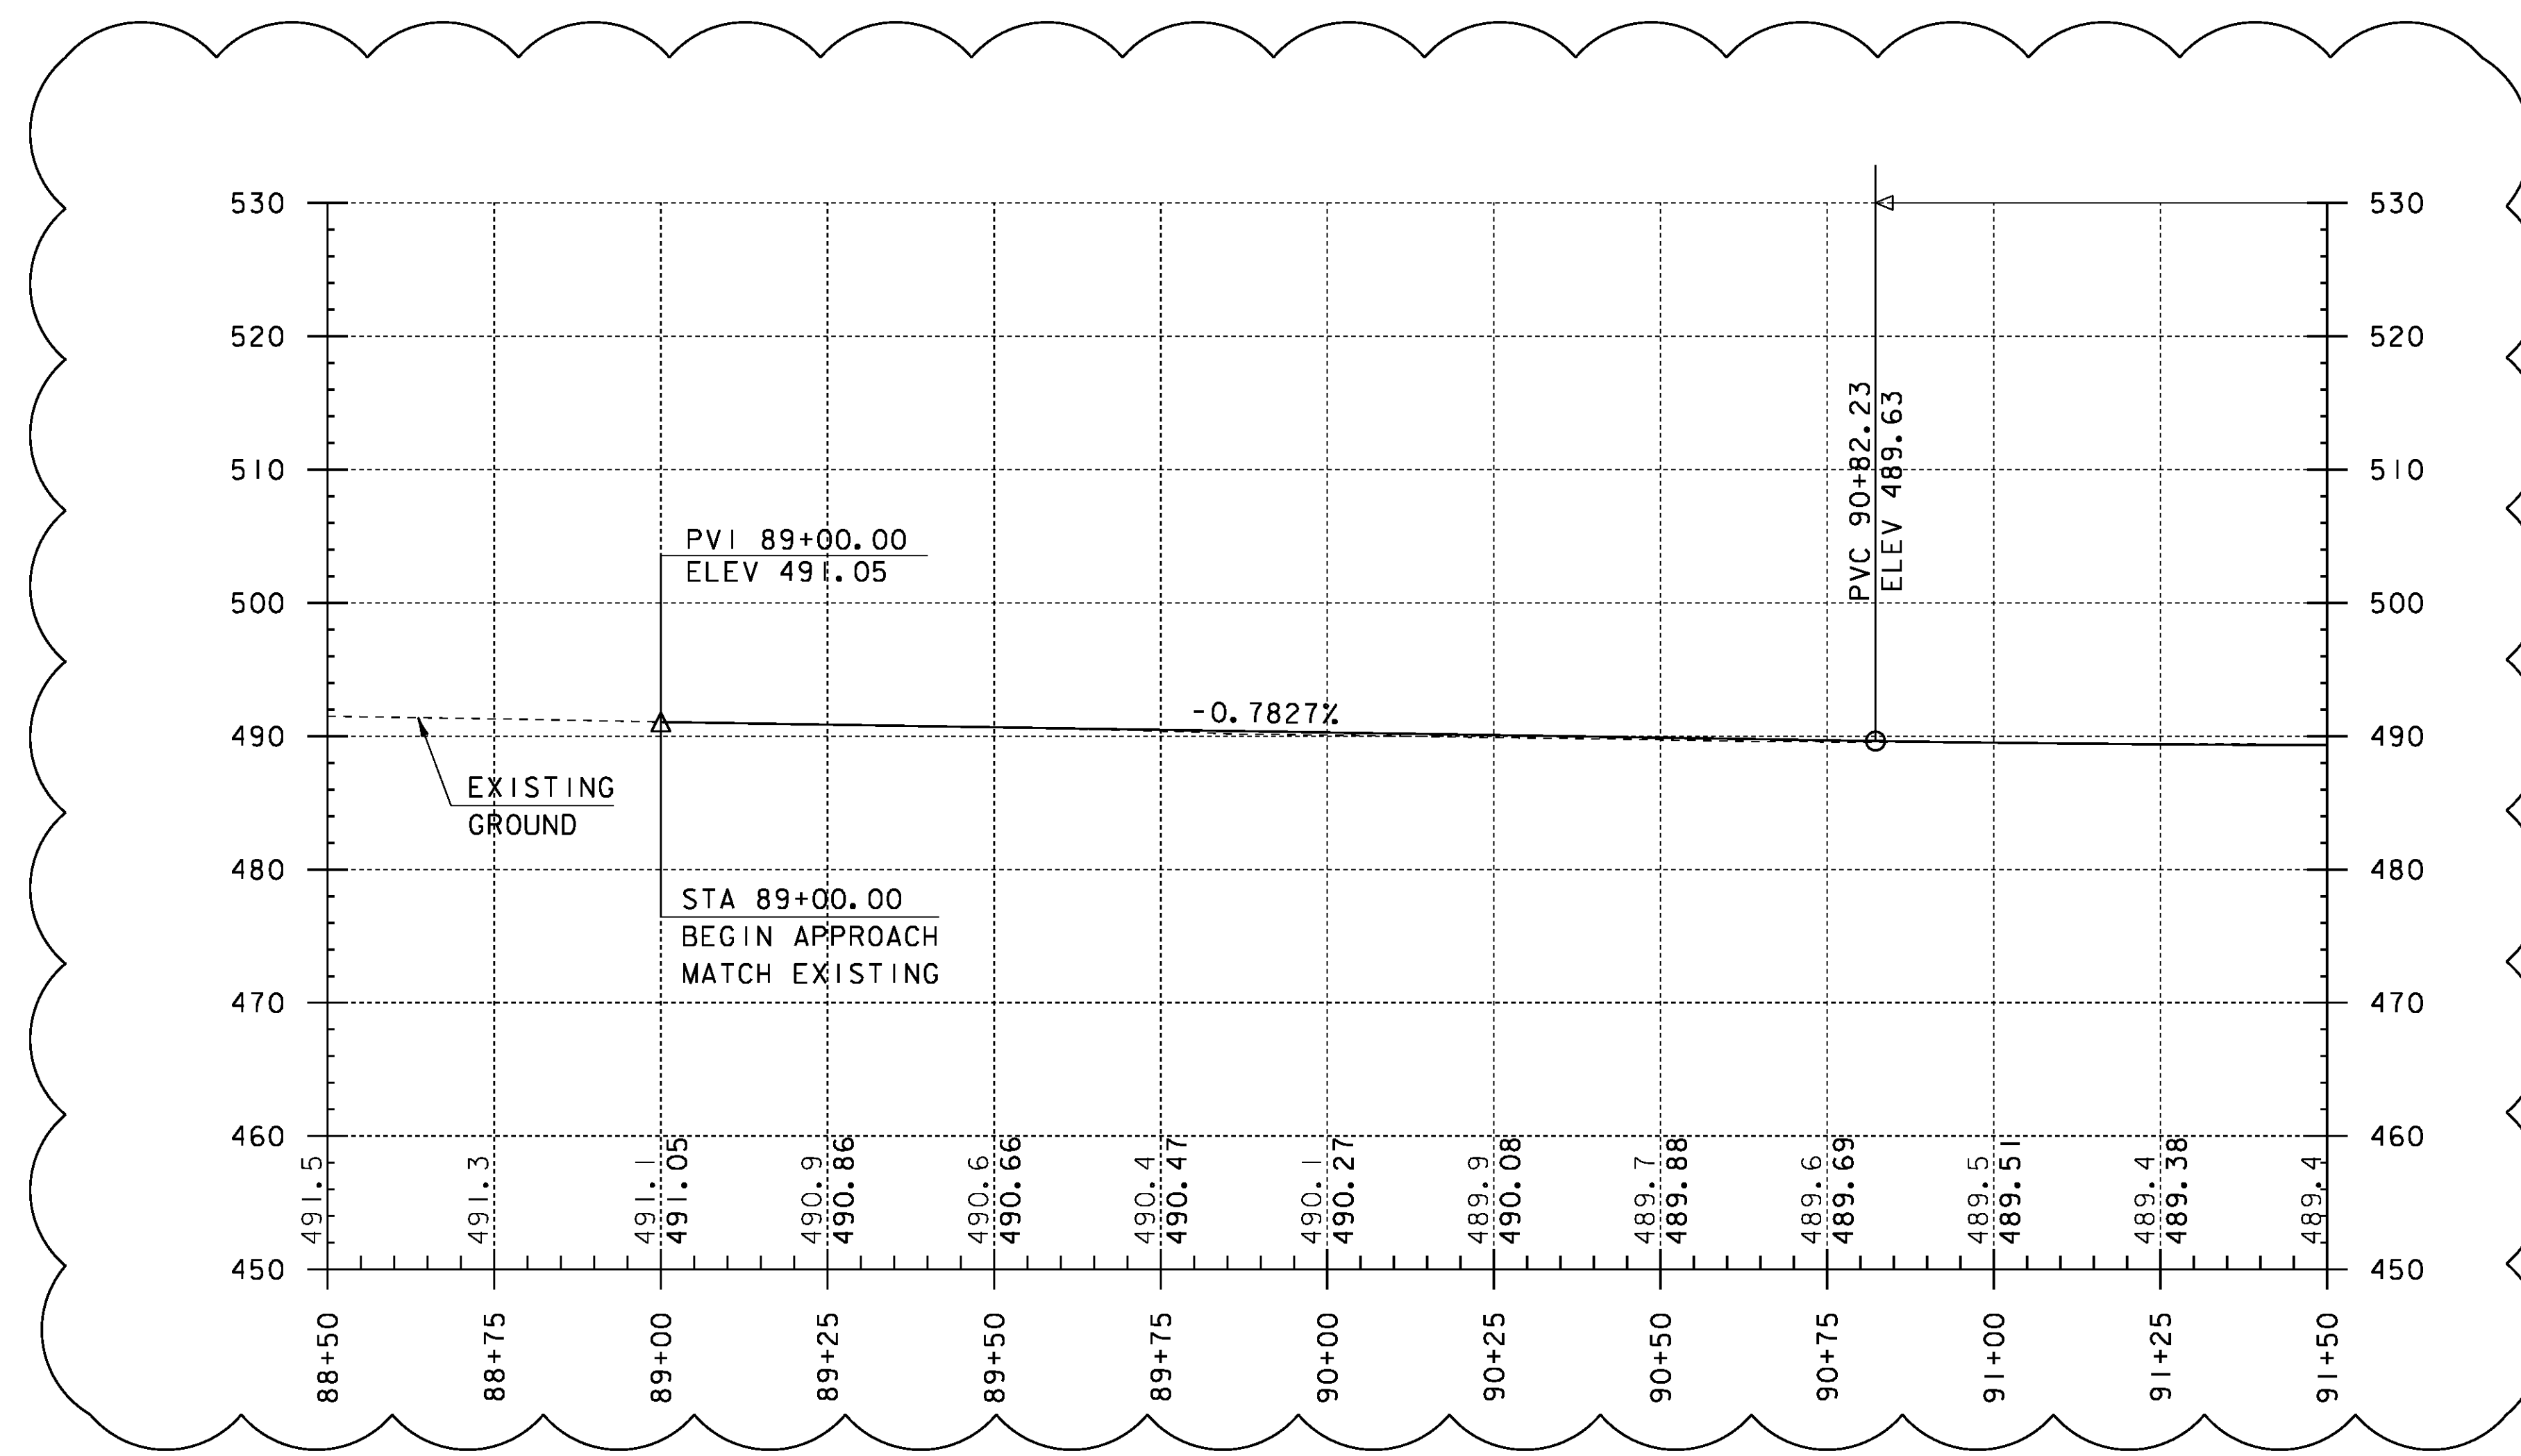

**PROFILE ALONG VT 15**


HORIZONTAL SCALE: 1" = 20'-0"  
 VERTICAL SCALE: 1" = 10'-0"

**NOTE:**

ELEVATIONS SHOWN TO THE NEAREST TENTH ARE EXISTING GROUND ALONG PROPOSED CENTERLINE.

ELEVATIONS SHOWN TO THE NEAREST HUNDREDTH ARE FINISH GRADES ALONG PROPOSED CENTERLINE.

PROJECT NAME: JOHNSON	PLOT DATE: 16-JUN-2015
PROJECT NUMBER: BRF 030-2(26)	DRAWN BY: G. ROY
FILE NAME: s88bl93pro.dgn	CHECKED BY: H. SALLS
PROJECT LEADER: C. CARLSON	SHEET 15 OF 69
DESIGNED BY: H. SALLS	
VT 15 PROFILE (I)	

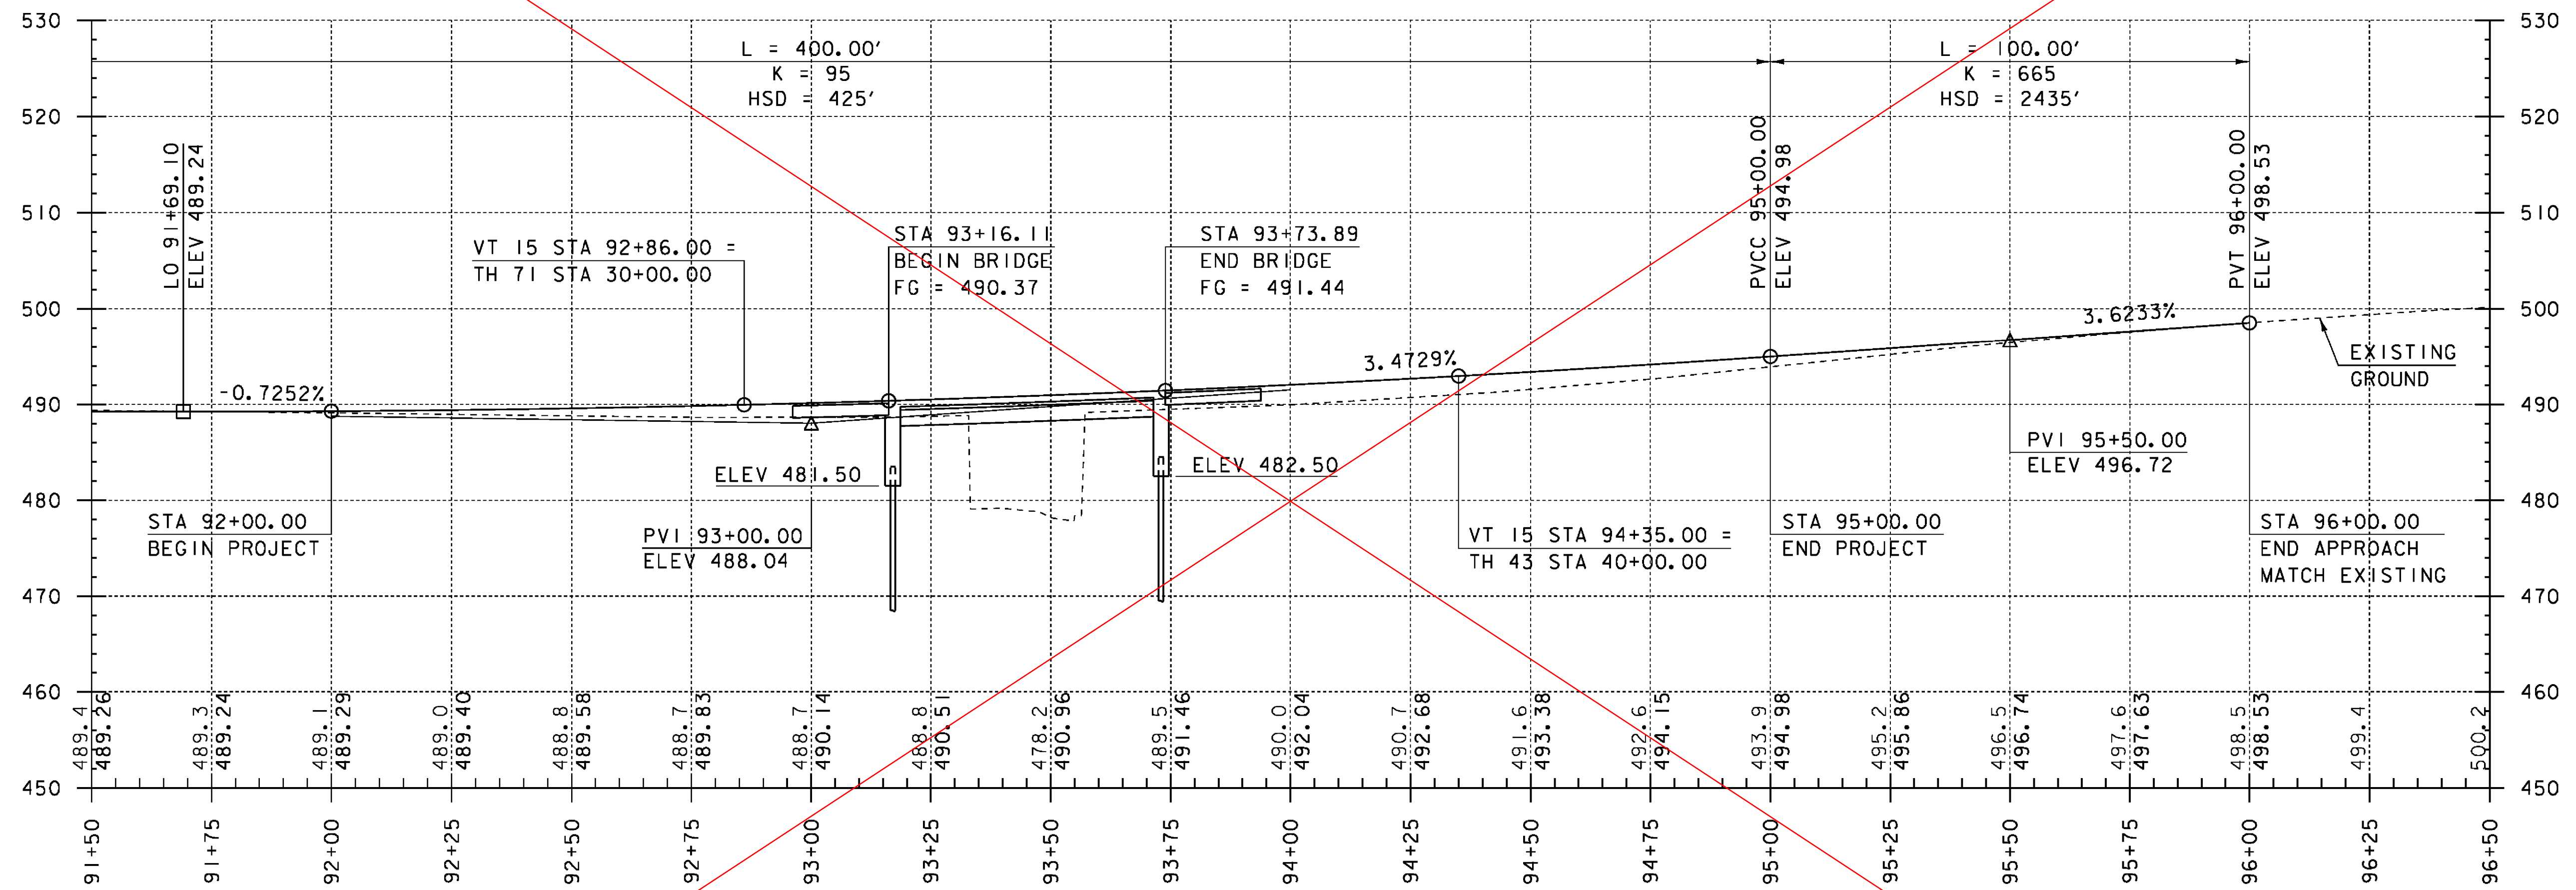

**PROFILE ALONG VT 15**

HORIZONTAL SCALE: 1" = 20'-0"  
 VERTICAL SCALE: 1" = 10'-0"

**NOTE:**

ELEVATIONS SHOWN TO THE NEAREST TENTH ARE EXISTING GROUND ALONG PROPOSED CENTERLINE.


ELEVATIONS SHOWN TO THE NEAREST HUNDRETH ARE FINISH GRADES ALONG PROPOSED CENTERLINE.

SEE REVISION: OCT-28-2014

PROJECT NAME: JOHNSON  
 PROJECT NUMBER: BRF 030-2(26)

FILE NAME: s88bi93pro.dgn  
 PROJECT LEADER: C. CARLSON  
 DESIGNED BY: H. SALLS  
 VT 15 PROFILE (2)

PLOT DATE: 10-JUN-2014  
 DRAWN BY: G. ROY  
 CHECKED BY: H. SALLS  
 SHEET 16 OF 69

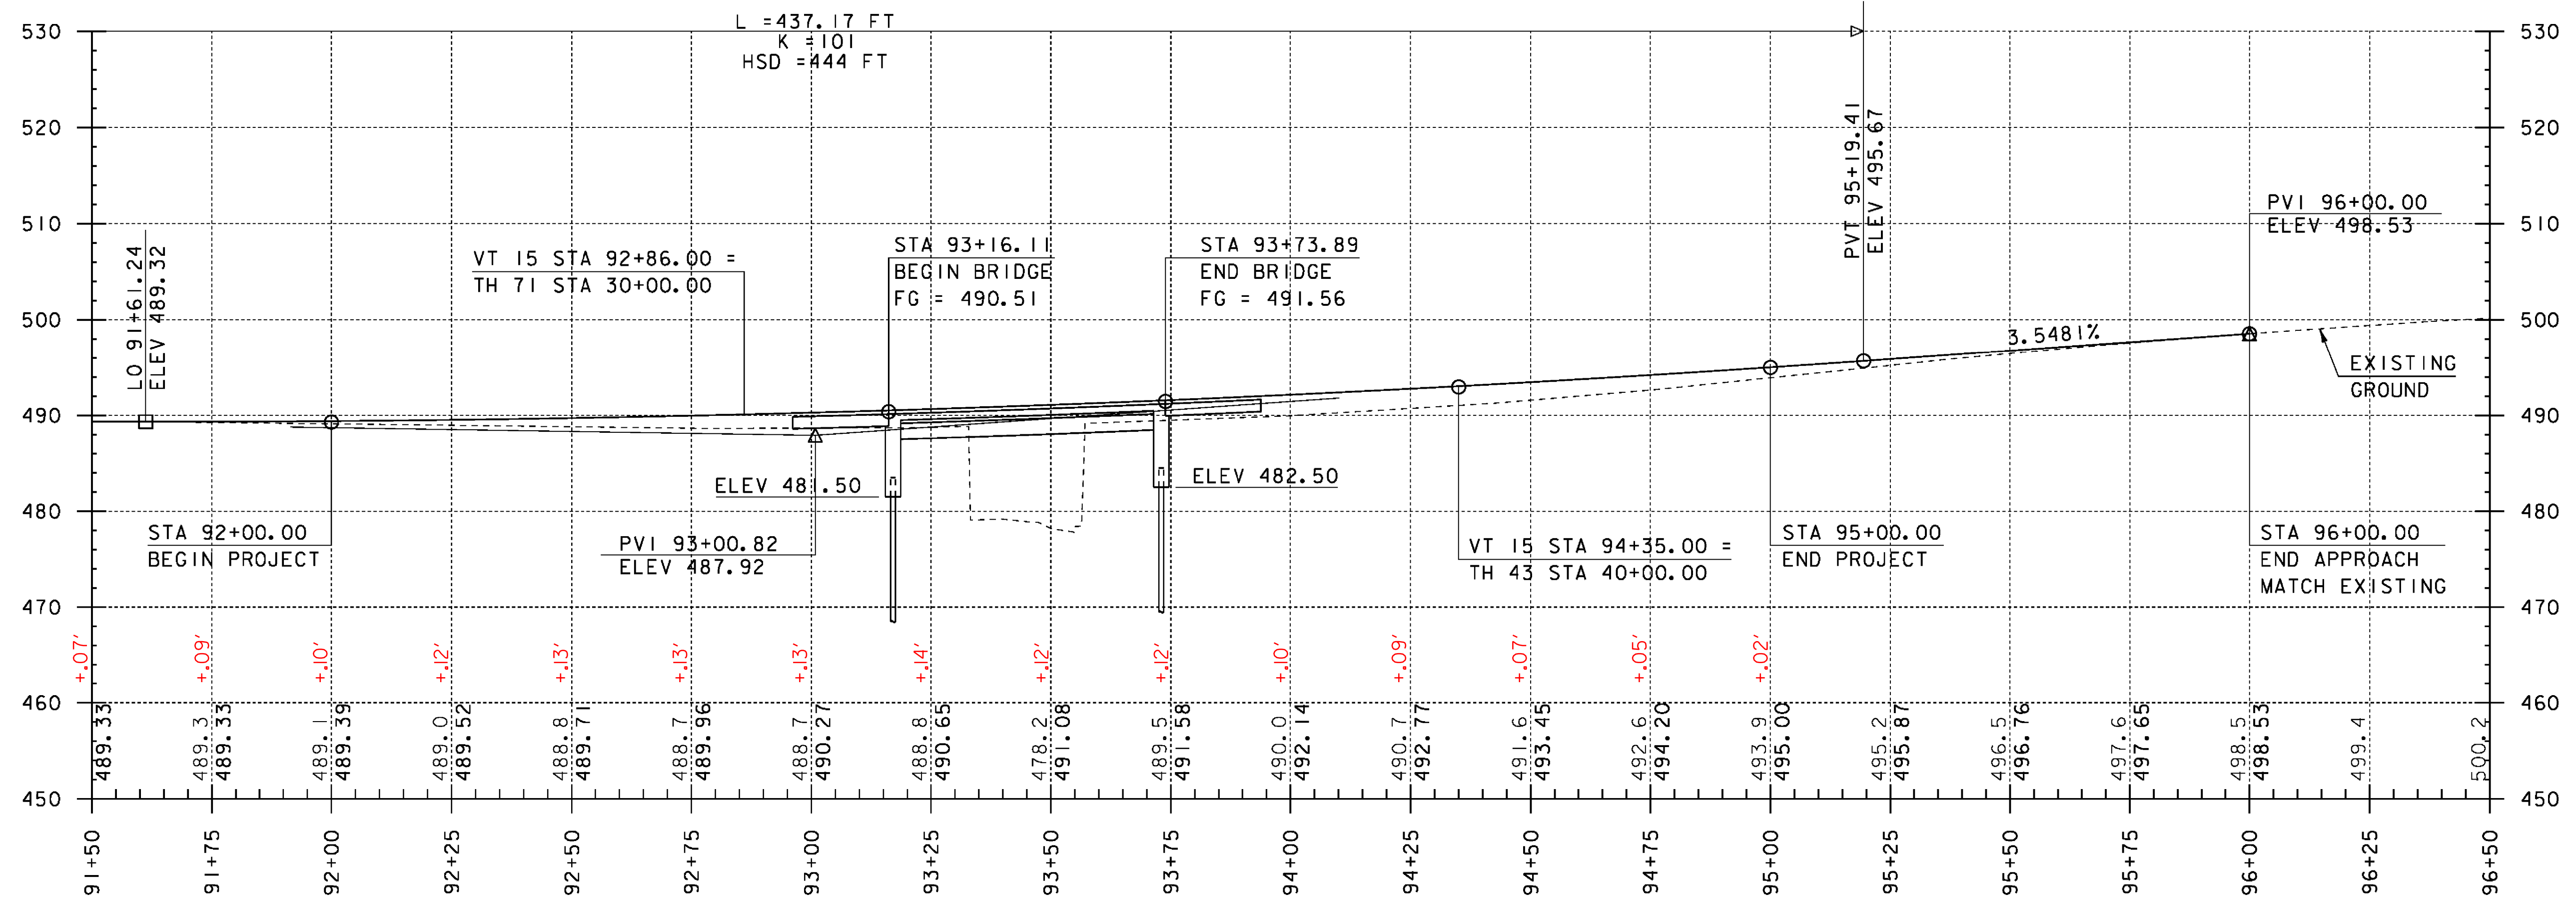

PROFILE ALONG VT 15

HORIZONTAL SCALE: 1" = 20'-0"  
 VERTICAL SCALE: 1" = 10'-0"

* FROM OLD PROFILE

NOTE:

ELEVATIONS SHOWN TO THE NEAREST TENTH ARE EXISTING GROUND ALONG PROPOSED CENTERLINE.


ELEVATIONS SHOWN TO THE NEAREST HUNDRETH ARE FINISH GRADES ALONG PROPOSED CENTERLINE.

PROJECT NAME: JOHNSON  
 PROJECT NUMBER: BRF 030-2(26)

REVISION	DATE	DESCRIPTION	BY
1	06-16-2015	RAISED GRADE 0.13 FT OVER BRIDGE TANGENT REPLACED SAG BOTH ENDS	MCL


FILE NAME: s88bi93pro.dgn  
 PROJECT LEADER: C. CARLSON  
 DESIGNED BY: H. SALLS  
 VT 15 PROFILE (2)

PLOT DATE: 16-JUN-2015  
 DRAWN BY: G. ROY  
 CHECKED BY: H. SALLS  
 SHEET 16 OF 69

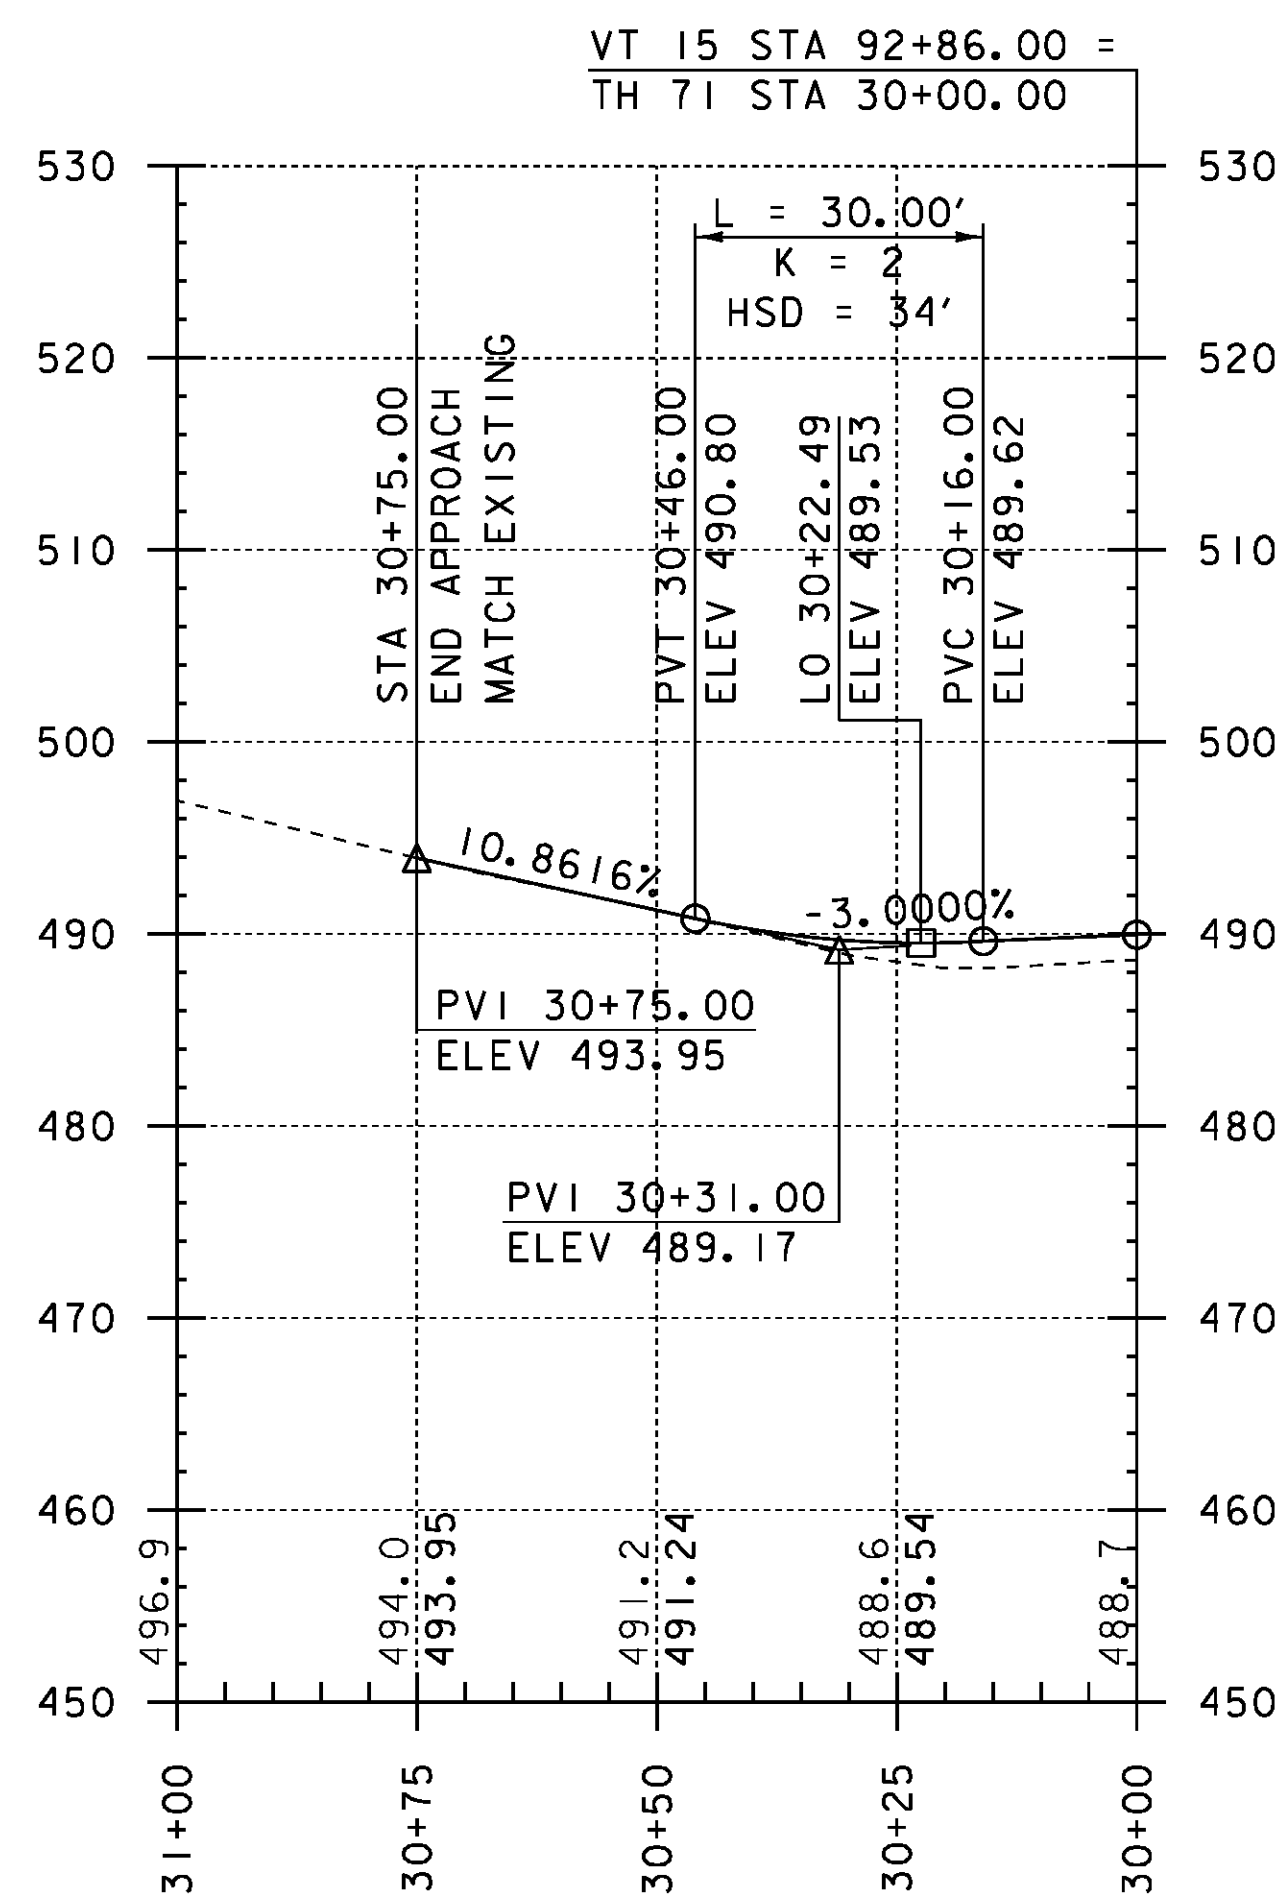


**PROFILE ALONG TH 71**

HORIZONTAL SCALE: 1" = 20'-0"  
 VERTICAL SCALE: 1" = 10'-0"

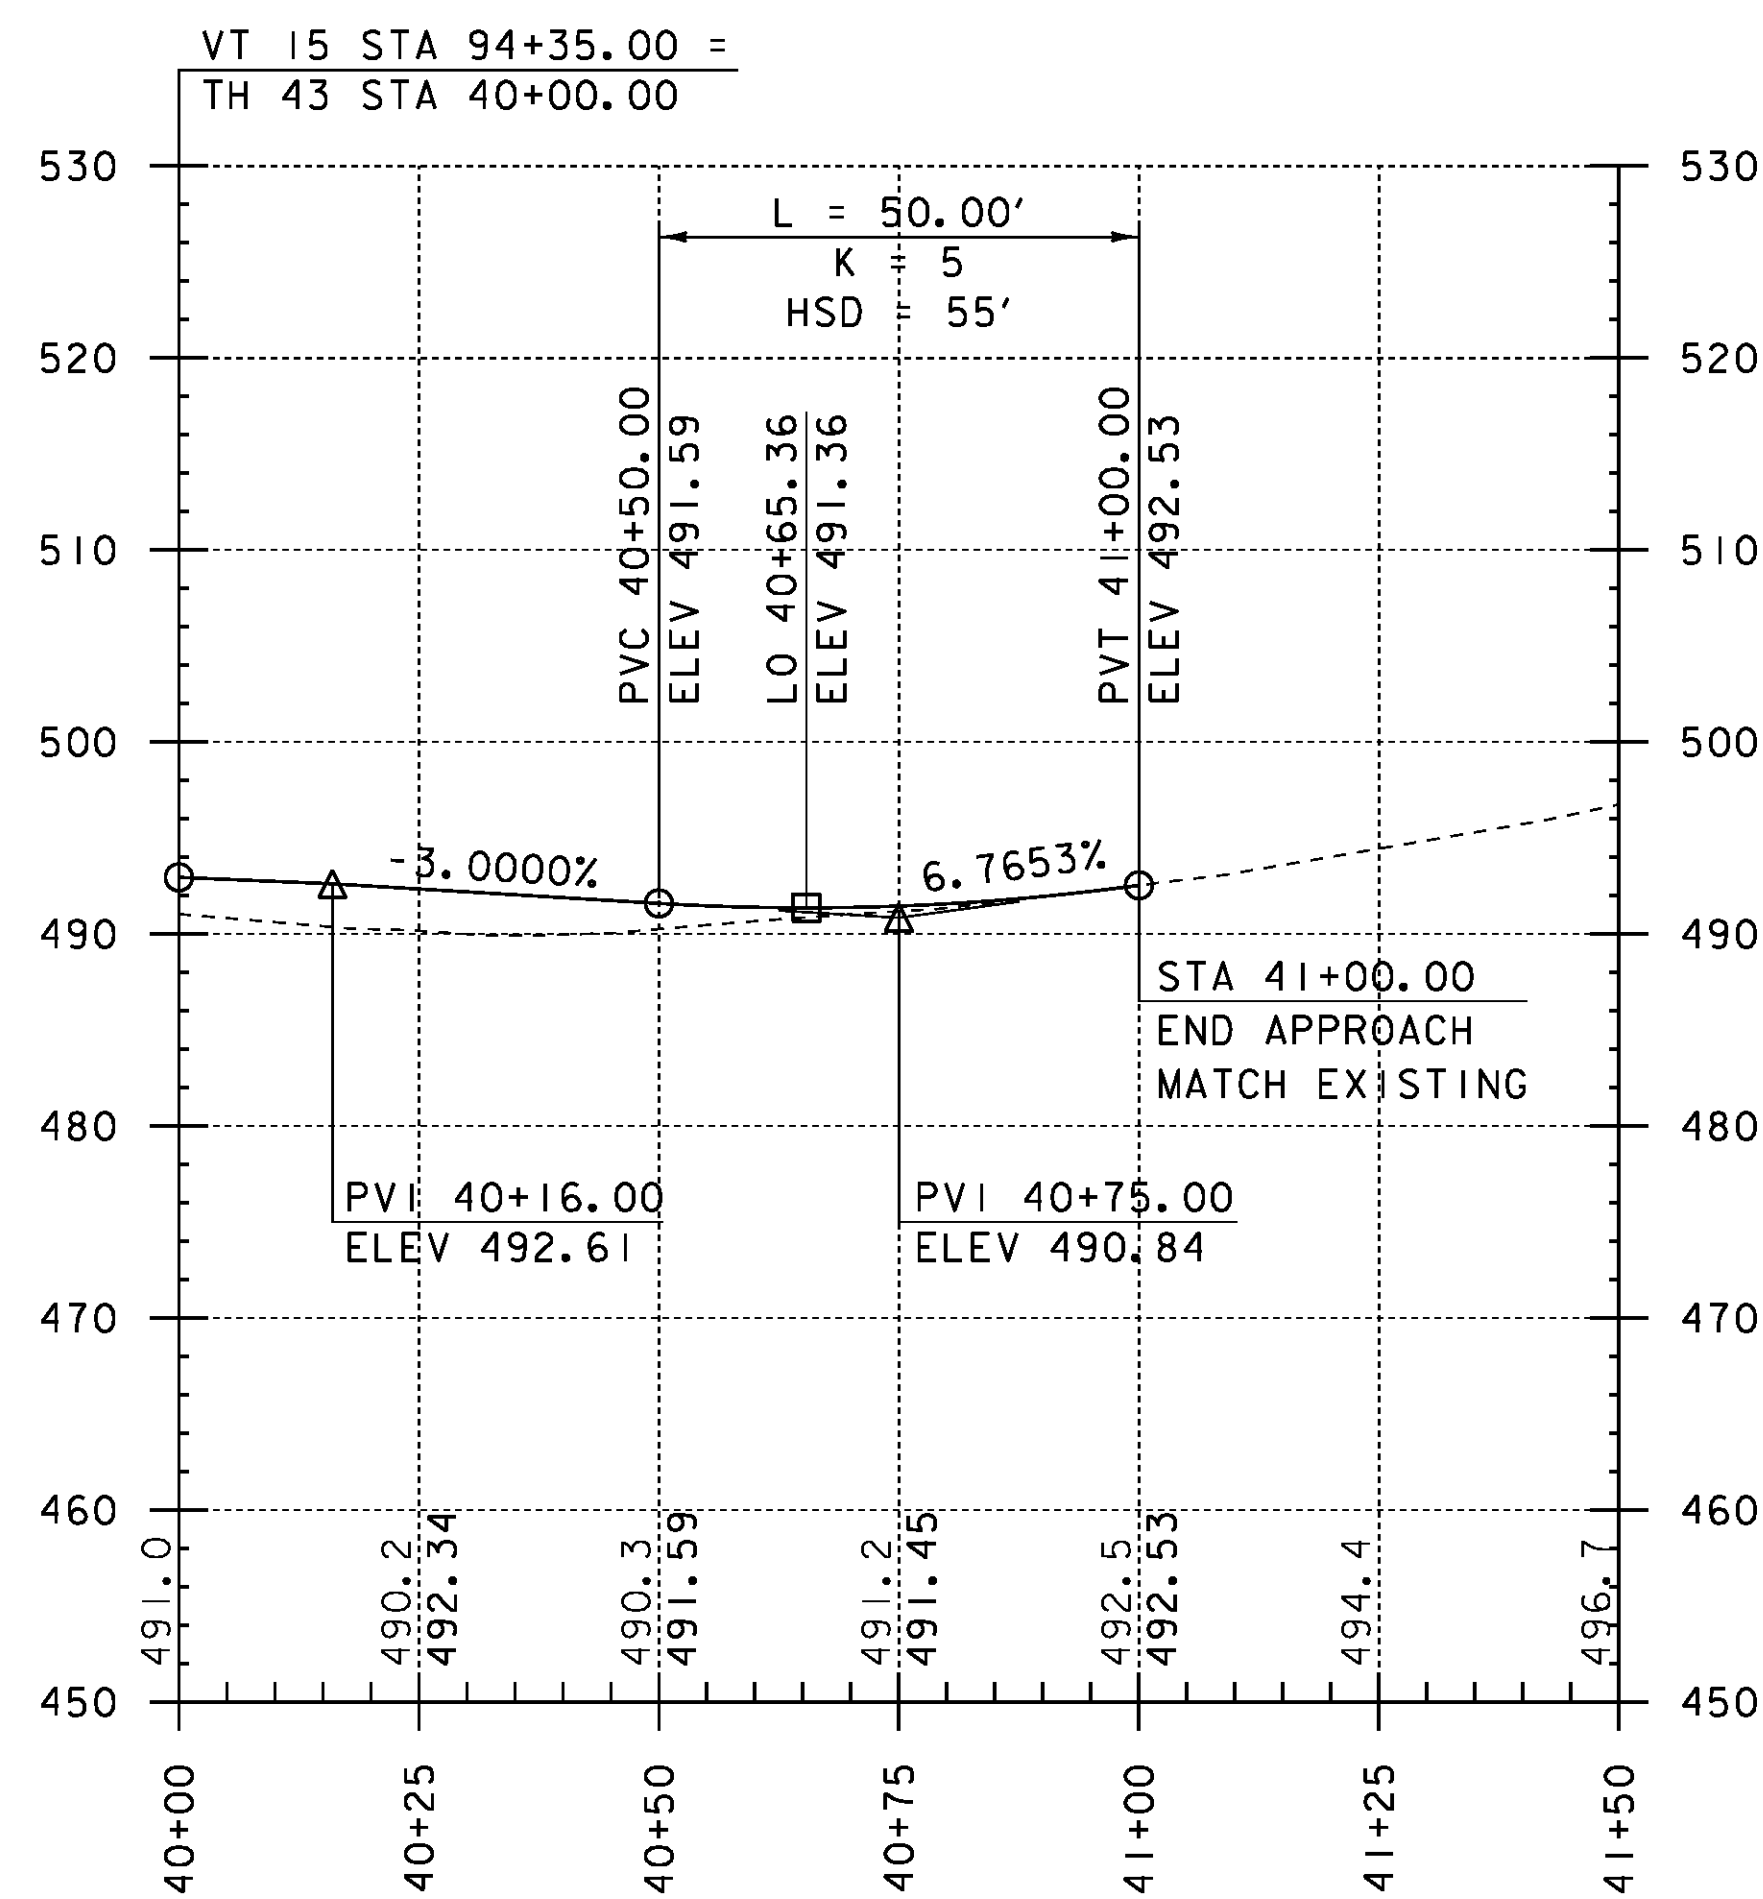

**PROFILE ALONG TH 43**


HORIZONTAL SCALE: 1" = 20'-0"  
 VERTICAL SCALE: 1" = 10'-0"

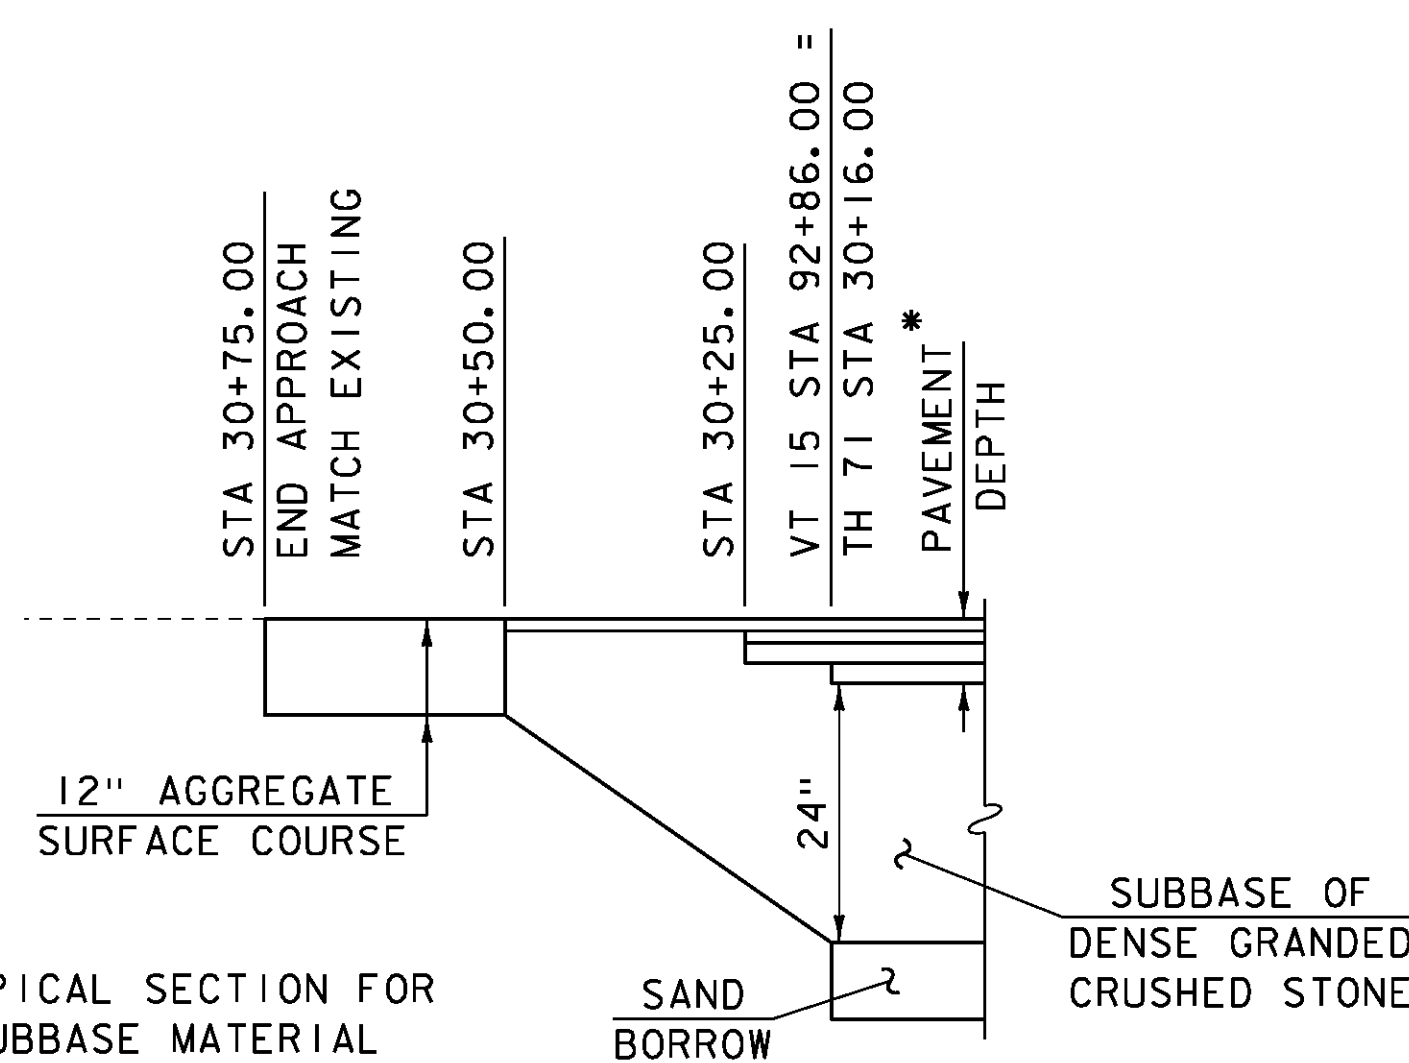

*SEE ROADWAY TYPICAL SECTION FOR PAVEMENT AND SUBBASE MATERIAL DESIGN INFORMATION.

**TH 71 MATERIAL TRANSITION**

HORIZONTAL SCALE: 1" = 20'-0"  
 VERTICAL SCALE: 1" = 2'-0"

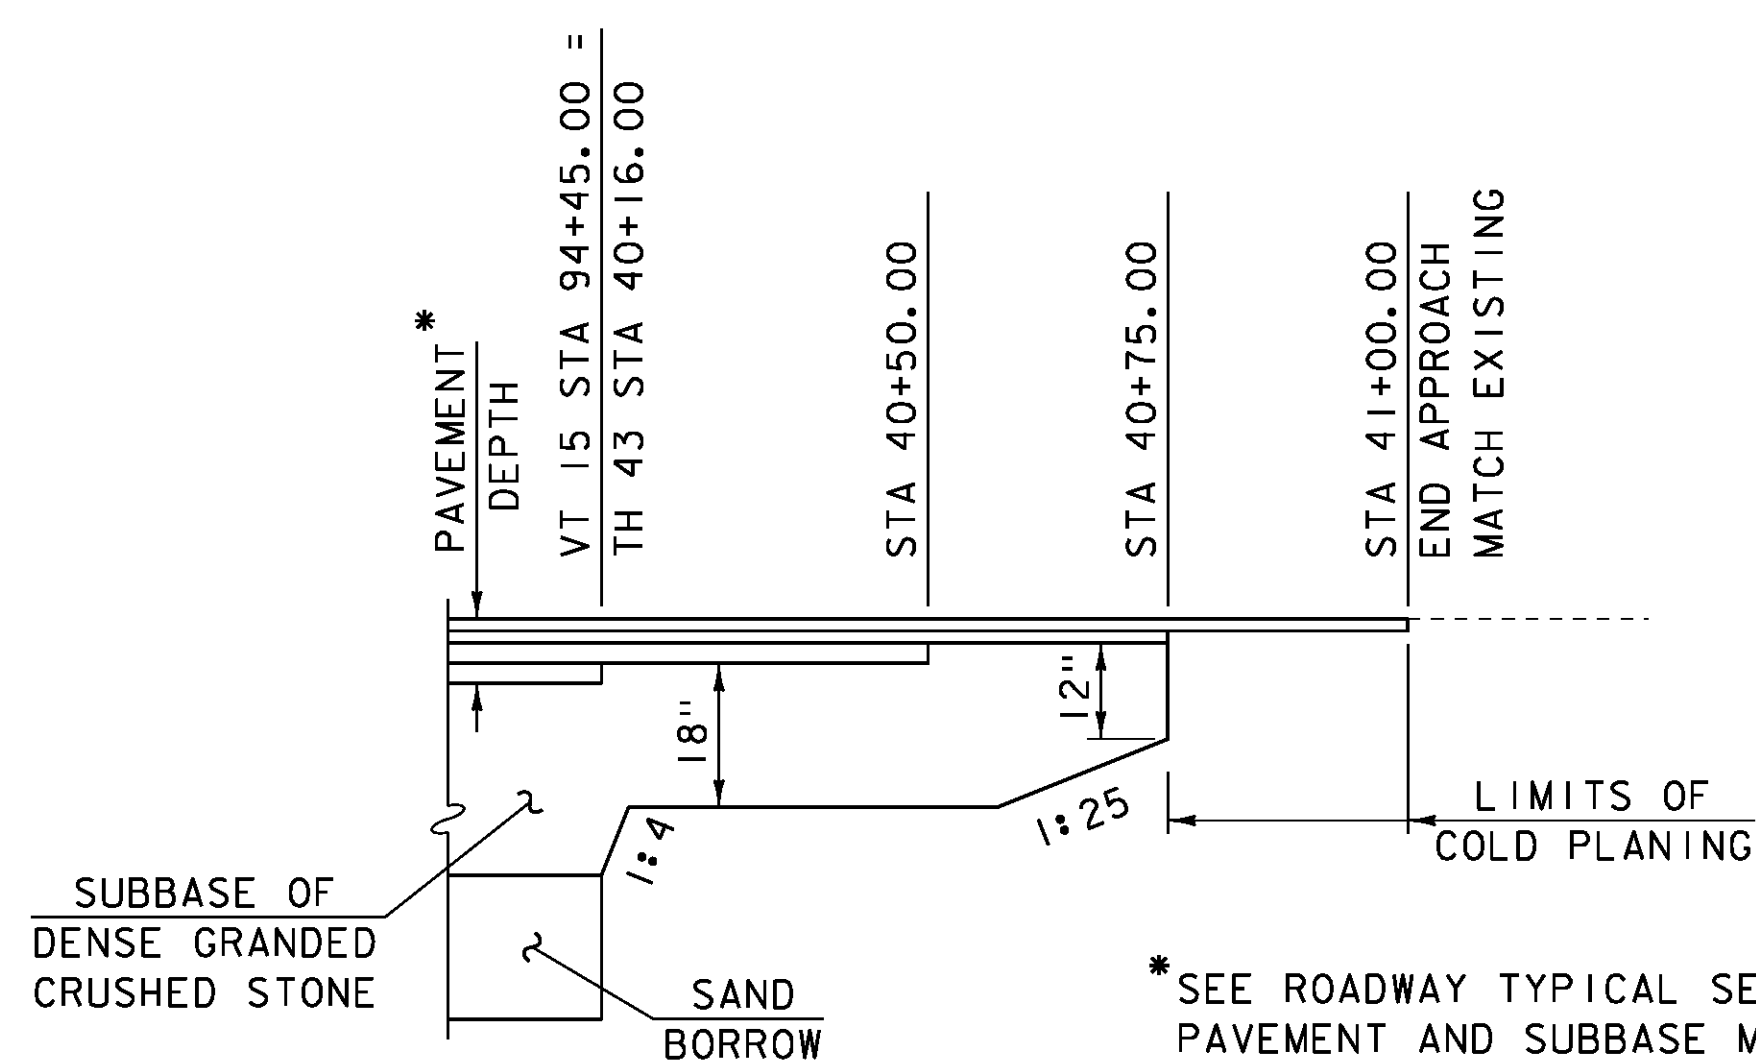


*SEE ROADWAY TYPICAL SECTION FOR PAVEMENT AND SUBBASE MATERIAL DESIGN INFORMATION.

**TH 43 MATERIAL TRANSITION**

HORIZONTAL SCALE: 1" = 20'-0"  
 VERTICAL SCALE: 1" = 2'-0"

PROJECT NAME: JOHNSON  
 PROJECT NUMBER: BRF 030-2(26)

FILE NAME: s88bl93pro.dgn PLOT DATE: 10-JUN-2014  
 PROJECT LEADER: C. CARLSON DRAWN BY: G. ROY  
 DESIGNED BY: H. SALLS CHECKED BY: H. SALLS  
 TH 71 AND TH 43 PROFILES AND MATERIAL TRANSITIONS SHEET 17 OF 69

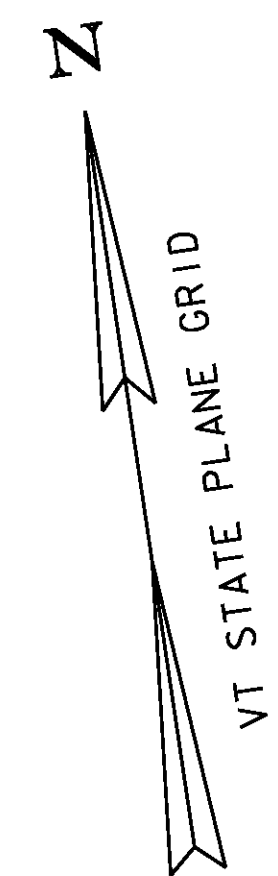

EXISTING ROW

APPROXIMATE RELOCATION OF AERIAL UTILITY FACILITIES OWNED BY COMCAST (TO BE DONE BY OTHERS)

APPROXIMATE LOCATION OF EXISTING AERIAL FACILITIES OWNED BY COMCAST & VERMONT ELECTRIC COOPERATIVE, INC. (NOTE: VERMONT ELECTRIC COOPERATIVE, INC. WILL REMOVE THE SINGLE PHASE POWER LINE AND NEUTRAL LINE DURING CONSTRUCTION AND REATTACH AFTER CONSTRUCTION)

APPROXIMATE RELOCATION OF AERIAL UTILITY FACILITIES OWNED BY TELEPHONE OPERATING COMPANY OF VERMONT, L.L.C. AND COMCAST


APPROXIMATE LOCATION OF AERIAL UTILITY FACILITIES OWNED BY TELEPHONE OPERATING COMPANY OF VERMONT, L.L.C. AND COMCAST

EXISTING ROW

MATCHLINE


STA 92+00.00


VT 15 TO CAMBRIDGE

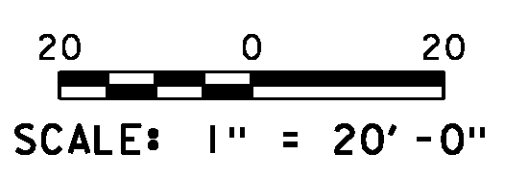

NOTE: SEE THE UTILITY SPECIAL PROVISIONS FOR ADDITIONAL INFORMATION AND REQUIREMENTS.

PROJECT NAME:	JOHNSON	PLOT DATE:	10-JUN-2014
PROJECT NUMBER:	BRF 030-2(26)	DRAWN BY:	G. ROY
FILE NAME:	s88b193bdr_util.dgn	CHECKED BY:	H. SALLS
PROJECT LEADER:	C. CARLSON	UTILITY LAYOUT (I)	SHEET 18 OF 69
DESIGNED BY:	G. ROY		

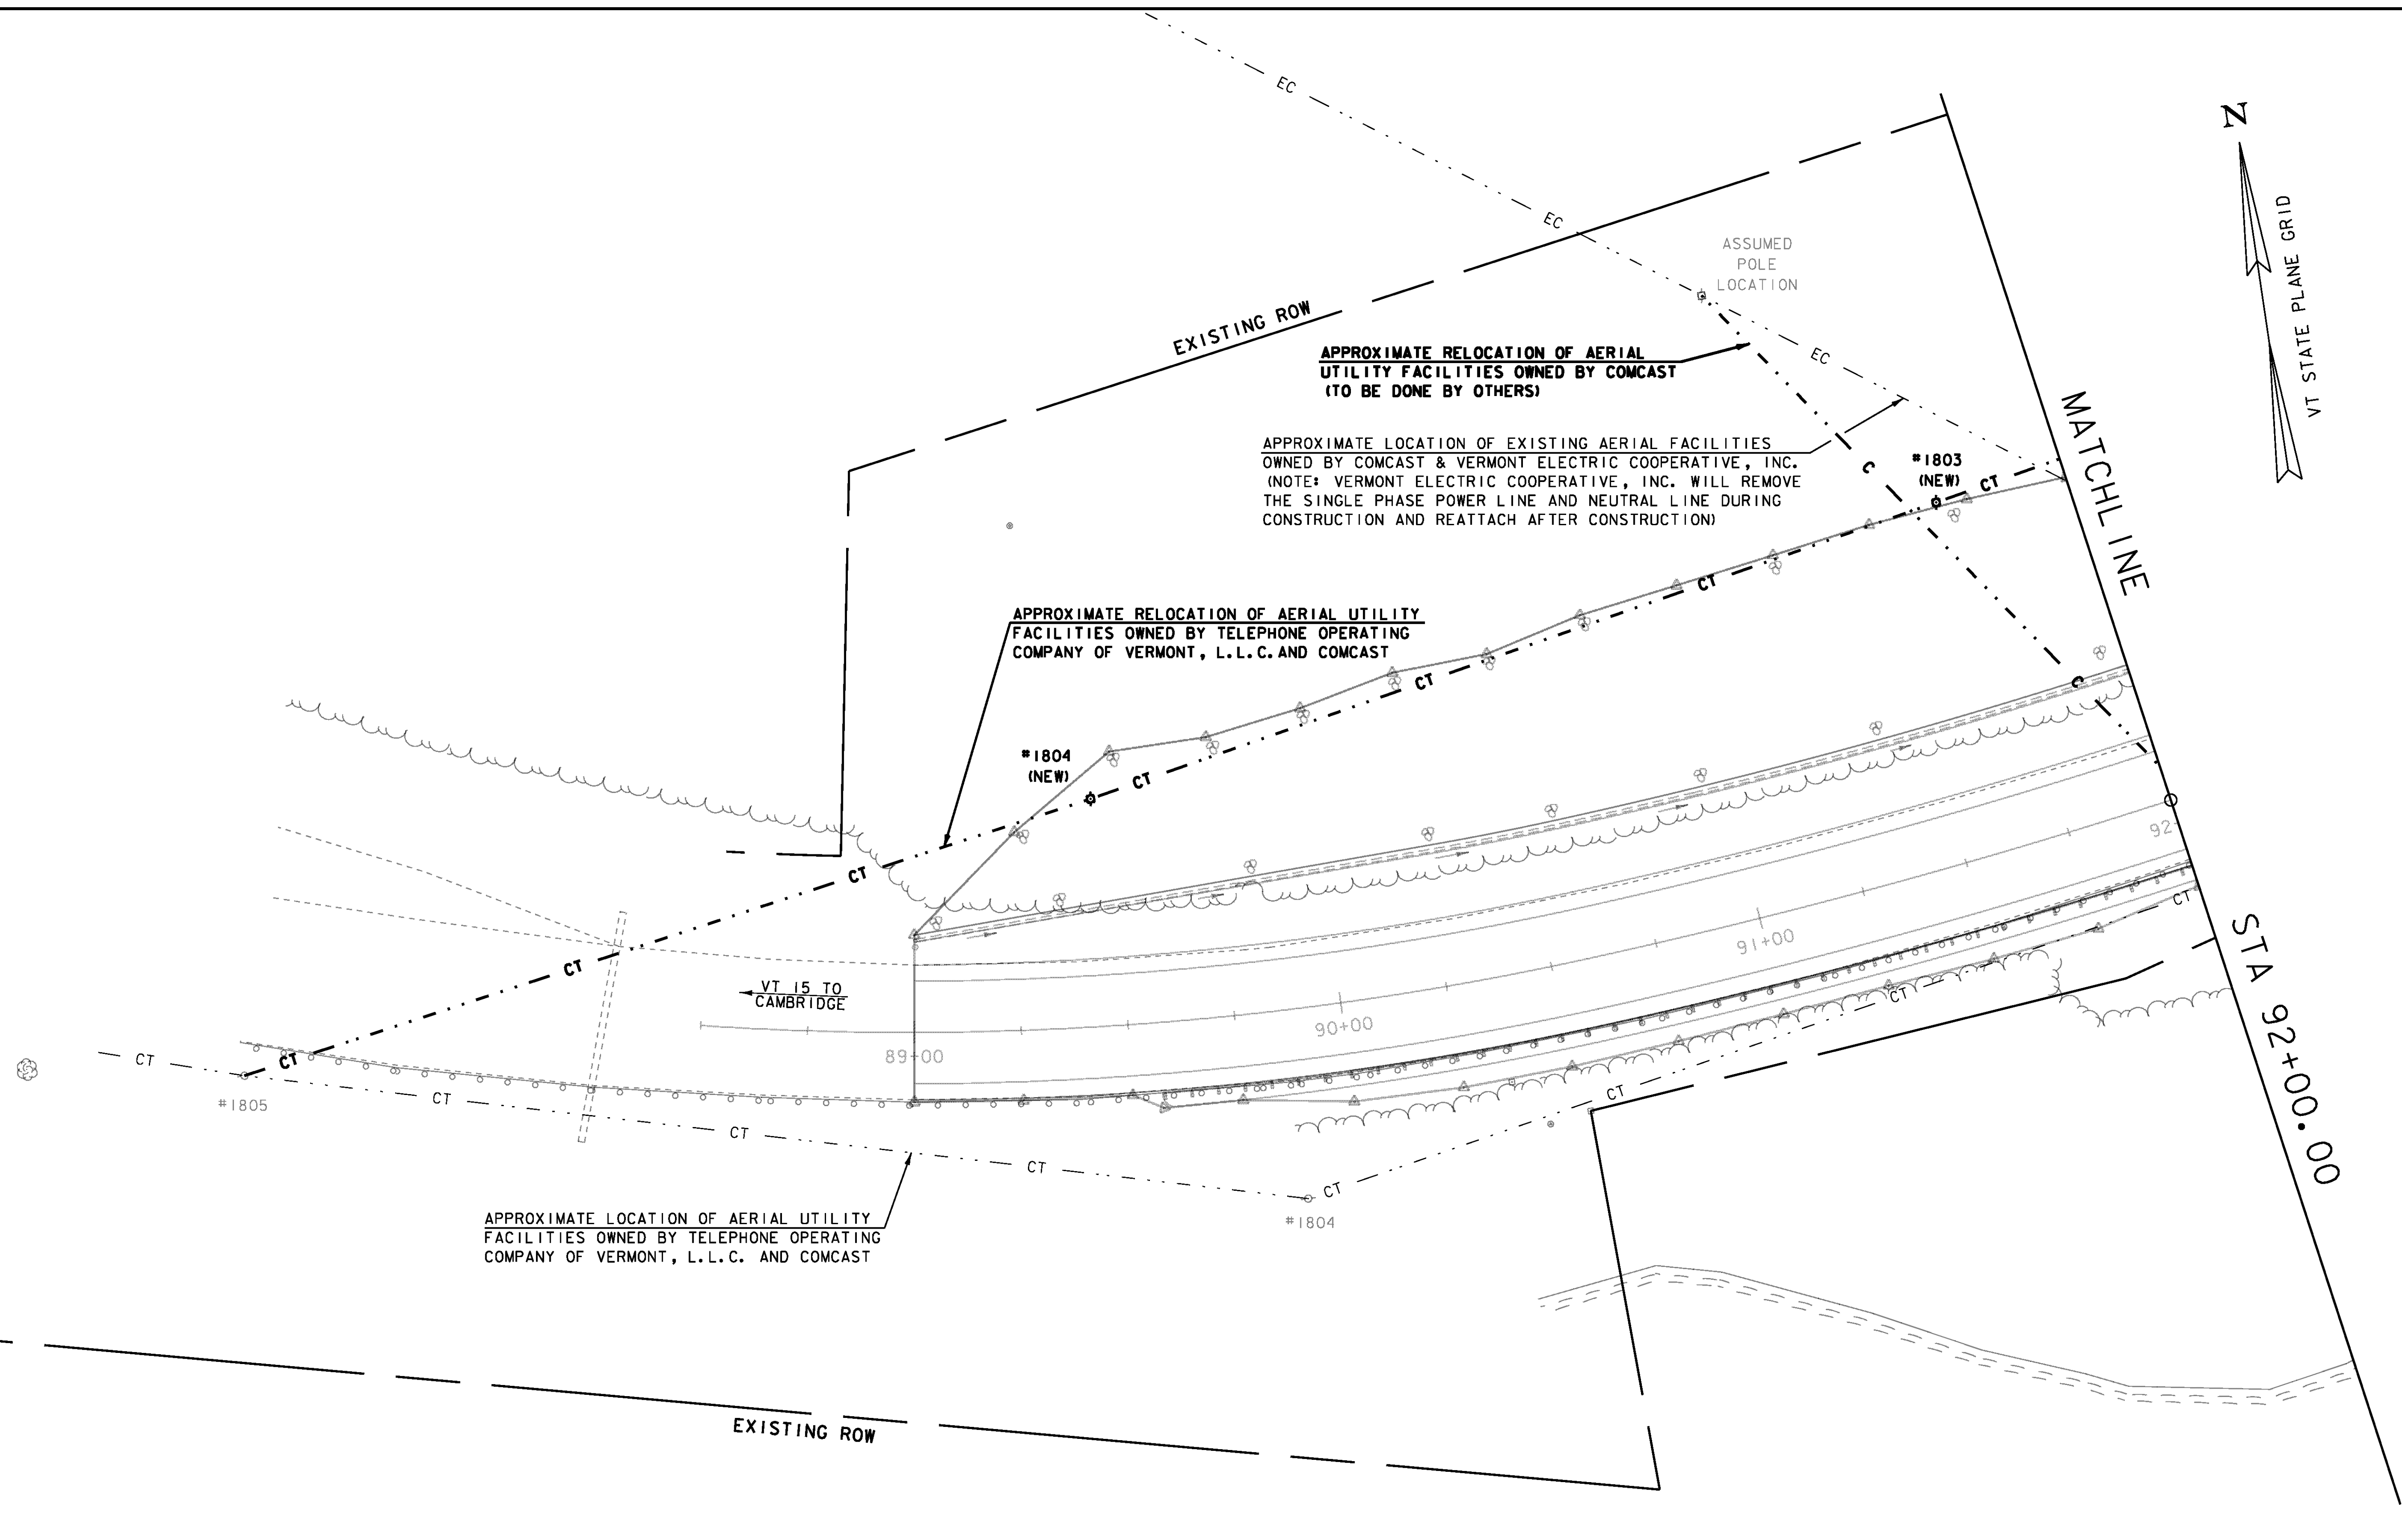

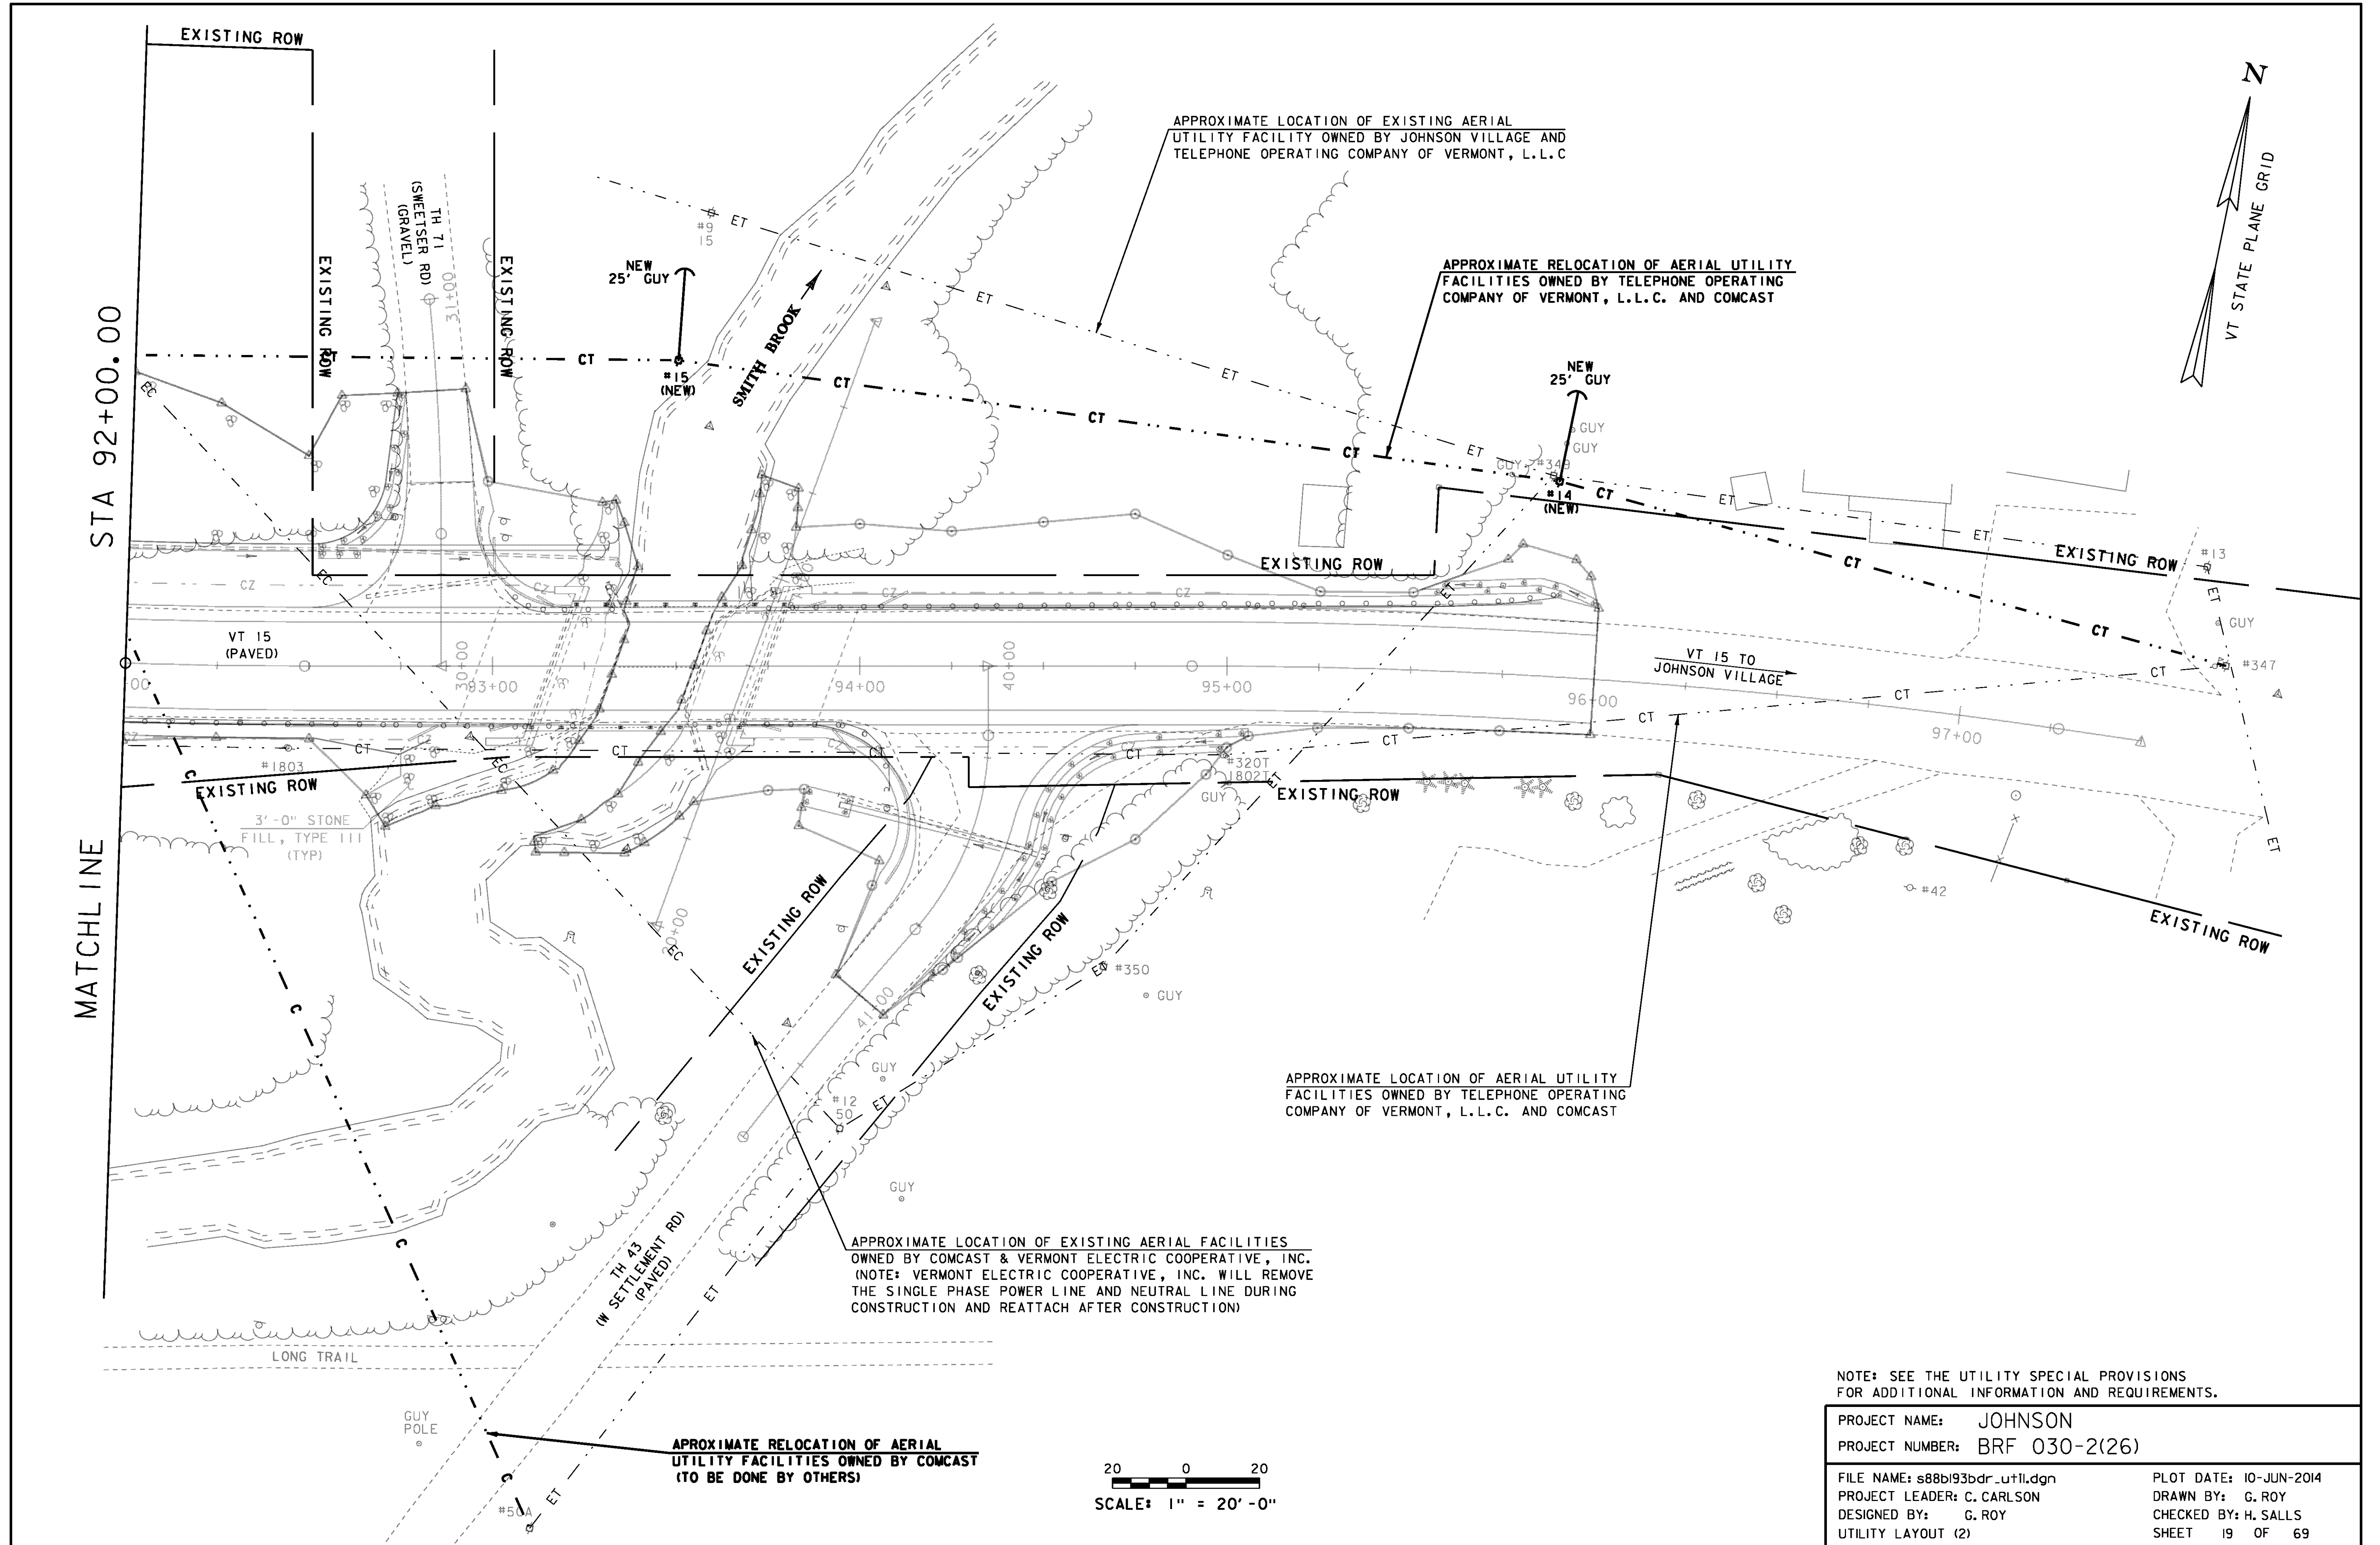



APPROXIMATE LOCATION OF EXISTING AERIAL UTILITY FACILITY OWNED BY JOHNSON VILLAGE AND TELEPHONE OPERATING COMPANY OF VERMONT, L.L.C

APPROXIMATE RELOCATION OF AERIAL UTILITY FACILITIES OWNED BY TELEPHONE OPERATING COMPANY OF VERMONT, L.L.C. AND COMCAST

APPROXIMATE LOCATION OF AERIAL UTILITY FACILITIES OWNED BY TELEPHONE OPERATING COMPANY OF VERMONT, L.L.C. AND COMCAST

APPROXIMATE LOCATION OF EXISTING AERIAL FACILITIES OWNED BY COMCAST & VERMONT ELECTRIC COOPERATIVE, INC. (NOTE: VERMONT ELECTRIC COOPERATIVE, INC. WILL REMOVE THE SINGLE PHASE POWER LINE AND NEUTRAL LINE DURING CONSTRUCTION AND REATTACH AFTER CONSTRUCTION)

APPROXIMATE RELOCATION OF AERIAL UTILITY FACILITIES OWNED BY COMCAST (TO BE DONE BY OTHERS)

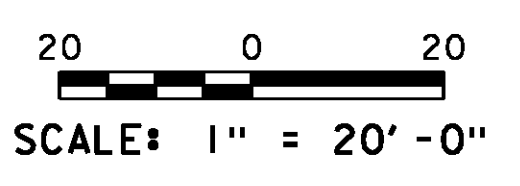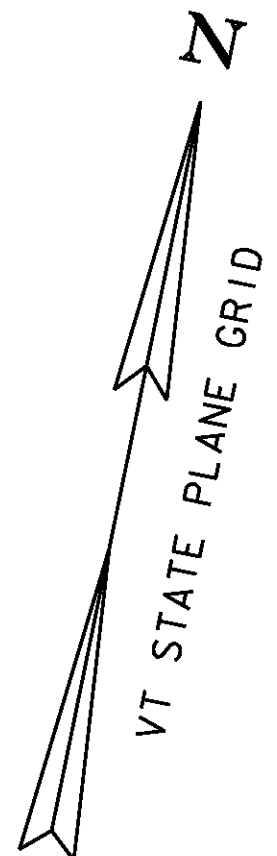

NOTE: SEE THE UTILITY SPECIAL PROVISIONS FOR ADDITIONAL INFORMATION AND REQUIREMENTS.



PROJECT NAME:	JOHNSON	PLOT DATE:	10-JUN-2014
PROJECT NUMBER:	BRF 030-2(26)	DRAWN BY:	G. ROY
FILE NAME:	s88b193bdr_util.dgn	CHECKED BY:	H. SALLS
PROJECT LEADER:	C. CARLSON	UTILITY LAYOUT (2)	SHEET 19 OF 69
DESIGNED BY:	G. ROY		

**4 INCH WHITE LINE**

VT 15 STA 89+00.0 LT - VT 15 STA 92+00.0 LT  
VT 15 STA 89+00.0 RT - VT 15 STA 92+00.0 RT


**4 INCH YELLOW LINE**

VT 15 STA 89+00.0 C - VT 15 STA 92+00.0 C (DOUBLE)

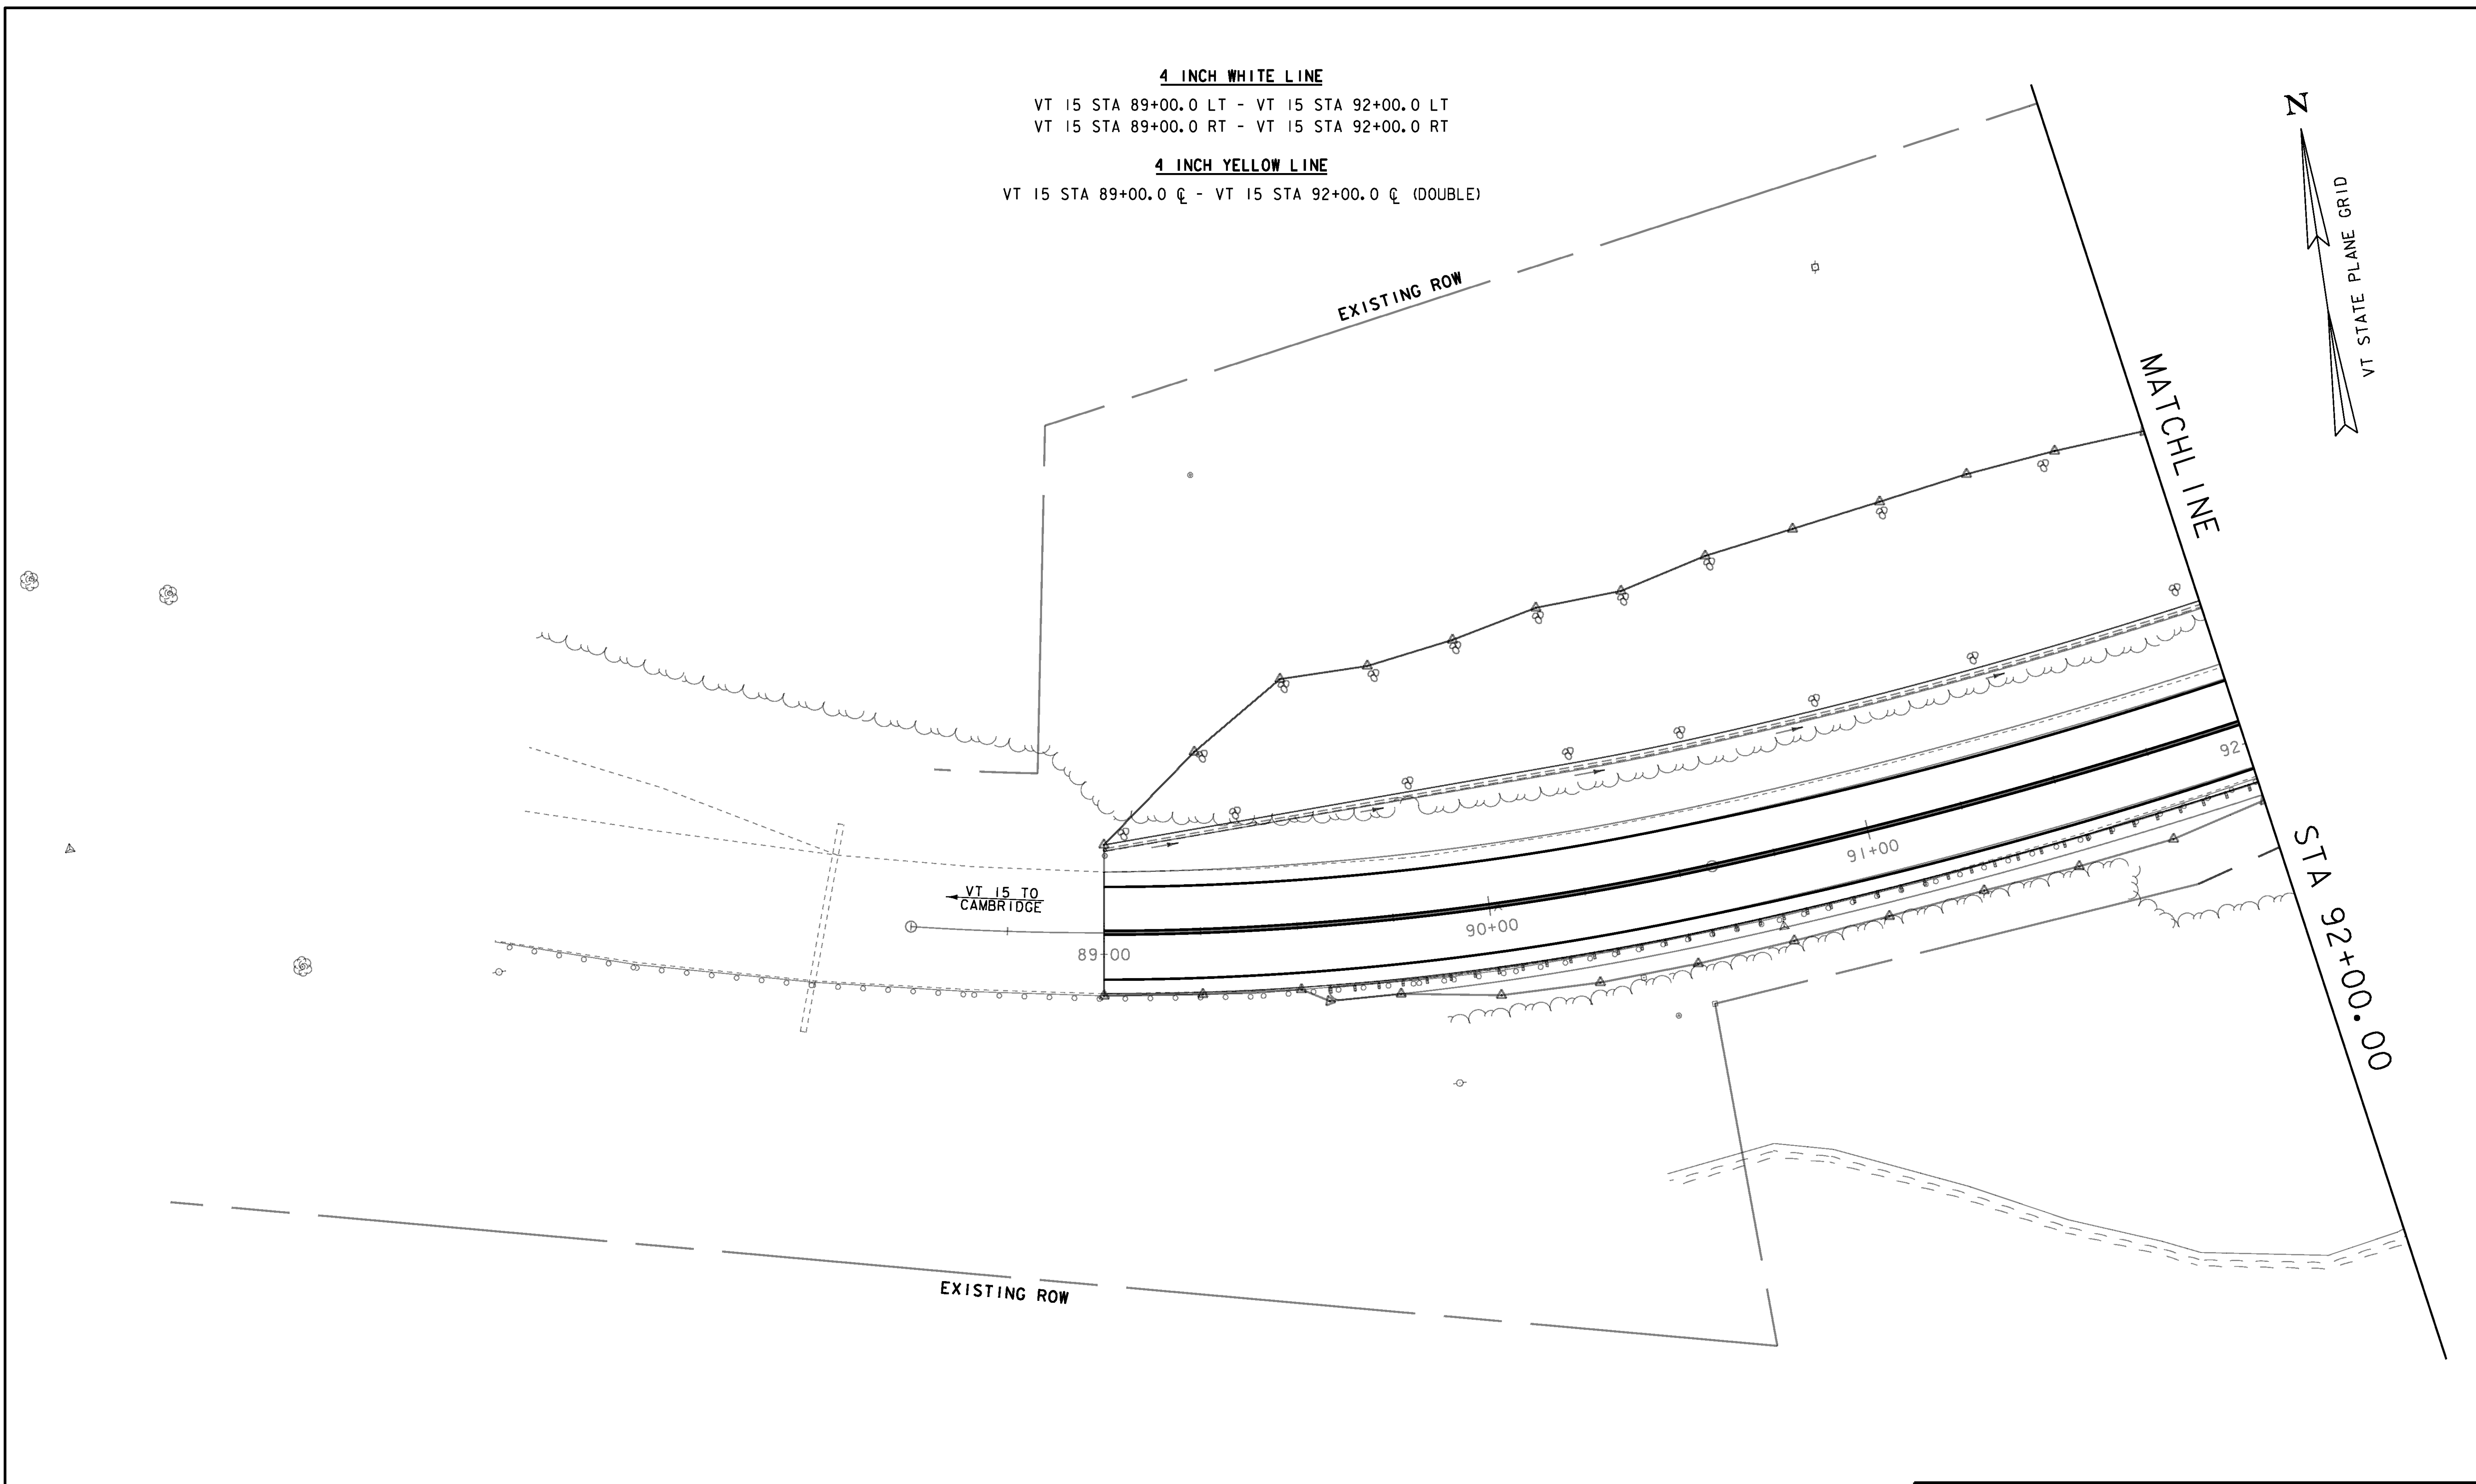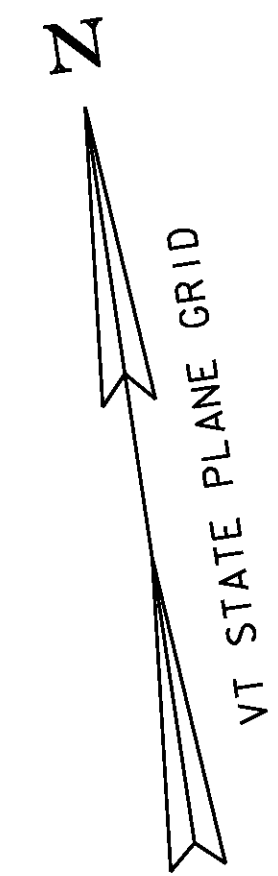


20 0 20  
SCALE: 1" = 20'-0"

PROJECT NAME: JOHNSON	PLOT DATE: 10-JUN-2014
PROJECT NUMBER: BRF 030-2(26)	DRAWN BY: R. PELLETT
FILE NAME: s88b193sign.dgn	CHECKED BY: H. SALLS
PROJECT LEADER: C. CARLSON	SHEET 20 OF 69
DESIGNED BY: H. SALLS	
SIGNS & PAVEMENT MARKINGS (I)	

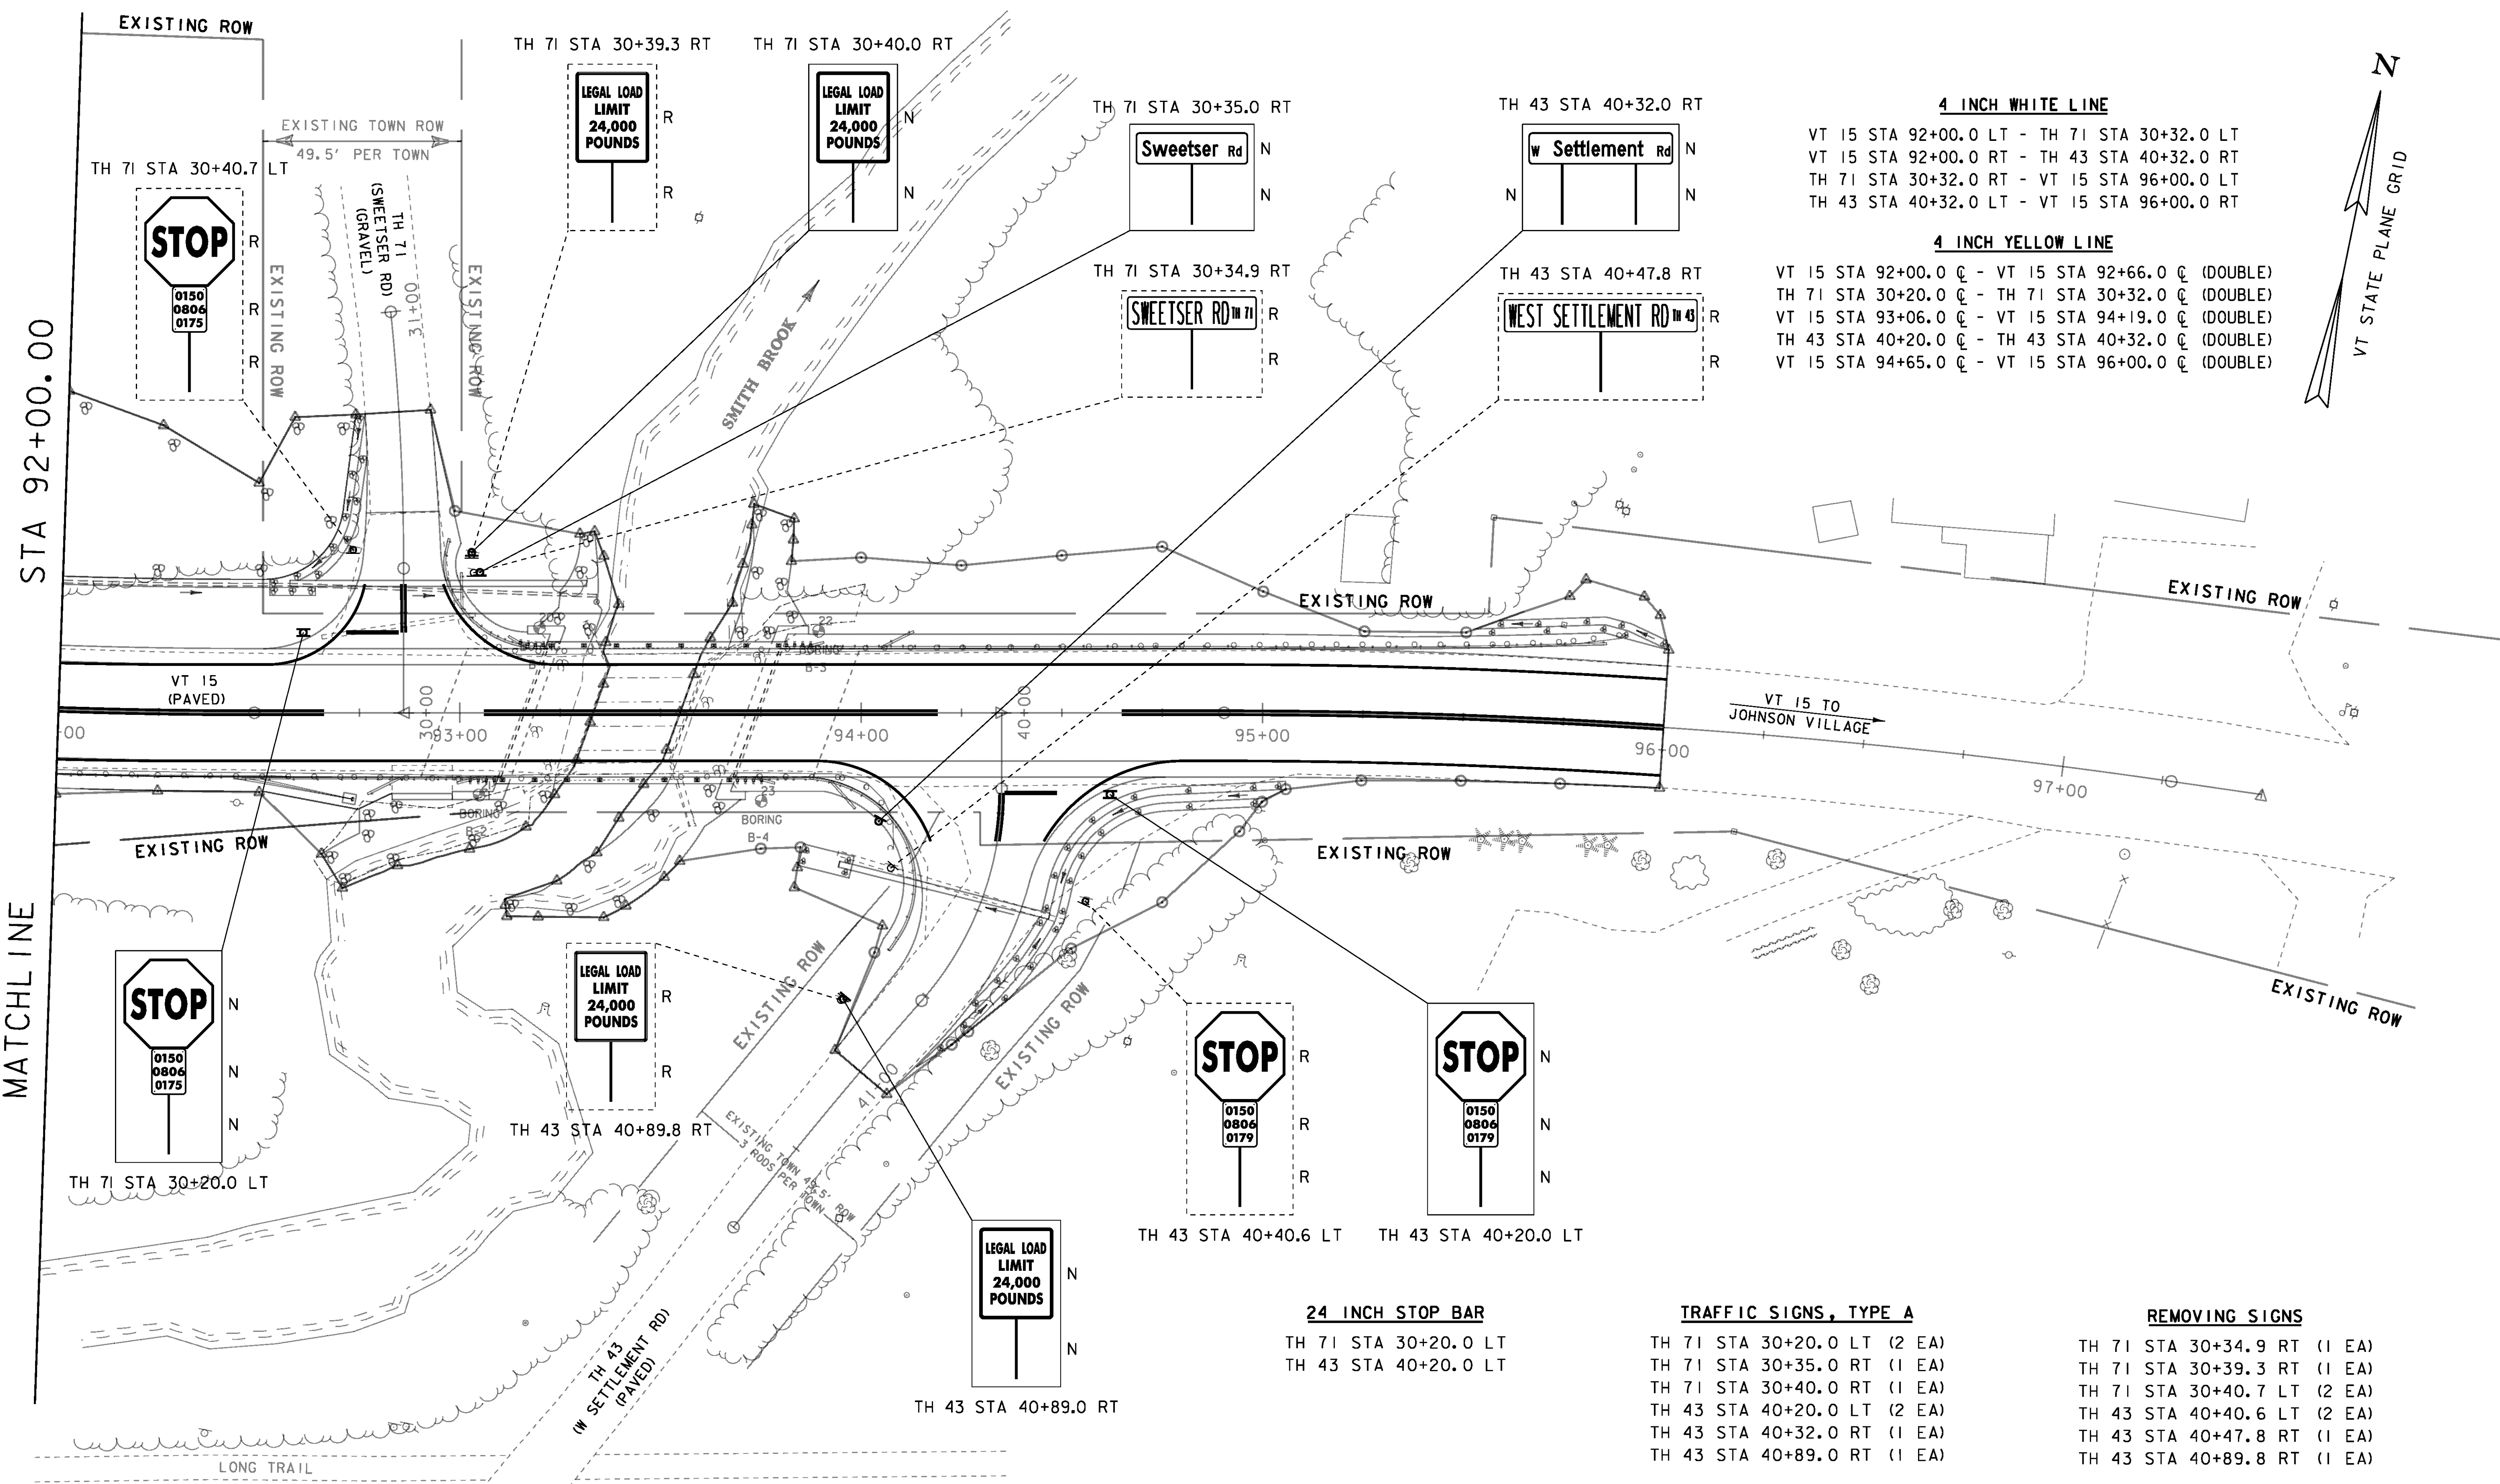


**4 INCH WHITE LINE**  
 VT 15 STA 92+00.0 LT - TH 71 STA 30+32.0 LT  
 VT 15 STA 92+00.0 RT - TH 43 STA 40+32.0 RT  
 TH 71 STA 30+32.0 RT - VT 15 STA 96+00.0 LT  
 TH 43 STA 40+32.0 LT - VT 15 STA 96+00.0 RT

**4 INCH YELLOW LINE**  
 VT 15 STA 92+00.0 C - VT 15 STA 92+66.0 C (DOUBLE)  
 TH 71 STA 30+20.0 C - TH 71 STA 30+32.0 C (DOUBLE)  
 VT 15 STA 93+06.0 C - VT 15 STA 94+19.0 C (DOUBLE)  
 TH 43 STA 40+20.0 C - TH 43 STA 40+32.0 C (DOUBLE)  
 VT 15 STA 94+65.0 C - VT 15 STA 96+00.0 C (DOUBLE)

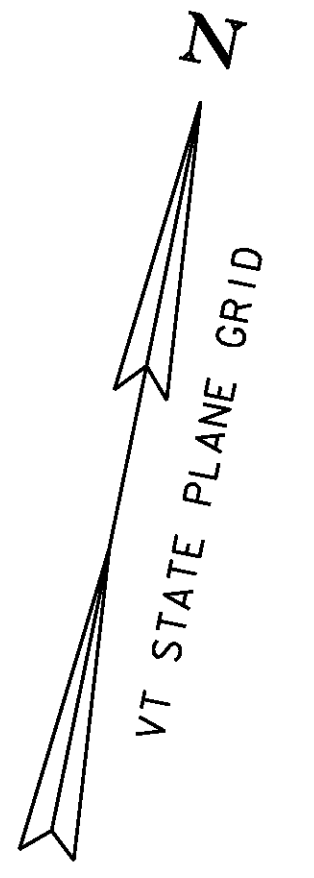

MATCHLINE

STA 92+00.00

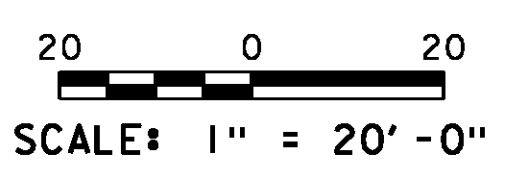

**TRAFFIC SIGNS, TYPE A**  
 TH 71 STA 30+20.0 LT (2 EA)  
 TH 71 STA 30+35.0 RT (1 EA)  
 TH 71 STA 30+40.0 RT (1 EA)  
 TH 43 STA 40+20.0 LT (2 EA)  
 TH 43 STA 40+32.0 RT (1 EA)  
 TH 43 STA 40+89.0 RT (1 EA)

**REMOVING SIGNS**  
 TH 71 STA 30+34.9 RT (1 EA)  
 TH 71 STA 30+39.3 RT (1 EA)  
 TH 71 STA 30+40.7 LT (2 EA)  
 TH 43 STA 40+40.6 LT (2 EA)  
 TH 43 STA 40+47.8 RT (1 EA)  
 TH 43 STA 40+89.8 RT (1 EA)

**LEGEND**  
 R: REMOVE  
 R&S: REMOVE AND SALVAGE  
 RET: RETAIN  
 N: NEW  
 S: SALVAGE

PROJECT NAME: JOHNSON  
 PROJECT NUMBER: BRF 030-2(26)  
 FILE NAME: s88bl93sign.dgn  
 PROJECT LEADER: C. CARLSON  
 DESIGNED BY: H. SALLS  
 SIGNS & PAVEMENT MARKINGS (2)

PLOT DATE: 10-JUN-2014  
 DRAWN BY: R. PELLETT  
 CHECKED BY: H. SALLS  
 SHEET 21 OF 69



**SOIL CLASSIFICATION**

**AASHTO**

A1	Gravel and Sand
A3	Fine Sand
A2	Silty or Clayey Gravel and Sand
A4	Silty Soil - Low Compressibility
A5	Silty Soil - Highly Compressible
A6	Clayey Soil - Low Compressibility
A7	Clayey Soil - Highly Compressible

**ROCK QUALITY DESIGNATION**

R.Q.D. (%)	ROCK DESCRIPTION
<25	Very Poor
25 to 50	Poor
51 to 75	Fair
76 to 90	Good
>90	Excellent

**SHEAR STRENGTH**

UNDRAINED SHEAR STRENGTH IN P.S.F.	CONSISTENCY
<250	Very Soft
250-500	Soft
500-1000	Med. Stiff
1000-2000	Stiff
2000-4000	Very Stiff
>4000	Hard

**CORRELATION GUIDE OF "N" TO DENSITY/CONSISTENCY**

DENSITY (GRANULAR SOILS)		CONSISTENCY (COHESIVE SOILS)	
N	DESCRIPTIVE TERM	N	DESCRIPTIVE TERM
<5	Very Loose	<2	Very Soft
5-10	Loose	2-4	Soft
11-24	Med. Dense	5-8	Med. Stiff
25-50	Dense	9-15	Stiff
>50	Very Dense	16-30	Very Stiff
		31-60	Hard
		>60	Very Hard

**COMMONLY USED SYMBOLS**


- ▼ Water Elevation
- ⊙ Standard Penetration Boring
- ⊕ Auger Boring
- ⊖ Rod Sounding
- S Sample
- N Standard Penetration Test
- Blow Count Per Foot For:
- 2" O. D. Sampler
- 1 1/2" I. D. Sampler
- Hammer Weight Of 140 Lbs.
- Hammer Fall Of 30"
- YS Field Vane Shear Test
- US Undisturbed Soil Sample
- B Blast
- DC Diamond Core
- MD Mud Drill
- WA Wash Ahead
- HSA Hollow Stem Auger
- AX Core Size 1 1/8"
- BX Core Size 1 3/8"
- NX Core Size 2 1/8"
- M Double Tube Core Barrel Used
- LL Liquid Limit
- PL Plastic Limit
- PI Plasticity Index
- NP Non Plastic
- w Moisture Content (Dry Wgt. Basis)
- D Dry
- M Moist
- MTW Moist To Wet
- W Wet
- Sat Saturated
- Bo Boulder
- Gr Gravel
- Sa Sand
- SI Silt
- Cl Clay
- HP Hardpan
- Le Ledge
- NLTD No Ledge To Depth
- CNPF Can Not Penetrate Further
- TLOB Top of Ledge Or Boulder
- NR No Recovery
- Rec. Recovery
- %Rec. Percent Recovery
- ROD Rock Quality Designation
- CBR California Bearing Ratio
- < Less Than
- > Greater Than
- R Refusal (N > 100)
- VTSPG NAD83 - See Note 7

**COLOR**

blk	Black	pnk	Pink
bl	Blue	pu	Purple
brn	Brown	rd	Red
dk	Dark	tn	Tan
gr	Gray	wh	White
gn	Green	yel	Yellow
lt	Light	mltc	Multicolored
or	Orange		

**DEFINITIONS (AASHTO)**

- BEDROCK (LEDGE)** - Rock in its native location of indefinite thickness.
- BOULDER** - A rock fragment with an average dimension > 12 inches.
- COBBLE** - Rock fragments with an average dimension between 3 and 12 inches.
- GRAVEL** - Rounded particles of rock < 3" and > 0.075" (#10 sieve).
- SAND** - Particles of rock < 0.075" (#10 sieve) and > 0.0029" (#200 sieve).
- SILT** - Soil < 0.0029" (#200 sieve), non or slightly plastic and exhibits no strength when air-dried.
- CLAY** - Fine grained soil, exhibits plasticity when moist and considerable strength when air-dried.
- VARVED** - Alternate layers of silt and clay.
- HARDPAN** - Extremely dense soil, cemented layer, not softened when wet.
- MUCK** - Soft organic soil (containing > 10% organic material).
- MOISTURE CONTENT** - Weight of water divided by dry weight of soil.
- FLOWING SAND** - Granular soil so saturated (loose) that it flows into drill casing during extraction of wash rod.
- STRIKE** - Angle from magnetic north to line of intersection of bed with a horizontal plane.
- DIP** - Inclination of bed with a horizontal plane.

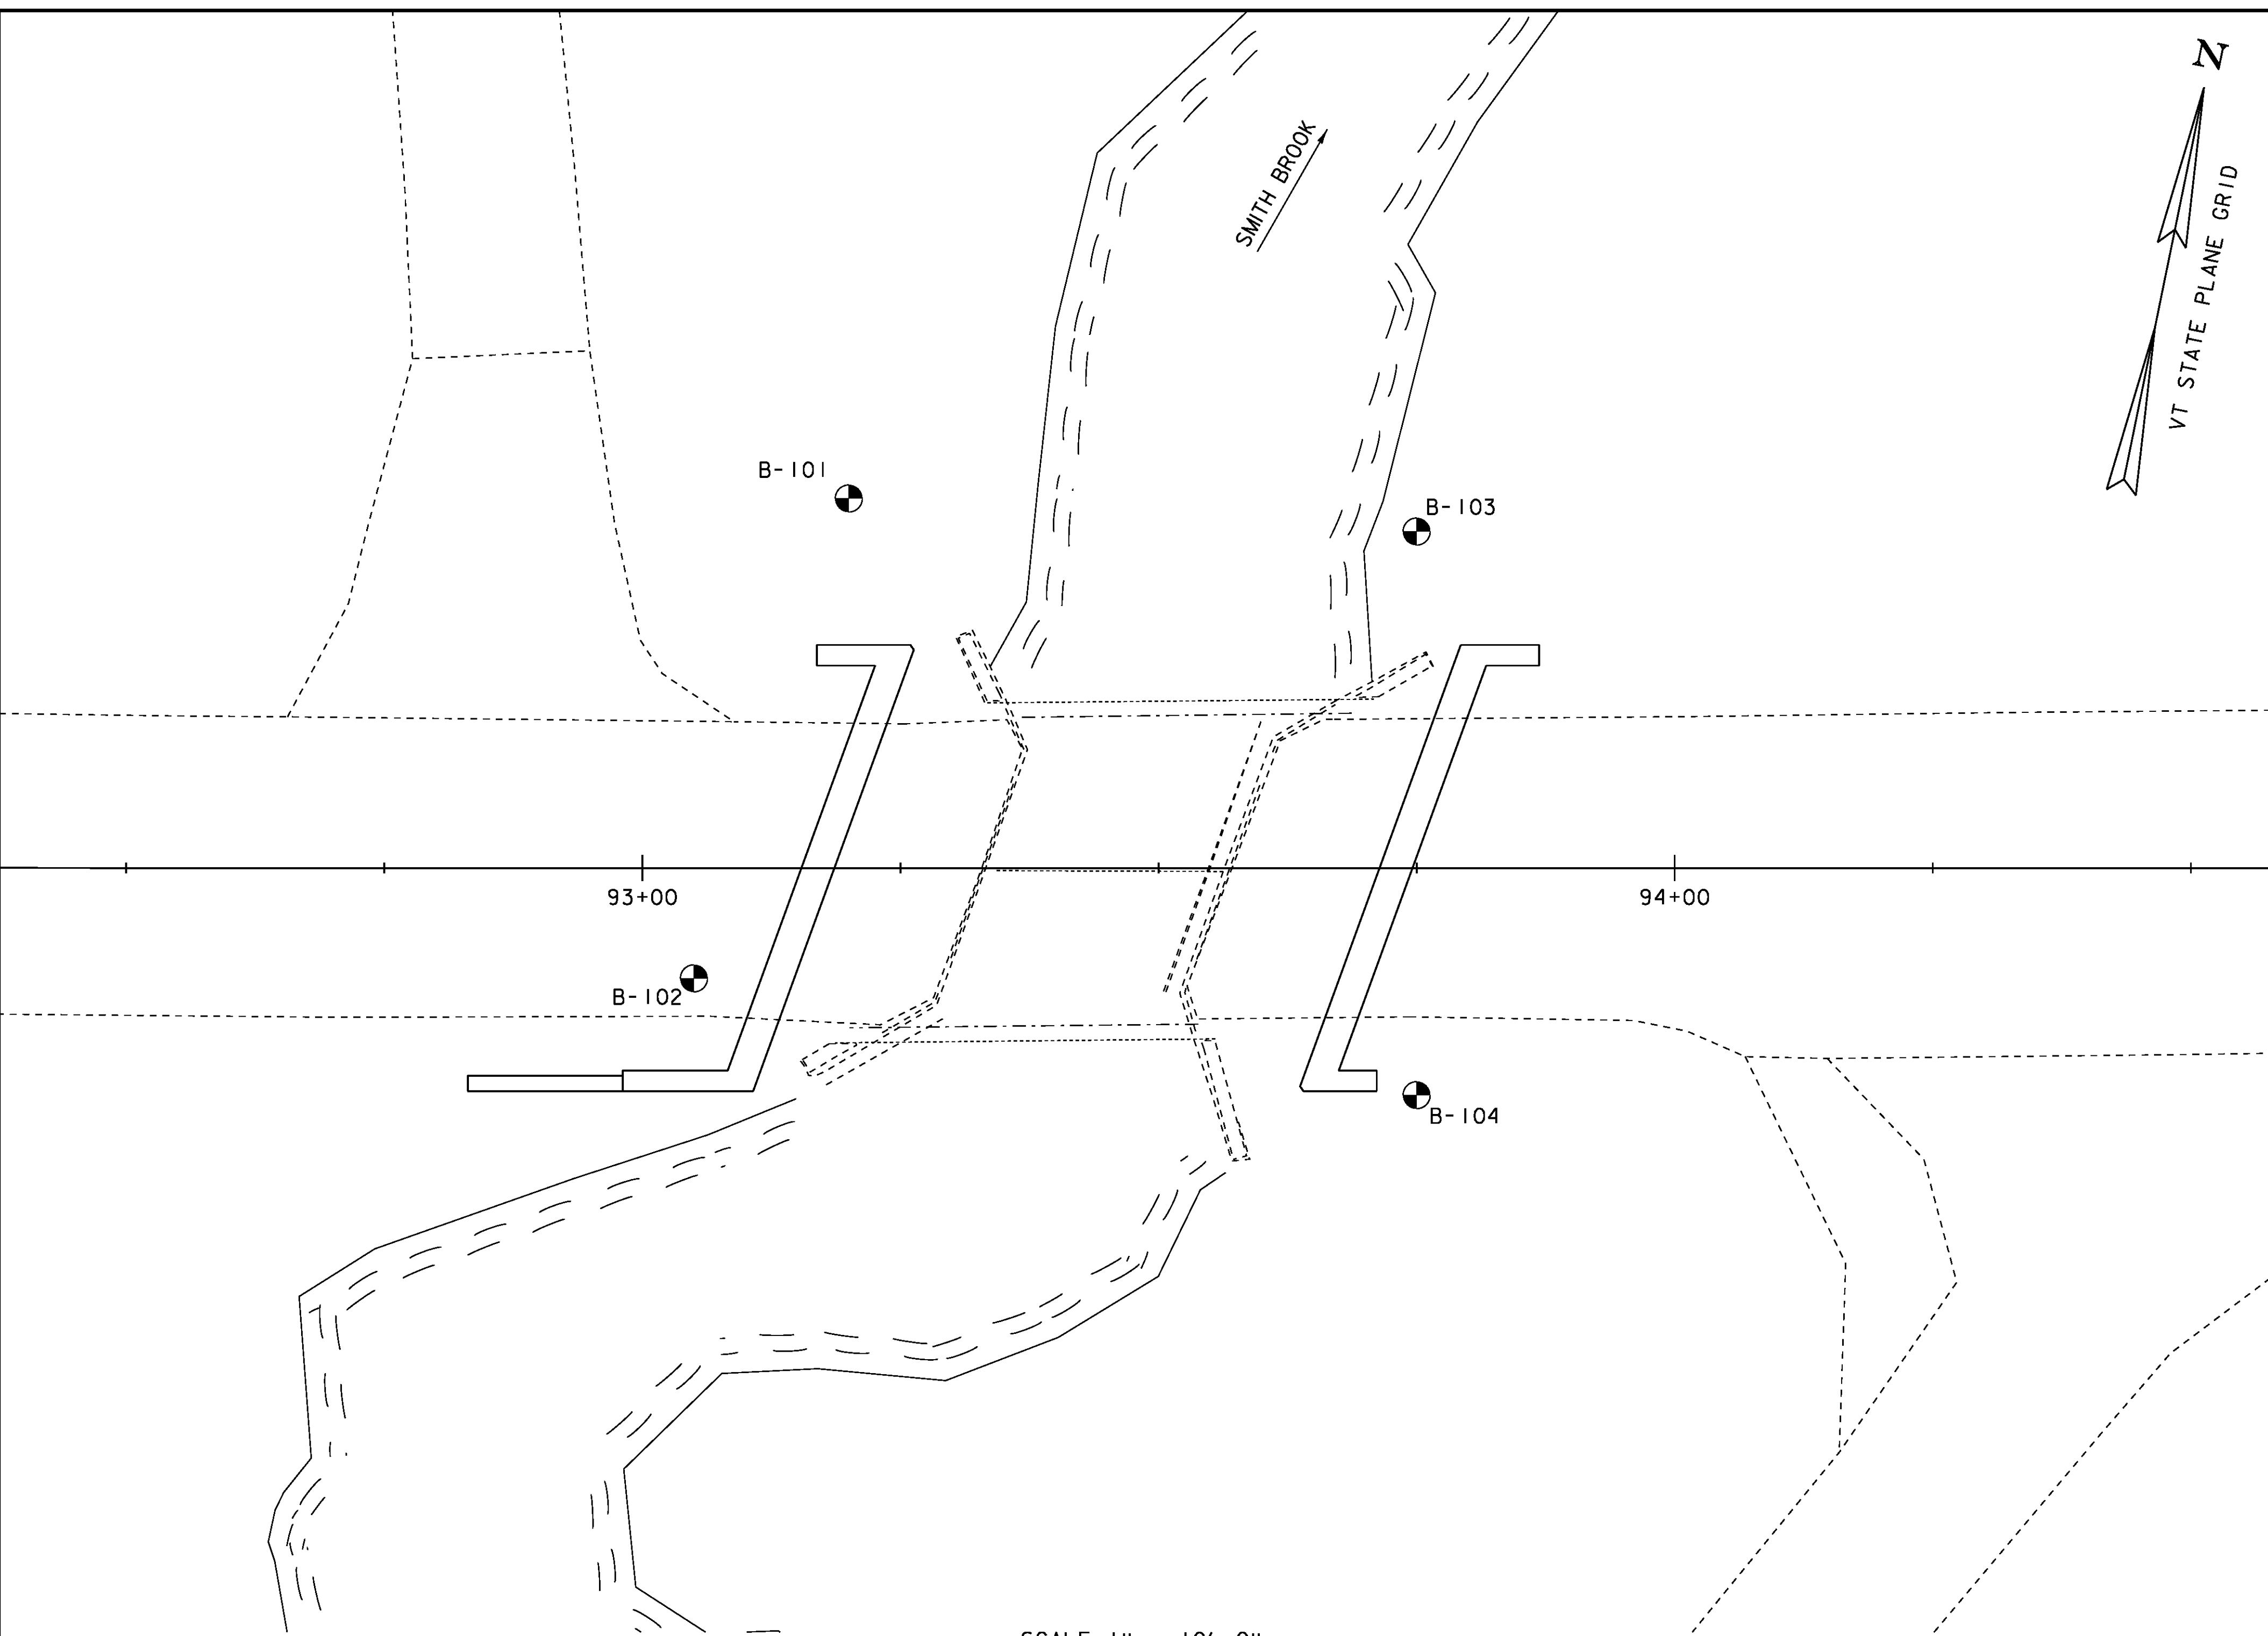

SCALE 1" = 10'-0"

**BORING CHART**

HOLE NO.	SURV. STATION	OFFSET	GROUND ELEV.	ELEV. TLOB
B-101	93+20	-35.80	488.59	436.89
B-102	93+05	10.68	488.78	433.18
B-103	93+75	-32.60	484.34	436.94
B-104	93+75	22.00	488.10	456.90


**GENERAL NOTES**

- The subsurface explorations shown herein were made between April 4, 2011 and June 20, 2011 by the Agency.
- Soil and rock classifications, properties and descriptions are based on engineering interpretation from available subsurface information by the Agency and may not necessarily reflect actual variations in subsurface conditions that may be encountered between individual boring or sample locations.
- Observed water levels and/or conditions indicated are as recorded at the time of exploration and may vary according to the prevailing rainfall, methods of exploration and other factors.
- Engineering judgment was exercised in preparing the subsurface information presented herein. Analysis and interpretation of subsurface data was performed and interpreted for Agency design and estimating purposes. Presentation of the information in the Contract is intended to provide the Contractor access to the same data available to the Agency. The subsurface information is presented in good faith and is not intended as a substitute for personal investigation, independent interpretation, independent analysis or judgment by the Contractor.
- Pictorial structure details shown on the boring plan layout or soils profile are for illustrative purposes only and may not accurately portray final contract details.
- Terminology used on boring logs to describe the hardness, degree of weathering, and spacing of fractures, joints and other discontinuities in the bedrock is defined in the AASHTO Manual on Subsurface Investigations, 1988.
- Northing and Easting coordinates are shown in Vermont State Plane Grid North American Datum 1983 in meters and survey feet.

PROJECT NAME: JOHNSON  
PROJECT NUMBER: BRF 030-2(26)

FILE NAME: s88b193bor.dgn  
PROJECT LEADER: C. CARLSON  
DESIGNED BY: H. SALLS  
BORING INFORMATION


PLOT DATE: 10-JUN-2014  
DRAWN BY: R. PELLET  
CHECKED BY: H. SALLS  
SHEET 23 OF 69

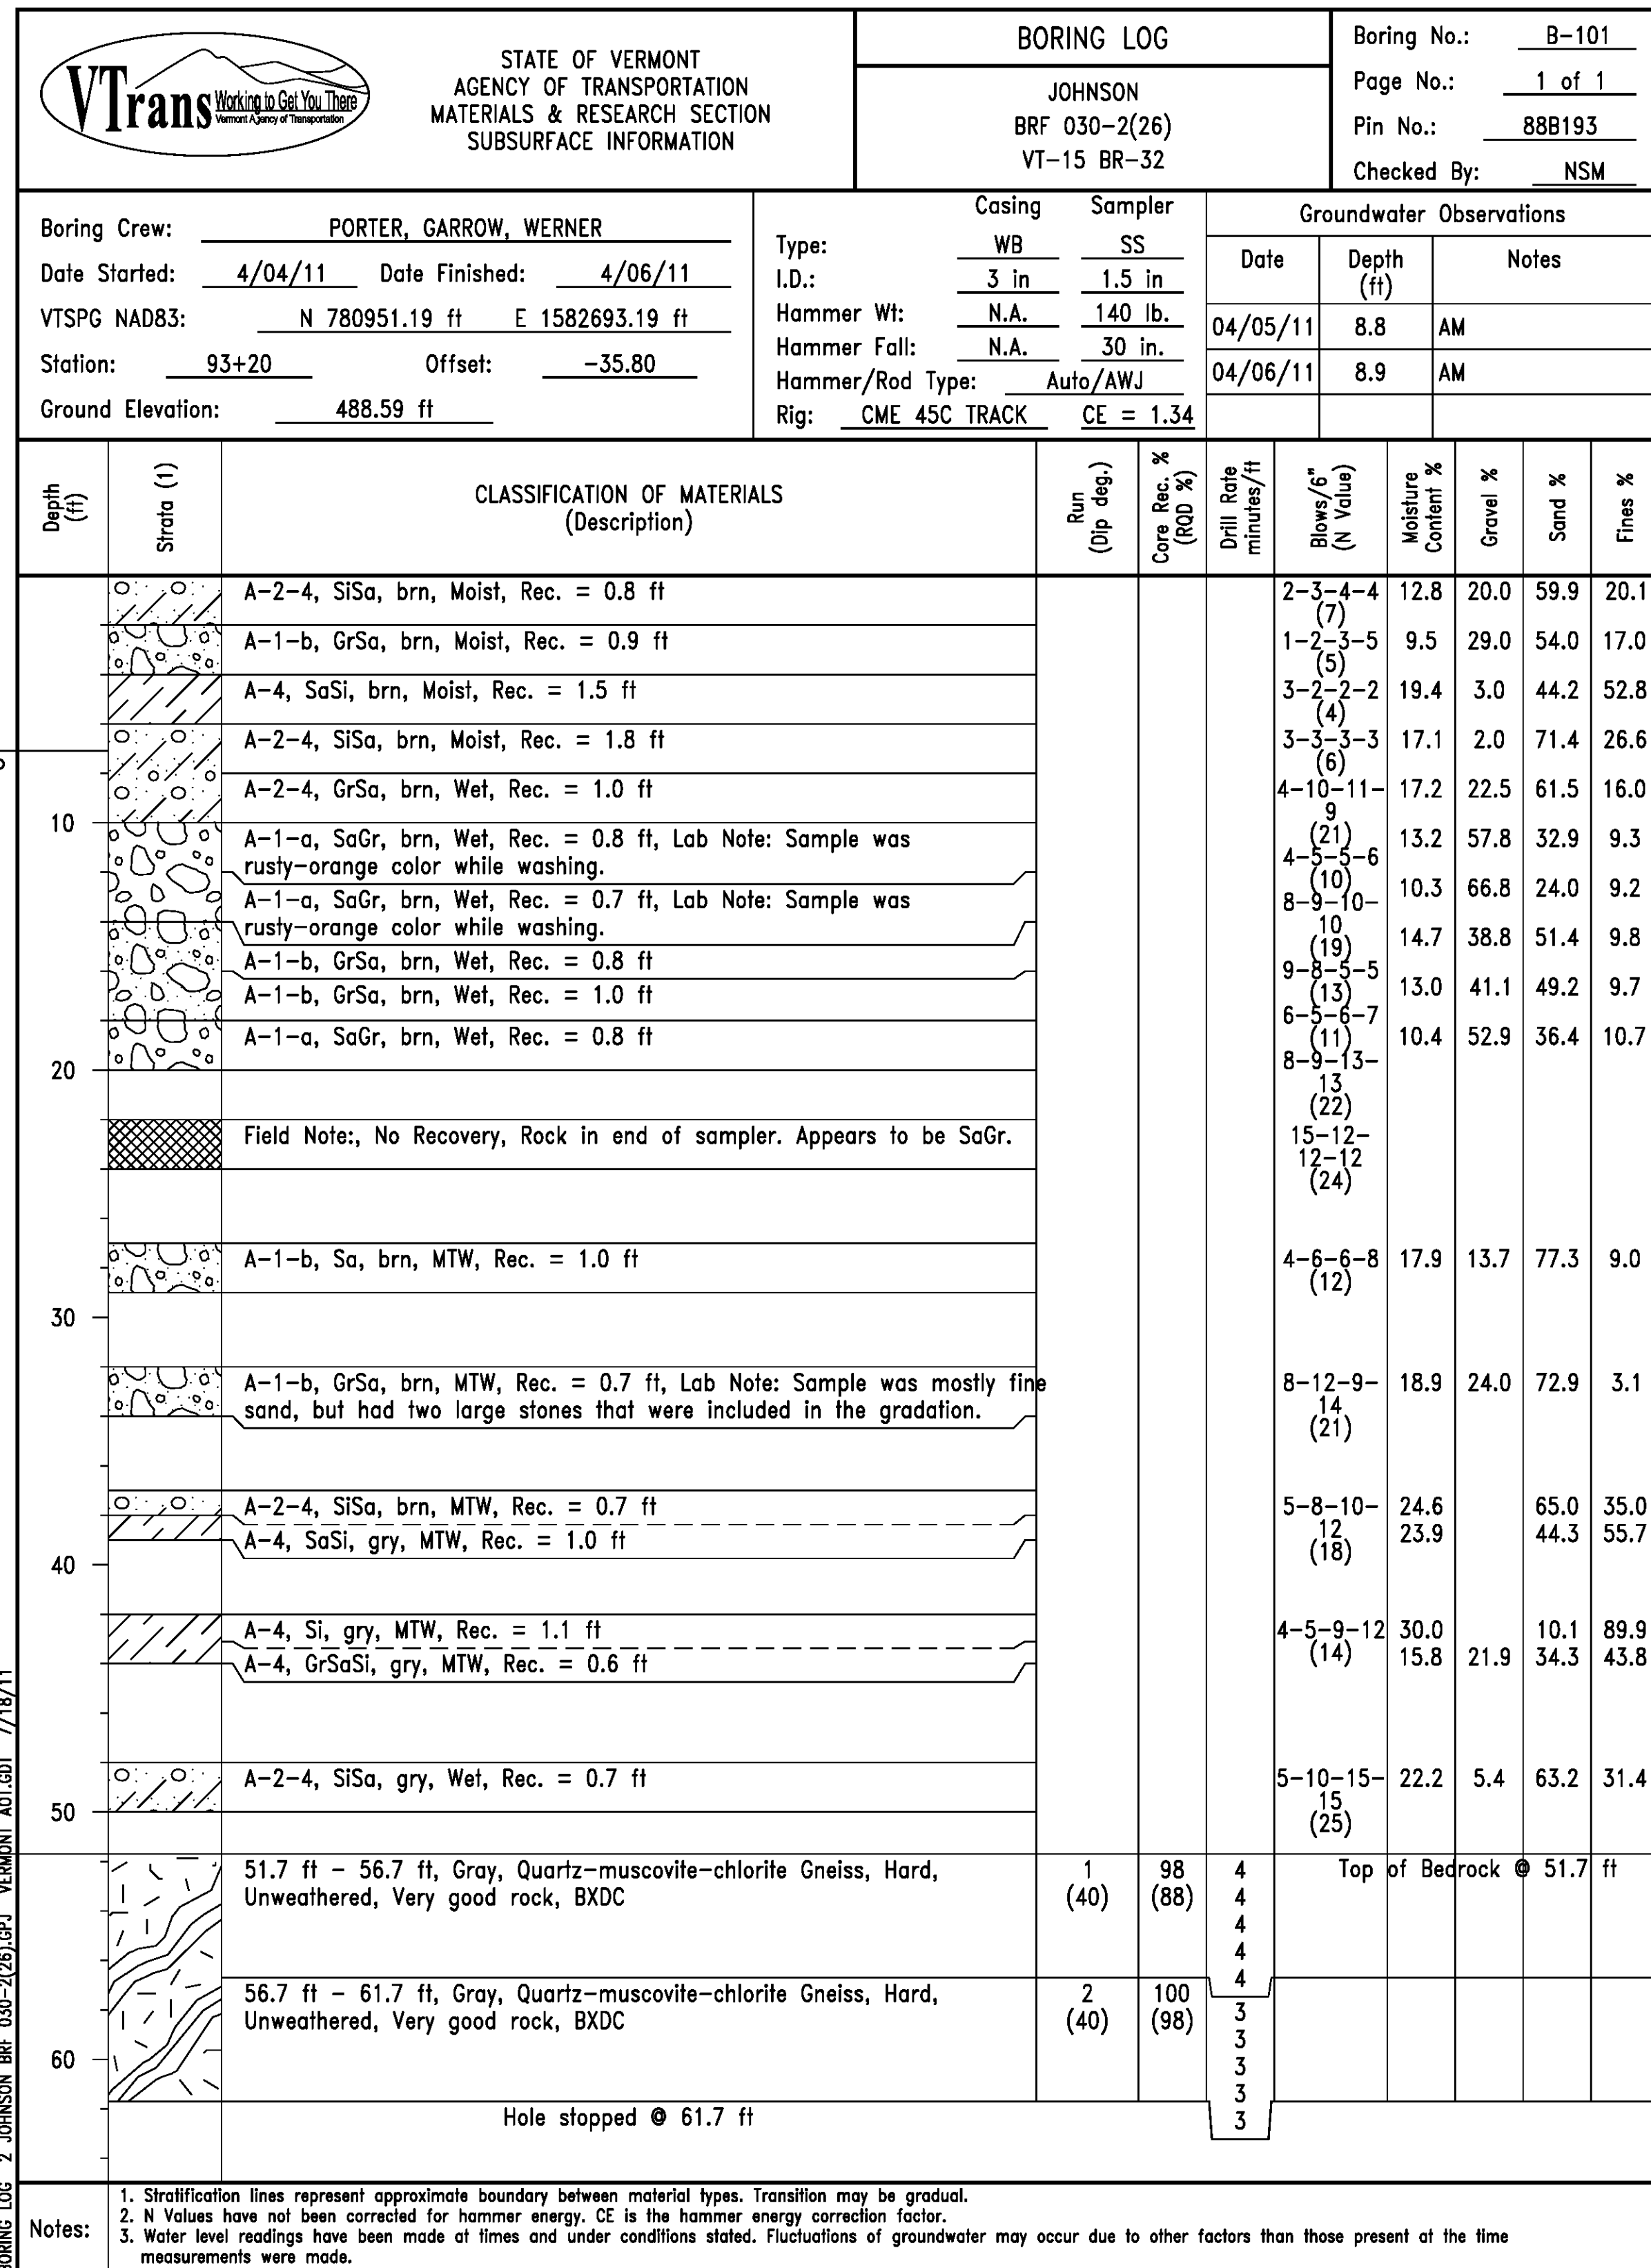

ABUT. NO. 1  
BOTTOM OF PILE CAP  
ELEV. 481.50

EST. PILE TIP  
ELEV. 436.89

BORING LOG 2 JOHNSON BRF 030-2(26).GPJ VERMONT AOT.GDT 7/18/11

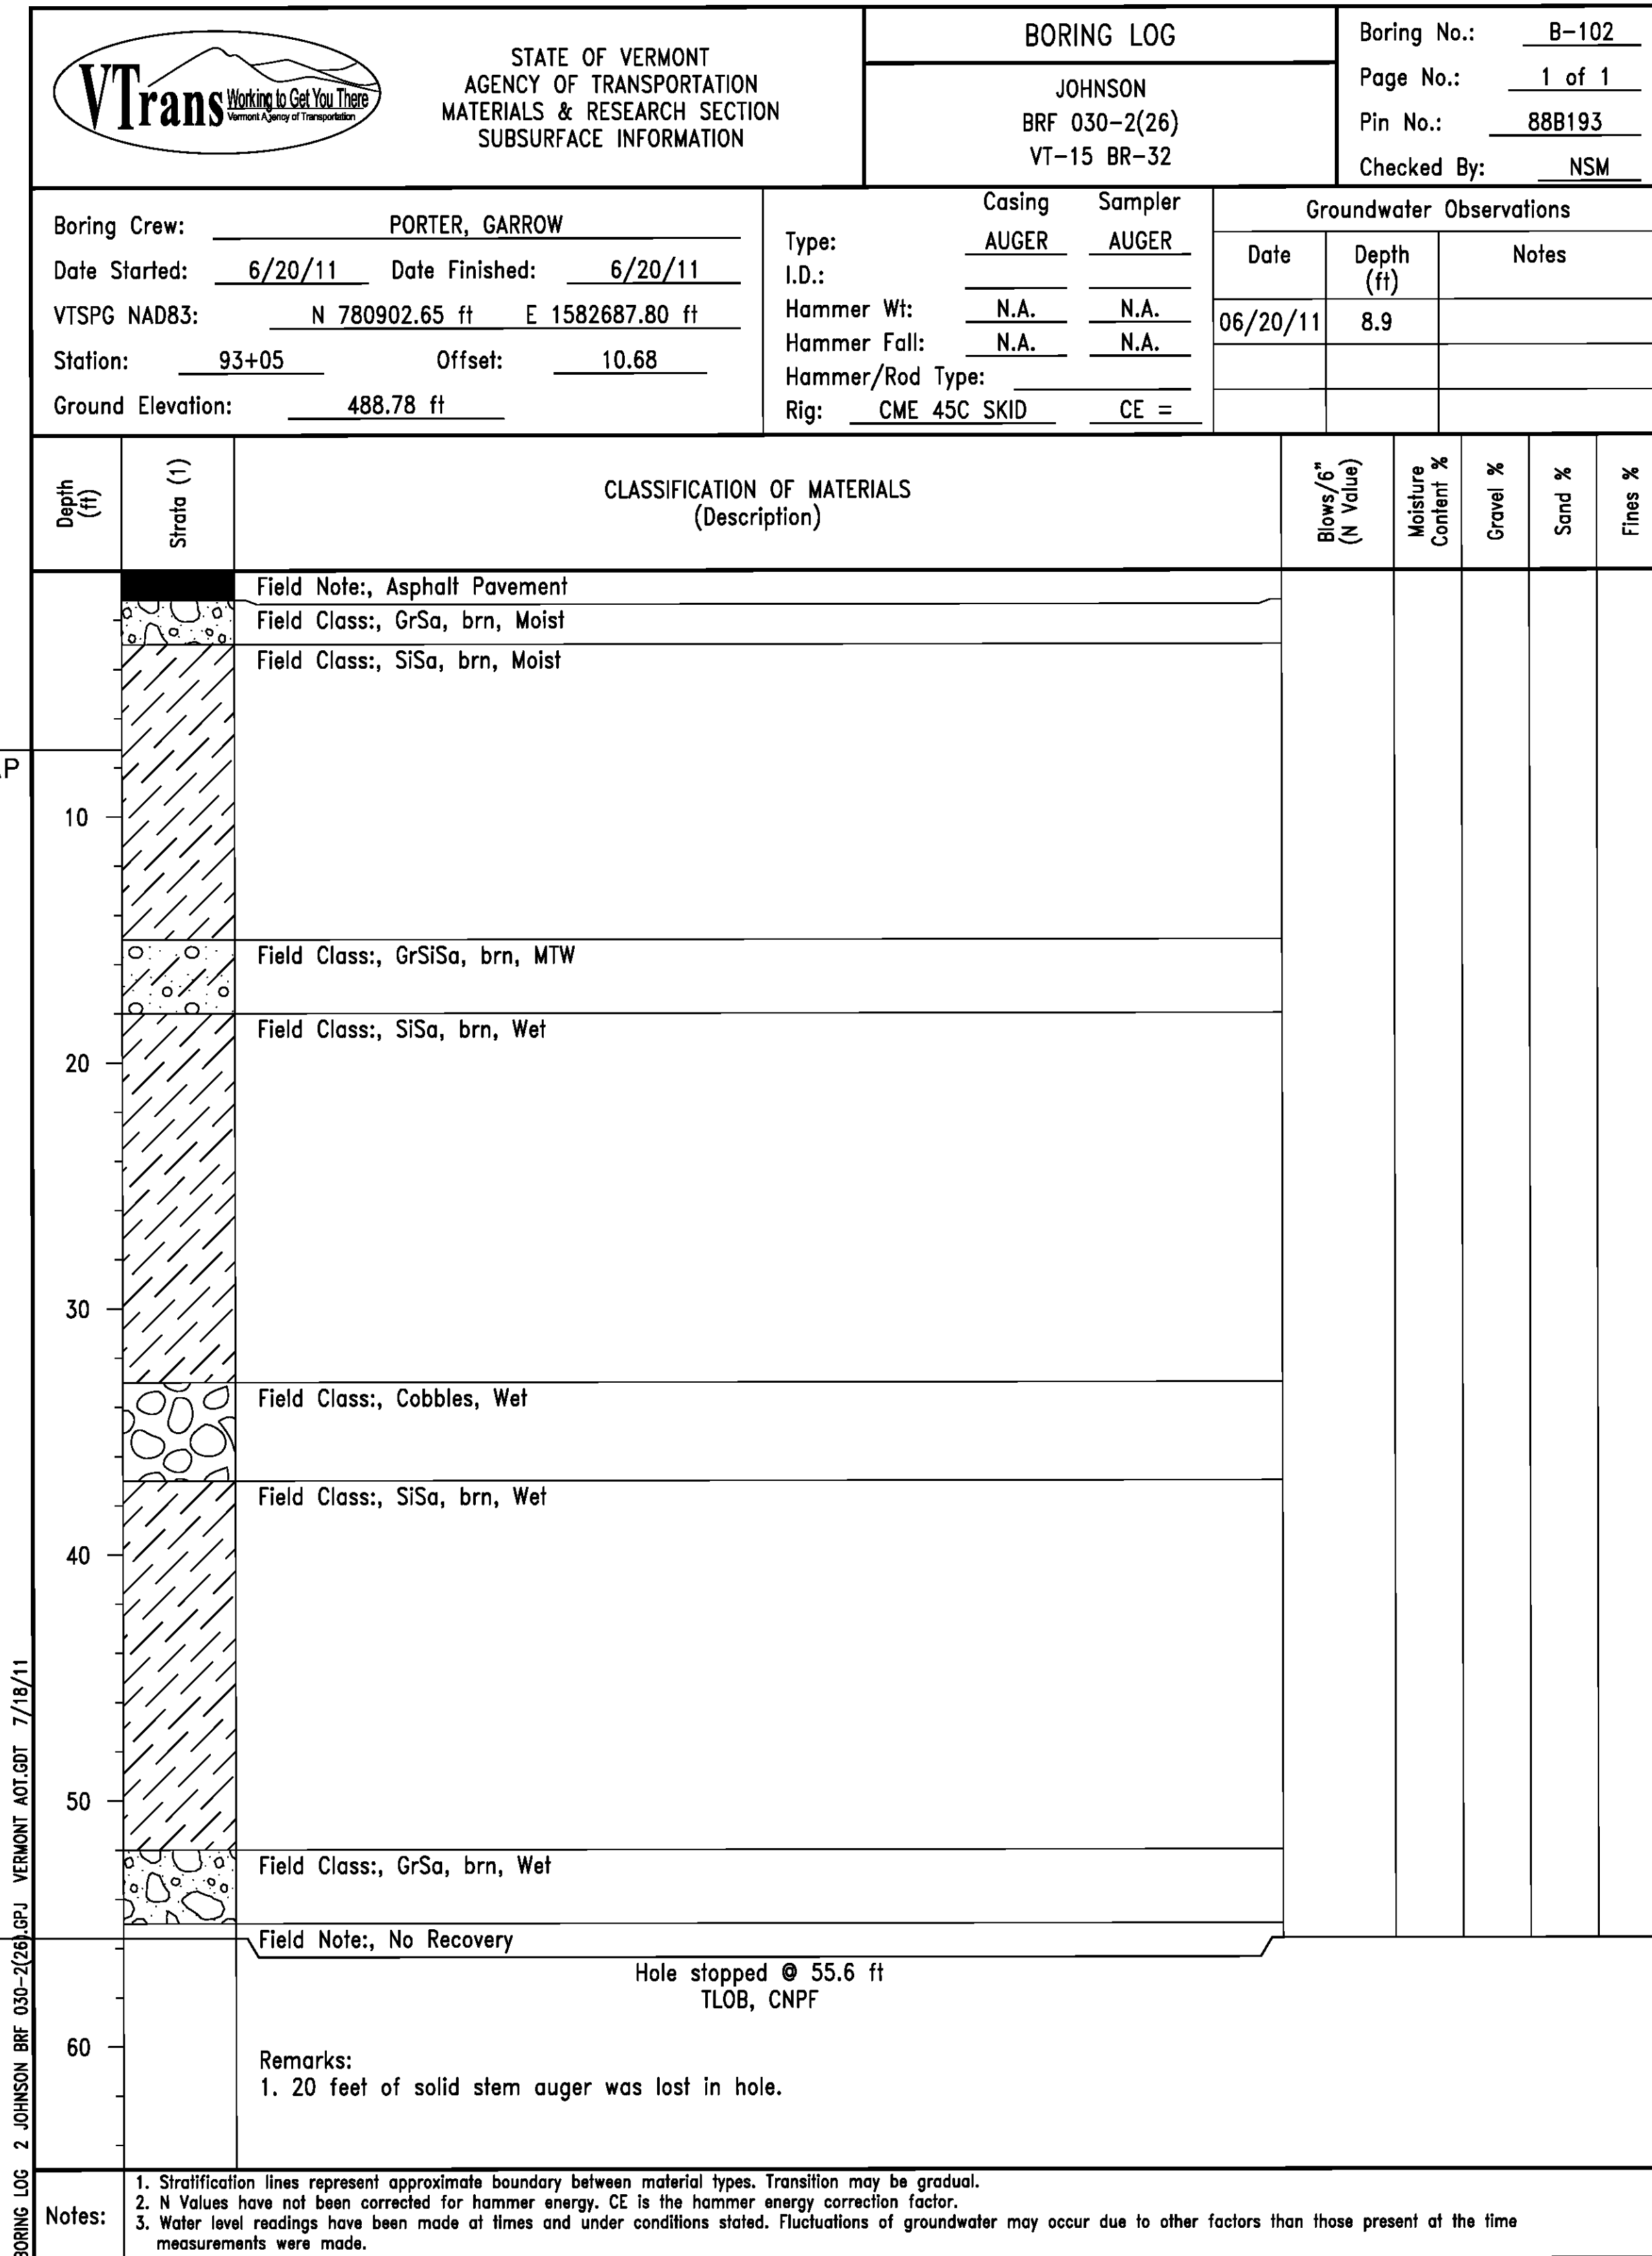

ABUT. NO. 1  
BOTTOM OF PILE CAP  
ELEV. 481.50

EST. PILE TIP  
ELEV. 433.18

BORING LOG 2 JOHNSON BRF 030-2(26).GPJ VERMONT AOT.GDT 7/18/11

PROJECT NAME: JOHNSON  
PROJECT NUMBER: BRF 030-2(26)

FILE NAME: s88b193bor.dgn PLOT DATE: 10-JUN-2014  
PROJECT LEADER: C. CARLSON DRAWN BY: R. PELLETT  
DESIGNED BY: H. SALLS CHECKED BY: H. SALLS  
BORING LOG (D) SHEET 24 OF 69

VT Trans Working to Get You There Vermont Agency of Transportation		STATE OF VERMONT AGENCY OF TRANSPORTATION MATERIALS & RESEARCH SECTION SUBSURFACE INFORMATION		BORING LOG		Boring No.: B-103					
Boring Crew: WERNER, WHITLOCK, HOLT				JOHNSON		Page No.: 1 of 1					
Date Started: 4/18/11 Date Finished: 4/25/11				BRF 030-2(26)		Pin No.: 88B193					
VTSPG NAD83: N 780959.34 ft E 1582749.14 ft				VT-15 BR-32		Checked By: NSM					
Station: 93+75 Offset: -32.60				Casing Sampler		Groundwater Observations					
Ground Elevation: 484.34 ft				Type: WB SS		Date Depth Notes					
				I.D.: 3 in 1.5 in							
				Hammer Wt: N.A. 140 lb.							
				Hammer Fall: N.A. 30 in.							
				Hammer/Rod Type: Auto/AWJ							
				Rig: CME 45C TRACK CE = 1.34							
Depth (ft)	Strata (1)	CLASSIFICATION OF MATERIALS (Description)	Run (dip deg.)	Core Rec. % (ROD %)	Drill Rate minutes/ft	Blows/ft (N Value)	Moisture Content %	Gravel %	Sand %	Fines %	
		A-2-4, SiSa, brn, Moist, Rec. = 0.4 ft				WH-WH-WH-2 (WH)	27.3	13.3	60.0	26.7	
		A-1-a, SaGr, brn, Wet, Rec. = 0.7 ft, Broken rock was within sample.				3-7-7-4 (14)	13.5	58.6	34.0	7.4	
10		A-3, Sa, brn, Wet, Rec. = 1.6 ft				6-2-3-3 (5)	24.8	5.3	87.3	7.4	
		A-2-4, SiSa, brn, Wet, Rec. = 2.0 ft				4-3-2-4 (5)	23.8	1.0	74.6	24.4	
20		A-2-4, Sa, brn, Wet, Rec. = 2.0 ft				1-2-3-4 (5)	22.1	4.5	77.4	18.1	
		A-1-b, GrSa, brn, Wet, Rec. = 2.0 ft				22-13-11-10 (24)	17.6	27.1	63.3	9.6	
30		A-2-4, Sa, brn, Wet, Rec. = 2.0 ft				19-10-8-10 (18)	18.0	16.7	69.7	13.6	
		A-2-4, SiSa, brn, Wet, Rec. = 1.2 ft				3-4-3-4 (7)	24.9	8.7	56.9	34.4	
40		A-4, SiSa, gry, Wet, Rec. = 1.4 ft				1-4-4-4 (8)	25.0	8.3	52.9	38.8	
		A-2-4, SiSa, gry, Wet, Rec. = 0.9 ft				1-3-4-7 (7)	23.5	2.0	73.5	24.5	
50		47.4 ft - 48.6 ft, Gray, Quartz-muscovite-chlorite Gneiss, Hard, Unweathered, Good rock, BXMDC, (RMR = 67)	1 (35)	67 (0)	6	Top of Bedrock @ 47.4 ft					
		48.6 ft - 52.4 ft, Gray, Quartz-muscovite-chlorite Gneiss, Hard, Unweathered, Good rock, BXMDC, (RMR = 77)	2 (35)	63 (61)	4						
		Hole stopped @ 52.4 ft			6						
Notes:		1. Stratification lines represent approximate boundary between material types. Transition may be gradual. 2. N Values have not been corrected for hammer energy. CE is the hammer energy correction factor. 3. Water level readings have been made at times and under conditions stated. Fluctuations of groundwater may occur due to other factors than those present at the time measurements were made.									

ABUT. NO. 2  
BOTTOM OF PILE CAP  
ELEV. 482.50

EST. PILE TIP  
ELEV. 436.94

BORING LOG 2 JOHNSON BRF 030-2(26).GPR VERMONT AOT.GDT 7/18/11

VT Trans Working to Get You There Vermont Agency of Transportation		STATE OF VERMONT AGENCY OF TRANSPORTATION MATERIALS & RESEARCH SECTION SUBSURFACE INFORMATION		BORING LOG		Boring No.: B-104					
Boring Crew: PORTER, GARROW, WERNER				JOHNSON		Page No.: 1 of 1					
Date Started: 4/07/11 Date Finished: 4/11/11				BRF 030-2(26)		Pin No.: 88B193					
VTSPG NAD83: N 780905.41 ft E 1582757.69 ft				VT-15 BR-32		Checked By: NSM					
Station: 93+75 Offset: 22.00				Casing Sampler		Groundwater Observations					
Ground Elevation: 488.1 ft				Type: WB SS		Date Depth Notes					
				I.D.: 3 in 1.5 in		04/08/11 9.5 AM					
				Hammer Wt: N.A. 140 lb.		04/12/11 7.8 AM, After hard rain					
				Hammer Fall: N.A. 30 in.							
				Hammer/Rod Type: Auto/AWJ							
				Rig: CME 45C TRACK CE = 1.34							
Depth (ft)	Strata (1)	CLASSIFICATION OF MATERIALS (Description)	Run (dip deg.)	Core Rec. % (ROD %)	Drill Rate minutes/ft	Blows/ft (N Value)	Moisture Content %	Gravel %	Sand %	Fines %	
		A-1-b, GrSa, brn, Moist, Rec. = 0.4 ft				2-2-3-4 (5)	8.5	40.0	49.0	11.0	
		A-1-b, GrSa, brn, Moist, Rec. = 1.2 ft				2-6-5-3 (11)	9.8	33.7	50.1	16.2	
5		Field Note: No Recovery., Sand on tip of sampler.				3-5-6-5 (11)					
		A-1-b, SaGr, brn, Wet, Rec. = 0.9 ft				3-4-4-5 (8)	10.8	46.0	45.3	8.7	
10		Visual Classification, SaGr, brn, Wet, Rec. = 0.2 ft, Insufficient sample for testing. No water return at 9.5 ft.				9-6-4-2 (10)	13.9				
		A-1-a, SaGr, gry, Wet, Rec. = 0.6 ft, Lots of broken rock was within sample.				2-14-26-24 (40)	11.8	63.2	23.9	12.9	
		Field Note: Sampler hit rock (cobble)				(NA)-3-2-2 (5)	19.5	18.8	68.1	13.1	
15		A-1-b, Sa, brn, Wet, Rec. = 0.4 ft, Lab Note: Sample was rusty-orange color.				2-4-4-4 (8)					
		Field Note: No Recovery.				2-3-8-9 (11)	16.5	32.4	55.4	12.2	
		A-1-b, GrSa, brn, Wet, Rec. = 1.1 ft, Lab Note: Sample was rusty-orange color.				9-7-7-7 (14)	12.9	48.2	41.7	10.1	
20		A-1-b, SaGr, brn, Wet, Rec. = 0.8 ft, Lab Note: Sample was rusty-orange color.									
		A-2-4, SiSa, brn, Wet, Rec. = 1.0 ft				3-4-5-4 (9)	23.9		76.6	23.4	
30		A-4, SiSa, brn, Wet, Rec. = 1.4 ft				2-3-4-5 (7)	28.3		61.1	38.9	
35		31.2 ft - 36.2 ft, Gray, Quartz-muscovite-chlorite Gneiss, Milky white Quartz vein from 31.6 to 33.5 ft. Hard, Unweathered, Very good rock, BXDC	1 (40)	100 (84)	5	Top of Bedrock @ 31.2 ft					
		36.2 ft - 41.2 ft, Gray, Quartz-muscovite-chlorite Gneiss, Hard, Unweathered, Very good rock, BXDC	2 (40)	96 (96)	4						
40		Hole stopped @ 41.2 ft			4						
Notes:		1. Stratification lines represent approximate boundary between material types. Transition may be gradual. 2. N Values have not been corrected for hammer energy. CE is the hammer energy correction factor. 3. Water level readings have been made at times and under conditions stated. Fluctuations of groundwater may occur due to other factors than those present at the time measurements were made.									


ABUT. NO. 2  
BOTTOM OF PILE CAP  
ELEV. 482.50

EST. PILE TIP  
ELEV. 456.90

BORING LOG 2 JOHNSON BRF 030-2(26).GPR VERMONT AOT.GDT 7/18/11


PROJECT NAME: JOHNSON  
PROJECT NUMBER: BRF 030-2(26)

FILE NAME: s88b193bor.dgn PLOT DATE: 10-JUN-2014  
PROJECT LEADER: C. CARLSON DRAWN BY: R. PELLET  
DESIGNED BY: H. SALLS CHECKED BY: H. SALLS  
BORING LOG (2) SHEET 25 OF 69

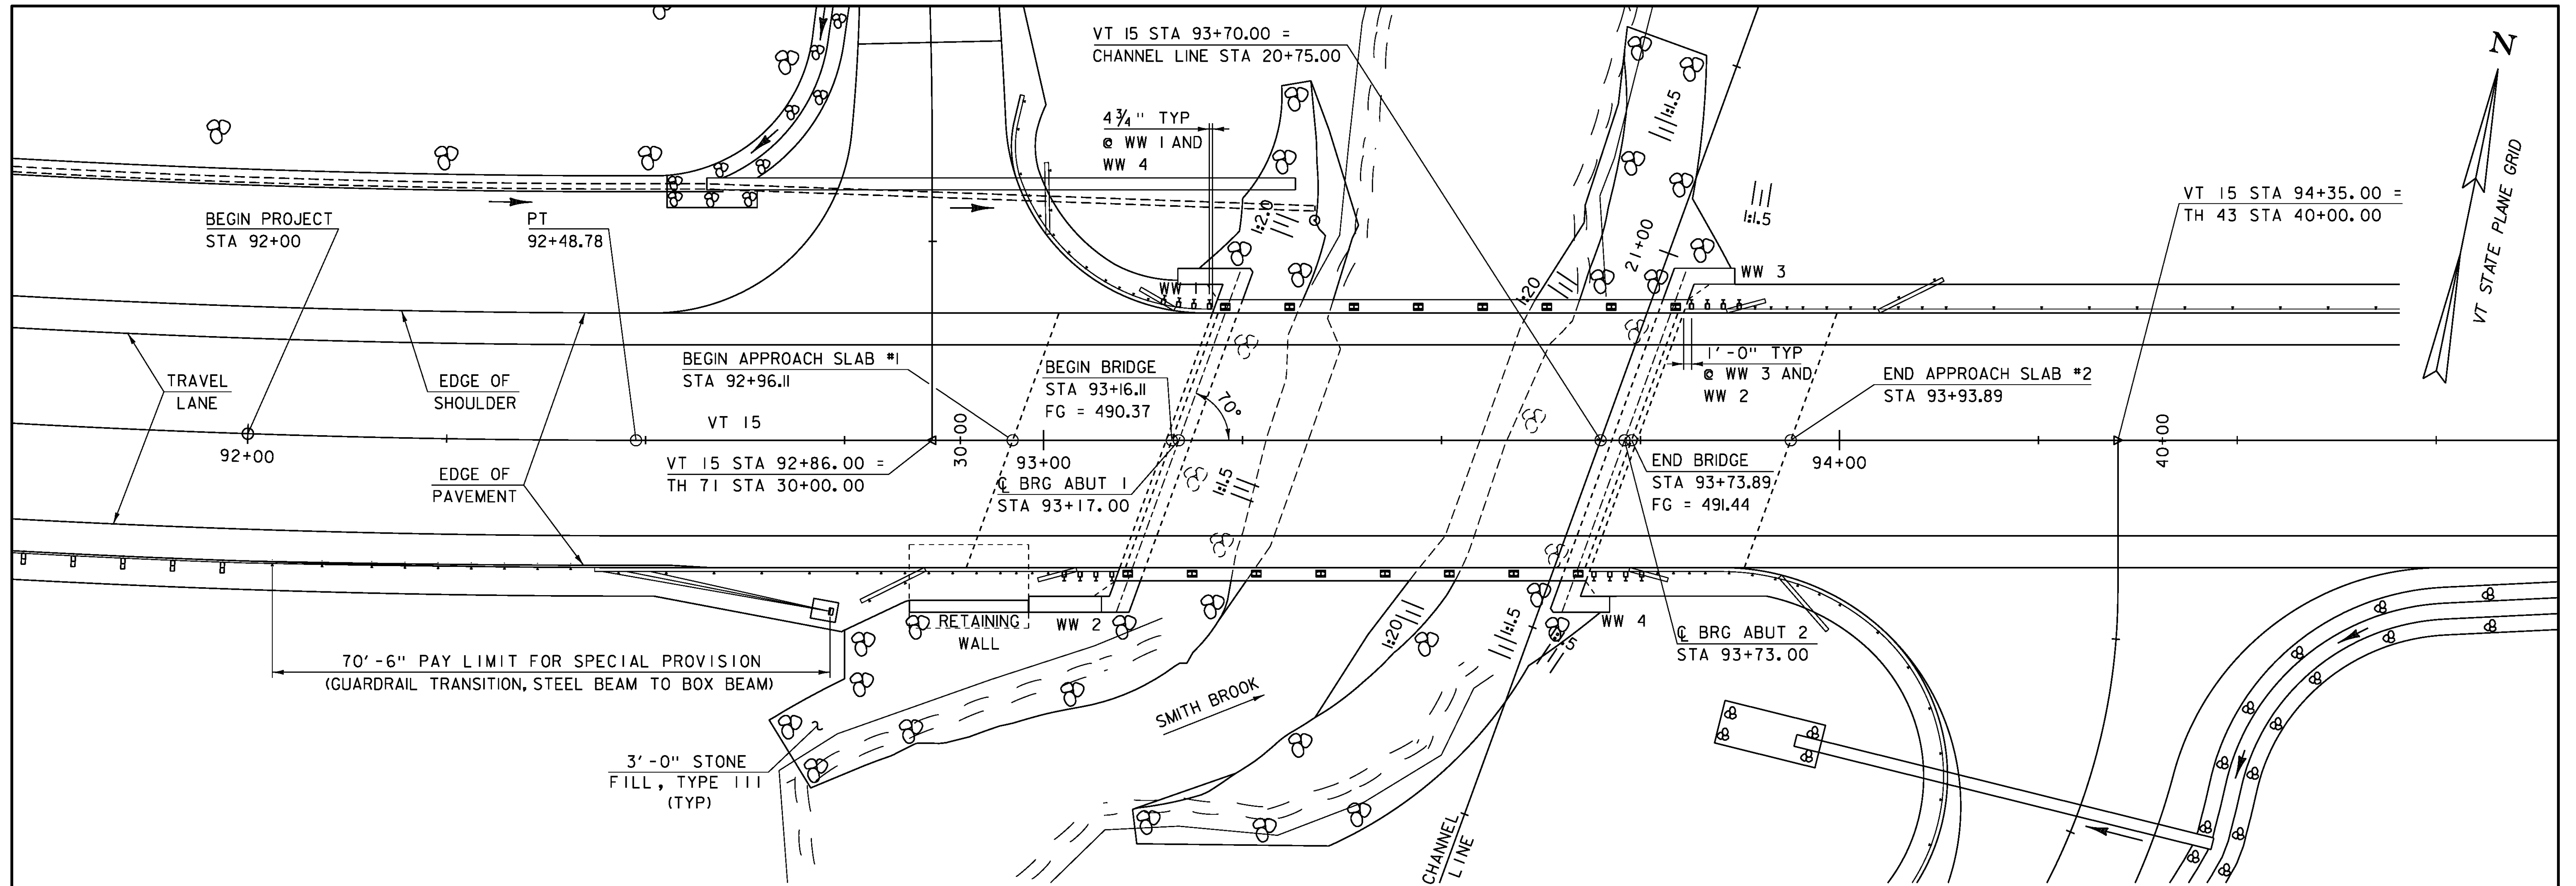

PLAN


SCALE 1" = 10'-0"  
 10 0 10

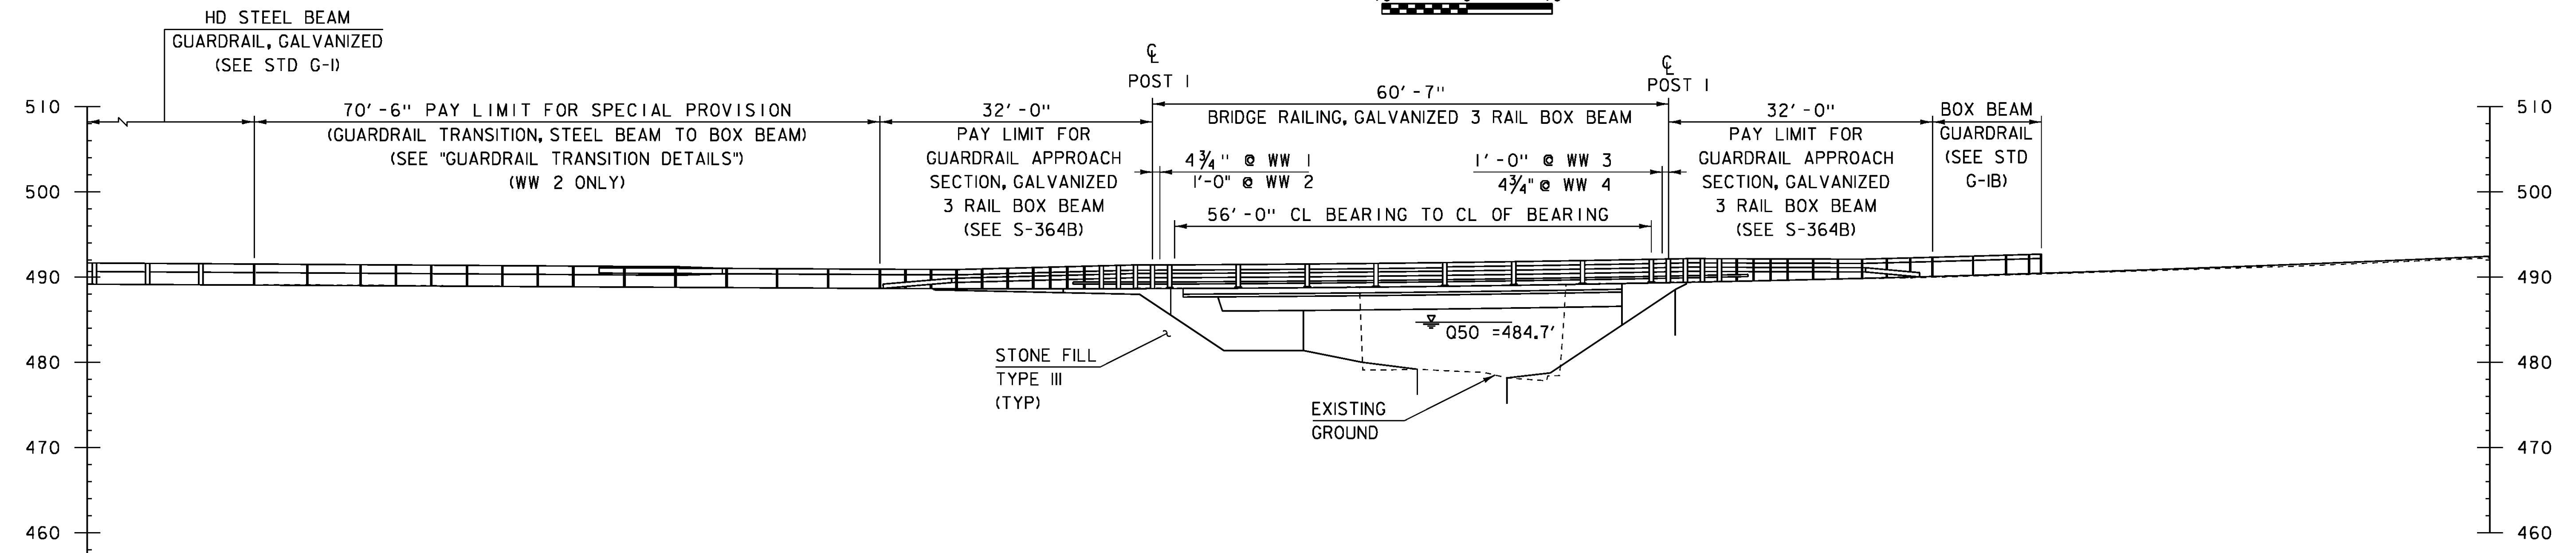


ELEVATION

SCALE 1" = 10'-0"  
 10 0 10

PROJECT NAME:	JOHNSON	PLOT DATE:	10-JUN-2014
PROJECT NUMBER:	BRF 030-2(26)	DRAWN BY:	R. PELLETT
FILE NAME:	s88b193pe.dgn	DESIGNED BY:	H. SALLS
PROJECT LEADER:	C. CARLSON	CHECKED BY:	H. SALLS
PLAN AND ELEVATION		SHEET	26 OF 69

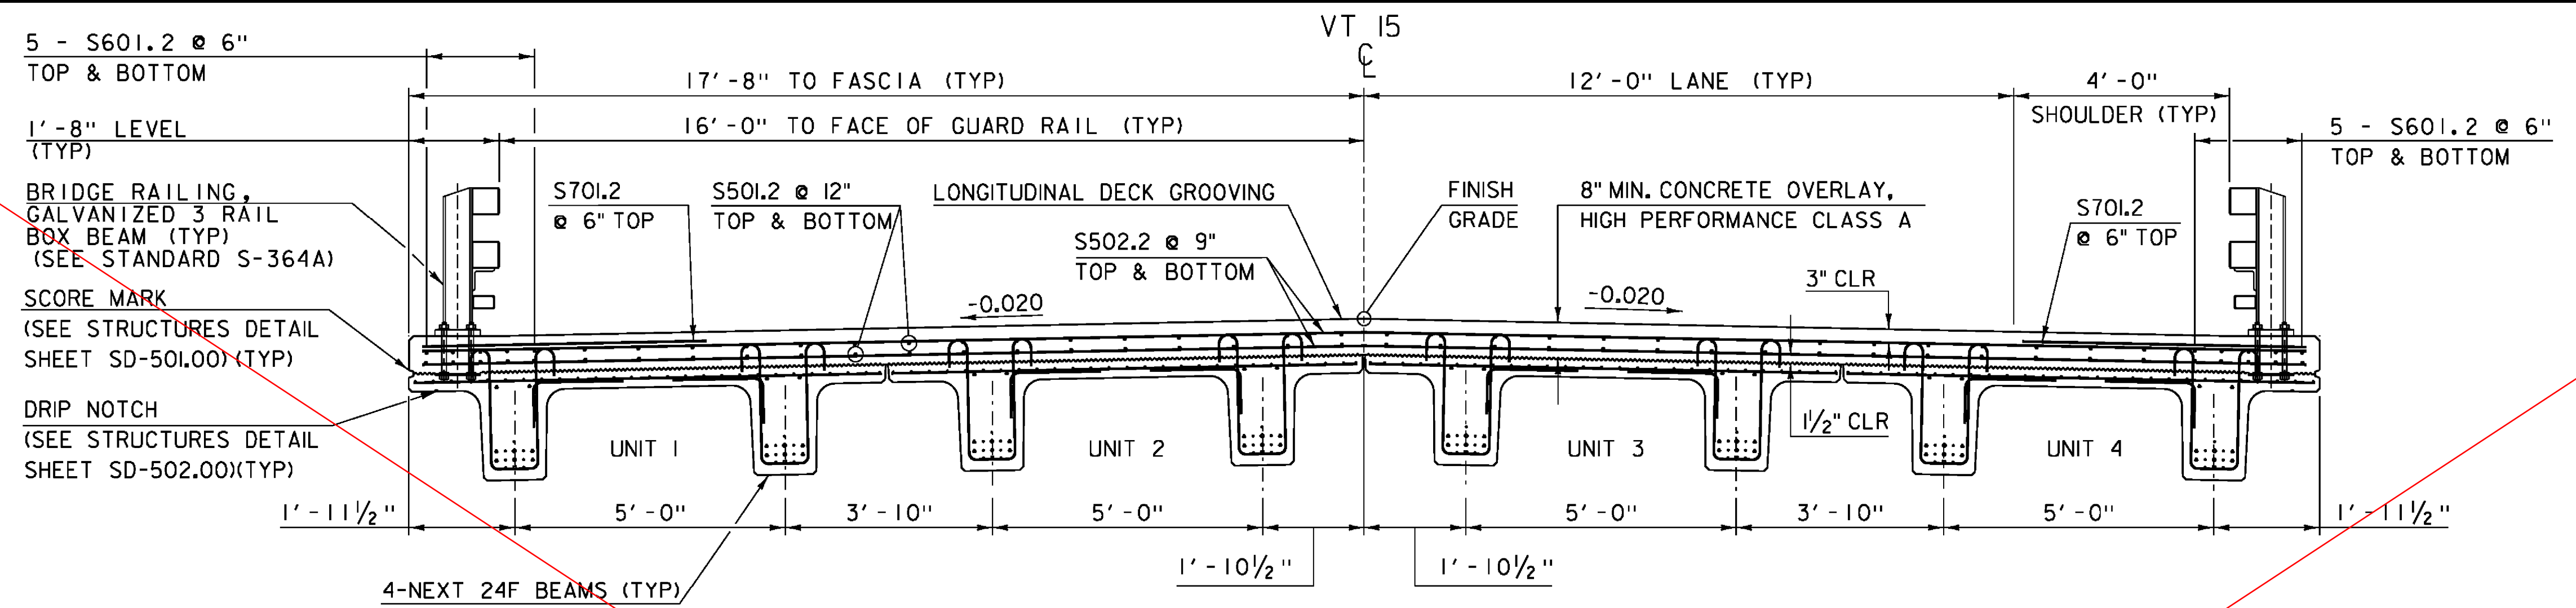

**BRIDGE TYPICAL SECTION**  
SCALE: 1/2" = 1'-0"

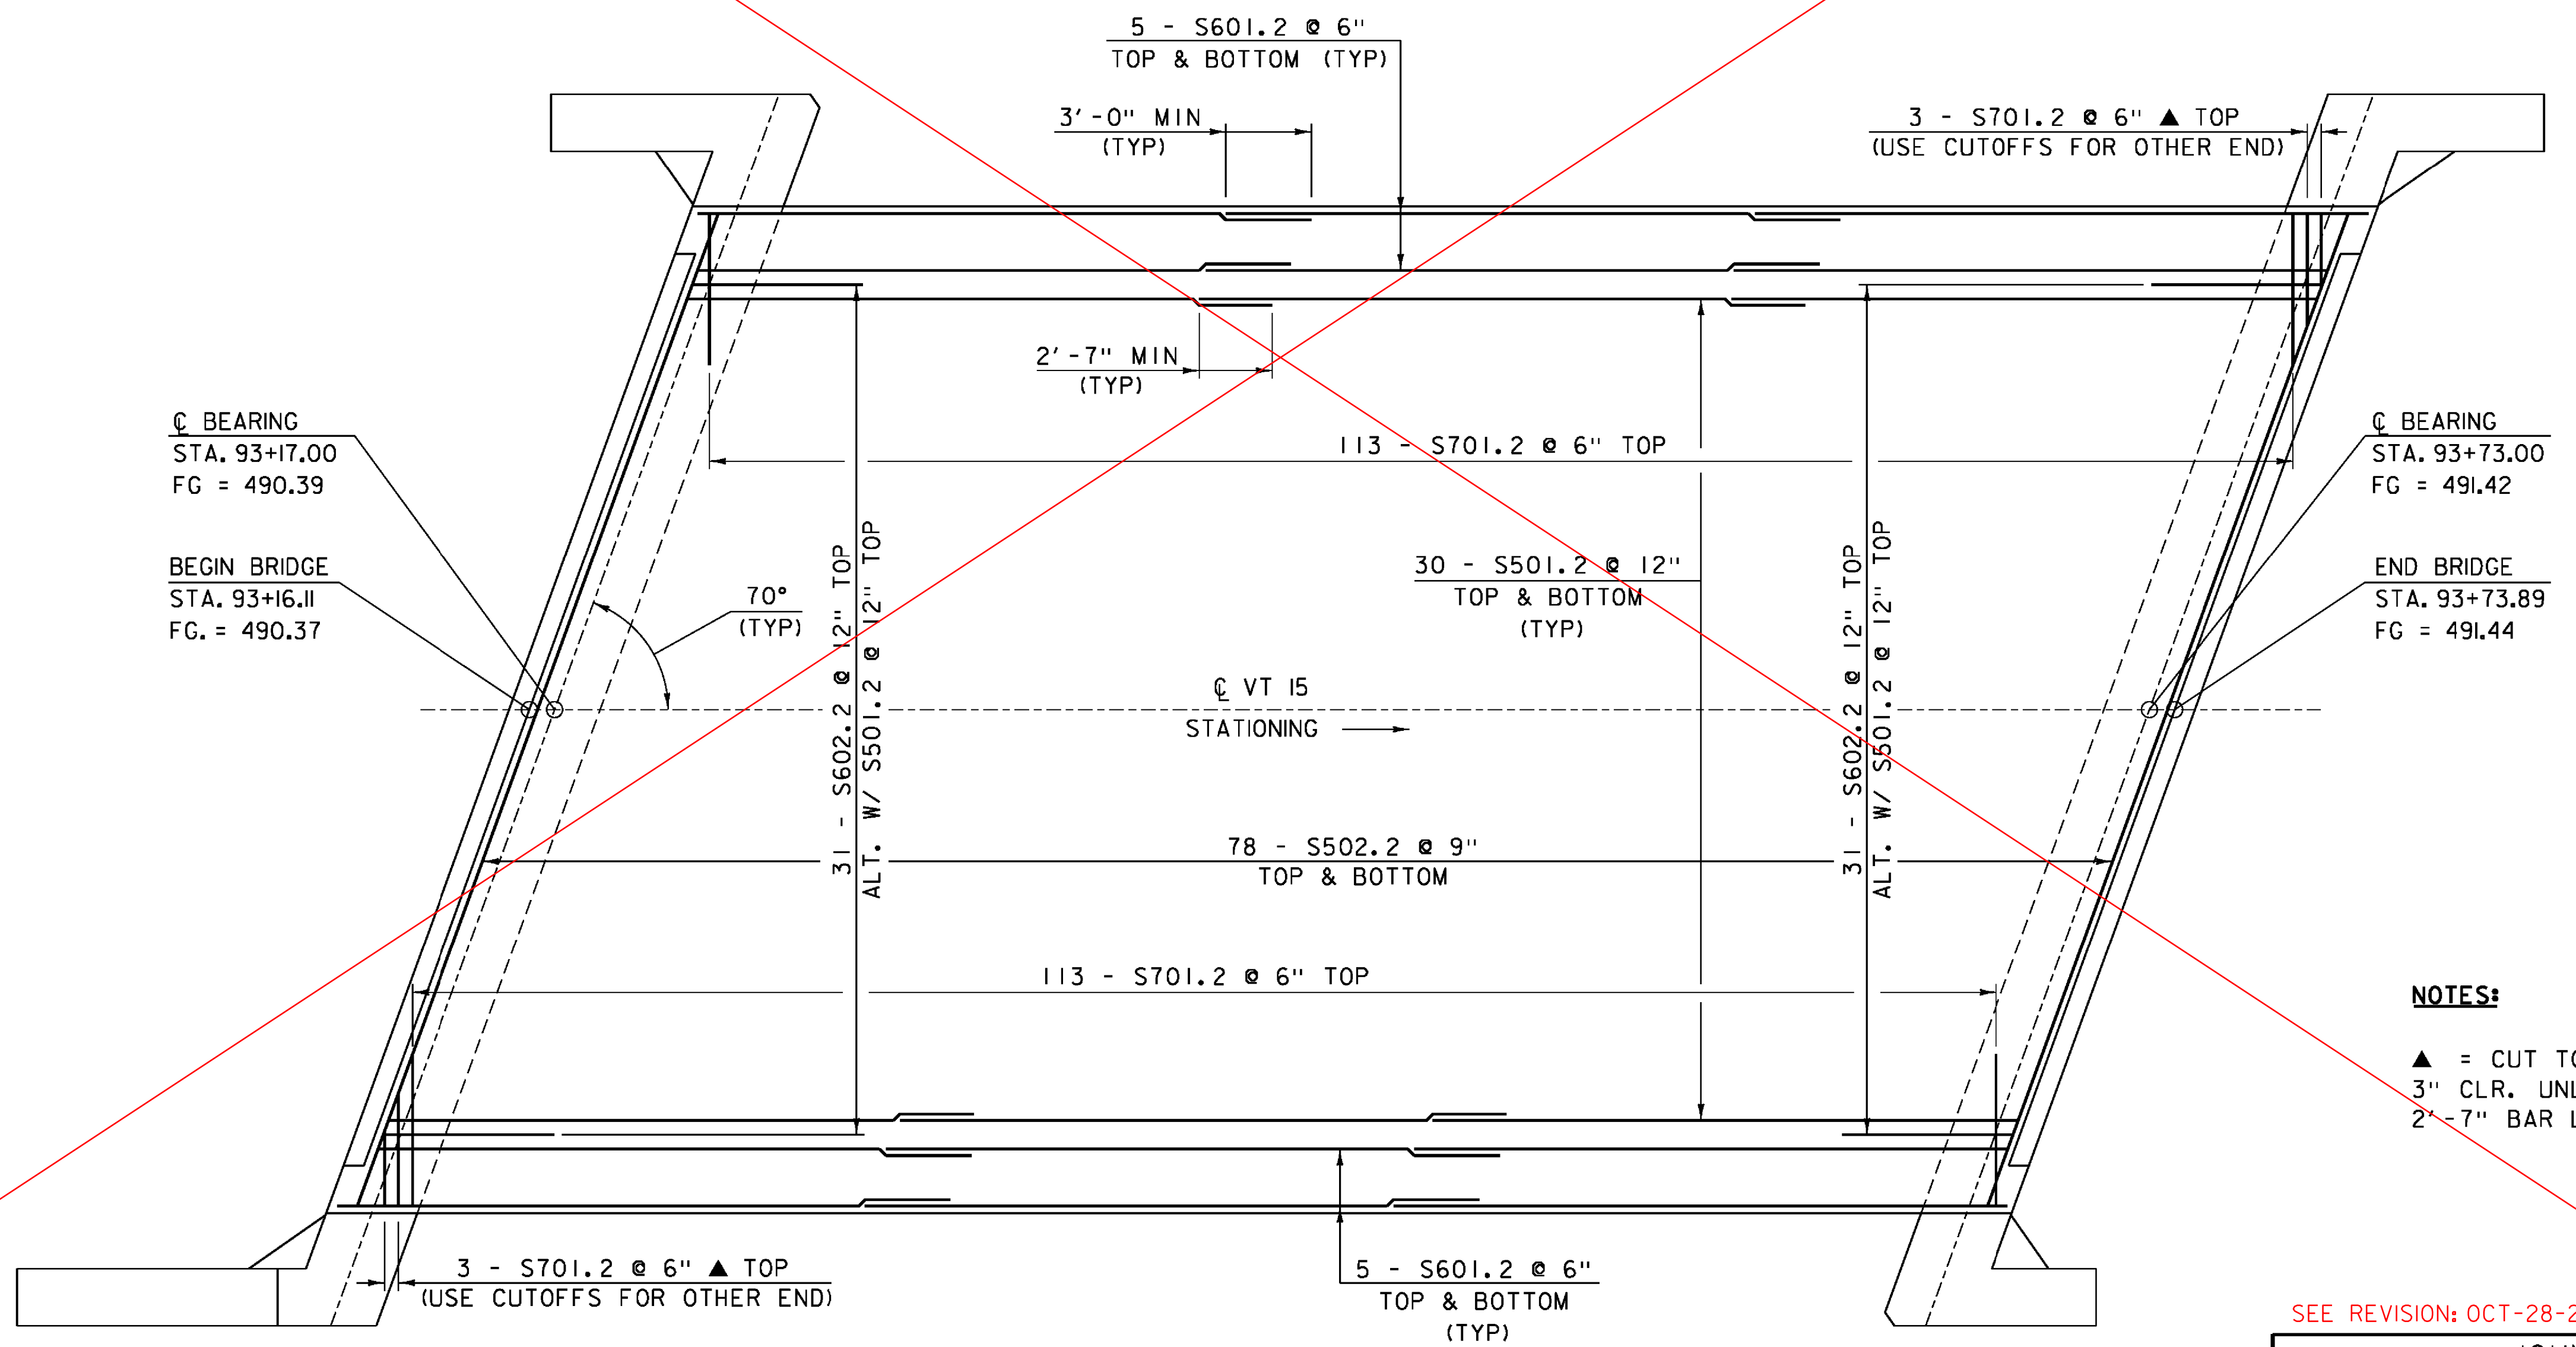


**OVERLAY REINFORCING PLAN**  
SCALE: 1/4" = 1'-0"

**NOTES:**  
▲ = CUT TO FIT IN FIELD  
3" CLR. UNLESS OTHERWISE NOTED  
2'-7" BAR LAP UNLESS OTHERWISE NOTED


SEE REVISION: OCT-28-2014

PROJECT NAME:	JOHNSON	PLOT DATE:	10-JUN-2014
PROJECT NUMBER:	BRF 030-2(26)	DRAWN BY:	G. ROKES
FILE NAME:	s88bi93sup.dgn	CHECKED BY:	H. SALLS
PROJECT LEADER:	C. CARLSON	SHEET	27 OF 69
DESIGNED BY:	H. SALLS		
BRIDGE DECK DETAILS			

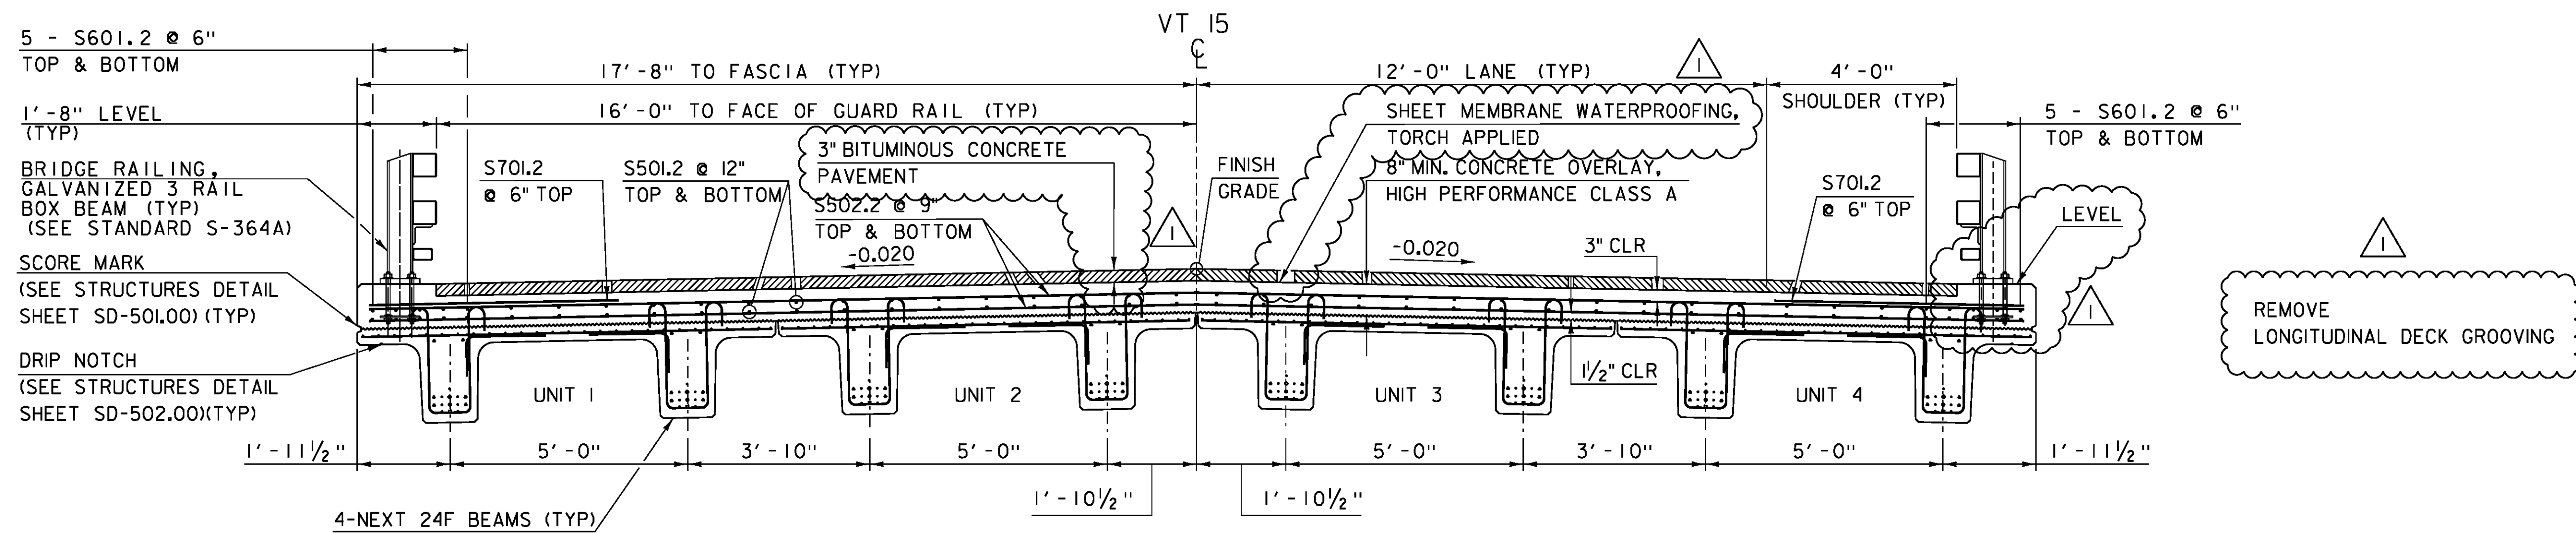

**BRIDGE TYPICAL SECTION**

SCALE: 1/2" = 1'-0"

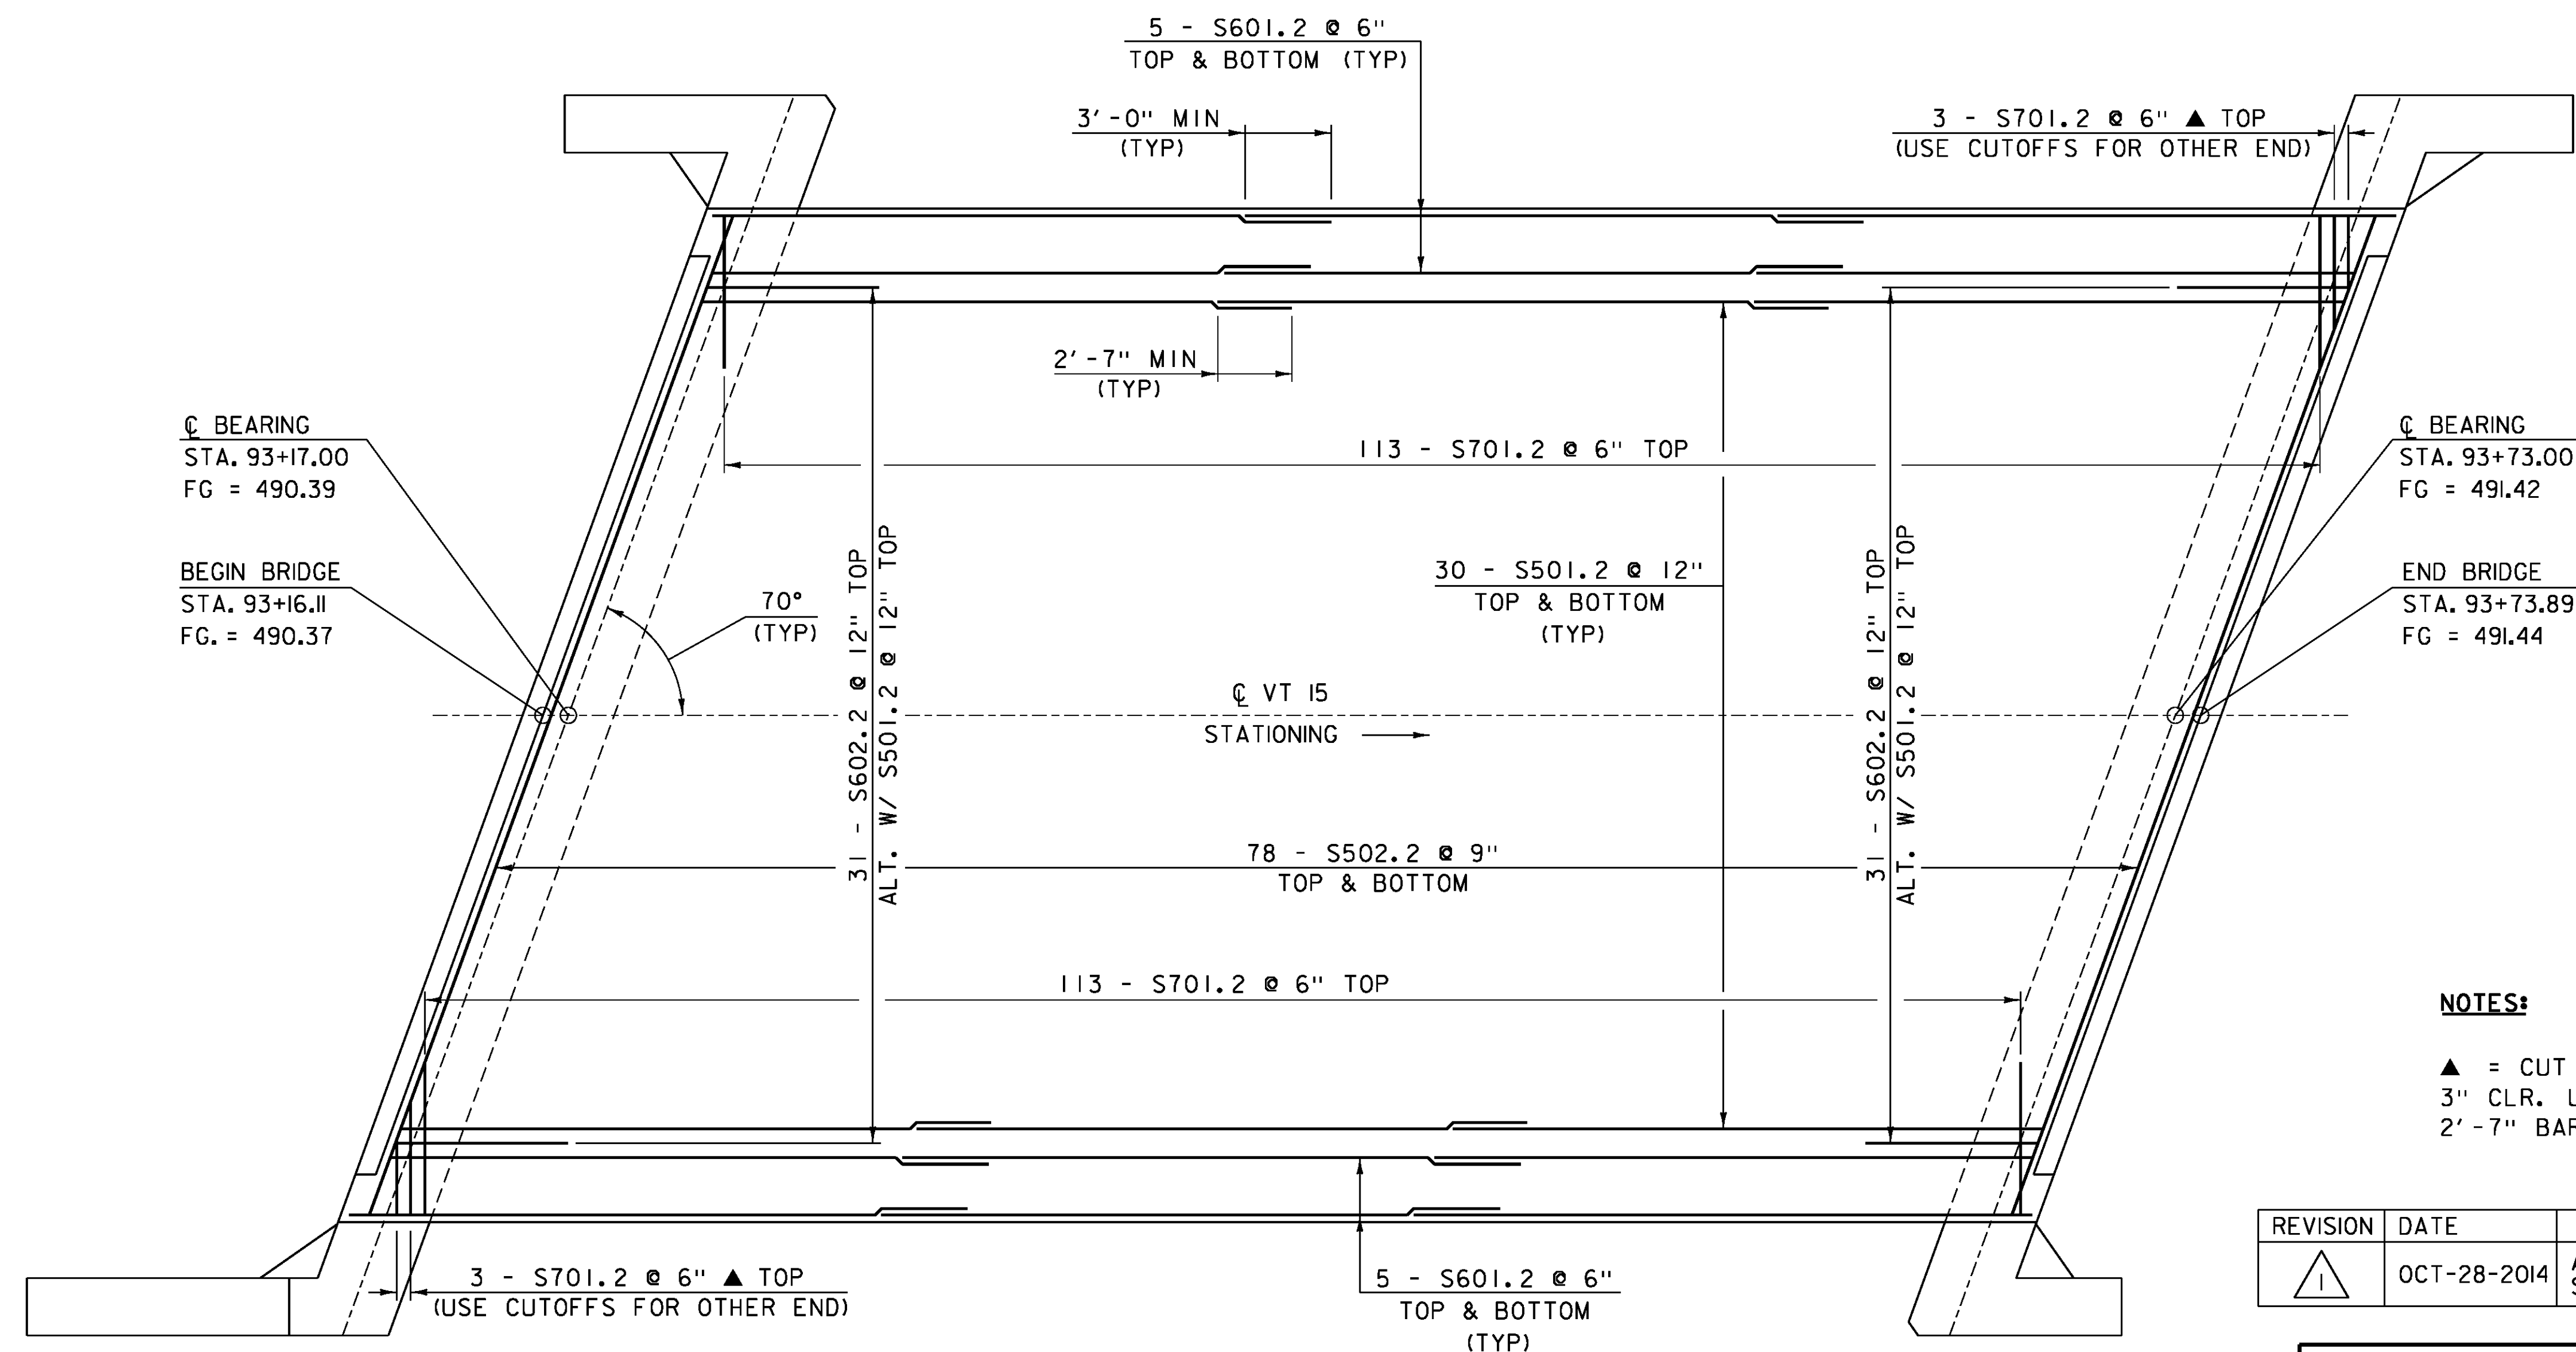

**OVERLAY REINFORCING PLAN**

SCALE: 1/4" = 1'-0"

REMOVE LONGITUDINAL DECK GROOVING


**NOTES:**

- ▲ = CUT TO FIT IN FIELD
- 3" CLR. UNLESS OTHERWISE NOTED
- 2'-7" BAR LAP UNLESS OTHERWISE NOTED


REVISION	DATE	DESCRIPTION	BY
1	OCT-28-2014	ADD 3" PAYMENT, LOWER BRIDGE SEAT, ADD 3" CONCRETE PEDESTAL	GNR

PROJECT NAME: JOHNSON  
PROJECT NUMBER: BRF 030-2(26)


FILE NAME: s88bl93sup.dgn PLOT DATE: 05-NOV-2014  
PROJECT LEADER: C. CARLSON DRAWN BY: G. ROKES  
DESIGNED BY: H. SALLS CHECKED BY: H. SALLS  
BRIDGE DECK DETAILS SHEET 27 OF 69

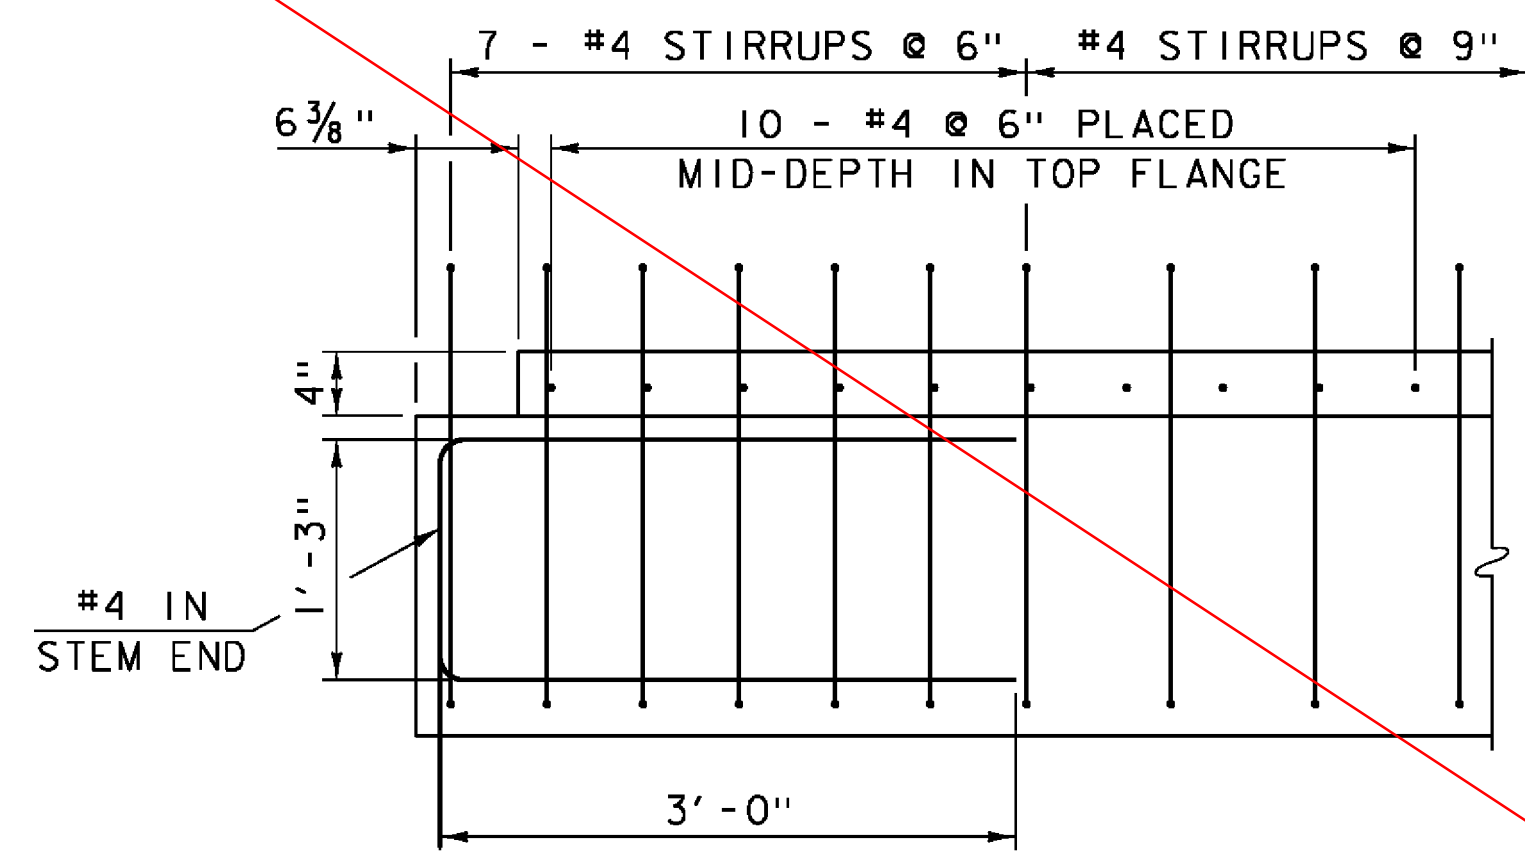


**STEM END - SIDE ELEVATION**  
SCALE: 1" = 1'-0"

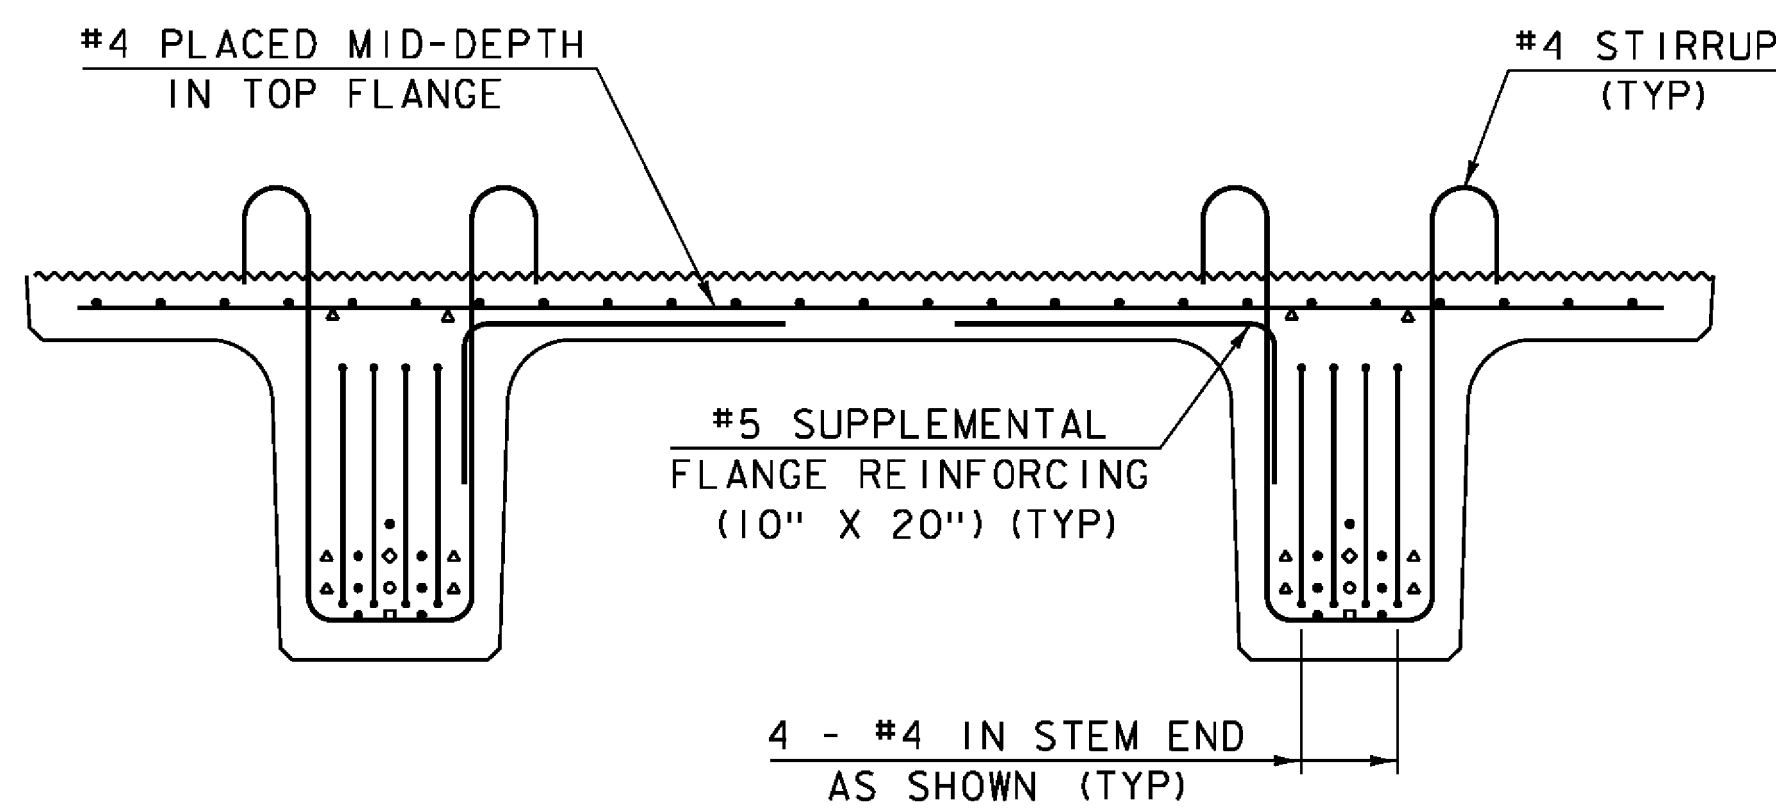


**STEM END - END ELEVATION**  
SCALE: 1" = 1'-0"

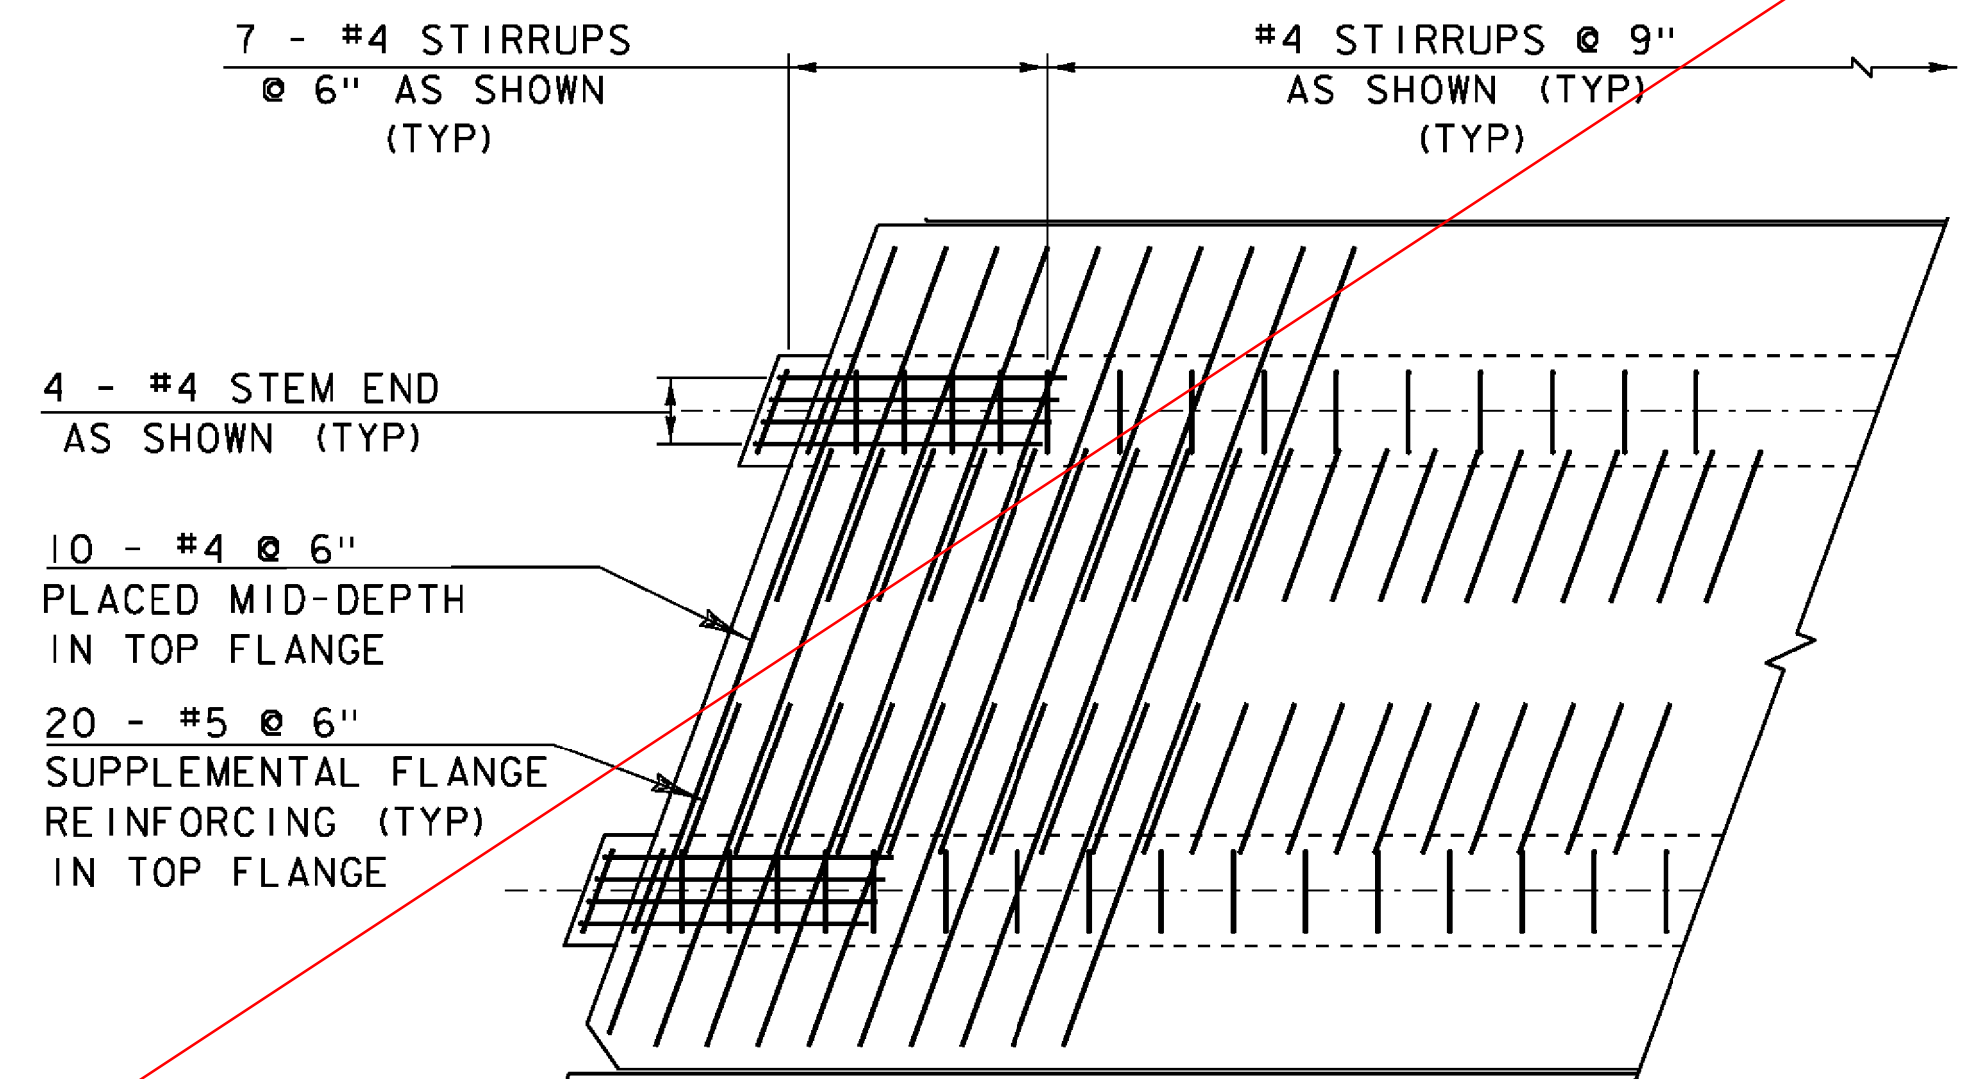

**STEM END - PLAN**  
SCALE: 1/2" = 1'-0"

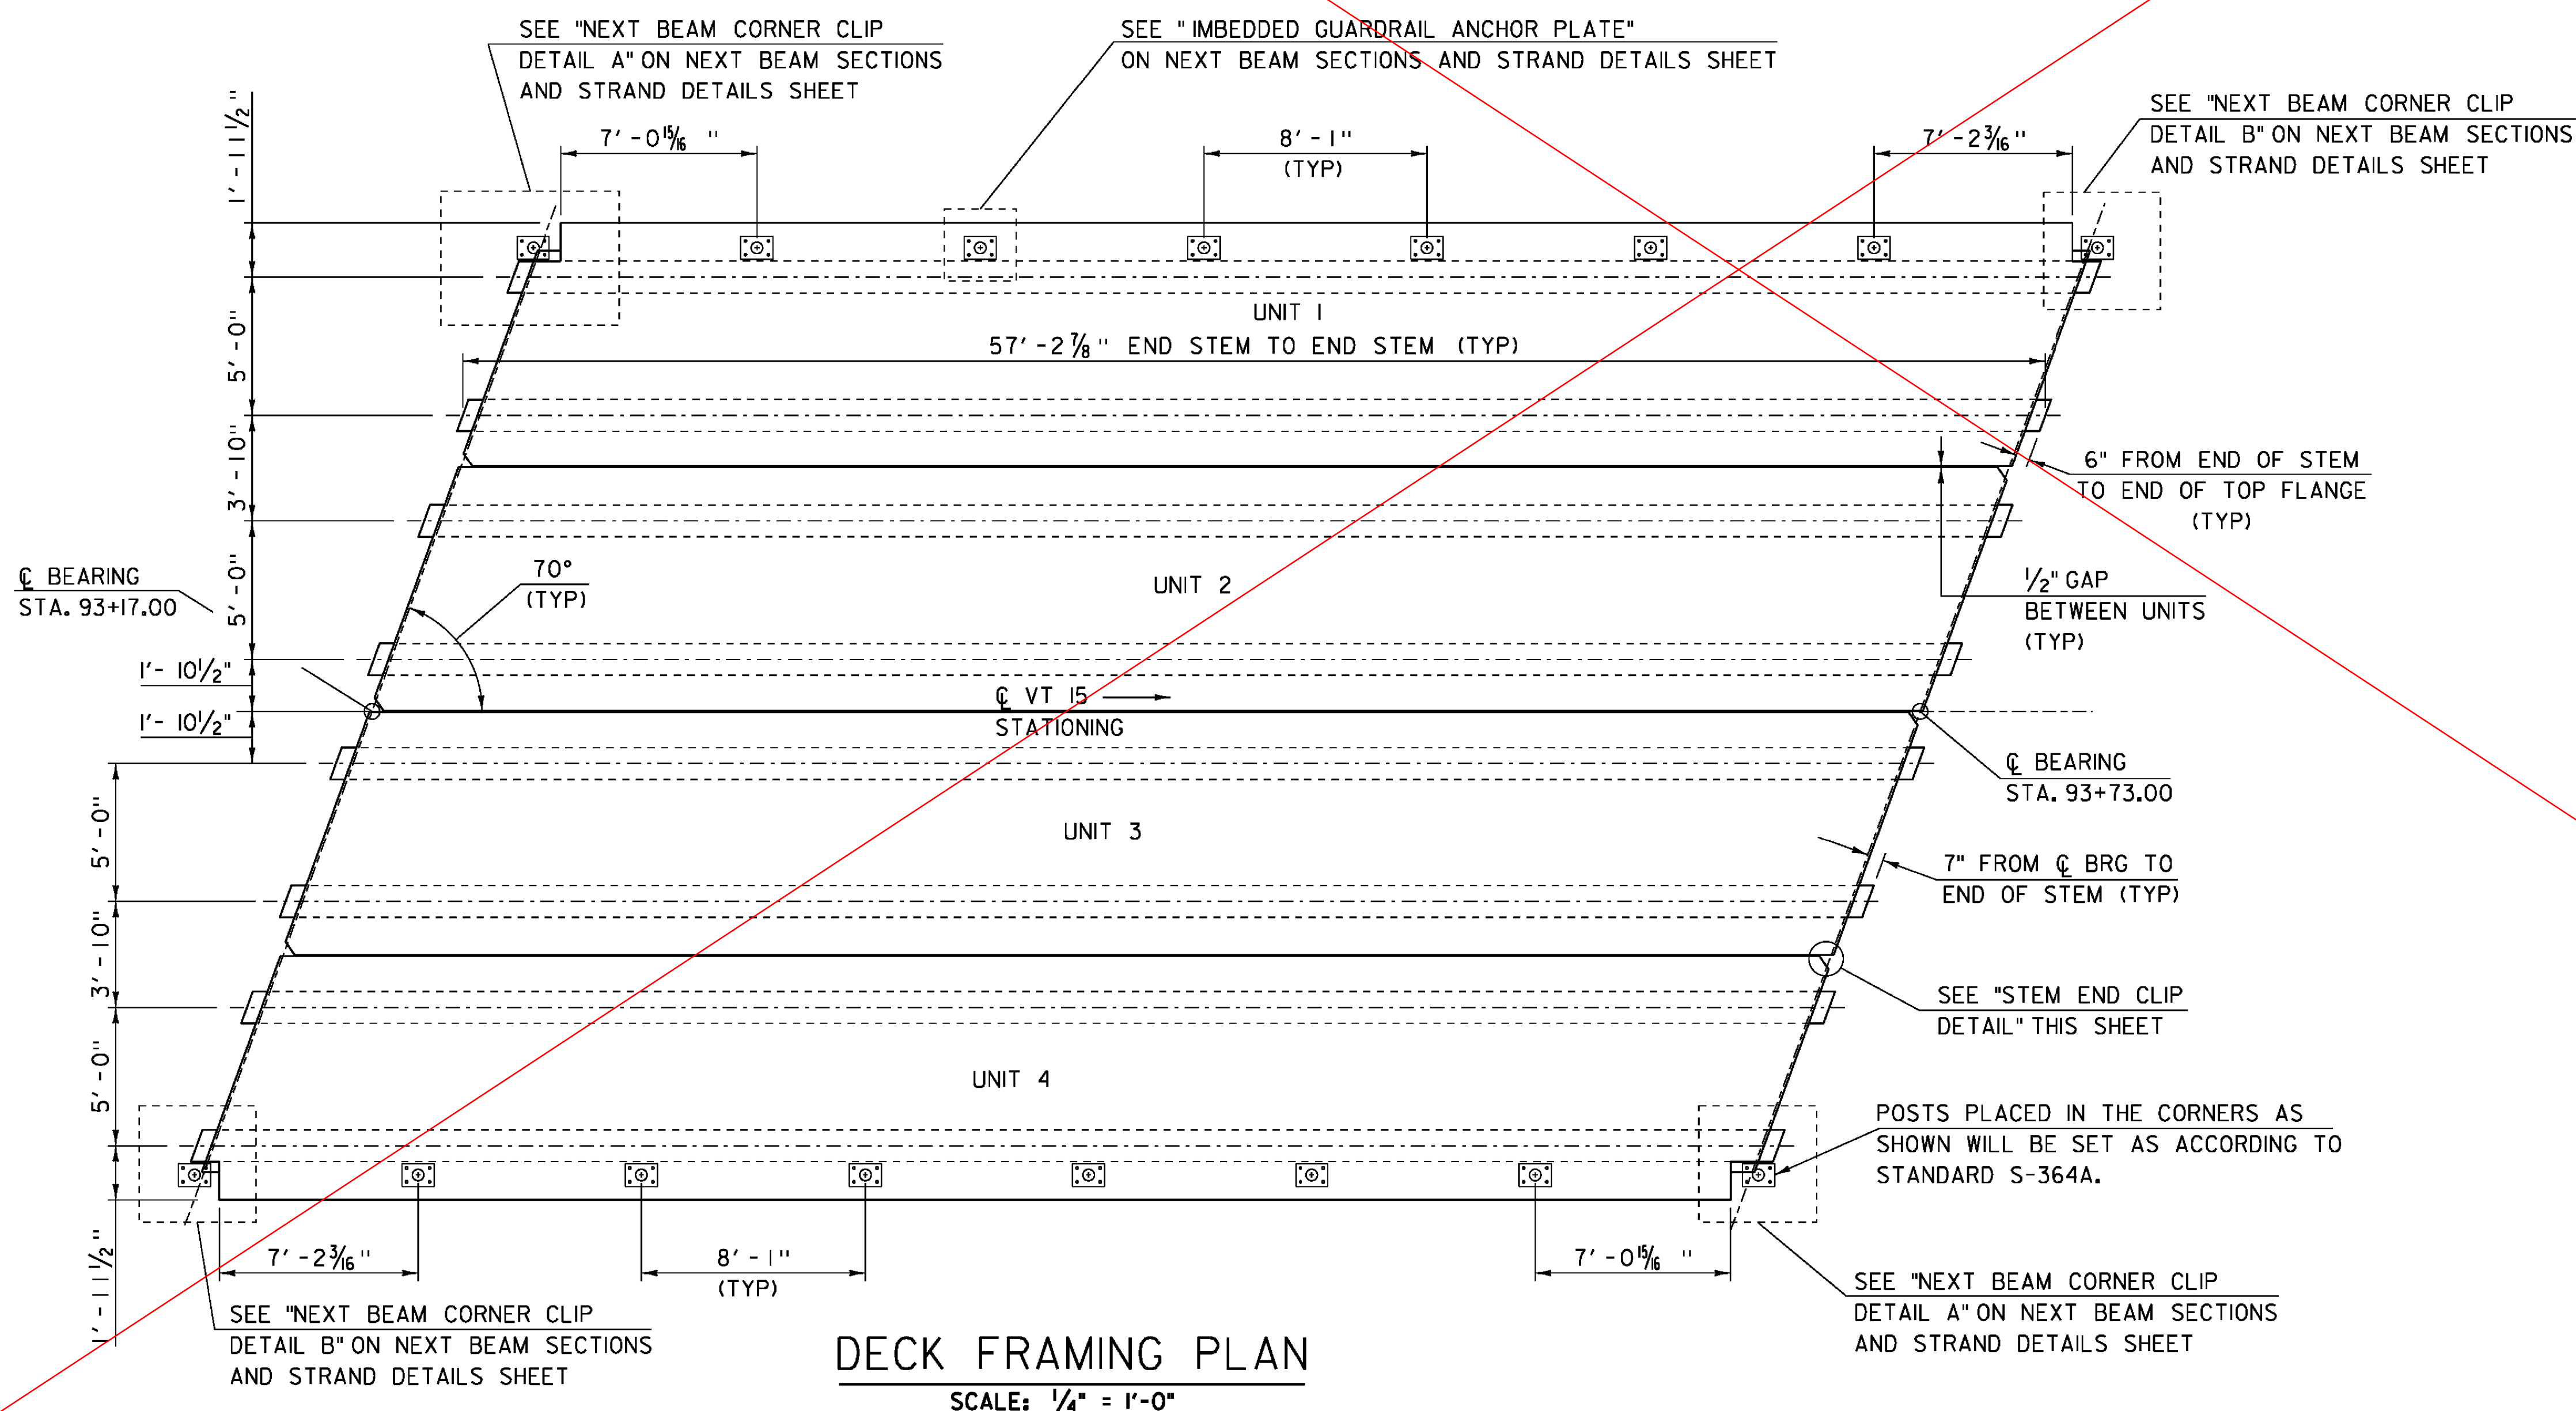


**DECK FRAMING PLAN**  
SCALE: 1/4" = 1'-0"

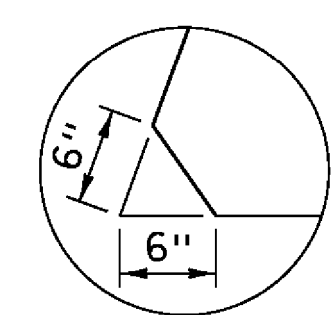


**TOP FLANGE CLIP DETAIL**  
SCALE: 1" = 1'-0"

SEE REVISION: OCT-28-2014


PROJECT NAME:	JOHNSON	PLOT DATE:	10-JUN-2014
PROJECT NUMBER:	BRF 030-2(26)	DRAWN BY:	G. ROKES
FILE NAME:	s88bi93sup.dgn	DESIGNED BY:	H. SALLS
PROJECT LEADER:	C. CARLSON	CHECKED BY:	H. SALLS
FRAMING PLAN AND STEM END DETAILS		SHEET	28 OF 69

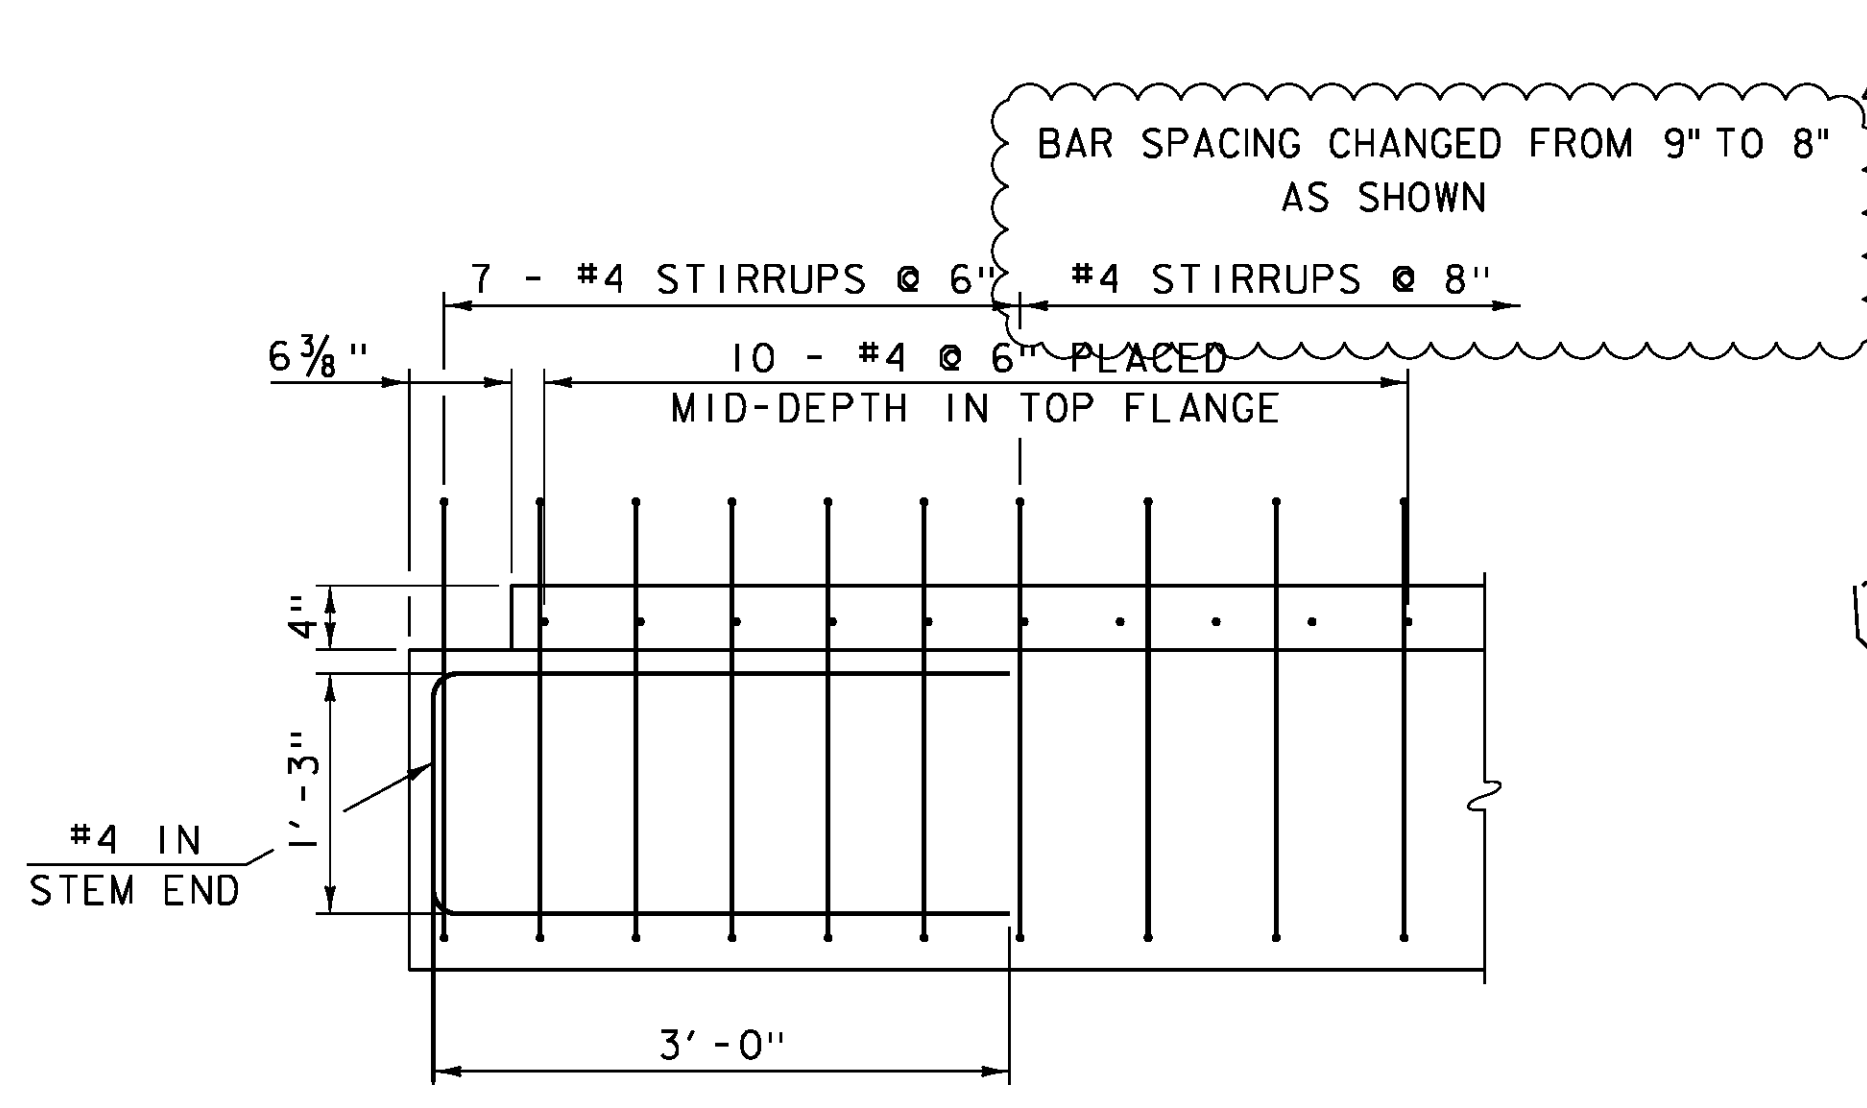


**STEM END - SIDE ELEVATION**  
SCALE: 1" = 1'-0"

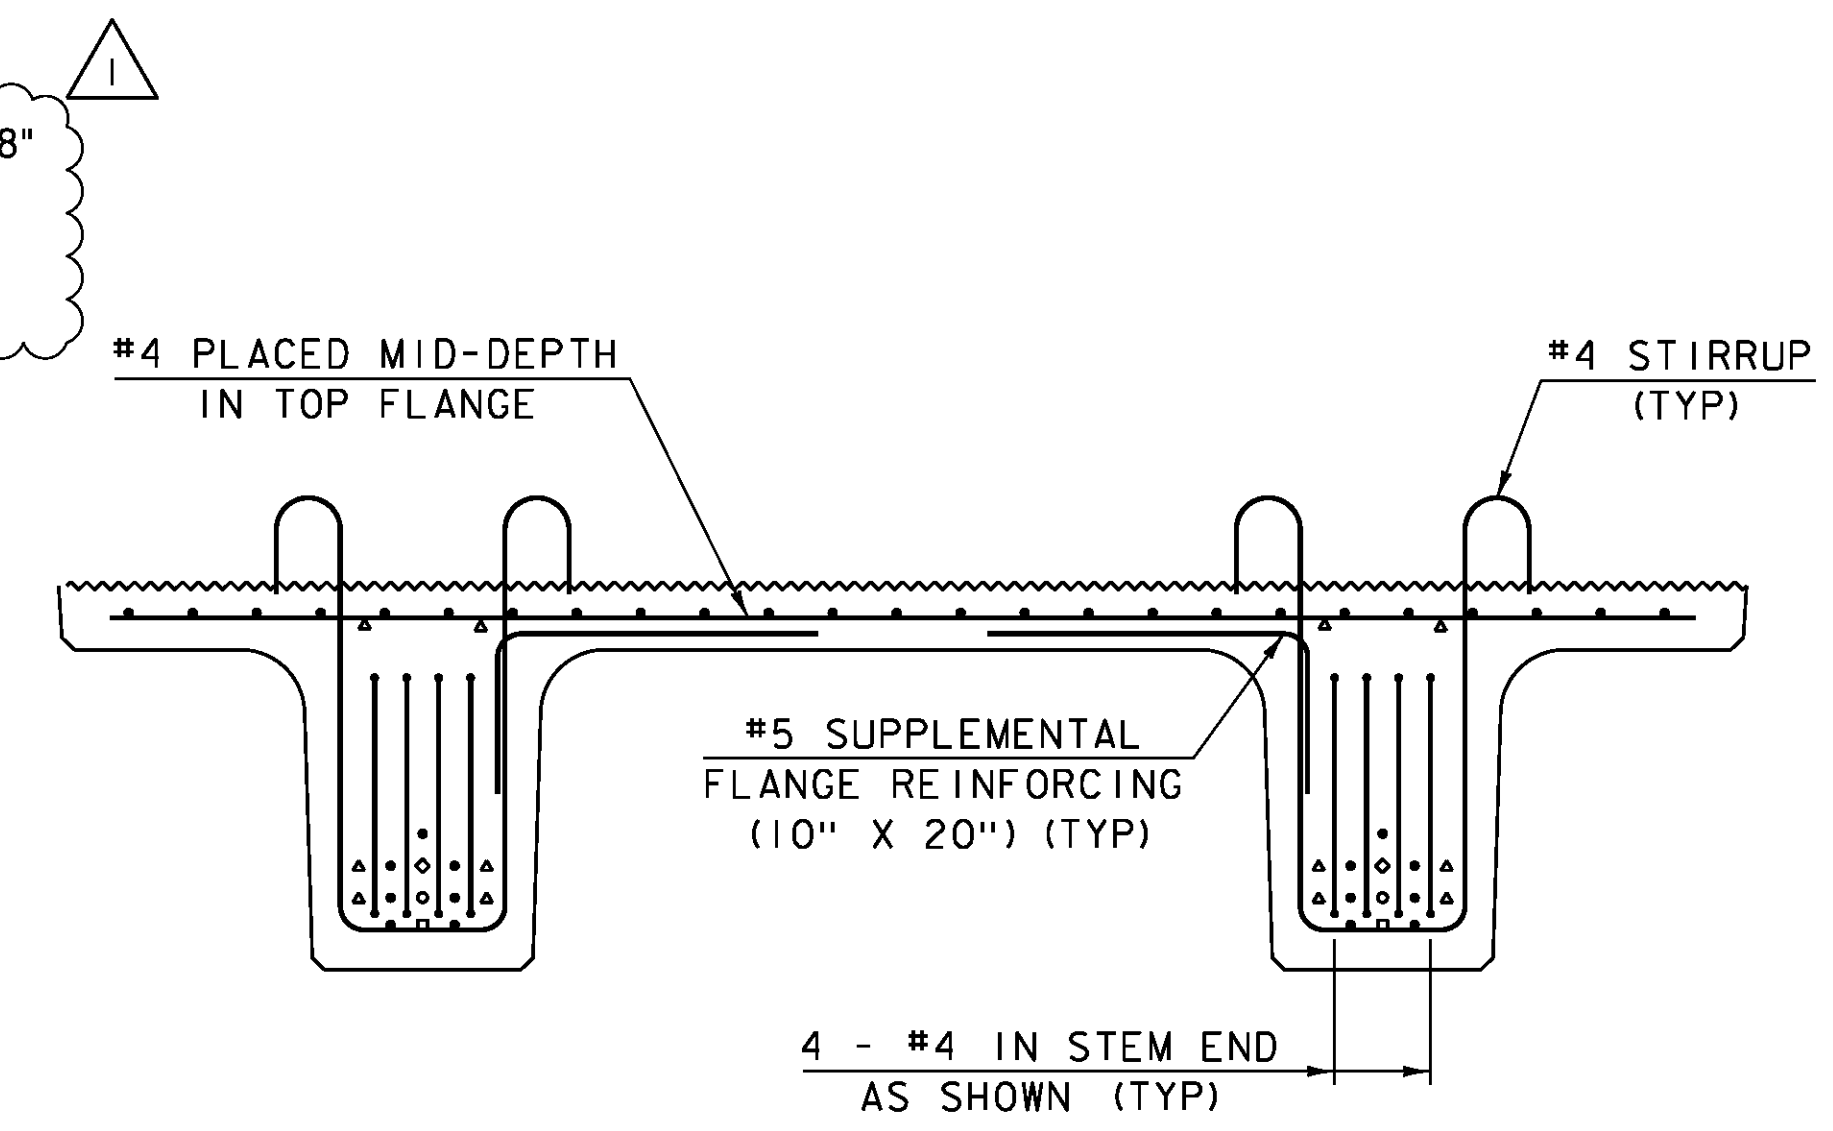


**STEM END - END ELEVATION**  
SCALE: 1" = 1'-0"

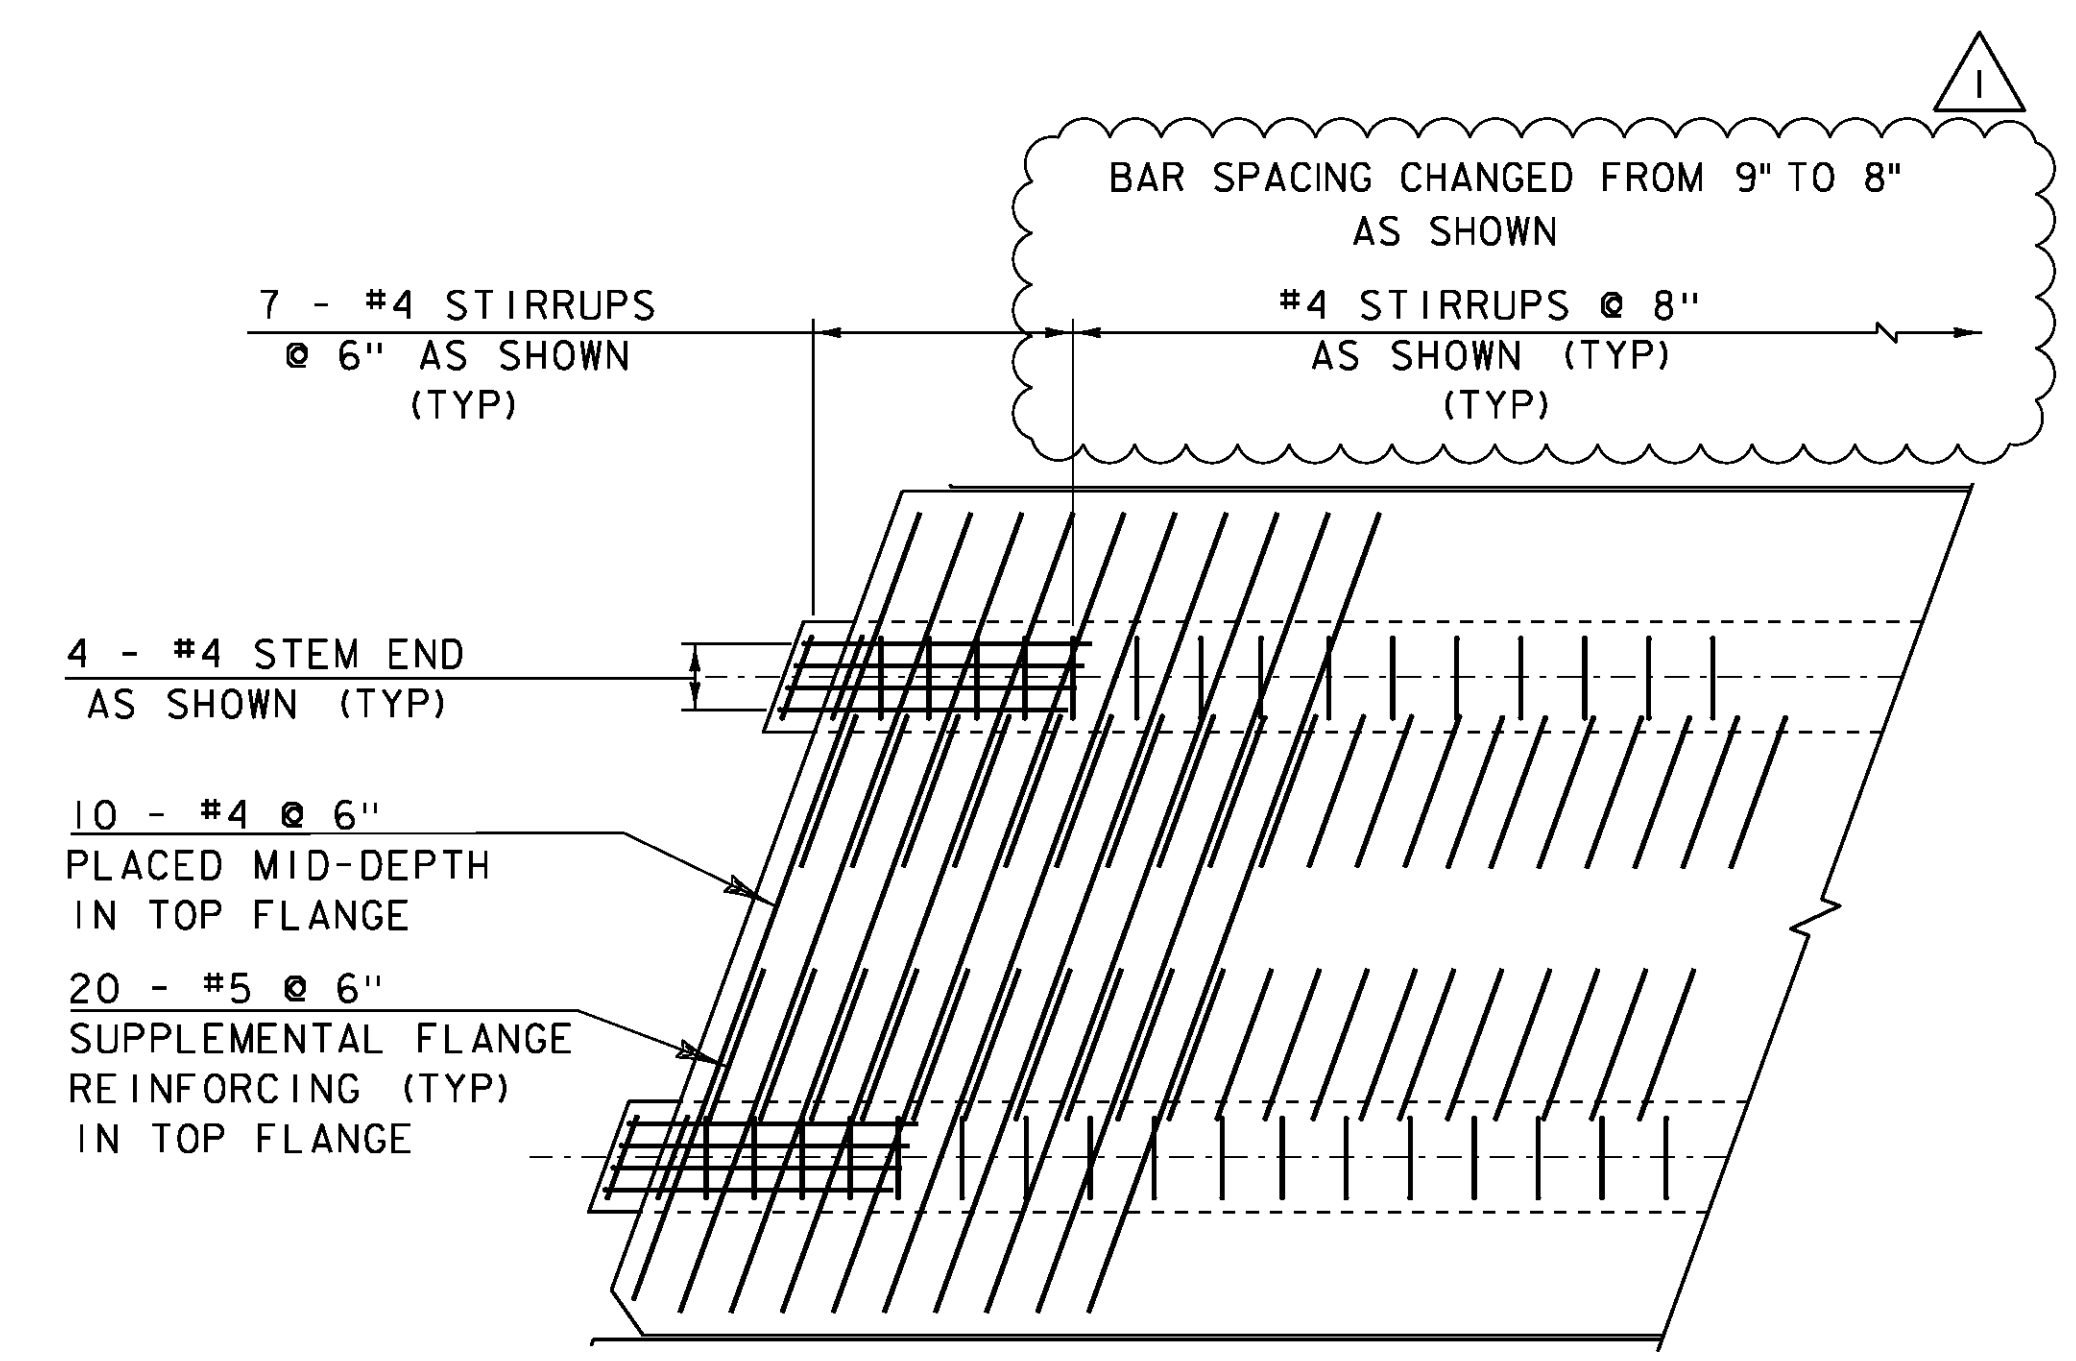

**STEM END - PLAN**  
SCALE: 1/2" = 1'-0"

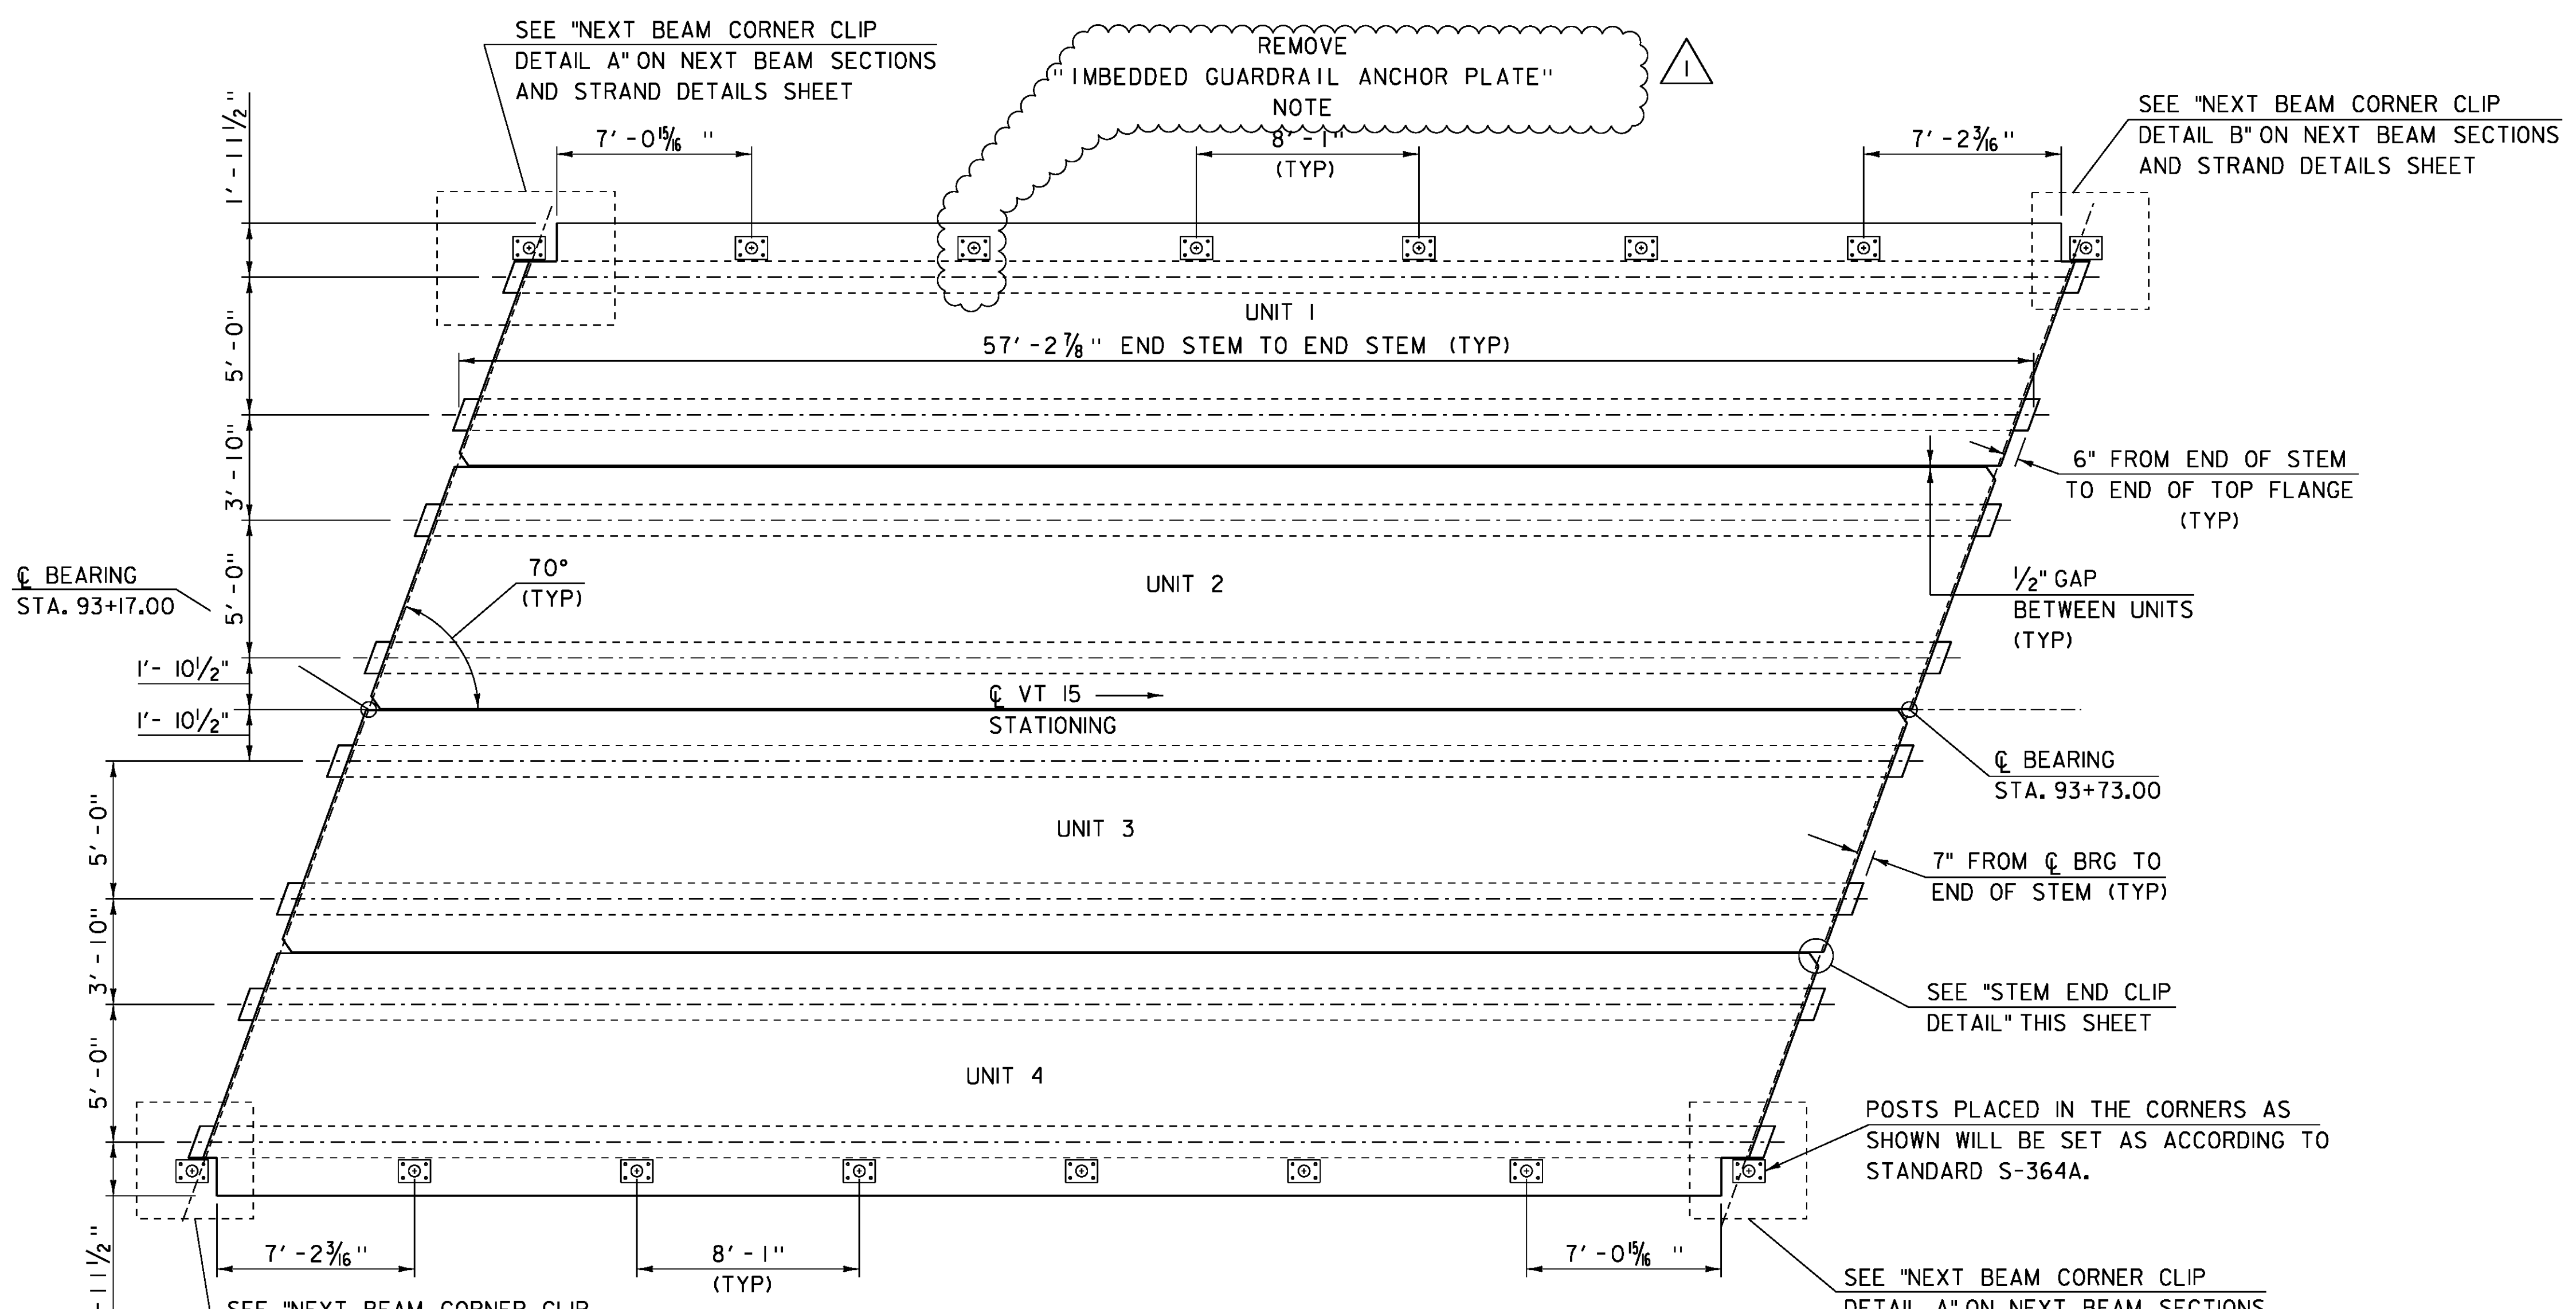









**DECK FRAMING PLAN**  
SCALE: 1/4" = 1'-0"

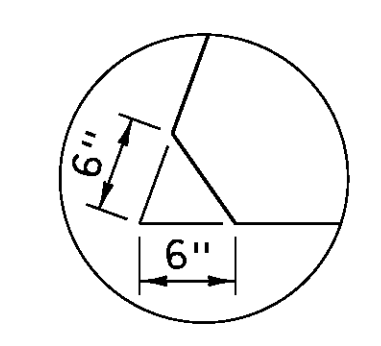

**TOP FLANGE CLIP DETAIL**  
SCALE: 1" = 1'-0"

REVISION	DATE	DESCRIPTION	BY
1	OCT-28-2014	ADD 3" PAYMENT, LOWER BRIDGE SEAT, ADD 3" CONCRETE PEDESTAL	GNR

PROJECT NAME:	JOHNSON	PLOT DATE:	05-NOV-2014
PROJECT NUMBER:	BRF 030-2(26)	DRAWN BY:	G. ROKES
FILE NAME:	s88bl93sup.dgn	CHECKED BY:	H. SALLS
PROJECT LEADER:	C. CARLSON	FRAMING PLAN AND STEM END DETAILS	SHEET 28 OF 69
DESIGNED BY:	H. SALLS		

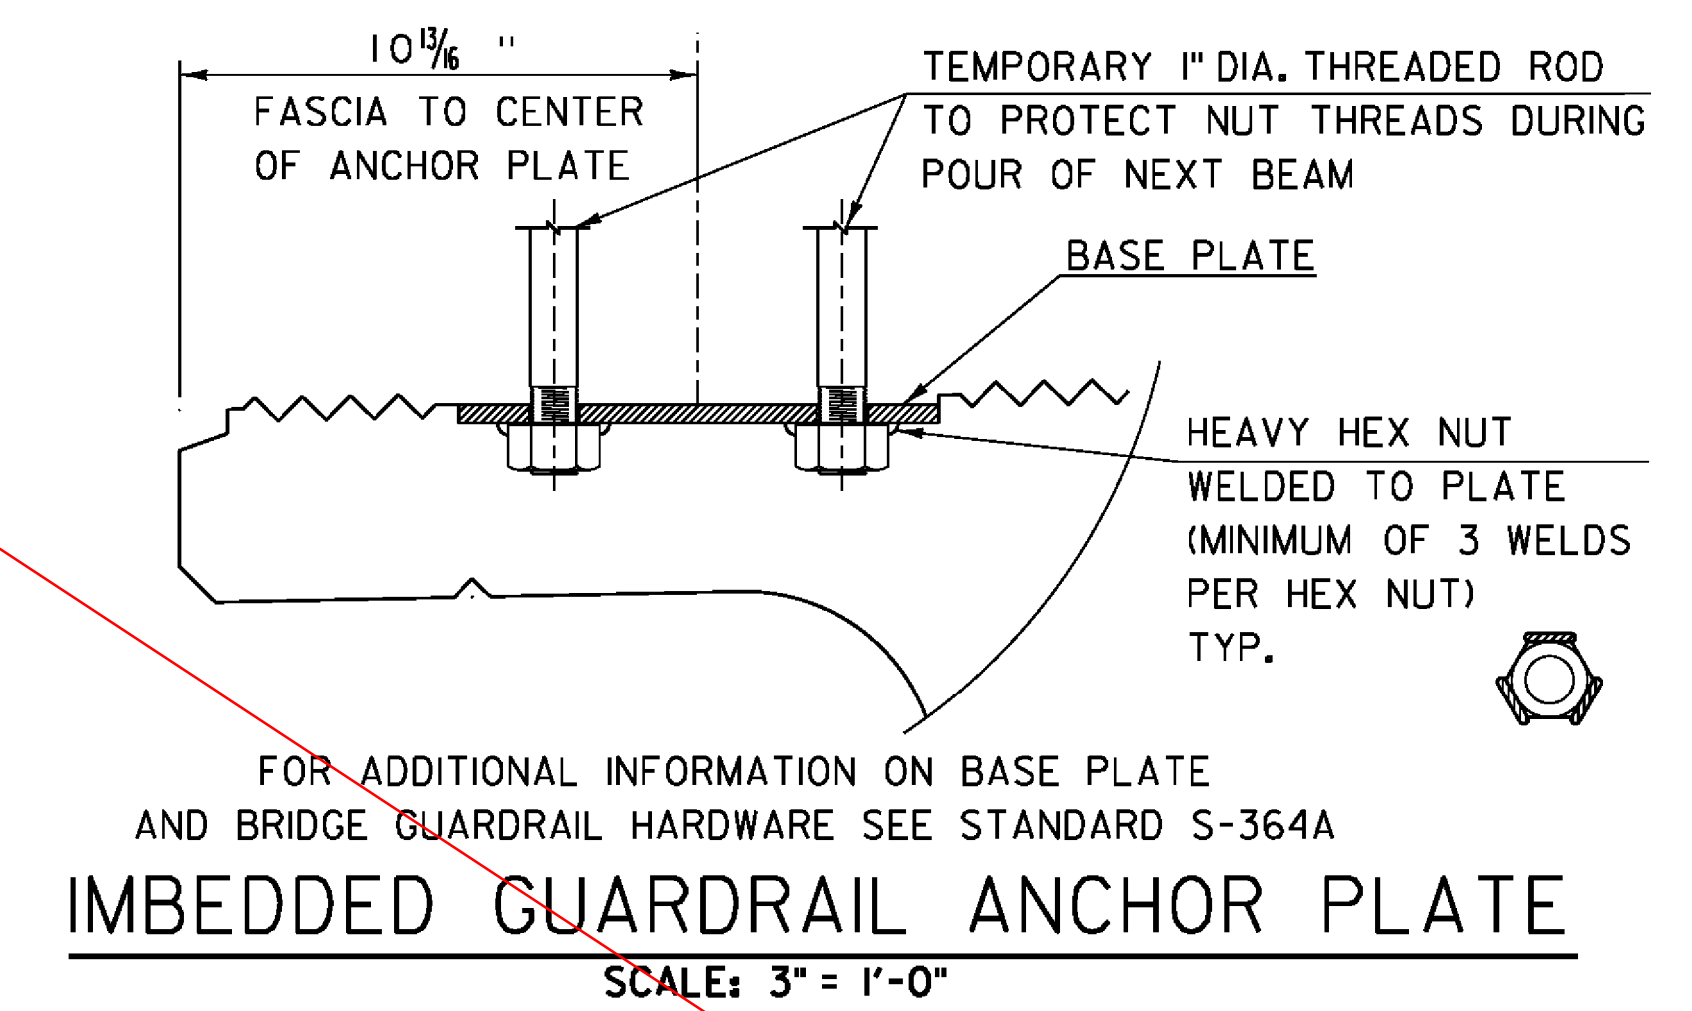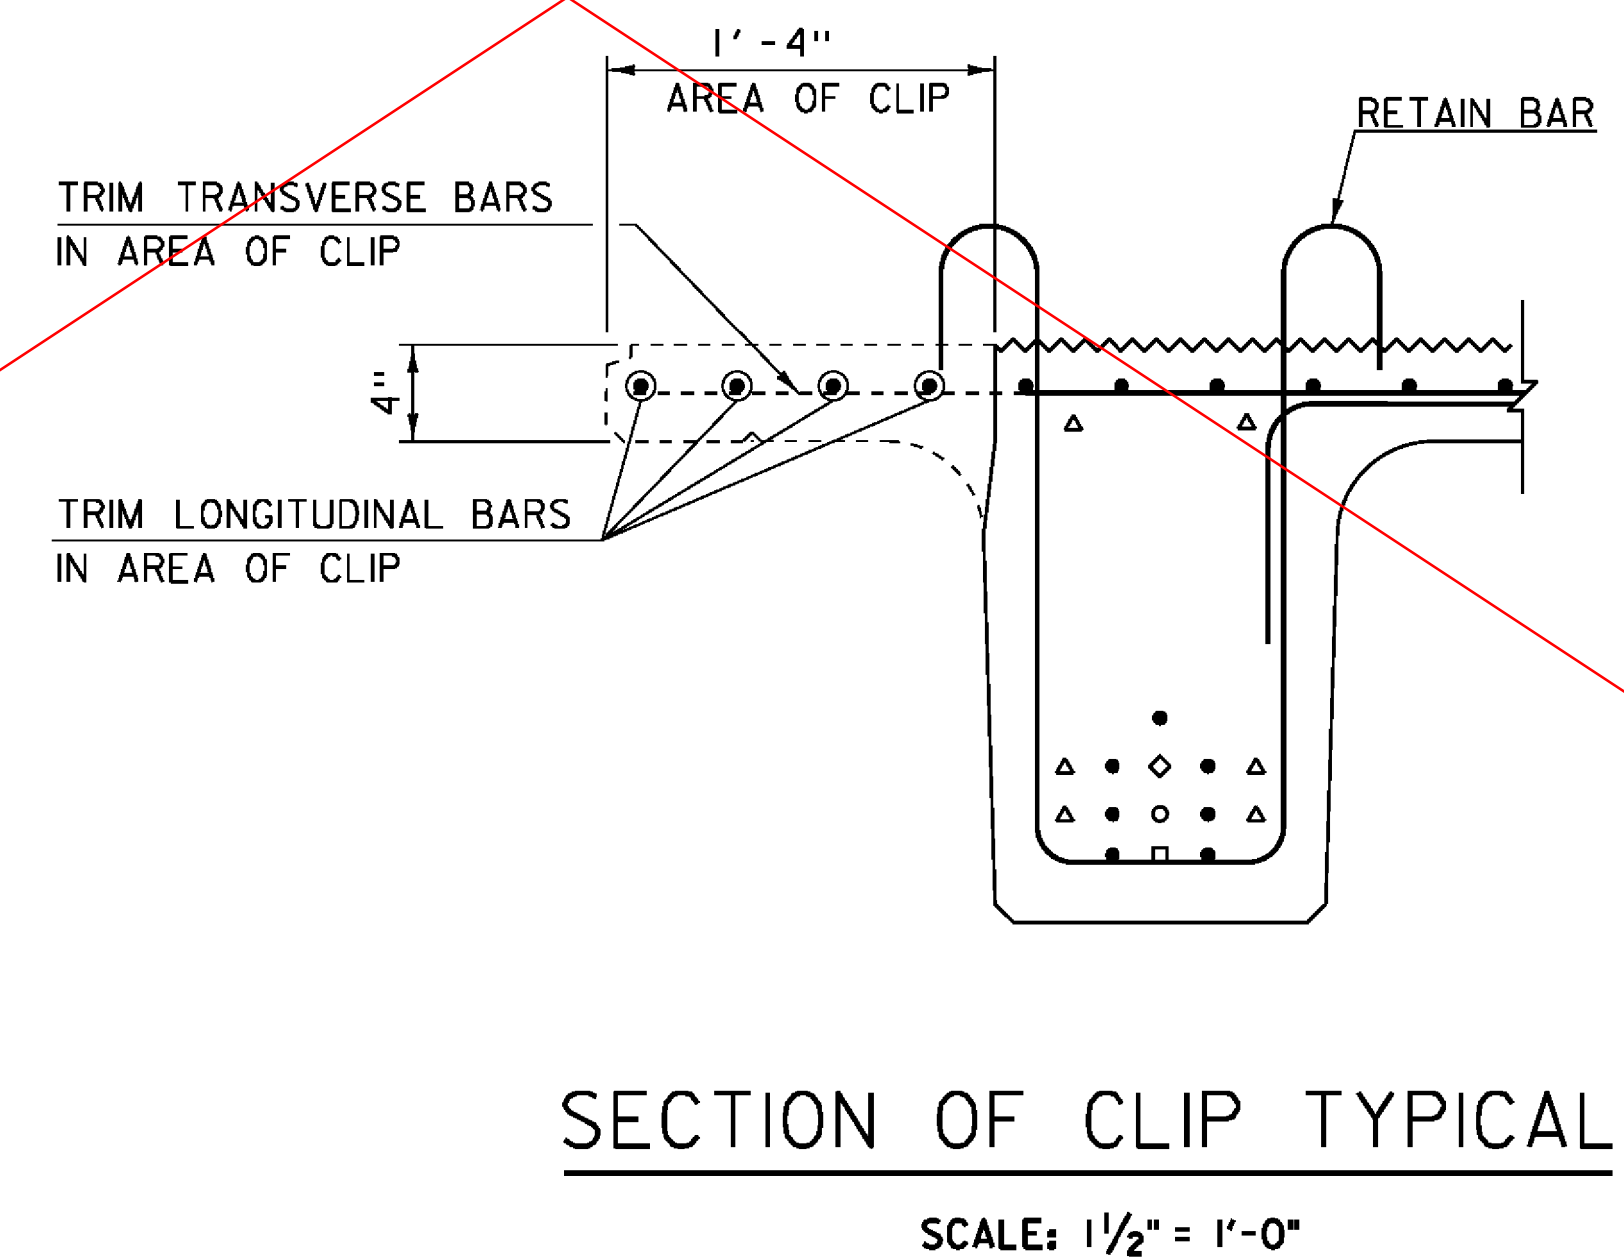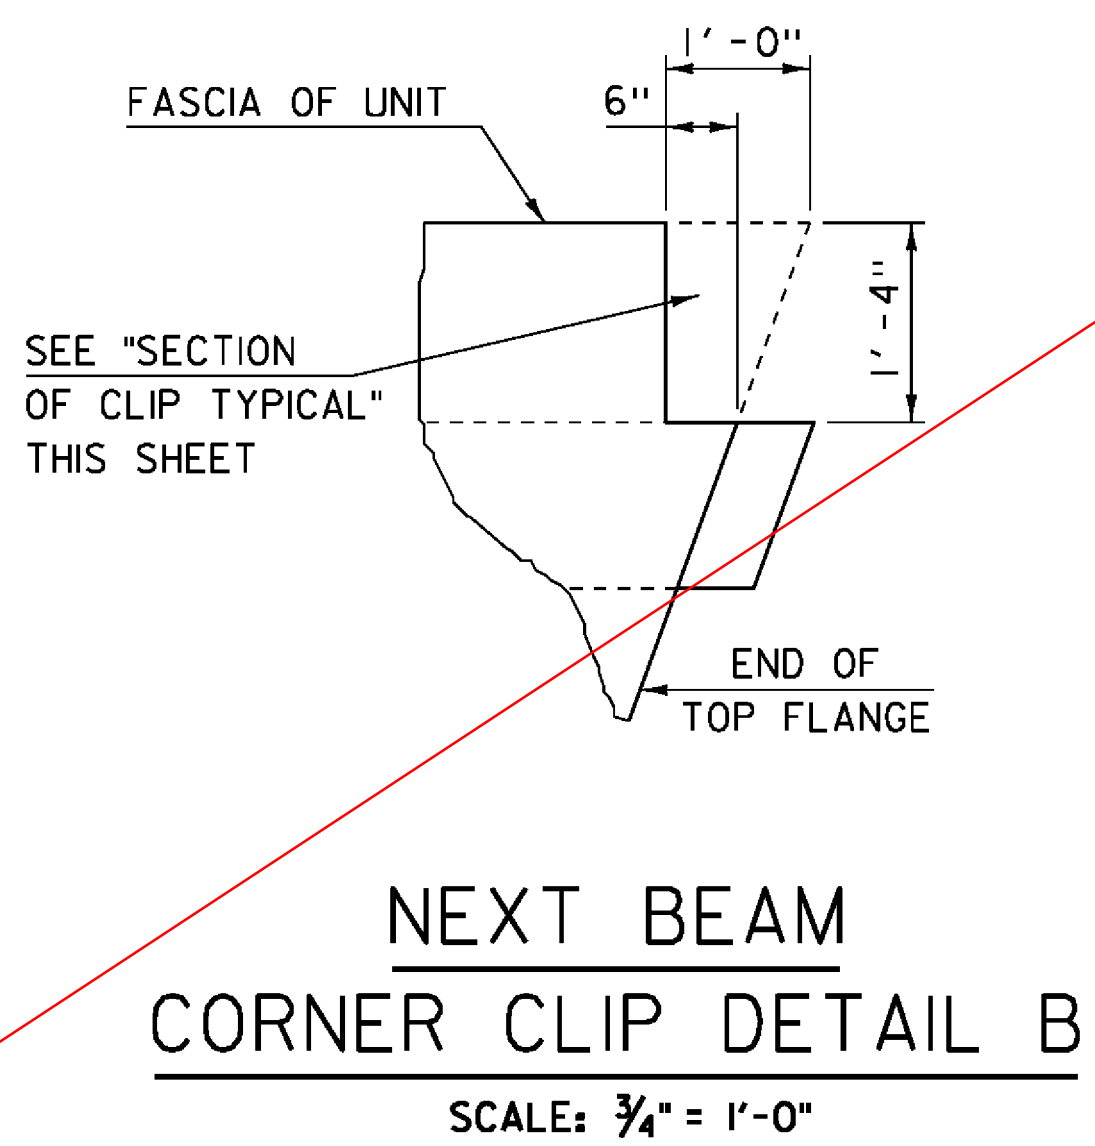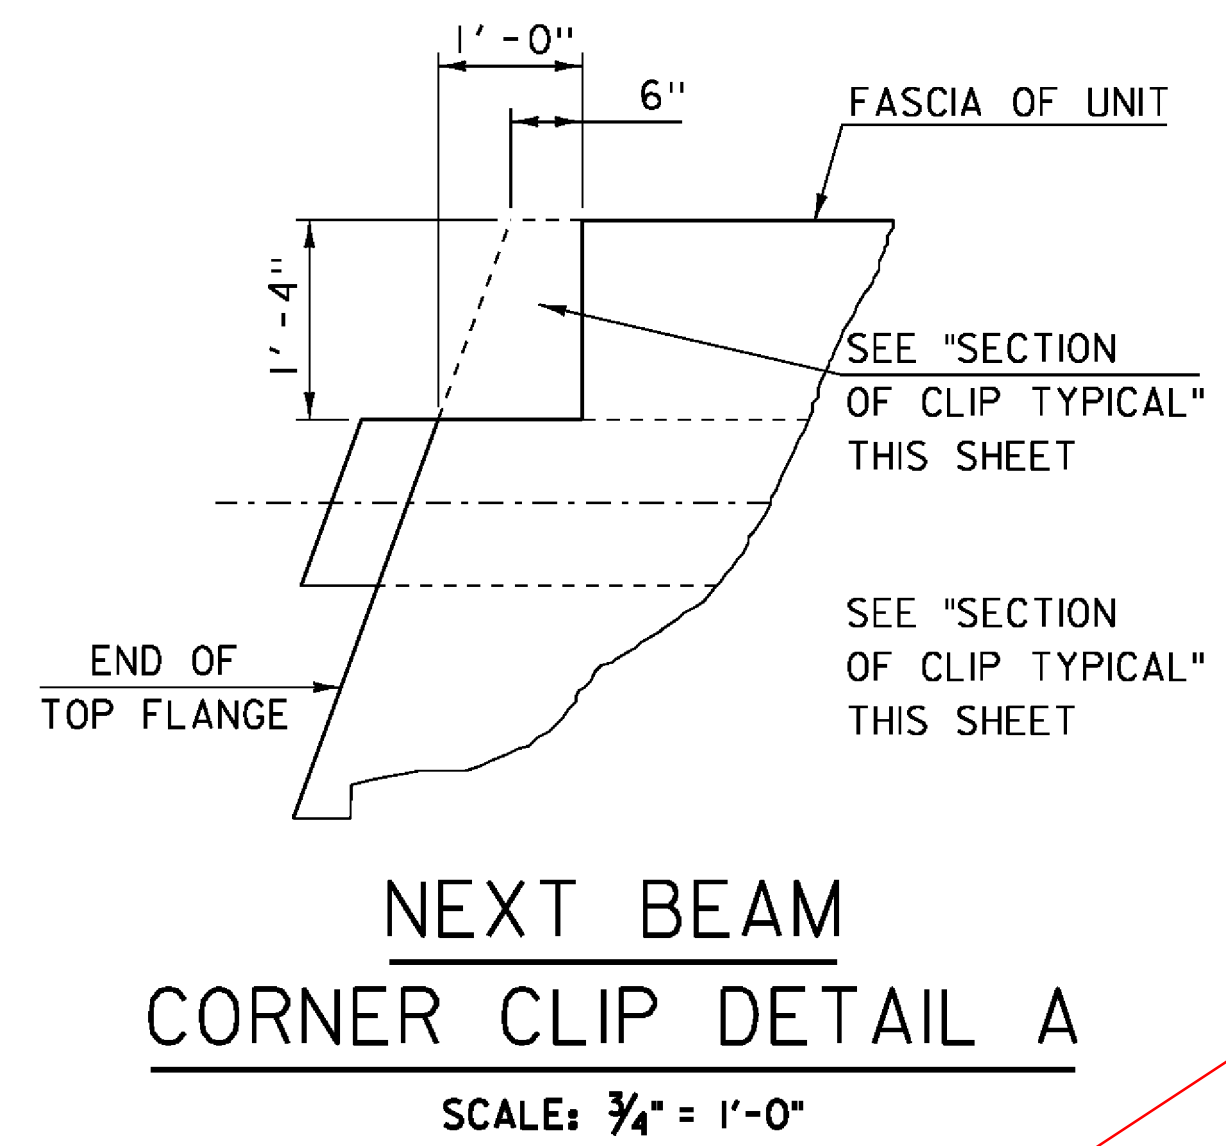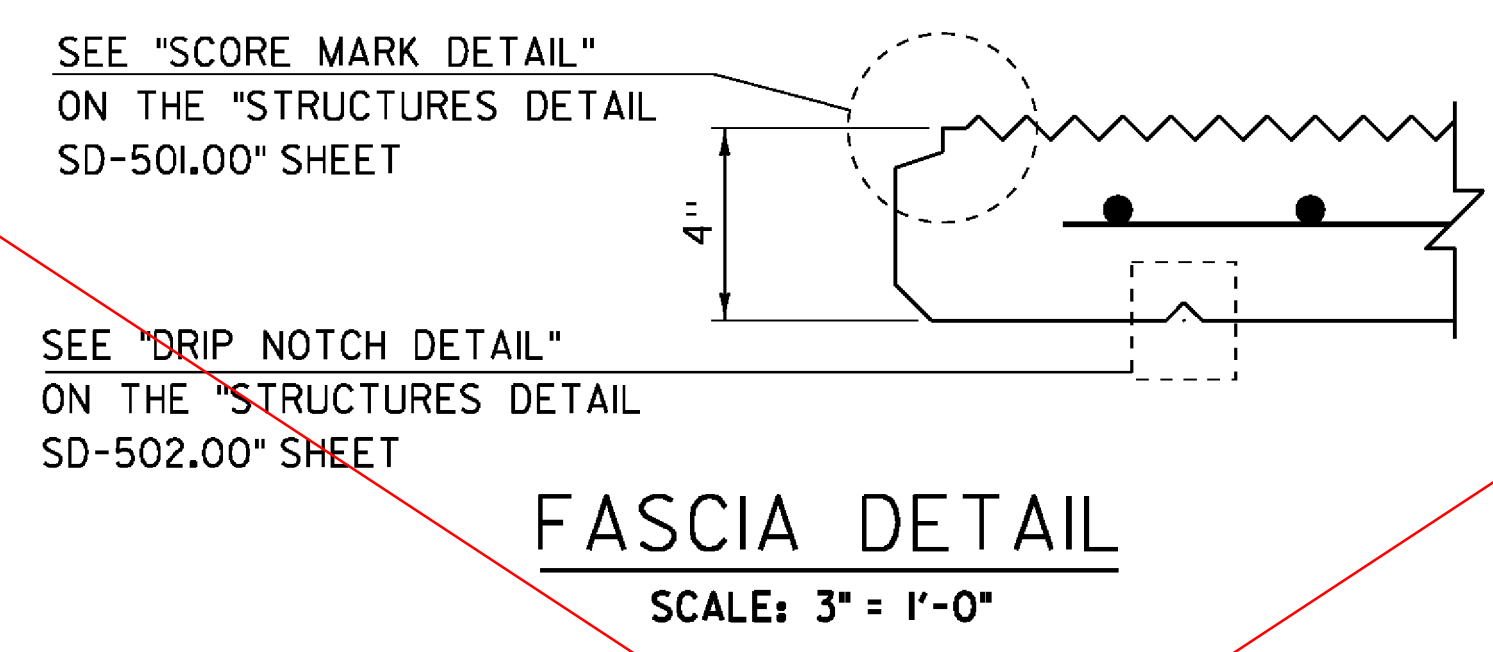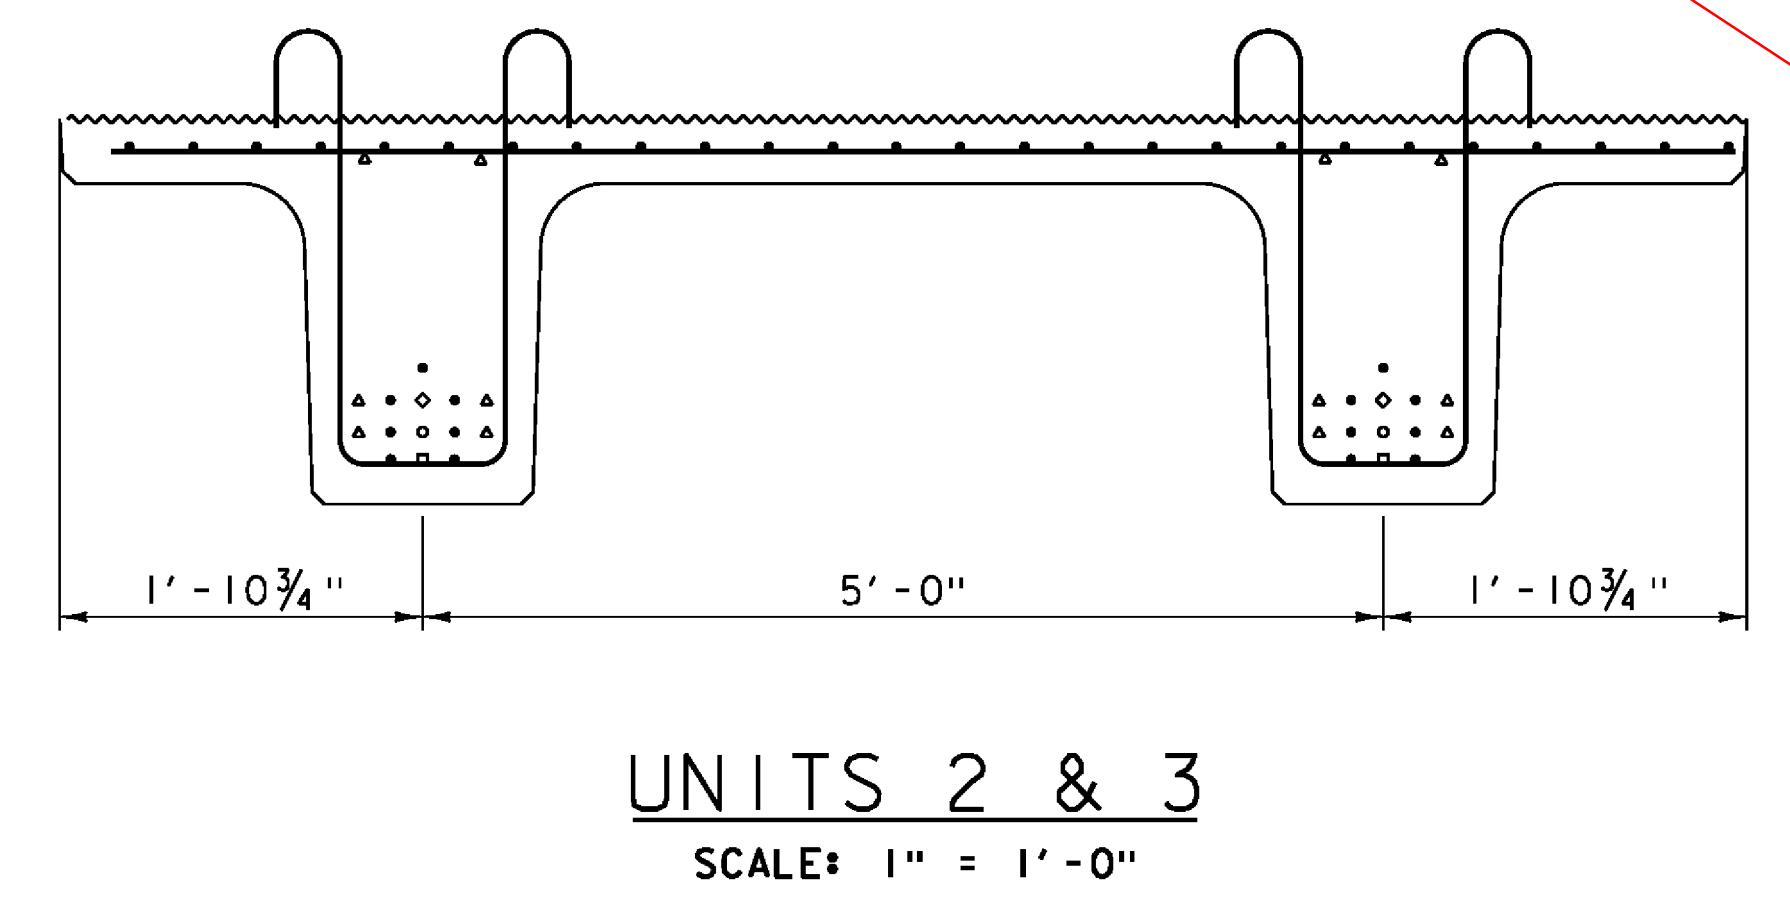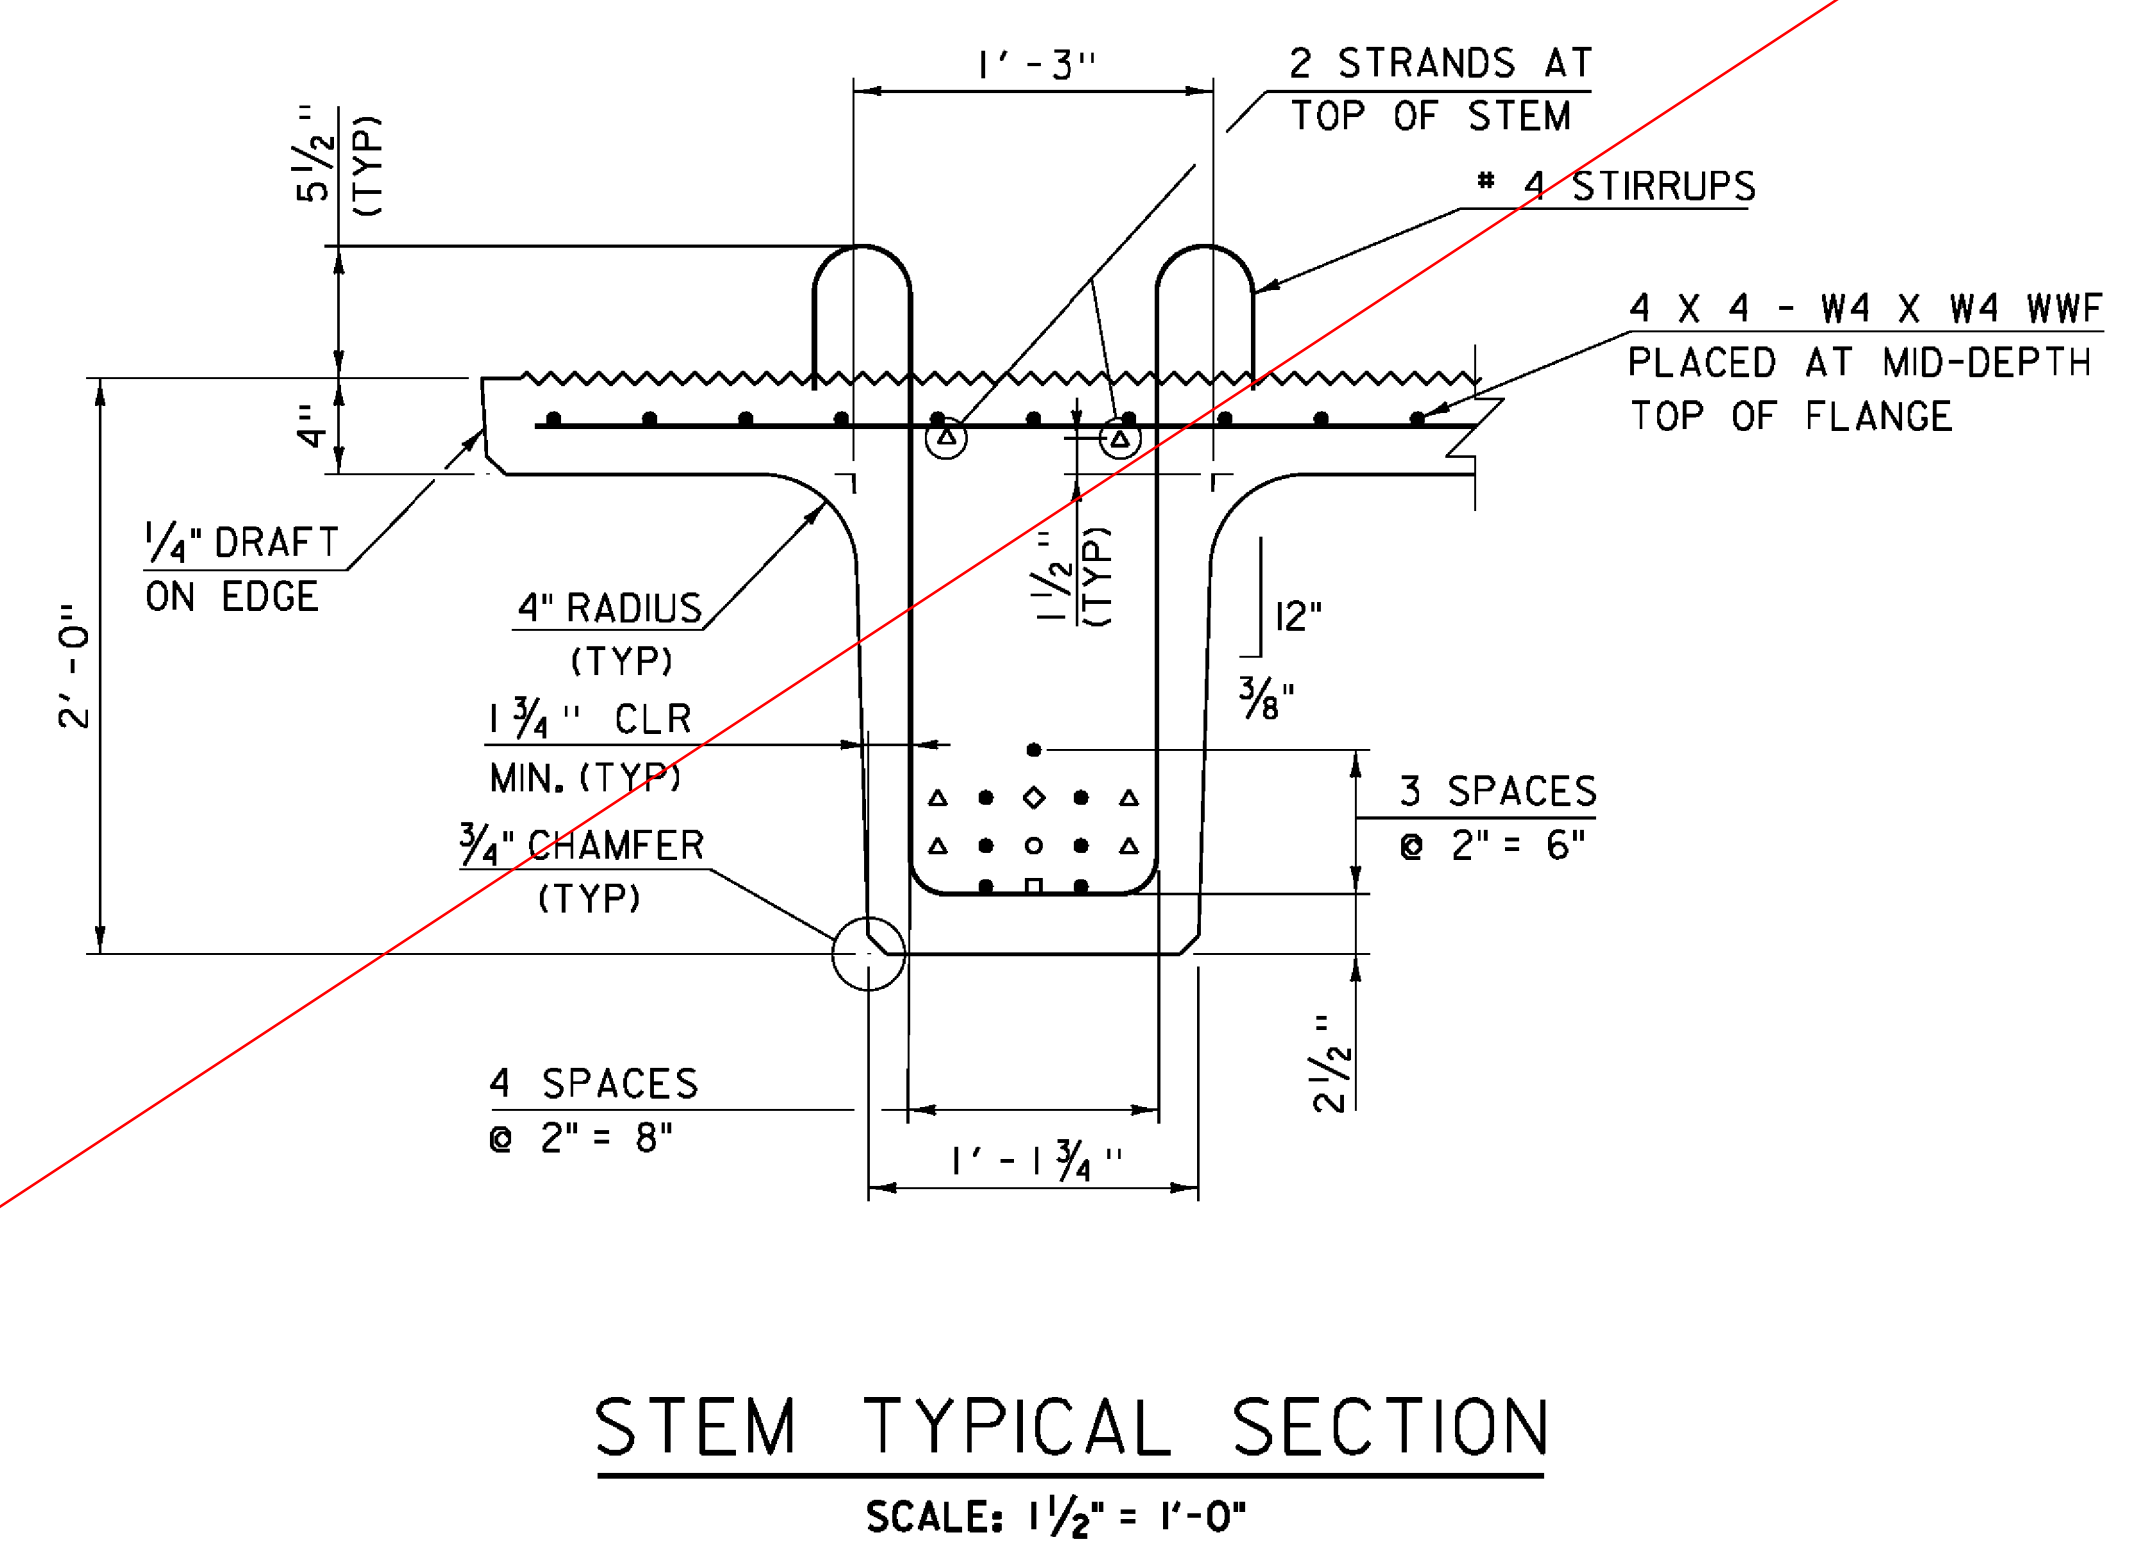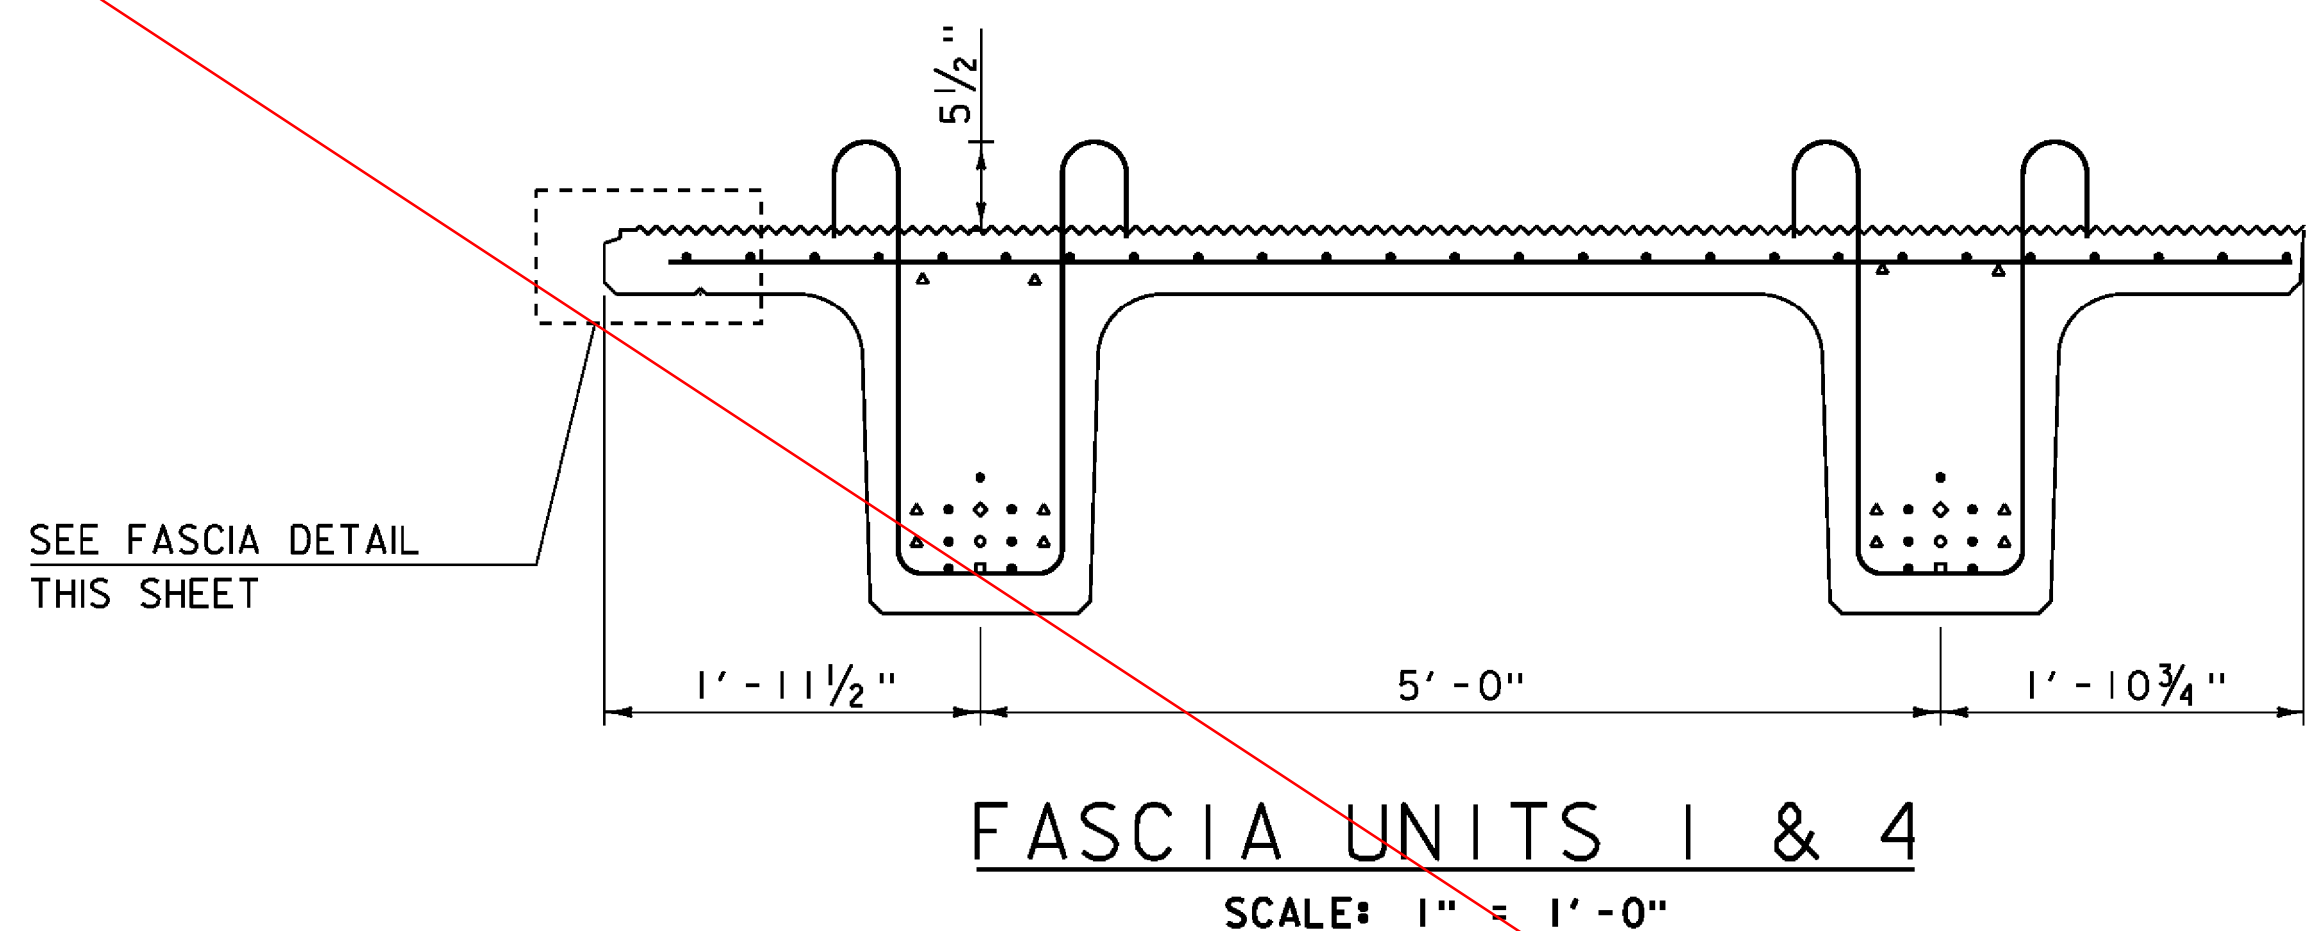

- STRAND LEGEND**
- NOT DEBONDED
  - △ DEBONDED 0' - 6"
  - ◇ DEBONDED 4' - 0"
  - DEBONDED 8' - 0"
  - DEBONDED 10' - 0"


- NOTES:**
1. TOP SURFACE OF TOP FLANGE SHALL HAVE A RAKE FINISH. SEE STRUCTURES DETAIL SHEET SD-501.00.
  2. STRANDS IN THE TOP AND BOTTOM ROWS THAT ARE NOT DEBONDED SHALL EXTEND 1'-6" FROM THE FINISHED END OF EACH BEAM STEM.

SEE REVISION: OCT-28-2014


PROJECT NAME: JOHNSON  
PROJECT NUMBER: BRF 030-2(26)

FILE NAME: s88bi93sup.dgn  
PROJECT LEADER: C. CARLSON  
DESIGNED BY: H. SALLS  
NEXT BEAM SECTIONS AND STRAND DETAILS SHEET 29 OF 69


PLOT DATE: 10-JUN-2014  
DRAWN BY: G. ROKES  
CHECKED BY: H. SALLS

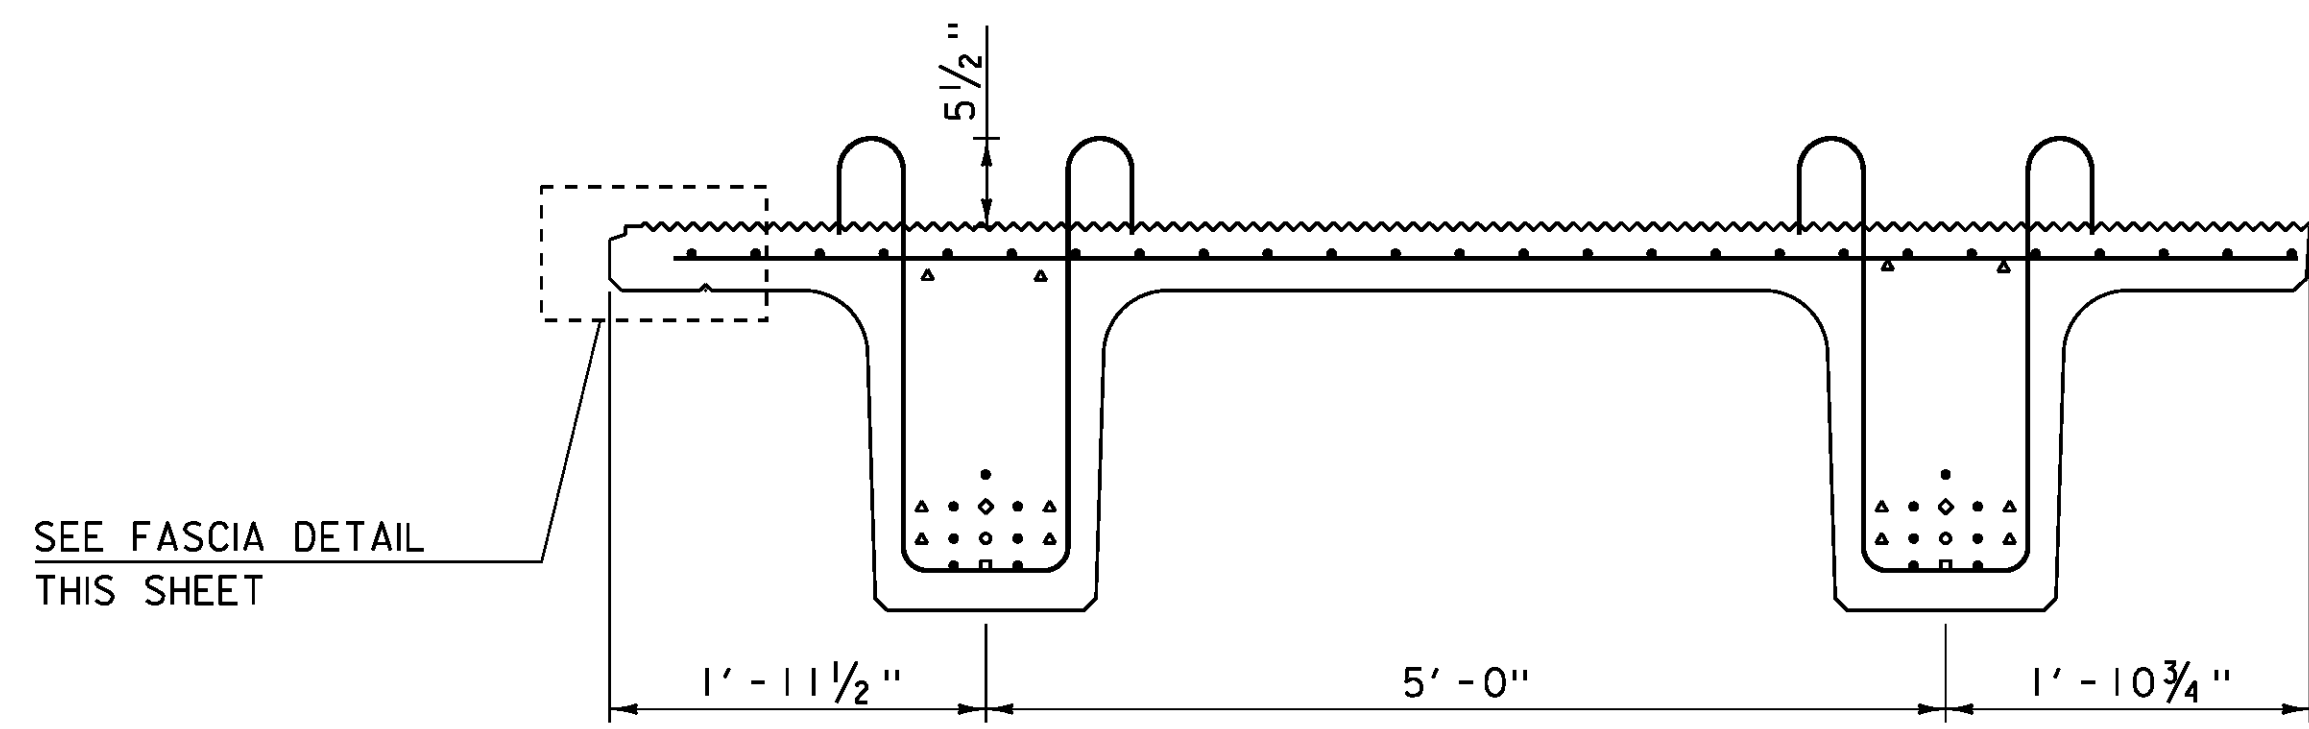


**FASCIA UNITS 1 & 4**  
SCALE: 1" = 1'-0"

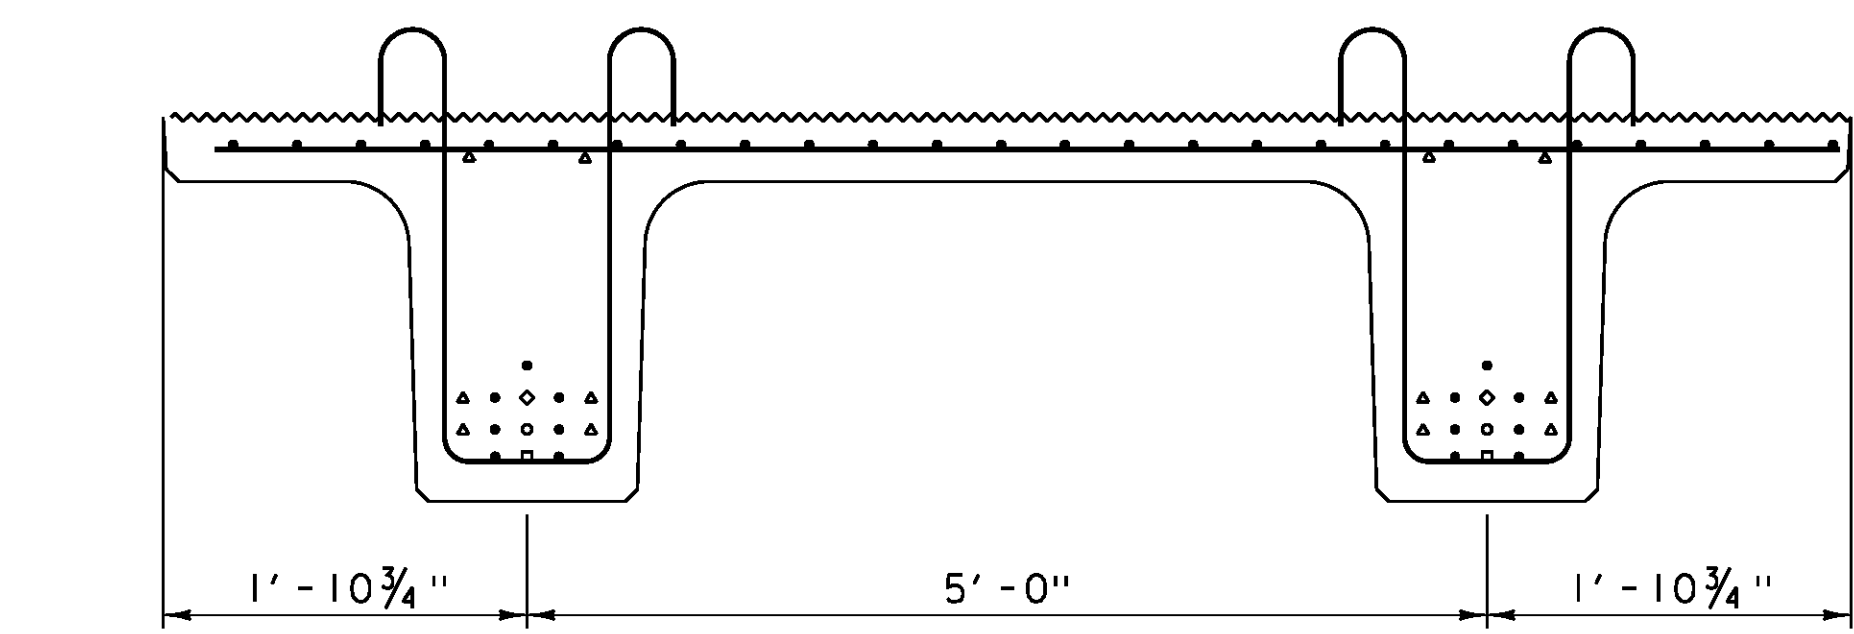


**UNITS 2 & 3**  
SCALE: 1" = 1'-0"

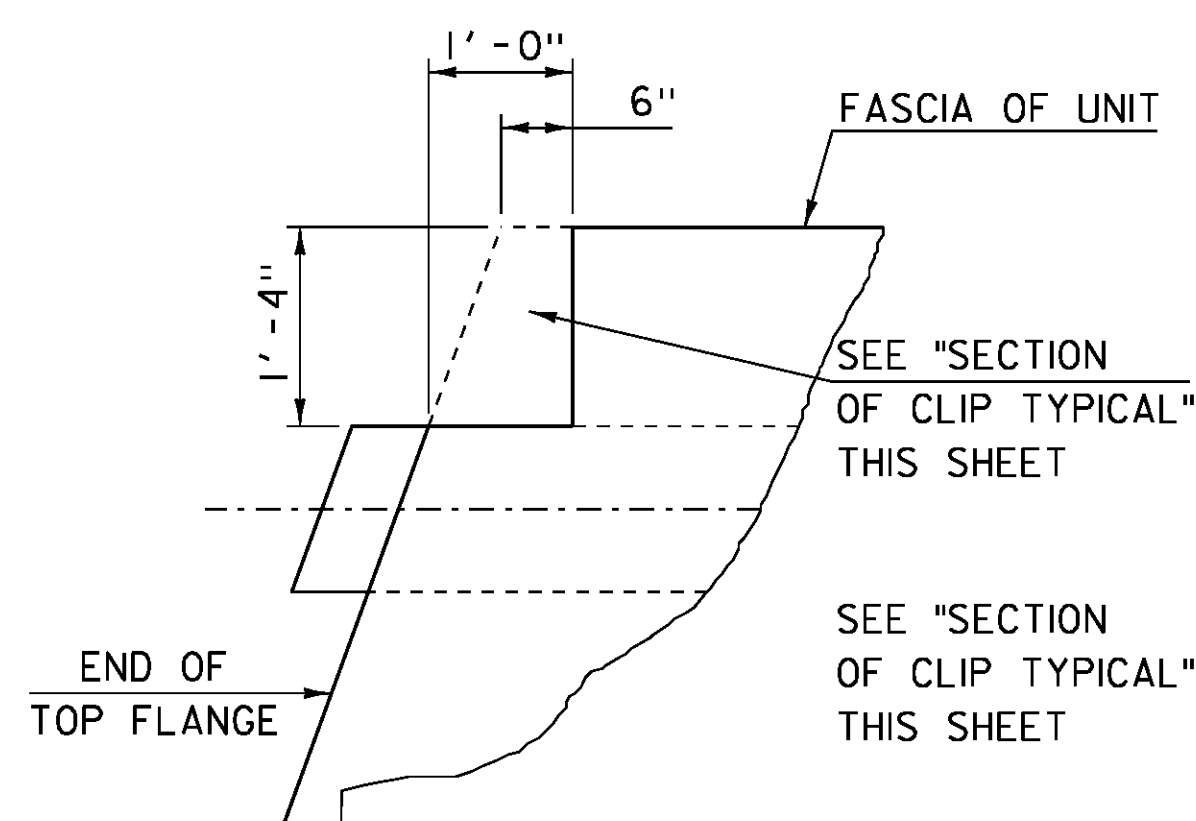


**NEXT BEAM  
CORNER CLIP DETAIL A**  
SCALE: 3/4" = 1'-0"

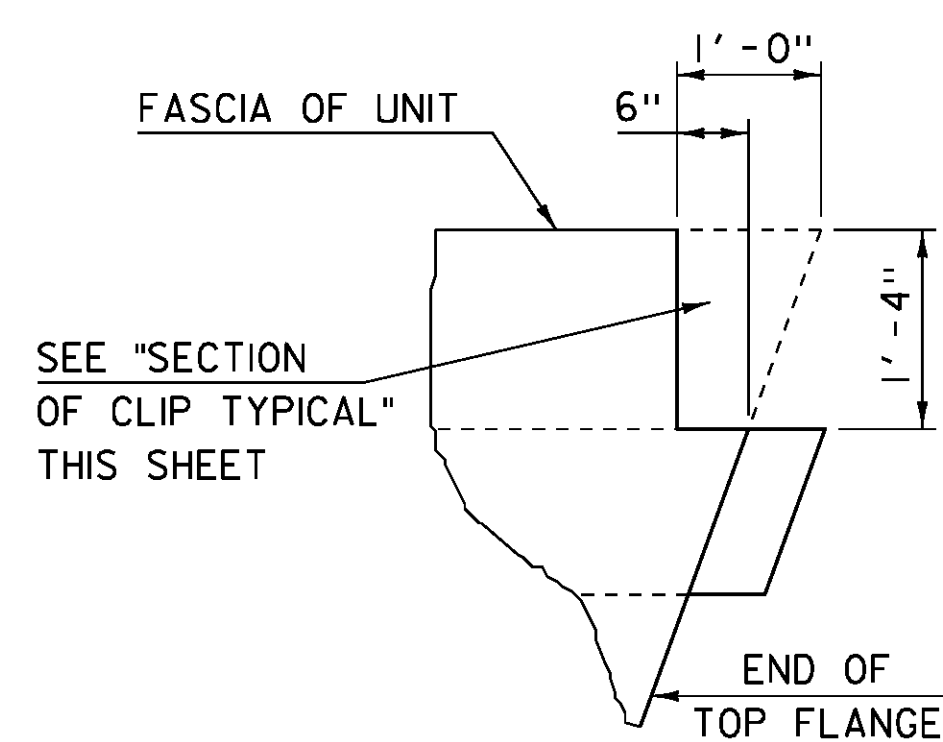


**NEXT BEAM  
CORNER CLIP DETAIL B**  
SCALE: 3/4" = 1'-0"

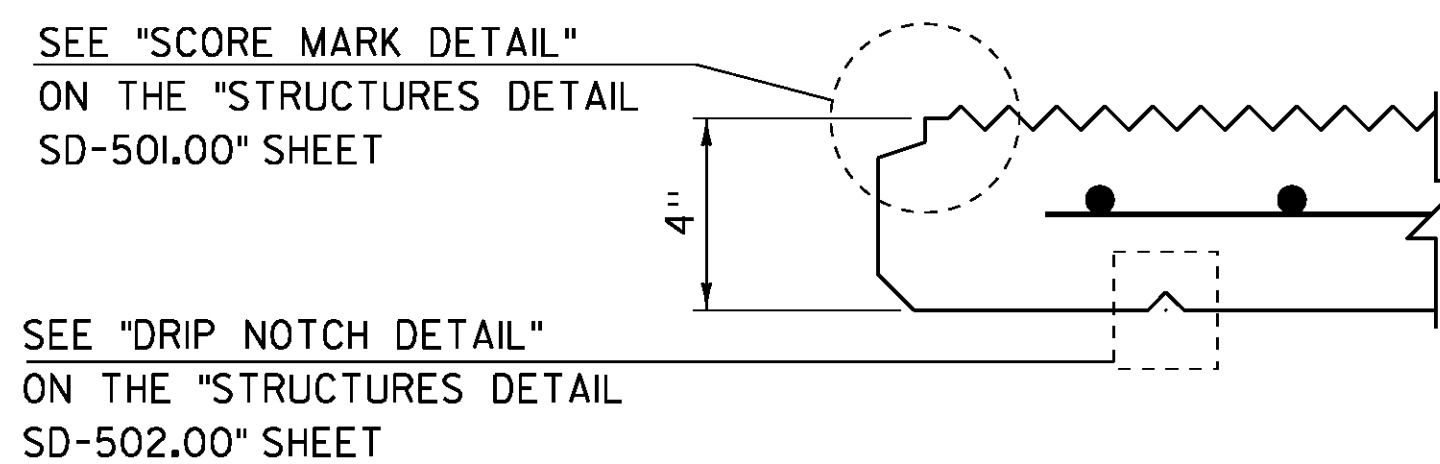

**FASCIA DETAIL**  
SCALE: 3" = 1'-0"

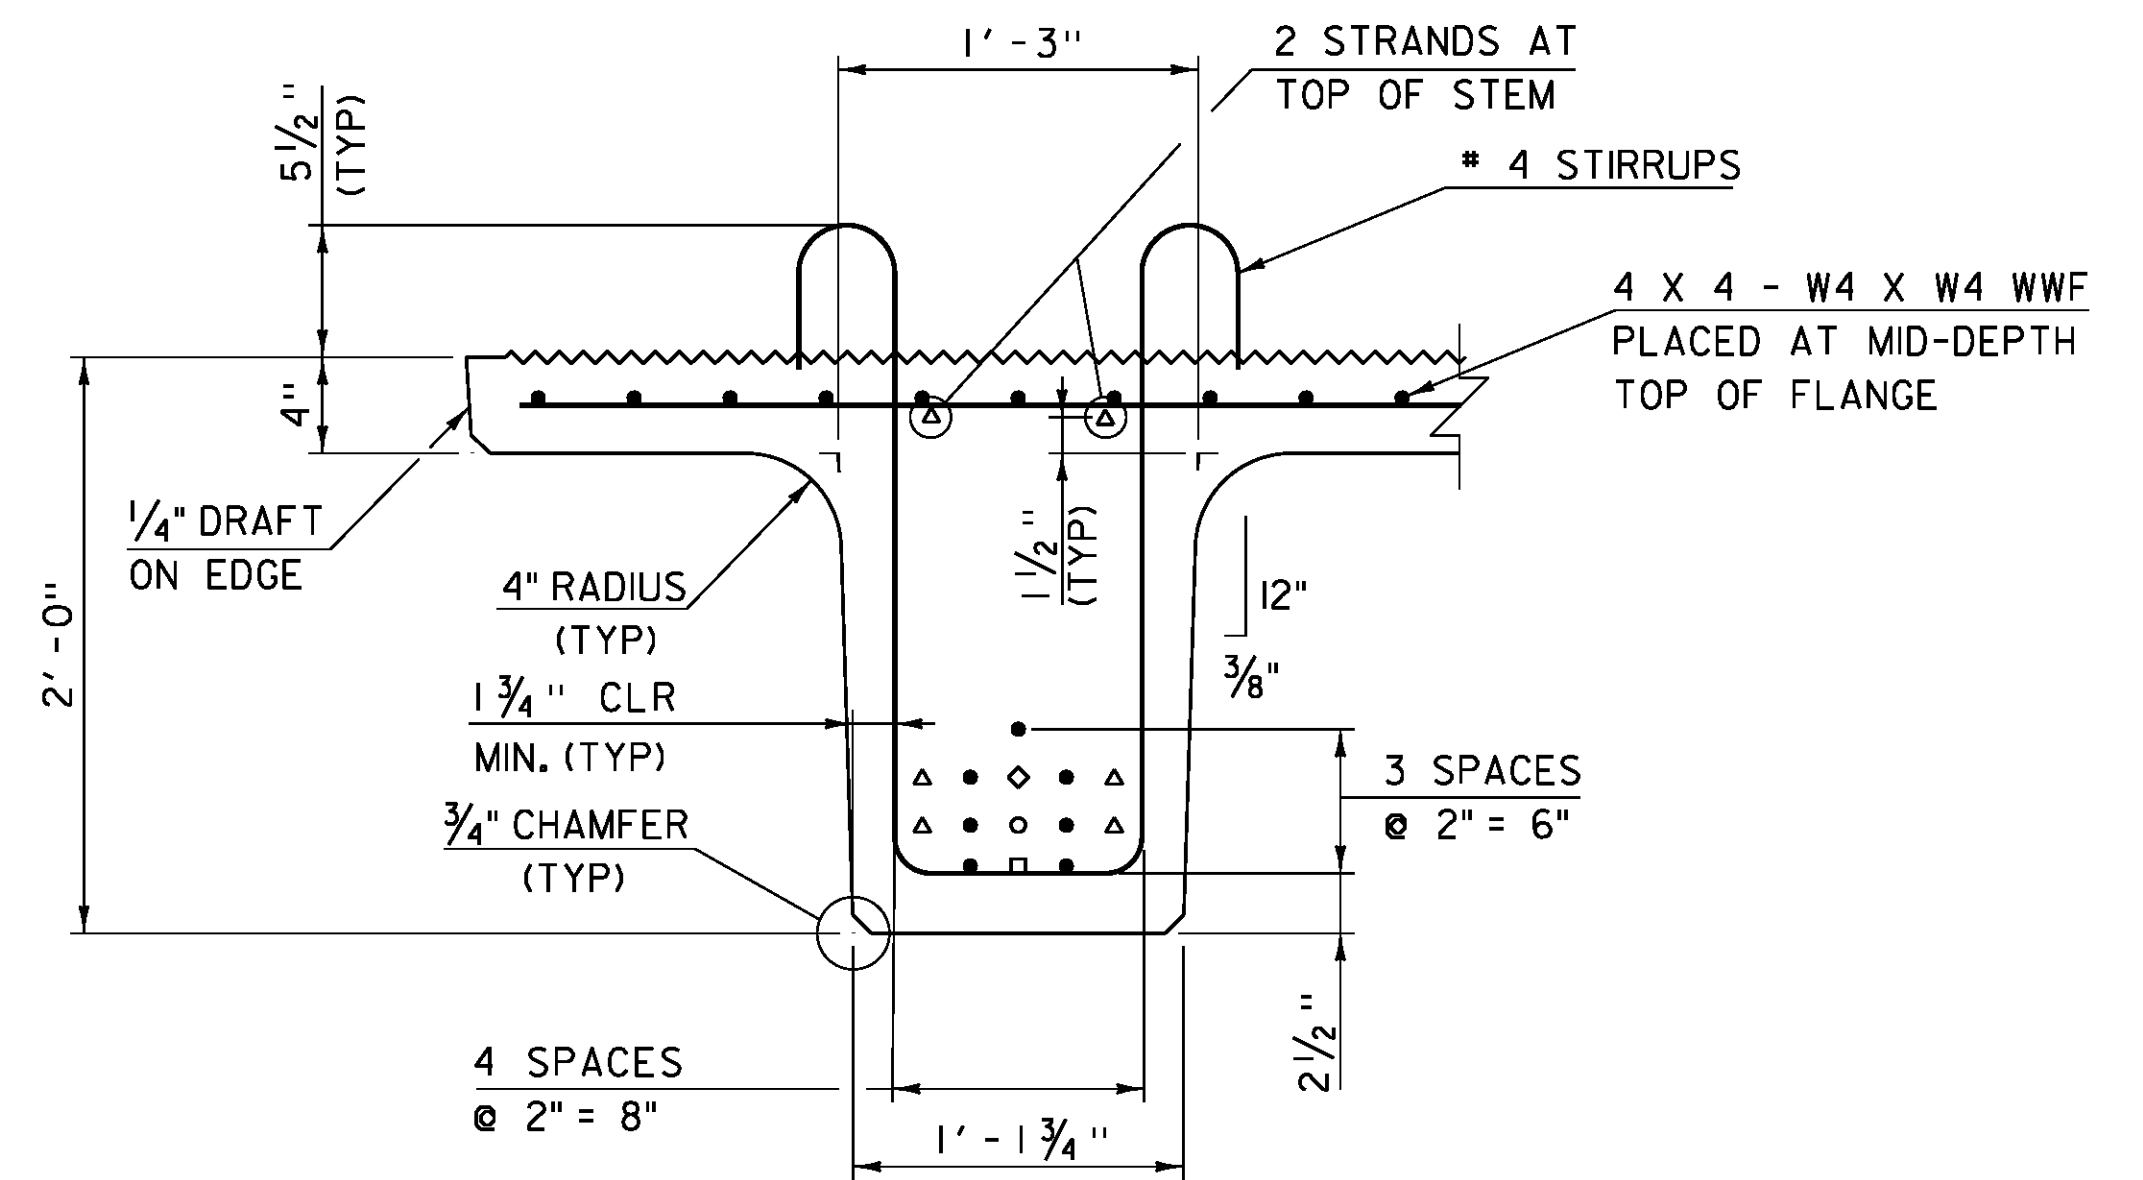

**STEM TYPICAL SECTION**  
SCALE: 1 1/2" = 1'-0"

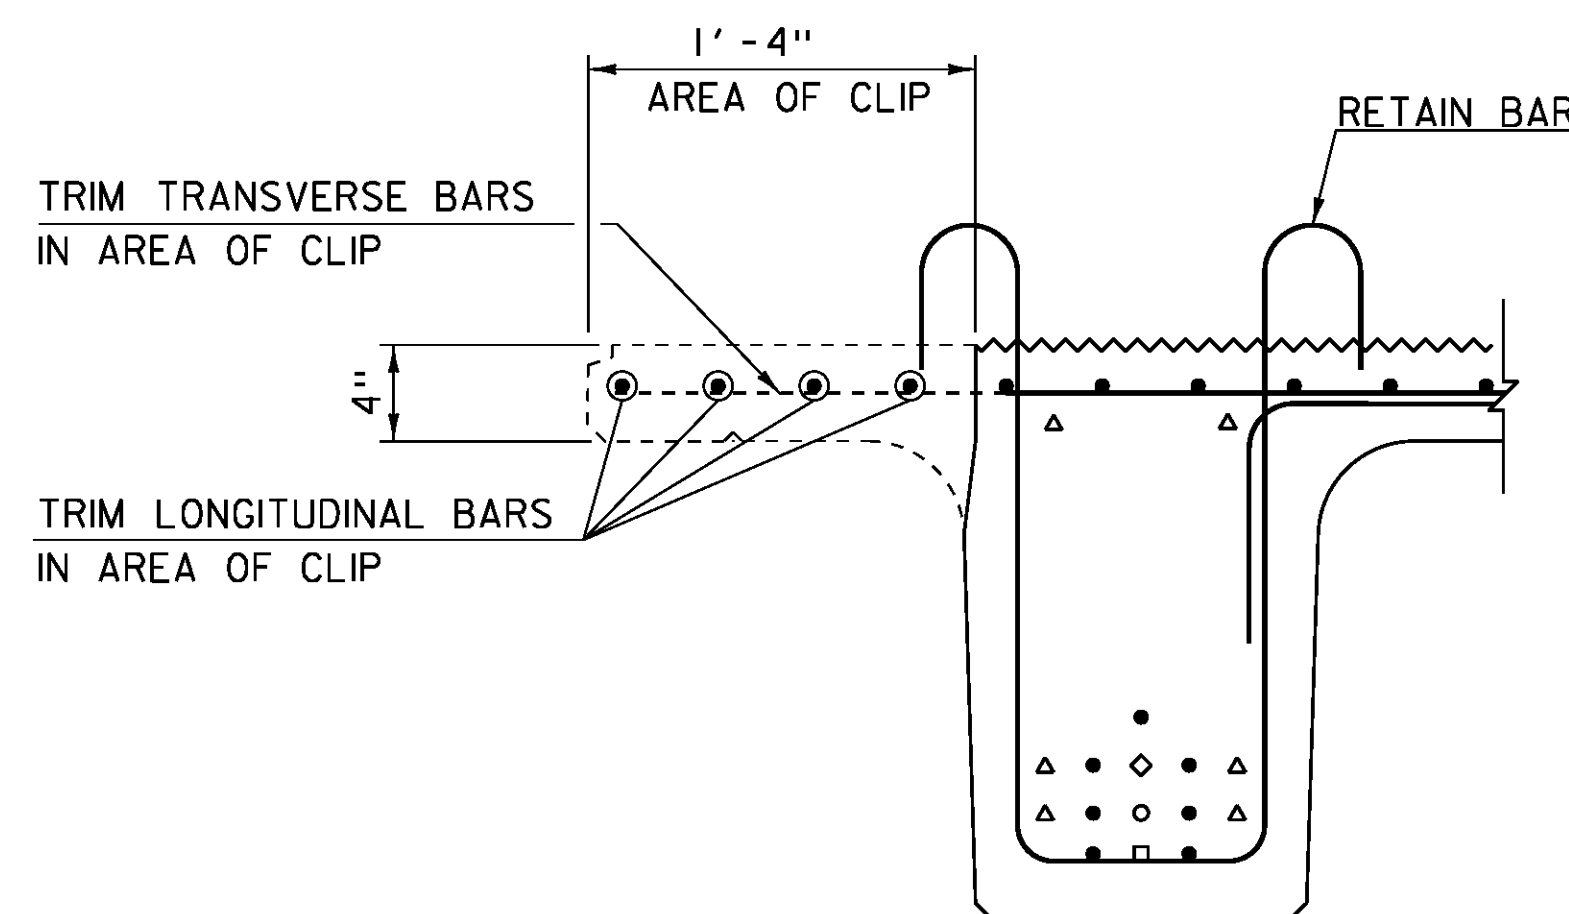

**SECTION OF CLIP TYPICAL**  
SCALE: 1 1/2" = 1'-0"

△  
REMOVE  
"IMBEDDED GUARDRAIL ANCHOR PLATE"  
DETAIL

**STRAND LEGEND**

- NOT DEBONDED
- △ DEBONDED 0' - 6"
- ◇ DEBONDED 4' - 0"
- DEBONDED 8' - 0"
- DEBONDED 10' - 0"


**NOTES:**

1. TOP SURFACE OF TOP FLANGE SHALL HAVE A RAKE FINISH. SEE STRUCTURES DETAIL SHEET SD-501.00.
2. STRANDS IN THE TOP AND BOTTOM ROWS THAT ARE NOT DEBONDED SHALL EXTEND 1'-6" FROM THE FINISHED END OF EACH BEAM STEM.

REVISION	DATE	DESCRIPTION	BY
△	OCT-28-2014	ADD 3" PAYMENT, LOWER BRIDGE SEAT, ADD 3" CONCRETE PEDESTAL	GNR


PROJECT NAME: JOHNSON  
PROJECT NUMBER: BRF 030-2(26)

FILE NAME: s88bl93sup.dgn PLOT DATE: 05-NOV-2014  
PROJECT LEADER: C. CARLSON DRAWN BY: G. ROKES  
DESIGNED BY: H. SALLS CHECKED BY: H. SALLS  
NEXT BEAM SECTIONS AND STRAND DETAILS SHEET 29 OF 69

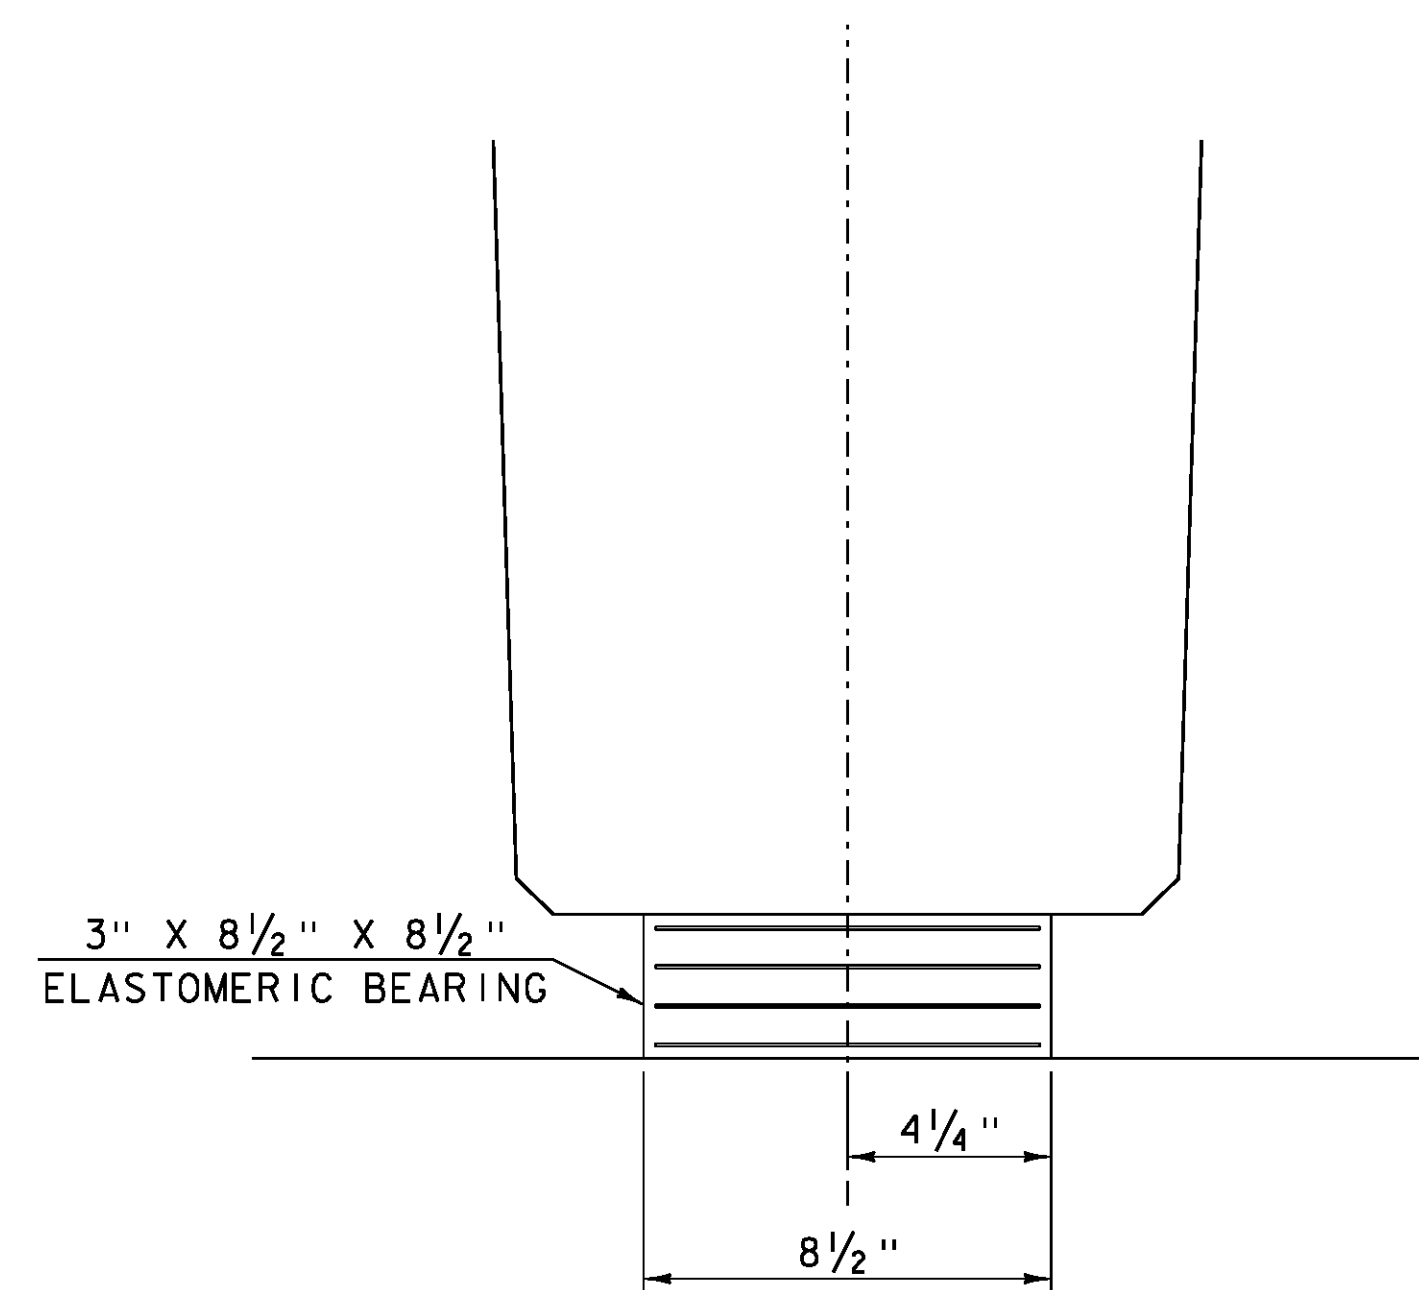

- 2 - 1/4" EXTERIOR LAYERS OF ELASTOMER
- 3 - 3/4" INTERIOR LAYERS OF ELASTOMER
- 4 - 1/16" STEEL REINFORCING PLATES

**FRONT VIEW**

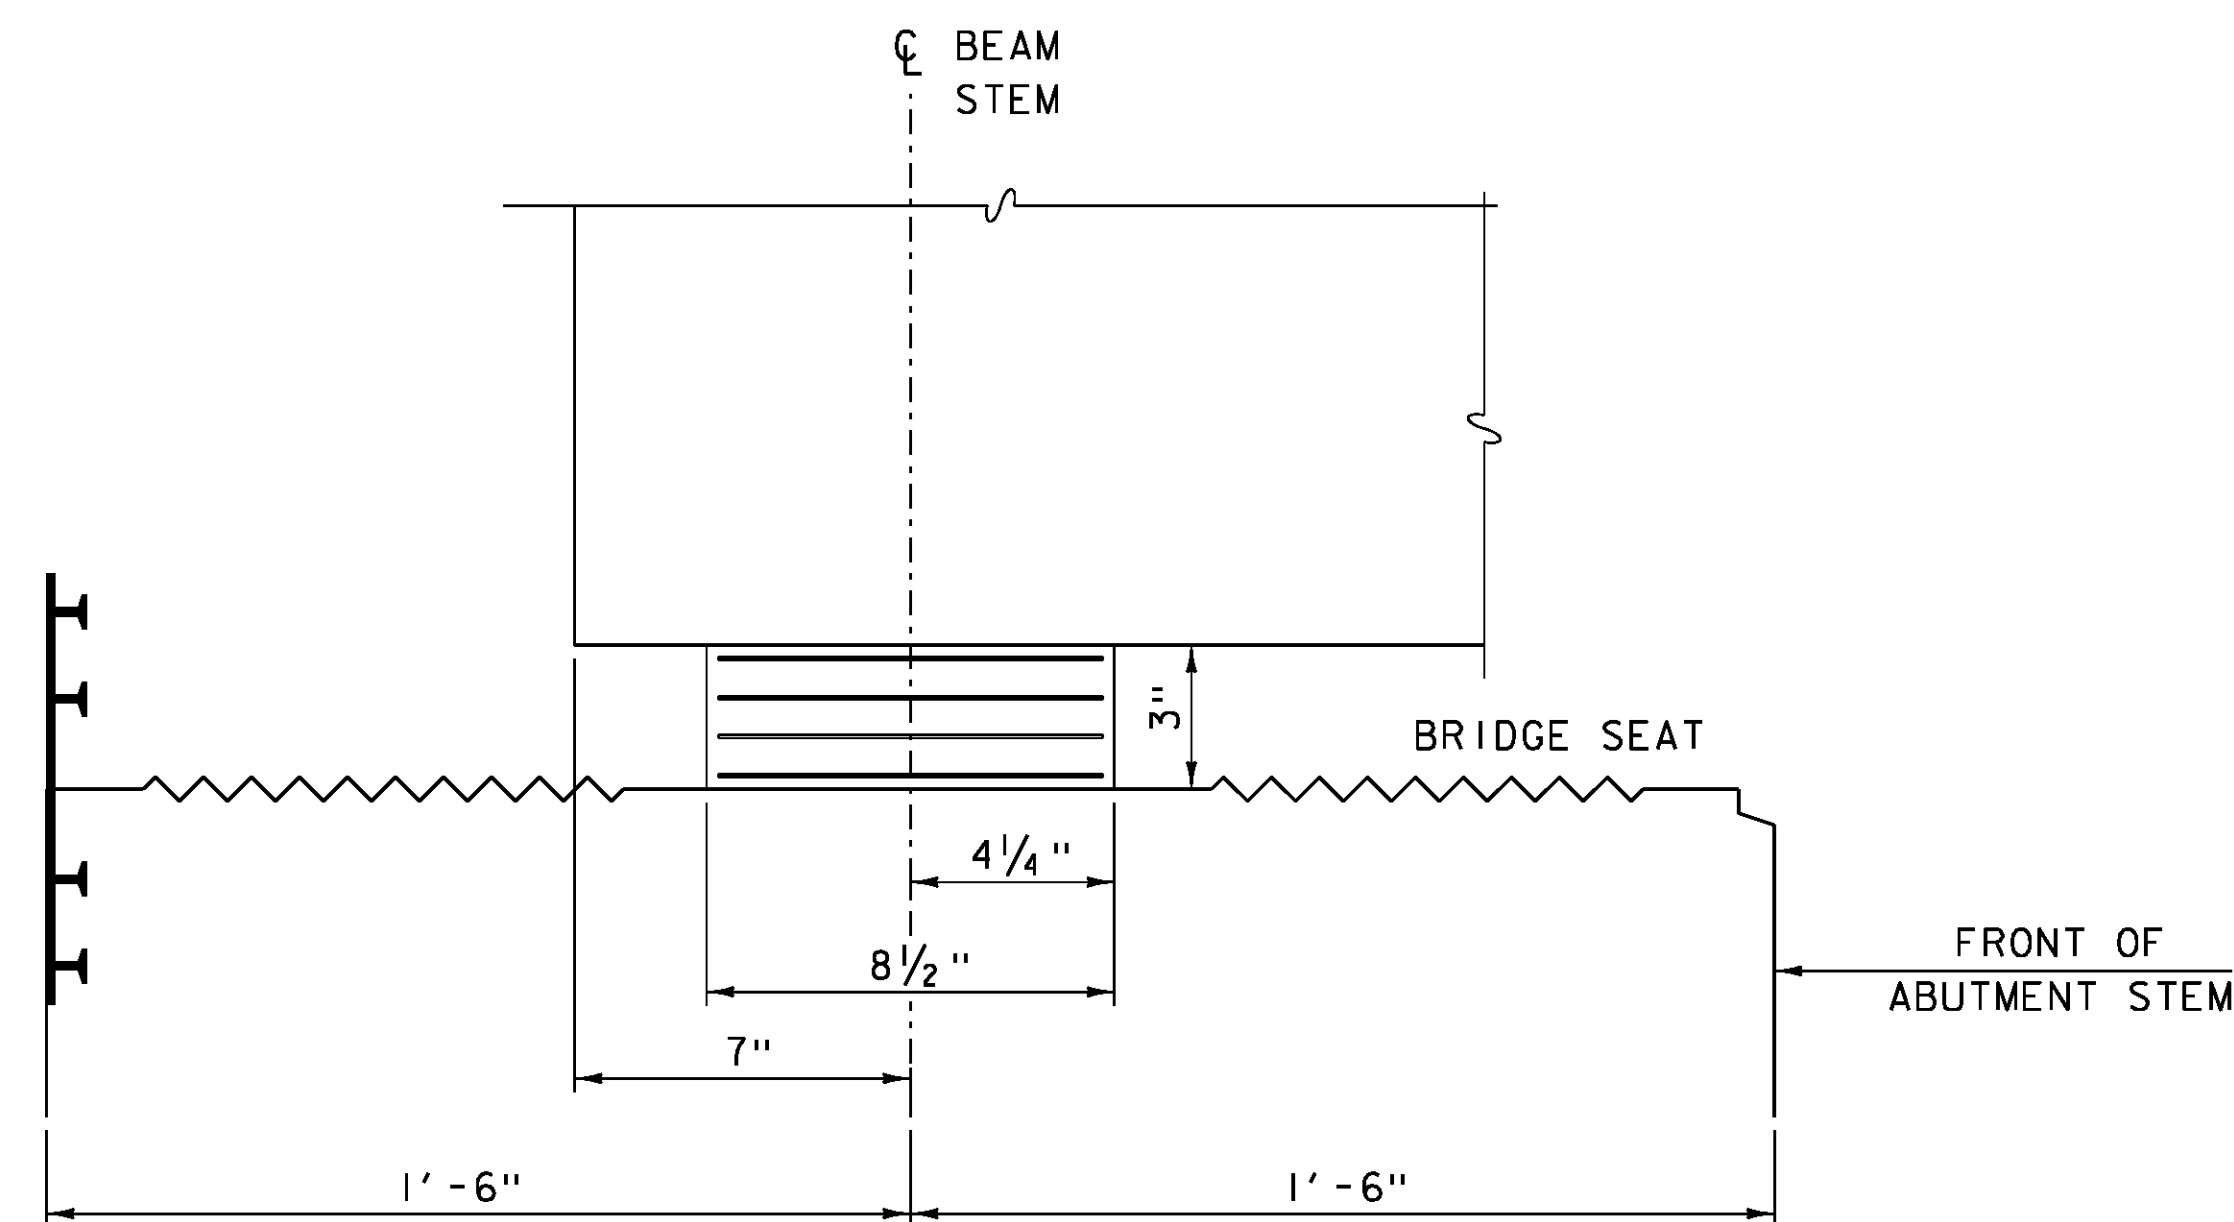

**SIDE VIEW**


**ELASTOMERIC BEARING DETAILS**

SCALE: 3" = 1' - 0"


**BEARING NOTES**

1. BEARINGS SHALL CONFORM TO THE APPLICABLE SUBSECTIONS OF STANDARD SPECIFICATIONS SECTIONS 531 AND 731.
2. ALL REINFORCEMENT BETWEEN LAYERS OF ELASTOMER SHALL BE STEEL AASHTO M270M/M270 GRADE 36. ALL INTERNAL STEEL PLATES SHALL BE SAND BLASTED AND FREE OF COATINGS, RUST AND MILL SCALE. THE PLATES SHALL BE FREE OF SHARP EDGES AND BURRS.
3. STEEL REINFORCED ELASTOMERIC BEARINGS SHALL HAVE A MINIMUM 1/8" EDGE SEAL OF ELASTOMER INTEGRAL WITH BEARING OVER ALL INTERNAL PLATES.
4. THE ELASTOMER WAS DESIGNED WITH A SHEAR MODULUS OF 100 PSI +/- 15%
5. THE CONTRACTOR IS ADVISED TO HAVE SHIMS AVAILABLE FOR USE FOR ELEVATION ADJUSTMENTS UPON THE SETTING OF THE SUPERSTRUCTURE UNITS. THE SHIMS SHALL BE FABRICATED ACCORDING TO SECTION 531 AND SHALL BE INCLUDED UNDER ITEM 531.17, "BEARING DEVICE ASSEMBLY, STEEL REINFORCED ELASTOMERIC PAD".


PROJECT NAME: JOHNSON	PLOT DATE: 10-JUN-2014
PROJECT NUMBER: BRF 030-2(26)	DRAWN BY: G. ROKES
FILE NAME: s88bl93sub.dgn	CHECKED BY: H. SALLS
PROJECT LEADER: C. CARLSON	SHEET 30 OF 69
DESIGNED BY: H. SALLS	
BEARING DETAILS	

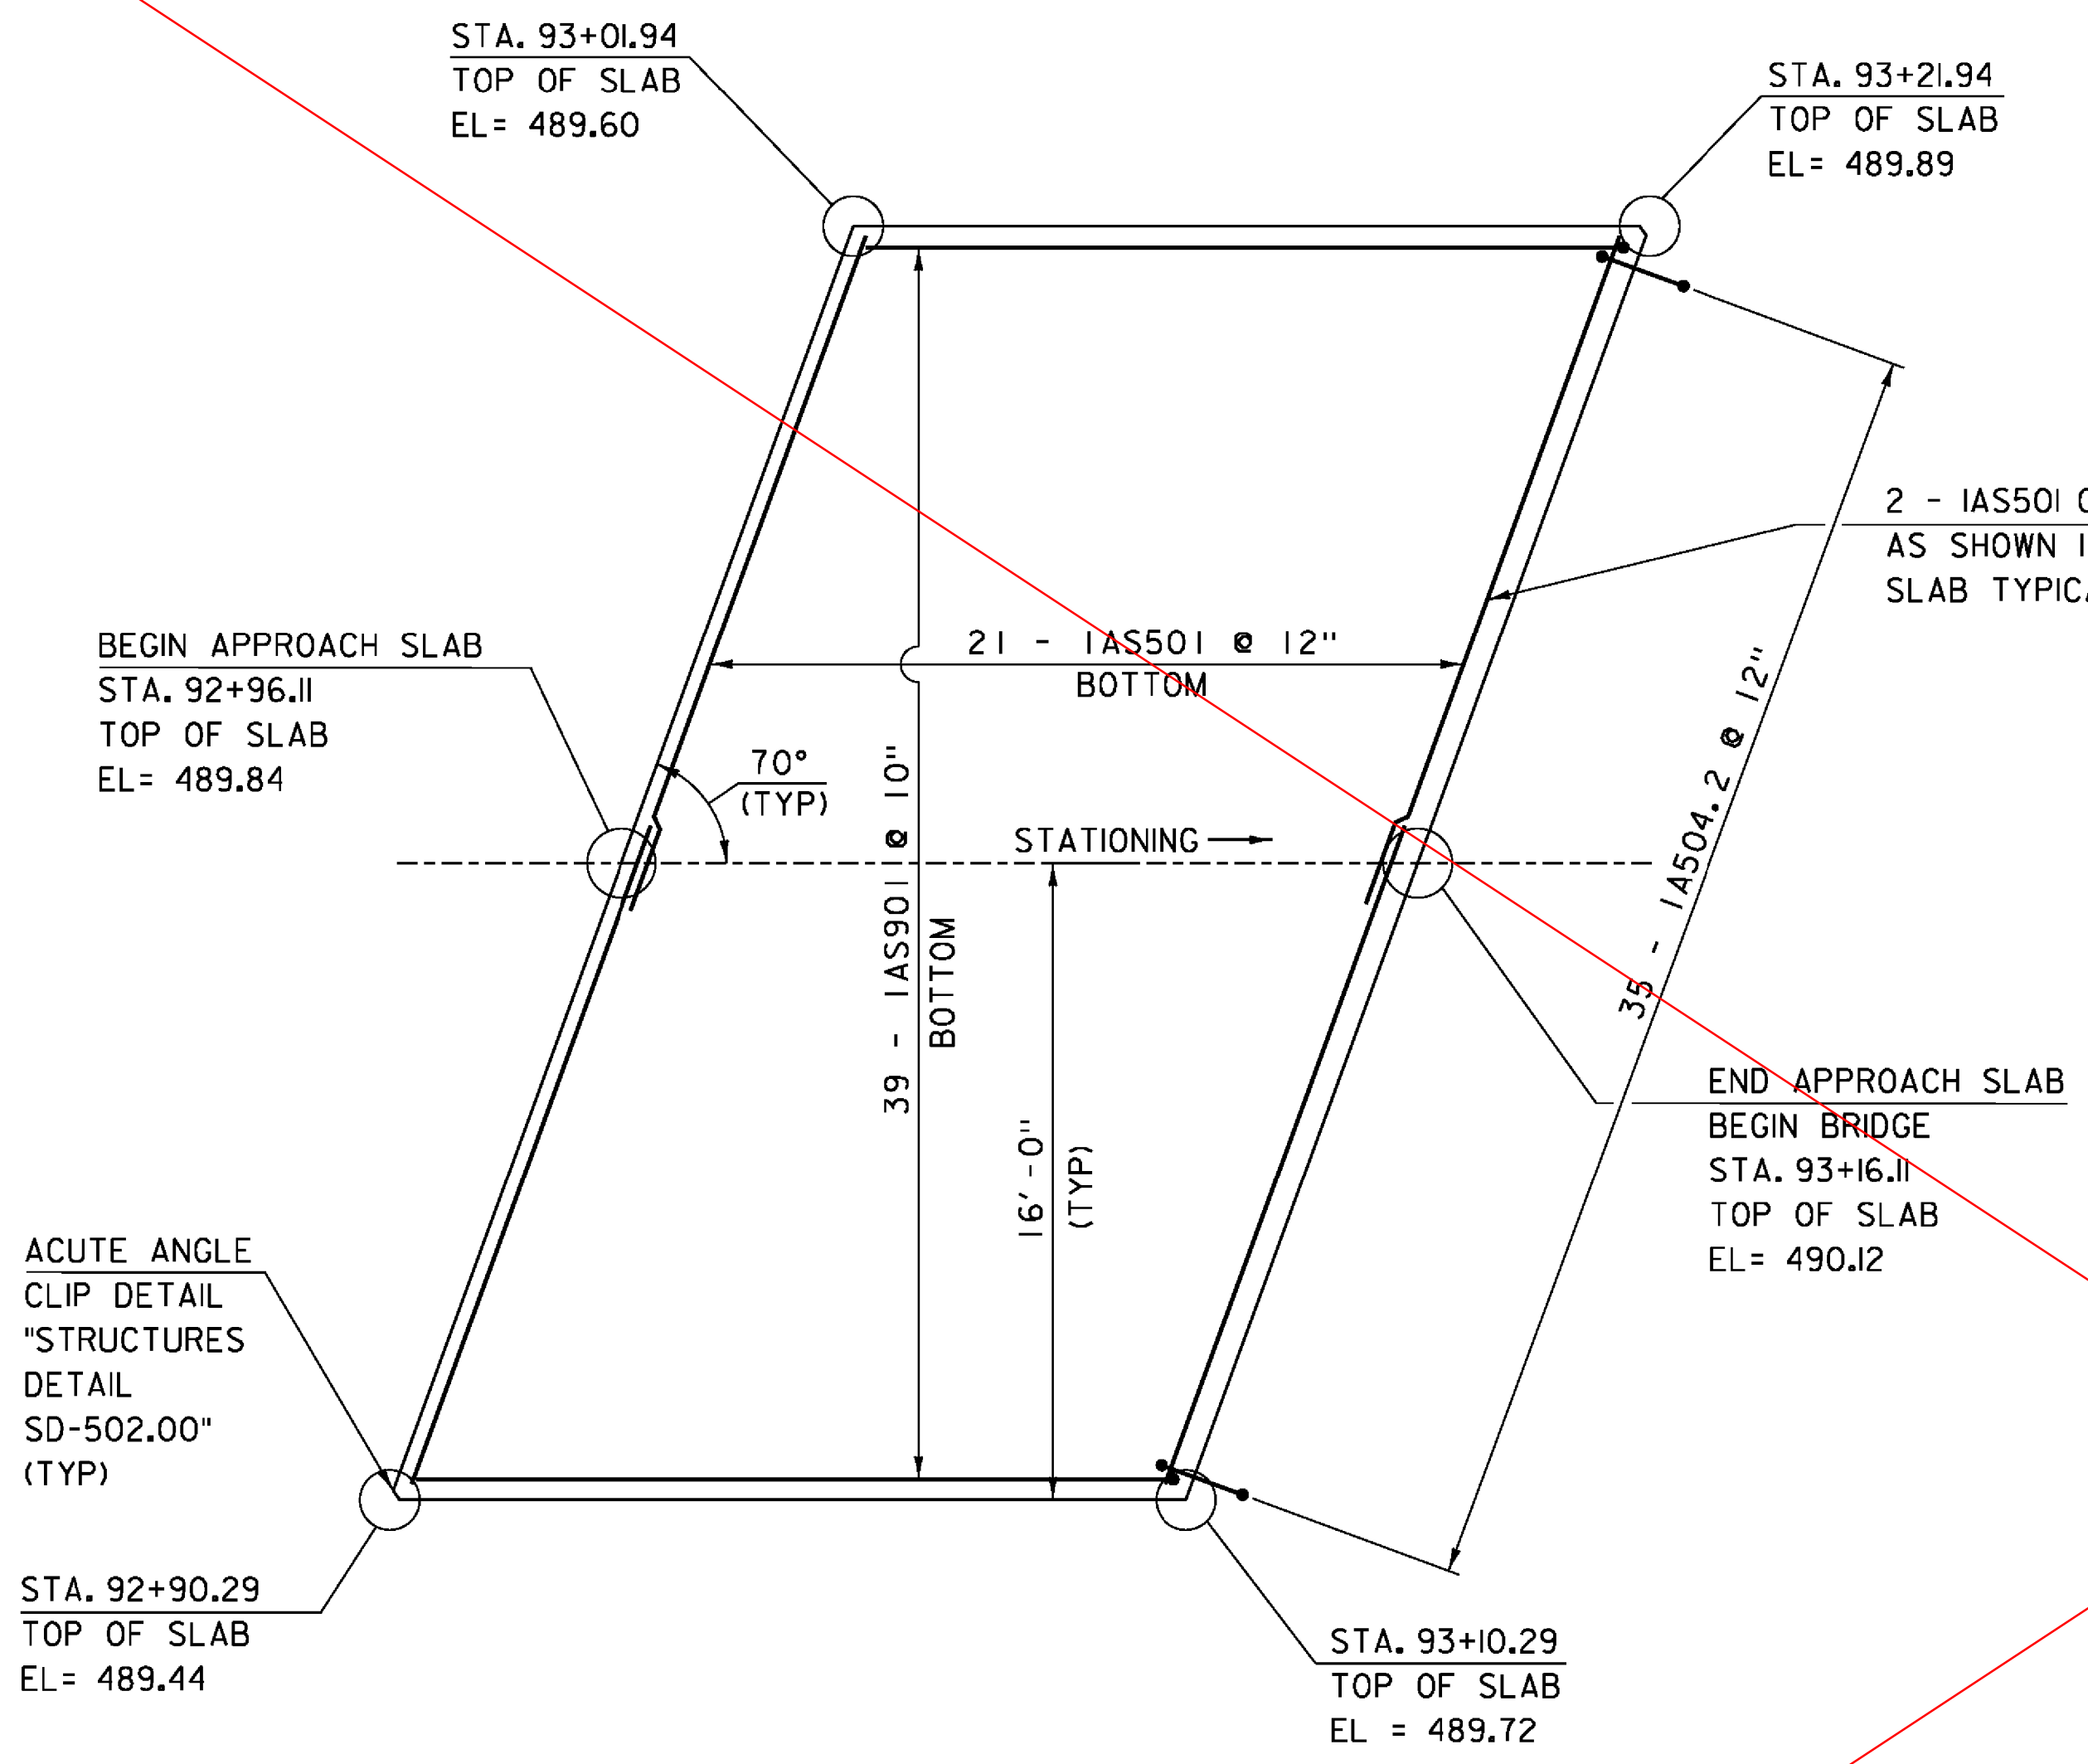

**APPROACH SLAB # 1 PLAN**  
SCALE: 1/4" = 1'-0"

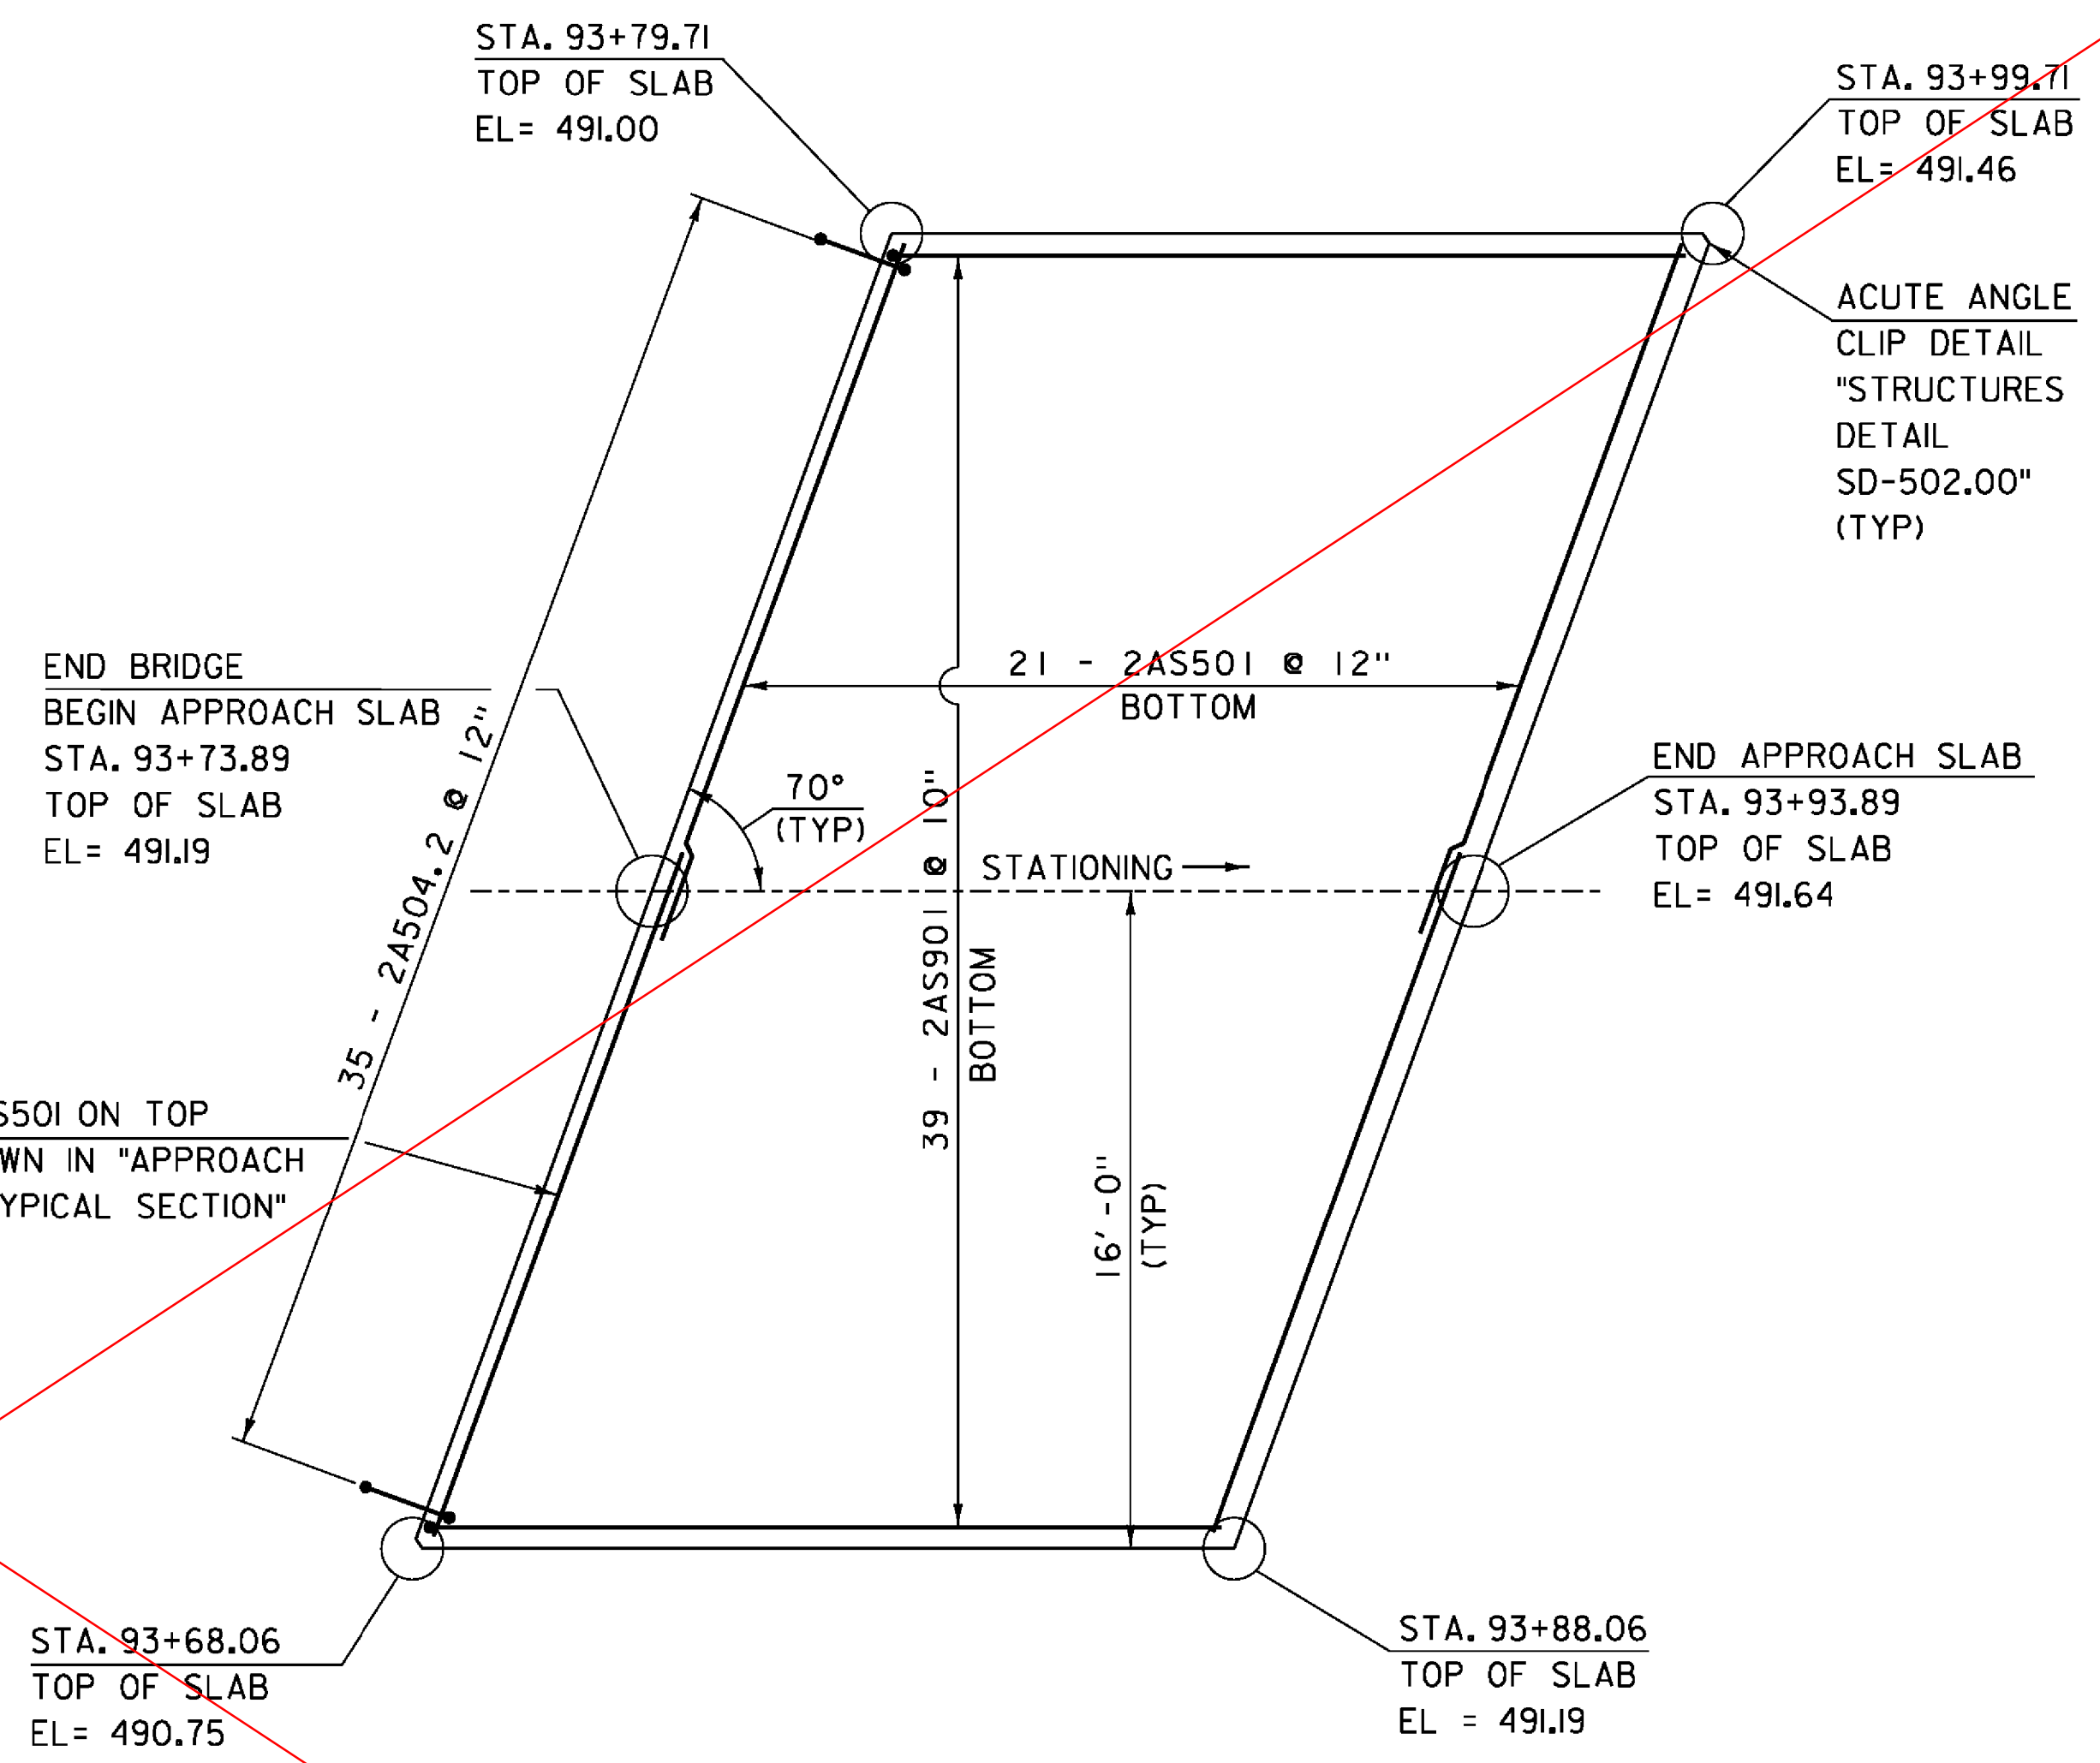

**APPROACH SLAB # 2 PLAN**  
SCALE: 1/4" = 1'-0"

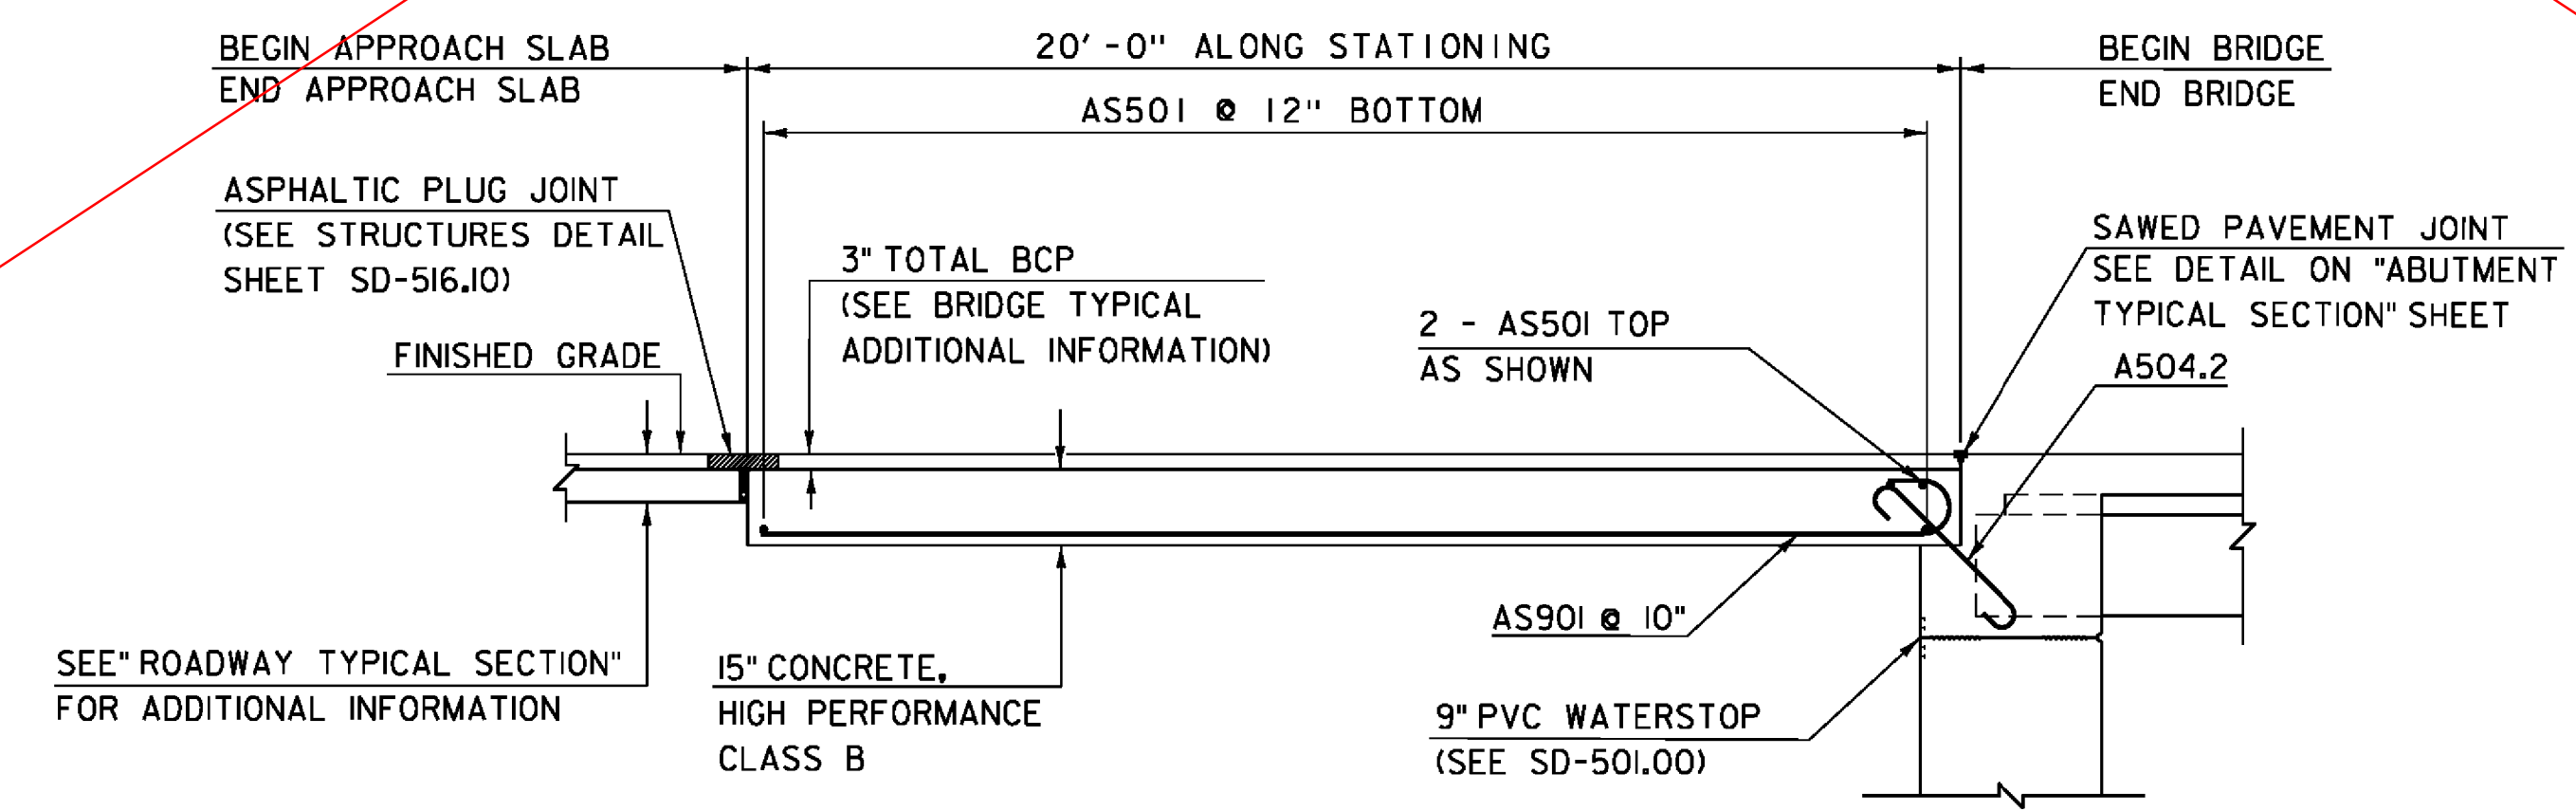


**APPROACH SLAB TYPICAL SECTION**  
SCALE: 3/8" = 1'-0"

**NOTE:**  
NF = NEAR FACE  
FF = FAR FACE  
EF = EACH FACE  
▲ = CUT TO FIT IN FIELD  
3" CLEAR, UNLESS OTHERWISE SPECIFIED ON THE PLANS.  
2'-2" BAR LAP UNLESS OTHERWISE SPECIFIED ON THE PLANS.


SEE REVISION: OCT-28-2014

PROJECT NAME:	JOHNSON	PLOT DATE:	10-JUN-2014
PROJECT NUMBER:	BRF 030-2(26)	DRAWN BY:	G. ROKES
FILE NAME:	s88bi93sub.dgn	CHECKED BY:	H. SALLS
PROJECT LEADER:	C. CARLSON	SHEET	31 OF 69
DESIGNED BY:	H. SALLS		

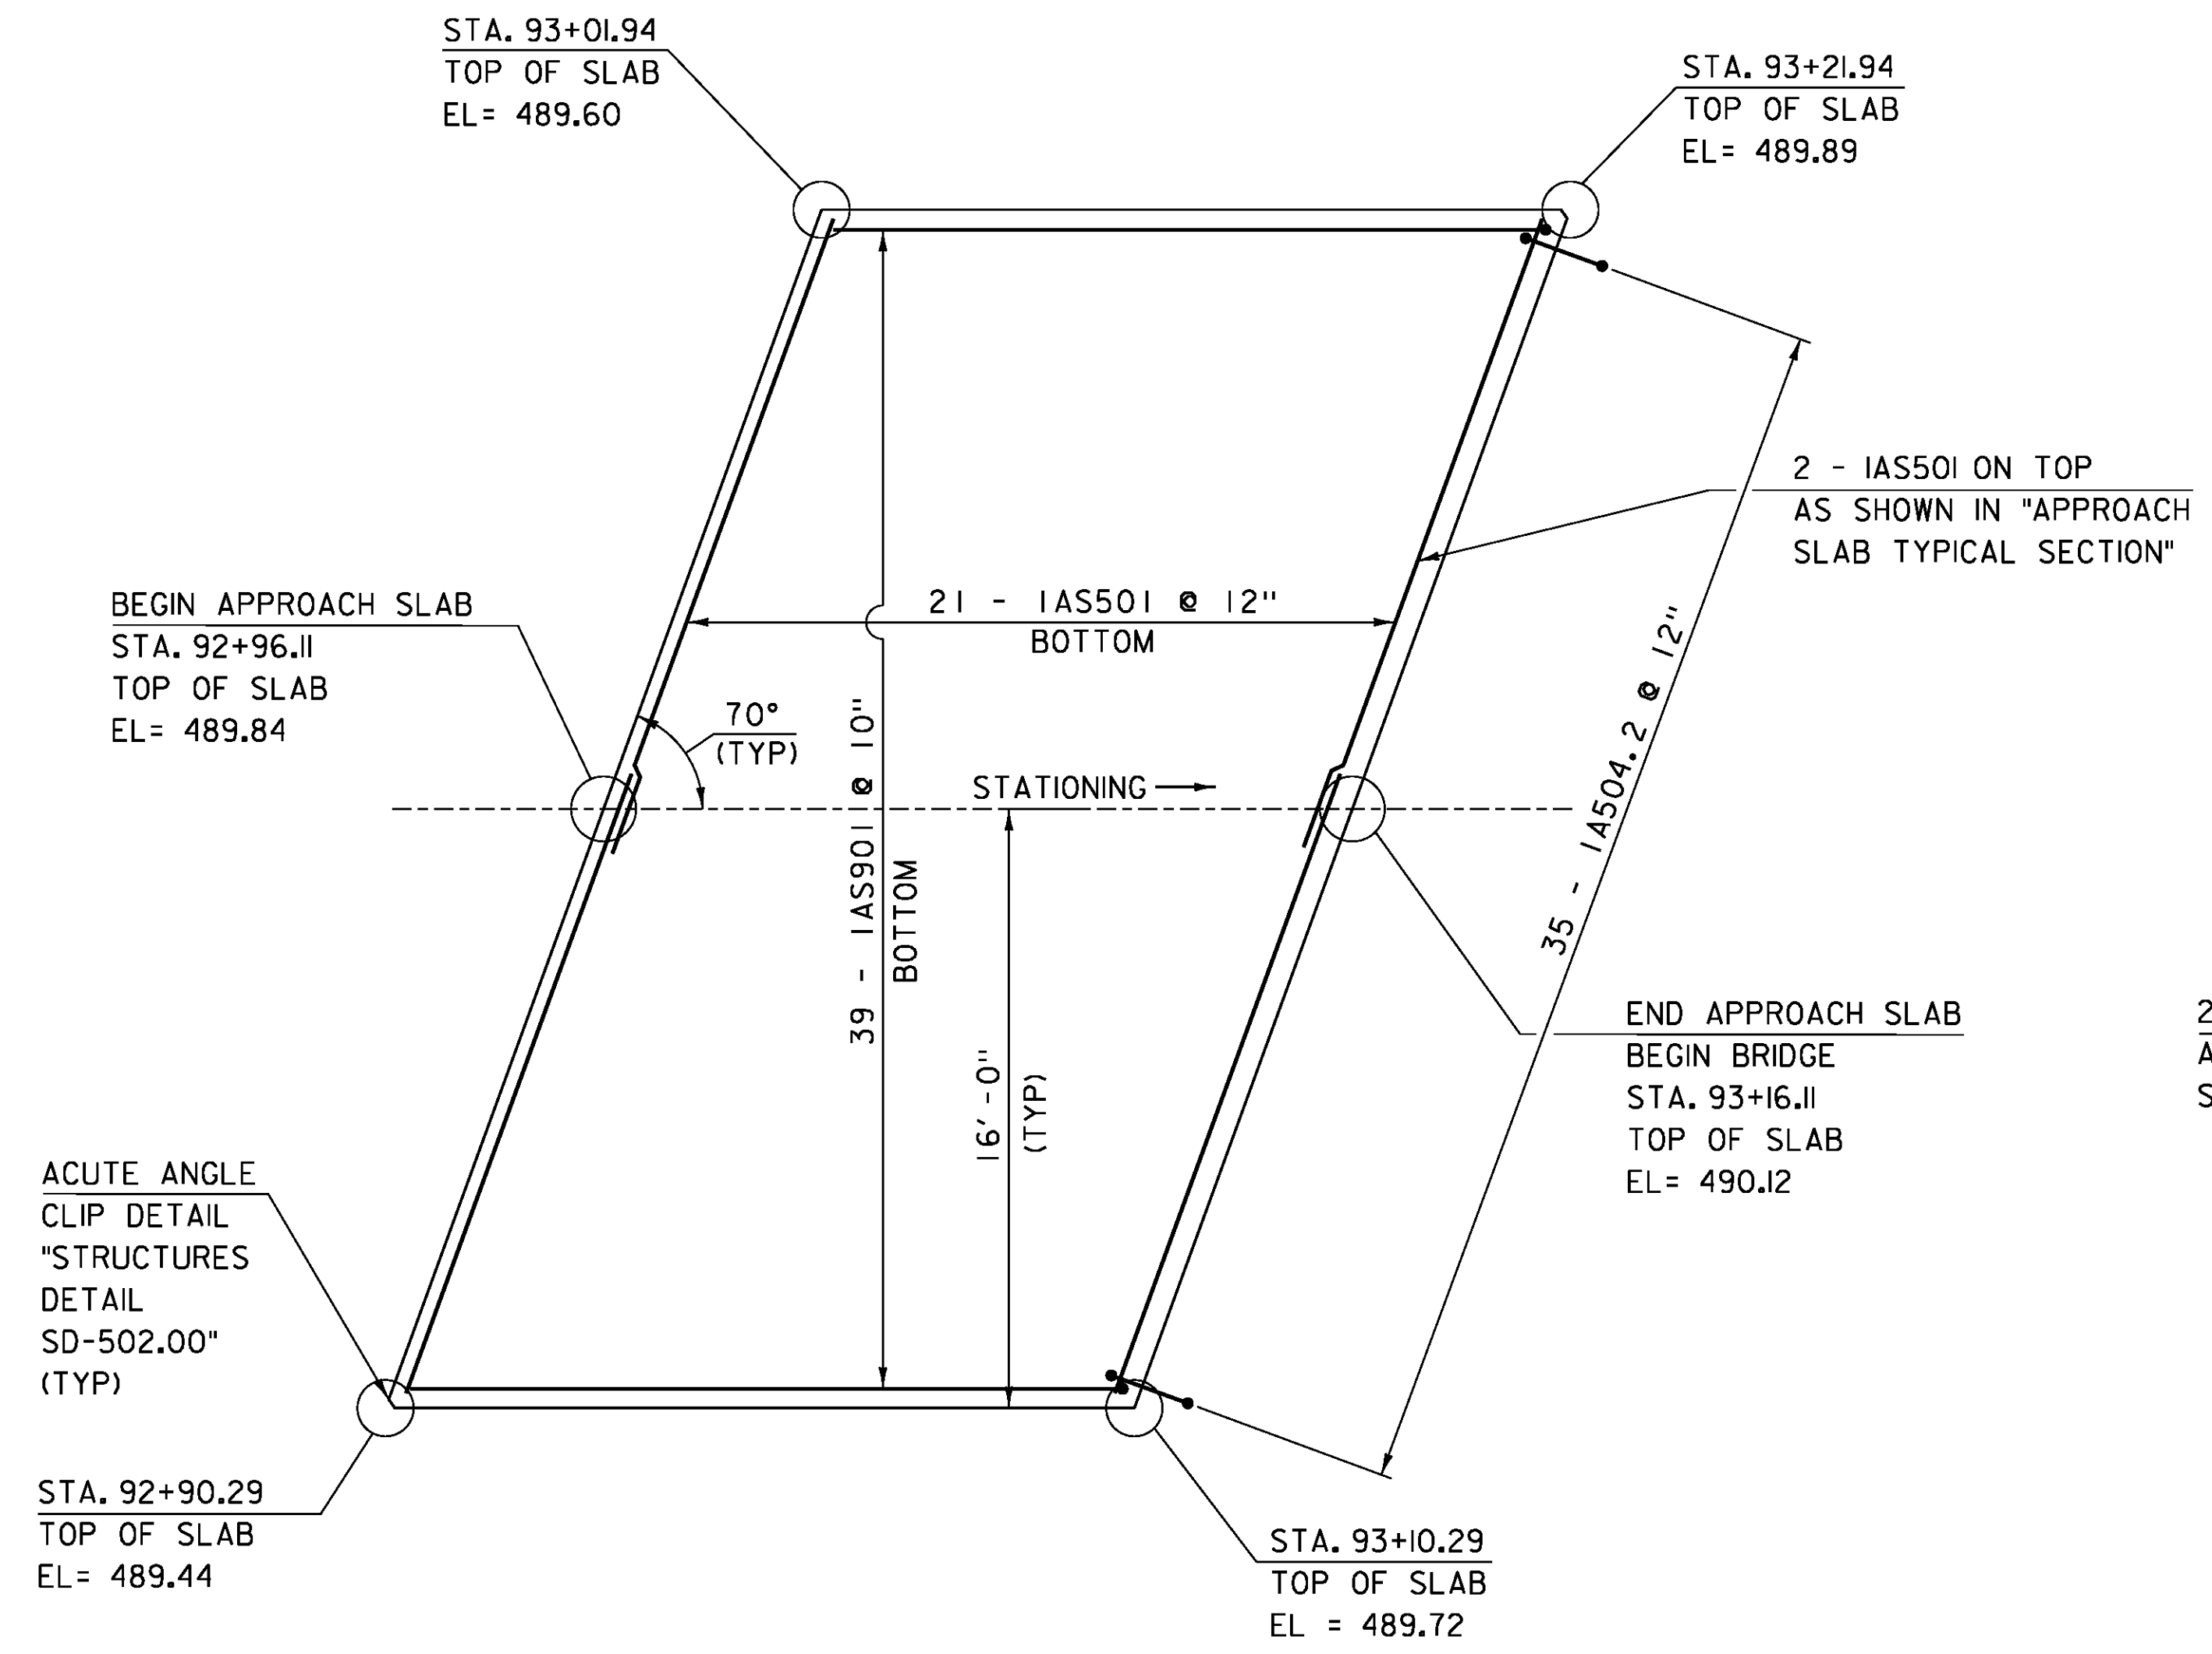


APPROACH SLAB # 1 PLAN

SCALE: 1/4" = 1'-0"

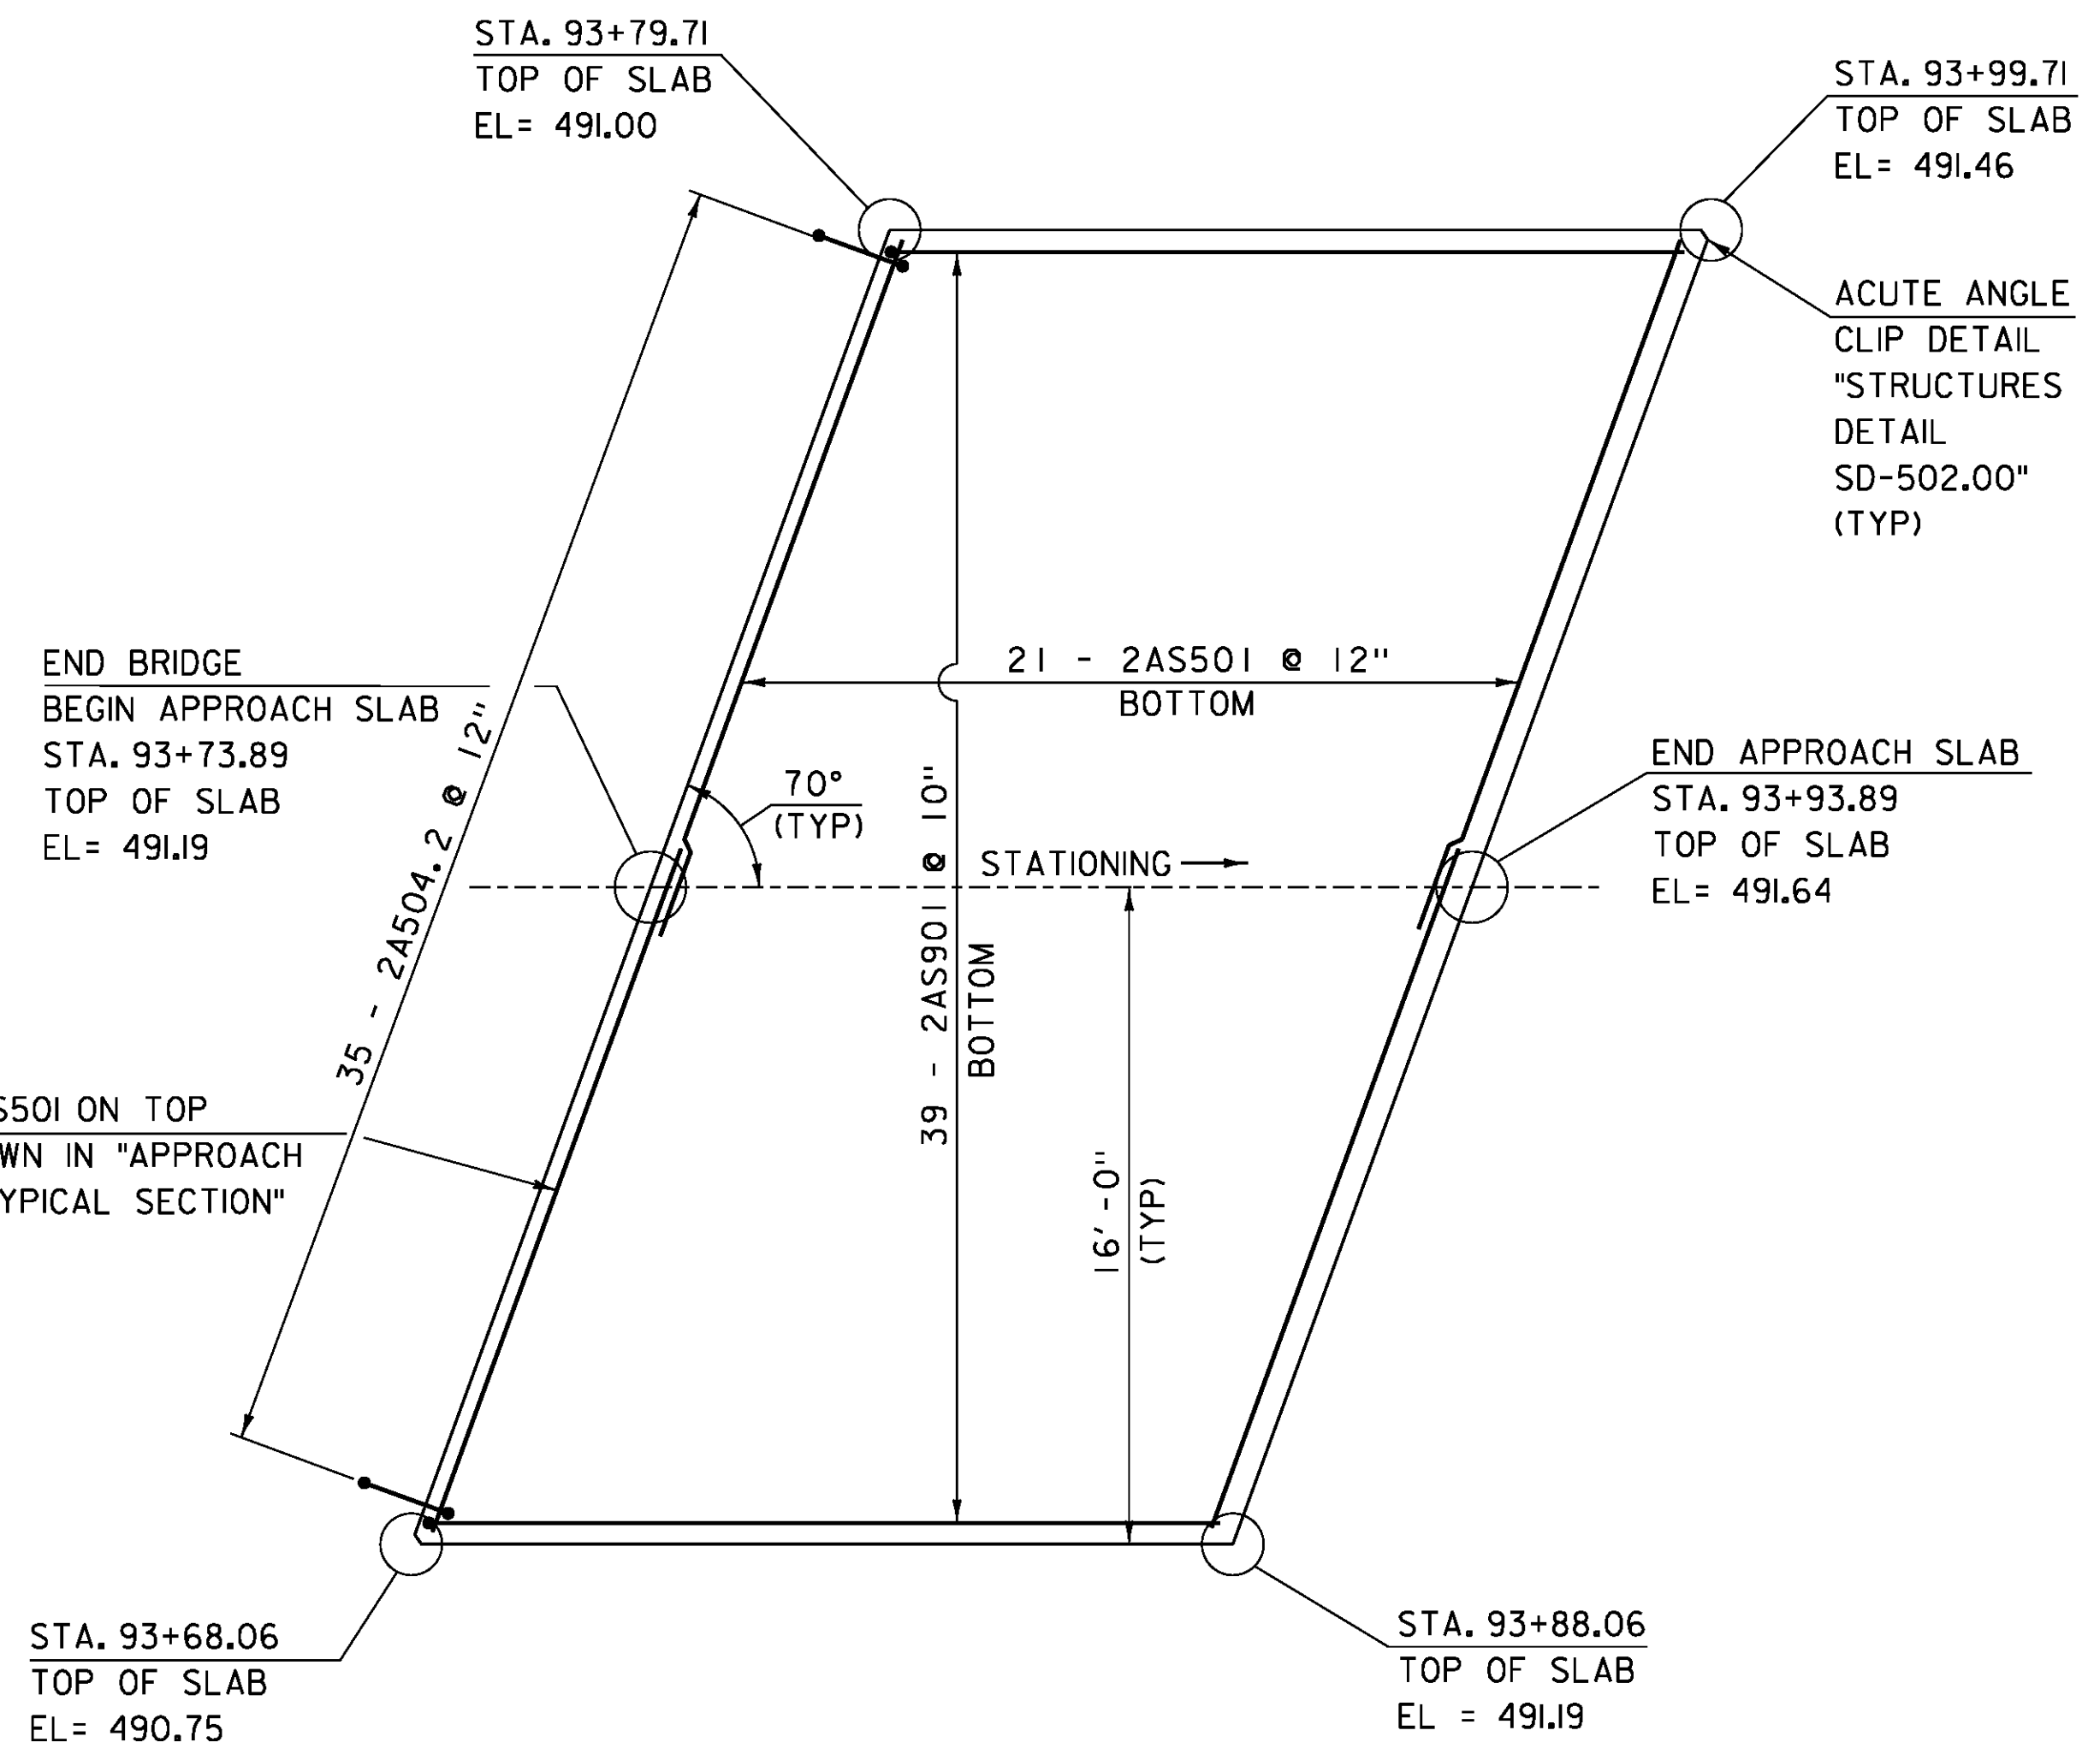

APPROACH SLAB # 2 PLAN

SCALE: 1/4" = 1'-0"

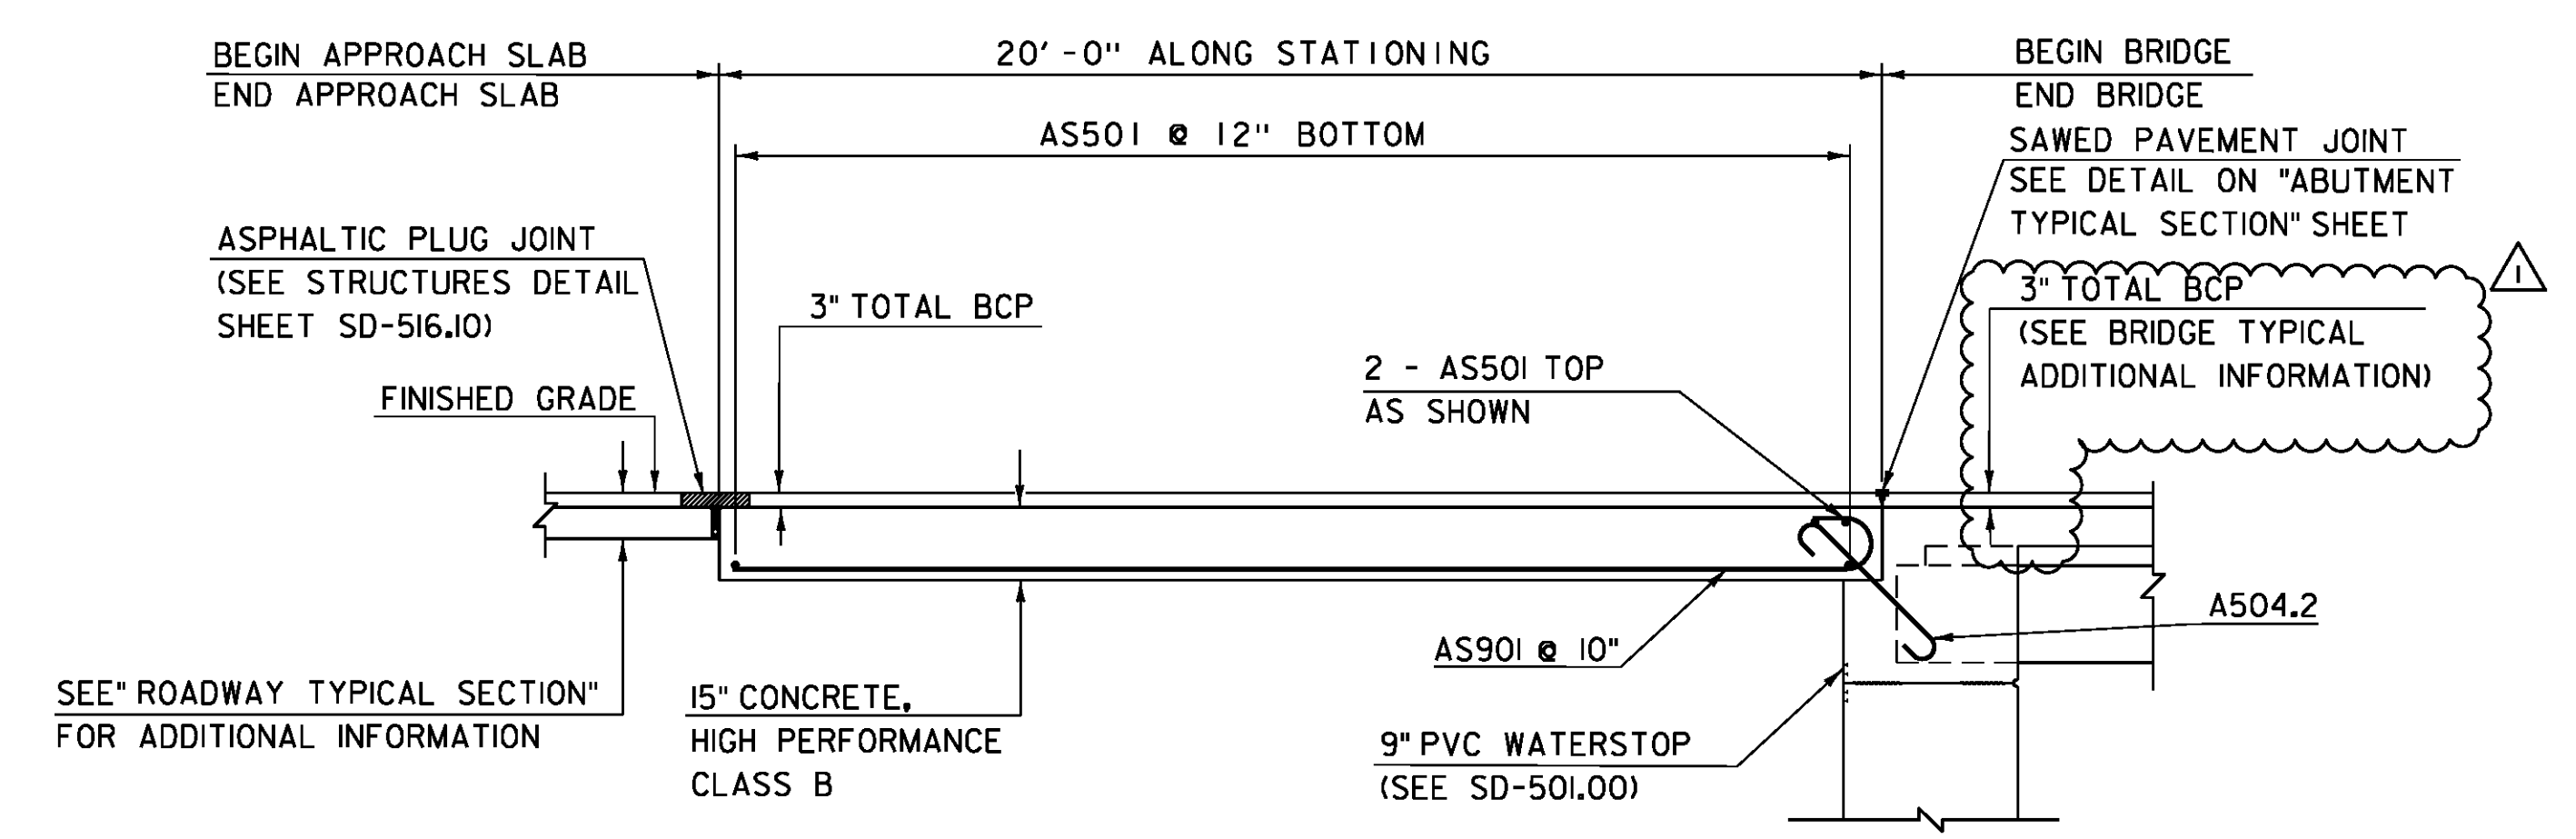


APPROACH SLAB TYPICAL SECTION

SCALE: 3/8" = 1'-0"

REVISION	DATE	DESCRIPTION	BY
1	OCT-28-2014	ADD 3" PAYMENT, LOWER BRIDGE SEAT, ADD 3" CONCRETE PEDESTAL	GNR


**NOTE:**  
 NF = NEAR FACE  
 FF = FAR FACE  
 EF = EACH FACE  
 ▲ = CUT TO FIT IN FIELD  
 3" CLEAR, UNLESS OTHERWISE SPECIFIED ON THE PLANS.  
 2'-2" BAR LAP UNLESS OTHERWISE SPECIFIED ON THE PLANS.

PROJECT NAME:	JOHNSON
PROJECT NUMBER:	BRF 030-2(26)
FILE NAME:	s88bl93sub.dgn
PROJECT LEADER:	C. CARLSON
DESIGNED BY:	H. SALLS
APPROACH SLAB PLAN AND TYPICAL SECTION	
PLOT DATE:	05-NOV-2014
DRAWN BY:	G. ROKES
CHECKED BY:	H. SALLS
SHEET	31 OF 69

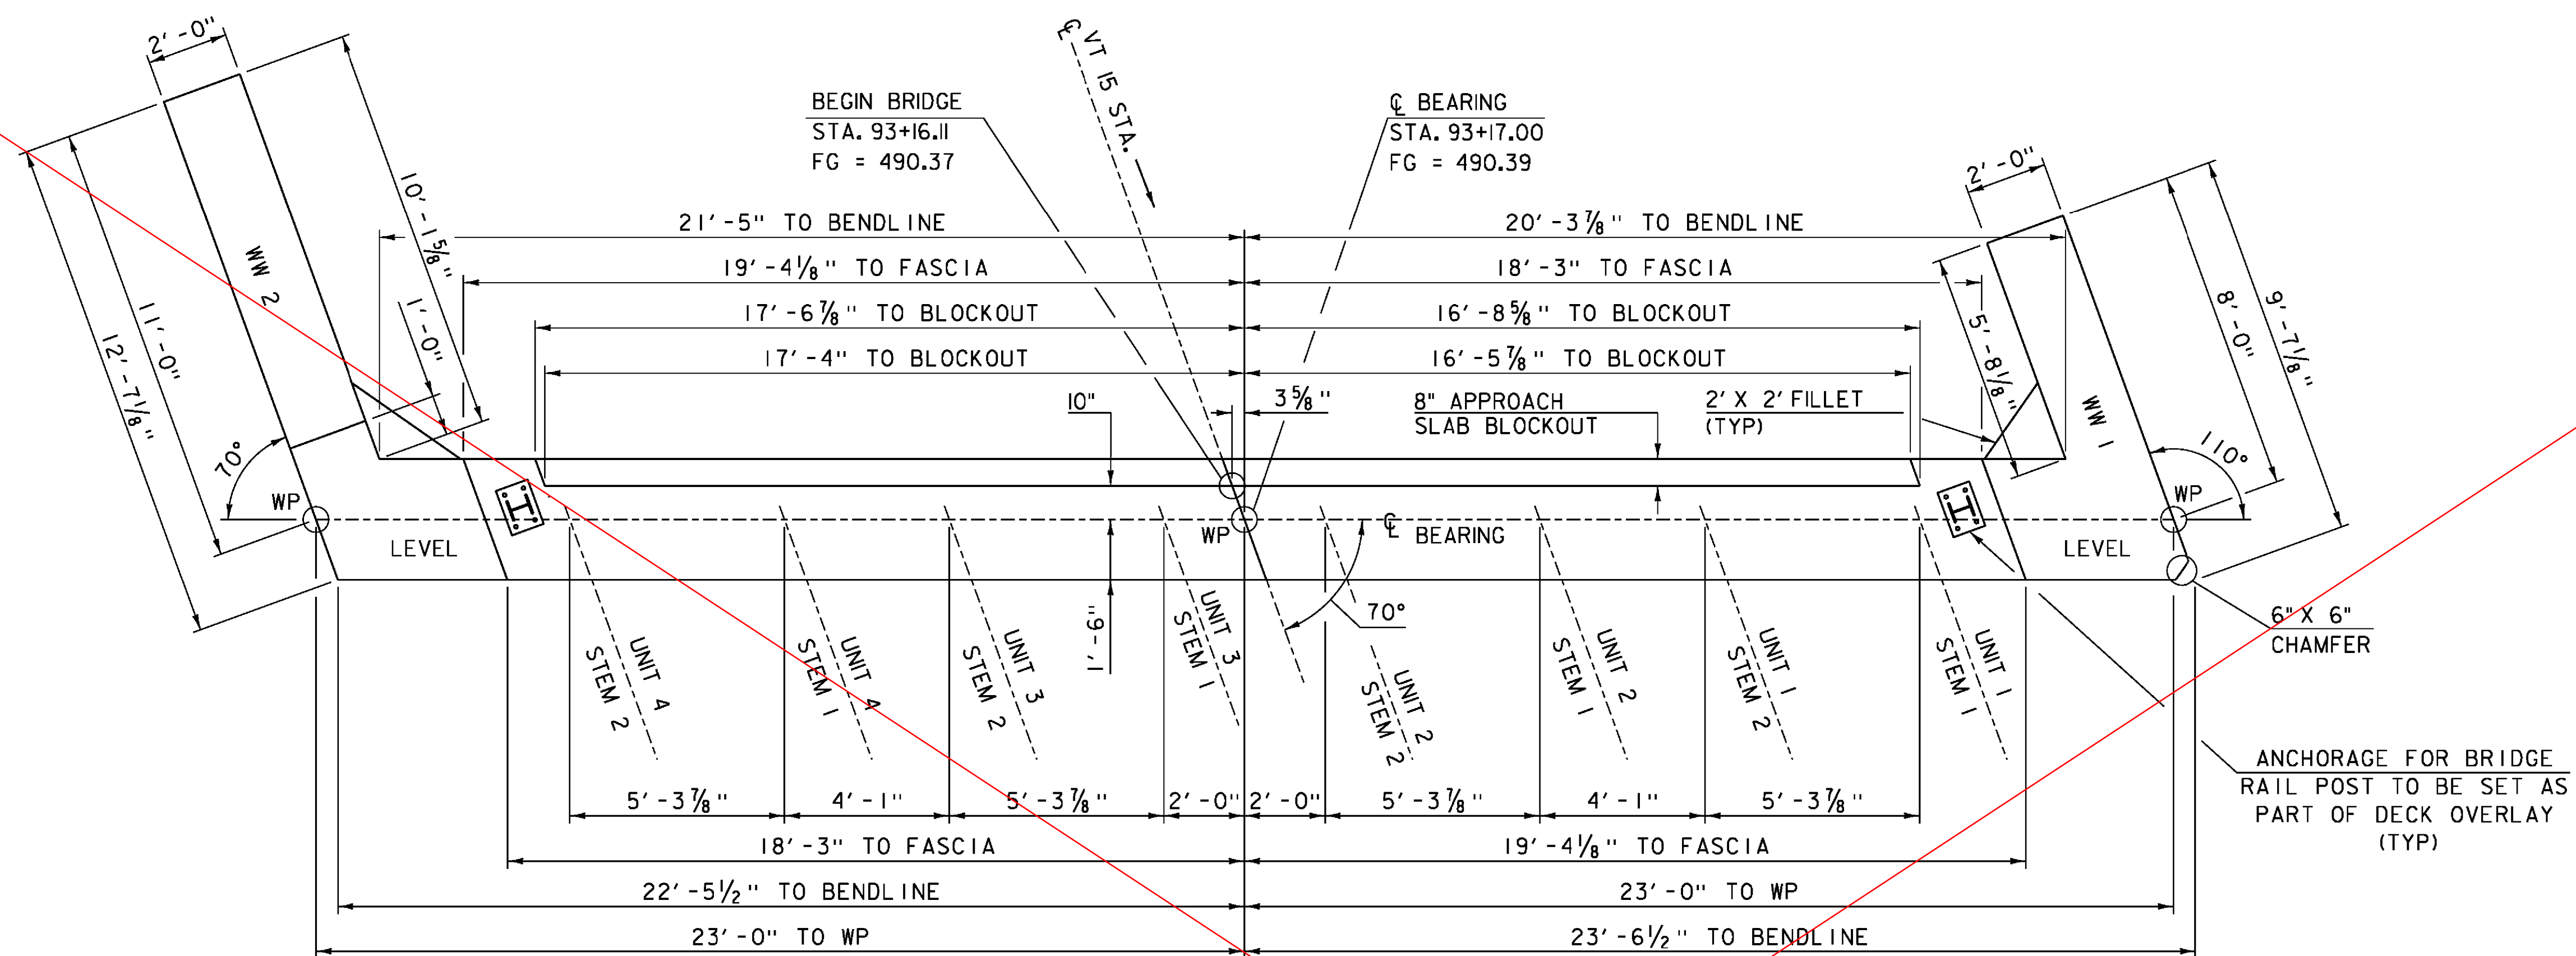

**ABUTMENT #1 PLAN**

SCALE: 3/8" = 1'-0"

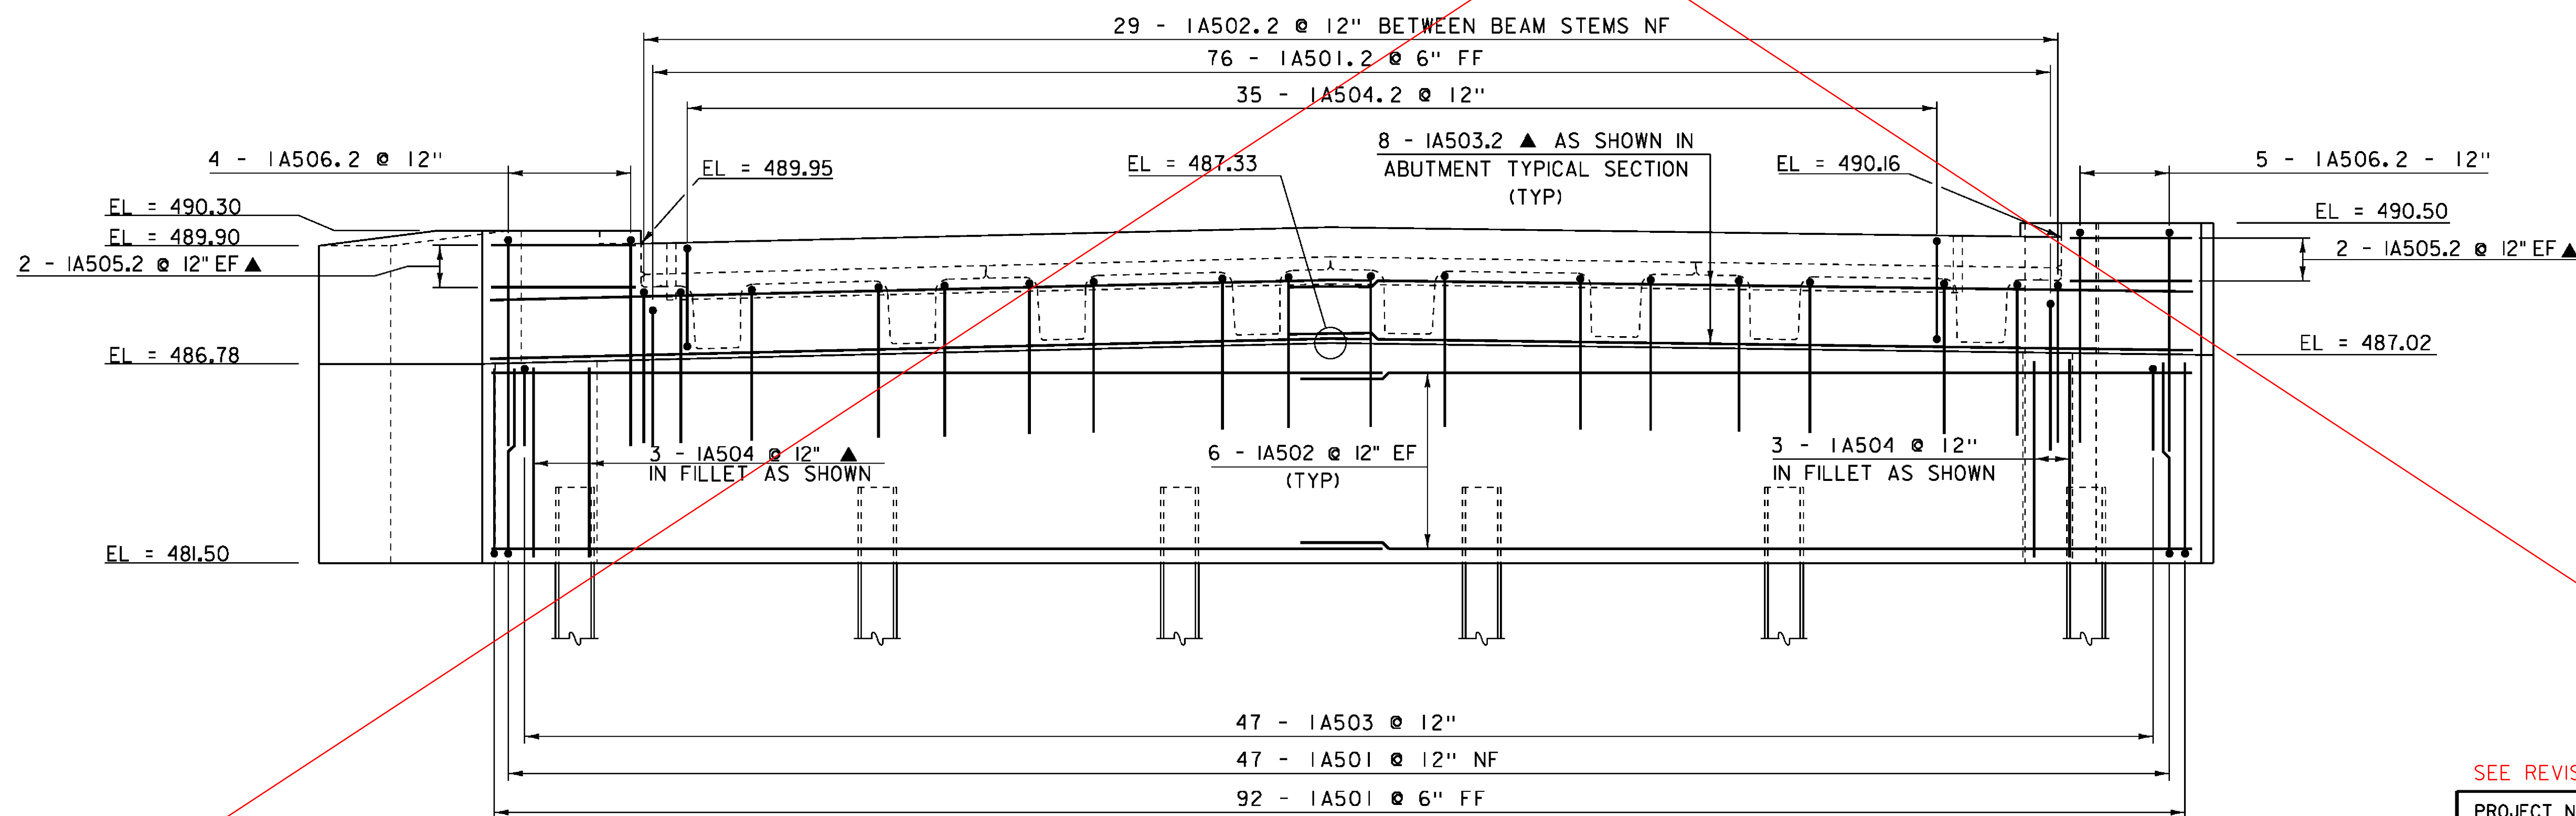

**ABUTMENT #1 ELEVATION**

SCALE: 3/8" = 1'-0"


**NOTE:**

- NF = NEAR FACE
- FF = FAR FACE
- EF = EACH FACE
- ▲ = CUT TO FIT IN FIELD
- 3" CLEAR, UNLESS OTHERWISE SPECIFIED ON THE PLANS.
- 2'-2" BAR LAP UNLESS OTHERWISE SPECIFIED ON THE PLANS.

SEE REVISION: OCT-28-2014


PROJECT NAME: JOHNSON  
PROJECT NUMBER: BRF 030-2(26)

FILE NAME: s88bi93sub.dgn	PLOT DATE: 10-JUN-2014
PROJECT LEADER: C. CARLSON	DRAWN BY: G. ROKES
DESIGNED BY: H. SALLS	CHECKED BY: H. SALLS
ABUTMENT #1 PLAN AND ELEVATION	SHEET 32 OF 69

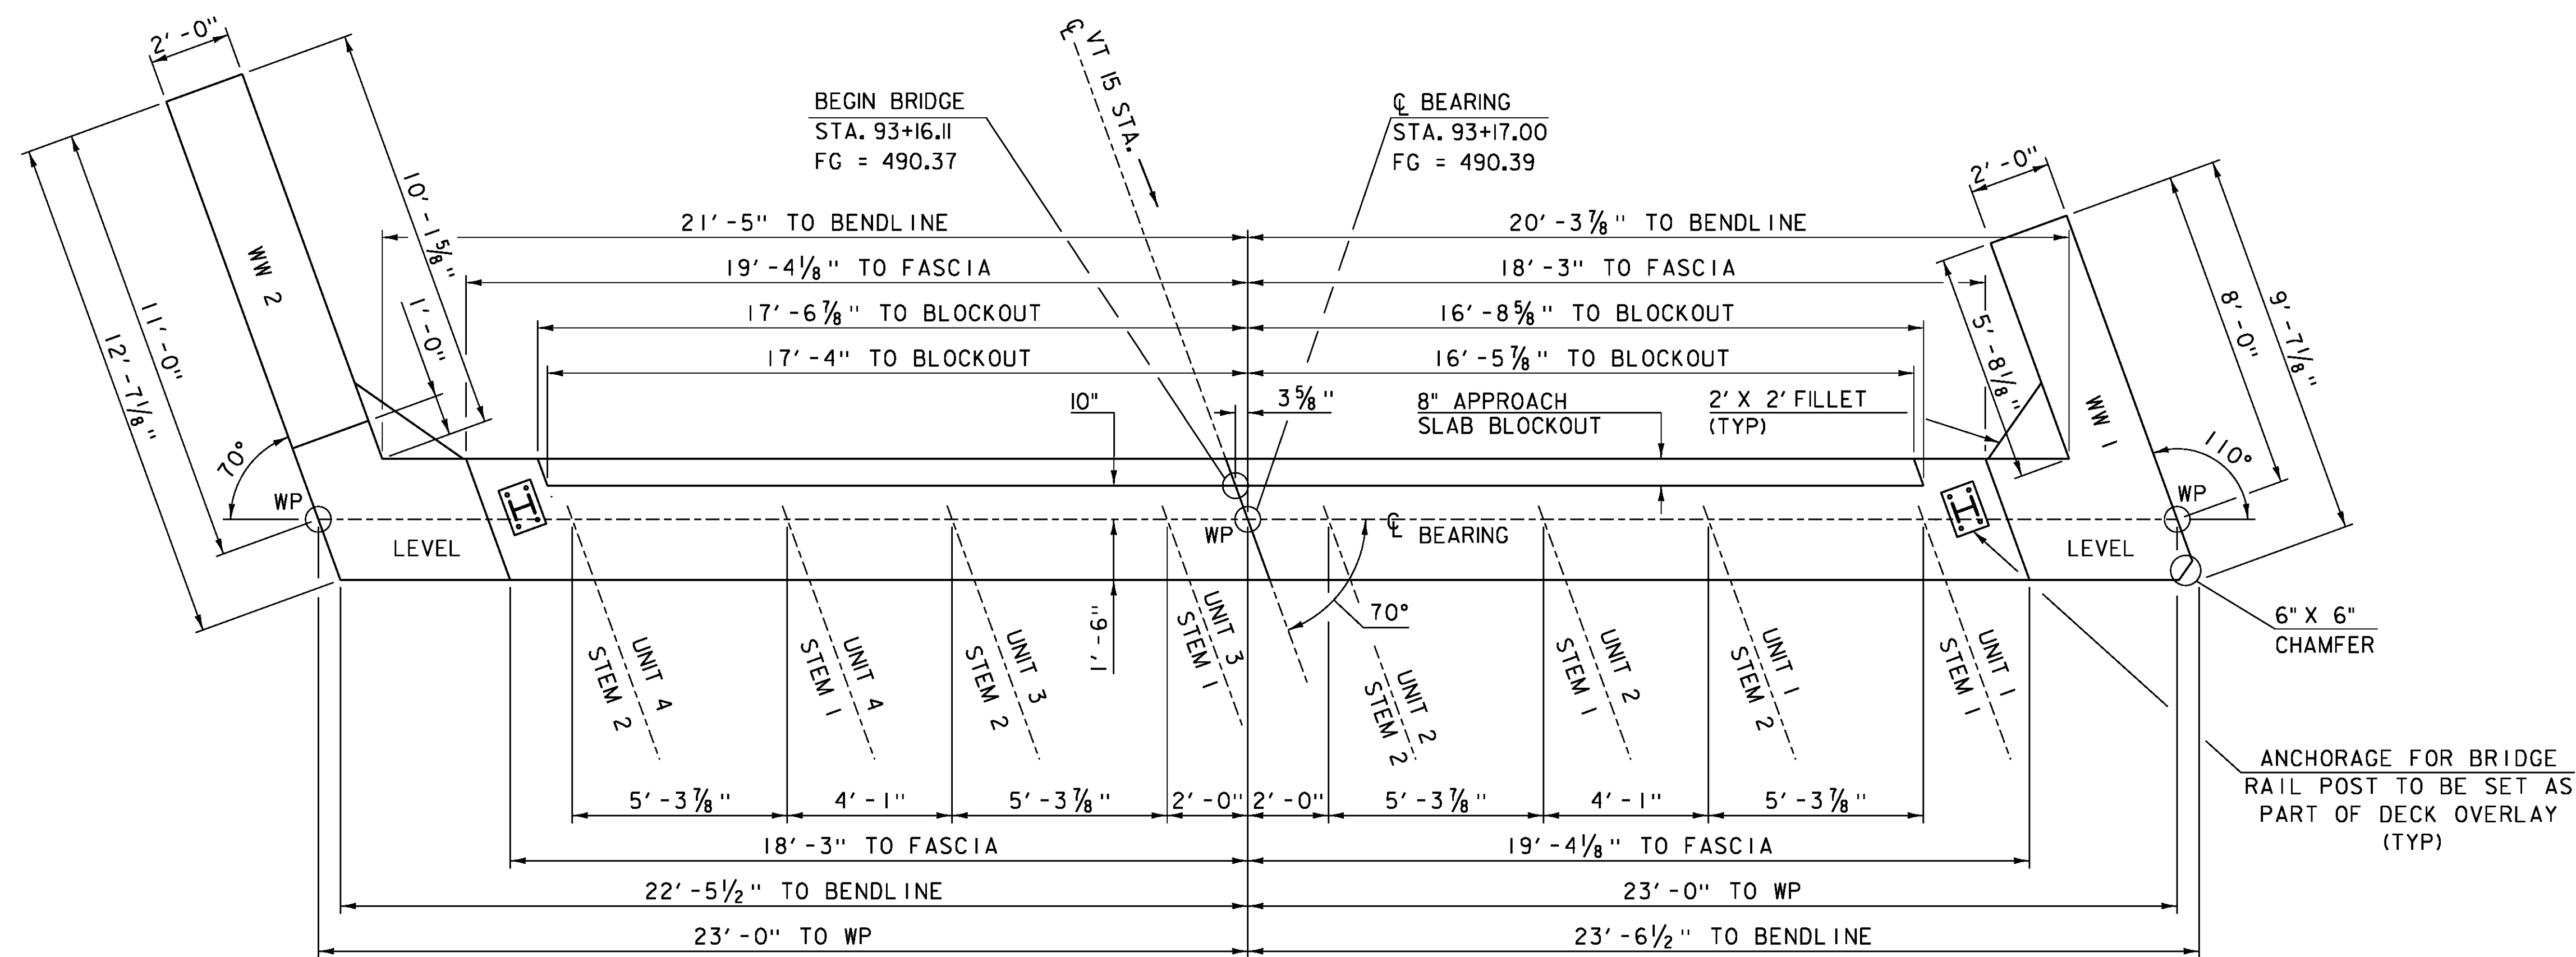

**ABUTMENT #1 PLAN**

SCALE: 3/8" = 1'-0"

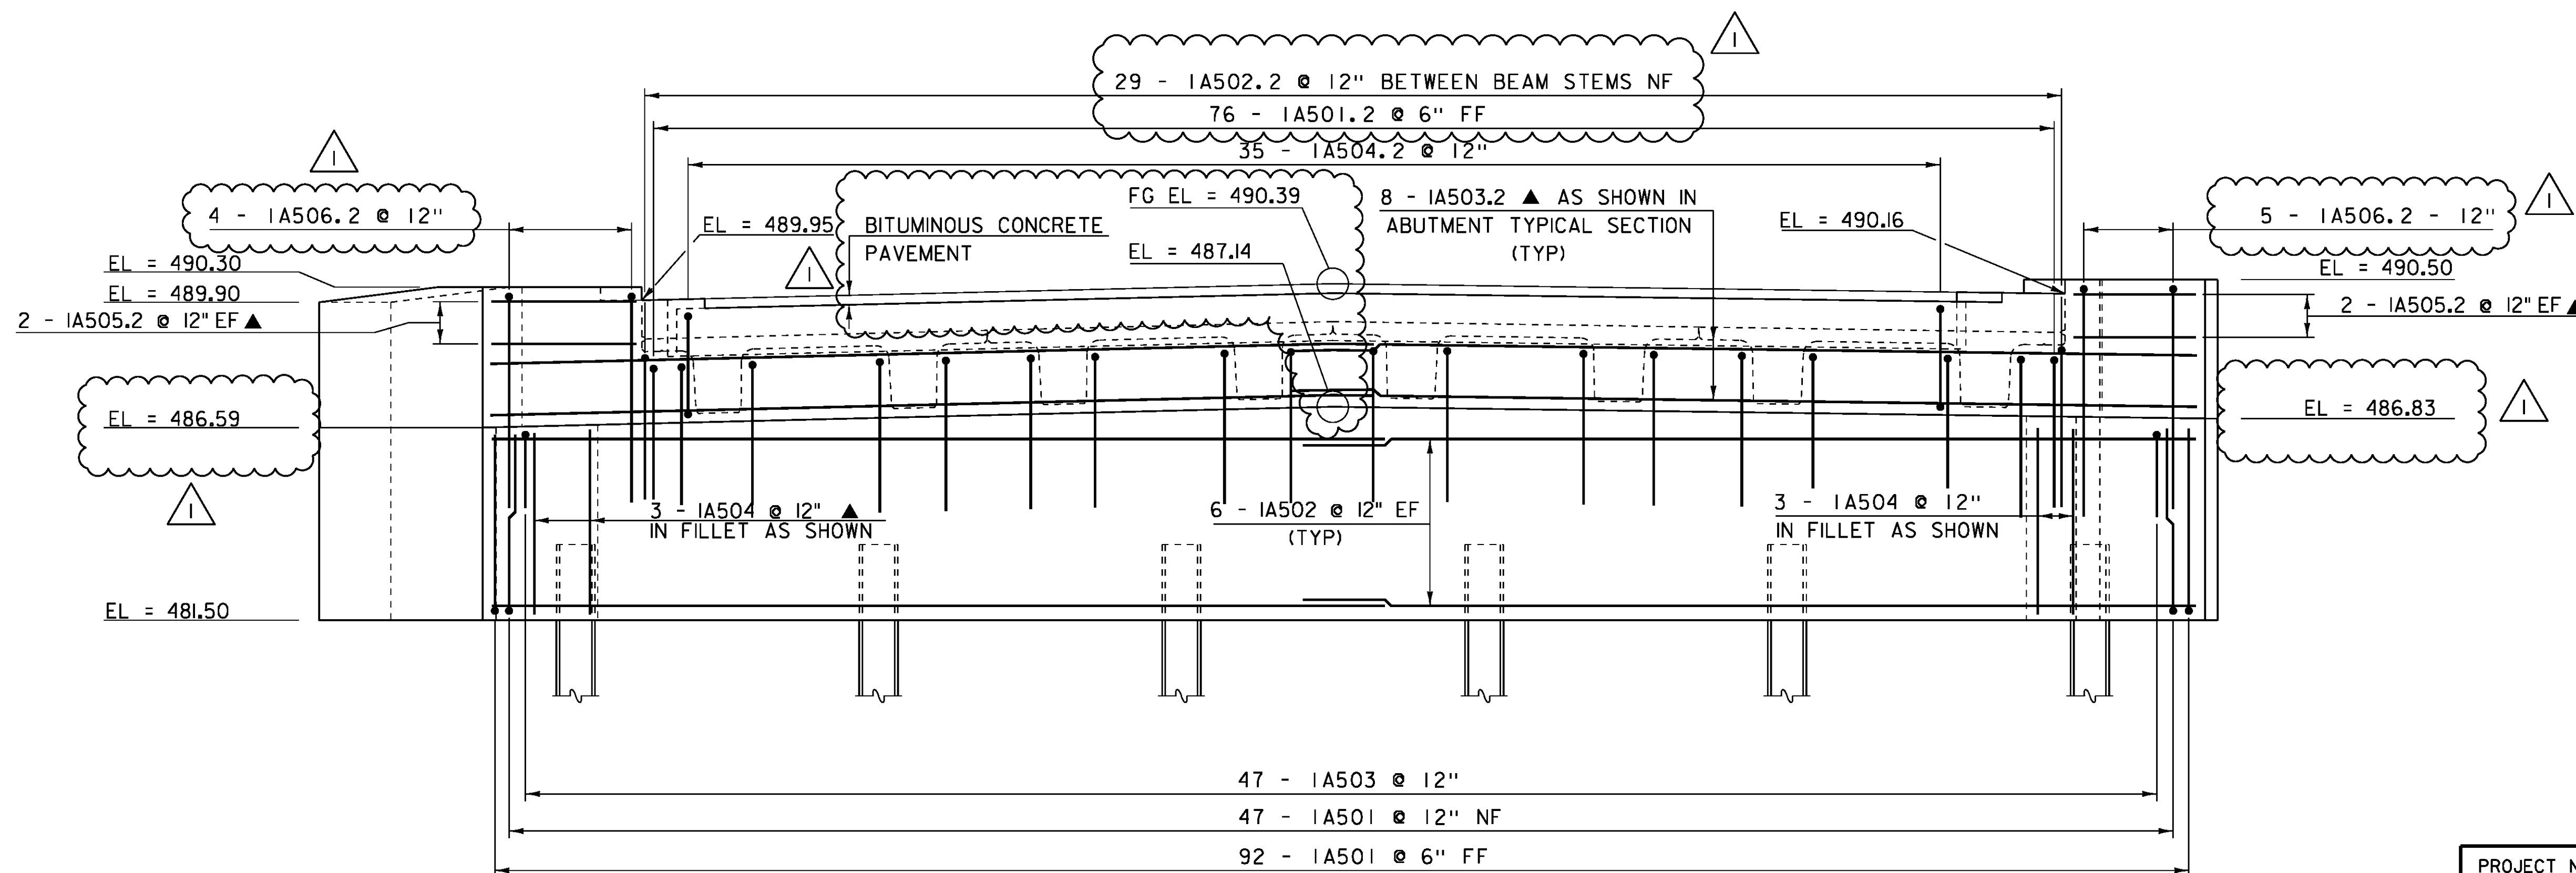

**ABUTMENT #1 ELEVATION**

SCALE: 3/8" = 1'-0"

**NOTE:**


- NF = NEAR FACE
- FF = FAR FACE
- EF = EACH FACE
- ▲ = CUT TO FIT IN FIELD
- 3" CLEAR, UNLESS OTHERWISE SPECIFIED ON THE PLANS.
- 2'-2" BAR LAP UNLESS OTHERWISE SPECIFIED ON THE PLANS.

REVISION	DATE	DESCRIPTION	BY
1	OCT-28-2014	ADD 3" PAYMENT, LOWER BRIDGE SEAT, ADD 3" CONCRETE PEDESTAL	GNR


PROJECT NAME: JOHNSON  
PROJECT NUMBER: BRF 030-2(26)

FILE NAME: s88bl93sub.dgn  
PROJECT LEADER: C. CARLSON  
DESIGNED BY: H. SALLS  
ABUTMENT #1 PLAN AND ELEVATION

PLOT DATE: 05-NOV-2014  
DRAWN BY: G. ROKES  
CHECKED BY: H. SALLS  
SHEET 32 OF 69

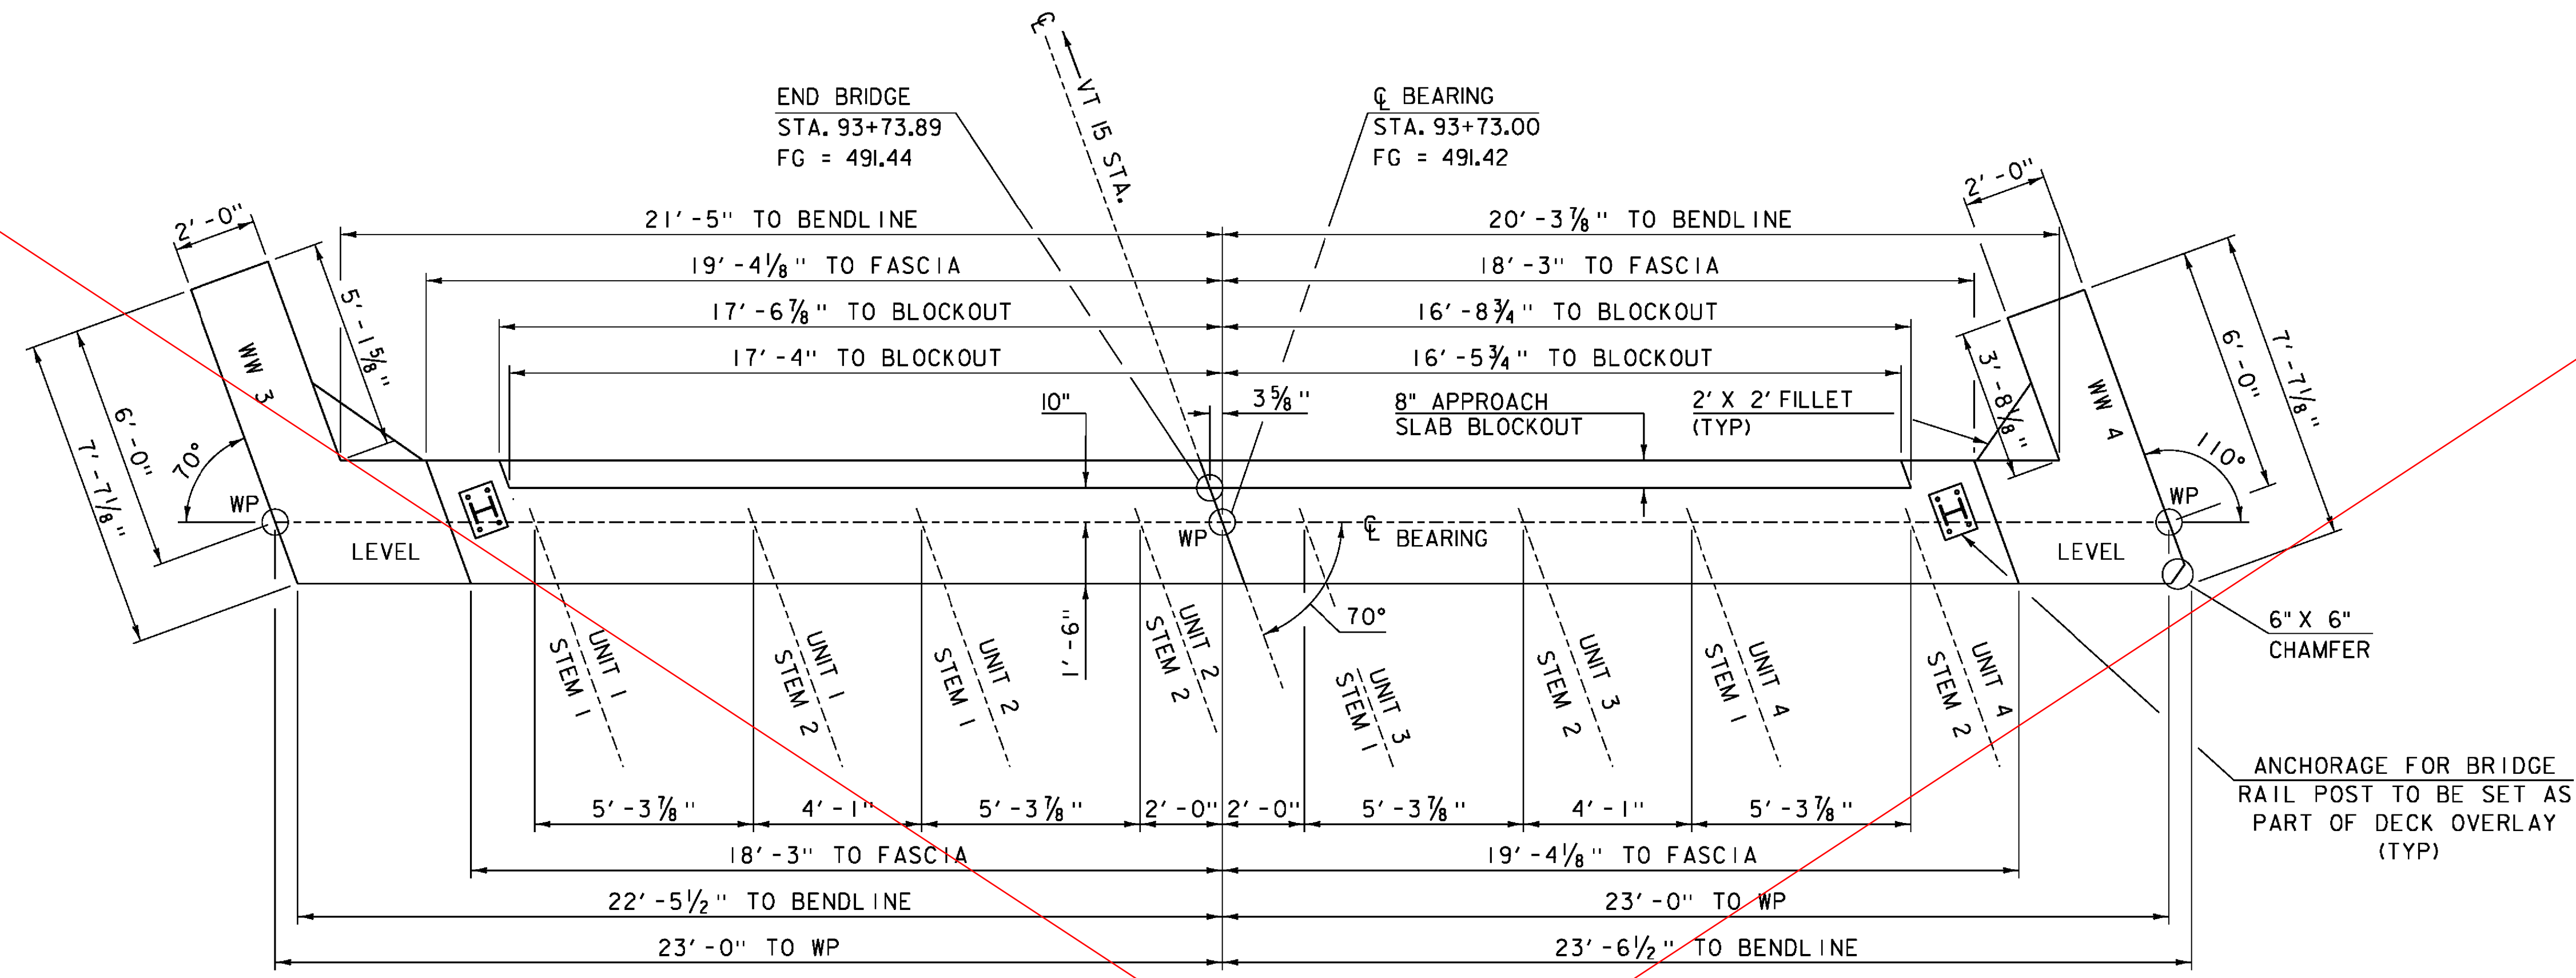

**ABUTMENT #2 PLAN**  
SCALE: 3/8" = 1'-0"

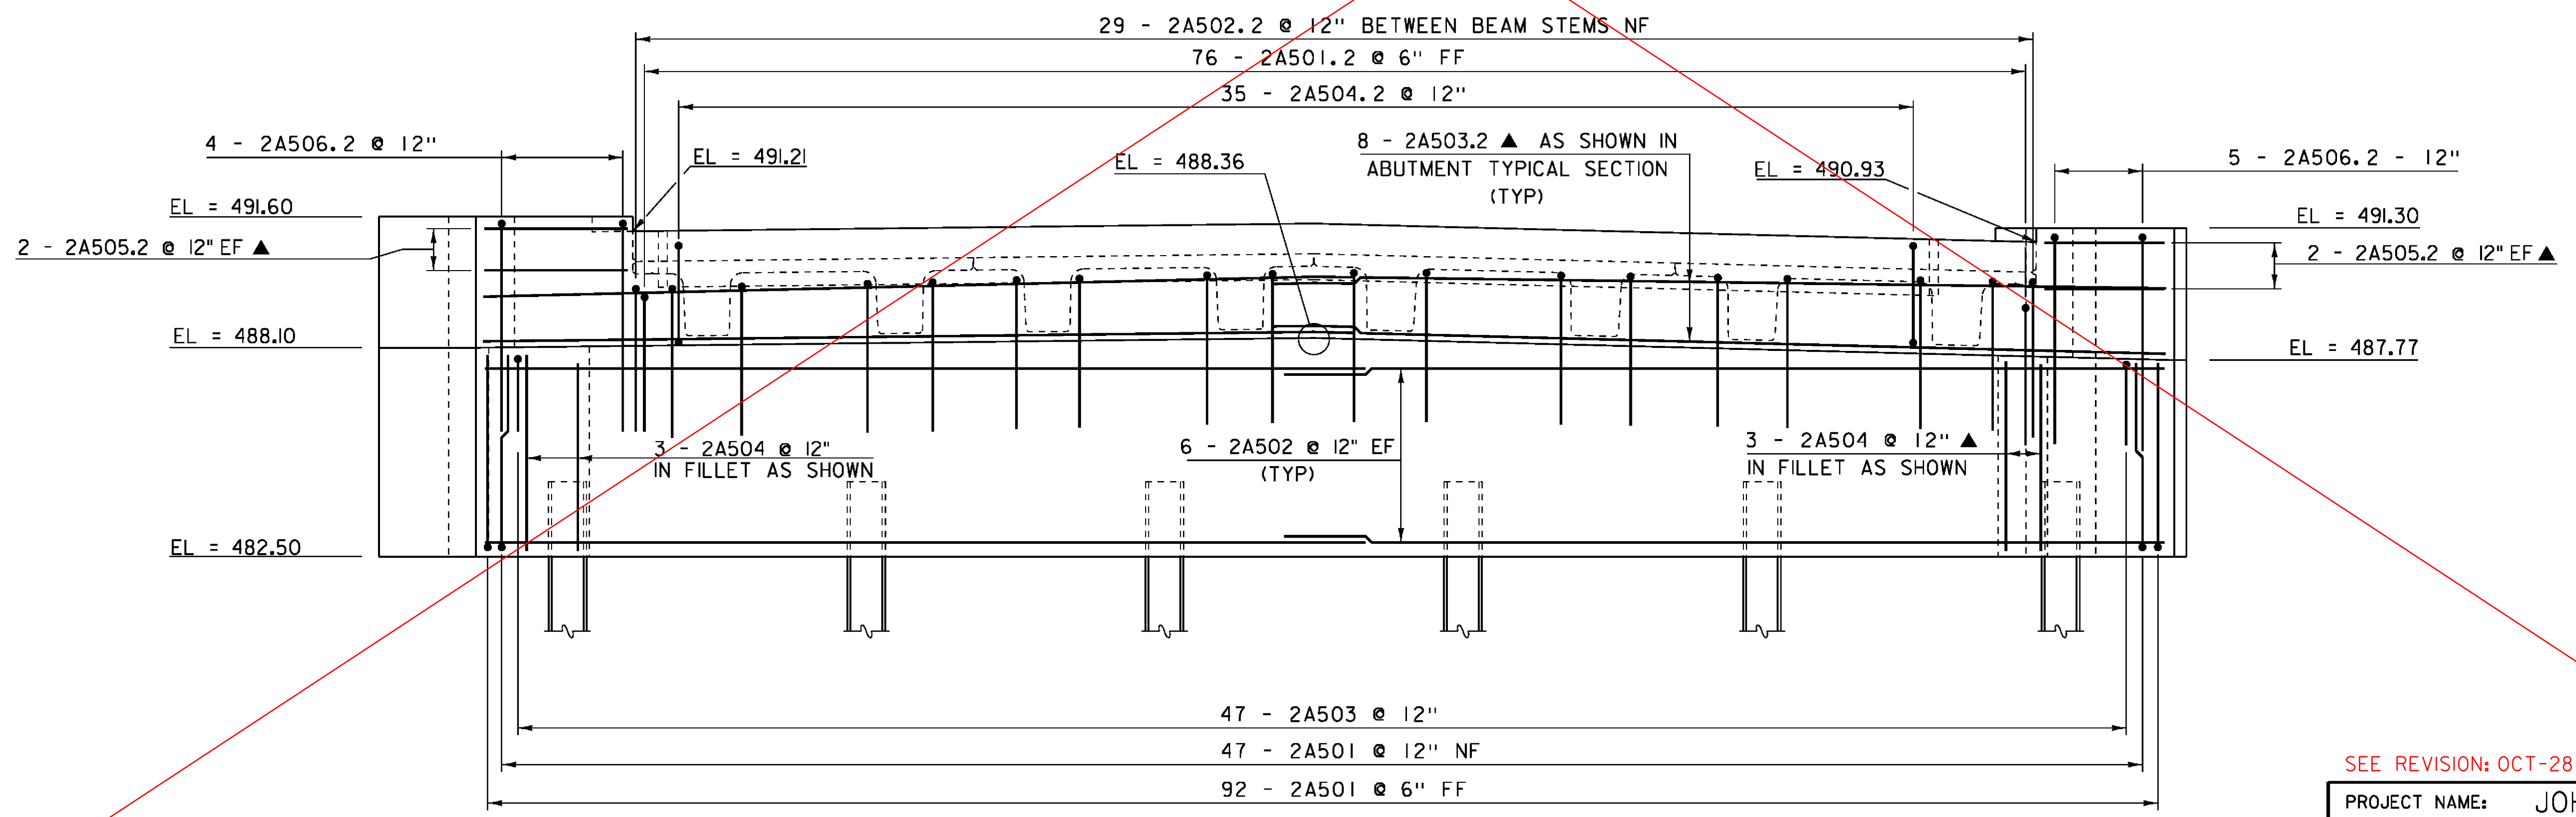


**ABUTMENT #2 ELEVATION**  
SCALE: 3/8" = 1'-0"

**NOTE:**  
 NF = NEAR FACE  
 FF = FAR FACE  
 EF = EACH FACE  
 ▲ = CUT TO FIT IN FIELD  
 3" CLEAR, UNLESS OTHERWISE SPECIFIED ON THE PLANS.  
 2'-2" BAR LAP UNLESS OTHERWISE SPECIFIED ON THE PLANS.


SEE REVISION: OCT-28-2014

PROJECT NAME:	JOHNSON	PLOT DATE:	10-JUN-2014
PROJECT NUMBER:	BRF 030-2(26)	DRAWN BY:	G. ROKES
FILE NAME:	s88bi93sub.dgn	CHECKED BY:	H. SALLS
PROJECT LEADER:	C. CARLSON	SHEET	33 OF 69
DESIGNED BY:	H. SALLS		
ABUTMENT #2 PLAN AND ELEVATION			

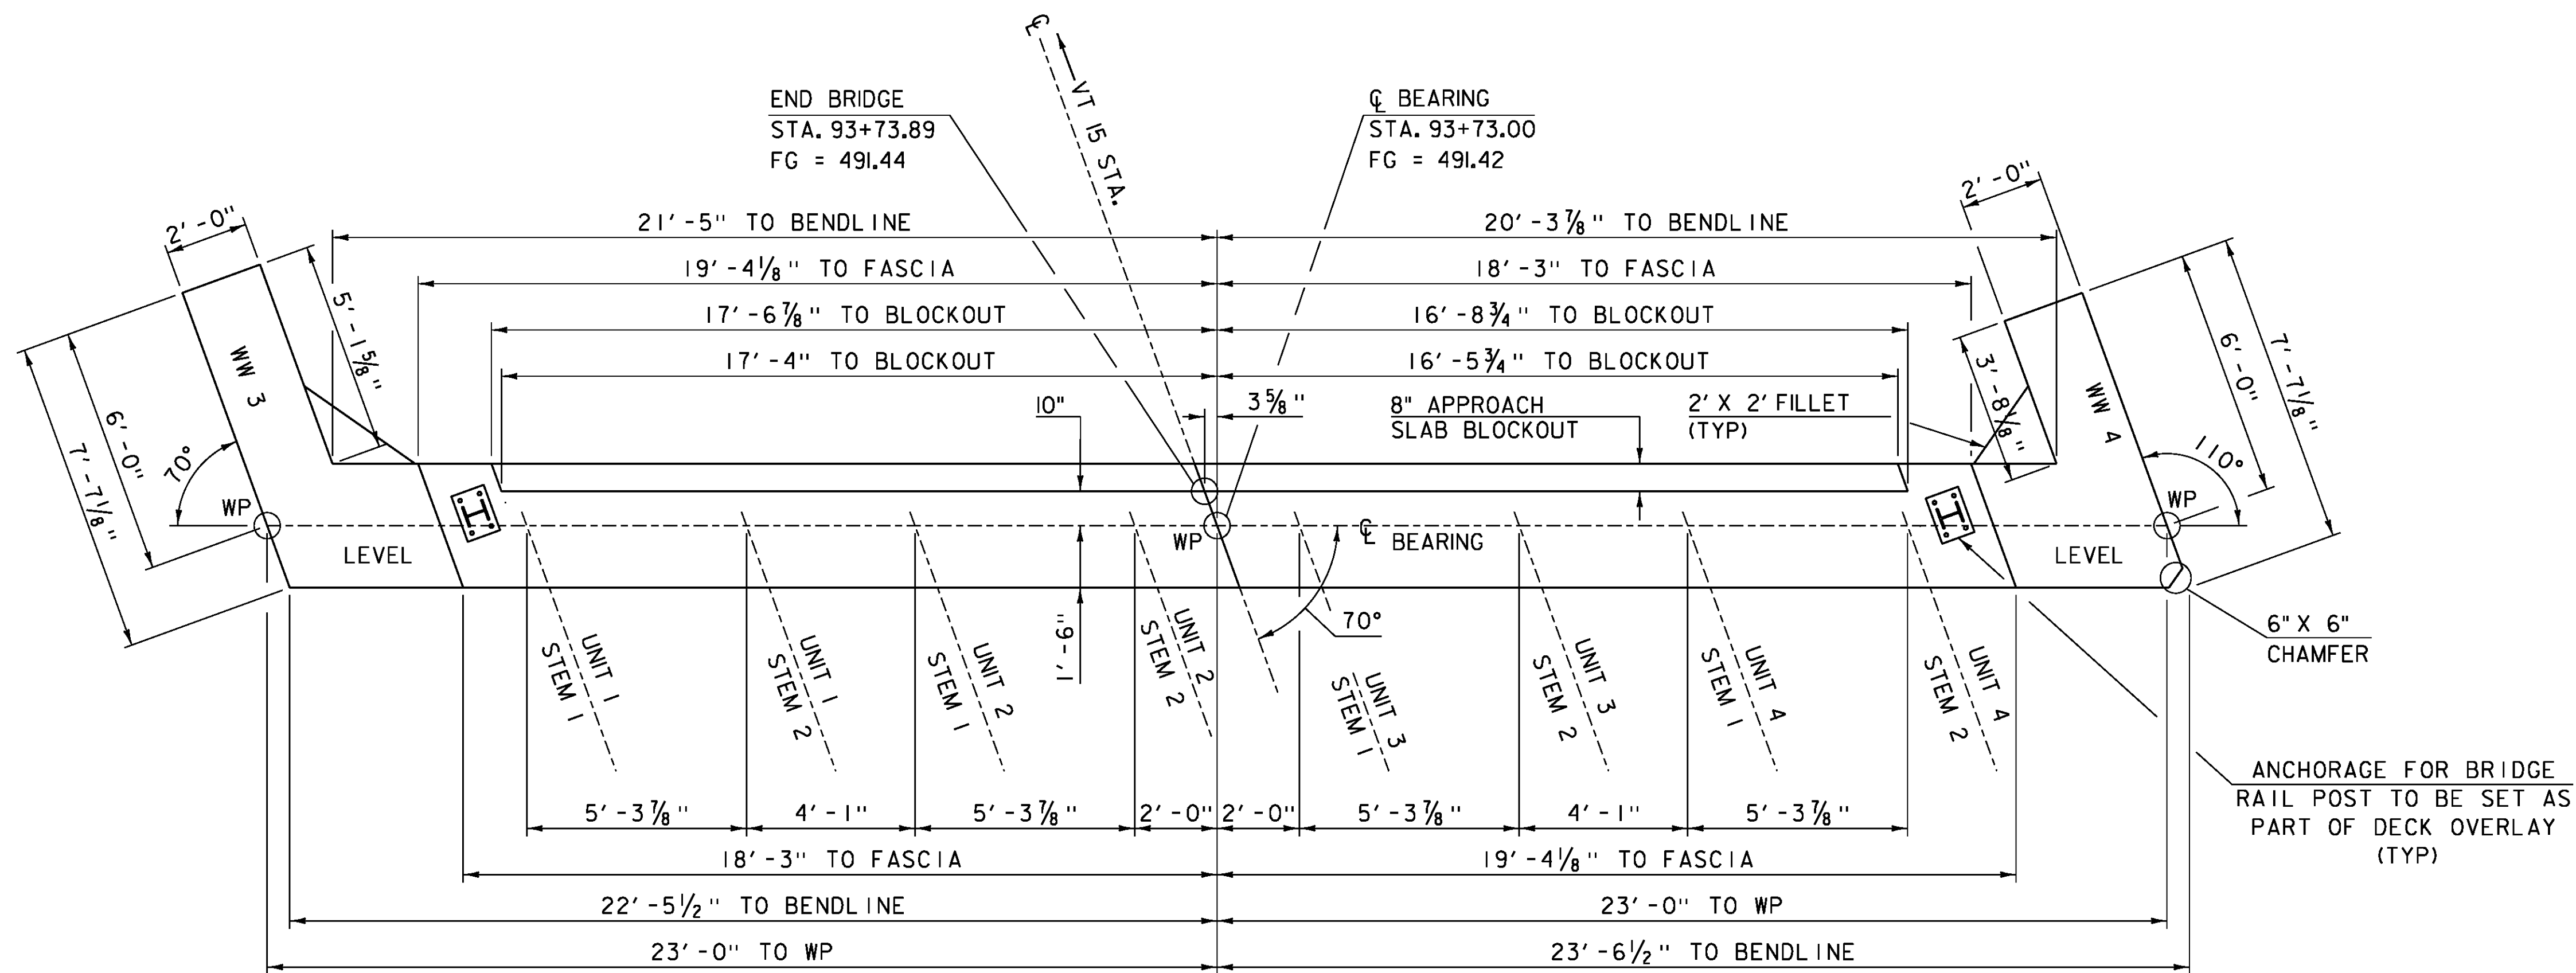

ABUTMENT #2 PLAN

SCALE: 3/8" = 1'-0"

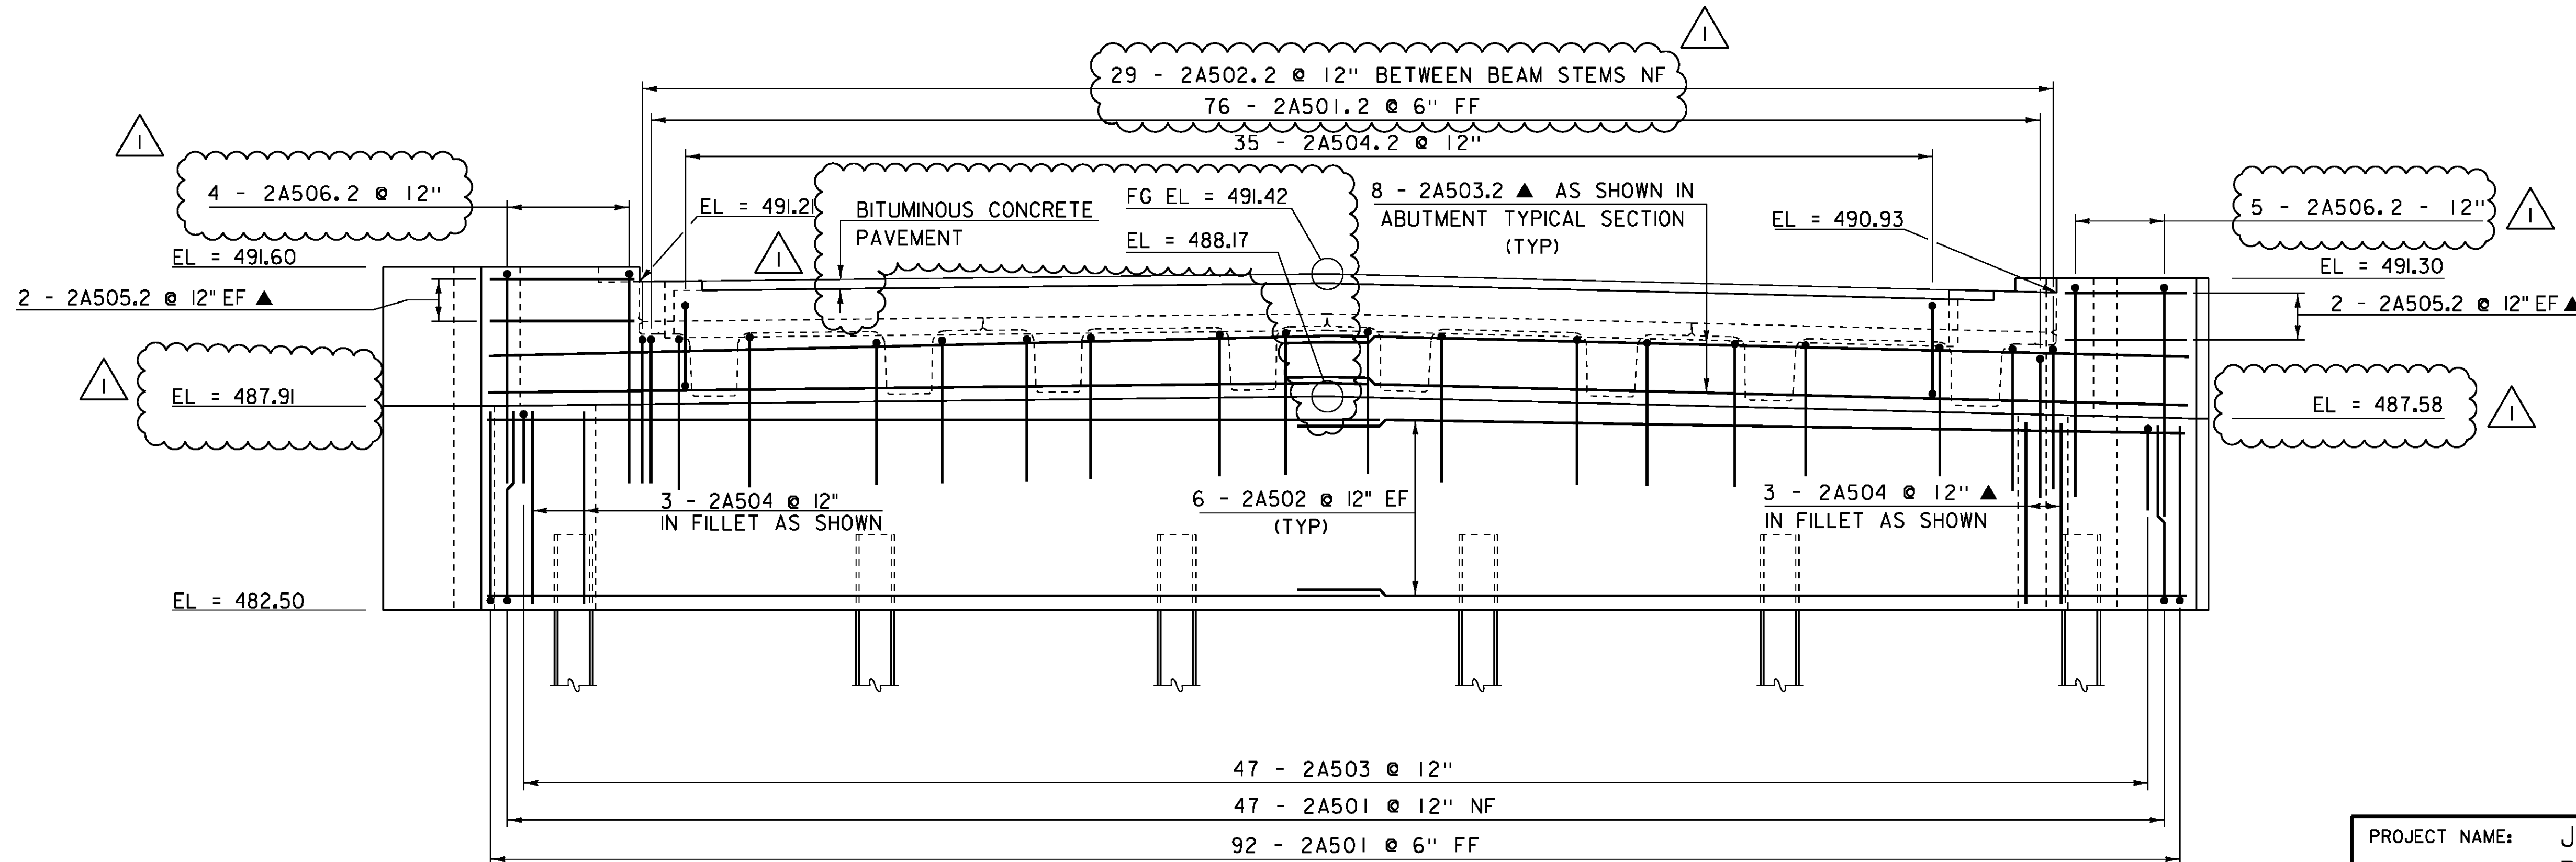

ABUTMENT #2 ELEVATION

SCALE: 3/8" = 1'-0"

NOTE:


- NF = NEAR FACE
- FF = FAR FACE
- EF = EACH FACE
- ▲ = CUT TO FIT IN FIELD
- 3" CLEAR, UNLESS OTHERWISE SPECIFIED ON THE PLANS.
- 2'-2" BAR LAP UNLESS OTHERWISE SPECIFIED ON THE PLANS.

PROJECT NAME: JOHNSON  
PROJECT NUMBER: BRF 030-2(26)

REVISION	DATE	DESCRIPTION	BY
1	OCT-28-2014	ADD 3" PAYMENT, LOWER BRIDGE SEAT, ADD 3" CONCRETE PEDESTAL	GNR


FILE NAME: s88bl93sub.dgn  
PROJECT LEADER: C. CARLSON  
DESIGNED BY: H. SALLS  
ABUTMENT #2 PLAN AND ELEVATION

PLOT DATE: 05-NOV-2014  
DRAWN BY: G. ROKES  
CHECKED BY: H. SALLS  
SHEET 33 OF 69

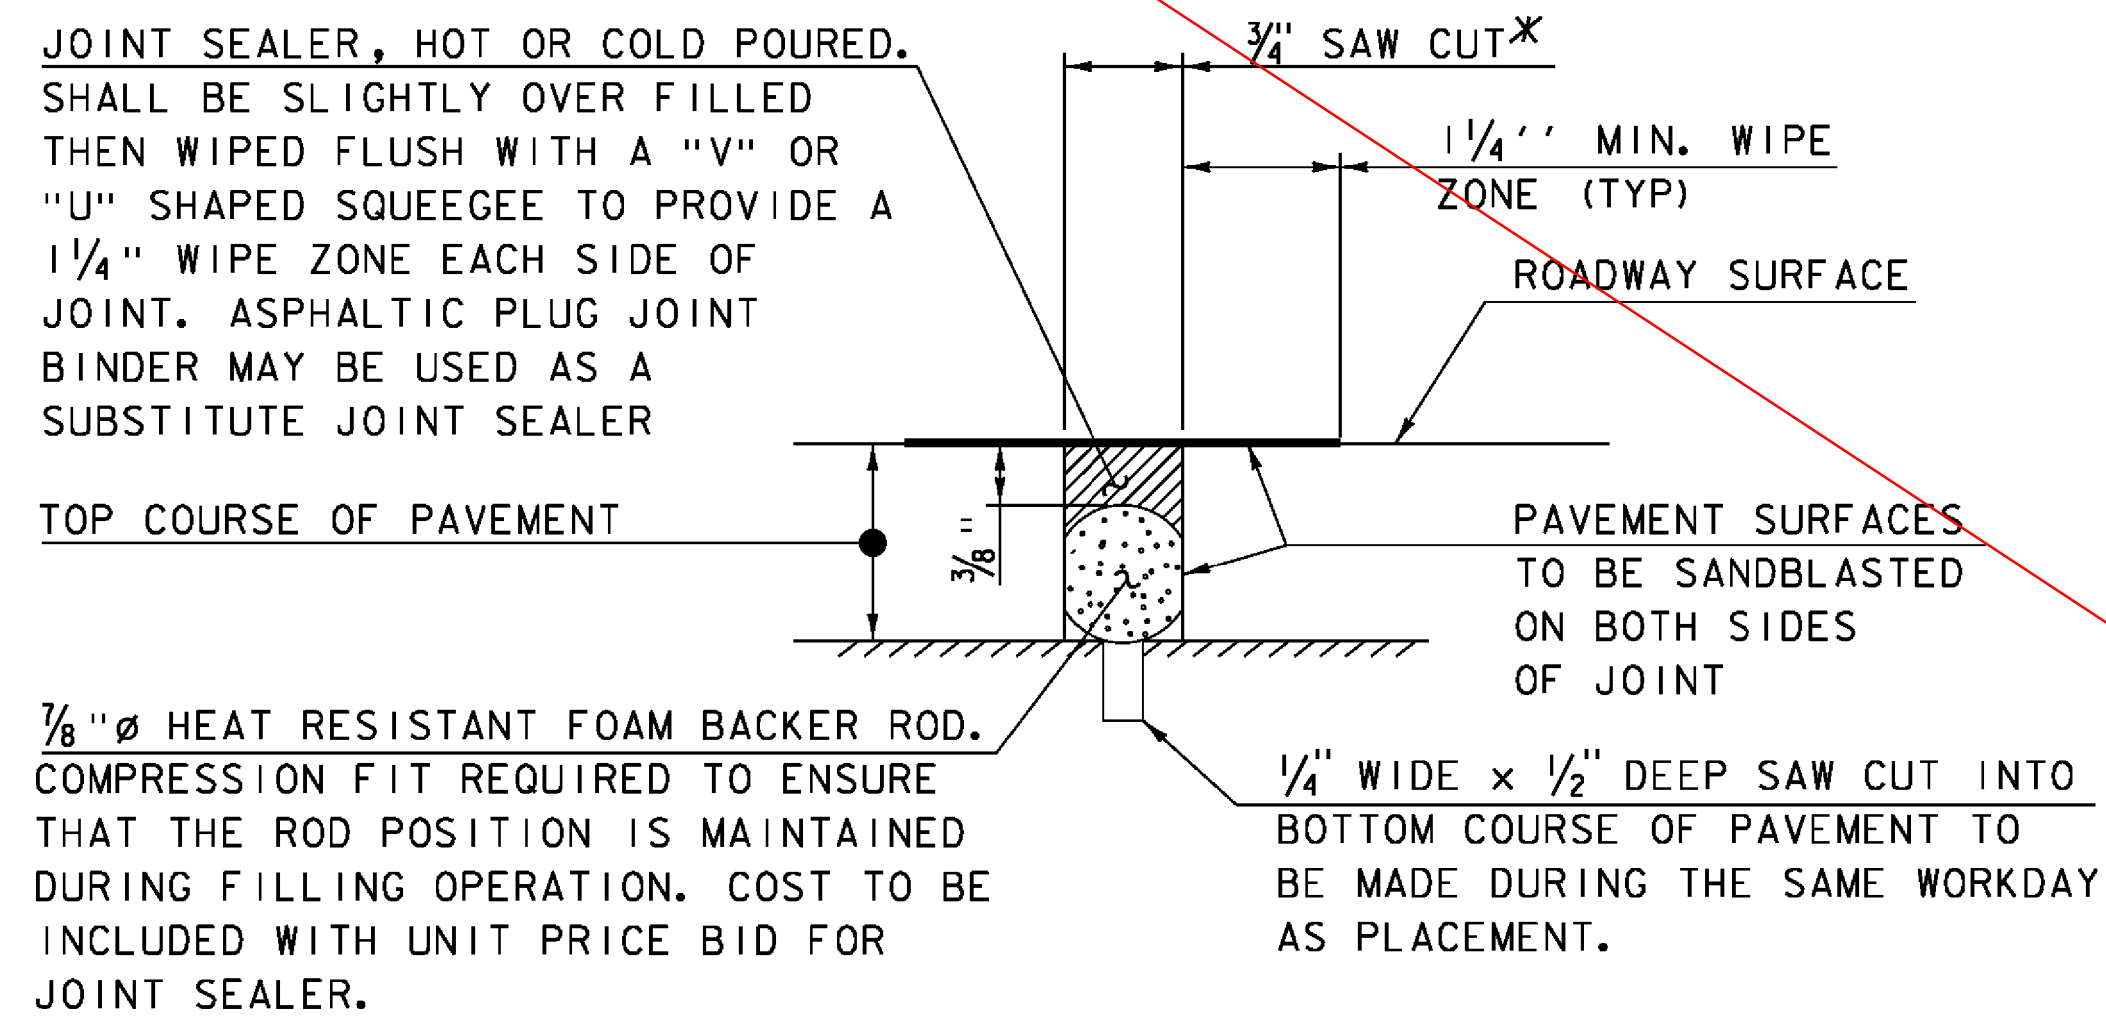

**SAWED PAVEMENT JOINT DETAIL**  
(NOT TO SCALE)

* JOINT IS TO BE LOCATED ACCURATELY BY STRING LINING, OR OTHER MEANS, PRIOR TO PAVING, SO THAT THE SAW CUTS WILL BE MADE DIRECTLY OVER THE END OF CONCRETE DECK. JOINT SHALL BE CUT DRY IN A SINGLE PASS AND BE SEALED WITHIN 24 HOURS OR PRIOR TO EXPOSURE TO TRAFFIC. JOINT SHALL BE CLEANED PRIOR TO APPLYING THE JOINT SEALER.

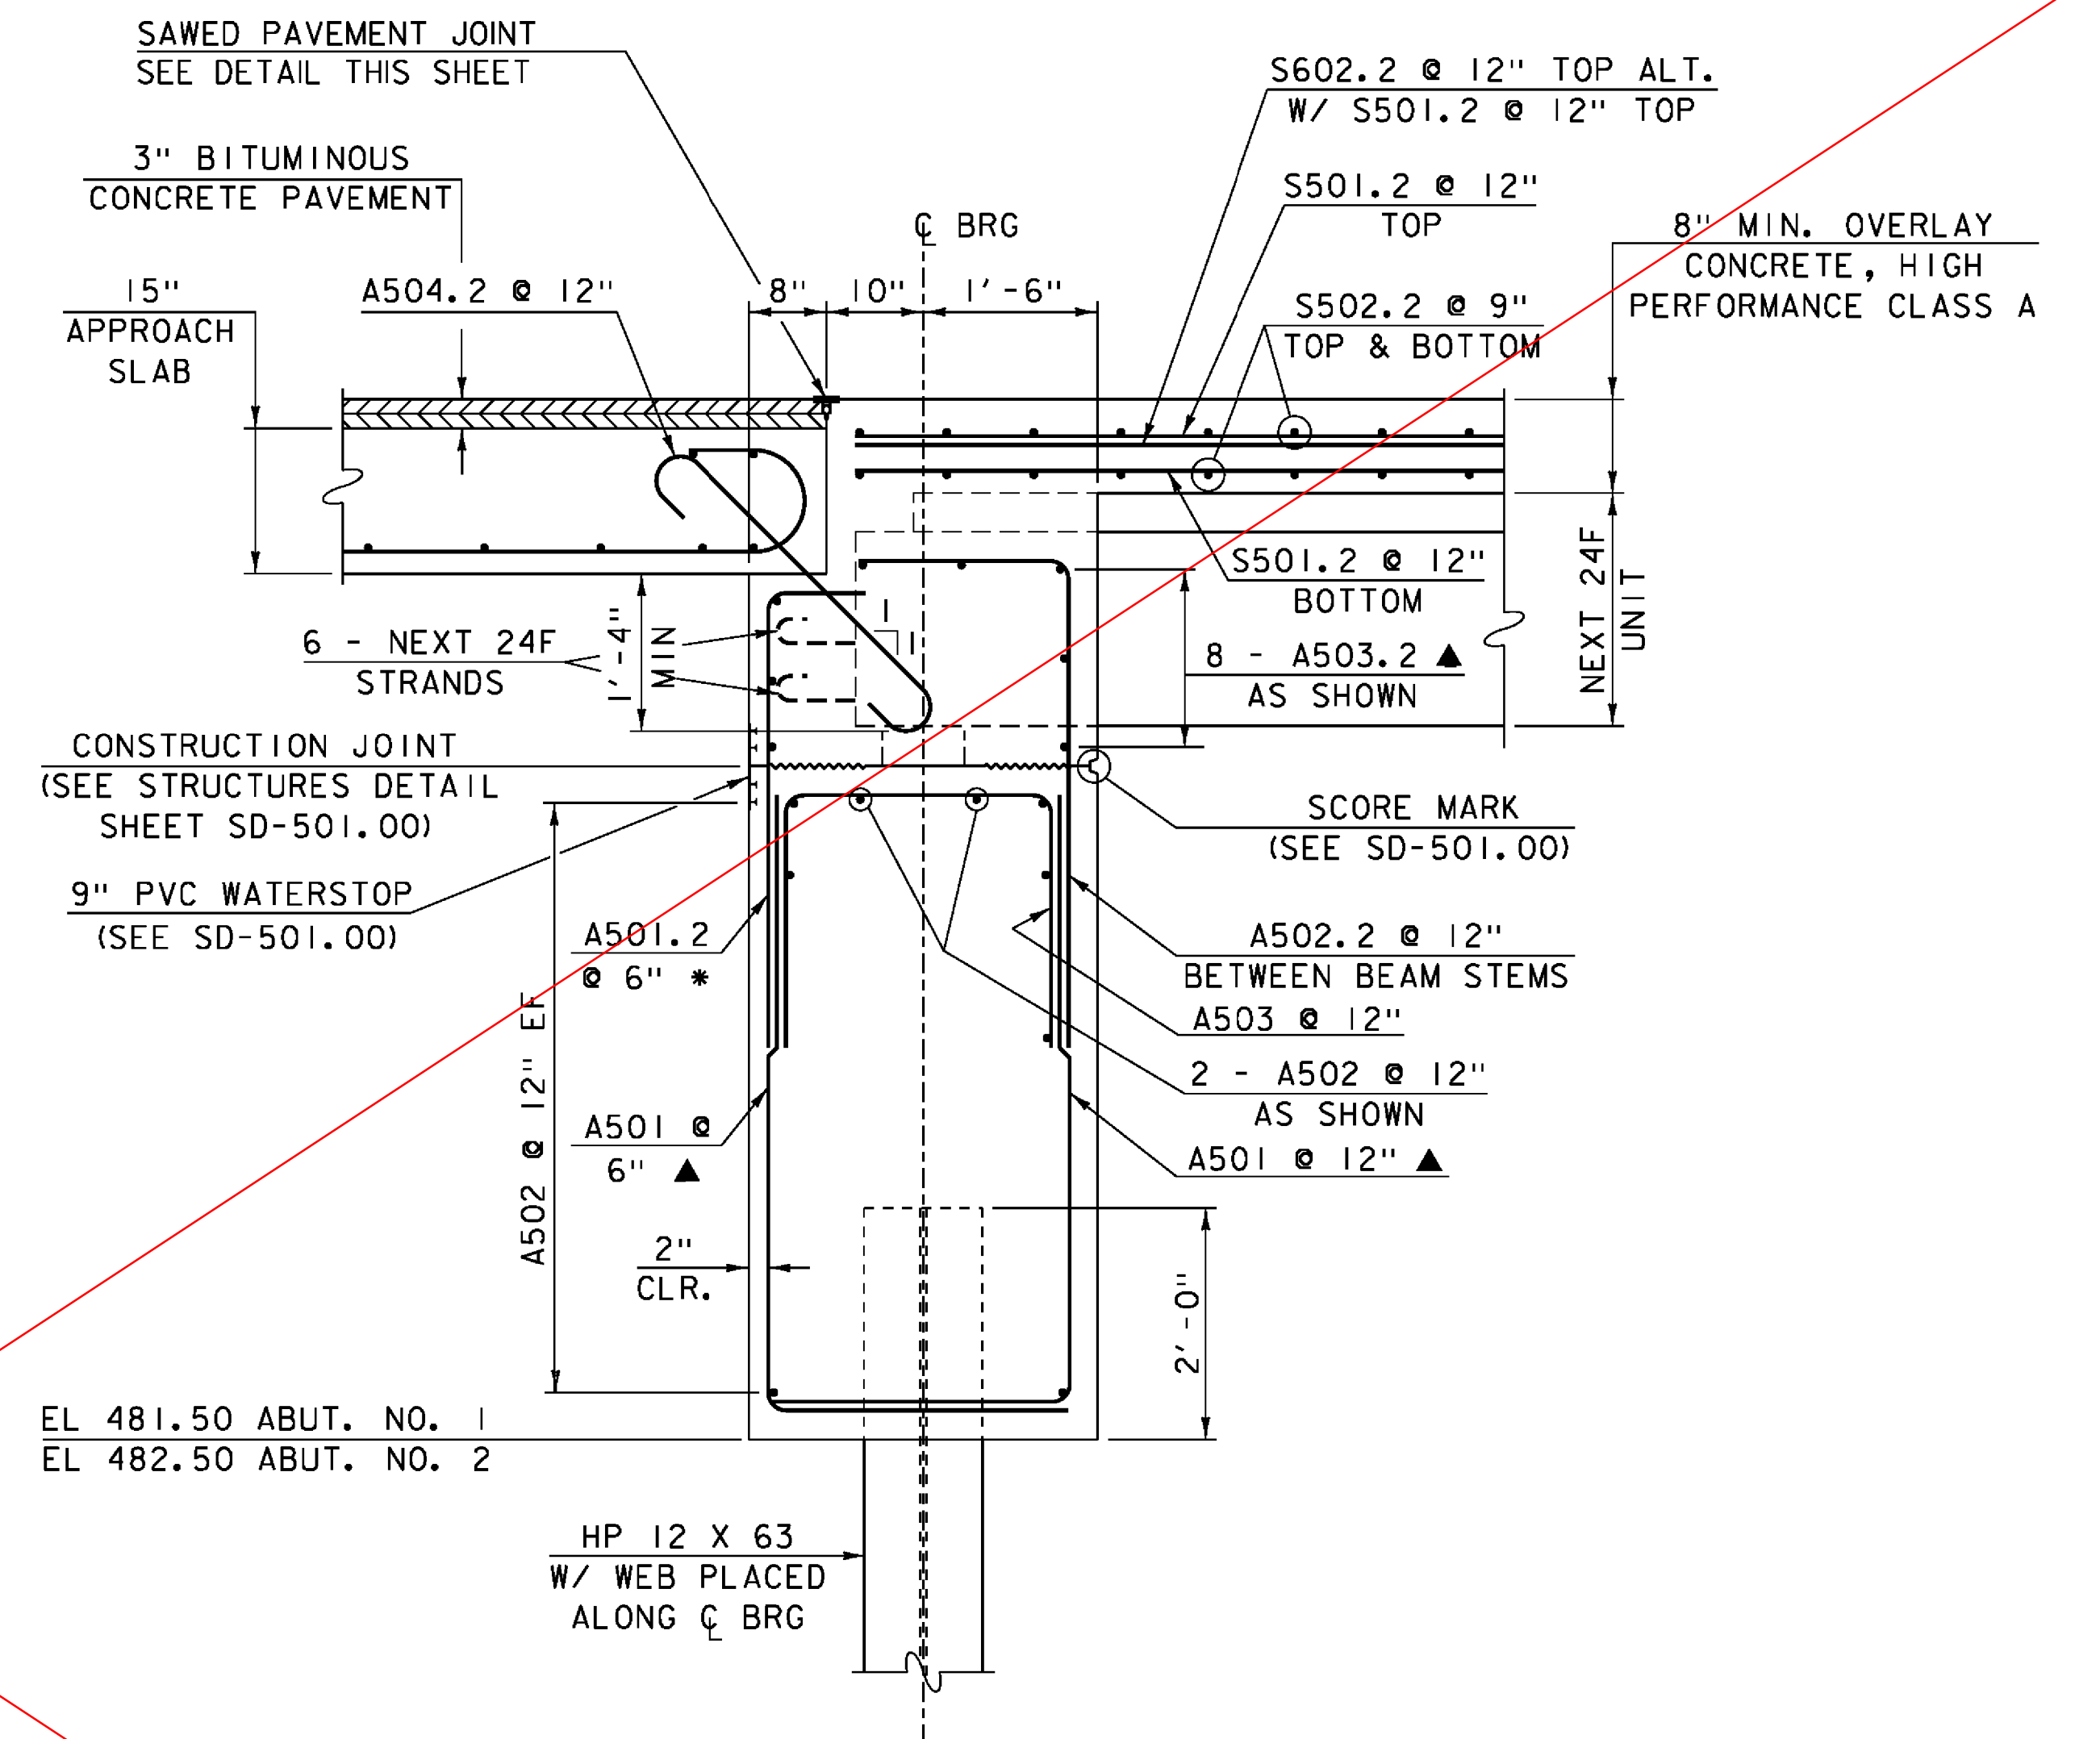

**ABUTMENT TYPICAL SECTION**

SCALE: 3/4" = 1'-0"


**NOTE:**  
NF = NEAR FACE  
FF = FAR FACE  
EF = EACH FACE  
▲ = CUT TO FIT IN FIELD  
3" CLR. UNLESS OTHERWISE NOTED  
2'-2" BAR LAP UNLESS OTHERWISE NOTED  
* THE HOOKS WILL NEED TO BE TURNED OR REMOVED WHEN IN CONFLICT WITH THE BEAM STEMS.

SEE REVISION: OCT-28-2014

PROJECT NAME: JOHNSON  
PROJECT NUMBER: BRF 030-2(26)


FILE NAME: s88bi93sub.dgn  
PROJECT LEADER: C. CARLSON  
DESIGNED BY: H. SALLS  
ABUTMENT TYPICAL SECTION

PLOT DATE: 10-JUN-2014  
DRAWN BY: G. ROKES  
CHECKED BY: H. SALLS  
SHEET 34 OF 69

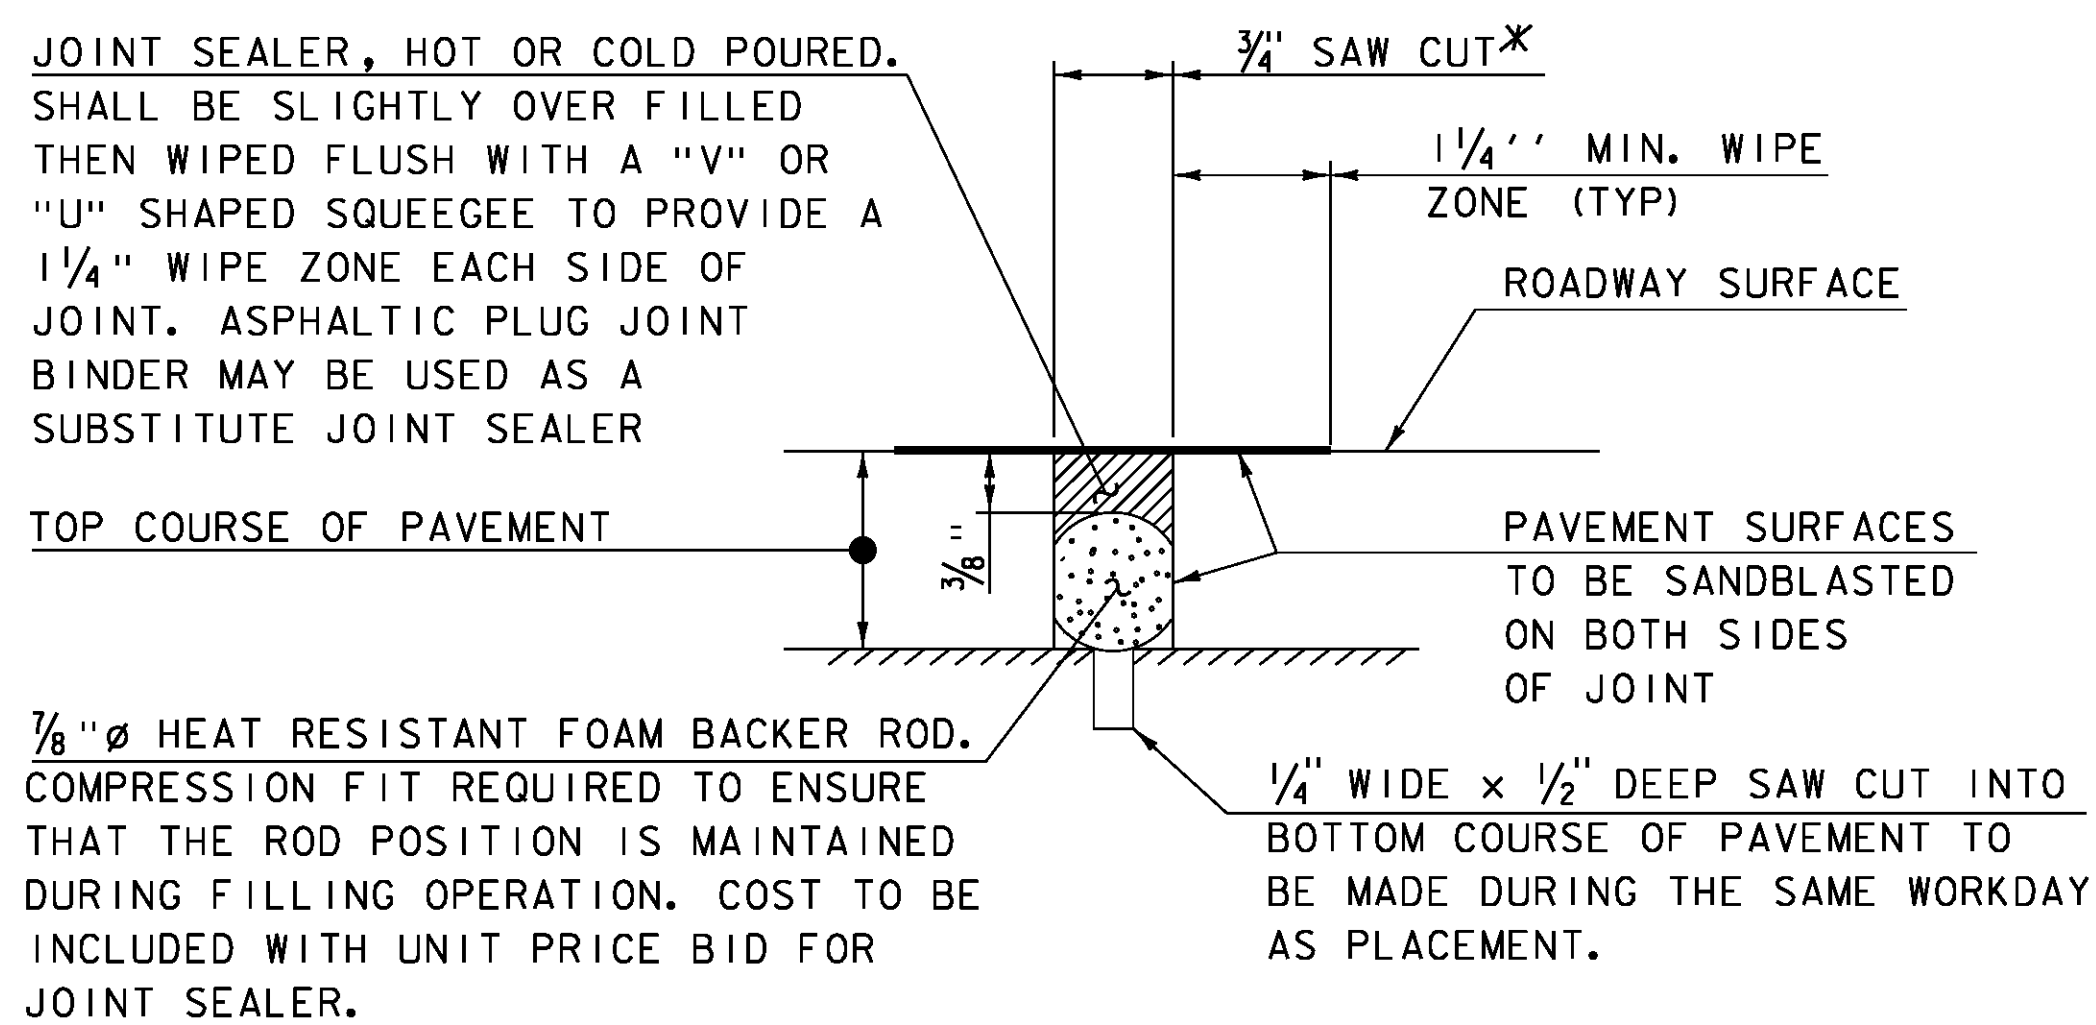

**SAWED PAVEMENT JOINT DETAIL**  
(NOT TO SCALE)

*JOINT IS TO BE LOCATED ACCURATELY BY STRING LINING, OR OTHER MEANS, PRIOR TO PAVING, SO THAT THE SAW CUTS WILL BE MADE DIRECTLY OVER THE END OF CONCRETE DECK. JOINT SHALL BE CUT DRY IN A SINGLE PASS AND BE SEALED WITHIN 24 HOURS OR PRIOR TO EXPOSURE TO TRAFFIC. JOINT SHALL BE CLEANED PRIOR TO APPLYING THE JOINT SEALER.

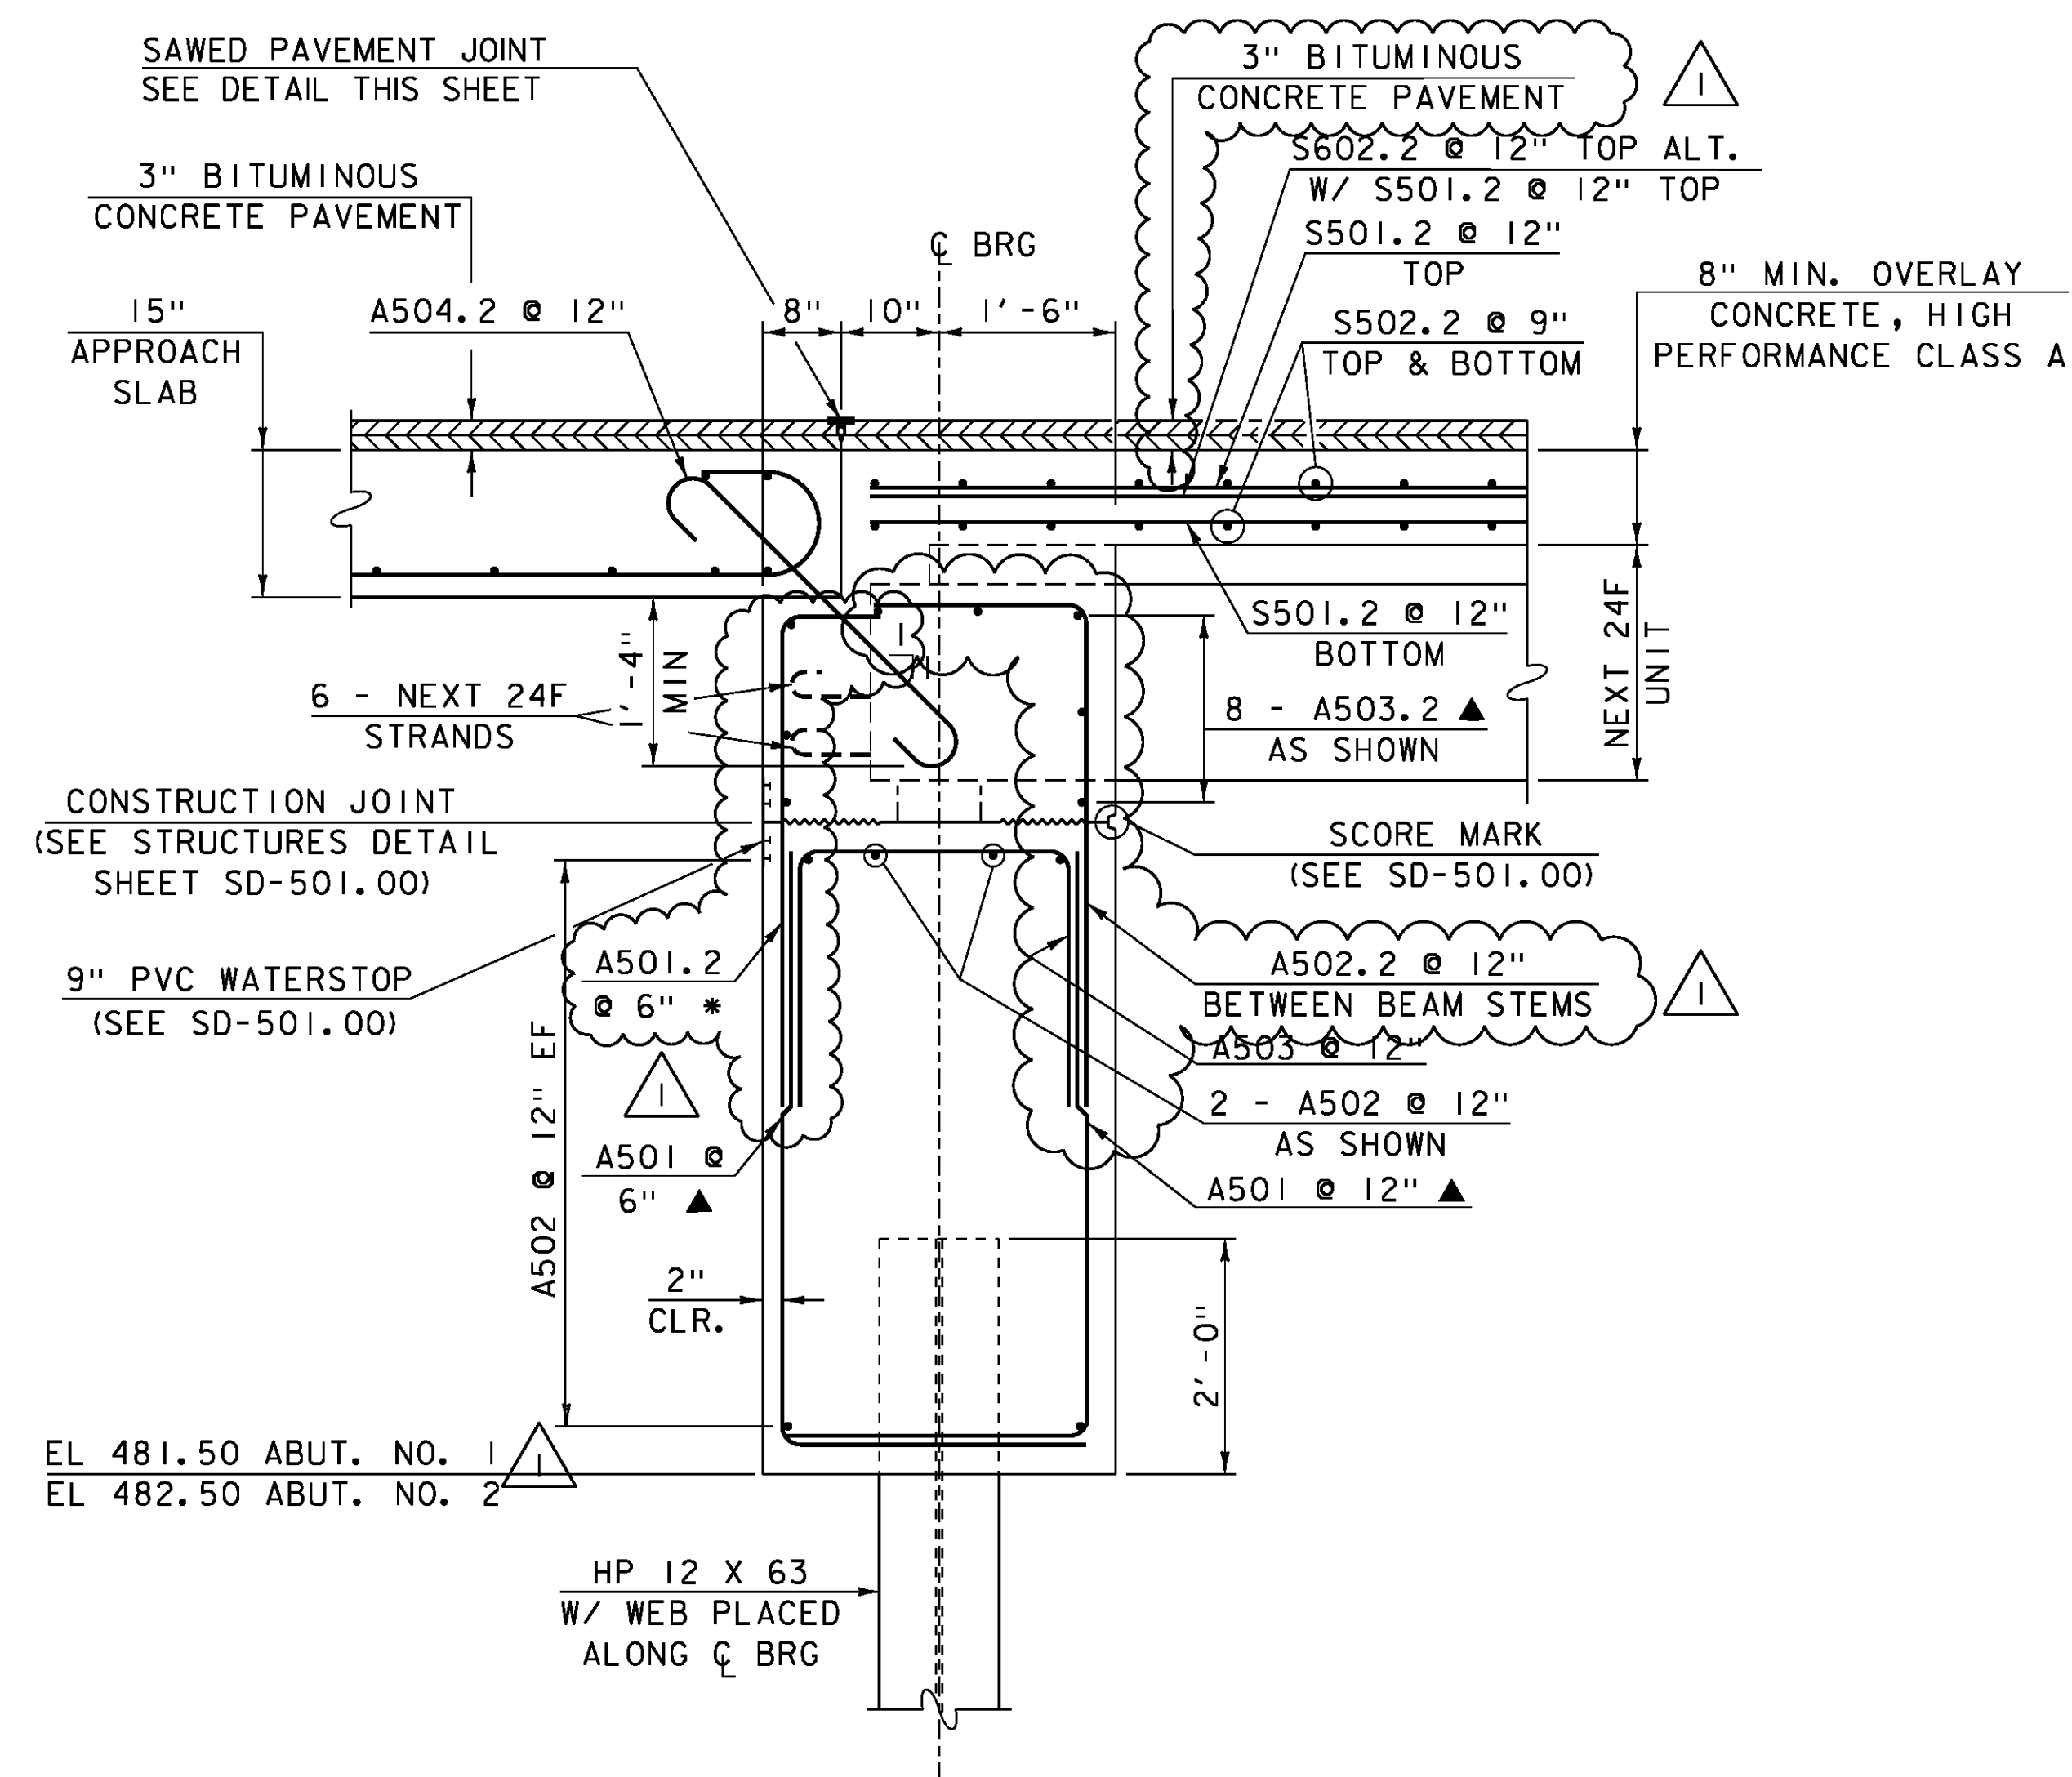

**ABUTMENT TYPICAL SECTION**

SCALE: 3/4" = 1'-0"


**NOTE:**

NF = NEAR FACE  
 FF = FAR FACE  
 EF = EACH FACE  
 ▲ = CUT TO FIT IN FIELD  
 3" CLR. UNLESS OTHERWISE NOTED  
 2'-2" BAR LAP UNLESS OTHERWISE NOTED  
 * THE HOOKS WILL NEED TO BE TURNED OR REMOVED WHEN IN CONFLICT WITH THE BEAM STEMS.


REVISION	DATE	DESCRIPTION	BY
1	OCT-28-2014	ADD 3" PAYMENT, LOWER BRIDGE SEAT, ADD 3" CONCRETE PEDESTAL	GNR

PROJECT NAME: JOHNSON  
 PROJECT NUMBER: BRF 030-2(26)


FILE NAME: s88bl93sub.dgn PLOT DATE: 05-NOV-2014  
 PROJECT LEADER: C. CARLSON DRAWN BY: G. ROKES  
 DESIGNED BY: H. SALLS CHECKED BY: H. SALLS  
 ABUTMENT TYPICAL SECTION SHEET 34 OF 69

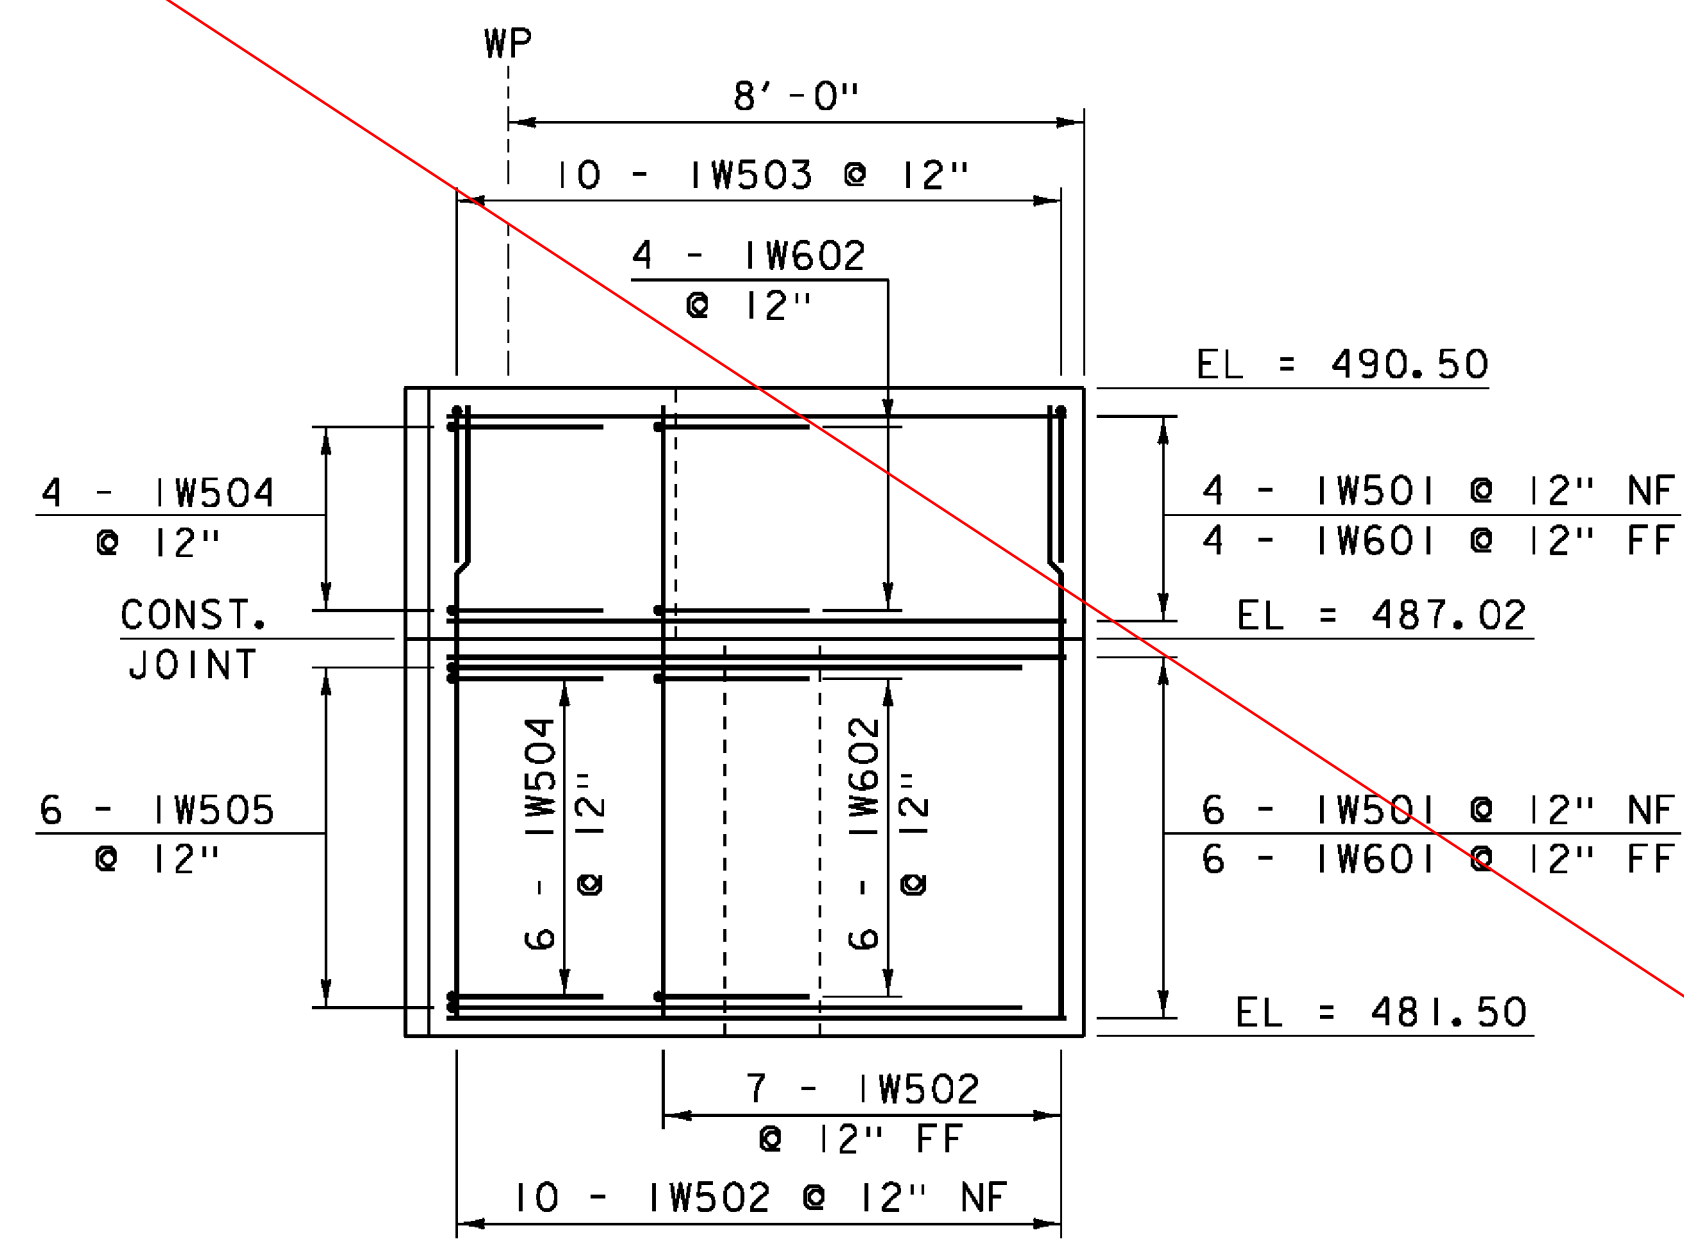


**WINGWALL #1 ELEVATION**  
SCALE: 3/8" = 1'-0"

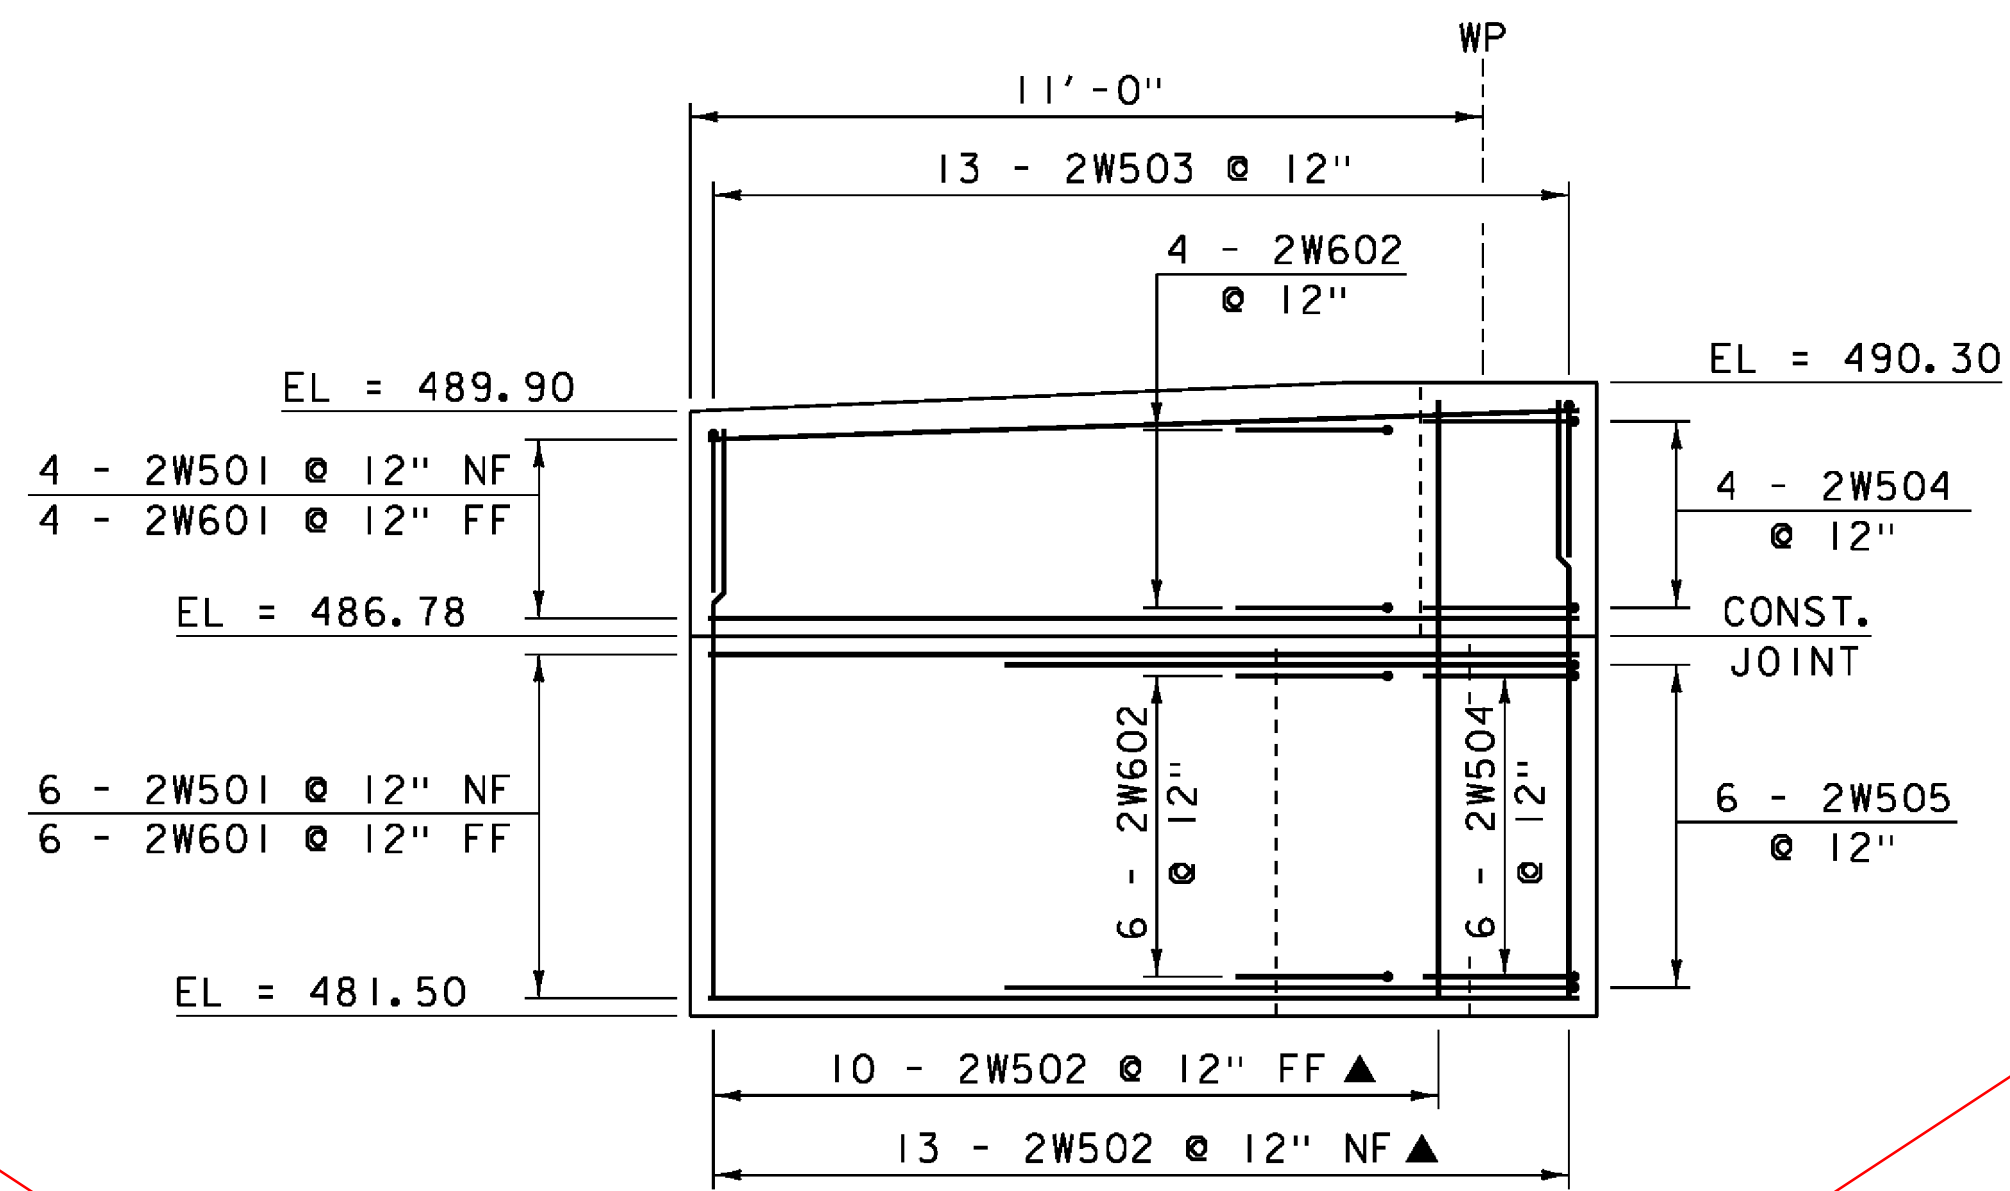


**WINGWALL #2 ELEVATION**  
SCALE: 3/8" = 1'-0"

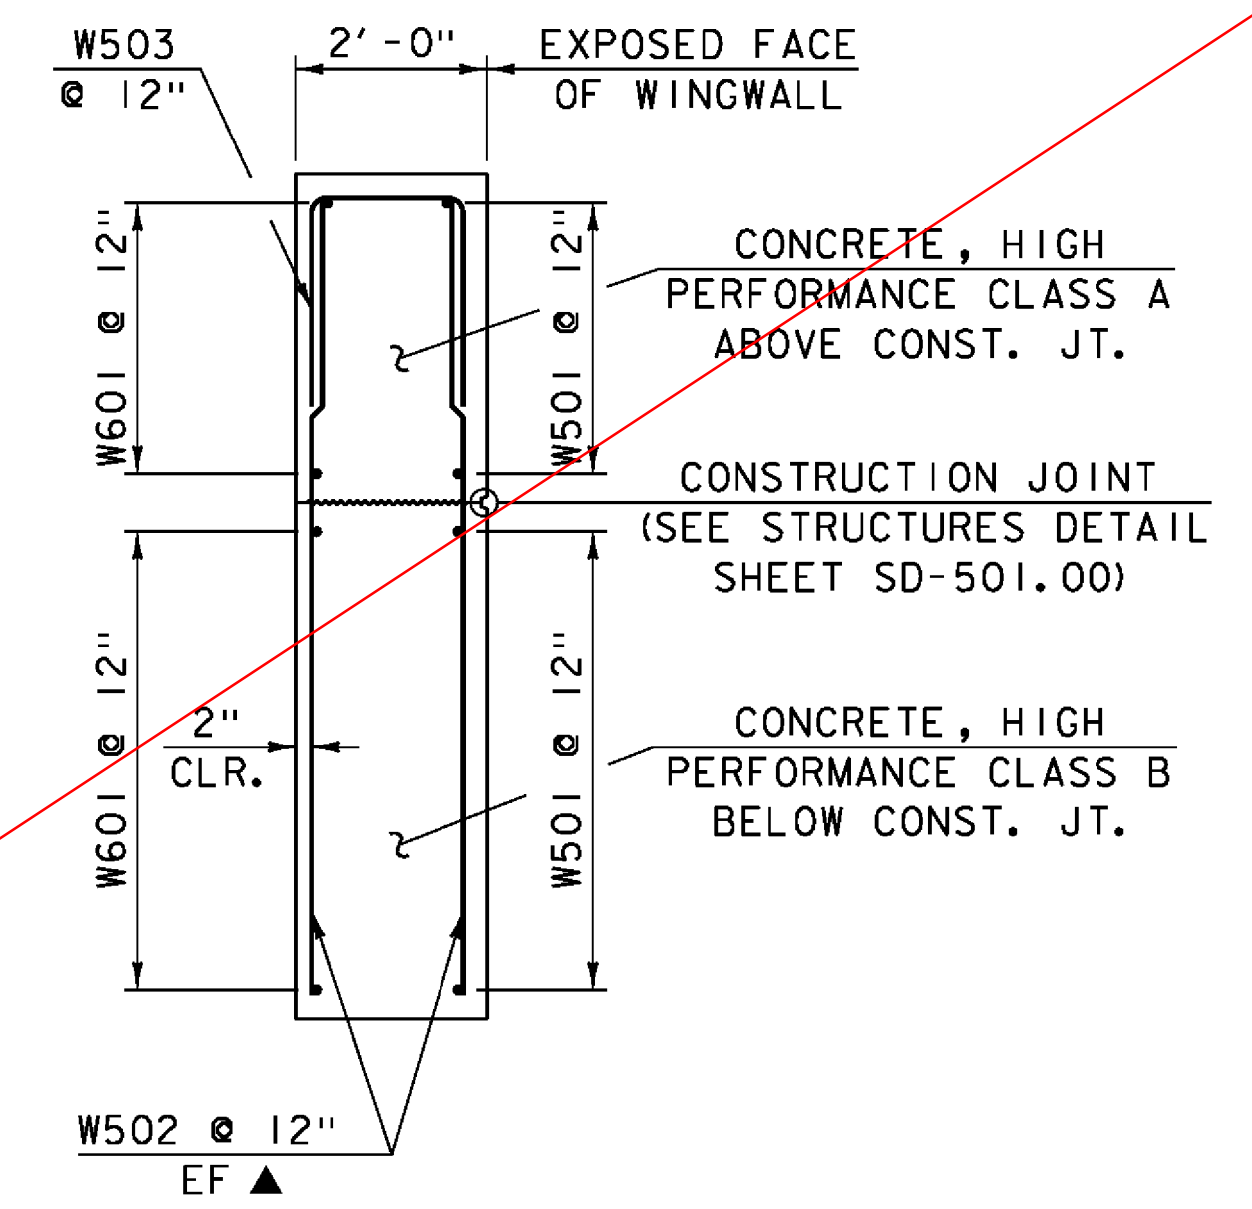


**WINGWALL TYPICAL SECTION**  
SCALE: 1/2" = 1'-0"

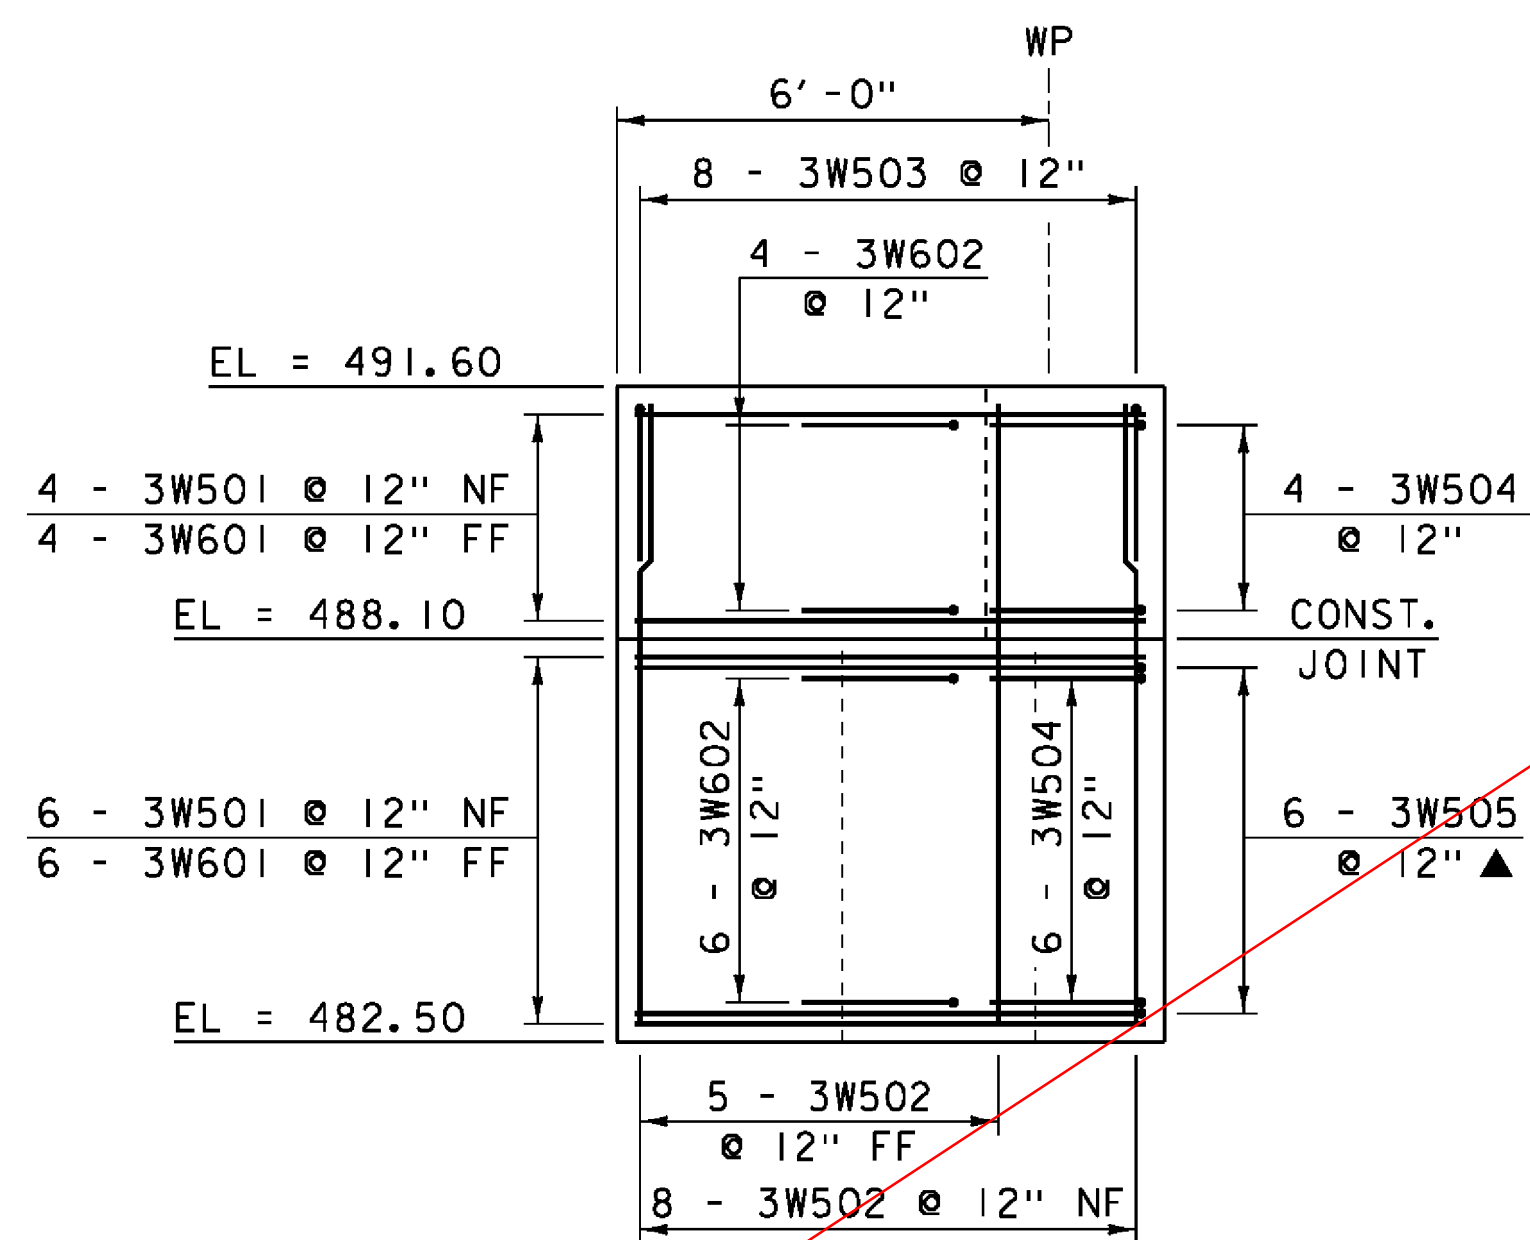

**WINGWALL #3 ELEVATION**  
SCALE: 3/8" = 1'-0"

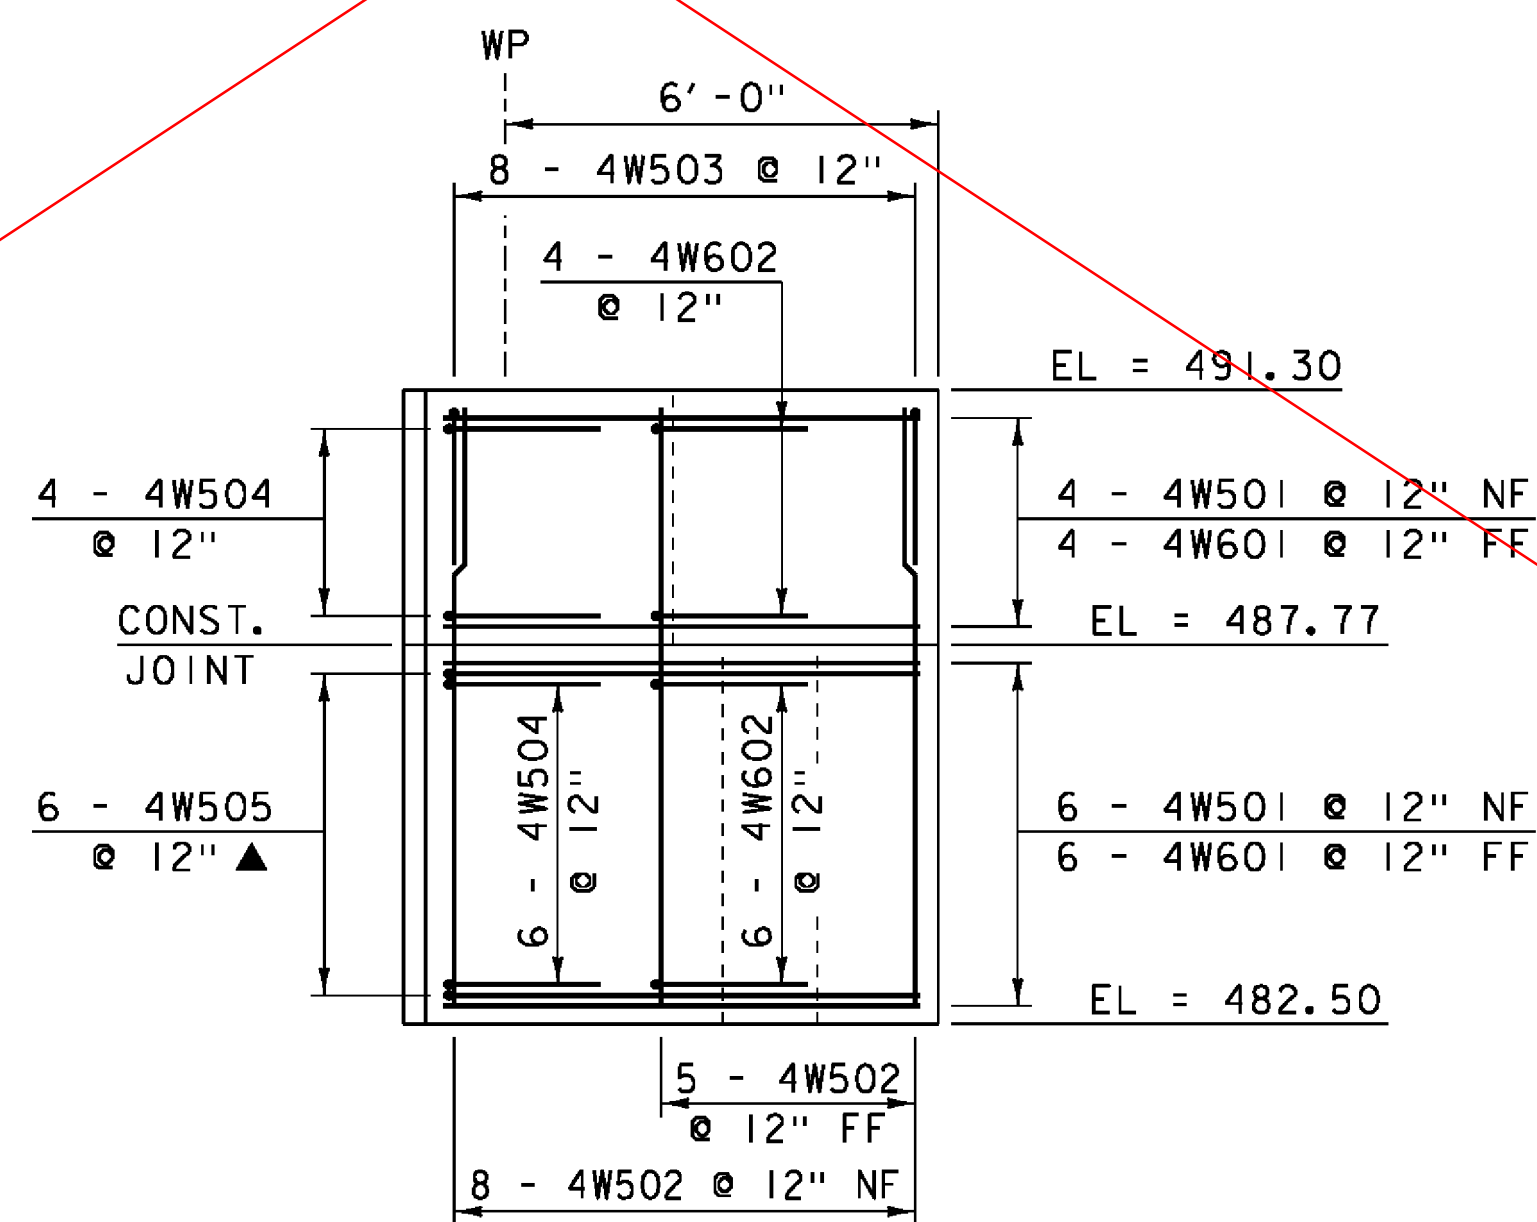

**WINGWALL #4 ELEVATION**  
SCALE: 3/8" = 1'-0"

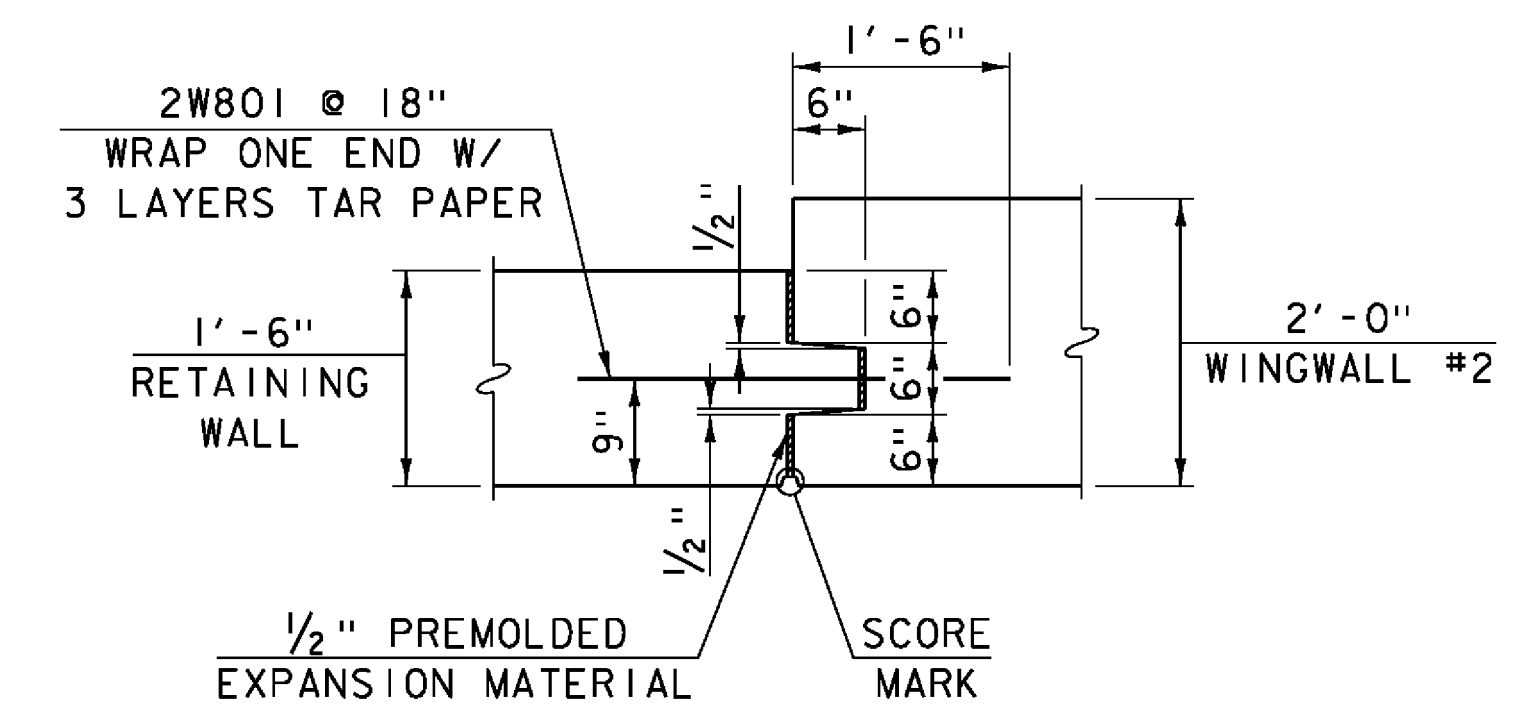


**CONCRETE EXPANSION JOINT**  
(BETWEEN RETAINING WALL AND WINGWALL #2)  
SCALE: 3/4" = 1'-0"

**NOTE:**  
NF = NEAR FACE  
FF = FAR FACE  
EF = EACH FACE  
▲ = CUT TO FIT IN FIELD  
3" CLEAR, UNLESS OTHERWISE SPECIFIED ON THE PLANS.  
2'-2" BAR LAP UNLESS OTHERWISE SPECIFIED ON THE PLANS.

SEE REVISION: OCT-28-2014


PROJECT NAME: JOHNSON  
PROJECT NUMBER: BRF 030-2(26)

FILE NAME: s88bi93sub.dgn  
PROJECT LEADER: C. CARLSON  
DESIGNED BY: H. SALLS  
PLOT DATE: 10-JUN-2014  
DRAWN BY: G. ROKES  
CHECKED BY: H. SALLS  
WINGWALL ELEVATIONS AND TYPICAL SECTION SHEET 35 OF 69

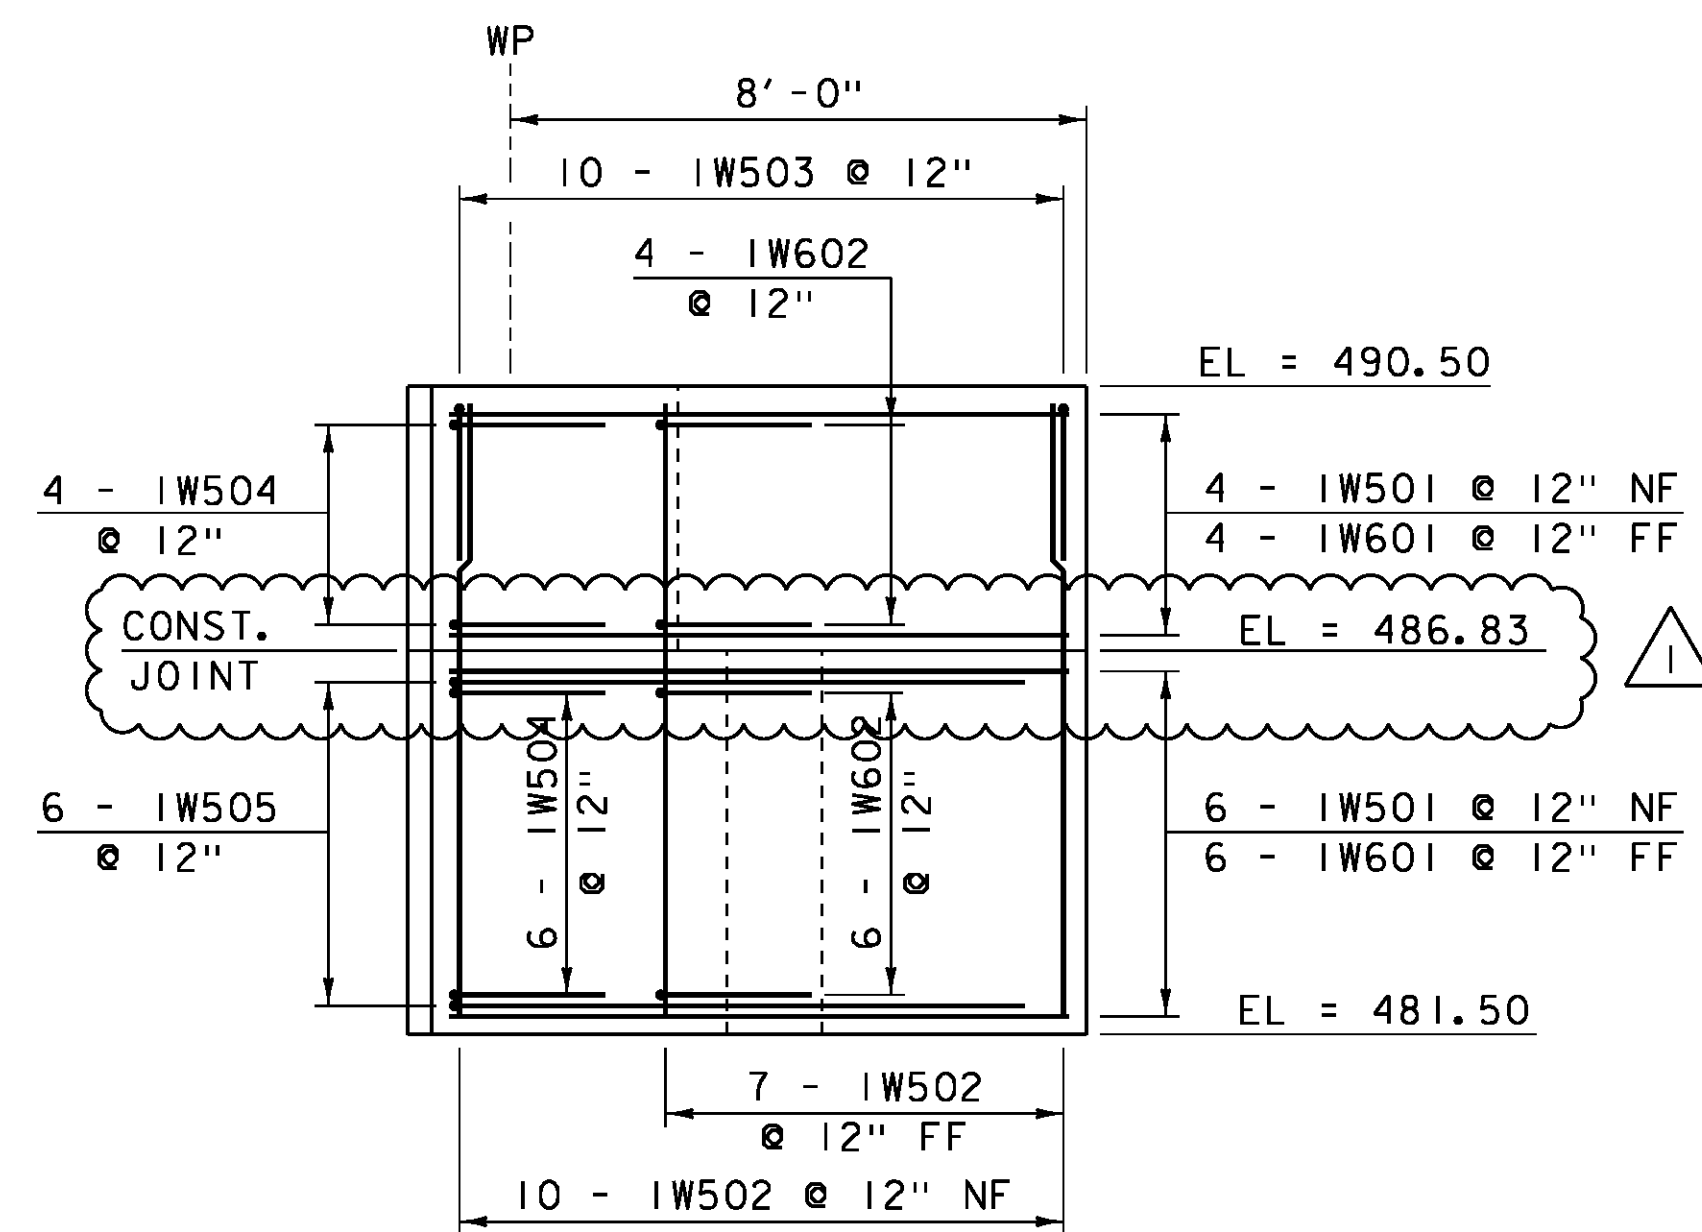


WINGWALL #1 ELEVATION

SCALE: 3/8" = 1'-0"

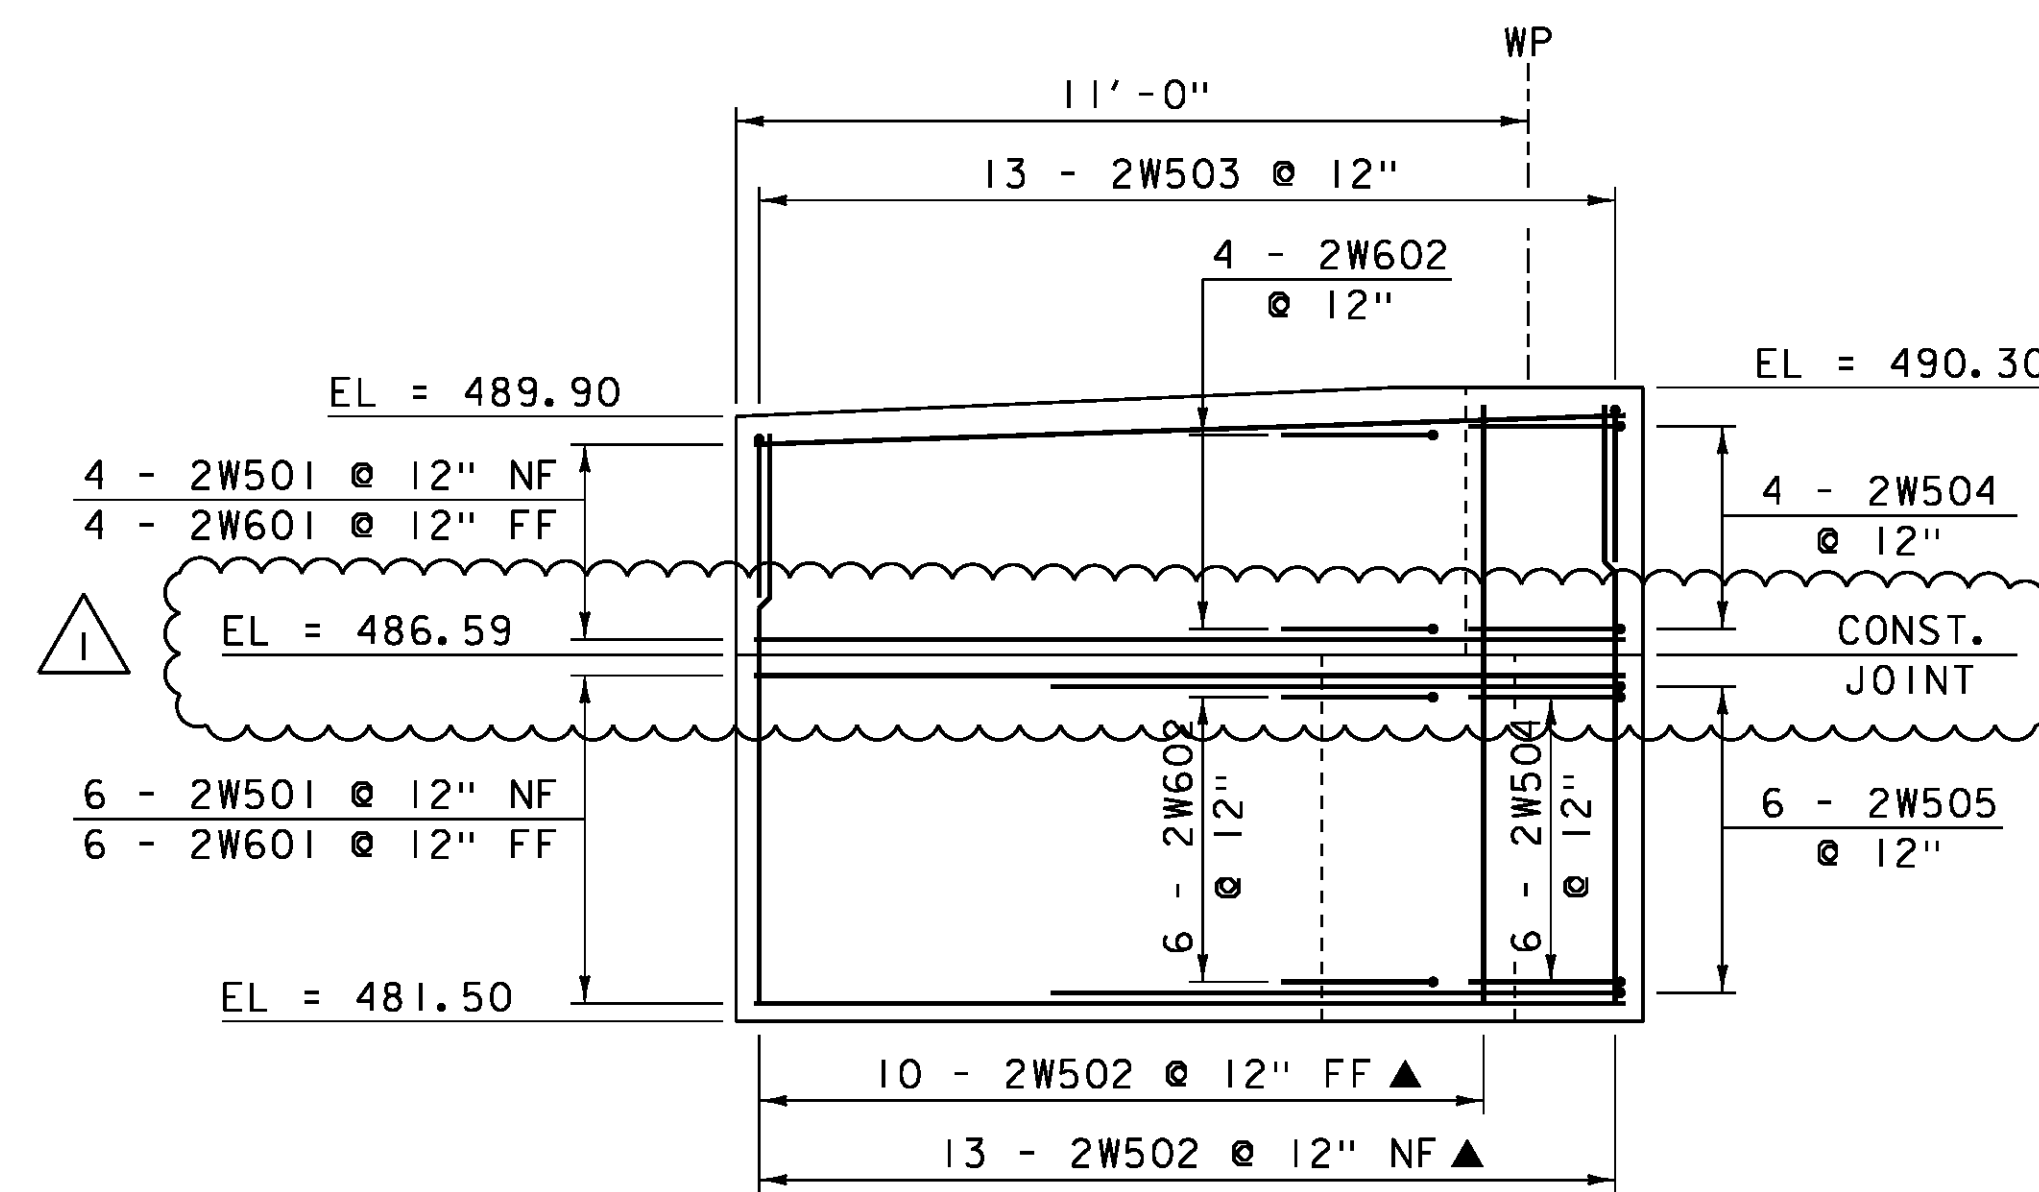


WINGWALL #2 ELEVATION

SCALE: 3/8" = 1'-0"

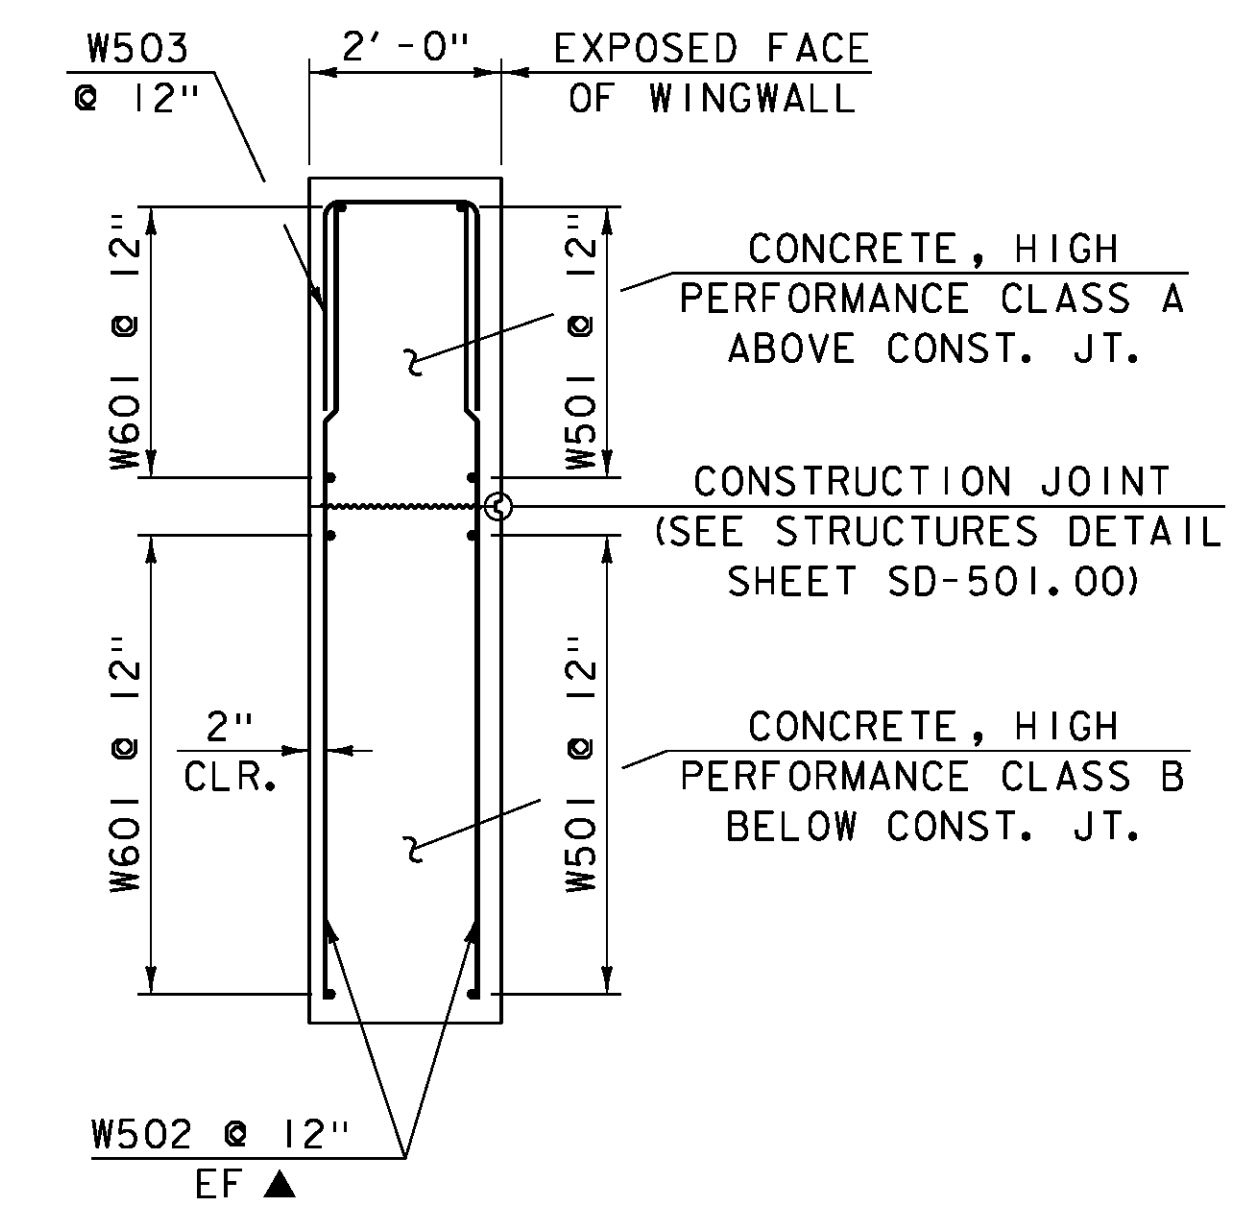


WINGWALL TYPICAL SECTION

SCALE: 1/2" = 1'-0"

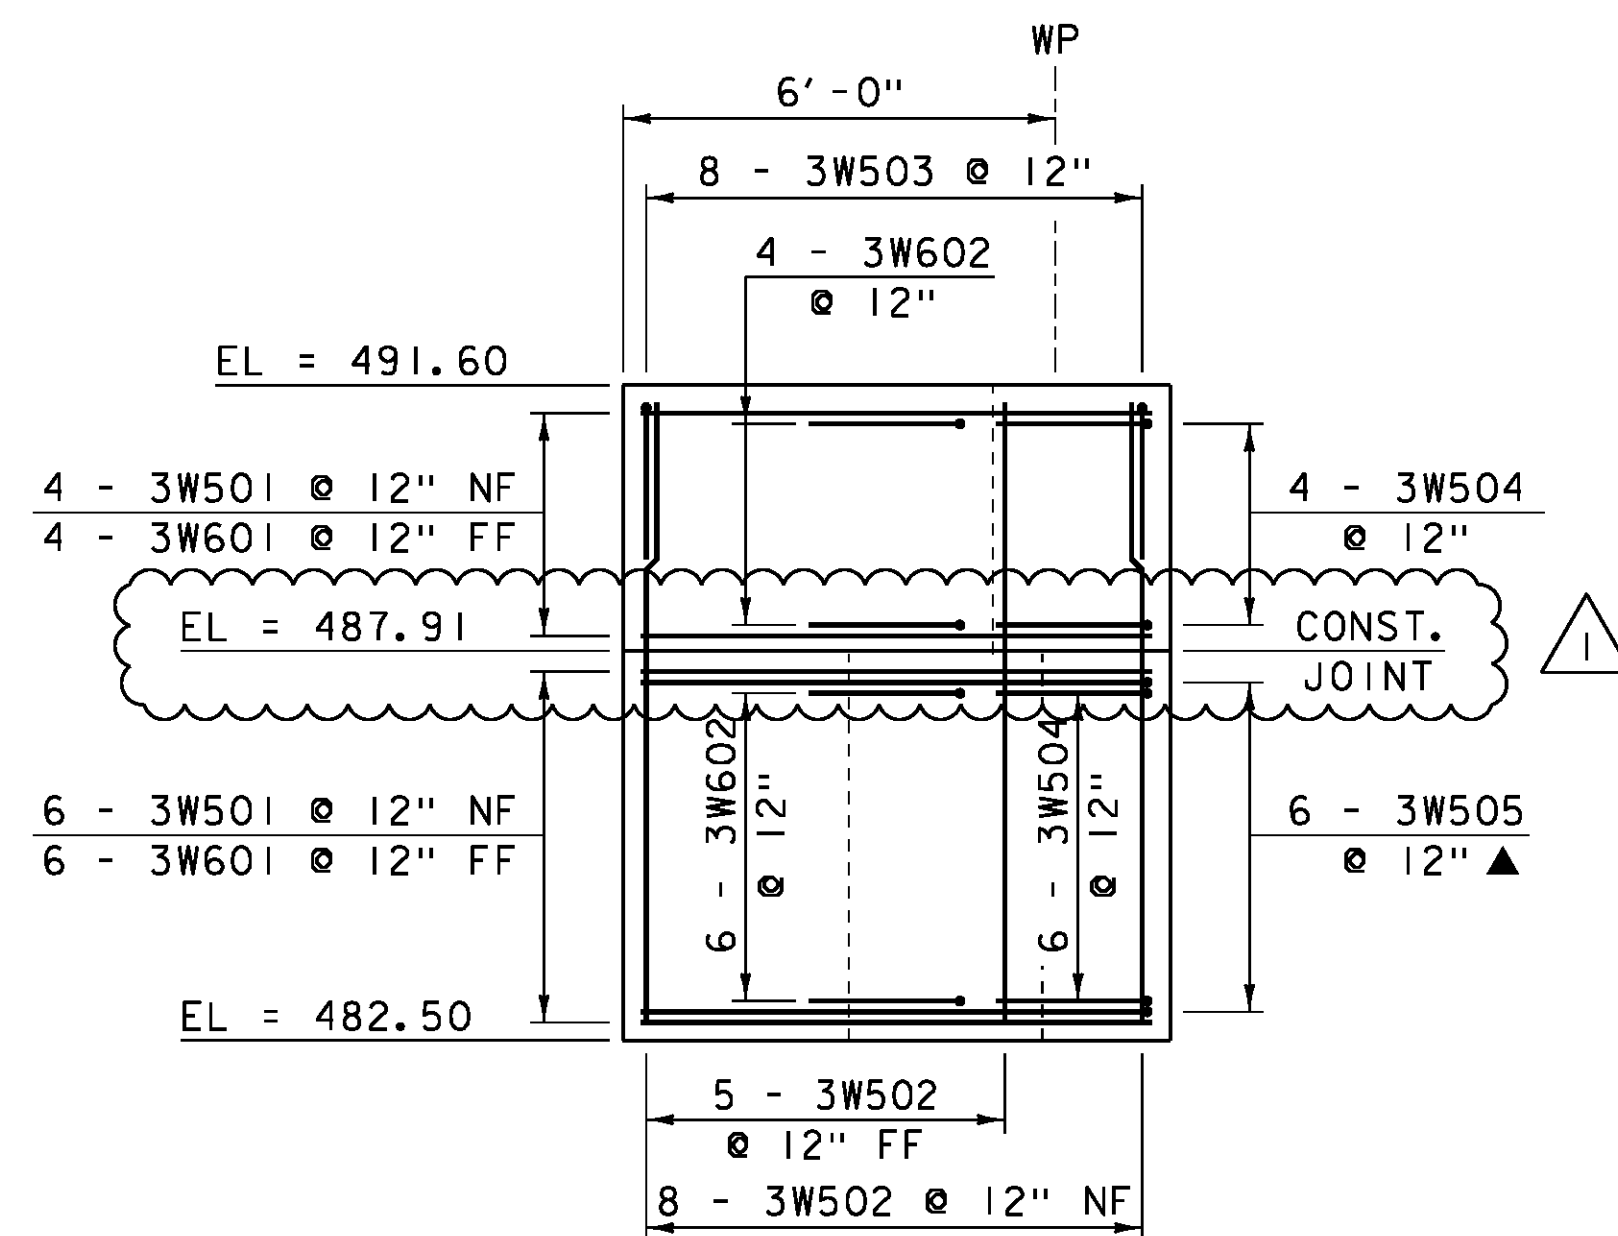


WINGWALL #3 ELEVATION

SCALE: 3/8" = 1'-0"

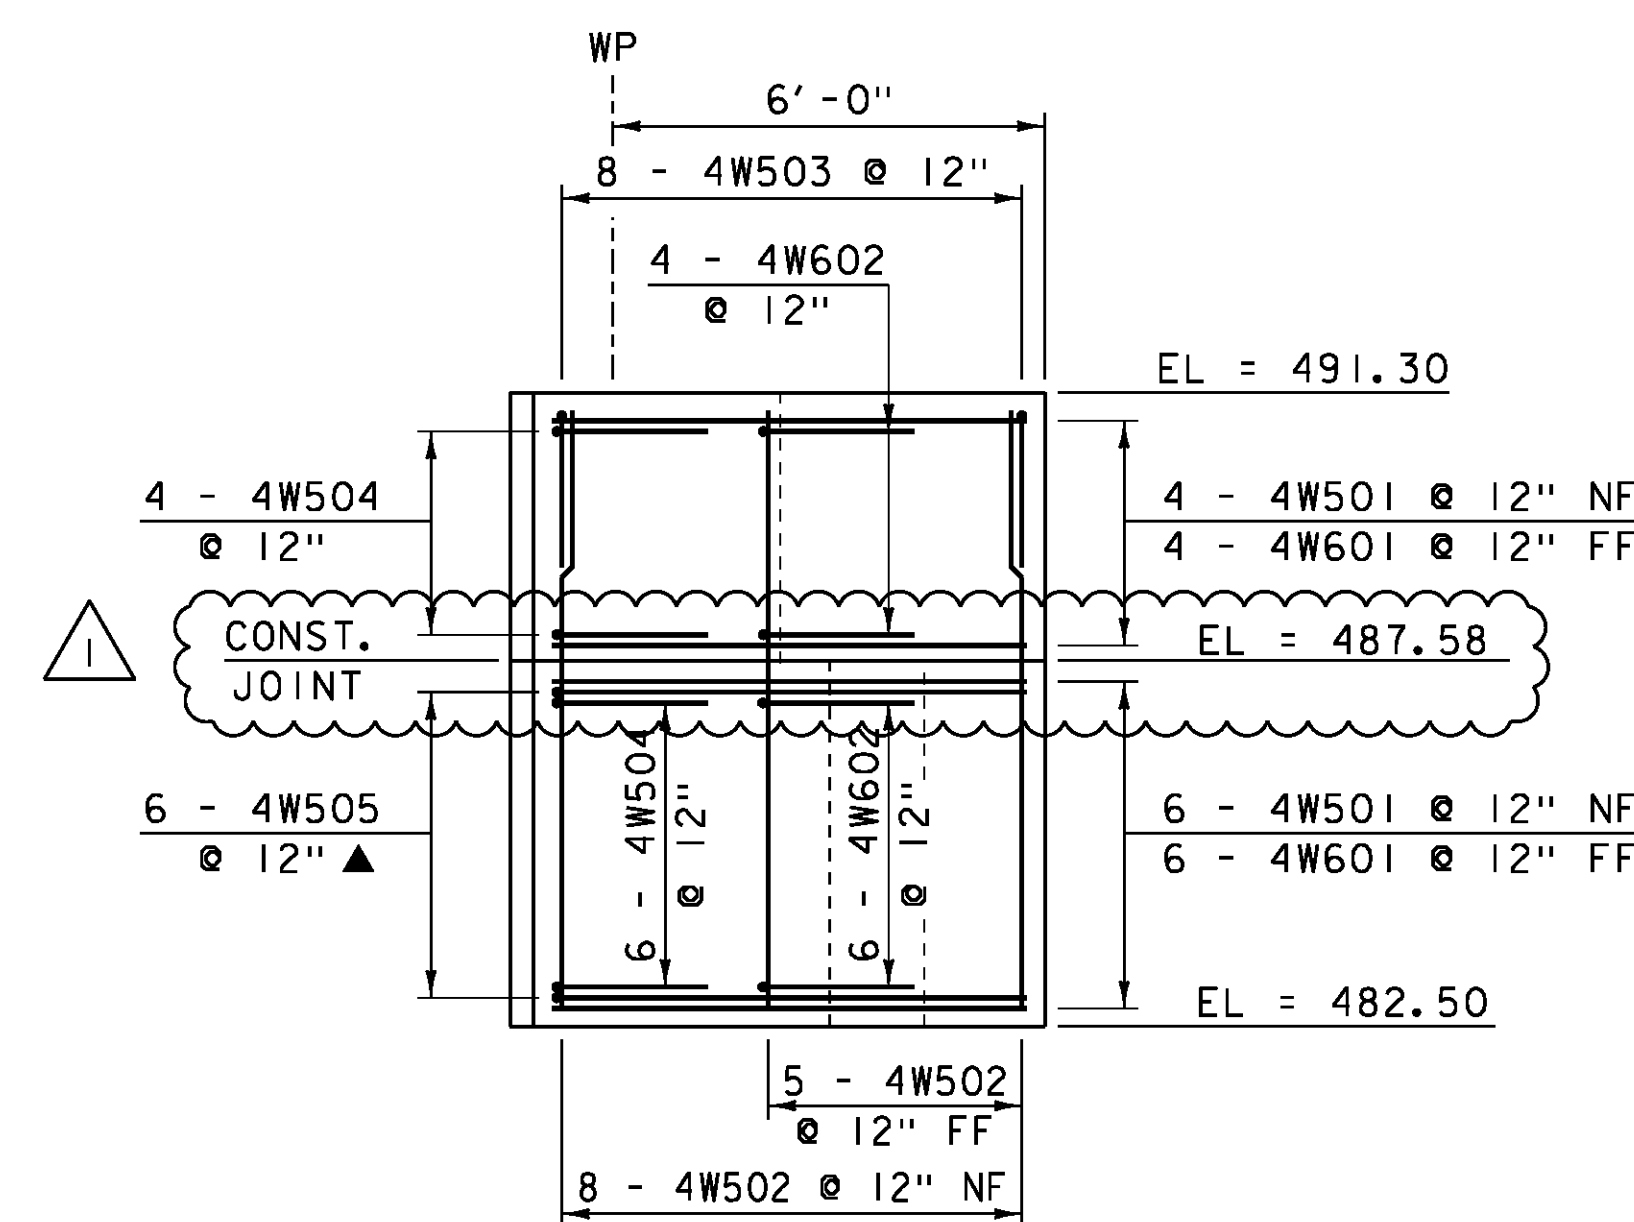

WINGWALL #4 ELEVATION

SCALE: 3/8" = 1'-0"

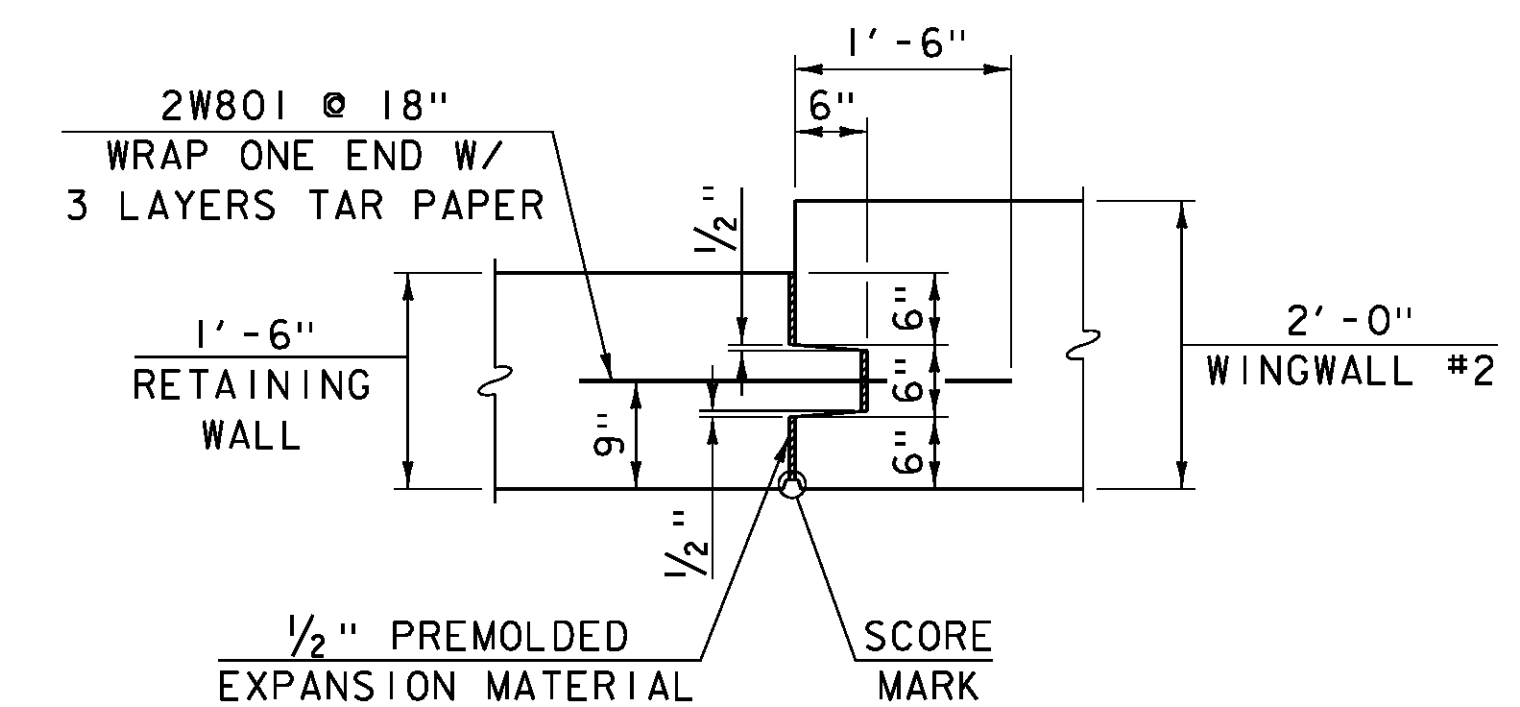

CONCRETE EXPANSION JOINT

(BETWEEN RETAINING WALL AND WINGWALL #2)

SCALE: 3/4" = 1'-0"

NOTE:


- NF = NEAR FACE
- FF = FAR FACE
- EF = EACH FACE
- ▲ = CUT TO FIT IN FIELD
- 3" CLEAR, UNLESS OTHERWISE SPECIFIED ON THE PLANS.
- 2'-2" BAR LAP UNLESS OTHERWISE SPECIFIED ON THE PLANS.

REVISION	DATE	DESCRIPTION	BY
1	OCT-28-2014	ADD 3" PAYMENT, LOWER BRIDGE SEAT, ADD 3" CONCRETE PEDESTAL	GNR

PROJECT NAME: JOHNSON  
PROJECT NUMBER: BRF 030-2(26)


FILE NAME: s88bl93sub.dgn  
PROJECT LEADER: C. CARLSON  
DESIGNED BY: H. SALLS  
WINGWALL ELEVATIONS AND TYPICAL SECTION SHEET 35 OF 69

PLOT DATE: 05-NOV-2014  
DRAWN BY: G. ROKES  
CHECKED BY: H. SALLS

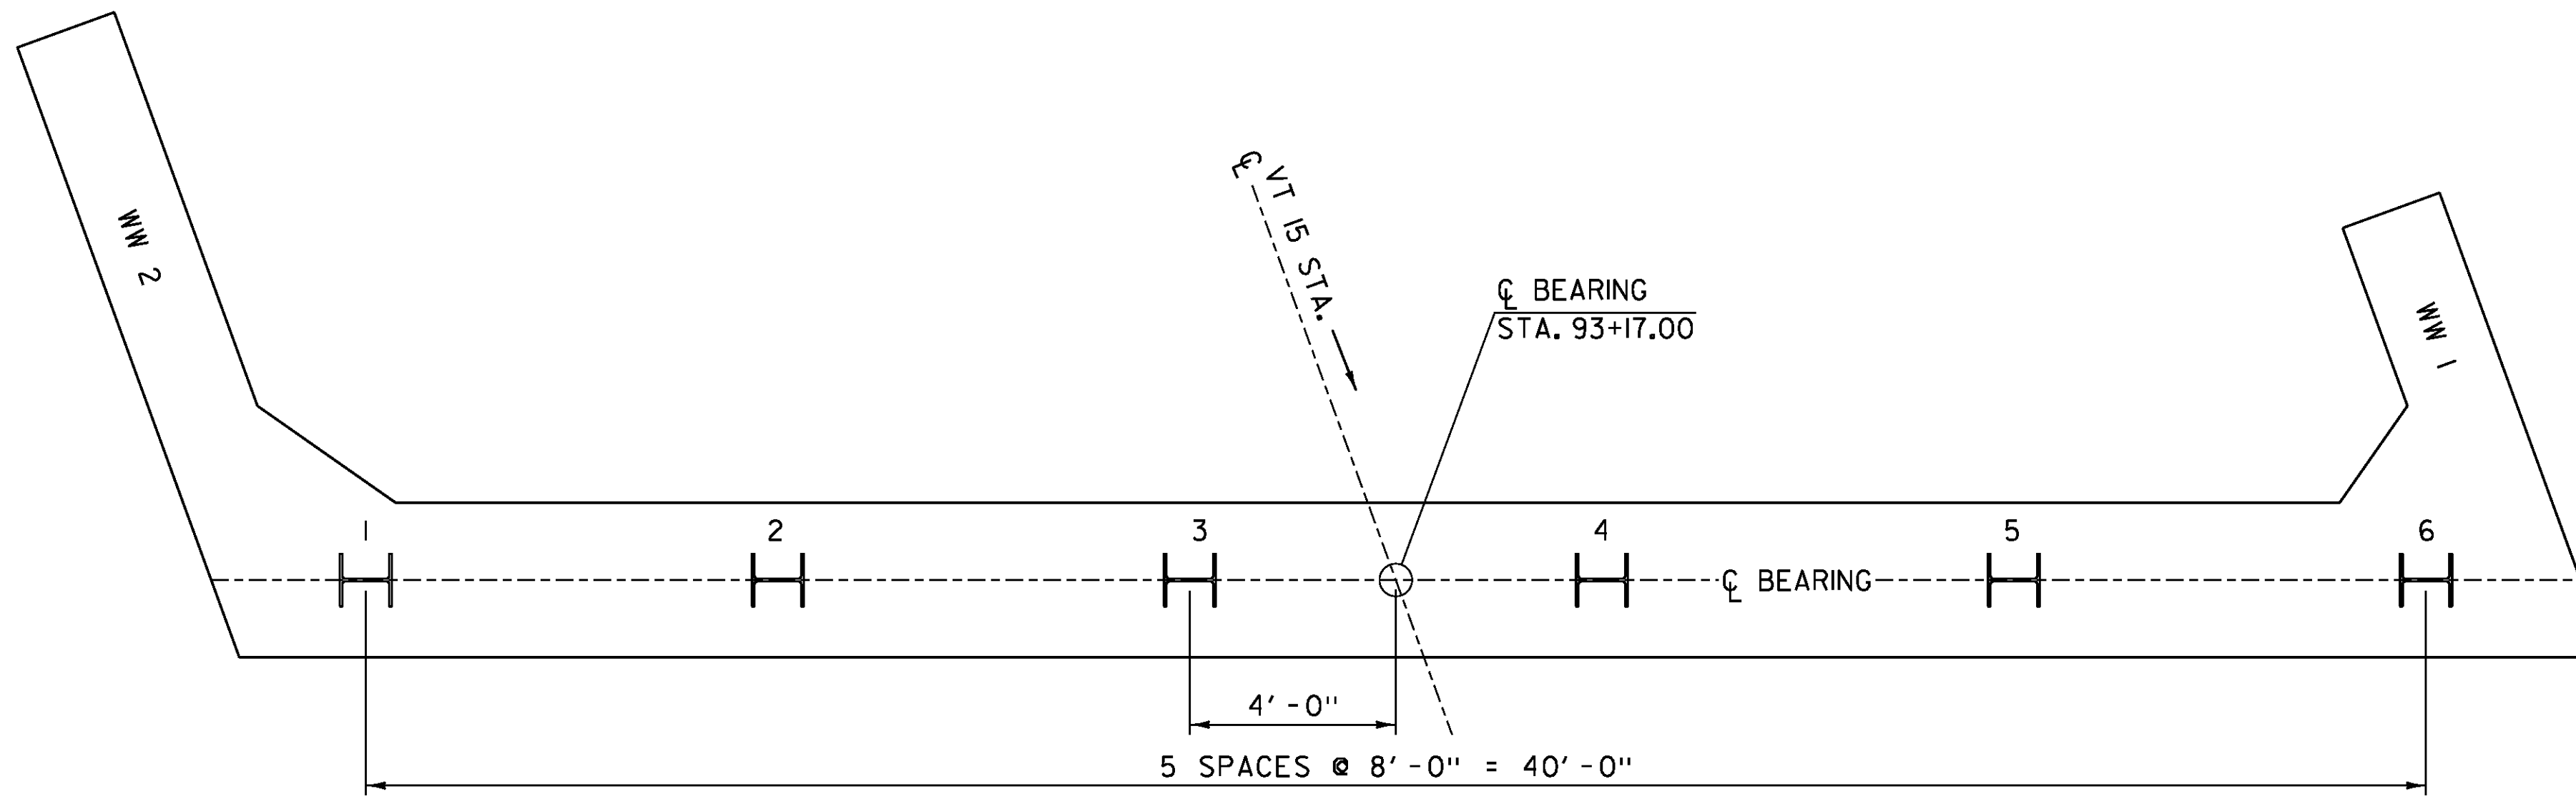

**ABUTMENT #1 PILE LAYOUT**

SCALE: 3/8" = 1'-0"

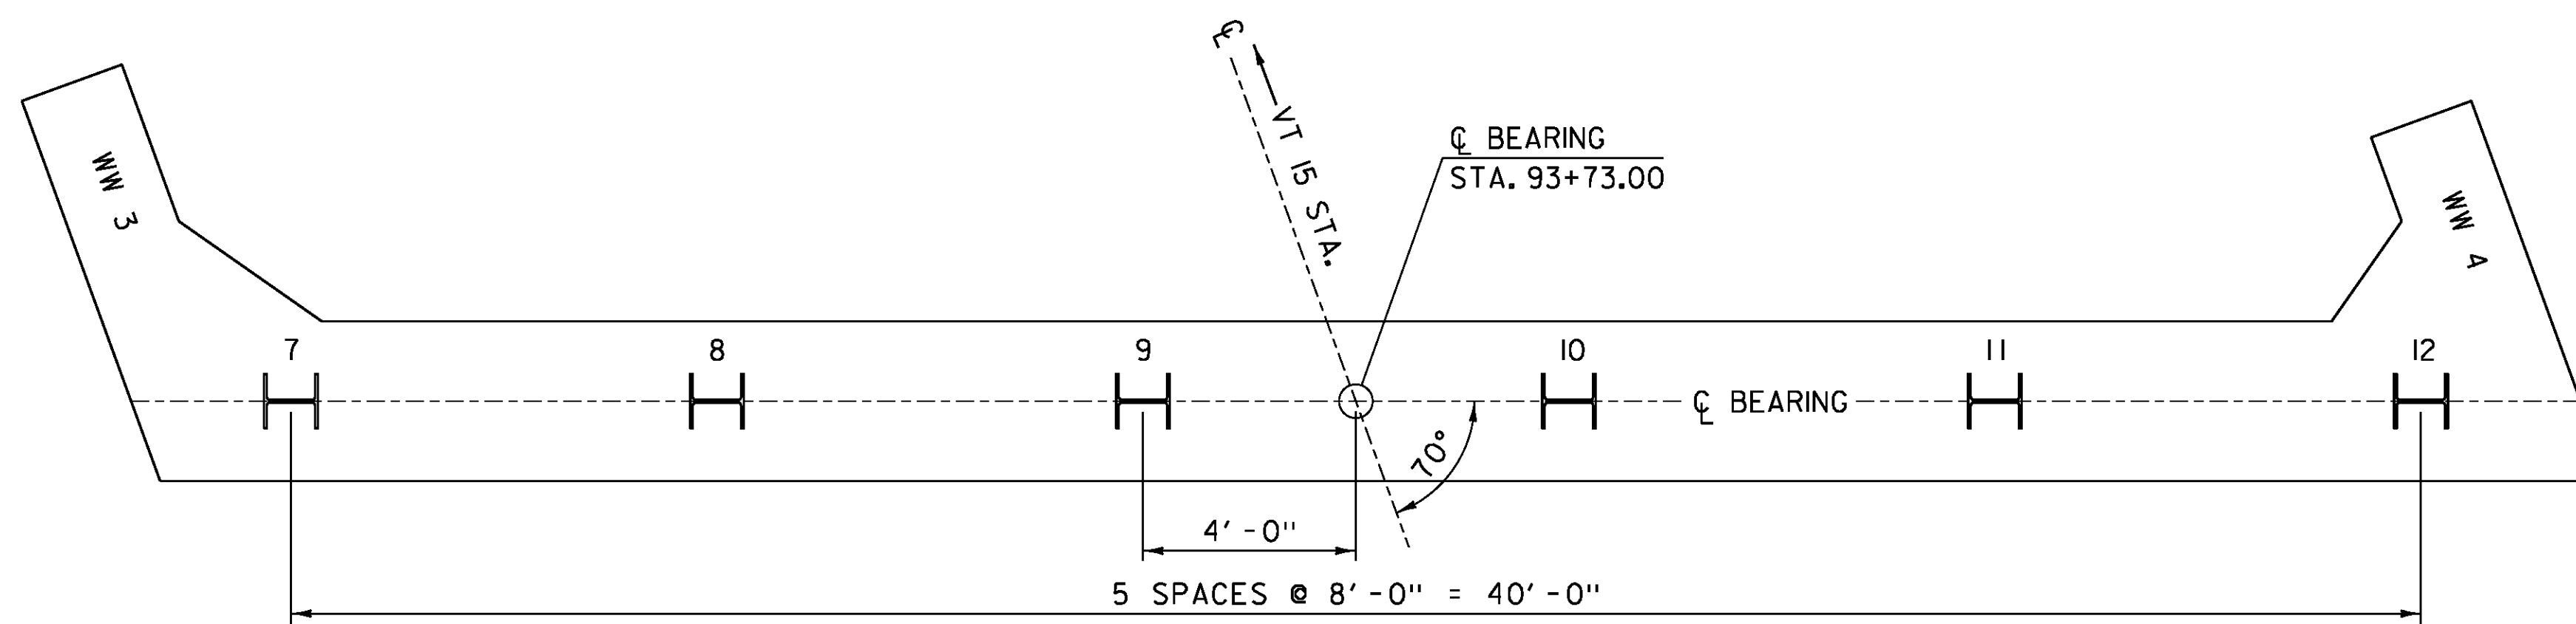


**ABUTMENT #2 PILE LAYOUT**

SCALE: 3/8" = 1'-0"


**NOTE:**  
SEE STRUCTURES DETAIL SD-601.00  
FOR PILE SPLICE DETAIL.

PROJECT NAME: JOHNSON	PLOT DATE: 10-JUN-2014
PROJECT NUMBER: BRF 030-2(26)	DRAWN BY: G. ROKES
FILE NAME: s88bl93sub.dgn	CHECKED BY: H. SALLS
PROJECT LEADER: C. CARLSON	SHEET 36 OF 69
DESIGNED BY: H. SALLS	
ABUTMENT #1 AND #2 PILE LAYOUT	

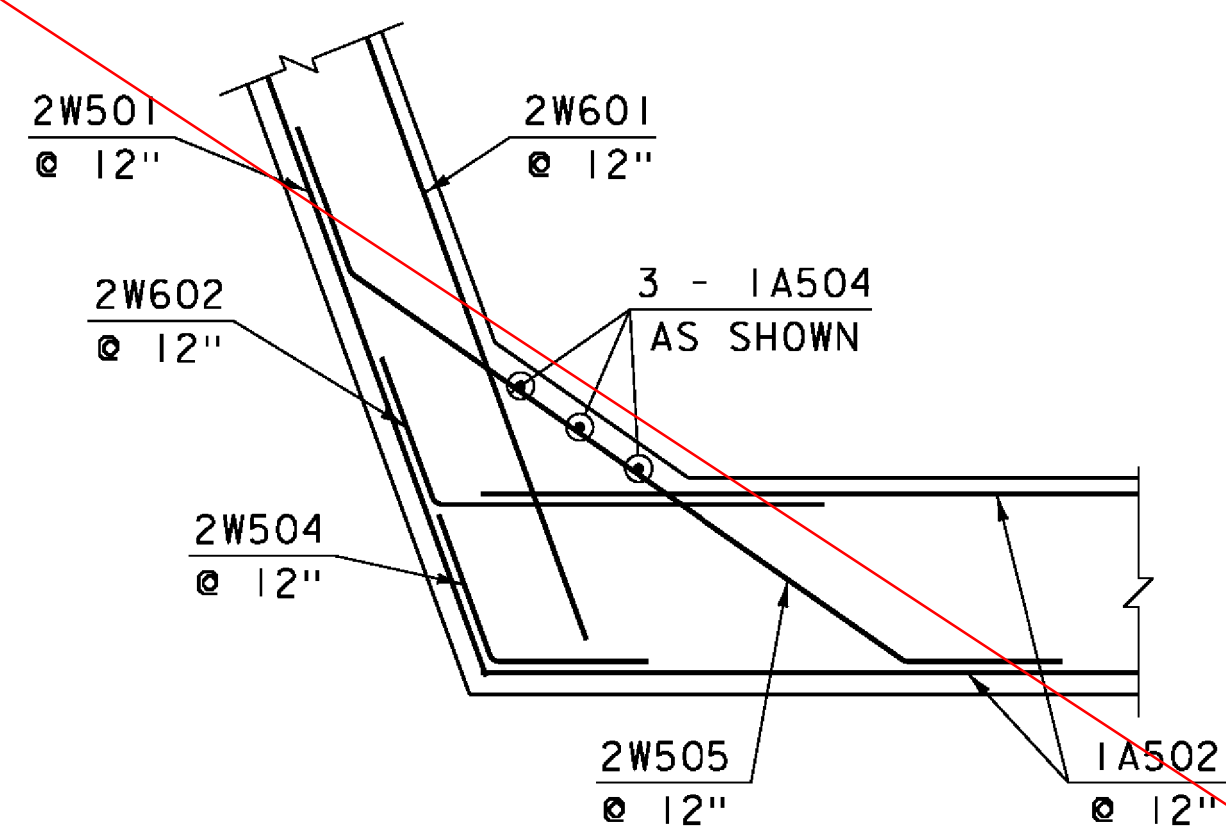


**WINGWALL NO. 2 CORNER  
REINFORCING BELOW  
CONSTRUCTION JOINT**

SCALE: 3/8" = 1'-0"  
(WINGWALL 3 SIMILAR)

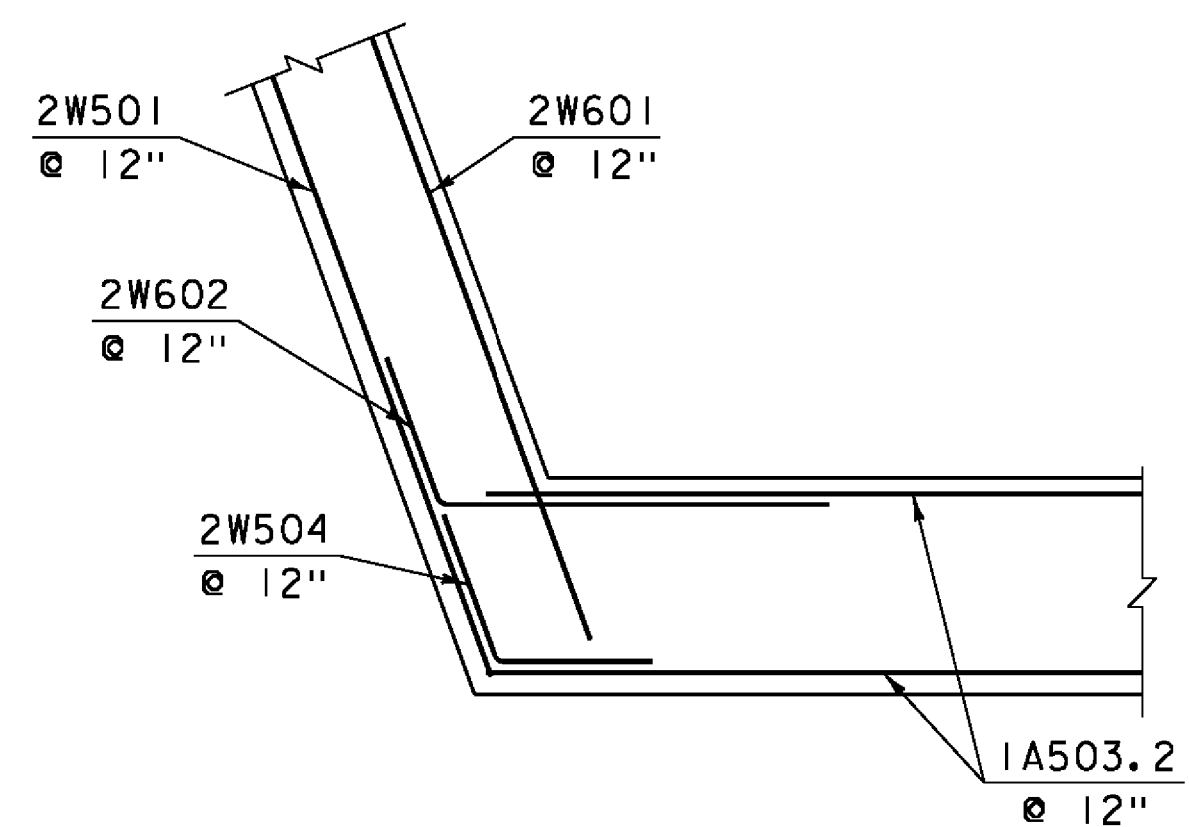


**WINGWALL NO. 2 CORNER  
REINFORCING ABOVE  
CONSTRUCTION JOINT**

SCALE: 3/8" = 1'-0"  
(WINGWALL 3 SIMILAR)

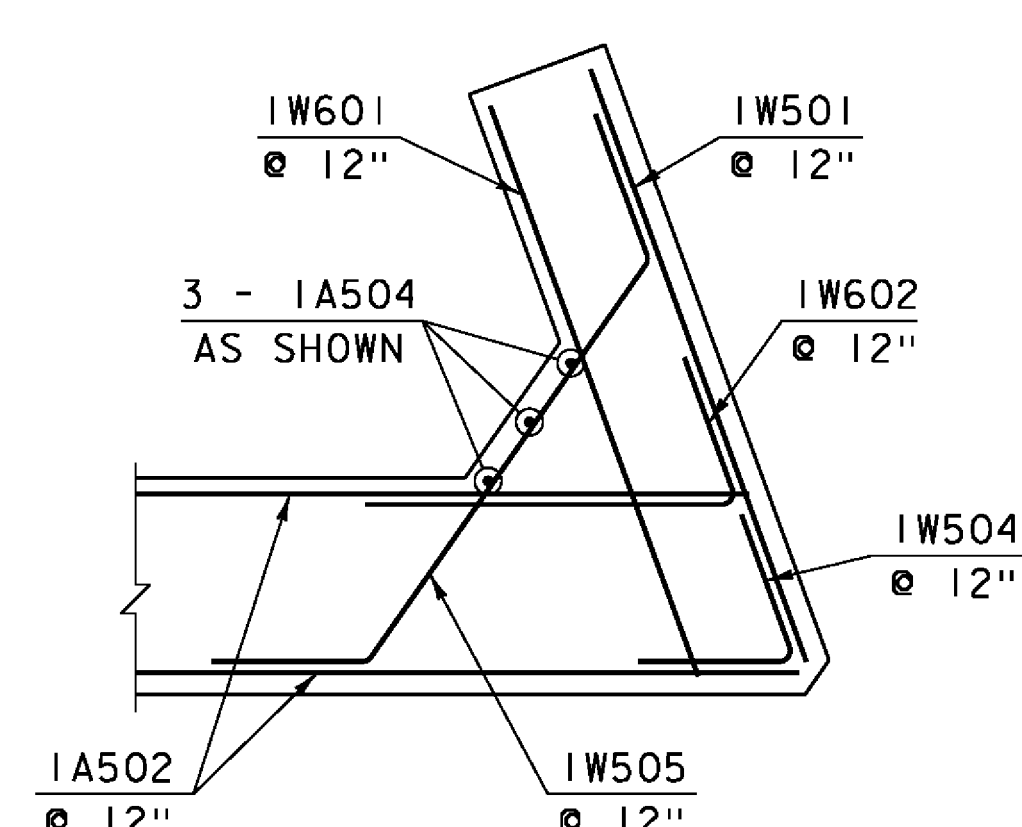


**WINGWALL NO. 1 CORNER  
REINFORCING BELOW  
CONSTRUCTION JOINT**

SCALE: 3/8" = 1'-0"  
(WINGWALL 4 SIMILAR)

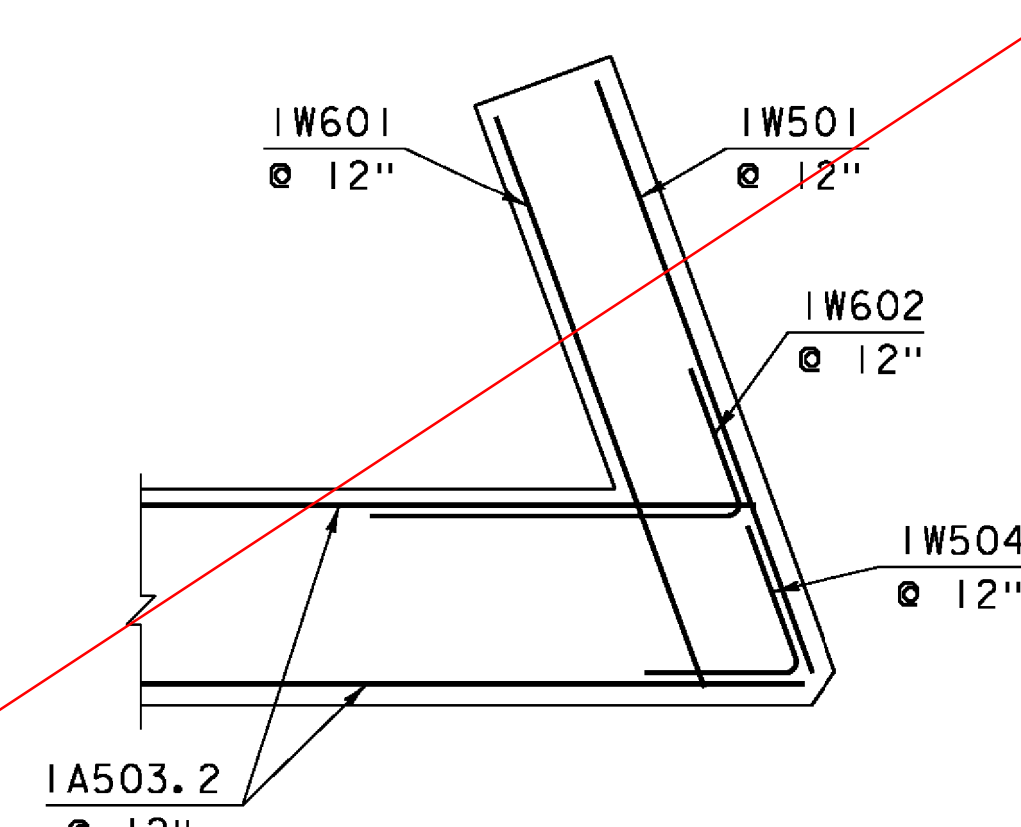


**WINGWALL NO. 1 CORNER  
REINFORCING ABOVE  
CONSTRUCTION JOINT**

SCALE: 3/8" = 1'-0"  
(WINGWALL 4 SIMILAR)

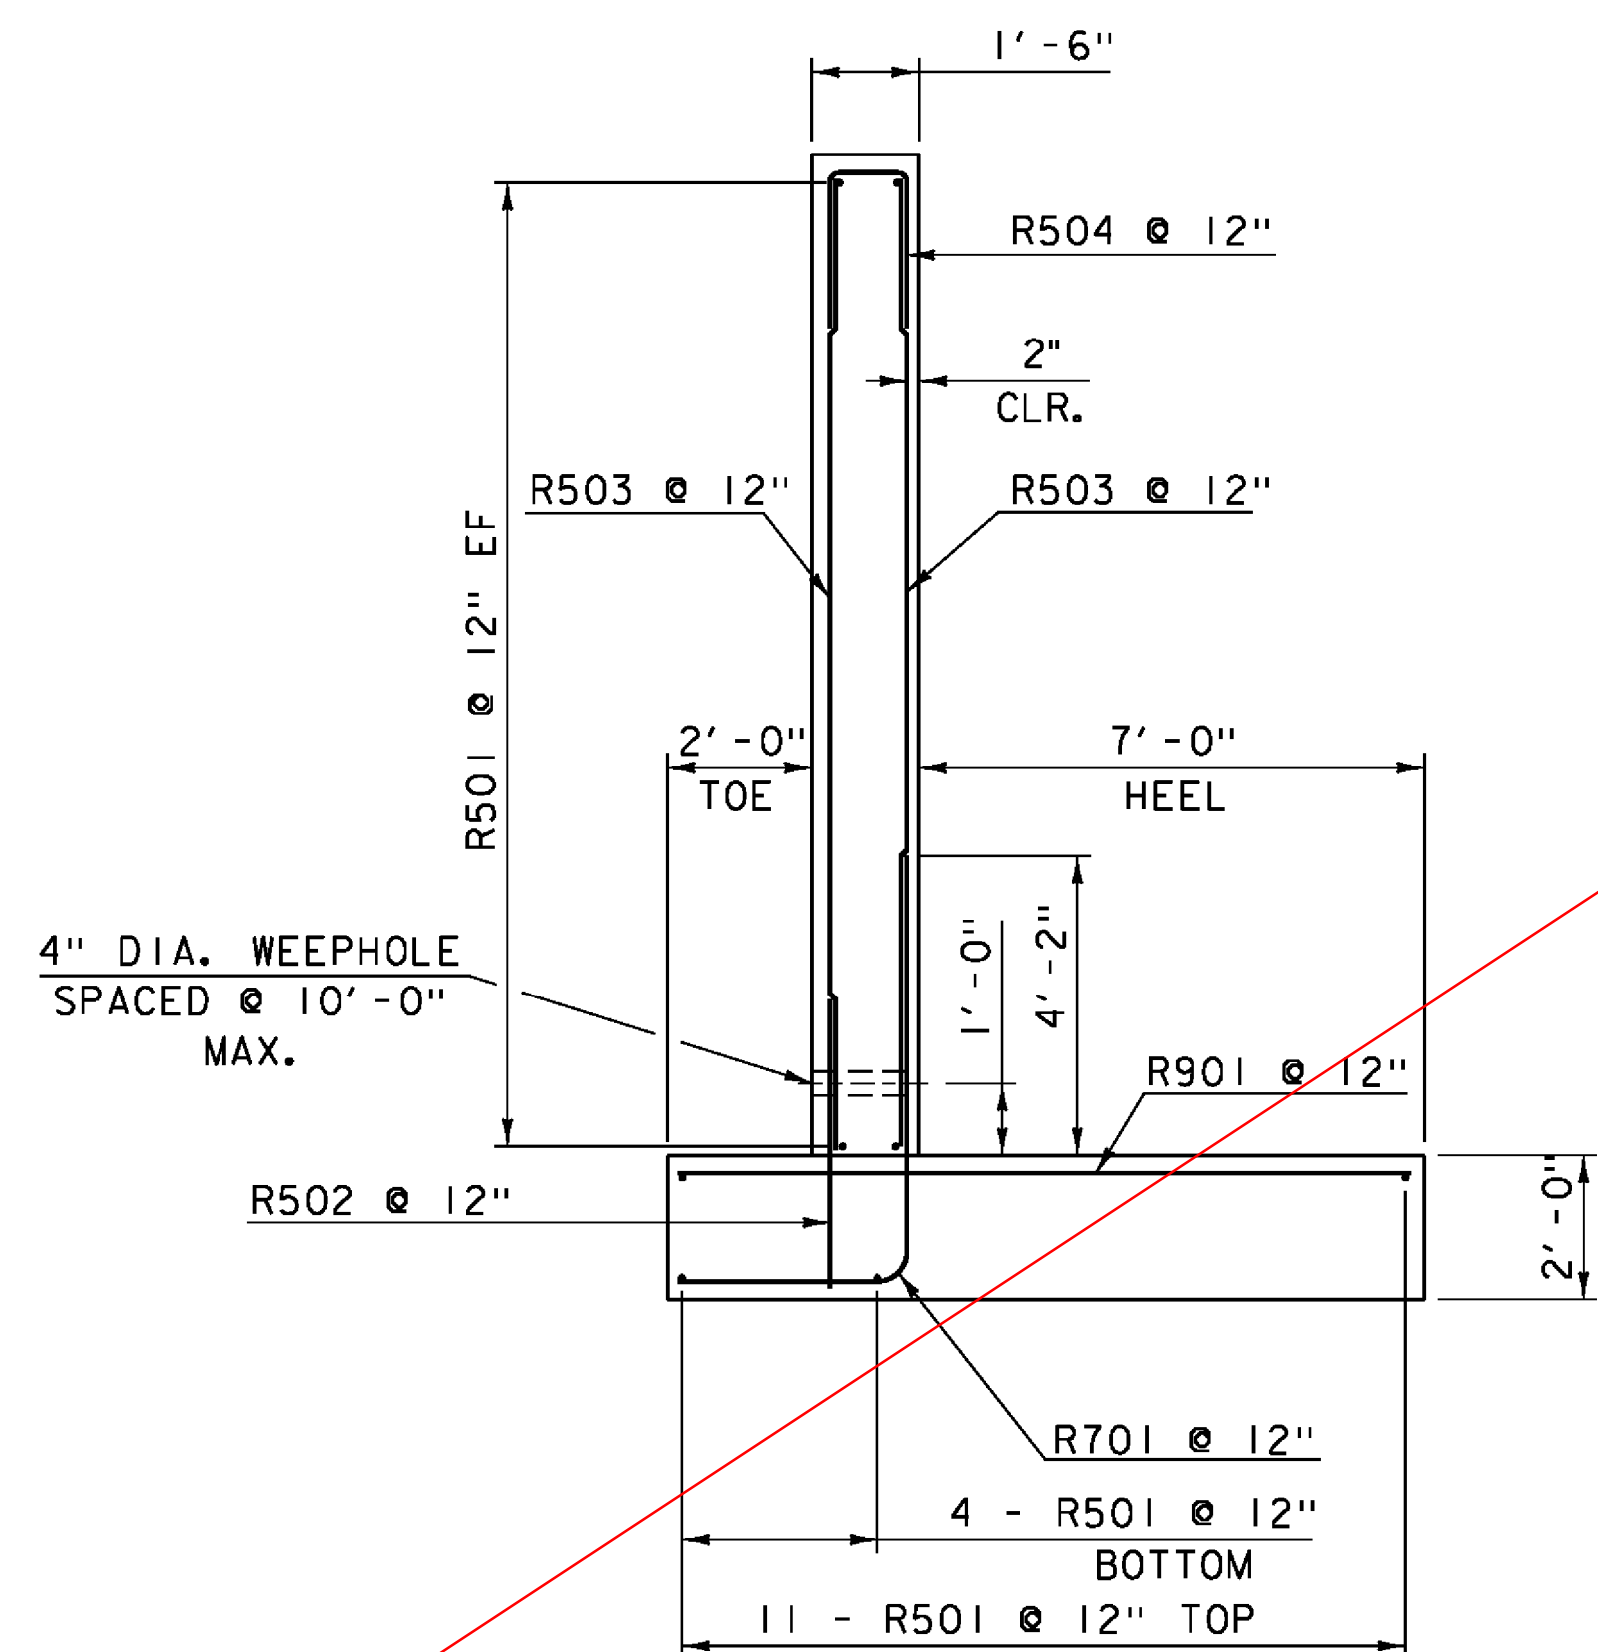

**RETAINING WALL TYPICAL**

SCALE: 3/8" = 1'-0"

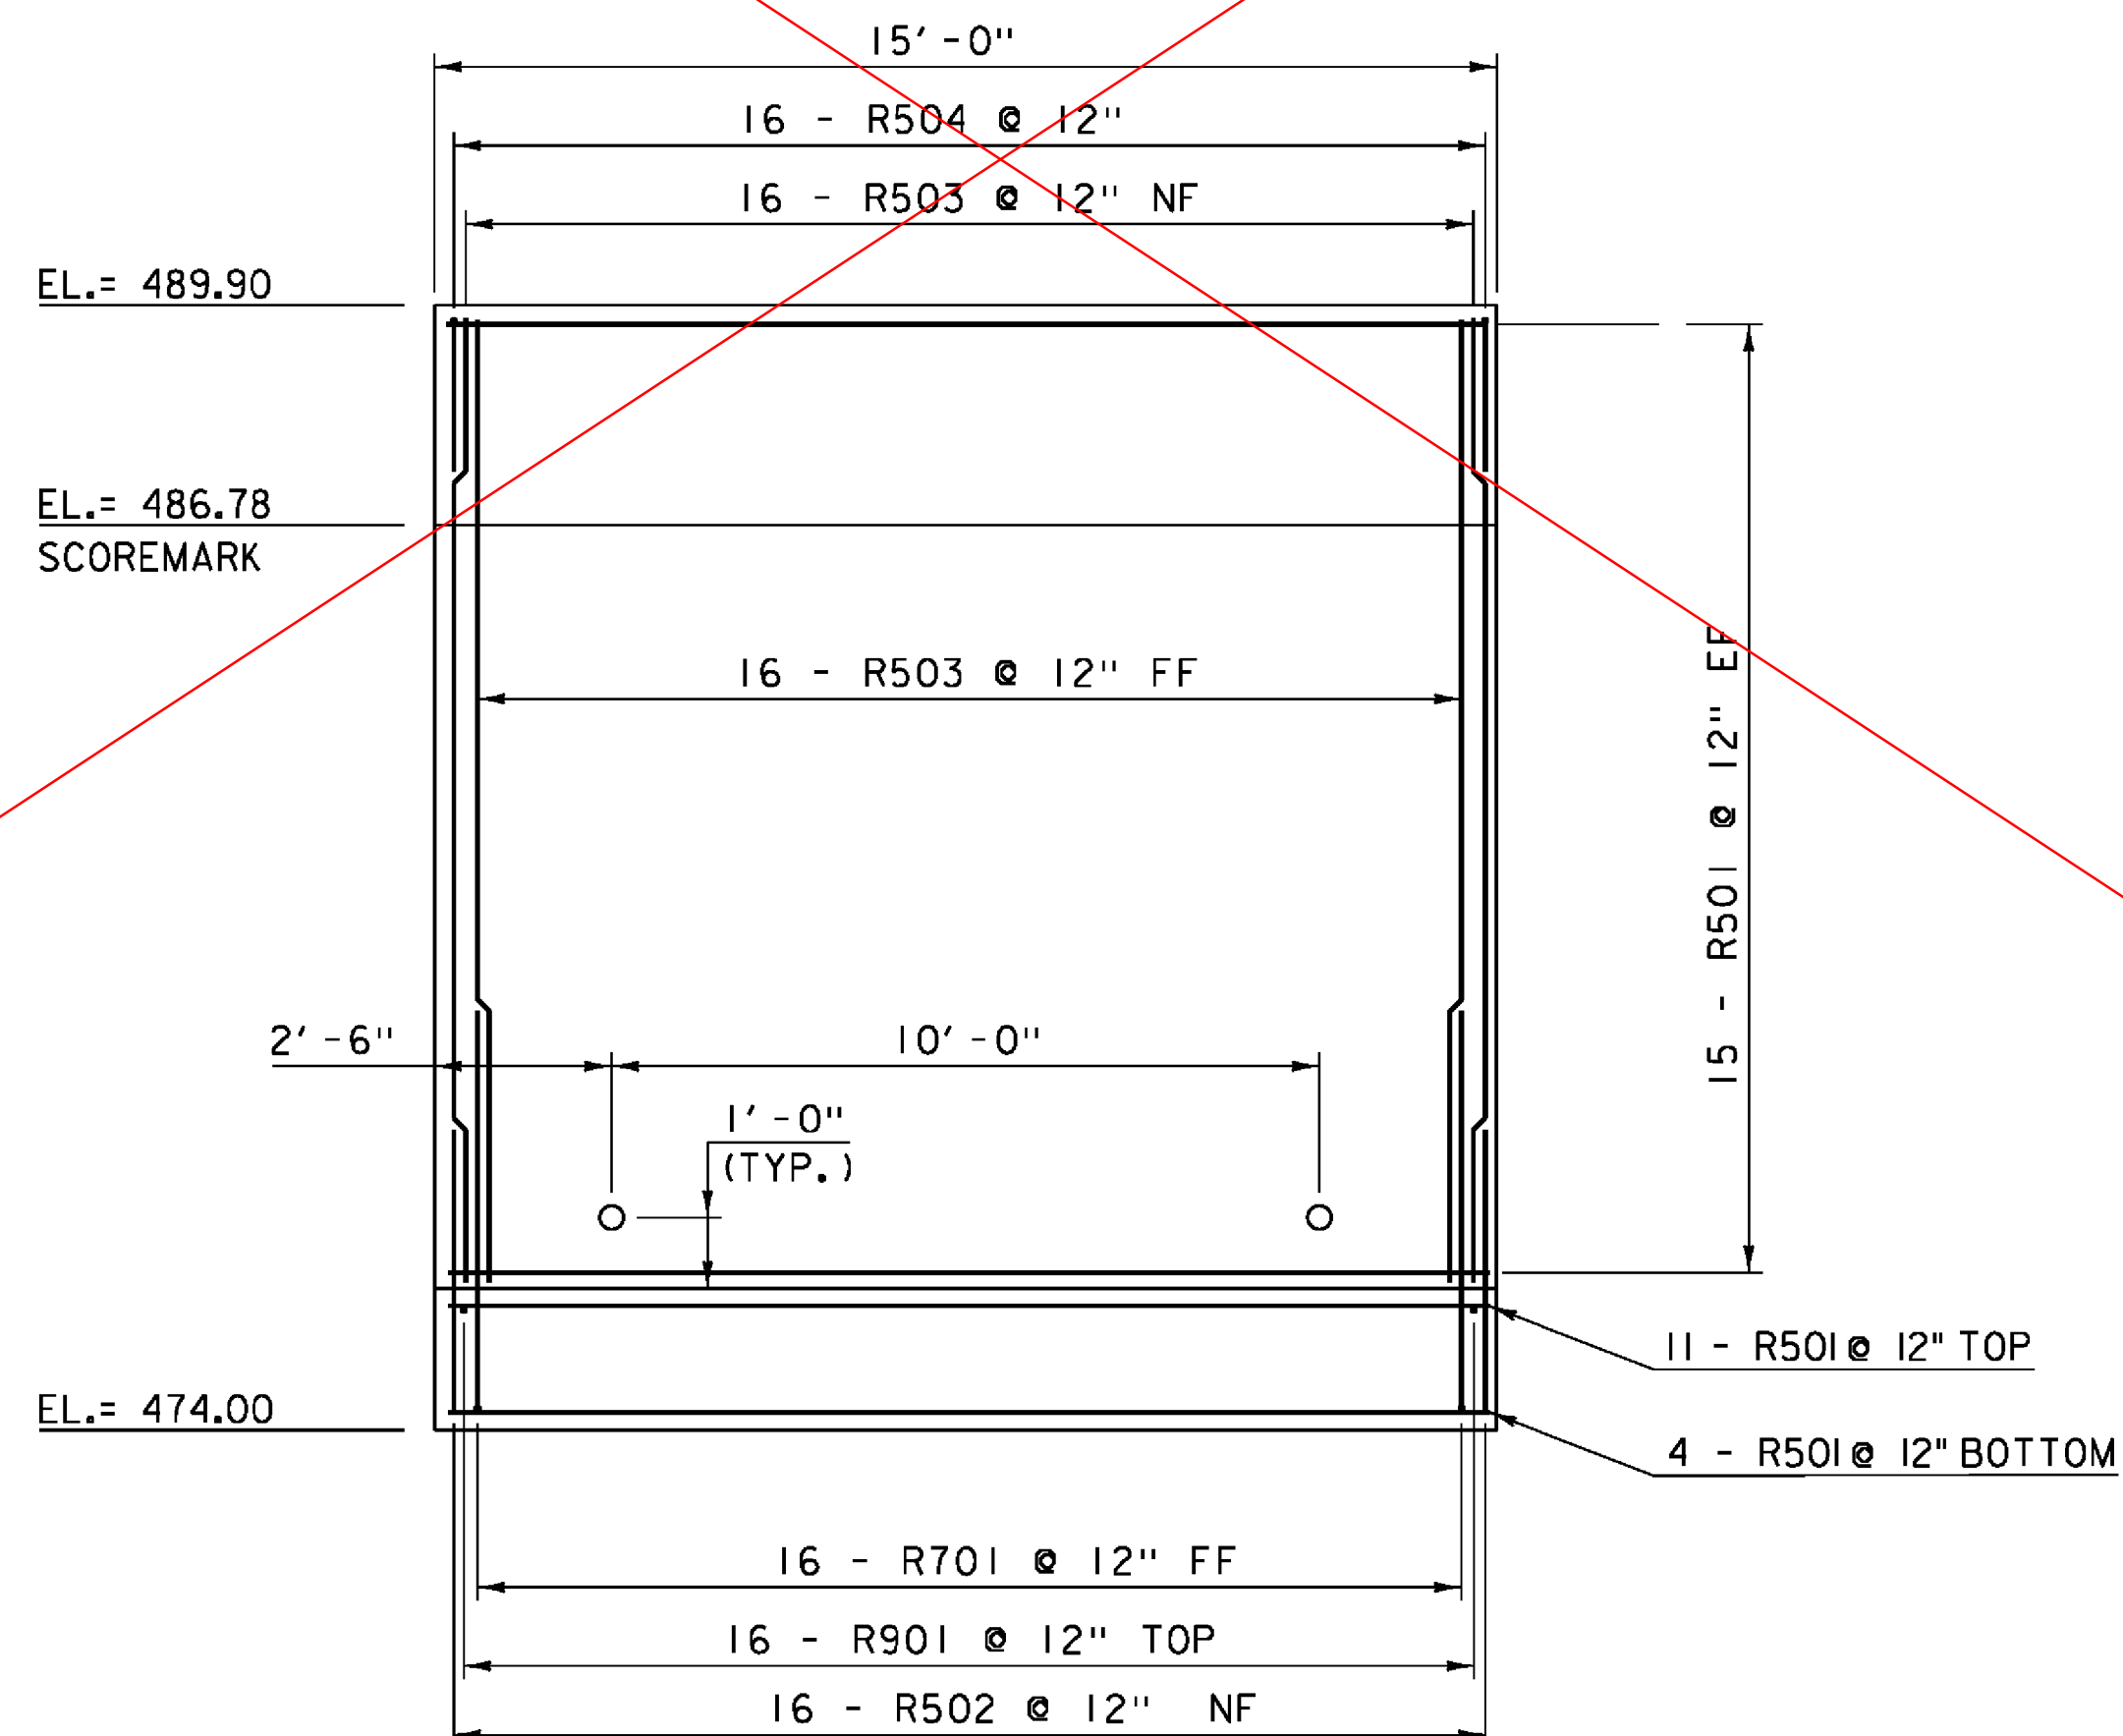

**RETAINING WALL ELEVATION**

SCALE: 3/8" = 1'-0"

NOTE: 1/2" EXPANSION MATERIAL SHALL BE PLACED BETWEEN WINGWALL #2 AND THE RETAINING WALL. IN ADDITION, 2 LAYERS OF GEOTEXTILE FABRIC SHALL BE PLACED OVER THE JOINT ON THE BACK (EARTH) SIDE.


**NOTE:**

- NF = NEAR FACE
- FF = FAR FACE
- EF = EACH FACE
- ▲ = CUT TO FIT IN FIELD
- 3" CLEAR, UNLESS OTHERWISE SPECIFIED ON THE PLANS.
- 2'-2" BAR LAP UNLESS OTHERWISE SPECIFIED ON THE PLANS.

SEE REVISION: OCT-28-2014


PROJECT NAME: JOHNSON  
PROJECT NUMBER: BRF 030-2(26)

FILE NAME: s88bi93sub.dgn PLOT DATE: 10-JUN-2014  
PROJECT LEADER: C. CARLSON DRAWN BY: G. ROKES  
DESIGNED BY: H. SALLS CHECKED BY: H. SALLS  
RETAINING WALL ELEVATION AND TYPICAL SECTION SHEET 37 OF 69

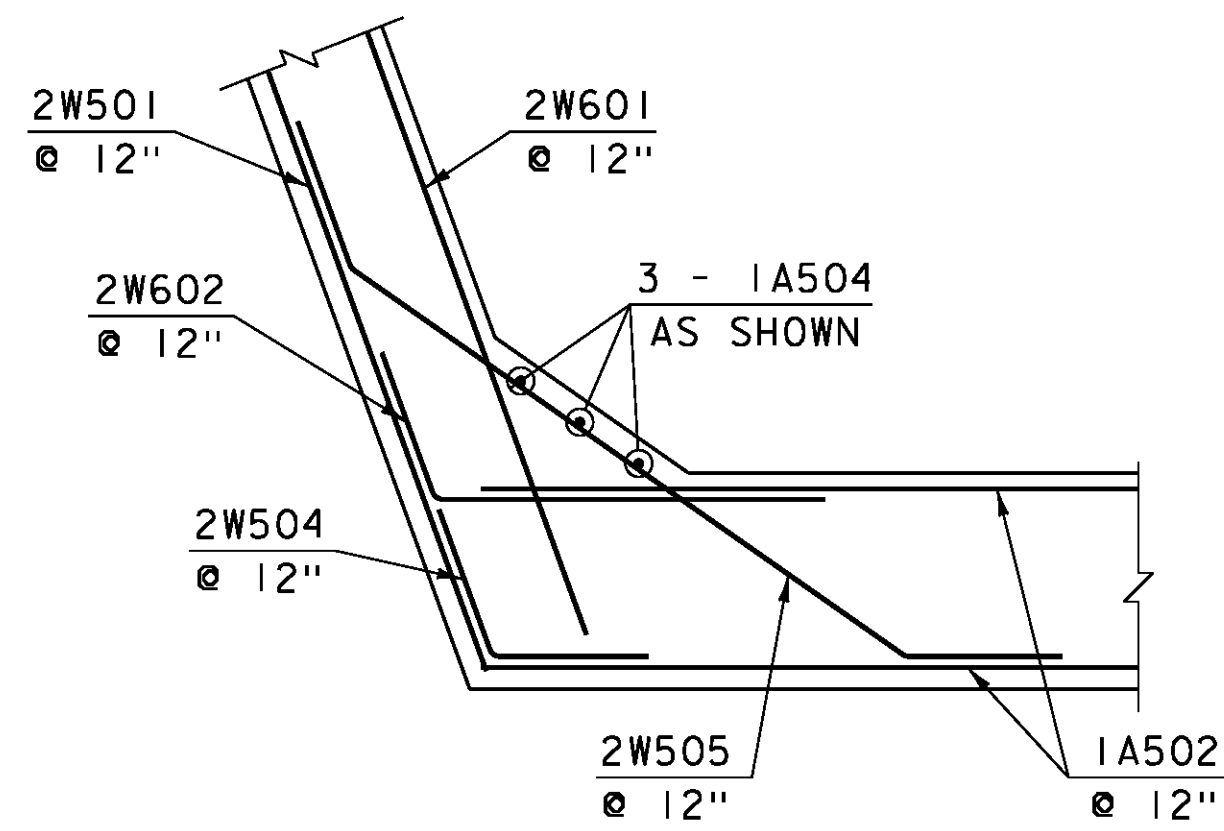


**WINGWALL NO. 2 CORNER  
REINFORCING BELOW  
CONSTRUCTION JOINT**

SCALE: 3/8" = 1'-0"  
(WINGWALL 3 SIMILAR)

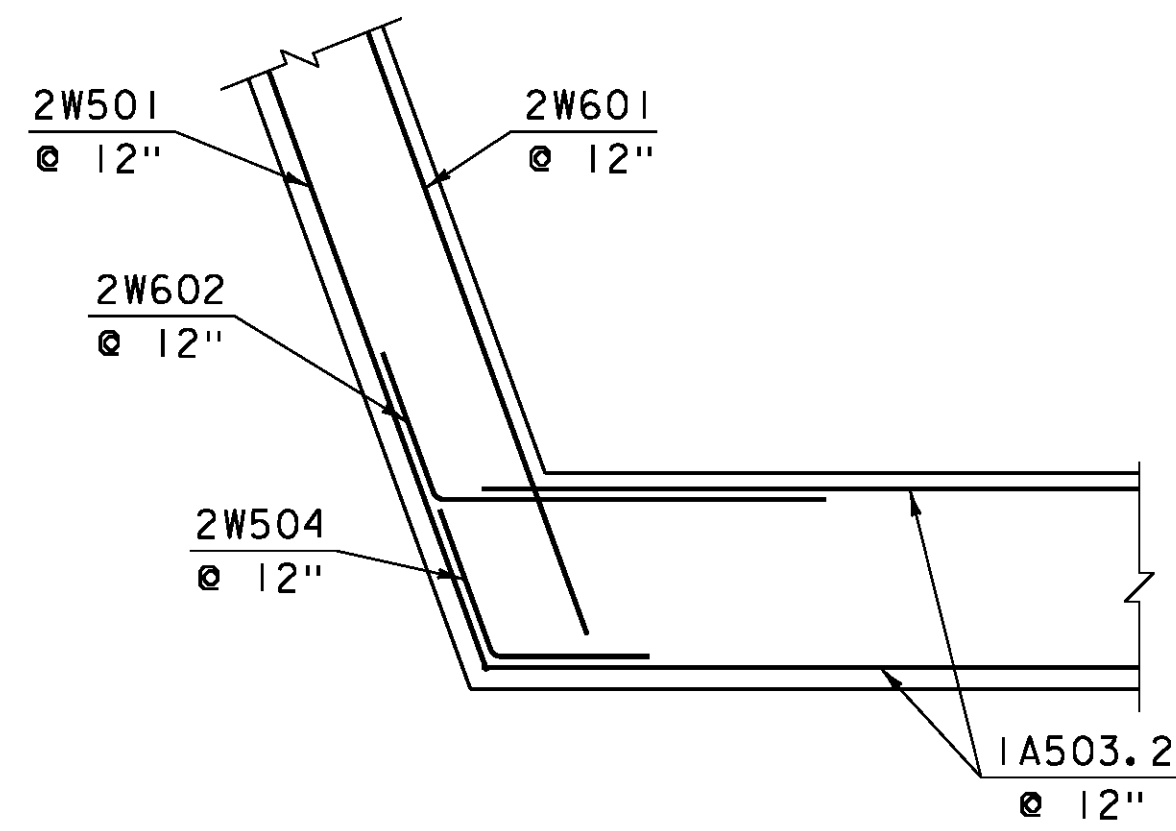


**WINGWALL NO. 2 CORNER  
REINFORCING ABOVE  
CONSTRUCTION JOINT**

SCALE: 3/8" = 1'-0"  
(WINGWALL 3 SIMILAR)

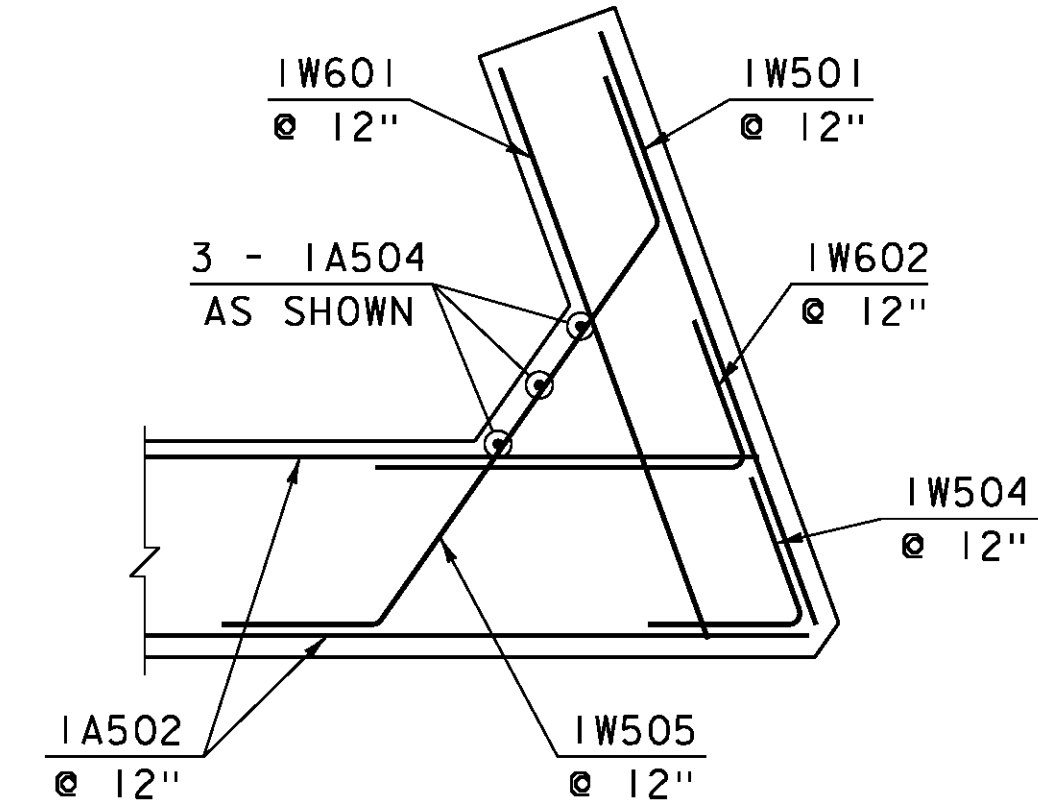


**WINGWALL NO. 1 CORNER  
REINFORCING BELOW  
CONSTRUCTION JOINT**

SCALE: 3/8" = 1'-0"  
(WINGWALL 4 SIMILAR)

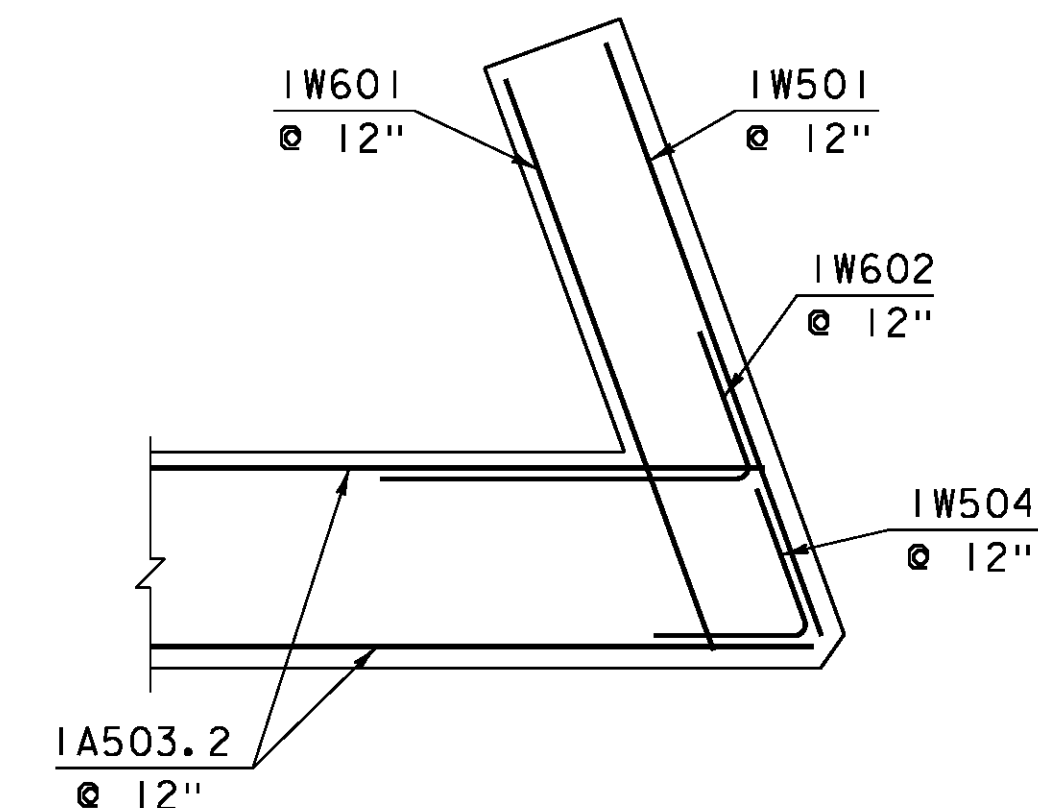


**WINGWALL NO. 1 CORNER  
REINFORCING ABOVE  
CONSTRUCTION JOINT**

SCALE: 3/8" = 1'-0"  
(WINGWALL 4 SIMILAR)

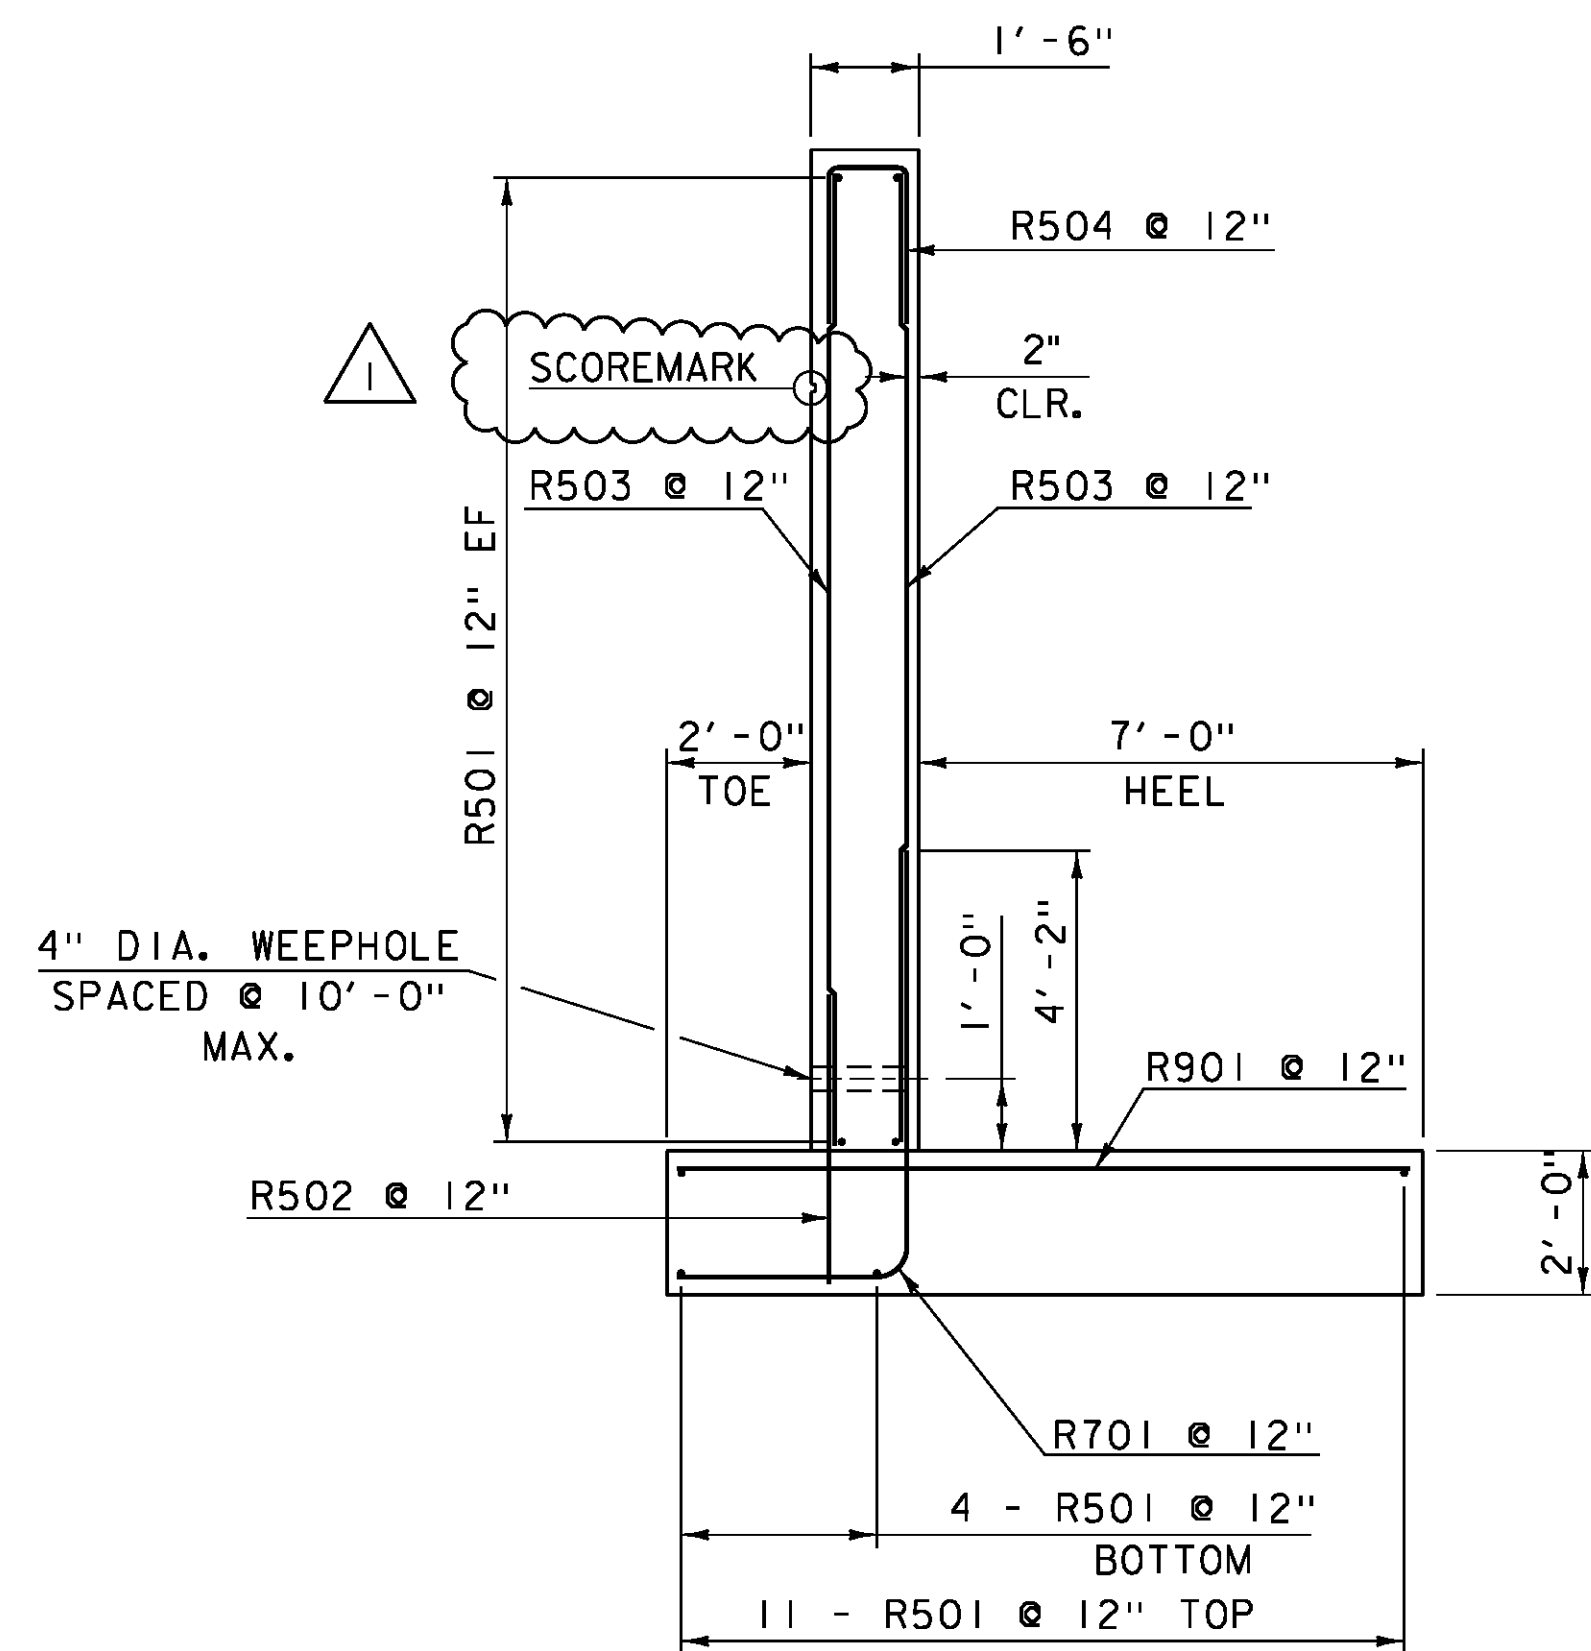

**RETAINING WALL TYPICAL**  
SCALE: 3/8" = 1'-0"

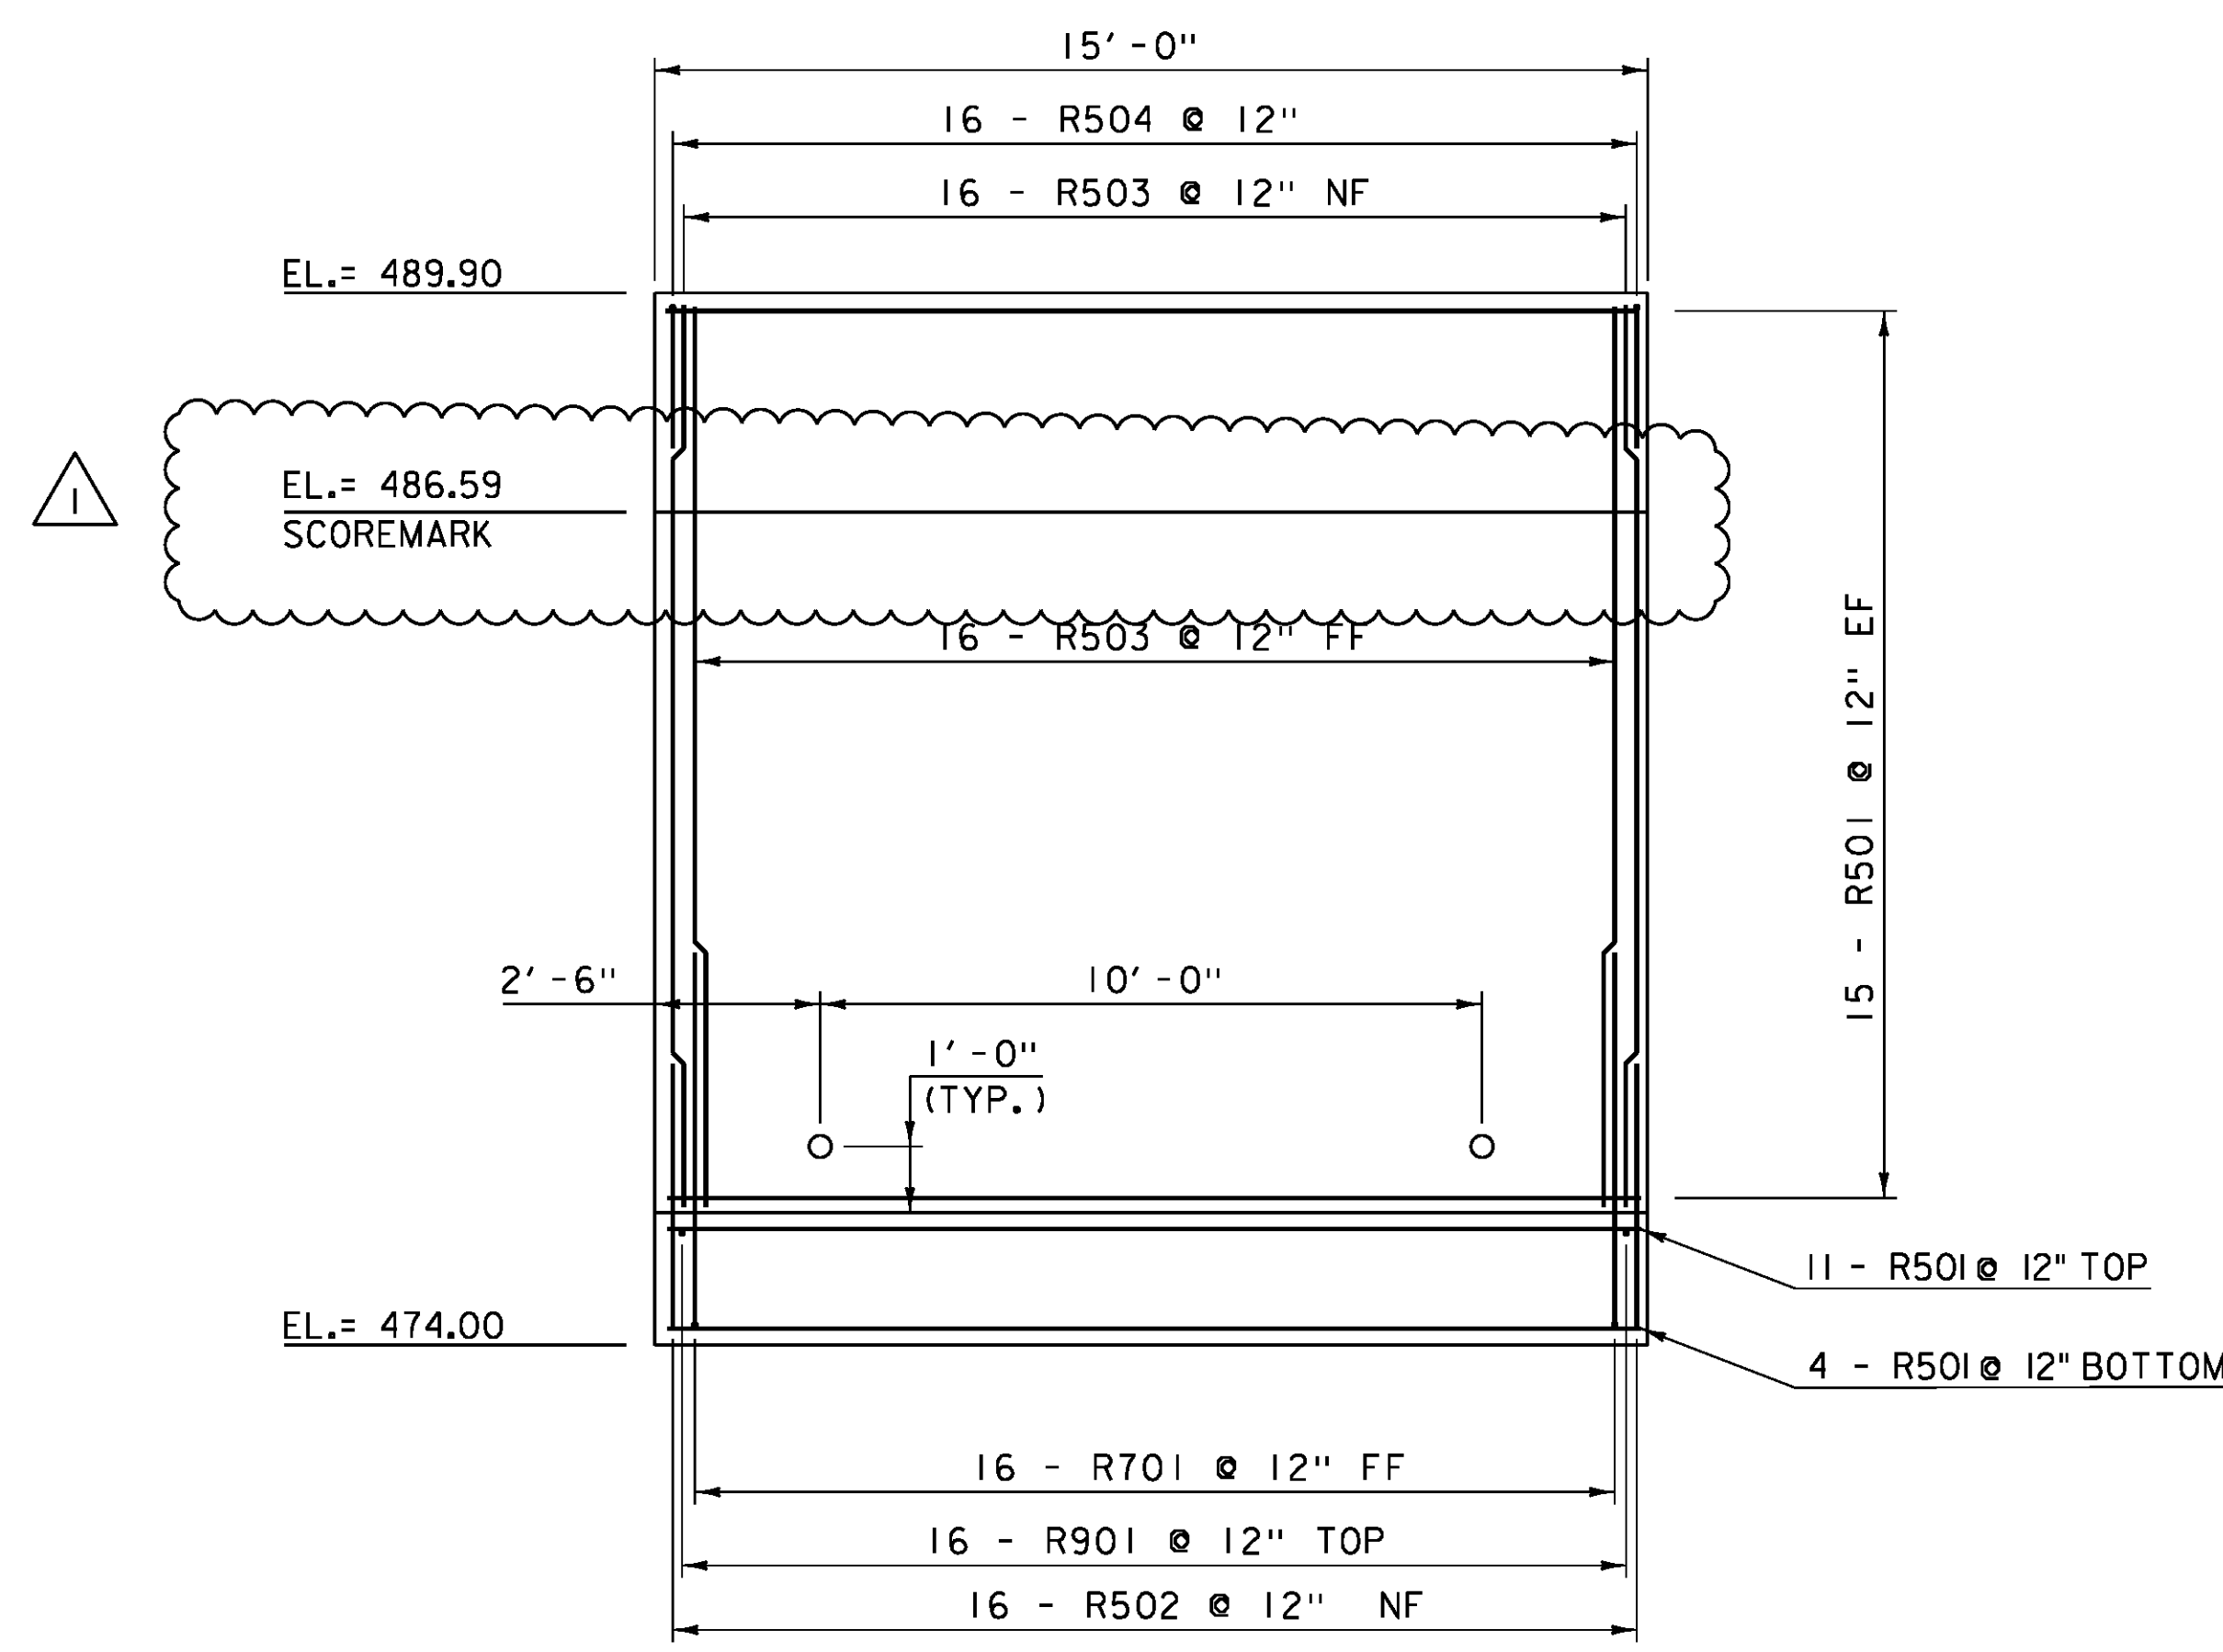

**RETAINING WALL ELEVATION**  
SCALE: 3/8" = 1'-0"

REVISION	DATE	DESCRIPTION	BY
1	OCT-28-2014	ADD 3" PAYMENT, LOWER BRIDGE SEAT, ADD 3" CONCRETE PEDESTAL	GNR

NOTE: 1/2" EXPANSION MATERIAL SHALL BE PLACED BETWEEN WINGWALL #2 AND THE RETAINING WALL. IN ADDITION, 2 LAYERS OF GEOTEXTILE FABRIC SHALL BE PLACED OVER THE JOINT ON THE BACK (EARTH) SIDE.

**NOTE:**  
NF = NEAR FACE  
FF = FAR FACE  
EF = EACH FACE  
▲ = CUT TO FIT IN FIELD  
3" CLEAR, UNLESS OTHERWISE SPECIFIED ON THE PLANS.  
2'-2" BAR LAP UNLESS OTHERWISE SPECIFIED ON THE PLANS.


PROJECT NAME:	JOHNSON
PROJECT NUMBER:	BRF 030-2(26)
FILE NAME:	s88bl93sub.dgn
PROJECT LEADER:	C. CARLSON
DESIGNED BY:	H. SALLS
RETAINING WALL ELEVATION AND TYPICAL SECTION SHEET	37 OF 69
PLOT DATE:	05-NOV-2014
DRAWN BY:	G. ROKES
CHECKED BY:	H. SALLS

# REINFORCING STEEL SCHEDULE

ITEM	EACH	SIZE	LENGTH	MARK	TYPE	A	B	C	D	E	F	G	H	J	K	R	O	ITEM	EACH	SIZE	LENGTH	MARK	TYPE	A	B	C	D	E	F	G	H	J	K	R	O
<b>CONCRETE DECK OVERLAY</b>																		<b>ABUTMENT # 2</b>																	
* 181	5	21'- 4"	S501.2	STR														* 24	5	23'- 10"	2A502	STR													
* 157	5	37'- 1"	S502.2	STR														* ▲ 7	5	5'- 1"	2A504	STR													
* 61	6	21'- 7"	S601.2	STR														139	5	7'- 4"	2A501	S10	2'- 7"	4'- 9"	---										
* 63	6	6'- 0"	S602.2	STR														47	5	6'- 11"	2A503	S10	2'- 2"	2'- 7"	2'- 2"										
▲ 234	7	5'- 4"	S701.2	STR														16	5	23'- 10"	2A503.2	STR													
<b>APPROACH SLAB #1</b>																		<b>WINGWALL # 3</b>																	
* 47	5	17'- 11"	1A501	STR														* 11	5	7'- 1"	3W501	STR													
* 40	9	20'- 9"	1A501	I	---	19'- 6"						1'- 3"		0'- 11"				13	5	8'- 7"	3W502	STR													
<b>APPROACH SLAB #2</b>																		<b>WINGWALL #4</b>																	
* 47	5	17'- 11"	2A501	STR														* 11	6	7'- 1"	3W601	STR													
* 40	9	20'- 9"	2A501	1	---	19'- 6"						1'- 3"		0'- 11"				8	5	5'- 11"	3W503	S10	2'- 2"	1'- 7"	2'- 2"										
<b>ABUTMENT # 1</b>																		<b>RETAINING WALL</b>																	
* ▲ 7	5	5'- 0"	1A504	STR														45	5	14'- 6"	R501	STR													
139	5	7'- 4"	1A501	S10	2'- 7"	4'- 9"	---											16	5	3'- 11"	R502	STR													
47	5	6'- 11"	1A503	S10	2'- 2"	2'- 7"	2'- 2"											* 33	5	13'- 7"	R503	STR													
▲ 8	5	3'- 8"	1A505.2	STR														* 17	9	10'- 0"	R901	STR													
76	5	5'- 2"	1A501.2	S10	4'- 4"	0'- 10"	---											16	5	5'- 5"	R504	S10	2'- 2"	1'- 1"	2'- 2"										
29	5	6'- 5"	1A502.2	S10	4'- 7"	1'- 10"	---											* 17	7	9'- 0"	R701	S10	5'- 11"	3'- 1"	---										
35	5	4'- 4"	1A504.2	1	0'- 7"	3'- 2"						0'- 7"		0'- 5"				<b>WINGWALL #2</b>																	
9	5	14'- 5"	1A506.2	S10	5'- 11"	2'- 7"	5'- 11"											* 11	5	12'- 1"	2W501	STR													
<b>WINGWALL #1</b>																		<b>ASTM STANDARD REINFORCING BARS</b>																	
* 11	5	8'- 7"	1W501	STR														#3	0.376	0.375	0.11	1.178													
17	5	8'- 6"	1W502	STR														#4	0.668	0.500	0.20	1.571													
* 11	6	8'- 7"	1W601	STR														#5	1.043	0.625	0.31	1.963													
10	5	5'- 11"	1W503	S10	2'- 2"	1'- 7"	2'- 2"											#6	1.502	0.750	0.44	2.356													
10	5	4'- 4"	1W504	27	2'- 2"	2'- 2"	---					1'- 3"	---	1'- 9"	---			#7	2.04	0.875	0.60	2.749													
6	5	10'- 8"	1W505	22	2'- 2"	6'- 4"	2'- 2"					1'- 3"	1'- 3"	1'- 9"	1'- 9"			#8	2.670	1.000	0.79	3.14													
* 11	6	7'- 4"	1W602	27	2'- 2"	5'- 2"						2'- 1"	---	0'- 9"	---			#9	3.400	1.13	1.00	3.54													
<b>WINGWALL #2</b>																		#10	4.3	1.270	1.27	3.990													
* 11	5	12'- 1"	2W501	STR														#11	5.31	1.410	1.56	4.430													
▲ 23	5	8'- 3"	2W502	STR														#14	7.65	1.69	2.25	5.32													
* 11	6	12'- 1"	2W601	STR														#18	13.60	2.26	4.00	7.09													
13	5	5'- 11"	2W503	S10	2'- 2"	1'- 7"	2'- 2"																												
10	5	4'- 4"	2W504	22	2'- 2"	2'- 2"	---																												
6	5	13'- 8"	2W505	22	2'- 2"	9'- 4"	2'- 2"																												
* 11	6	7'- 7"	2W602	22	2'- 2"	5'- 5"	0'- 0"																												

~ NOTES ~

- UNLESS OTHERWISE DESIGNATED, ALL BAR REINFORCEMENT FOR CONCRETE IN SIZES UP TO AND INCLUDING NO. 18 SHALL CONFORM TO THE REQUIREMENTS OF THE "SPECIFICATIONS FOR DEFORMED BILLET-STEEL BARS FOR CONCRETE REINFORCEMENT", AASHTO M 31 (ASTM A 615-S1). ALL BARS SHALL BE GRADE 60, UNLESS OTHERWISE DESIGNATED.
- FOR TYPICAL BENDING DETAILS, RECOMMENDED PIN DIAMETER "D" OF BENDS AND HOOKS, AND OTHER STANDARD PRACTICE, SEE CURRENT CONCRETE REINFORCING STEEL INSTITUTE "MANUAL OF STANDARD PRACTICE".
- BARS WHICH REQUIRE MORE ACCURATE BENDING THAN STANDARD PRACTICES SHOULD HAVE LIMITS INDICATED.
- ALL DIMENSIONS ARE OUT TO OUT OF BAR EXCEPT "A" AND "G" ON STANDARD 180 DEGREE AND 135 DEGREE HOOKS.
- "J" DIMENSION ON 180 DEGREE HOOKS TO BE SHOWN ONLY WHERE NECESSARY TO RESTRICT HOOK SIZE. OTHERWISE, STANDARD HOOKS ARE TO BE USED.
- "H" DIMENSION ON STIRRUPS TO BE SHOWN ONLY WHEN NECESSARY TO MAINTAIN CLEARANCES.
- WHERE SLOPE DIFFERS FROM 45 DEGREES, DIMENSIONS "H" AND "K" MUST BE SHOWN.
- ▲ DENOTES BARS TO BE CUT IN FIELD.
- * DENOTES ONE EXTRA BAR ADDED FOR TESTING PURPOSES.
- ▲ DENOTES TWO EXTRA BARS ADDED FOR TESTING PURPOSES.
- E IN BAR MARK PREFIX DENOTES EPOXY COATED REINFORCING STEEL.

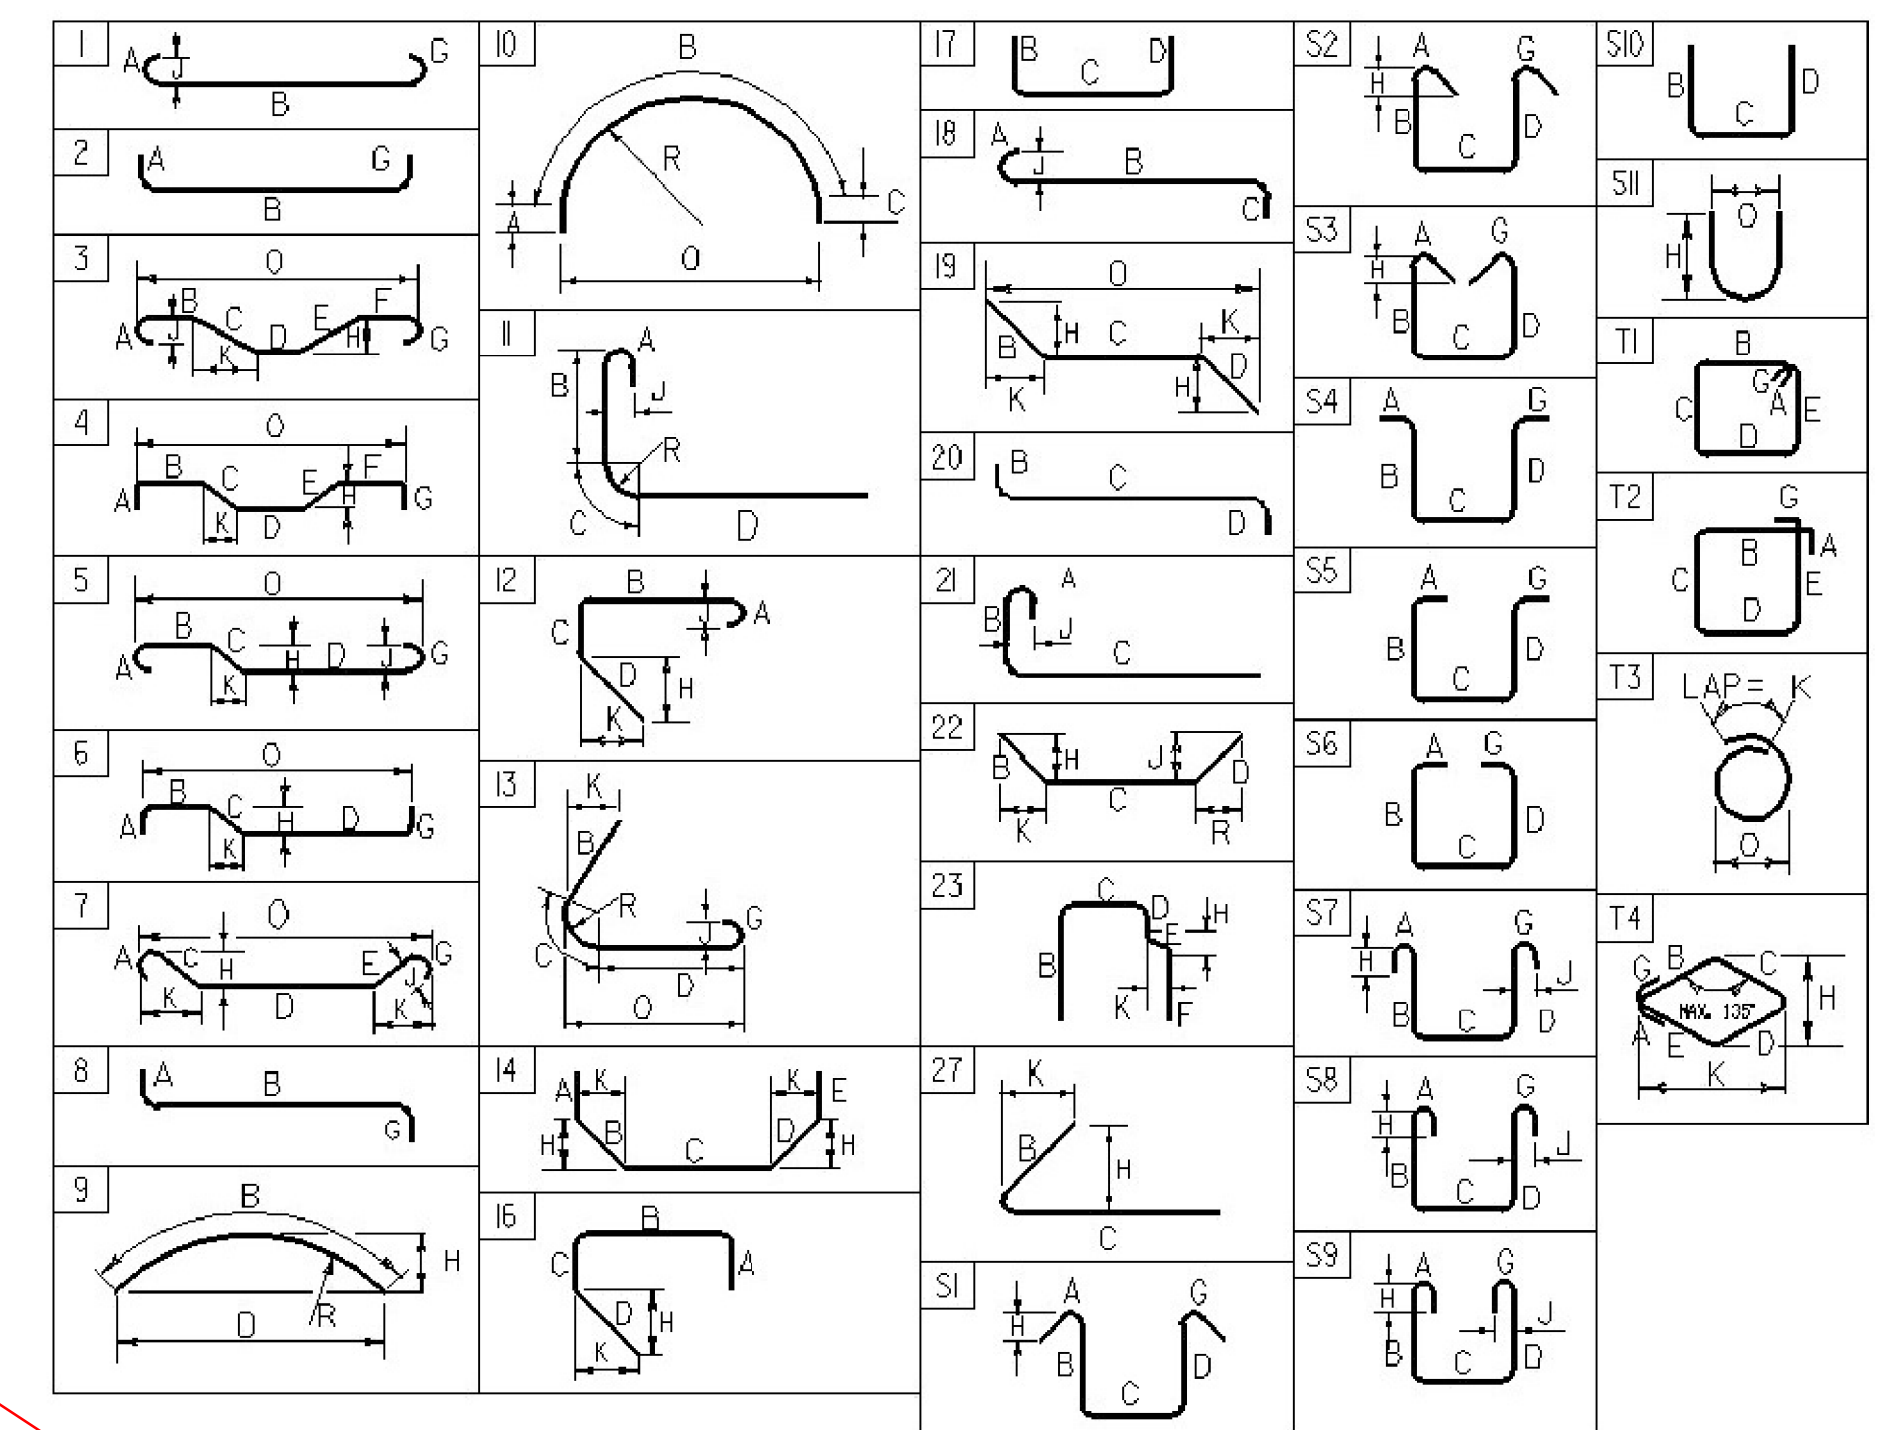

~ REINFORCING STEEL CORROSION RESISTANCE LEVEL ~

THE REINFORCING STEEL MARKS IN THIS SCHEDULE INDICATE THE REQUIRED BAR CORROSION RESISTANCE LEVEL. CORROSION RESISTANCE LEVEL IS DENOTED WITH A .2 FOR LEVEL TWO SUFFIX OR .3 FOR LEVEL THREE SUFFIX. .1 FOR LEVEL ONE IS TO BE OMITTED. THE BAR MATERIAL TYPE AND BAR STEEL GRADE PROVIDED FOR EACH CORROSION LEVEL WILL BE RECORDED ON THE PLAN SET PI SHEET FOR AS-BUILT RECORD PLAN ARCHIVES.

BAR SIZE	AREA	WEIGHT	RESISTANCE	RESISTANCE
#3	0.376	0.375	0.11	1.178
#4	0.668	0.500	0.20	1.571
#5	1.043	0.625	0.31	1.963
#6	1.502	0.750	0.44	2.356
#7	2.04	0.875	0.60	2.749
#8	2.670	1.000	0.79	3.14
#9	3.400	1.13	1.00	3.54
#10	4.3	1.270	1.27	3.990
#11	5.31	1.410	1.56	4.430
#14	7.65	1.69	2.25	5.32
#18	13.60	2.26	4.00	7.09

SEE REVISION: OCT-28-2014

PROJECT NAME: **JOHNSON**  
PROJECT NUMBER: **BRF 030-2(26)**

FILE NAME: s88b193rss.xls  
PROJECT MANAGER: C. CARLSON  
DESIGNED BY: H. SALLS  
REINFORCING STEEL SCHEDULE


PLOT DATE: **10-JUN-2014**  
DRAWN BY: **G. ROKES**  
CHECKED BY: **H. SALLS**  
SHEET **38** OF **69**

# REINFORCING STEEL SCHEDULE

ITEM	EACH	SIZE	LENGTH	MARK	TYPE	A	B	C	D	E	F	G	H	J	K	R	O	ITEM	EACH	SIZE	LENGTH	MARK	TYPE	A	B	C	D	E	F	G	H	J	K	R	O
<b>CONCRETE DECK OVERLAY</b>																		<b>ABUTMENT # 2</b>																	
*	181	5	21'- 4"	S501.2	STR													*	▲	7	5	5'- 1"	2A504	STR											
*	157	5	37'- 1"	S502.2	STR																														
*	61	6	21'- 7"	S601.2	STR													139	5	7'- 4"	2A501	S10	4'- 9"	2'- 7"	---										
*	63	6	6'- 0"	S602.2	STR													47	5	6'- 11"	2A503	S10	2'- 2"	2'- 7"	2'- 2"										
▲	▲	234	7	5'- 4"	S701.2	STR																													
TOTAL ~ 841.65 LBS LEVEL I FOR WINGWALLS																		TOTAL LEVEL I 2,030.63 LBS																	
TOTAL ~ 16,239.26 LBS LEVEL II																		TOTAL LEVEL II 759.39 LBS																	
<b>APPROACH SLAB #1</b>																		<b>WINGWALL # 3</b>																	
*	47	5	17'- 11"	1A501	STR													*	11	5	7'- 1"	3W501	STR												
*	40	9	20'- 9"	1A501	I	---	19'- 6"											13	5	8'- 7"	3W502	STR													
TOTAL ~ 3,611.00 LBS																		TOTAL LEVEL I 2,029.63 LBS																	
<b>APPROACH SLAB #2</b>																		<b>WINGWALL #4</b>																	
*	47	5	17'- 11"	2A501	STR													*	11	6	7'- 1"	3W601	STR												
*	40	9	20'- 9"	2A501	1	---	19'- 6"											8	5	5'- 11"	3W503	S10	2'- 2"	1'- 7"	2'- 2"										
TOTAL ~ 3,611.00 LBS																		TOTAL LEVEL II 756.26 LBS																	
<b>ABUTMENT # 1</b>																		<b>RETAINING WALL</b>																	
*	▲	7	5	5'- 0"	1A504	STR												45	5	14'- 6"	R501	STR													
139	5	7'- 4"	1A501	S10	4'- 9"	2'- 7"	---											16	5	3'- 11"	R502	STR													
47	5	6'- 11"	1A503	S10	2'- 2"	2'- 7"	2'- 2"											33	5	13'- 7"	R503	STR													
TOTAL LEVEL I 2,029.63 LBS																		TOTAL 2,128.77 LBS																	
16	5	23'- 10"	1A503.2	STR														*	17	9	10'- 0"	R901	STR												
▲	8	5	3'- 8"	1A505.2	STR													16	5	5'- 5"	R504	S10	2'- 2"	1'- 1"	2'- 2"										
76	5	5'- 4"	1A501.2	S10	4'- 6"	0'- 10"	---											*	17	7	9'- 0"	R701	S10	5'- 11"	3'- 1"	---									
29	5	6'- 6"	1A502.2	S10	4'- 8"	1'- 10"	---											TOTAL 830.26 LBS																	
35	5	4'- 4"	2A504.2	S10	0'- 7"	3'- 2"	---											<b>WINGWALL #1</b>																	
9	5	14'- 7"	1A506.2	S10	6'- 0"	2'- 7"	6'- 0"											*	11	5	8'- 7"	1W501	STR												
TOTAL LEVEL II 756.26 LBS																		<b>WINGWALL #2</b>																	
<b>WINGWALL #1</b>																		<b>WINGWALL #2</b>																	
*	11	5	8'- 7"	1W501	STR													*	11	5	12'- 1"	2W501	STR												
17	5	8'- 6"	1W502	STR														▲	23	5	8'- 3"	2W502	STR												
*	11	6	8'- 7"	1W601	STR													*	11	6	12'- 1"	2W601	STR												
10	5	5'- 11"	1W503	S10	2'- 2"	1'- 7"	2'- 2"											13	5	5'- 11"	2W503	S10	2'- 2"	1'- 7"	2'- 2"										
10	5	4'- 4"	1W504	27	2'- 2"	2'- 2"	---											10	5	4'- 4"	2W504	22	2'- 2"	2'- 2"	---										
6	5	10'- 8"	1W505	22	2'- 2"	6'- 4"	2'- 2"											6	5	13'- 8"	2W505	22	2'- 2"	9'- 4"	2'- 2"										
*	11	6	7'- 4"	1W602	27	2'- 2"	5'- 2"											*	11	6	7'- 7"	2W602	22	2'- 2"	5'- 5"	0'- 0"									
TOTAL 652.96 LBS																		TOTAL 2,128.77 LBS																	
<b>WINGWALL #2</b>																		<b>WINGWALL #3</b>																	
*	11	5	12'- 1"	2W501	STR													14	5	10'- 0"	2W504	22	2'- 2"	6'- 4"	2'- 2"										
▲	23	5	8'- 3"	2W502	STR													15	5	10'- 8"	2W505	22	2'- 2"	9'- 4"	2'- 2"										
*	11	6	12'- 1"	2W601	STR													16	5	5'- 5"	R504	S10	2'- 2"	1'- 1"	2'- 2"										
13	5	5'- 11"	2W503	S10	2'- 2"	1'- 7"	2'- 2"											17	7	9'- 0"	R701	S10	5'- 11"	3'- 1"	---										
10	5	4'- 4"	2W504	22	2'- 2"	2'- 2"	---											TOTAL 830.26 LBS																	
6	5	13'- 8"	2W505	22	2'- 2"	9'- 4"	2'- 2"											<b>WINGWALL #4</b>																	
*	11	6	7'- 7"	2W602	22	2'- 2"	5'- 5"	0'- 0"										*	11	5	6'- 7"	4W501	STR												
TOTAL 830.26 LBS																		<b>RETAINING WALL</b>																	
<b>WINGWALL #4</b>																		<b>RETAINING WALL</b>																	
11	5	8'- 7"	1W501	STR														45	5	14'- 6"	R501	STR													
17	5	8'- 6"	1W502	STR														16	5	3'- 11"	R502	STR													
*	11	6	8'- 7"	1W601	STR													33	5	13'- 7"	R503	STR													
10	5	5'- 11"	1W503	S10	2'- 2"	1'- 7"	2'- 2"											*	17	9	10'- 0"	R901	STR												
10	5	4'- 4"	1W504	27	2'- 2"	2'- 2"	---											16	5	5'- 5"	R504	S10	2'- 2"	1'- 1"	2'- 2"										
6	5	10'- 8"	1W505	22	2'- 2"	6'- 4"	2'- 2"											*	17	7	9'- 0"	R701	S10	5'- 11"	3'- 1"	---									
*	11	6	7'- 4"	1W602	27	2'- 2"	5'- 2"											TOTAL 2,128.77 LBS																	
TOTAL 652.96 LBS																		<b>WINGWALL #4</b>																	
<b>WINGWALL #2</b>																		<b>WINGWALL #4</b>																	
*	11	5	12'- 1"	2W501	STR													11	5	6'- 7"	4W501	STR													
▲	23	5	8'- 3"	2W502	STR													13	5	8'- 3"	4W502	STR													
*	11	6	12'- 1"	2W601	STR													8	5	5'- 11"	4W503	S10	2'- 2"	1'- 7"	2'- 2"										
13	5	5'- 11"	2W503	S10	2'- 2"	1'- 7"	2'- 2"											10	5	4'- 4"	4W504	27	2'- 2"	2'- 2"	---										
10	5	4'- 4"	2W504	22	2'- 2"	2'- 2"	---											▲	6	5	10'- 8"	4W505	22	2'- 2"	9'- 4"	2'- 2"									
6	5	13'- 8"	2W505	22	2'- 2"	9'- 4"	2'- 2"											*	11	6	7'- 4"	4W602	27	2'- 2"	5'- 2"										
*	11	6	7'- 7"	2W602	22	2'- 2"	5'- 5"	0'- 0"										TOTAL 2,128.77 LBS																	
TOTAL 830.26 LBS																		<b>RETAINING WALL</b>																	
<b>WINGWALL #4</b>																		<b>RETAINING WALL</b>																	
11	5	8'- 7"	1W501	STR														45	5	14'- 6"	R501	STR													
17	5	8'- 6"	1W502	STR														16	5	3'- 11"	R502	STR													
*	11	6	8'- 7"	1W601	STR													33	5	13'- 7"	R503	STR													
10	5	5'- 11"	1W503	S10	2'- 2"	1'- 7"	2'- 2"											*	17	9	10'- 0"	R901	STR												
10	5	4'- 4"	1W504	27	2'- 2"	2'- 2"	---											16	5	5'- 5"	R504	S10	2'- 2"	1'- 1"	2'- 2"										
6	5	10'- 8"	1W505	22	2'- 2"	6'- 4"	2'- 2"											*	17	7	9'- 0"	R701	S10	5'- 11"	3'- 1"	---									
*	11	6	7'- 4"	1W602	27	2'- 2"	5'- 2"											TOTAL 2,128.77 LBS																	
TOTAL 652.96 LBS																		<b>WINGWALL #4</b>																	


~ NOTES ~

- UNLESS OTHERWISE DESIGNATED, ALL BAR REINFORCEMENT FOR CONCRETE IN SIZES UP TO AND INCLUDING NO. 18 SHALL CONFORM TO THE REQUIREMENTS OF THE "SPECIFICATIONS FOR DEFORMED BILLET-STEEL BARS FOR CONCRETE REINFORCEMENT", AASHTO M31 (ASTM A 615-S1). ALL BARS SHALL BE GRADE 60, UNLESS OTHERWISE DESIGNATED.
- FOR TYPICAL BENDING DETAILS, RECOMMENDED PIN DIAMETER "D" OF BENDS AND HOOKS, AND OTHER STANDARD PRACTICE, SEE CURRENT CONCRETE REINFORCING STEEL INSTITUTE "MANUAL OF STANDARD PRACTICE".
- BARS WHICH REQUIRE MORE ACCURATE BENDING THAN STANDARD PRACTICES SHOULD HAVE LIMITS INDICATED.
- ALL DIMENSIONS ARE OUT TO OUT OF BAR EXCEPT "A" AND "G" ON STANDARD 180 DEGREE AND 135 DEGREE HOOKS.
- "J" DIMENSION ON 180 DEGREE HOOKS TO BE SHOWN ONLY WHERE NECESSARY TO RESTRICT HOOK SIZE. OTHERWISE, STANDARD HOOKS ARE TO BE USED.
- "H" DIMENSION ON STIRRUPS TO BE SHOWN ONLY WHEN NECESSARY TO MAINTAIN CLEARANCES.
- WHERE SLOPE DIFFERS FROM 45 DEGREES, DIMENSIONS "H" AND "K" MUST BE SHOWN.
- ▲ DENOTES BARS TO BE CUT IN FIELD.
- * DENOTES ONE EXTRA BAR ADDED FOR TESTING PURPOSES.
- △ DENOTES TWO EXTRA BARS ADDED FOR TESTING PURPOSES.
- E IN BAR MARK PREFIX DENOTES EPOXY COATED REINFORCING STEEL.

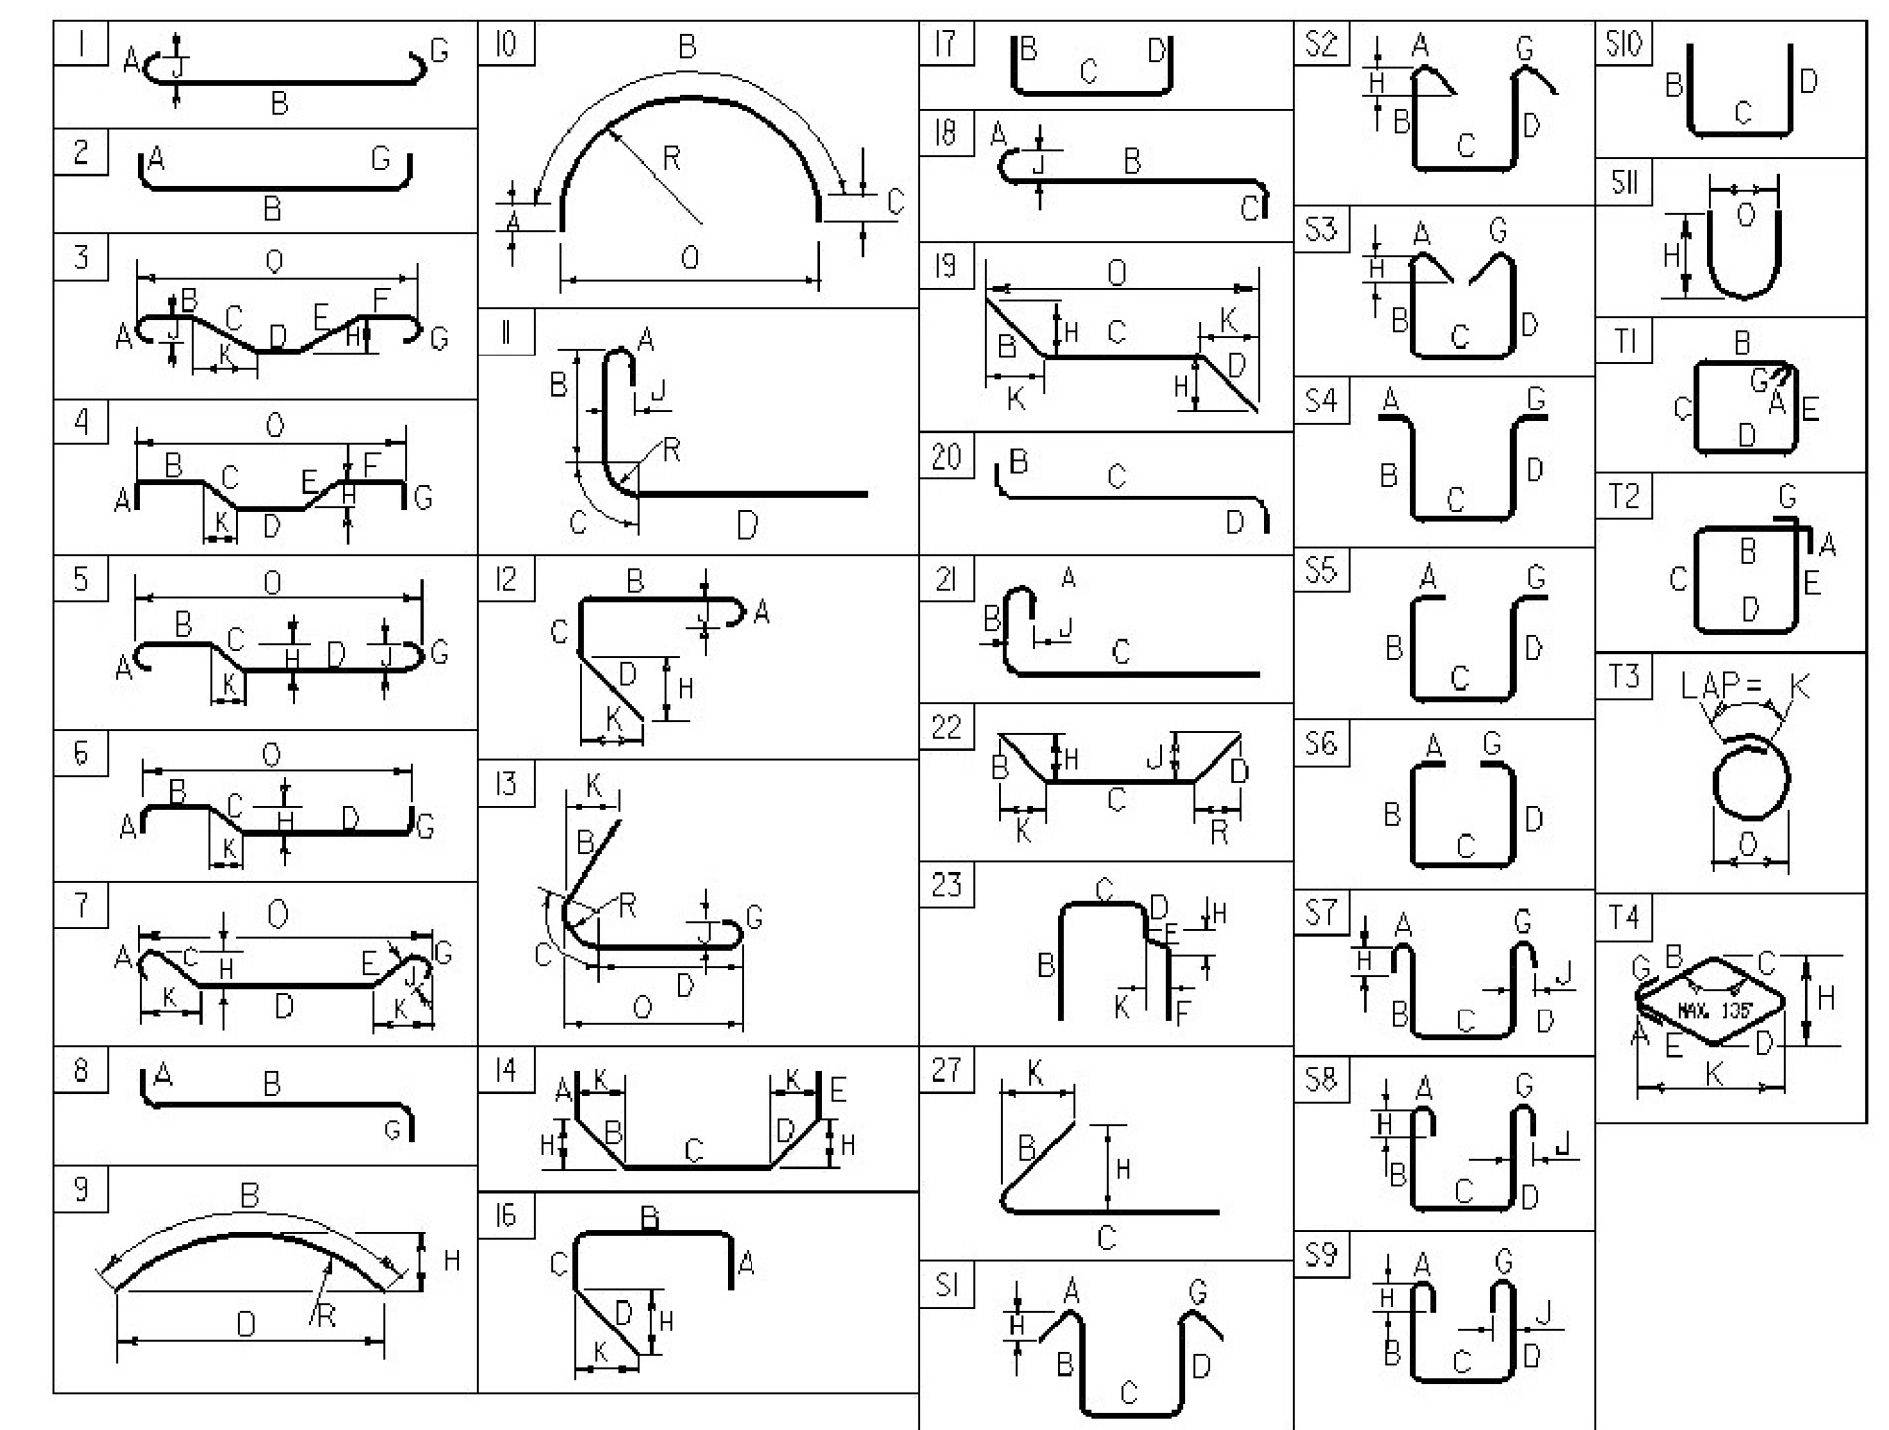


ASTM STANDARD REINFORCING BARS

BAR SIZE	YIELD STRENGTH (ksi)	TENSILE STRENGTH (ksi)	ELONGATION (%)	WELDABILITY
#3	0.376	0.375	0.11	1.178
#4	0.668	0.500	0.20	1.571
#5	1.043	0.625	0.31	1.963
#6	1.502	0.750	0.44	2.356
#7	2.04	0.875	0.60	2.749
#8	2.670	1.000	0.79	3.14
#9	3.400	1.13	1.00	3.54
#10	4.3	1.270	1.27	3.990
#11	5.31	1.410	1.56	4.4






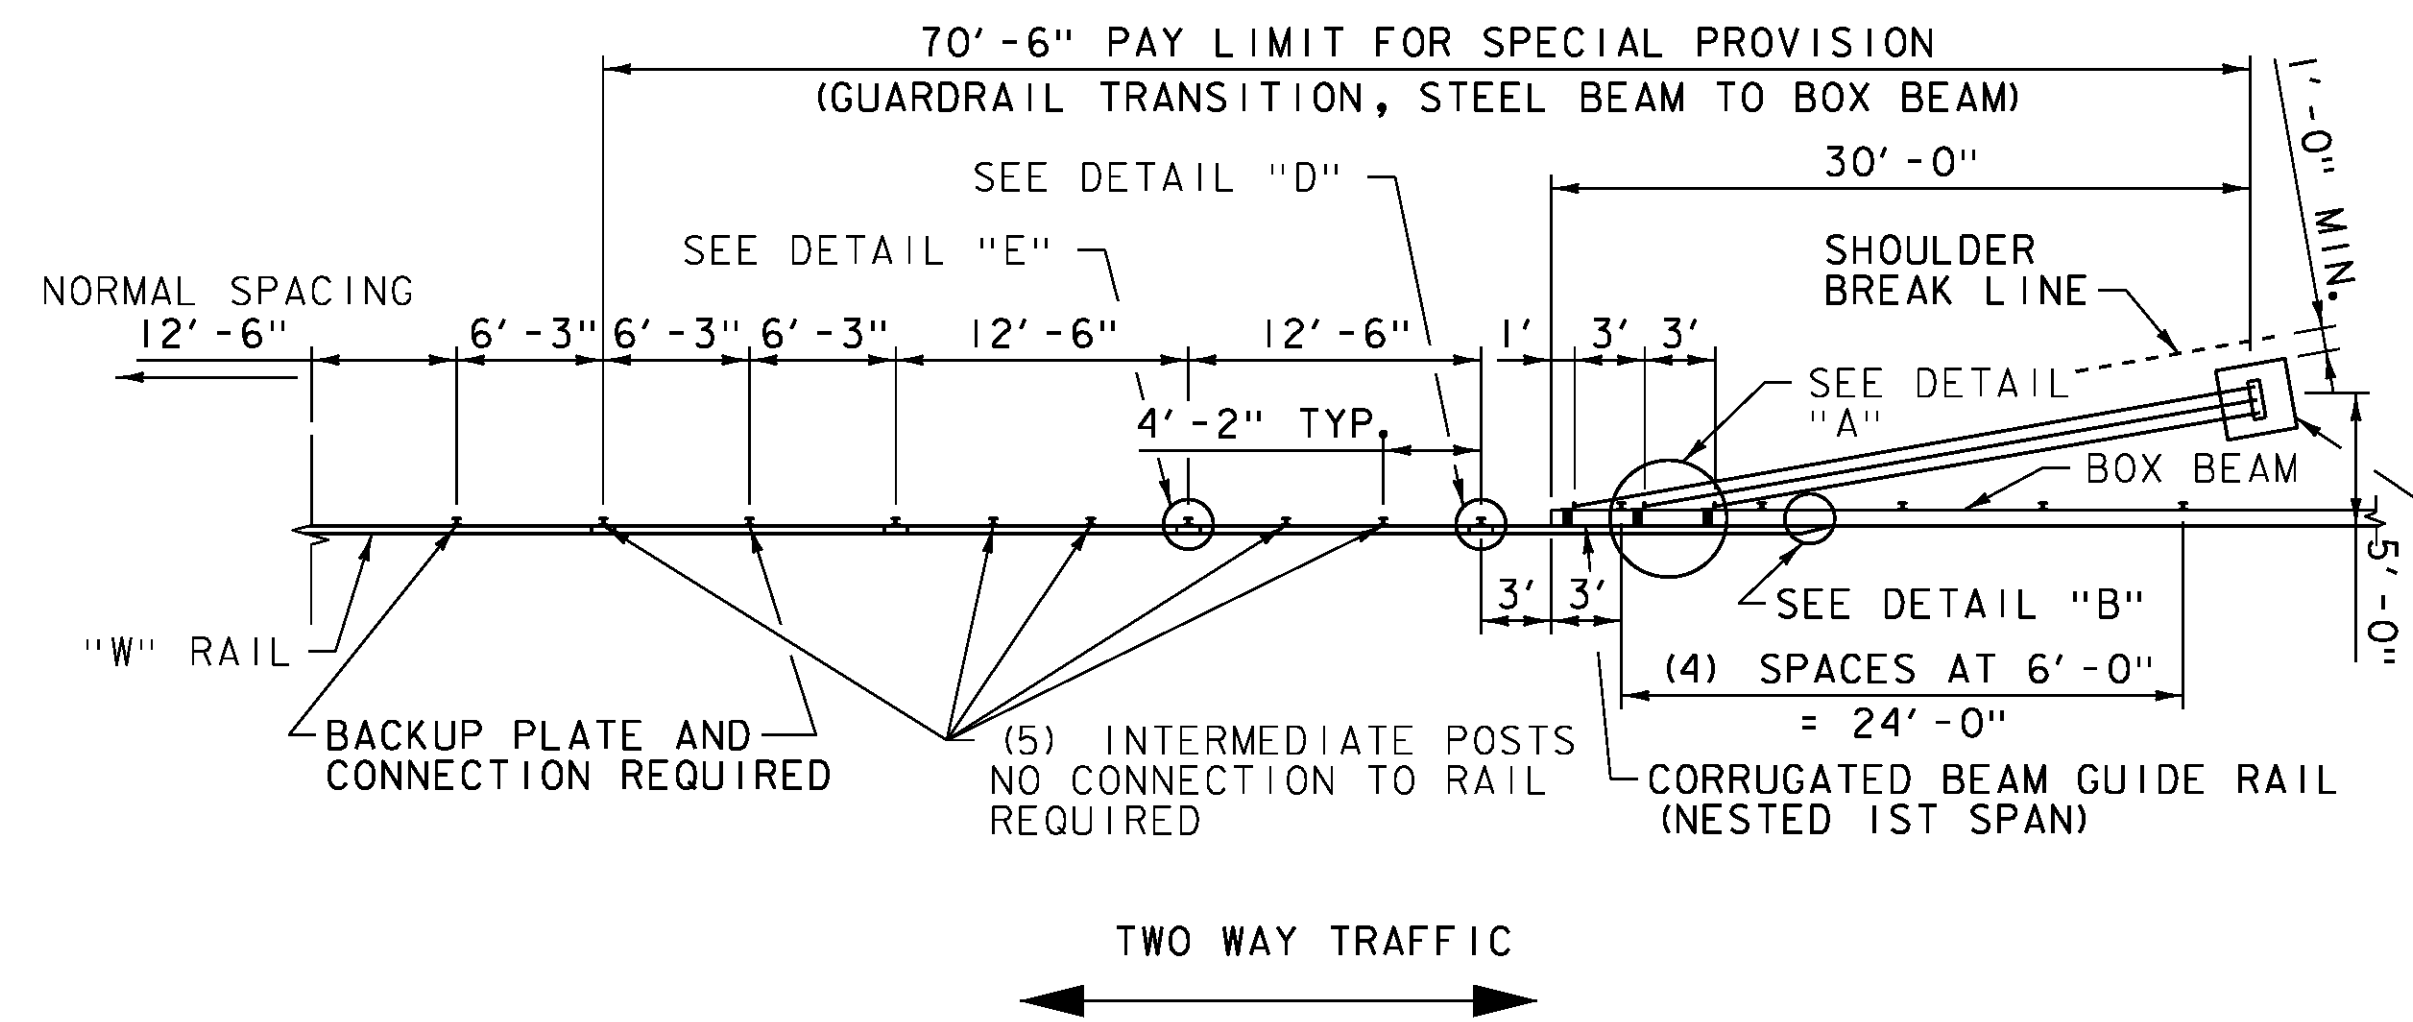


NOTE:  
SEE BRIDGE APPROACH PLANS  
WHEN TRANSITION IS USED  
ADJACENT TO STRUCTURE







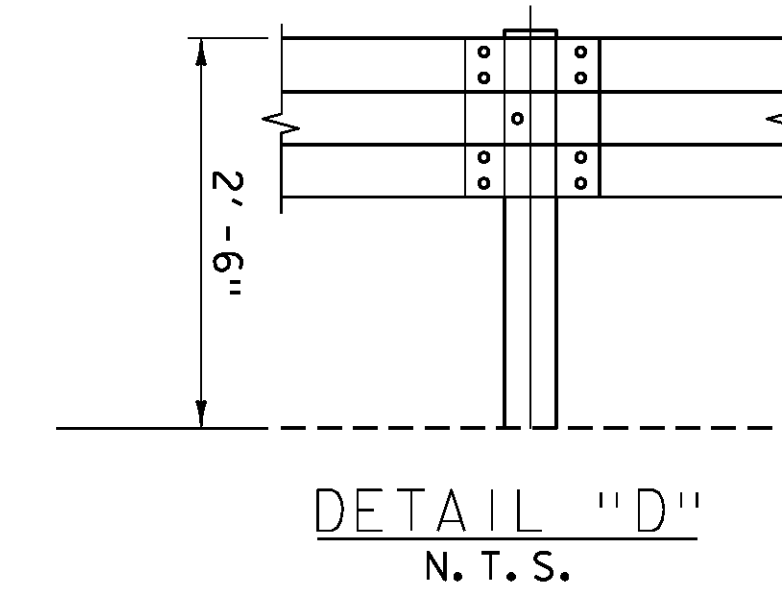


TYPICAL ANCHOR FOR STEEL TO BOX BEAM  
TRANSITION. SEE DETAILS IN "GUARDRAIL  
TRANSITION DETAILS" (2 OF 2).  
SPRING COMPENSATORS ARE NOT REQUIRED AT  
THIS LOCATION.

PLAN  
N. T. S.

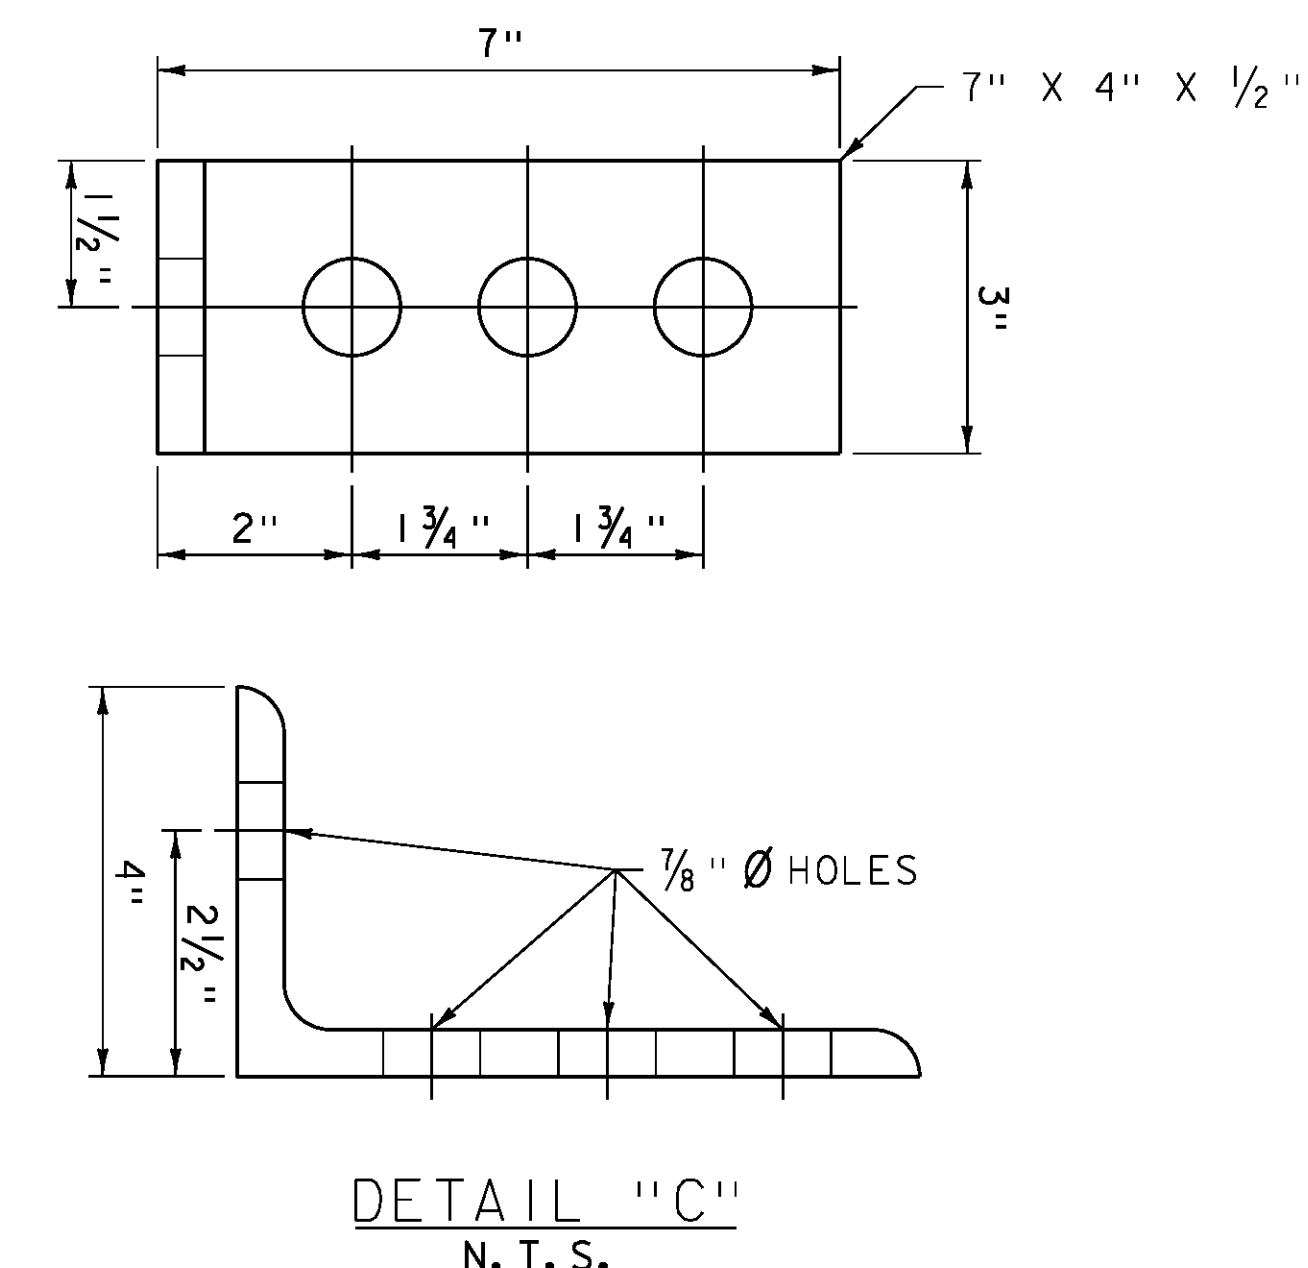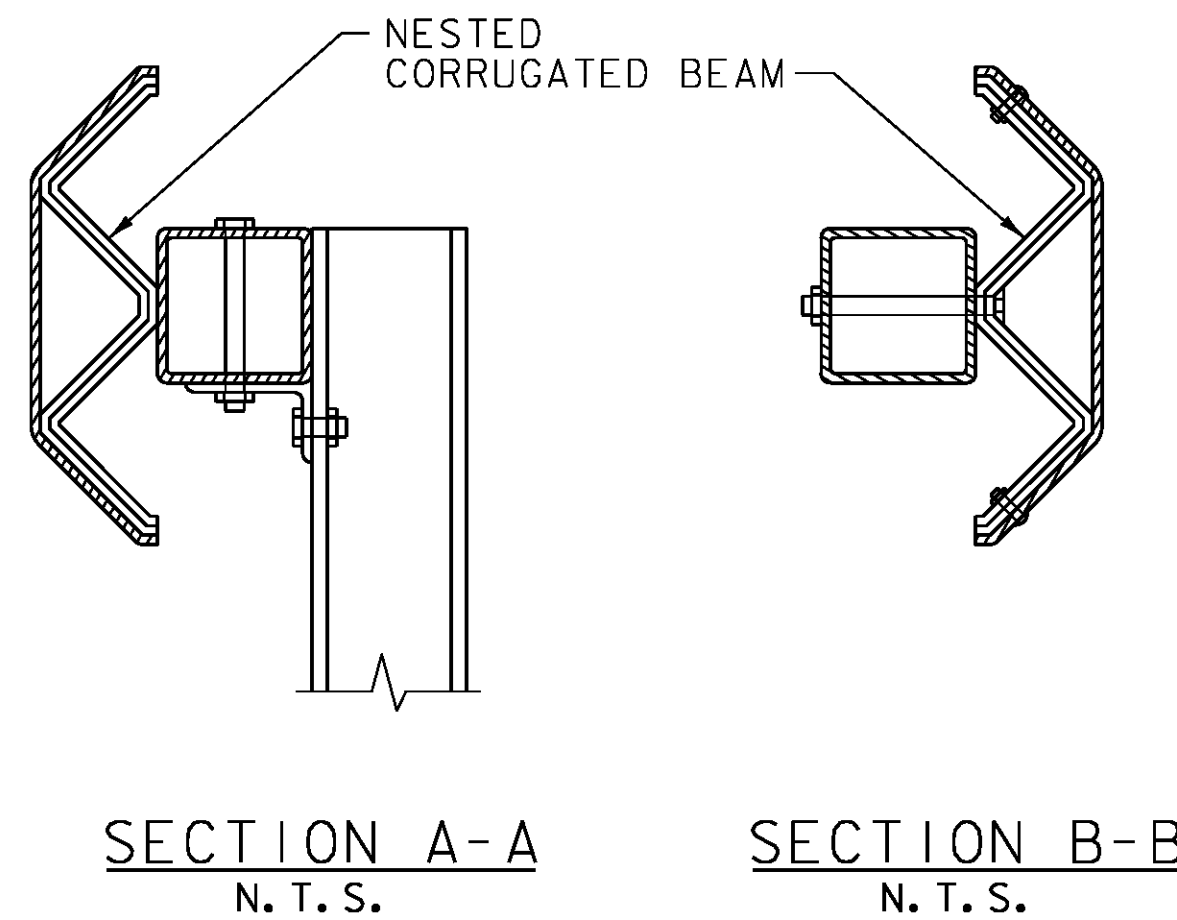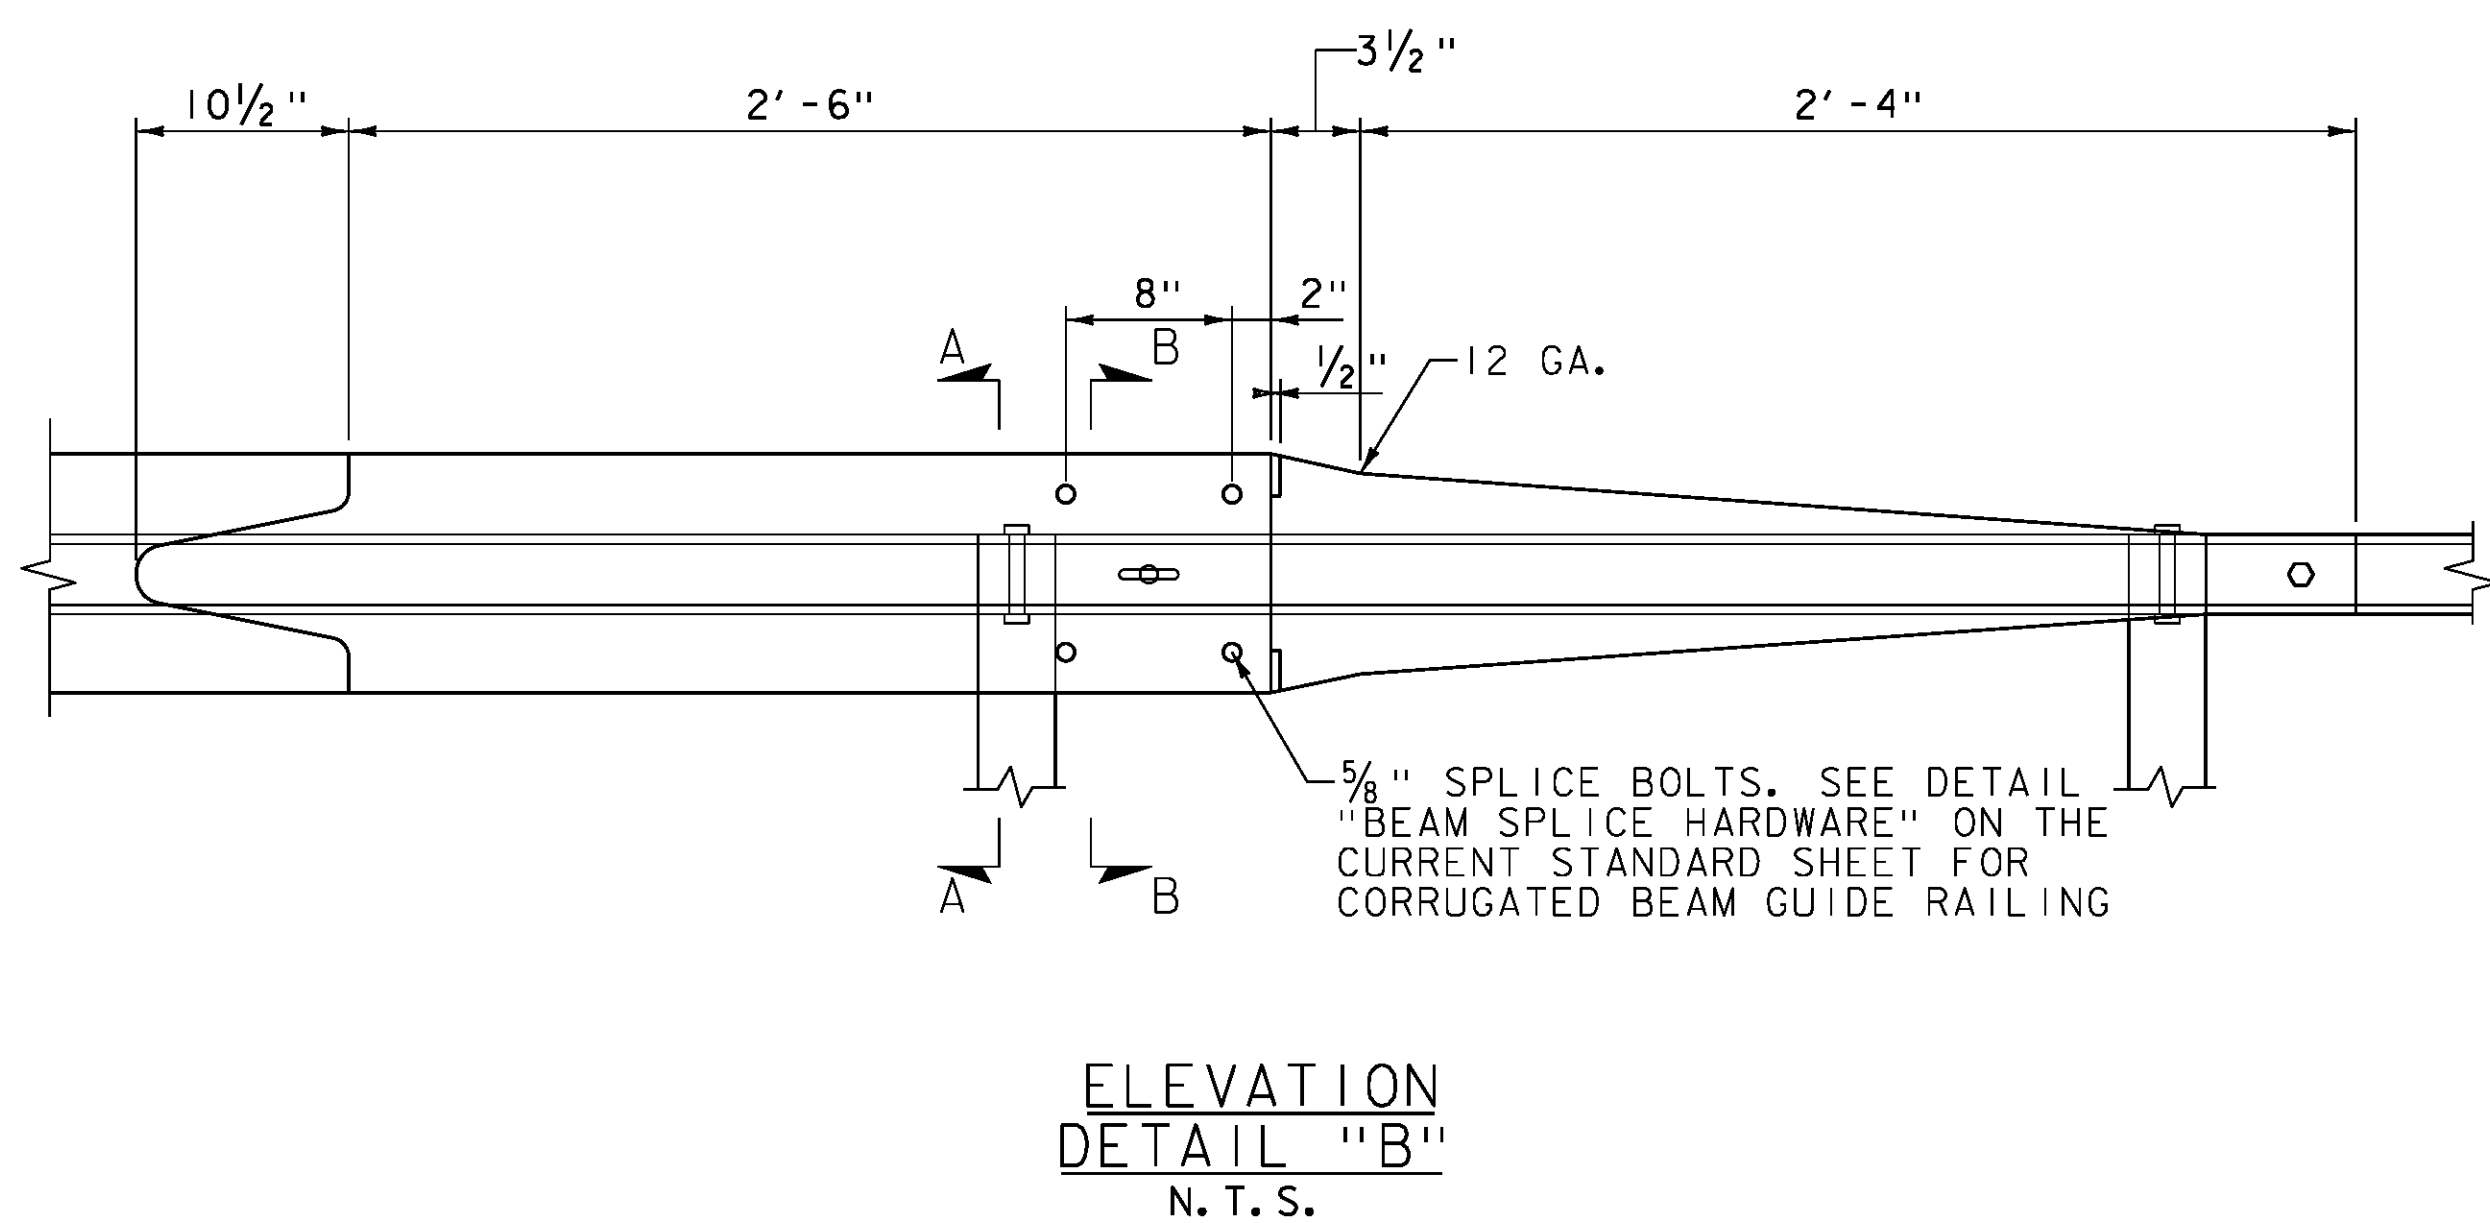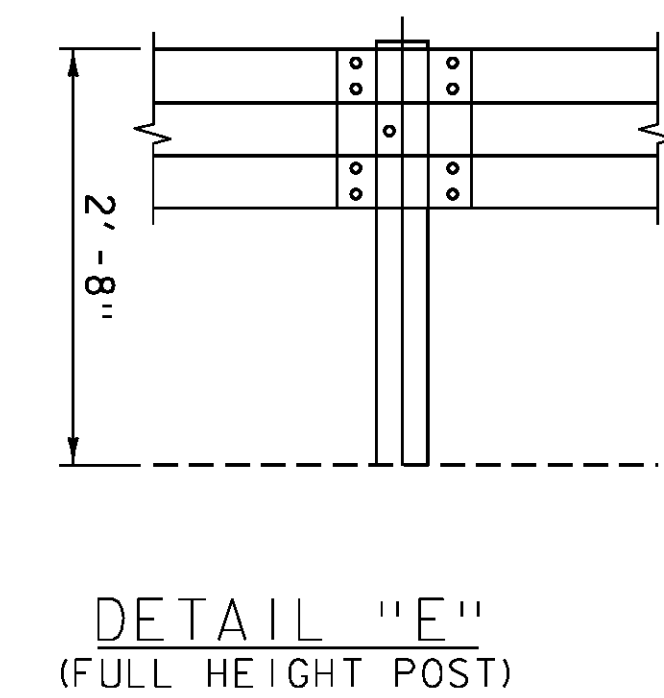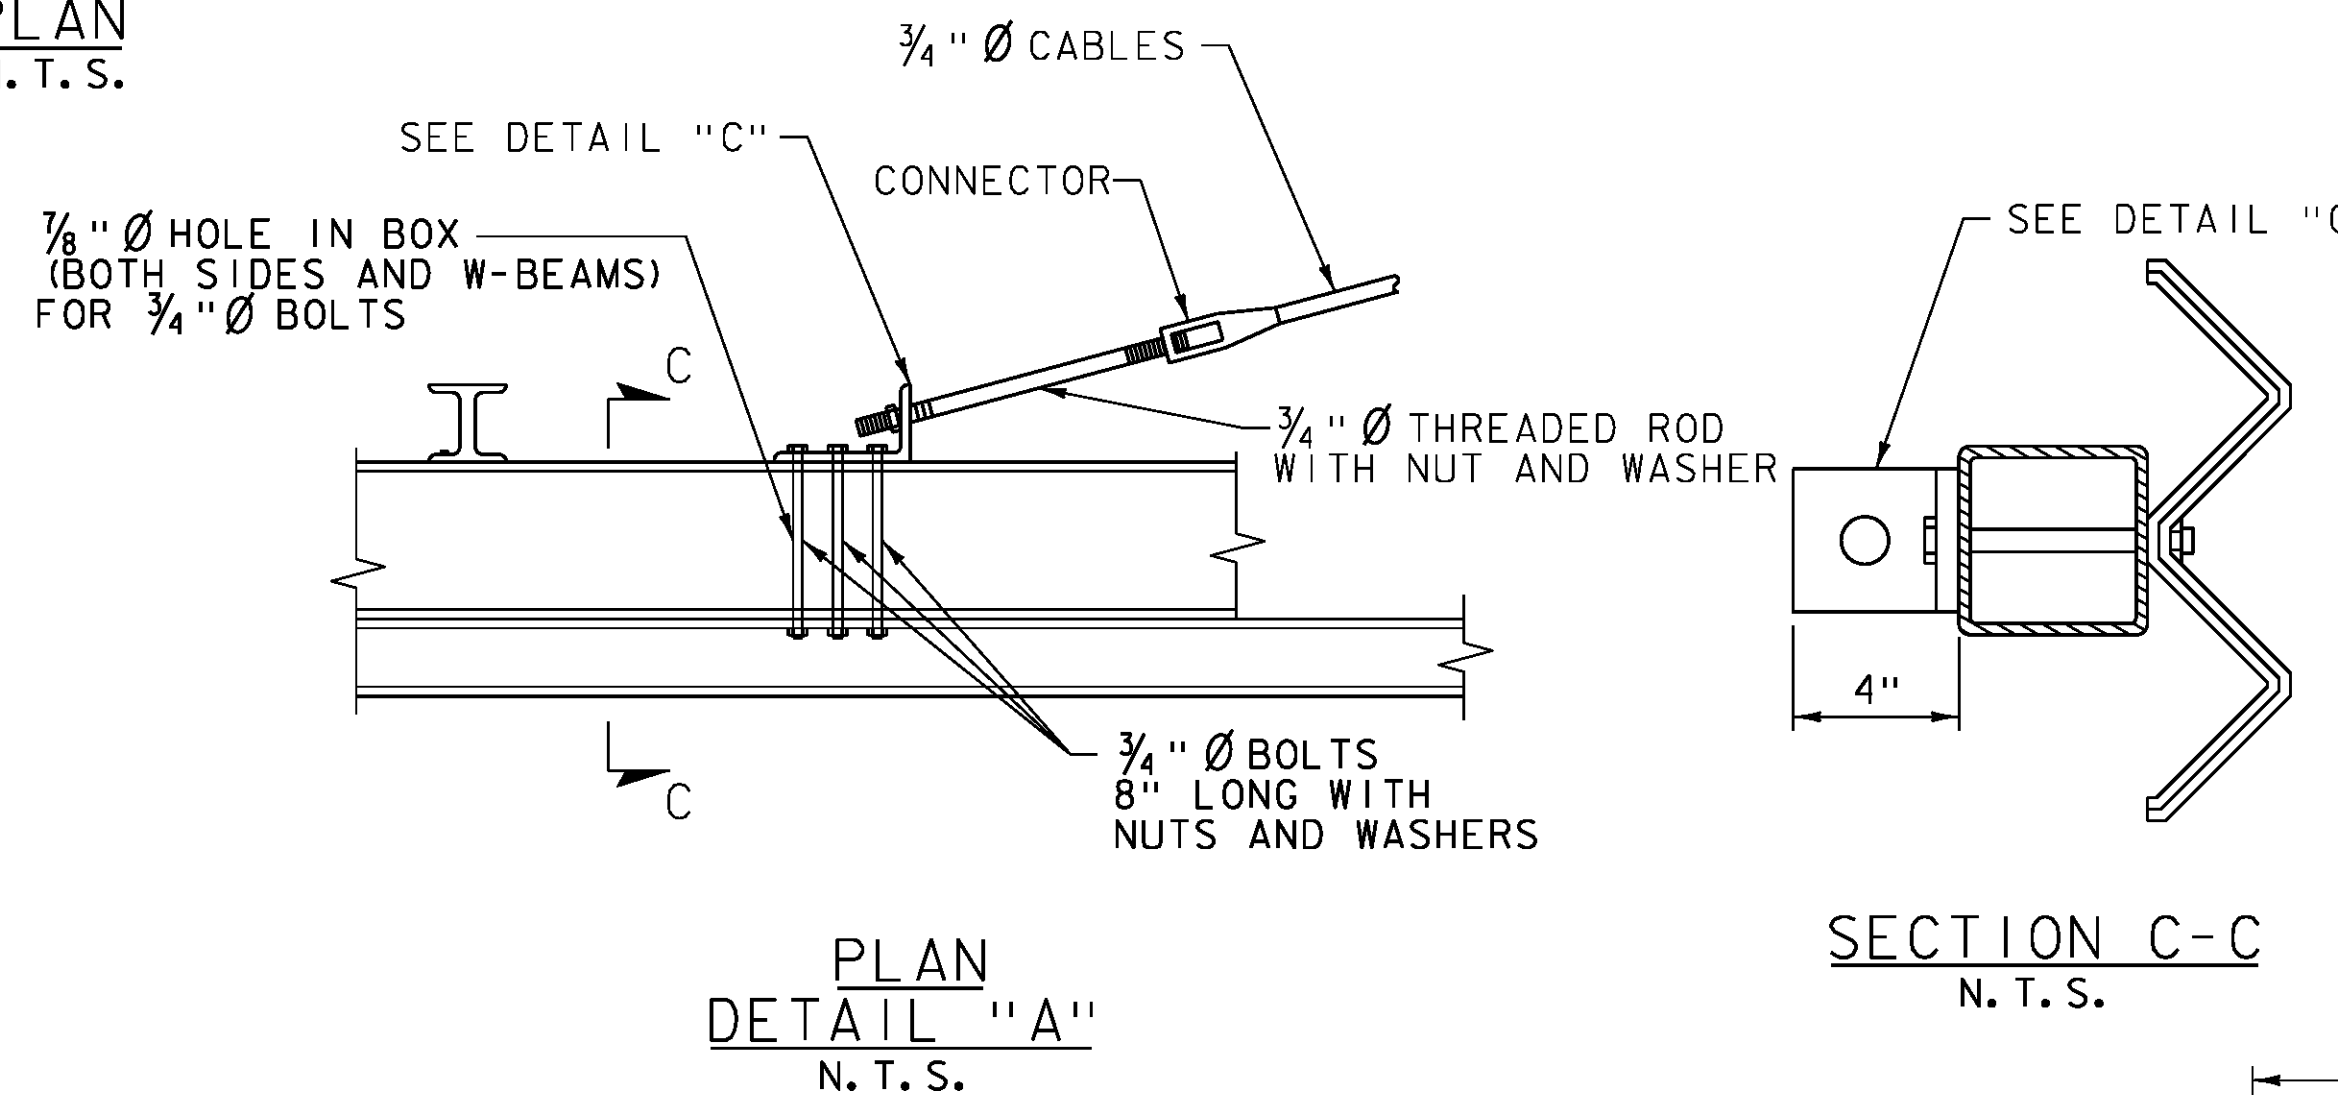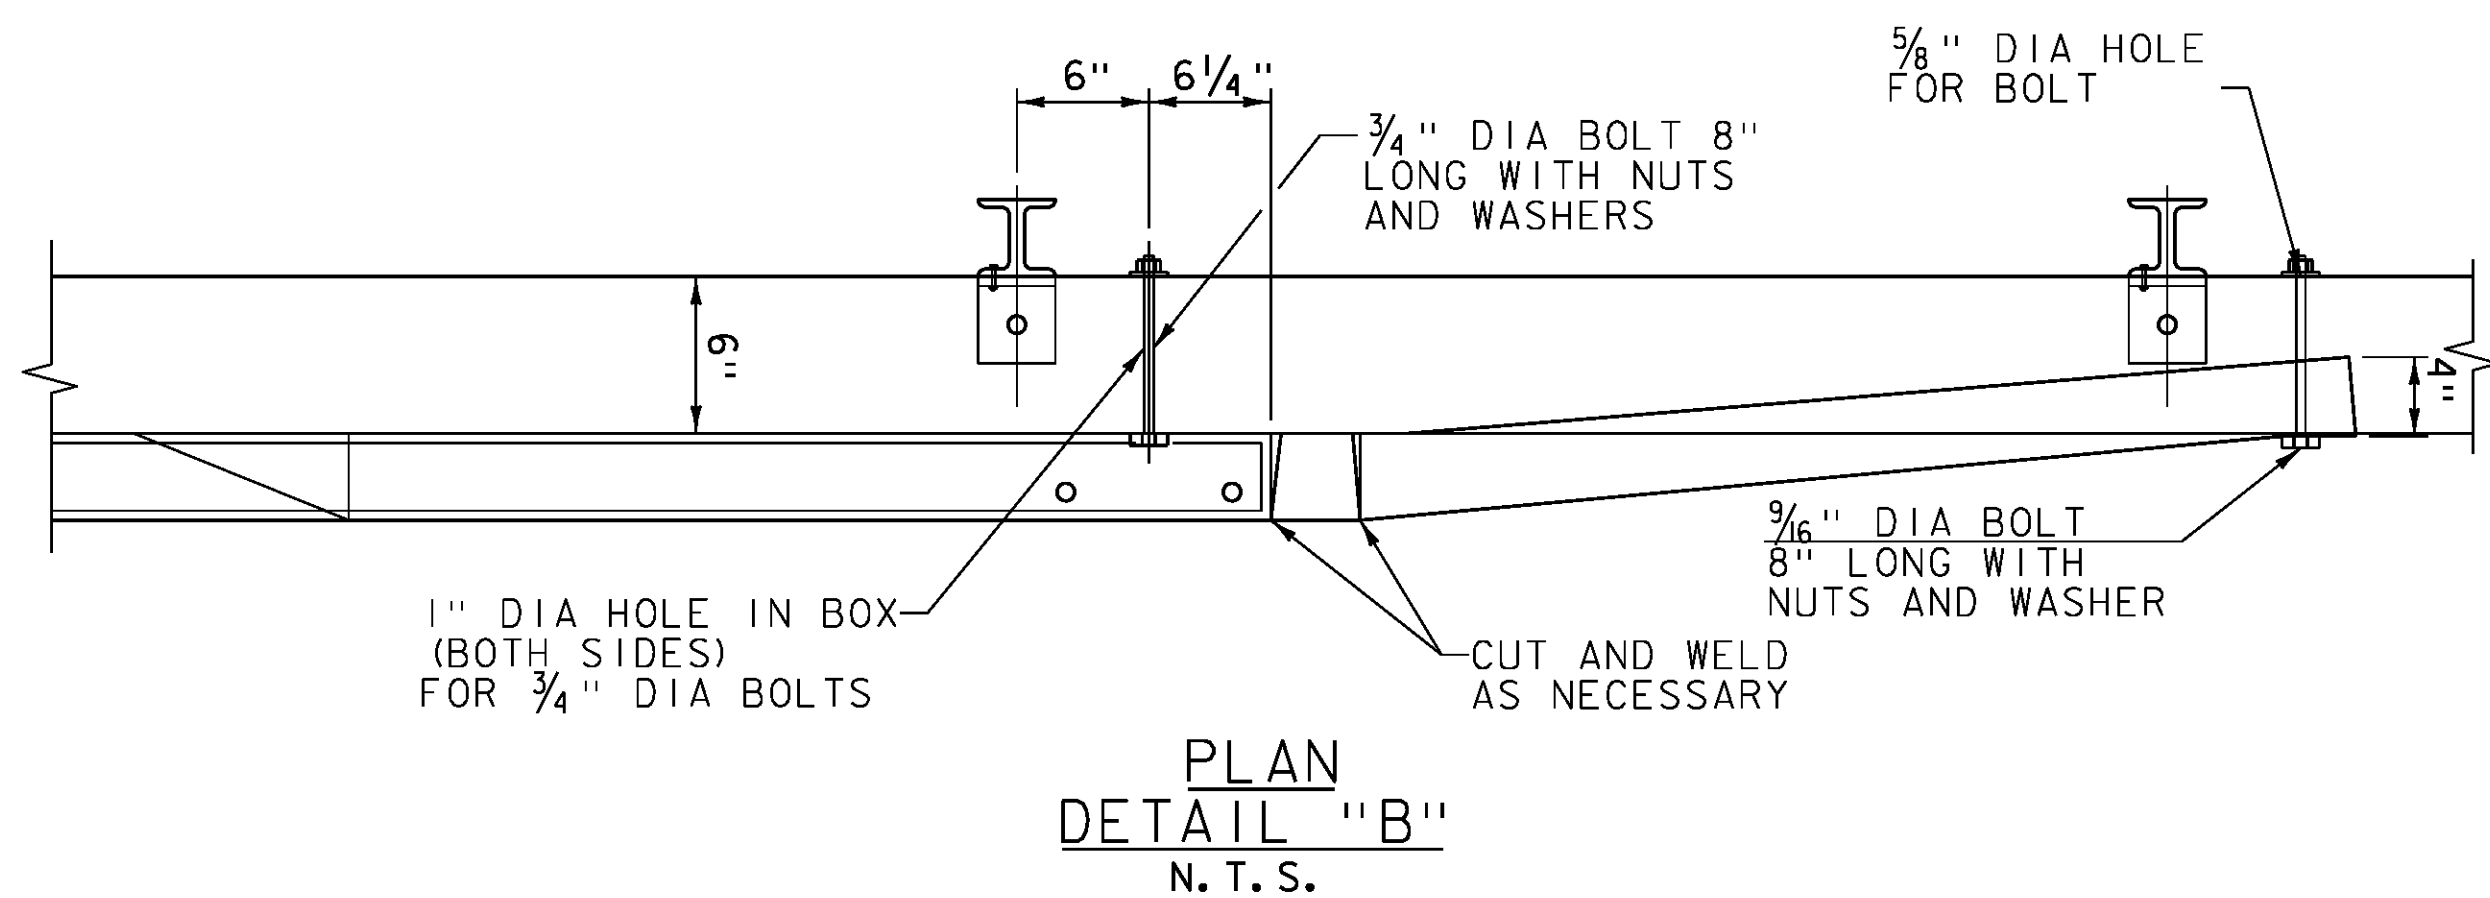

PROJECT NAME:	JOHNSON	PLOT DATE:	10-JUN-2014
BRF 030-2(26):	BRF 030-2(26)	PROJECT LEADER:	C. CARLSON
DESIGNED BY:	H. SALLS	DRAWN BY:	G. ROKES
GUARDRAIL TRANSITION DETAILS (1)		CHECKED BY:	H. SALLS
		SHEET	39 OF 69

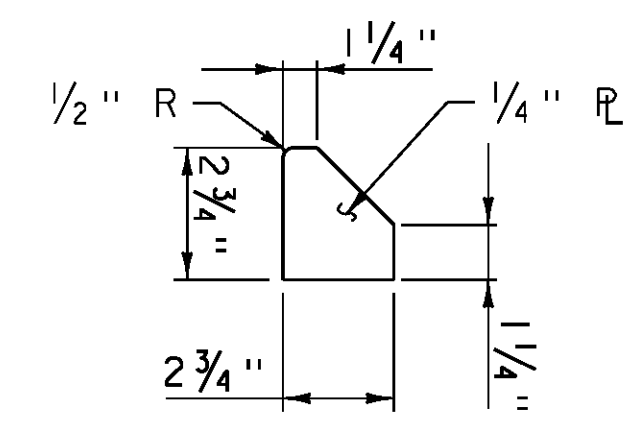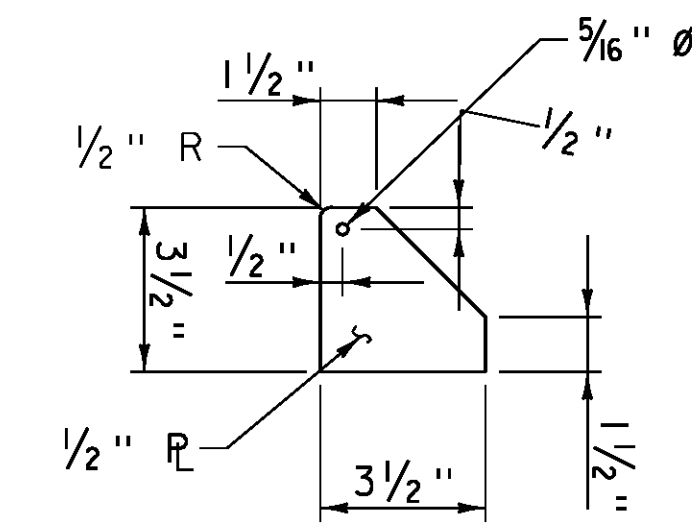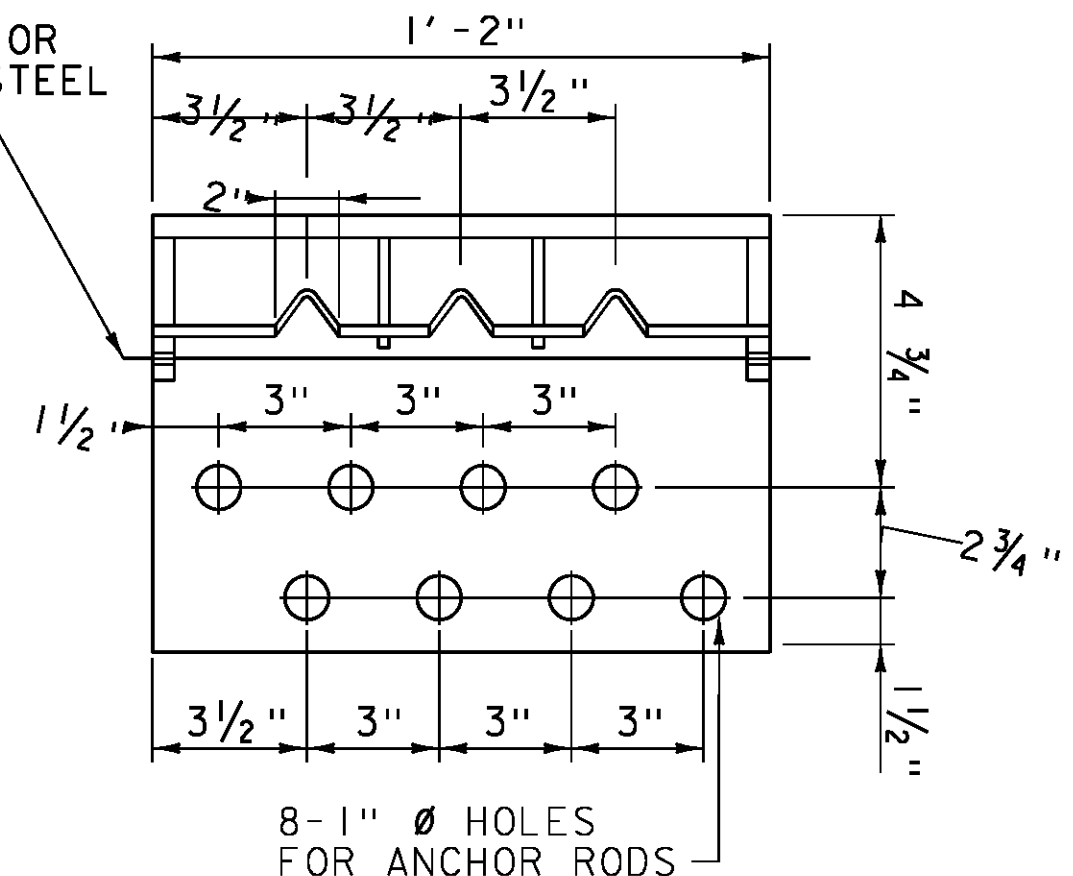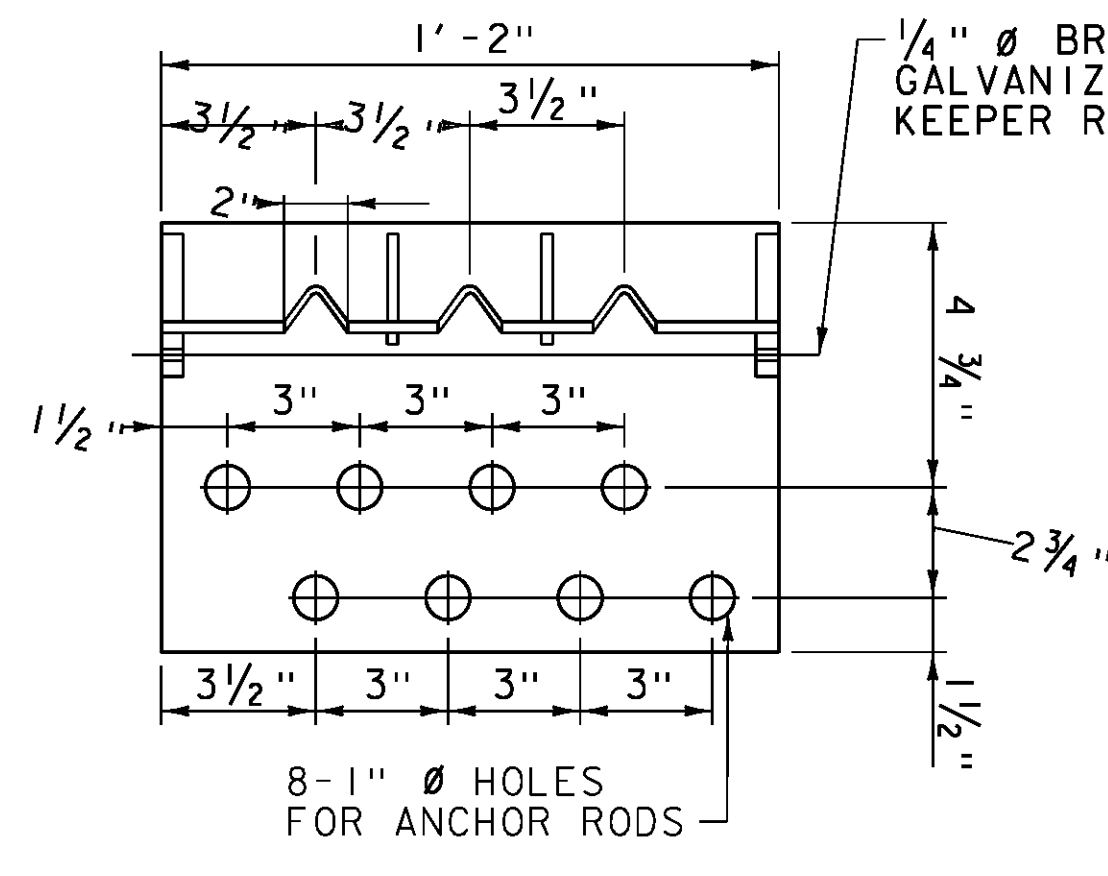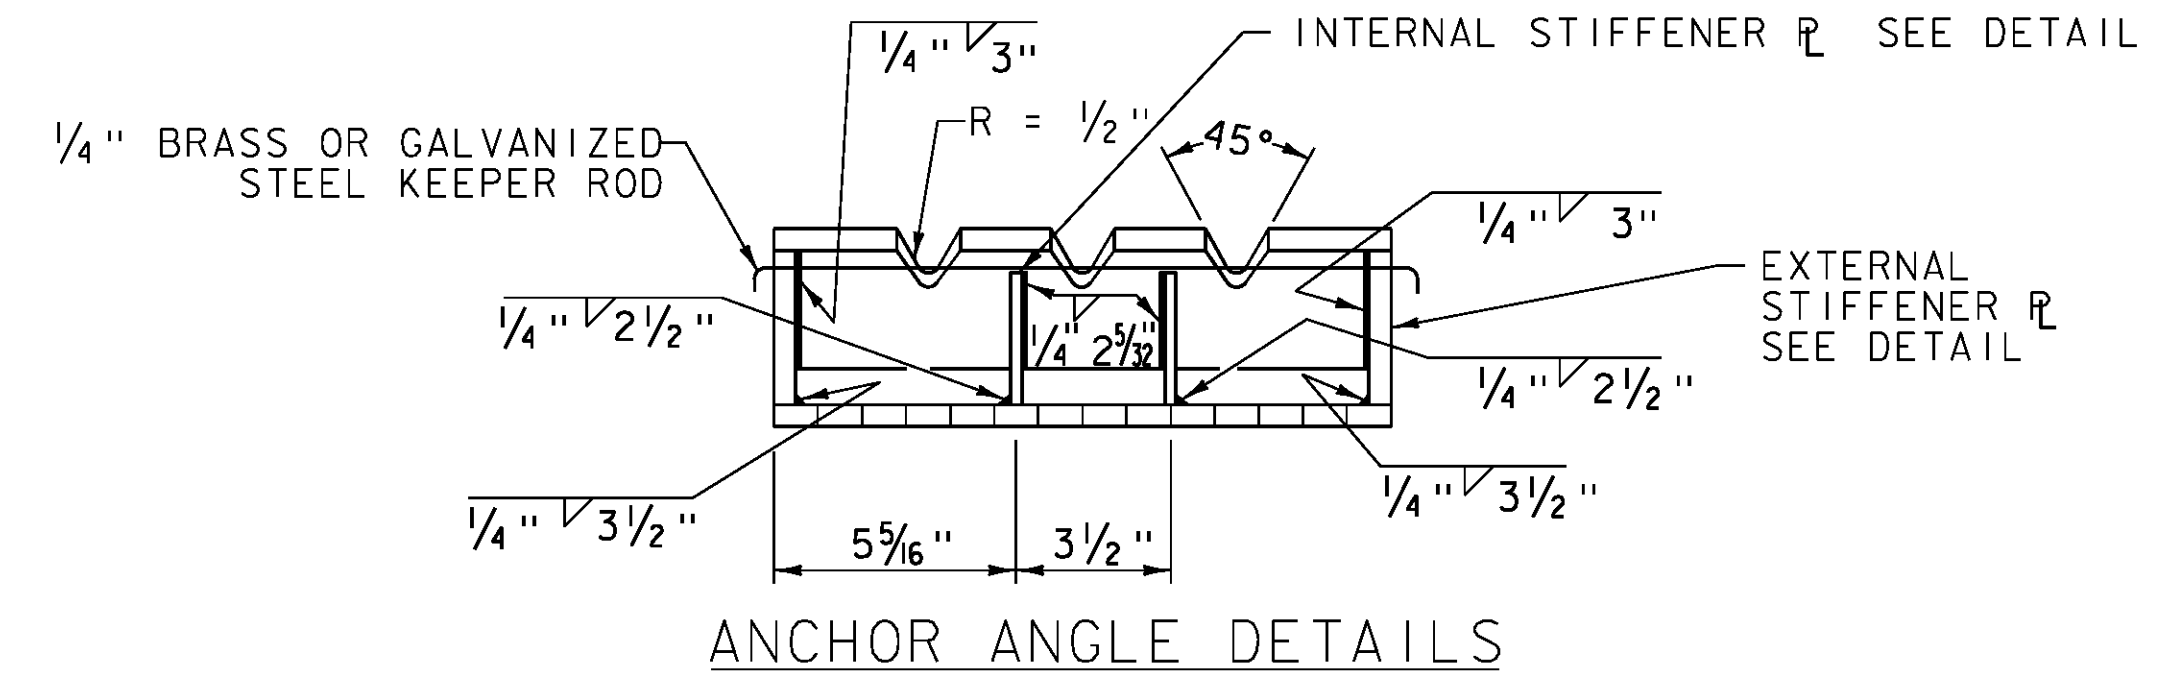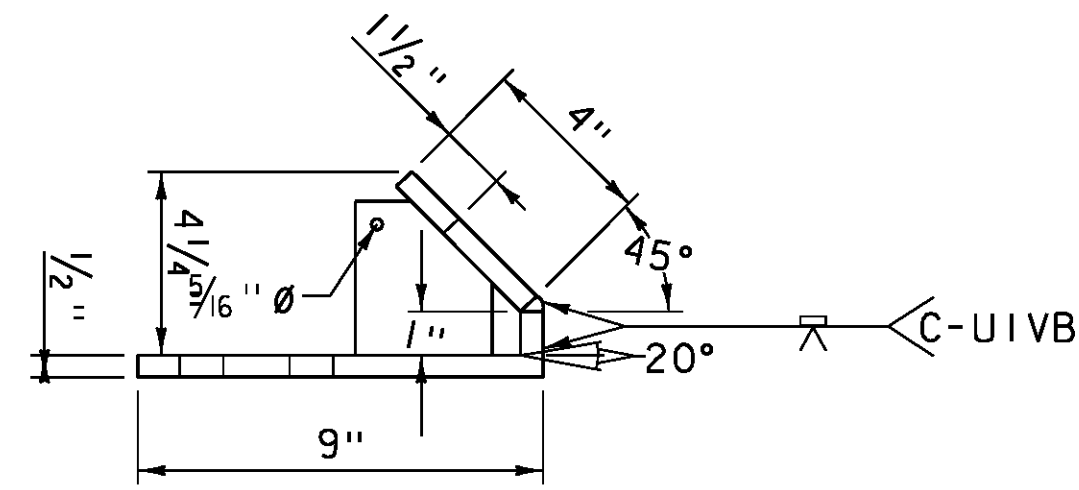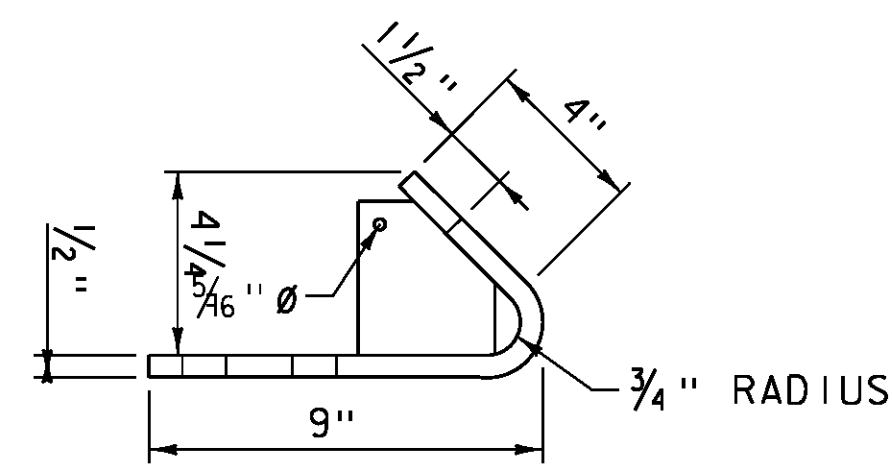


BENT PLATE ANCHOR ANGLE DETAILS

WELDED PLATE ANCHOR ANGLE DETAILS


EXTERNAL STIFFENER R ANCHOR ANGLE DETAILS

INTERNAL STIFFENER R ANCHOR ANGLE DETAILS


WASHER	WASHER SERIES	INSIDE DIAMETER "A"			OUTSIDE DIAMETER "B"			THICKNESS "C"		
		BASIC	TOLERANCE		BASIC	TOLERANCE		BASIC	MAX.	MIN.
			PLUS	MINUS		PLUS	MINUS			
3/4"	REGULAR	0.812	0.030	0.007	1.469	0.030	0.007	0.134	0.160	0.108
	WIDE	0.812	0.030	0.007	2.000	0.030	0.007	0.165	0.192	0.136
1/2"	NARROW	0.531	0.015	0.005	1.062	0.030	0.007	0.095	0.121	0.074

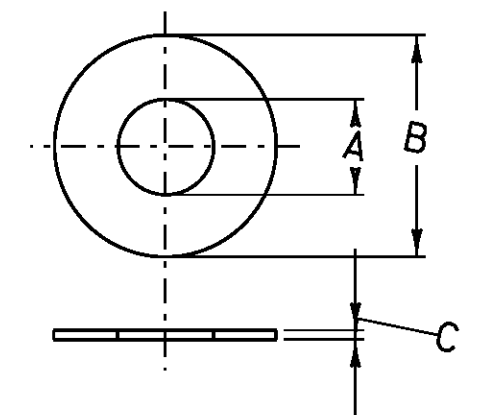

WASHER TABLE AND WASHER DETAIL

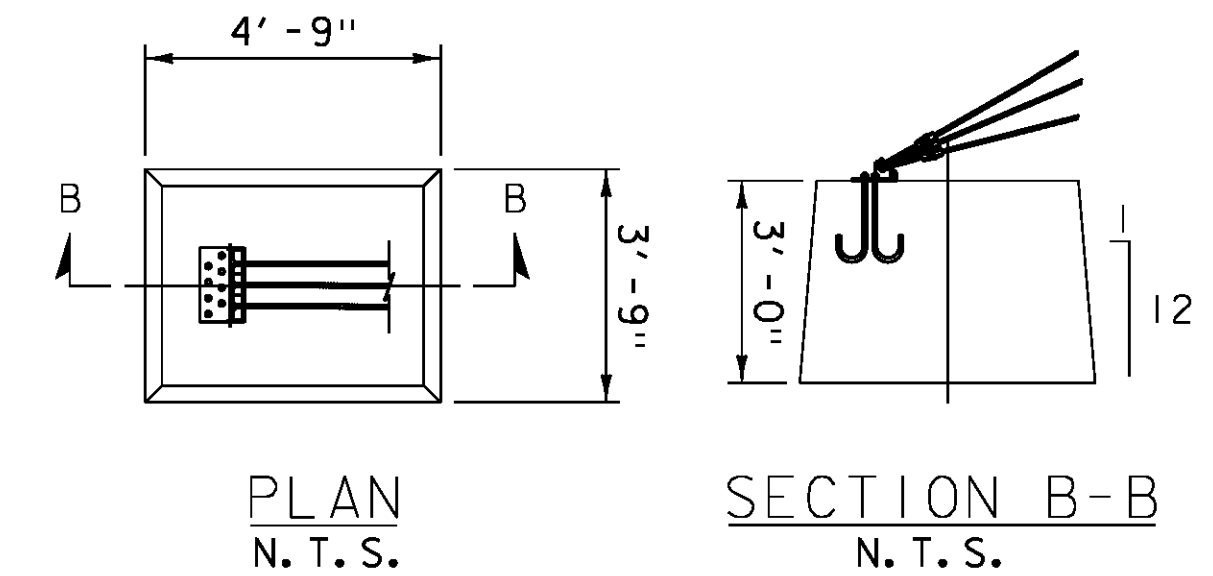


CONCRETE ANCHOR

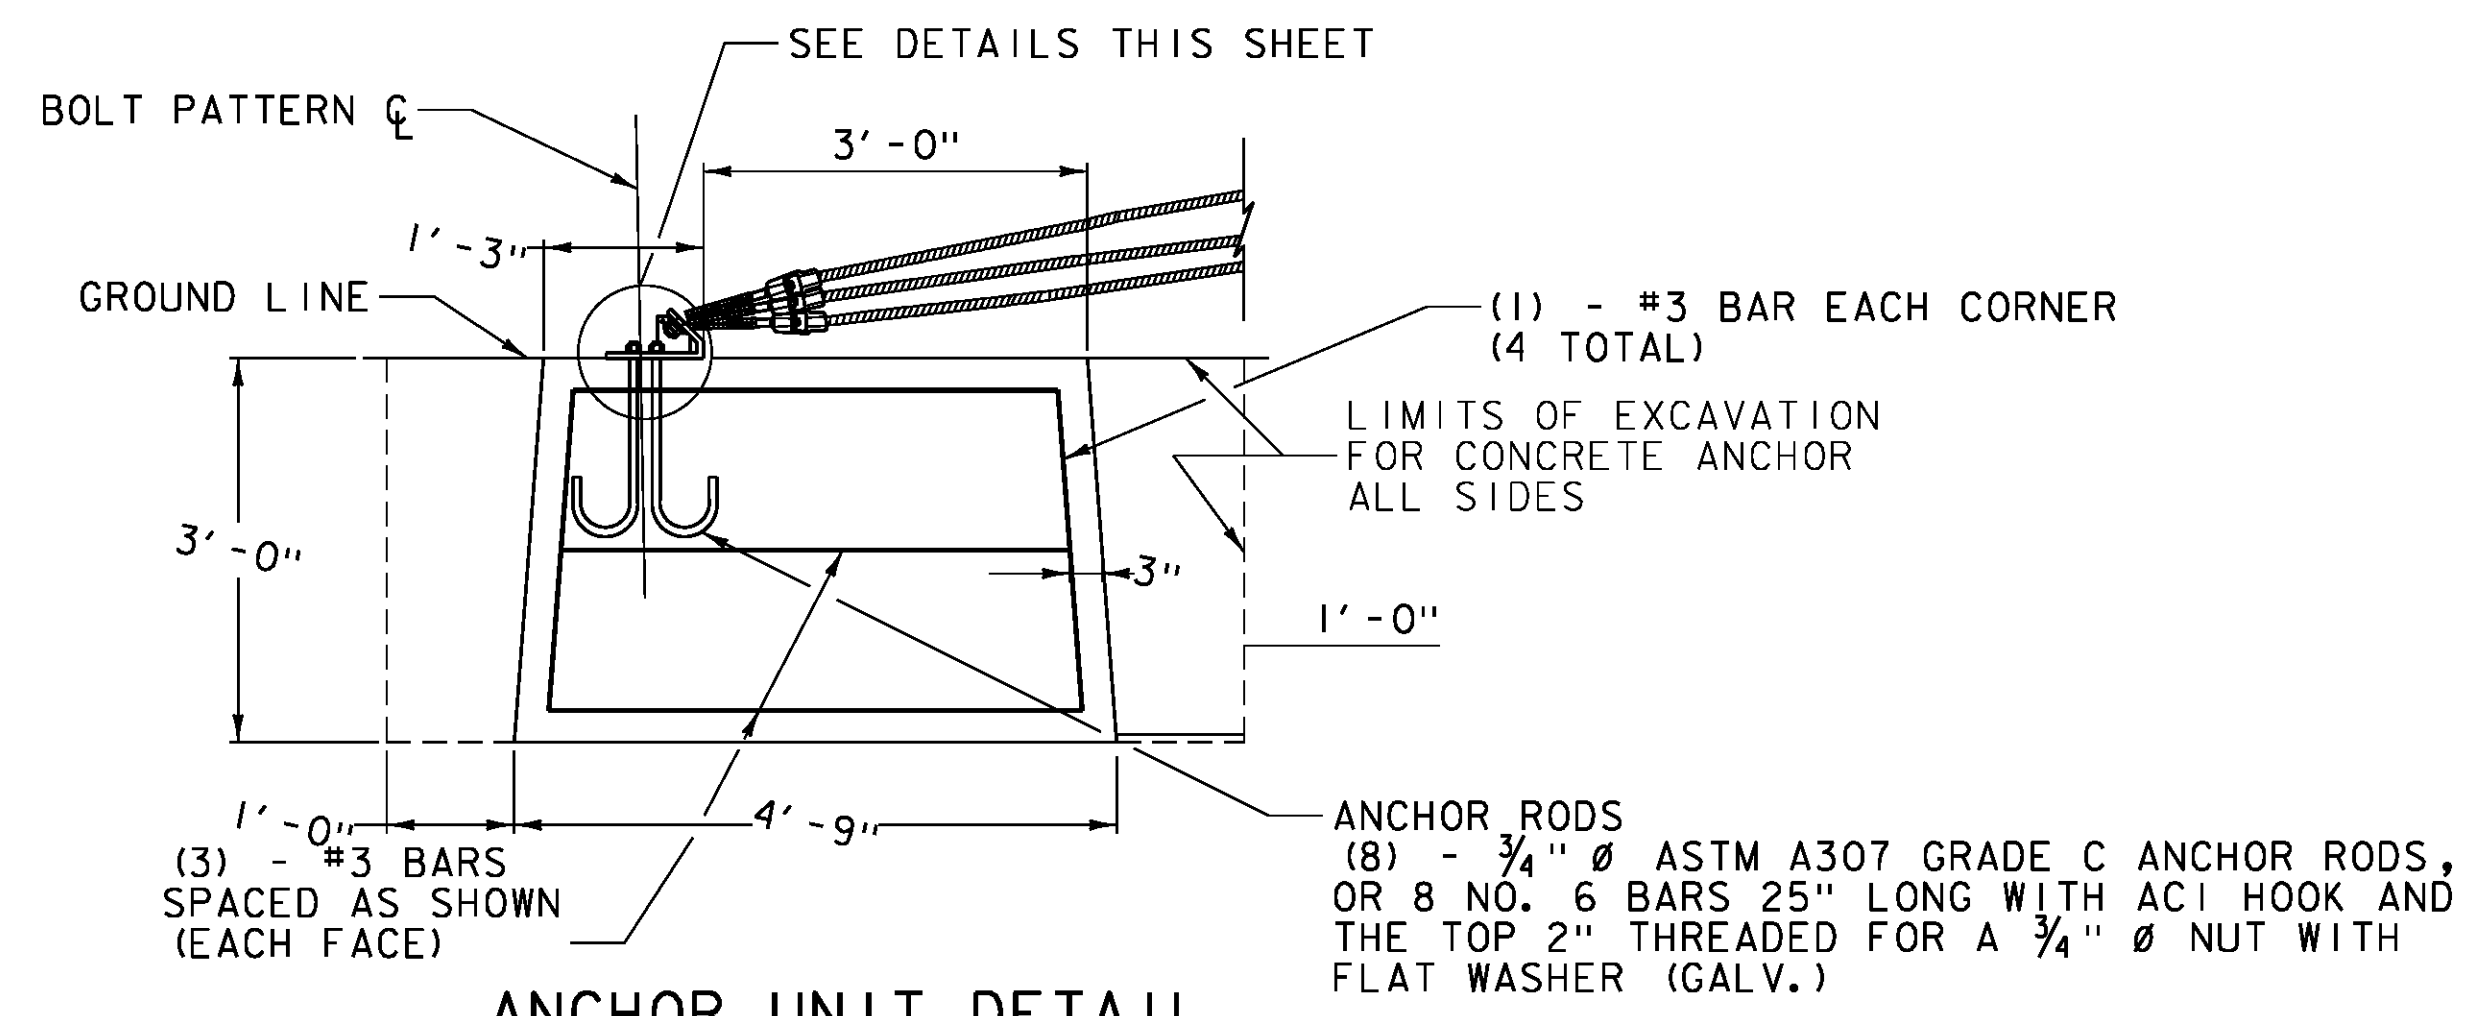

ANCHOR UNIT DETAIL

THE CONCRETE ANCHOR SHALL BE SET INTO THE EXCAVATION AS DETAILED. THE BOTTOM OF THE ANCHOR SHALL HAVE A FULL EVEN BEARING ON THE SURFACE UNDER IT.

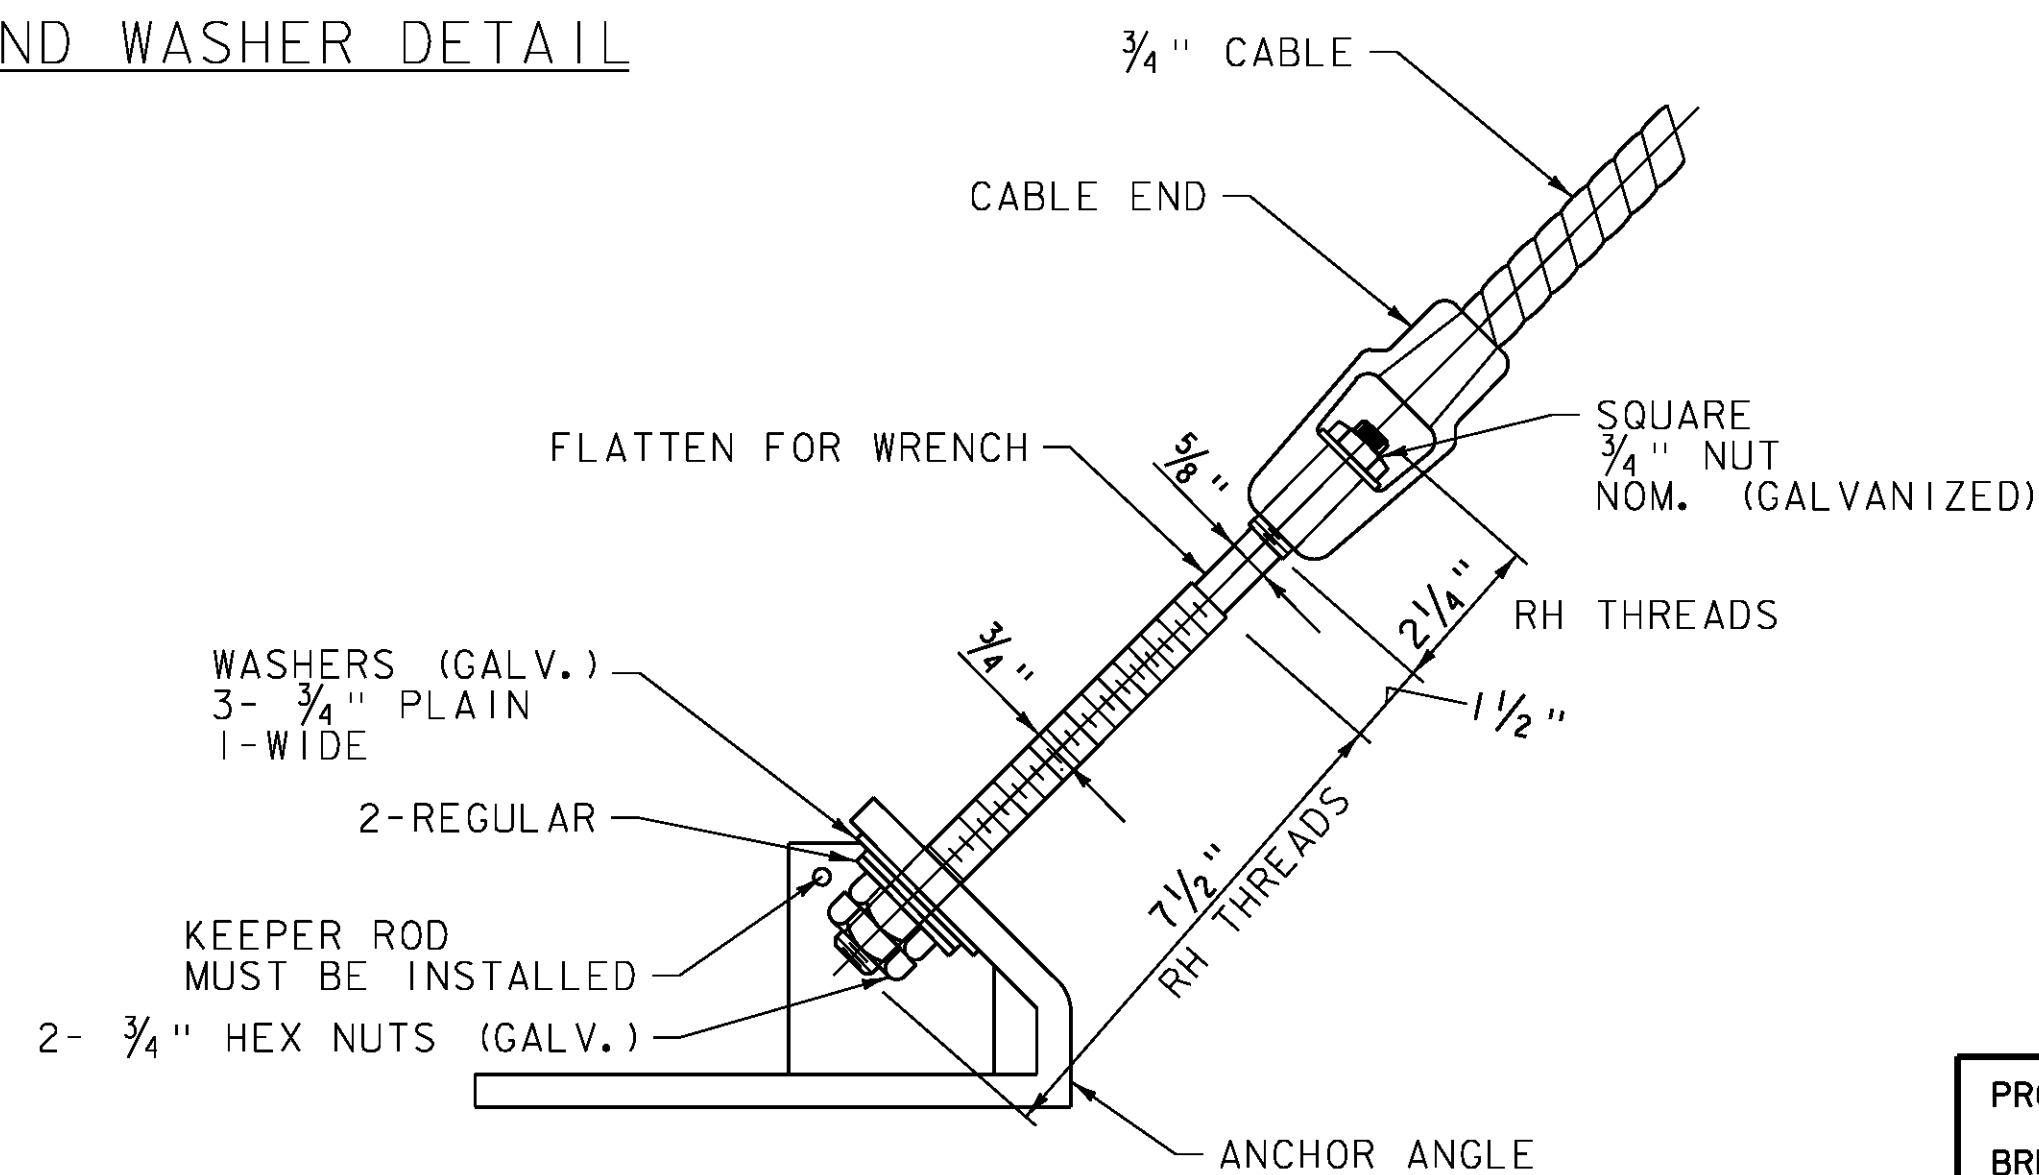


CABLE END ASSEMBLY TO ANCHOR ANGLE DETAILS

PROJECT NAME: JOHNSON  
 BRF 030-2(26): BRF 030-2(26)


FILE NAME: s88bl93rall.dgn  
 PROJECT LEADER: C. CARLSON  
 DESIGNED BY: H. SALLS  
 GUARDRAIL TRANSITION DETAILS (2)

PLOT DATE: 10-JUN-2014  
 DRAWN BY: G. ROKES  
 CHECKED BY: H. SALLS  
 SHEET 40 OF 69

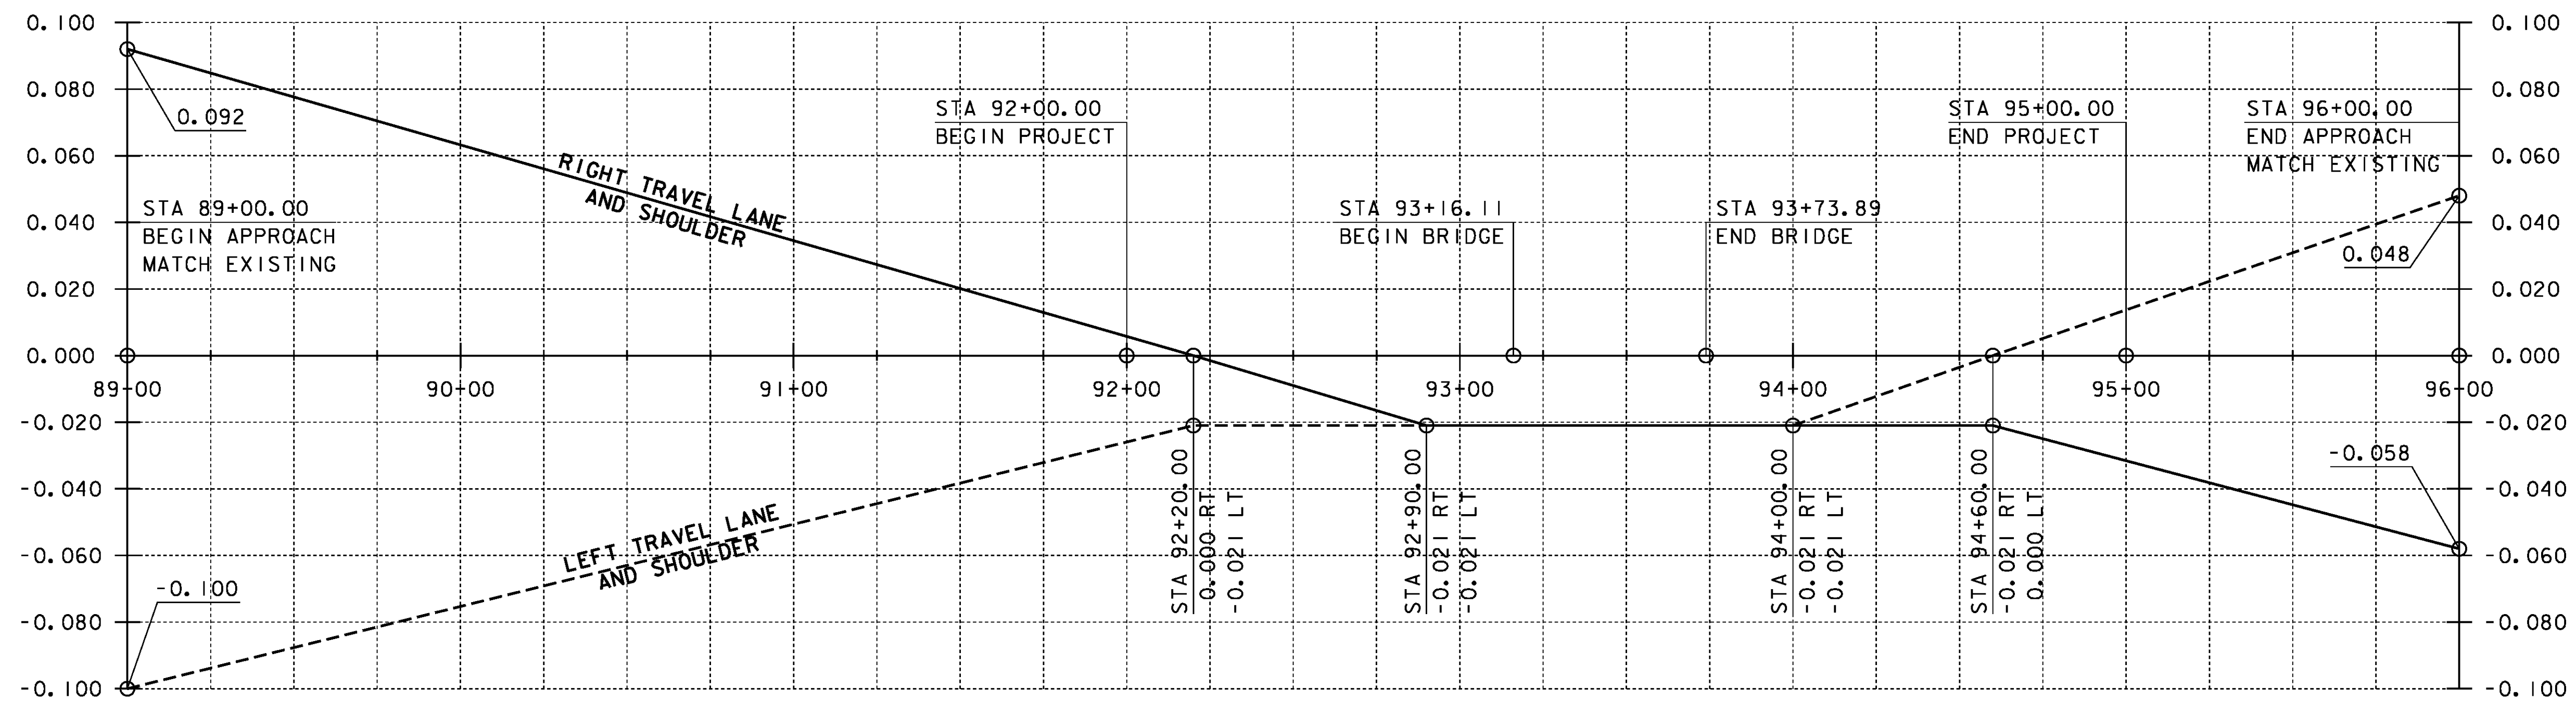

### VT 15 BANKING DIAGRAM

HORIZONTAL SCALE: 1" = 30'-0"  
 VERTICAL SCALE: 1" = 0.030' /'

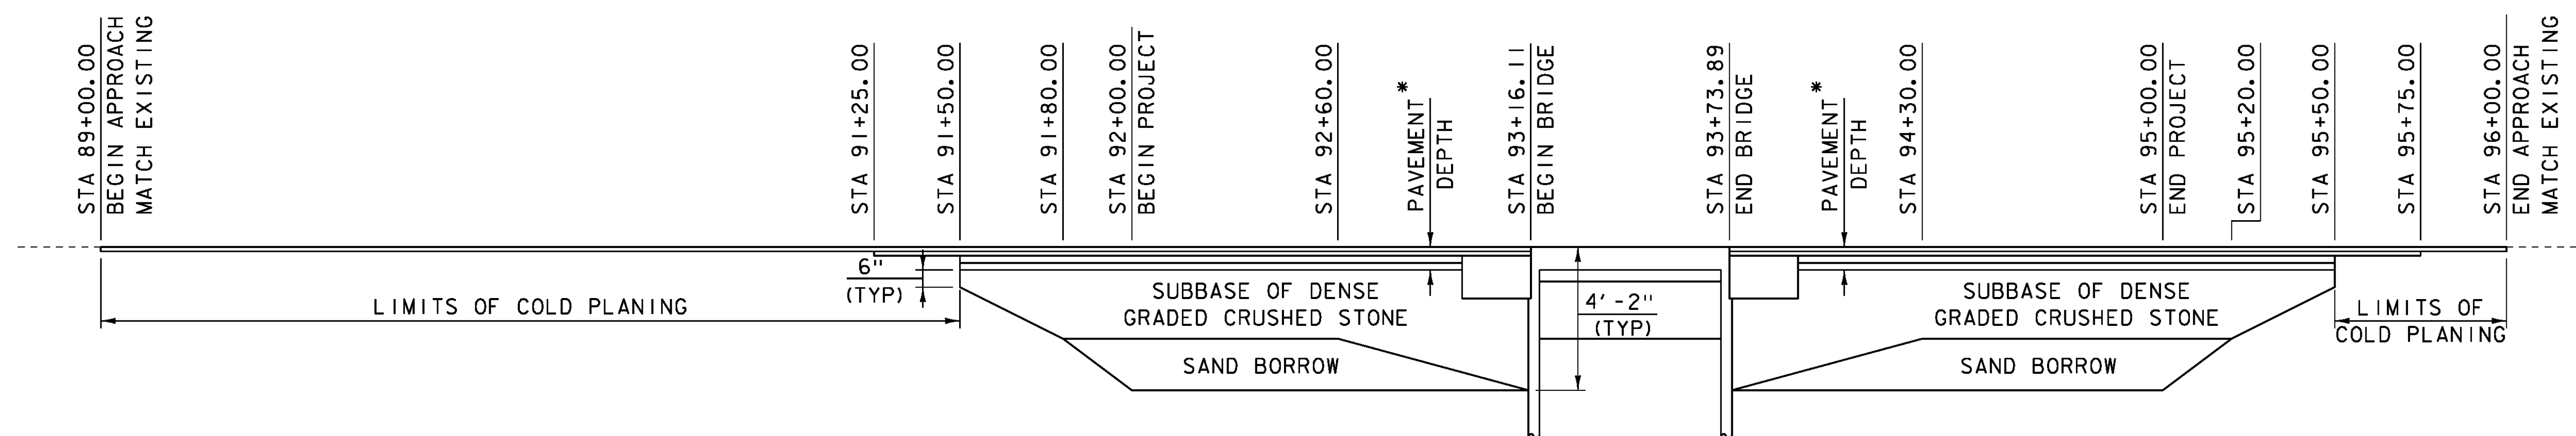


### VT 15 MATERIAL TRANSITION

HORIZONTAL SCALE: 1" = 30'-0"  
 VERTICAL SCALE: 1" = 3'-0"


* SEE ROADWAY TYPICAL SECTION FOR PAVEMENT AND SUBBASE MATERIAL DESIGN INFORMATION.

PROJECT NAME: JOHNSON	PLOT DATE: 10-JUN-2014
PROJECT NUMBER: BRF 030-2(26)	DRAWN BY: G. ROY
FILE NAME: s88bl93pro.dgn	CHECKED BY: H. SALLS
PROJECT LEADER: C. CARLSON	SHEET 41 OF 69
DESIGNED BY: H. SALLS	

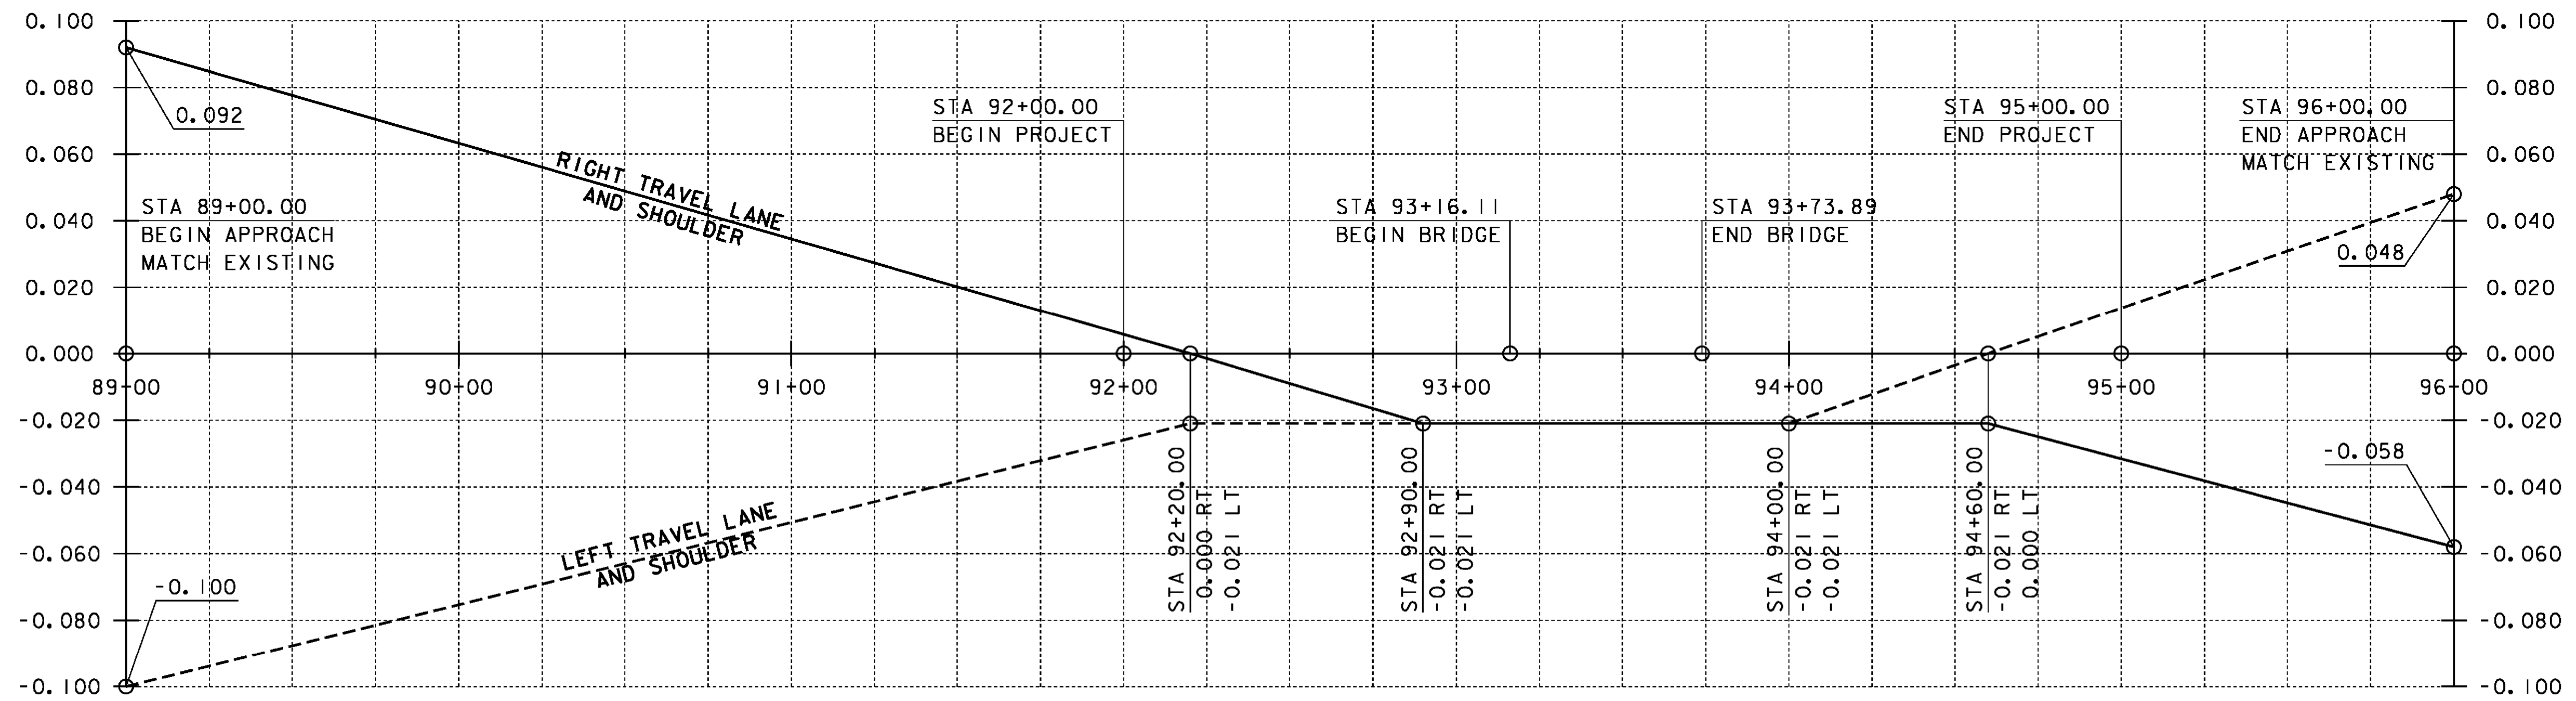

### VT 15 BANKING DIAGRAM

HORIZONTAL SCALE: 1" = 30'-0"  
VERTICAL SCALE: 1" = 0.030' /'

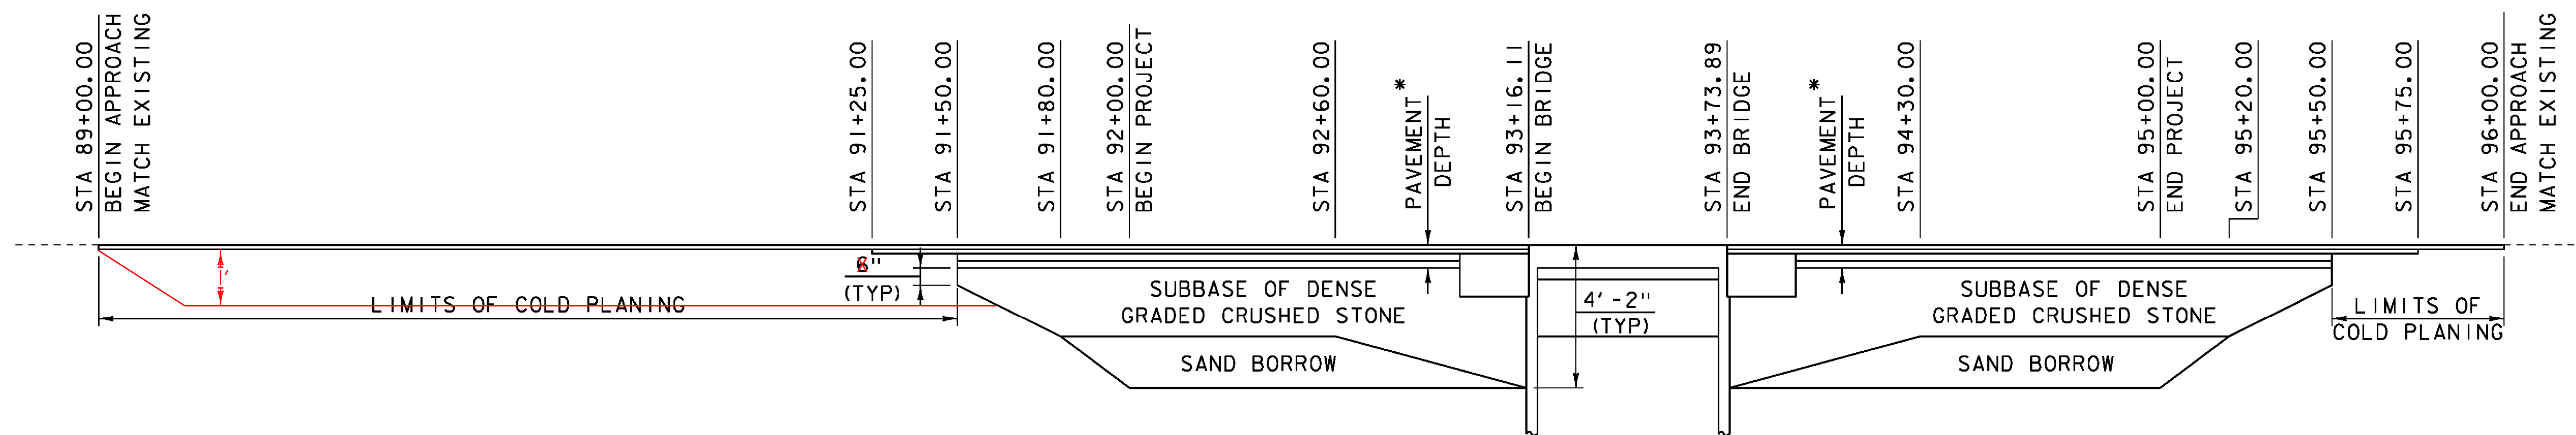

### VT 15 MATERIAL TRANSITION


HORIZONTAL SCALE: 1" = 30'-0"  
VERTICAL SCALE: 1" = 3'-0"

*SEE ROADWAY TYPICAL SECTION FOR  
PAVEMENT AND SUBBASE MATERIAL  
DESIGN INFORMATION.


PROJECT NAME: JOHNSON  
PROJECT NUMBER: BRF 030-2(26)

FILE NAME: s88bi93pro.dgn  
PROJECT LEADER: C. CARLSON  
DESIGNED BY: H. SALLS  
VT 15 BANKING DIAGRAM AND MATERIAL TRANSITION


PLOT DATE: 10-JUN-2014  
DRAWN BY: G. ROY  
CHECKED BY: H. SALLS  
SHEET 41 OF 69

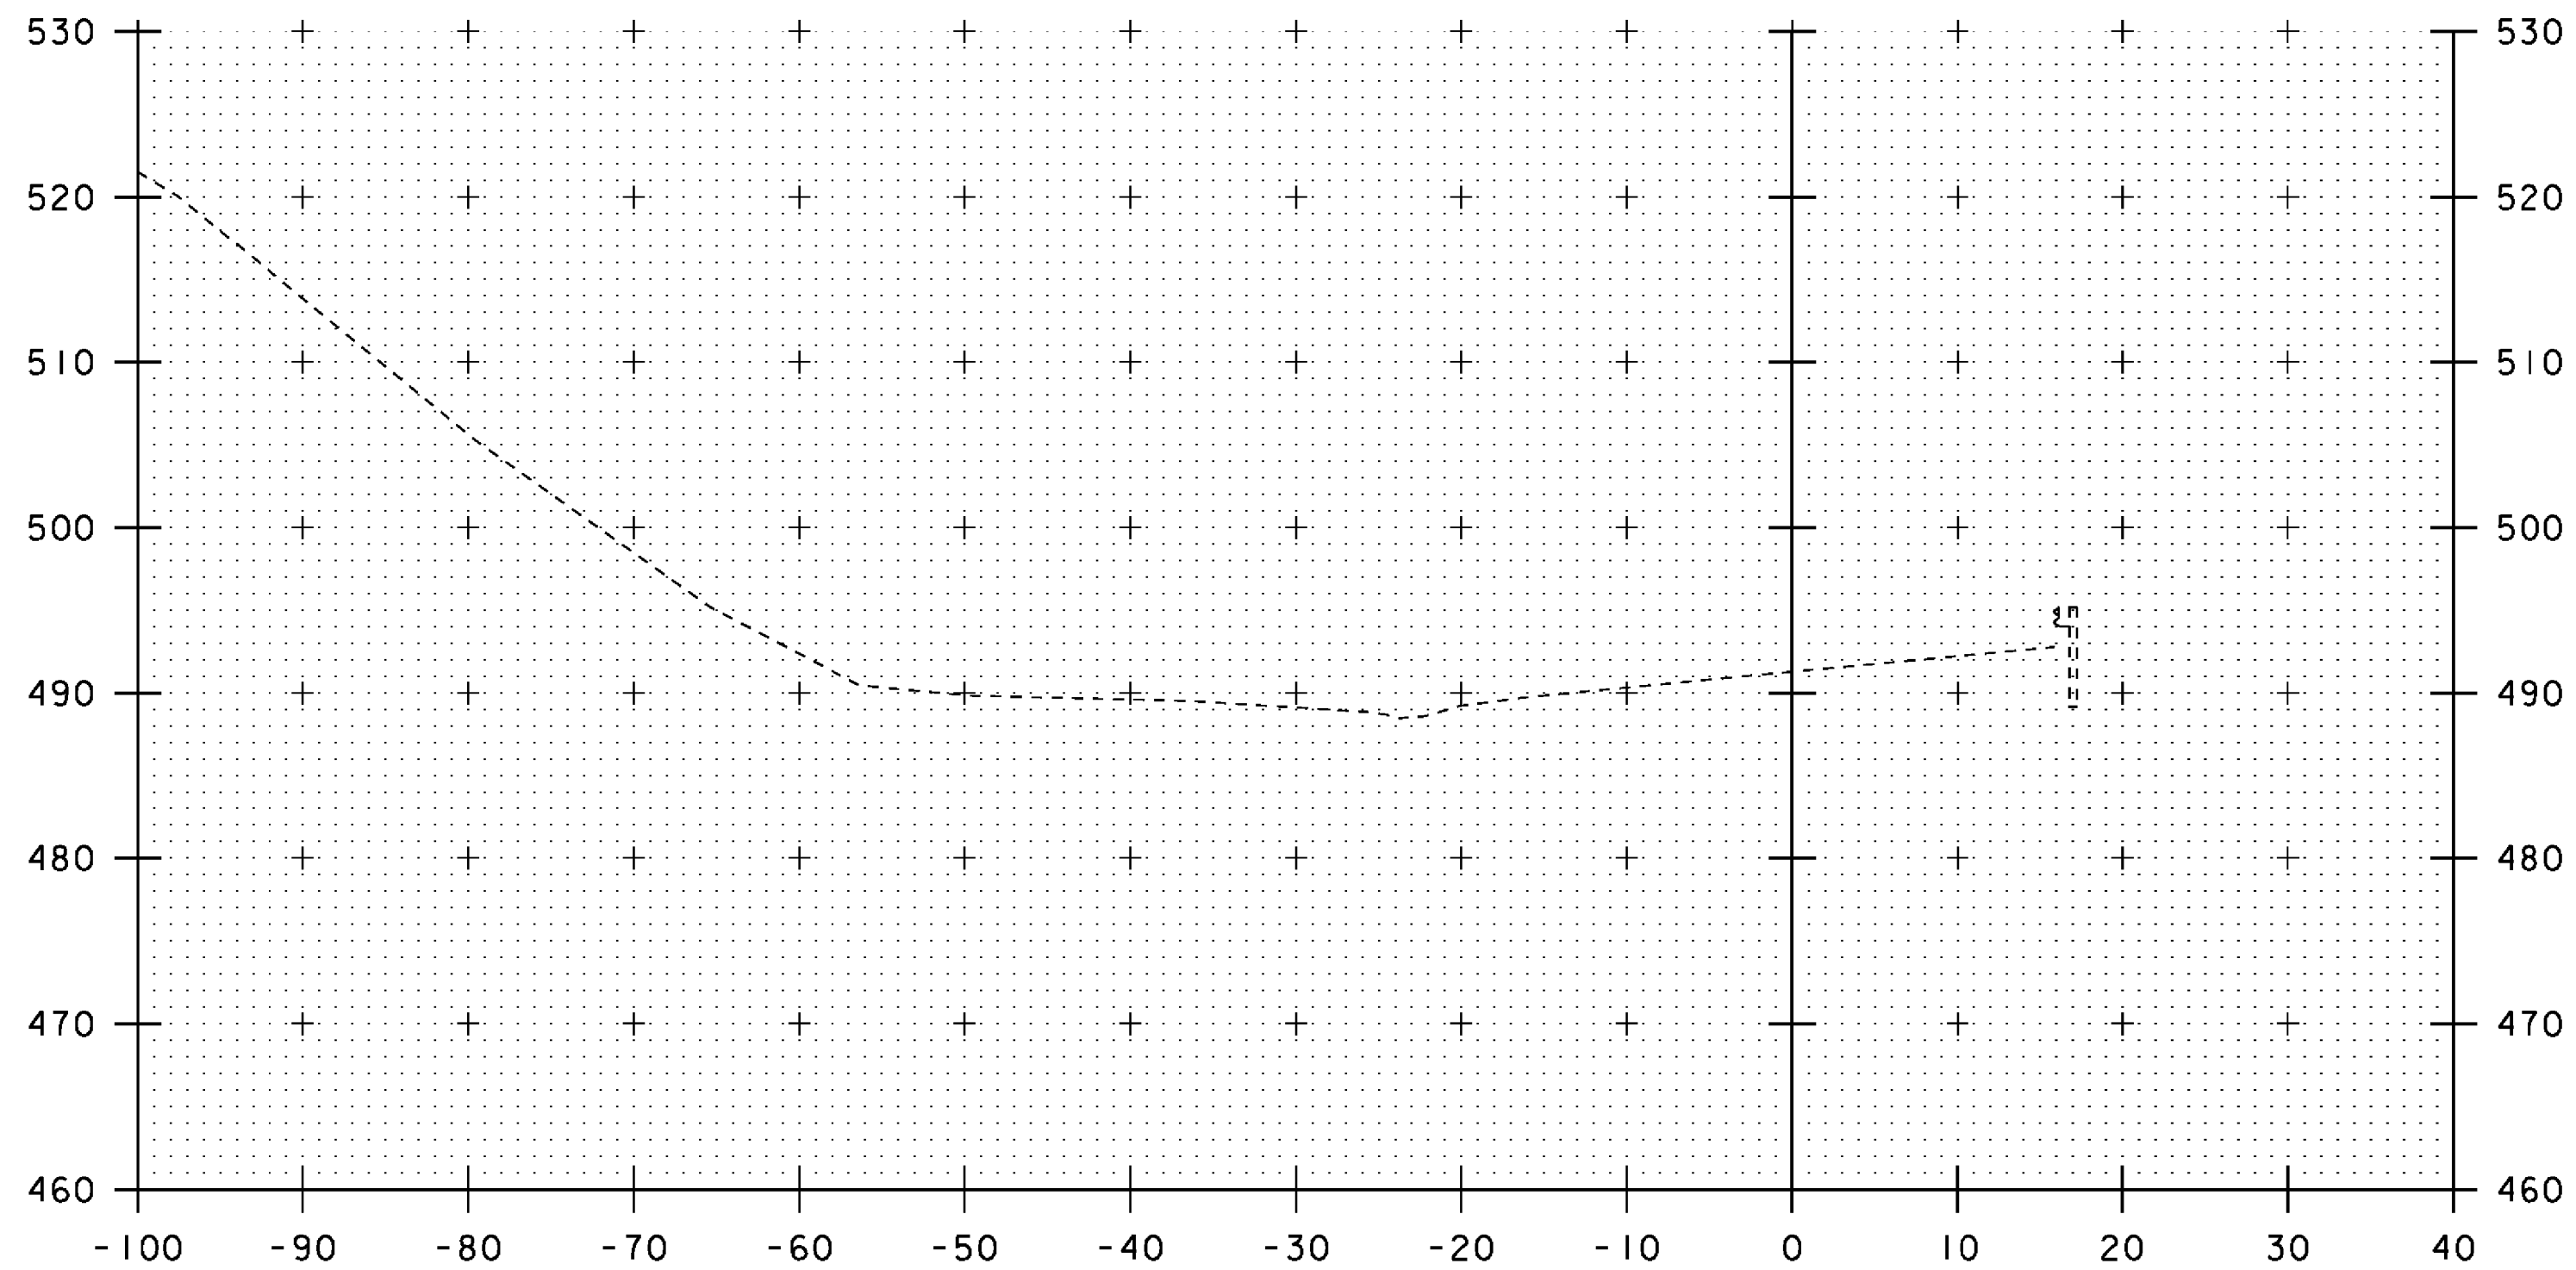


88+75

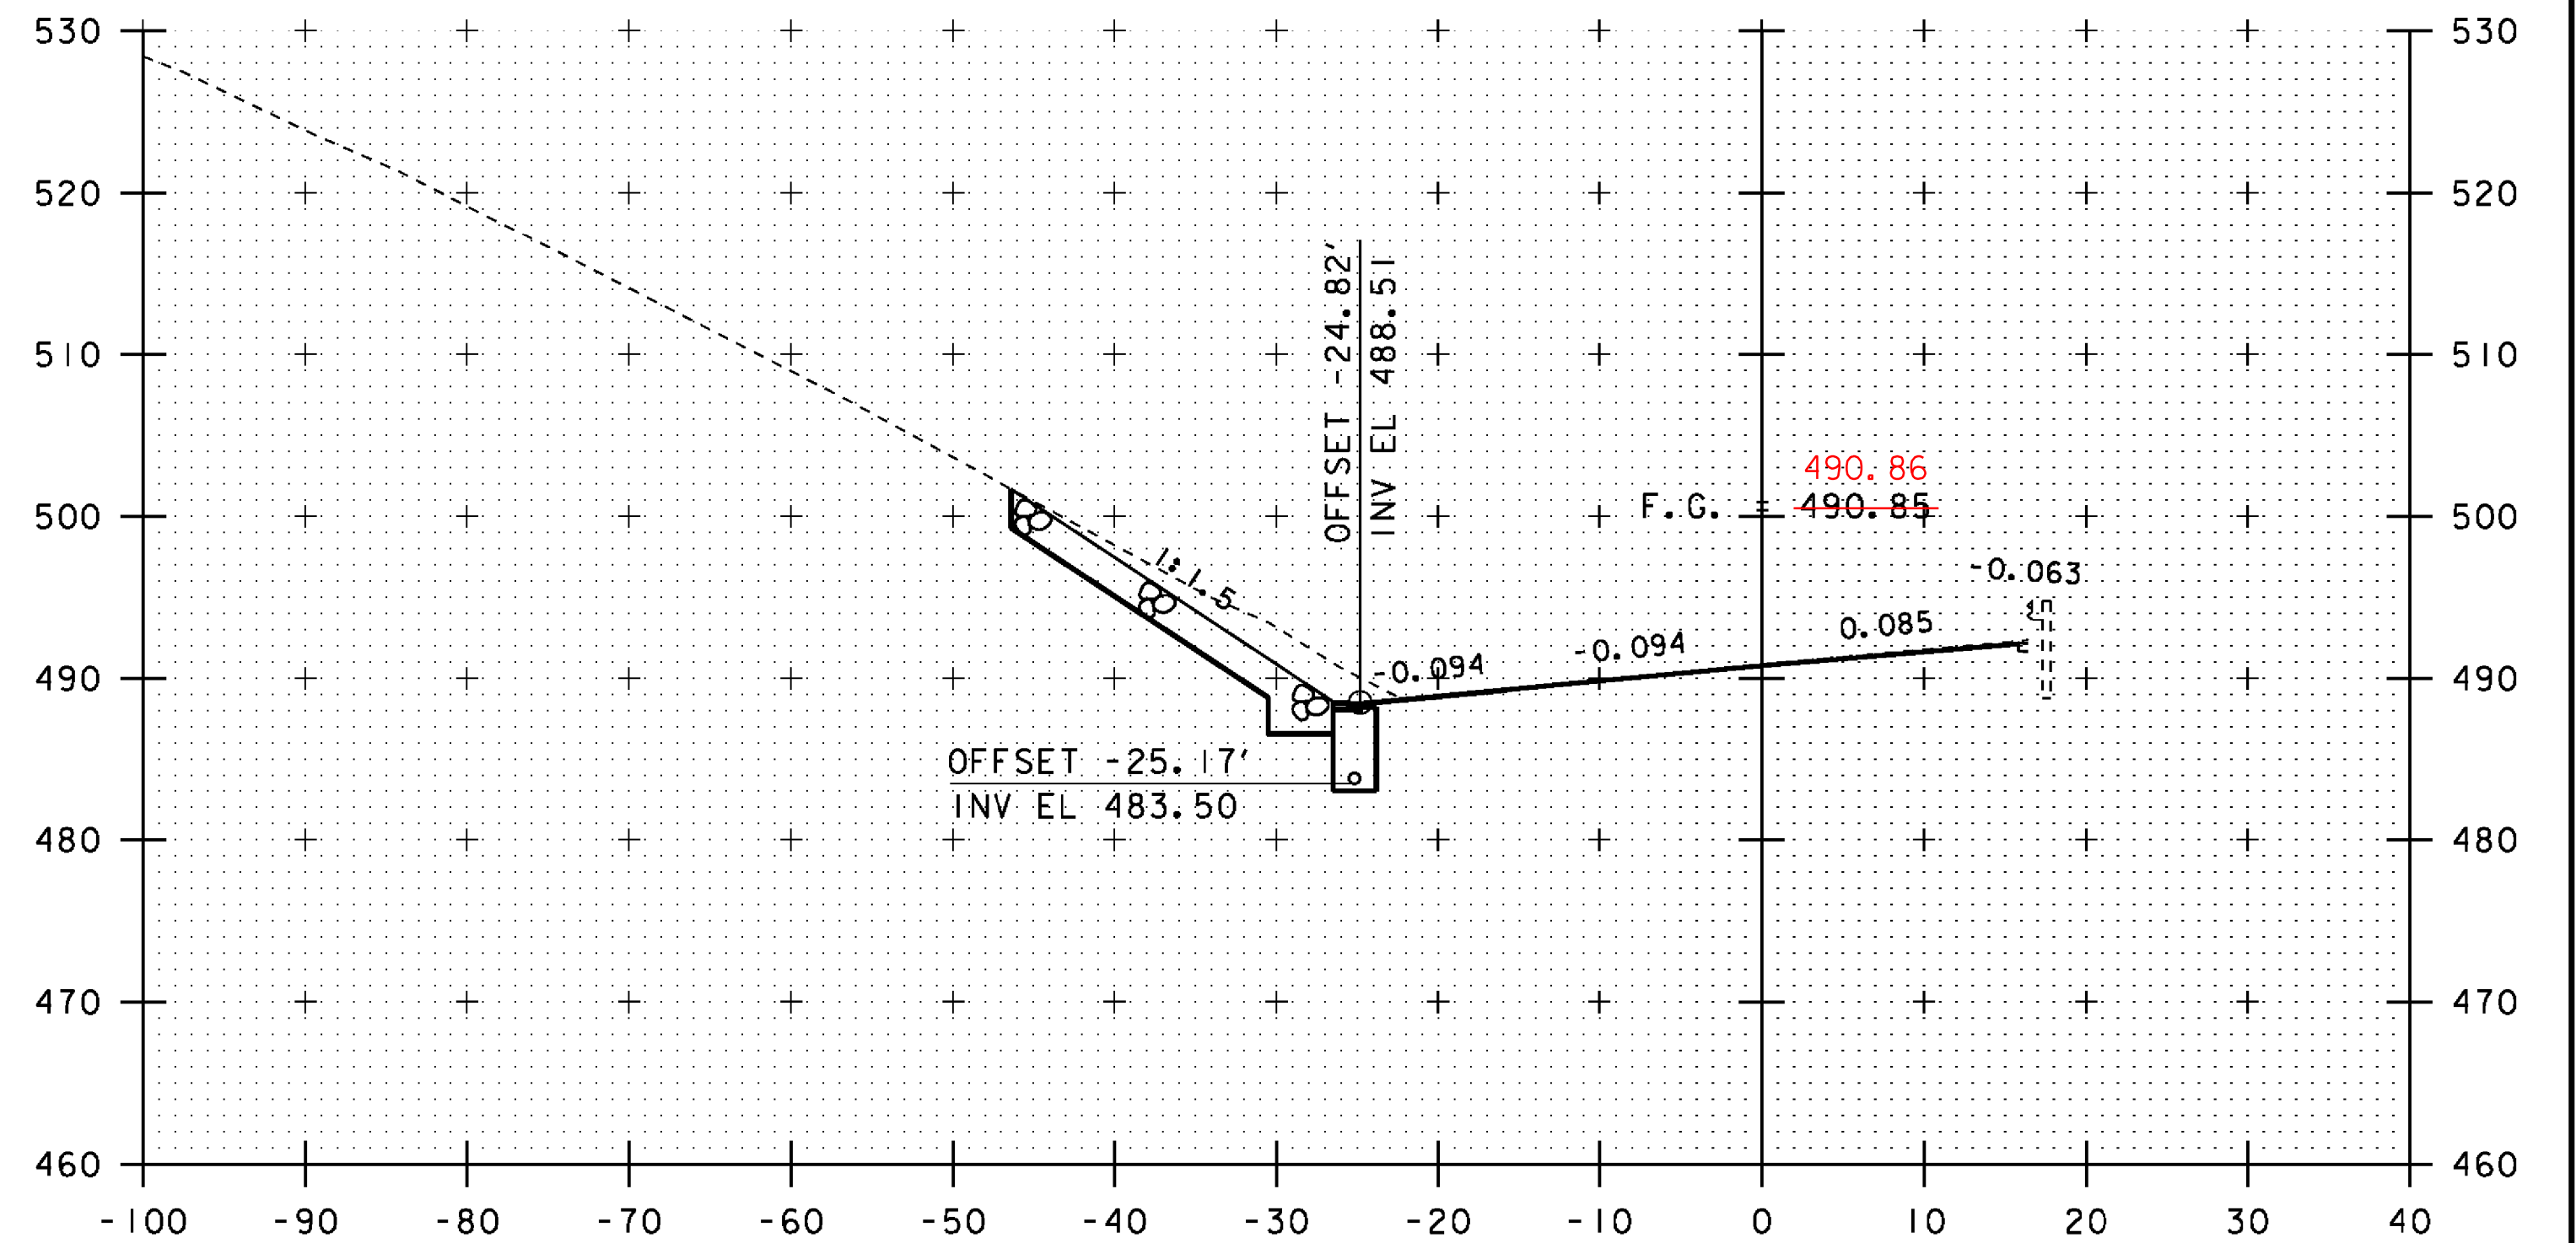

89+25

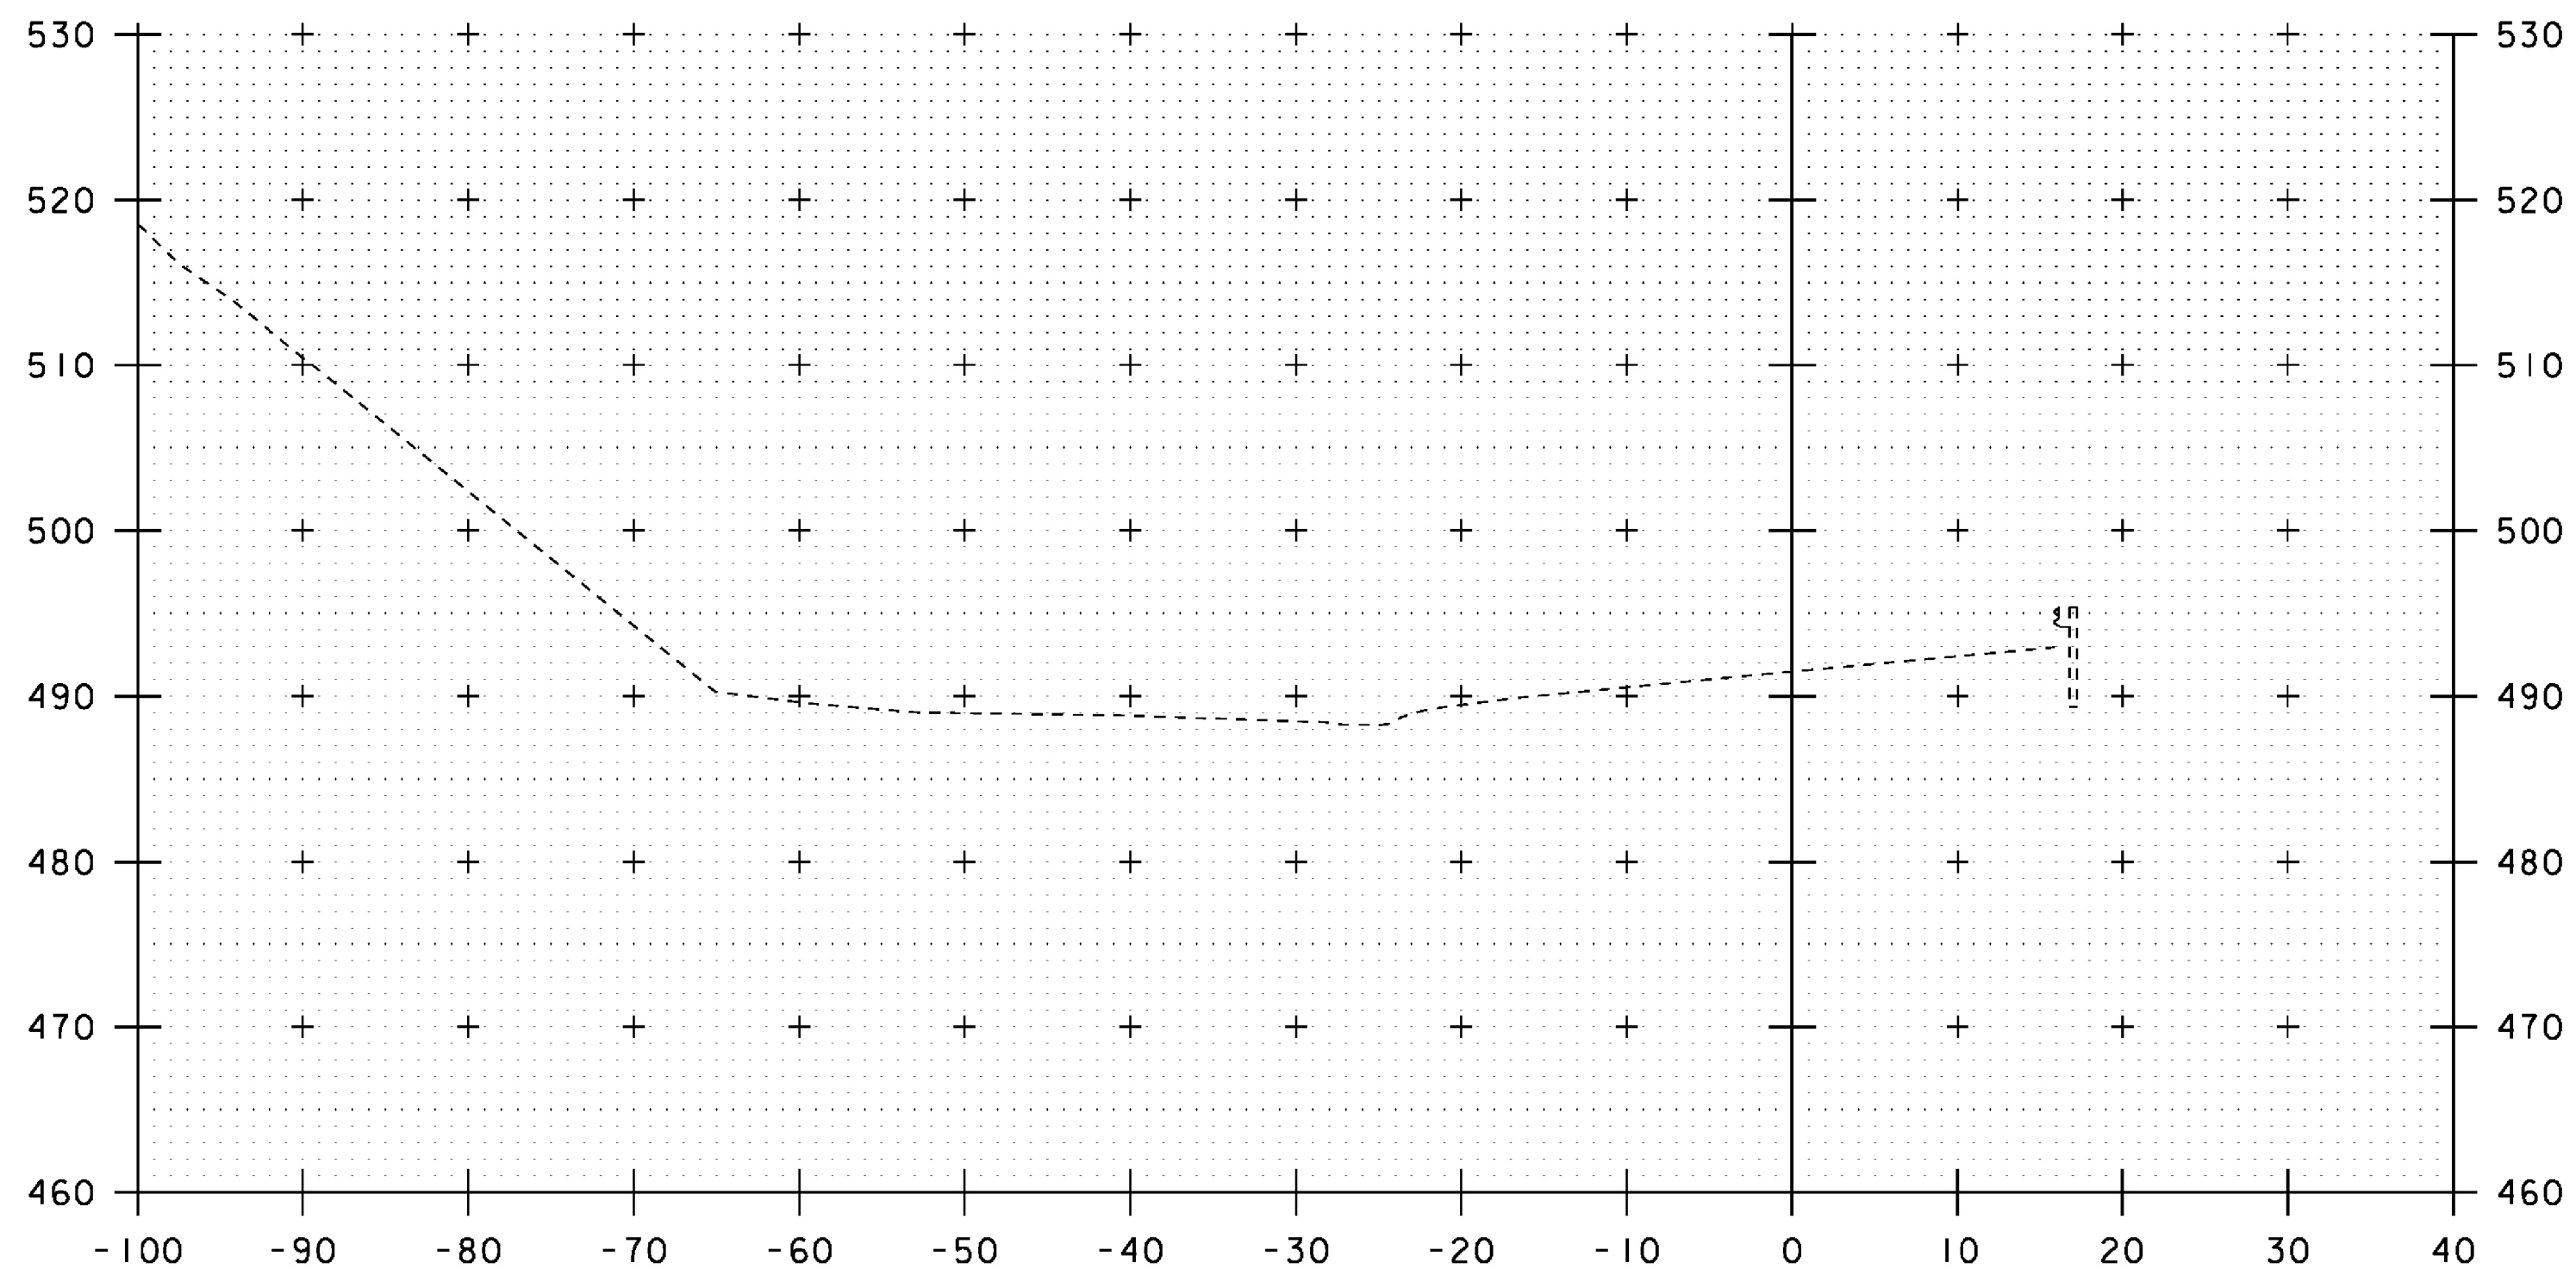

88+50

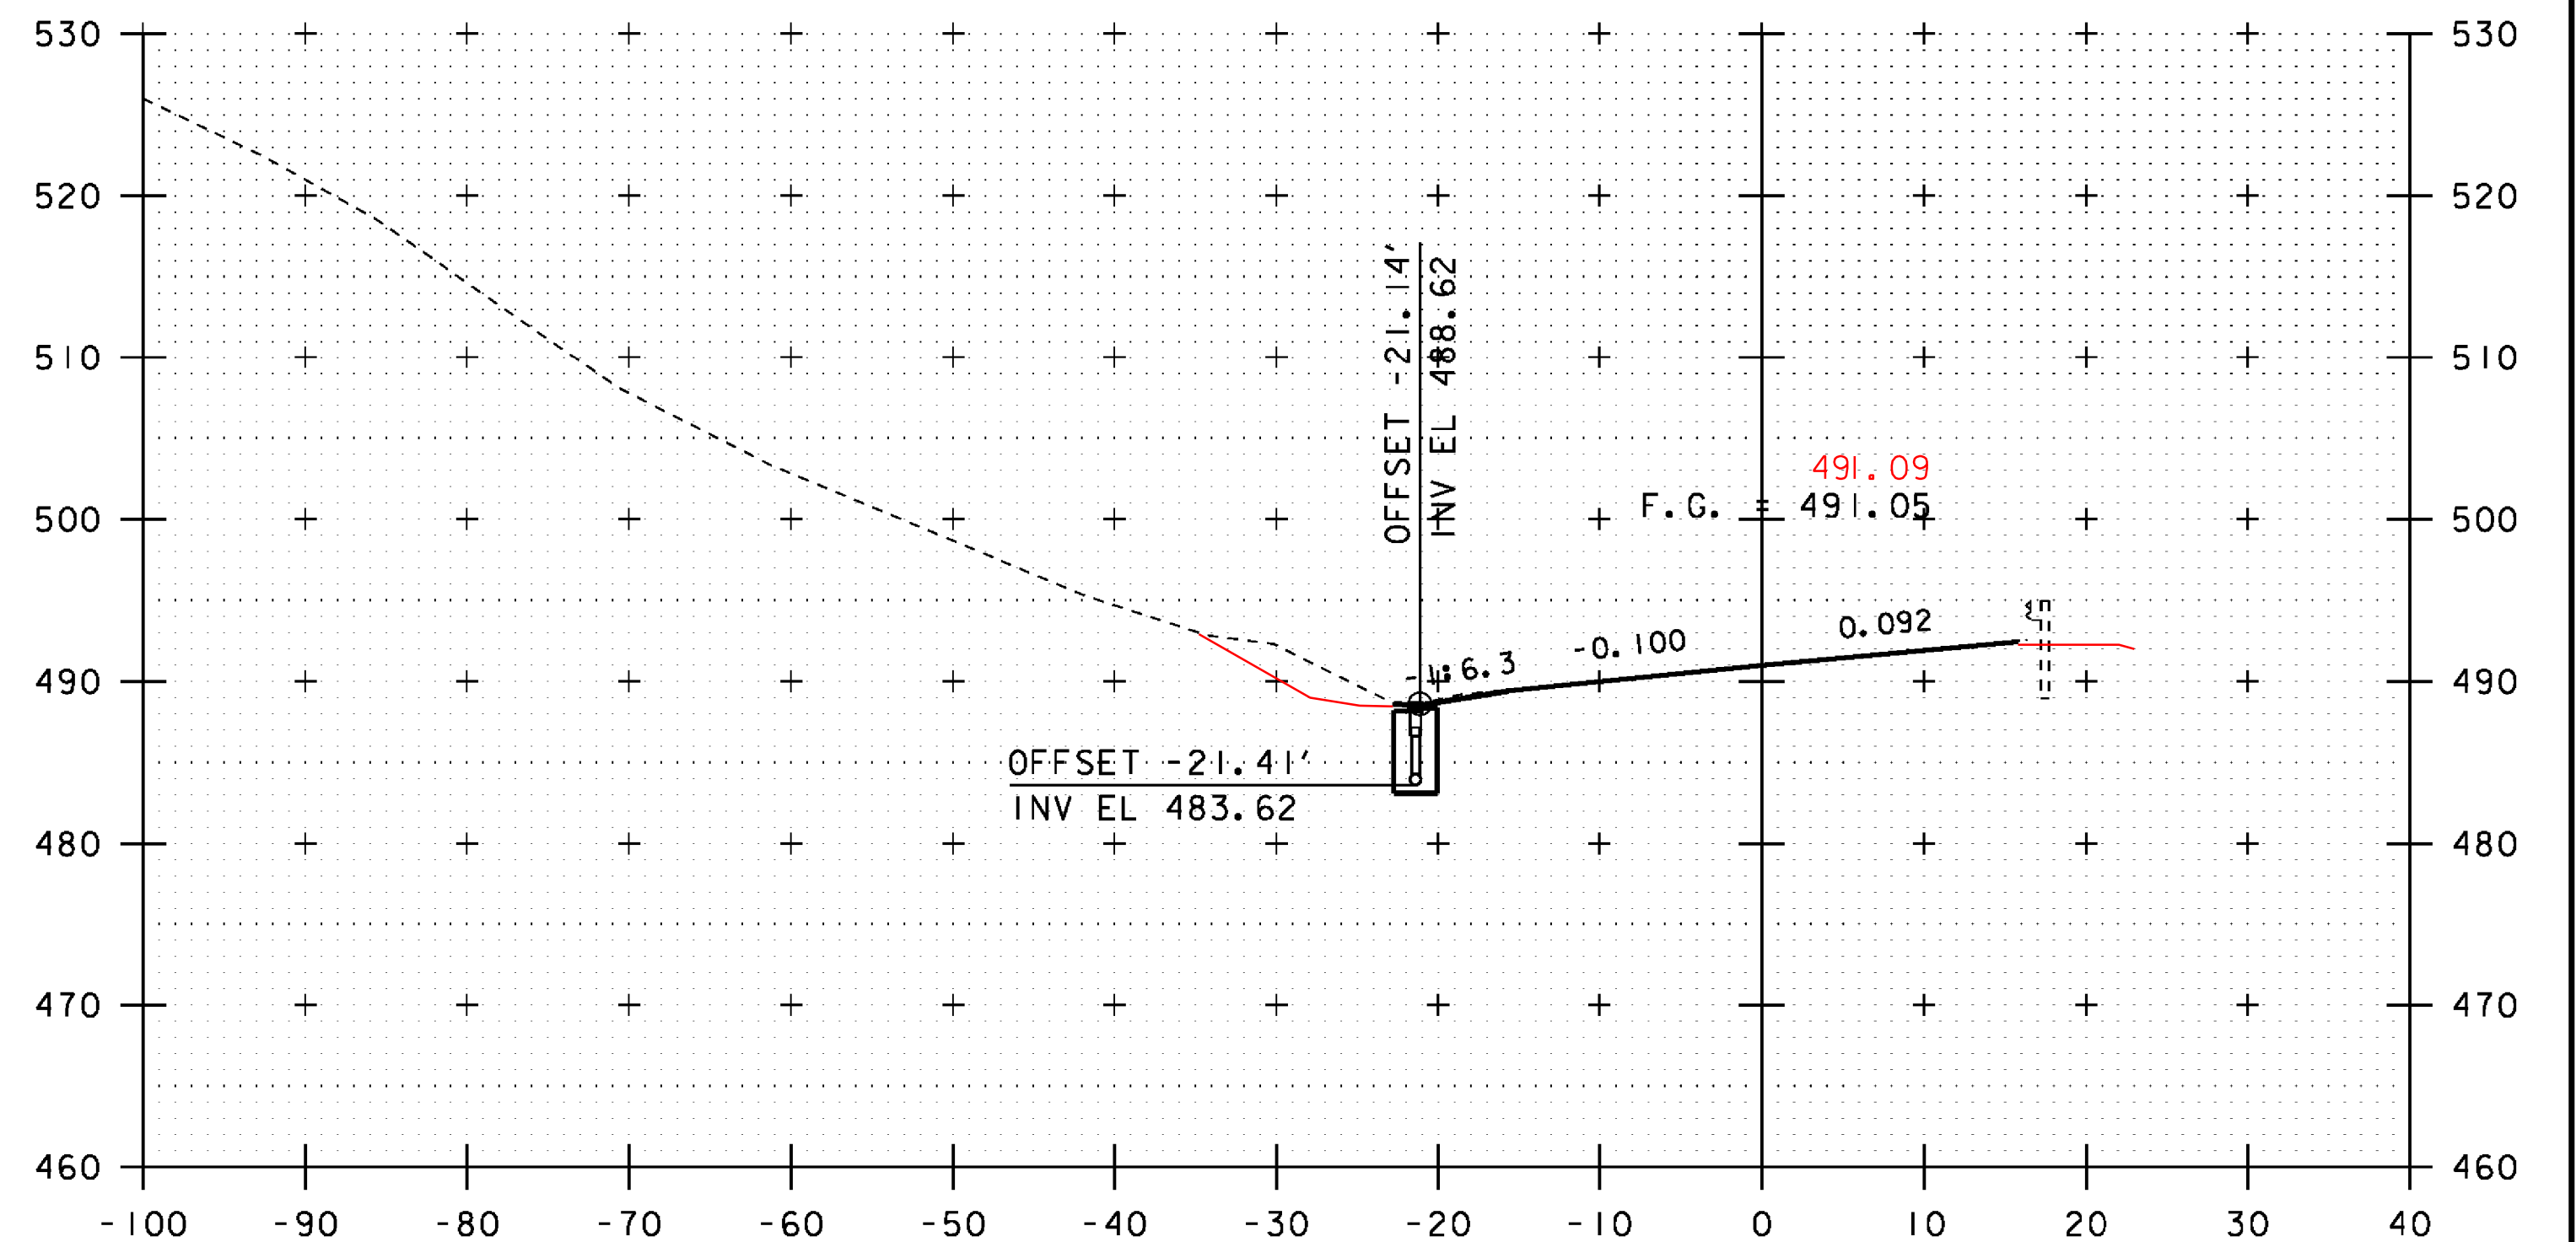

89+00

STA 89+00.0 LT - STA 92+53.0 LT  
CONSTRUCT STONE FILL, TYPE II BANK SLOPE

STA 89+00.0 LT - STA 92+53.0 LT  
CONSTRUCT GRASS-LINED DITCH

STA 89+00.0 LT - STA 92+58.0 LT  
NEW 8 INCH UNDERDRAIN PIPE W/  
UNDERDRAIN FLUSHING BASIN AND  
YIELDING MARKER POST AT INLET


SCALE: 1" = 10'-0"




STA. 88+50 TO STA. 89+25

STA 89+00.00  
BEGIN APPROACH  
MATCH EXISTING


PROJECT NAME: JOHNSON	PLOT DATE: 10-JUN-2014
PROJECT NUMBER: BRF 030-2(26)	DRAWN BY: G. ROY
FILE NAME: s88bi93xsl.dgn	CHECKED BY: H. SALLS
PROJECT LEADER: C. CARLSON	SHEET 42 OF 69
DESIGNED BY: H. SALLS	
VT 15 CROSS SECTIONS (I)	

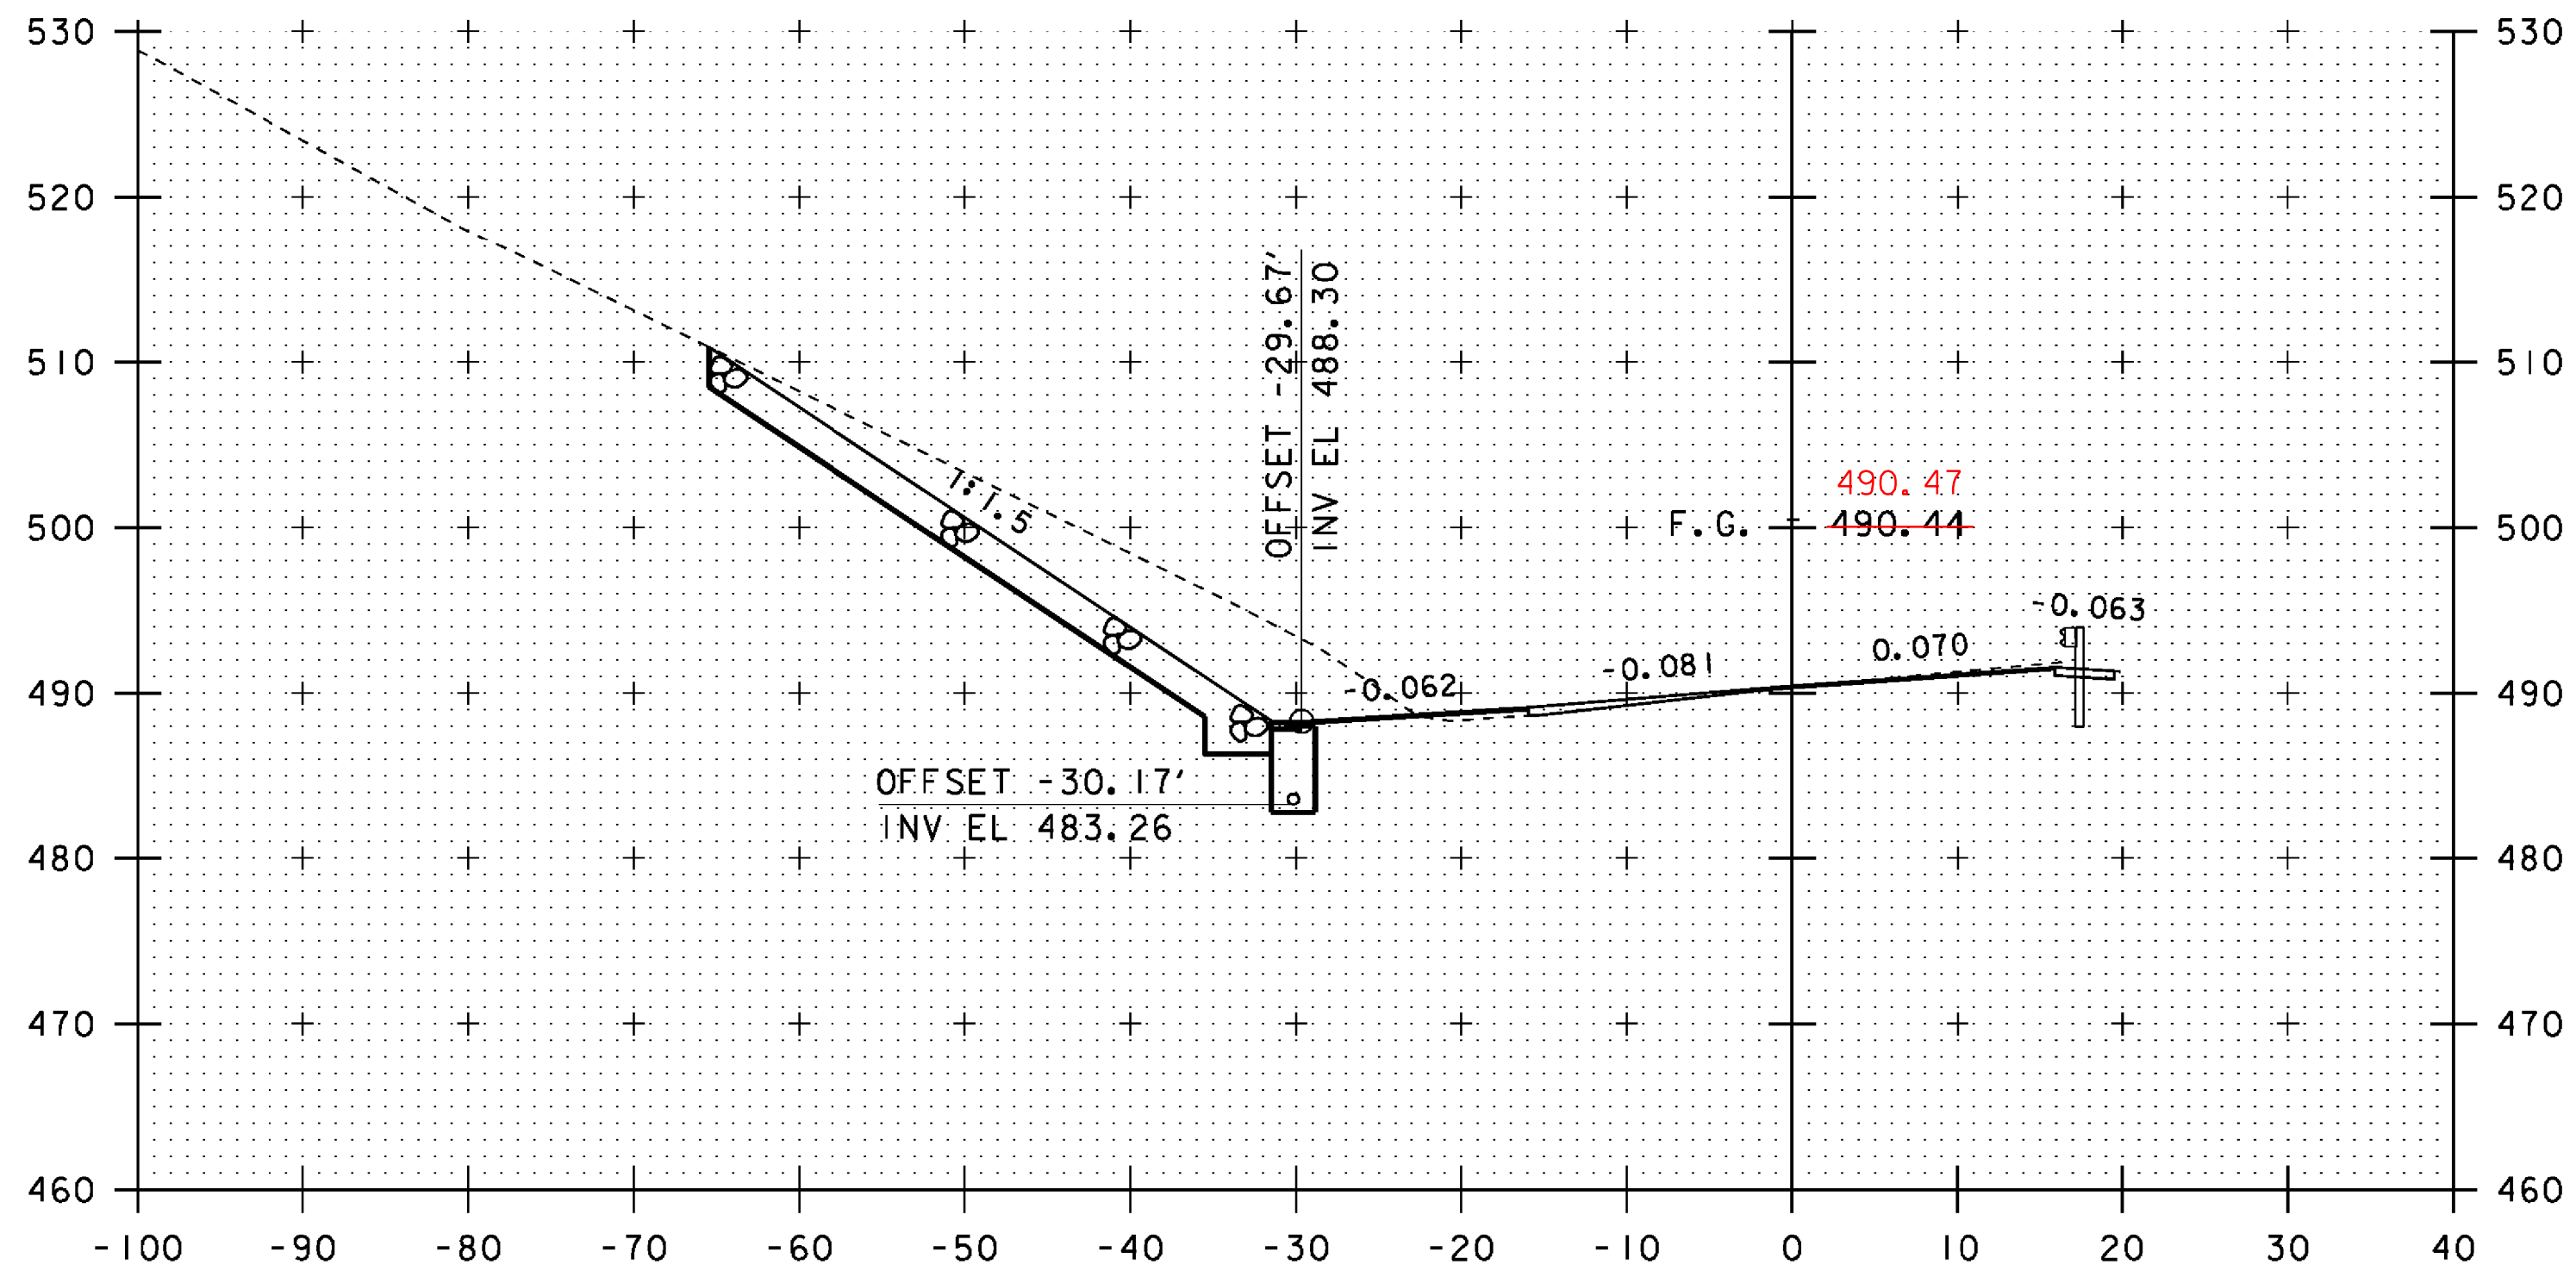


89+75

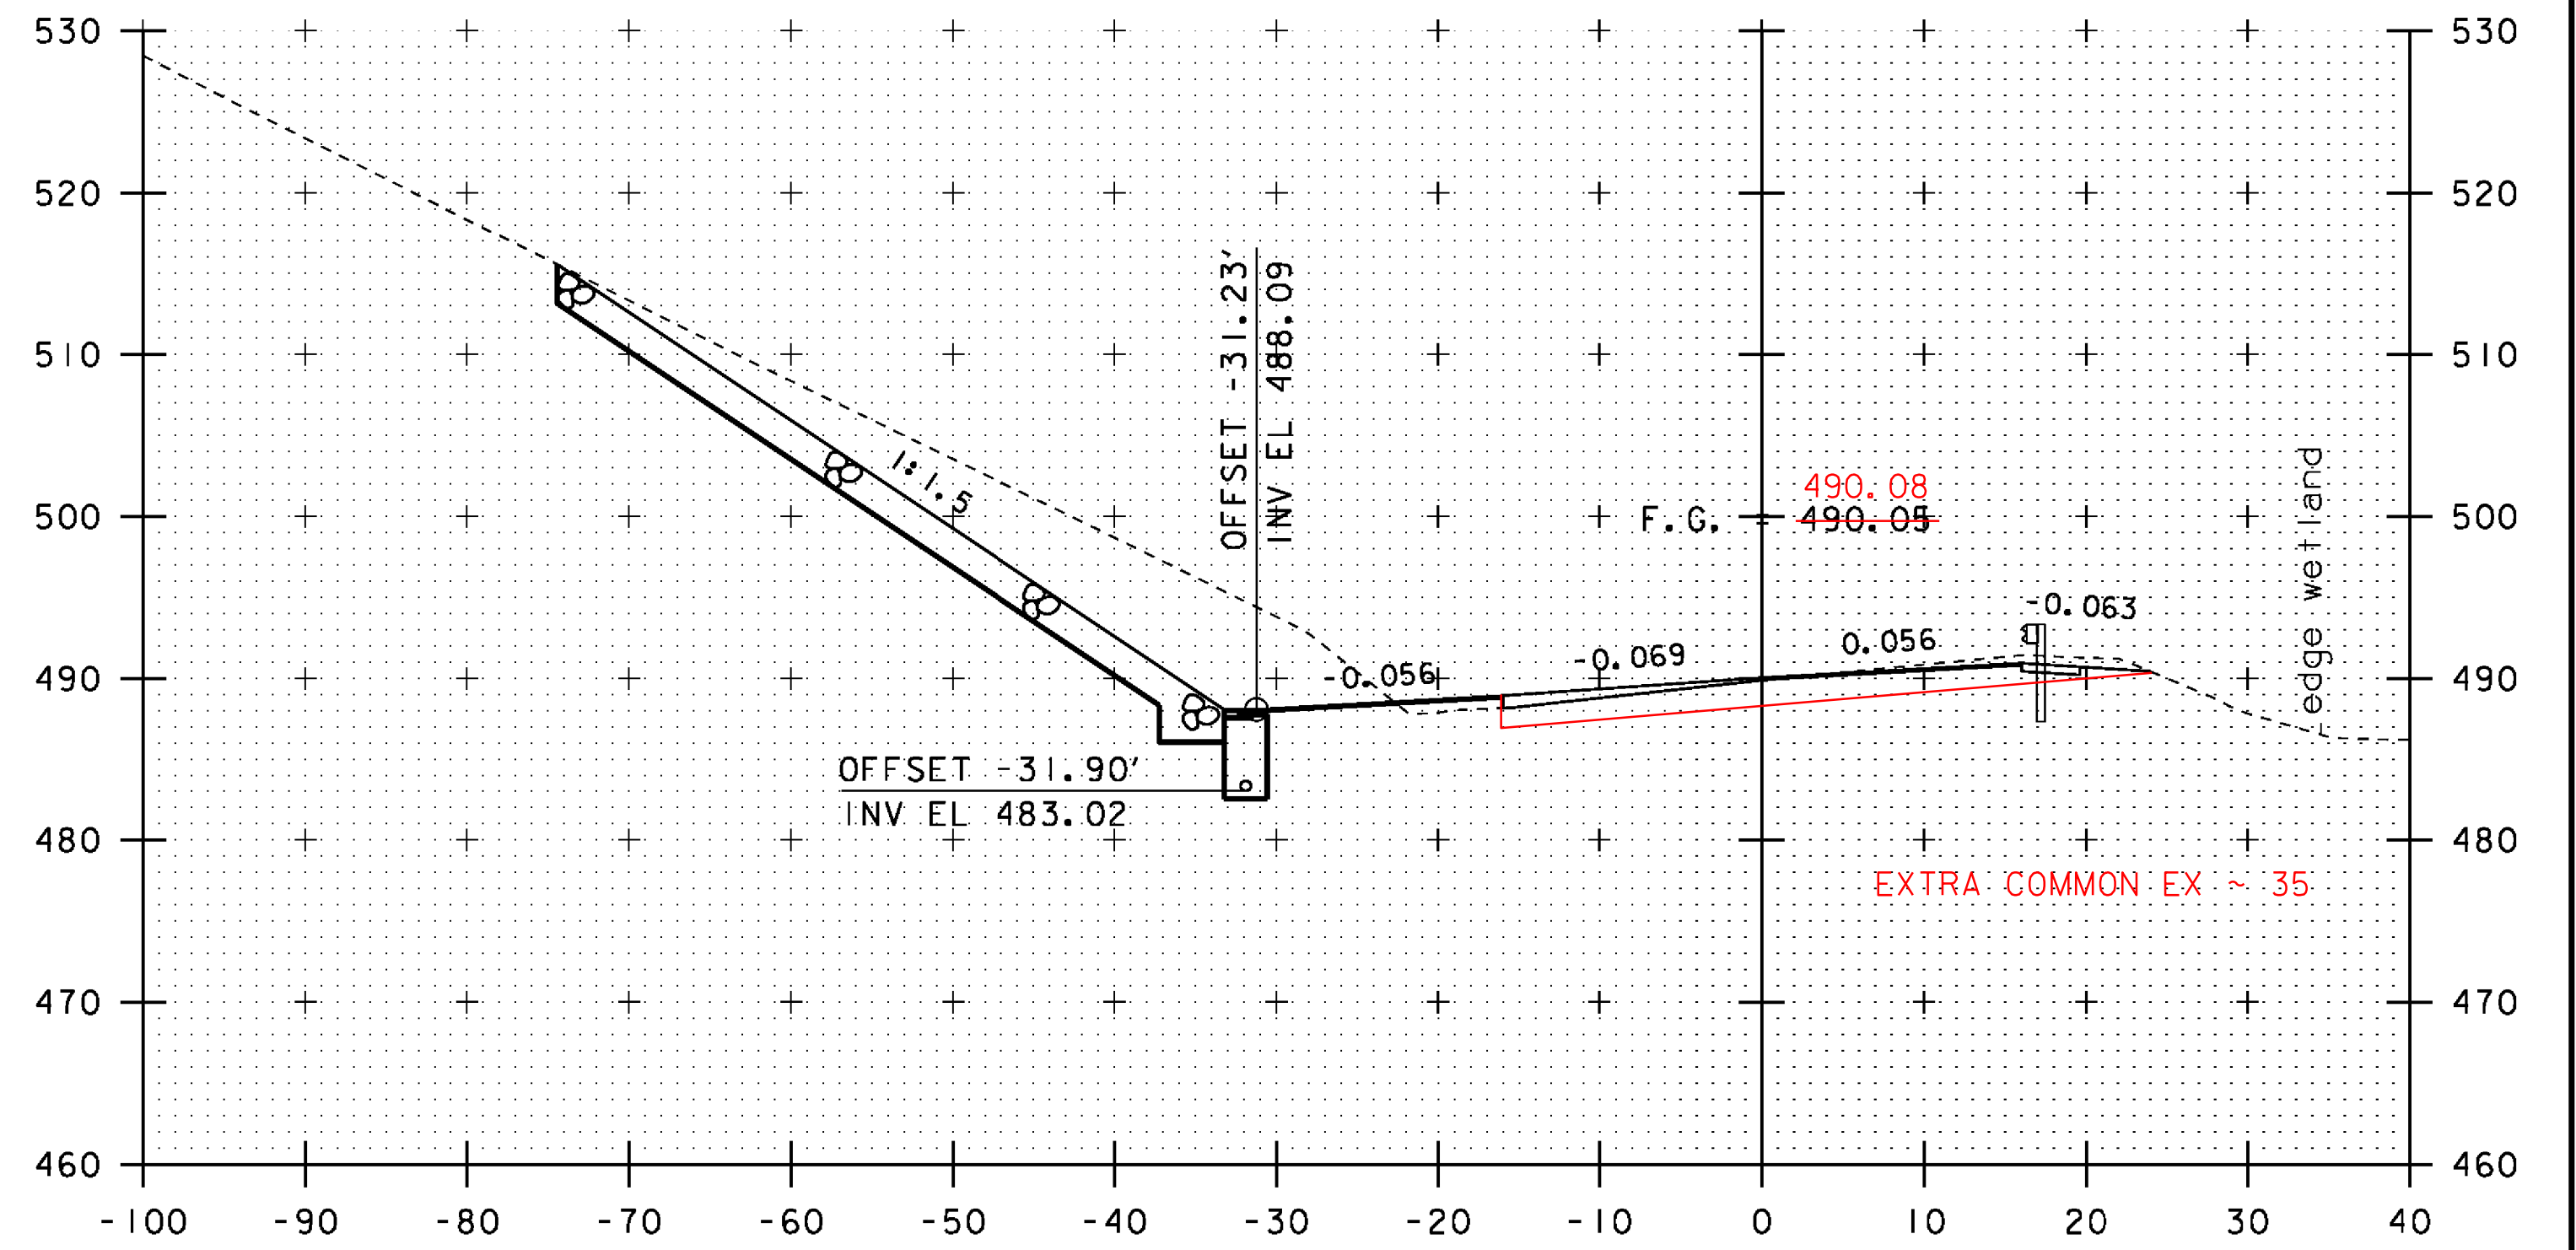

90+25

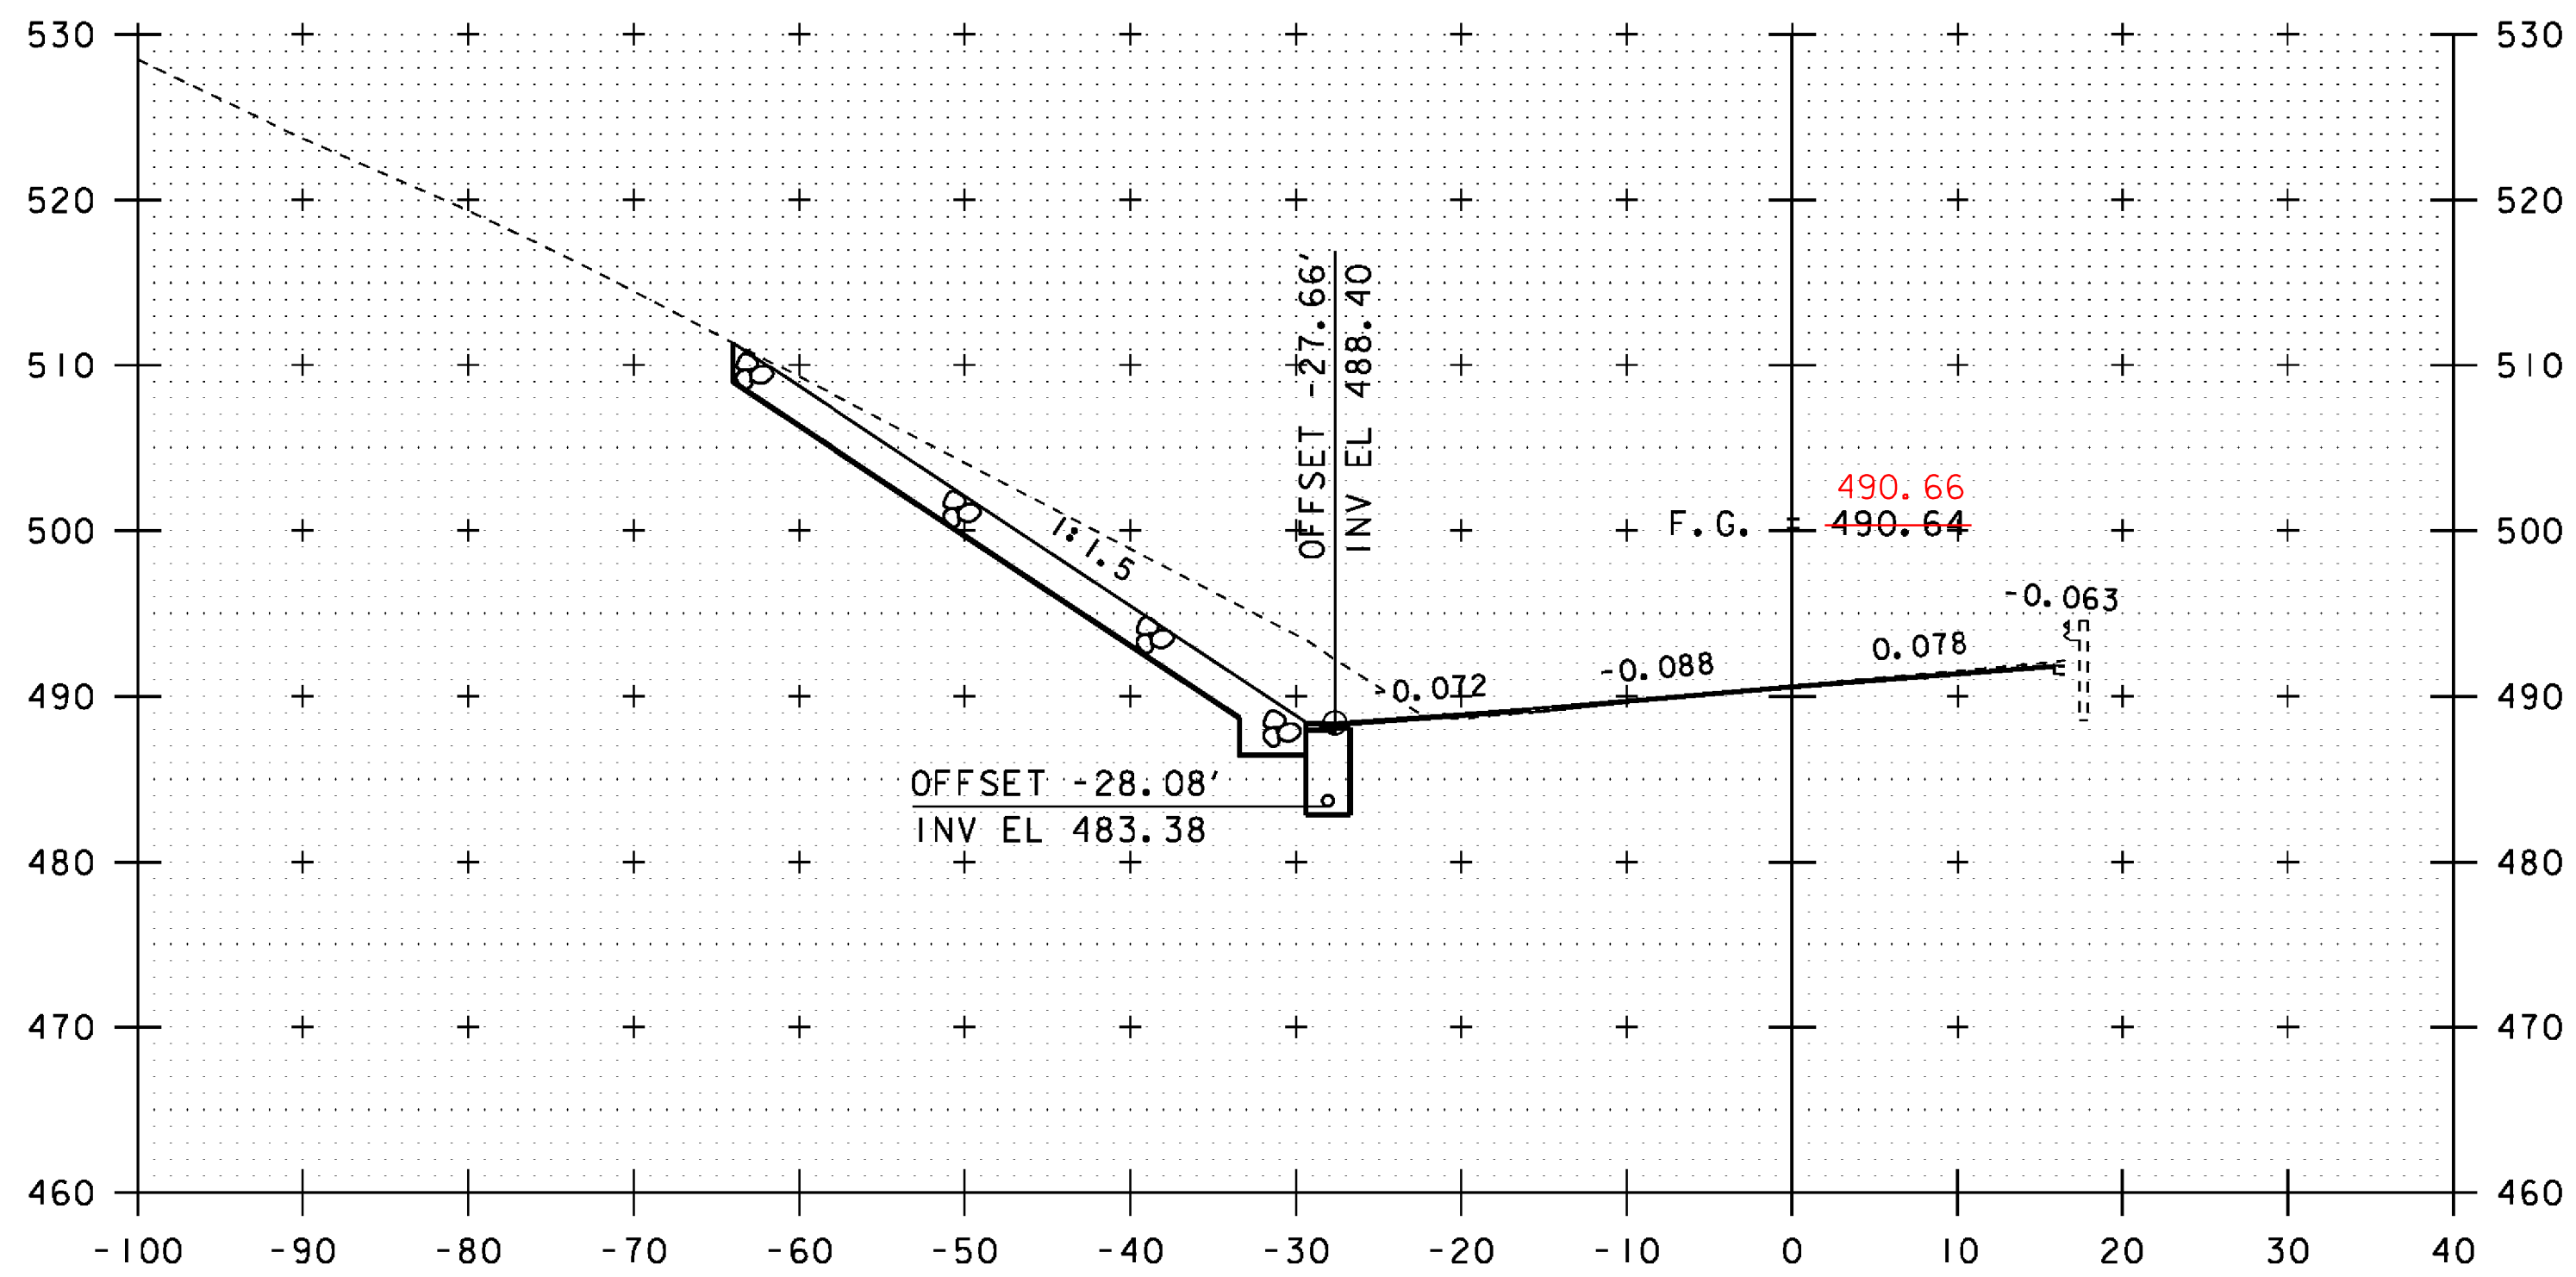

89+50

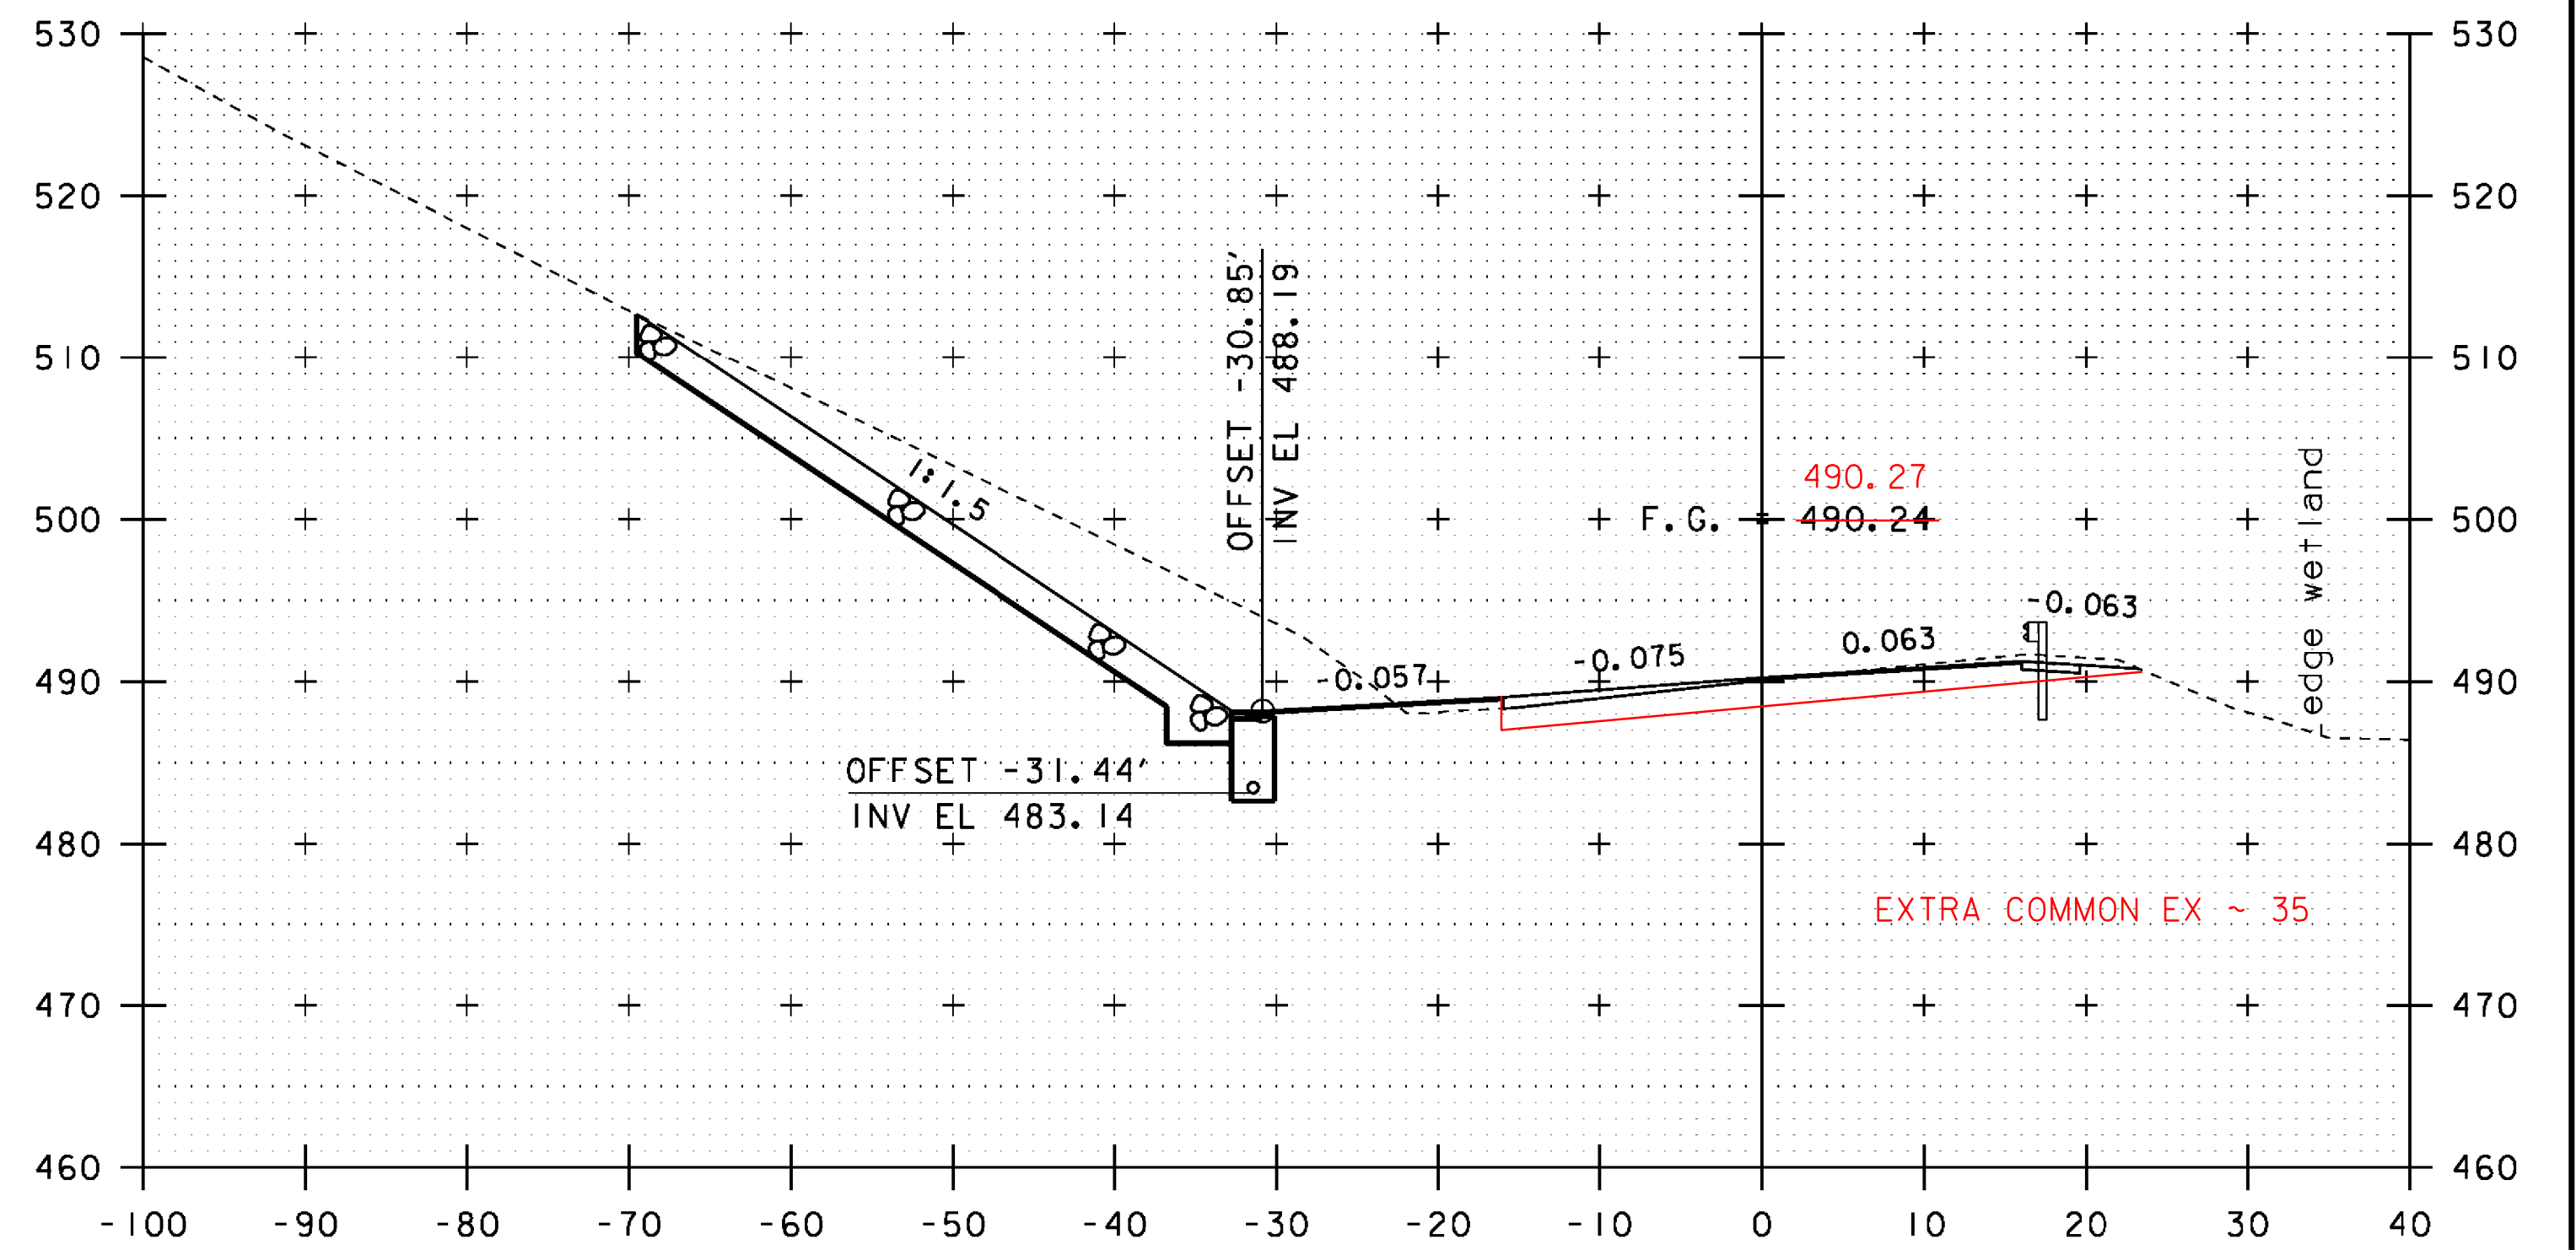

90+00


SCALE: 1" = 10'-0"

STA. 89+50 TO STA. 90+25


PROJECT NAME: JOHNSON  
 PROJECT NUMBER: BRF 030-2(26)

FILE NAME: s88bi93xsl.dgn  
 PROJECT LEADER: C. CARLSON  
 DESIGNED BY: H. SALLS  
 VT 15 CROSS SECTIONS (2)


PLOT DATE: 10-JUN-2014  
 DRAWN BY: G. ROY  
 CHECKED BY: H. SALLS  
 SHEET 43 OF 69

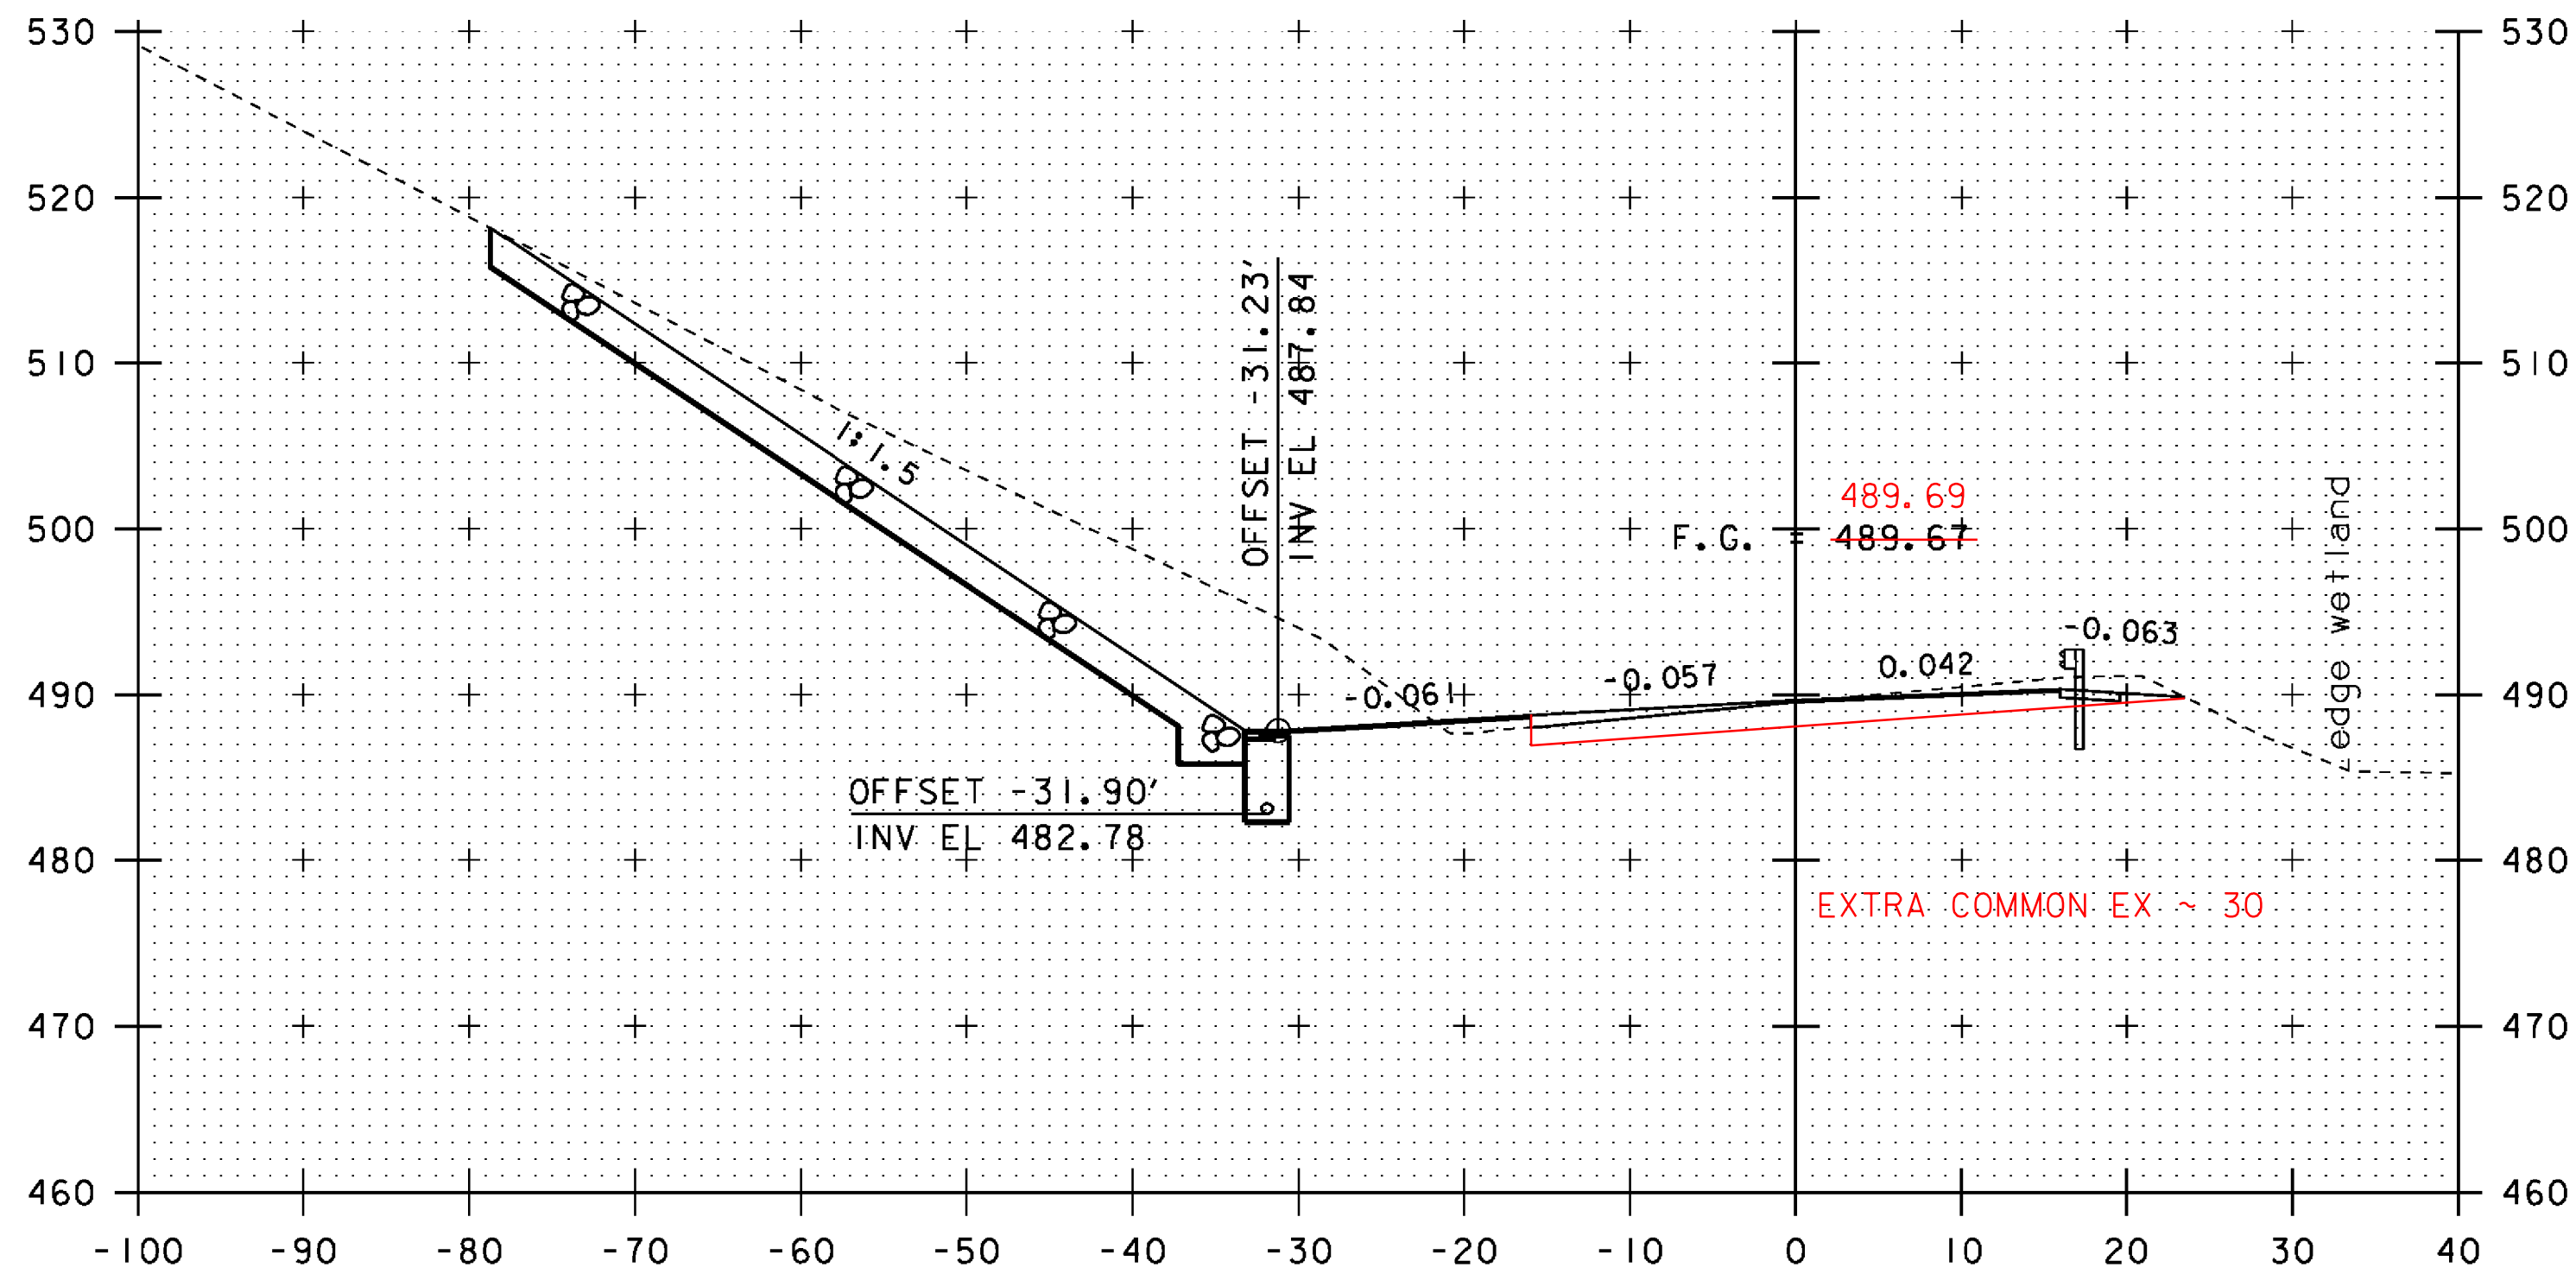


90+75

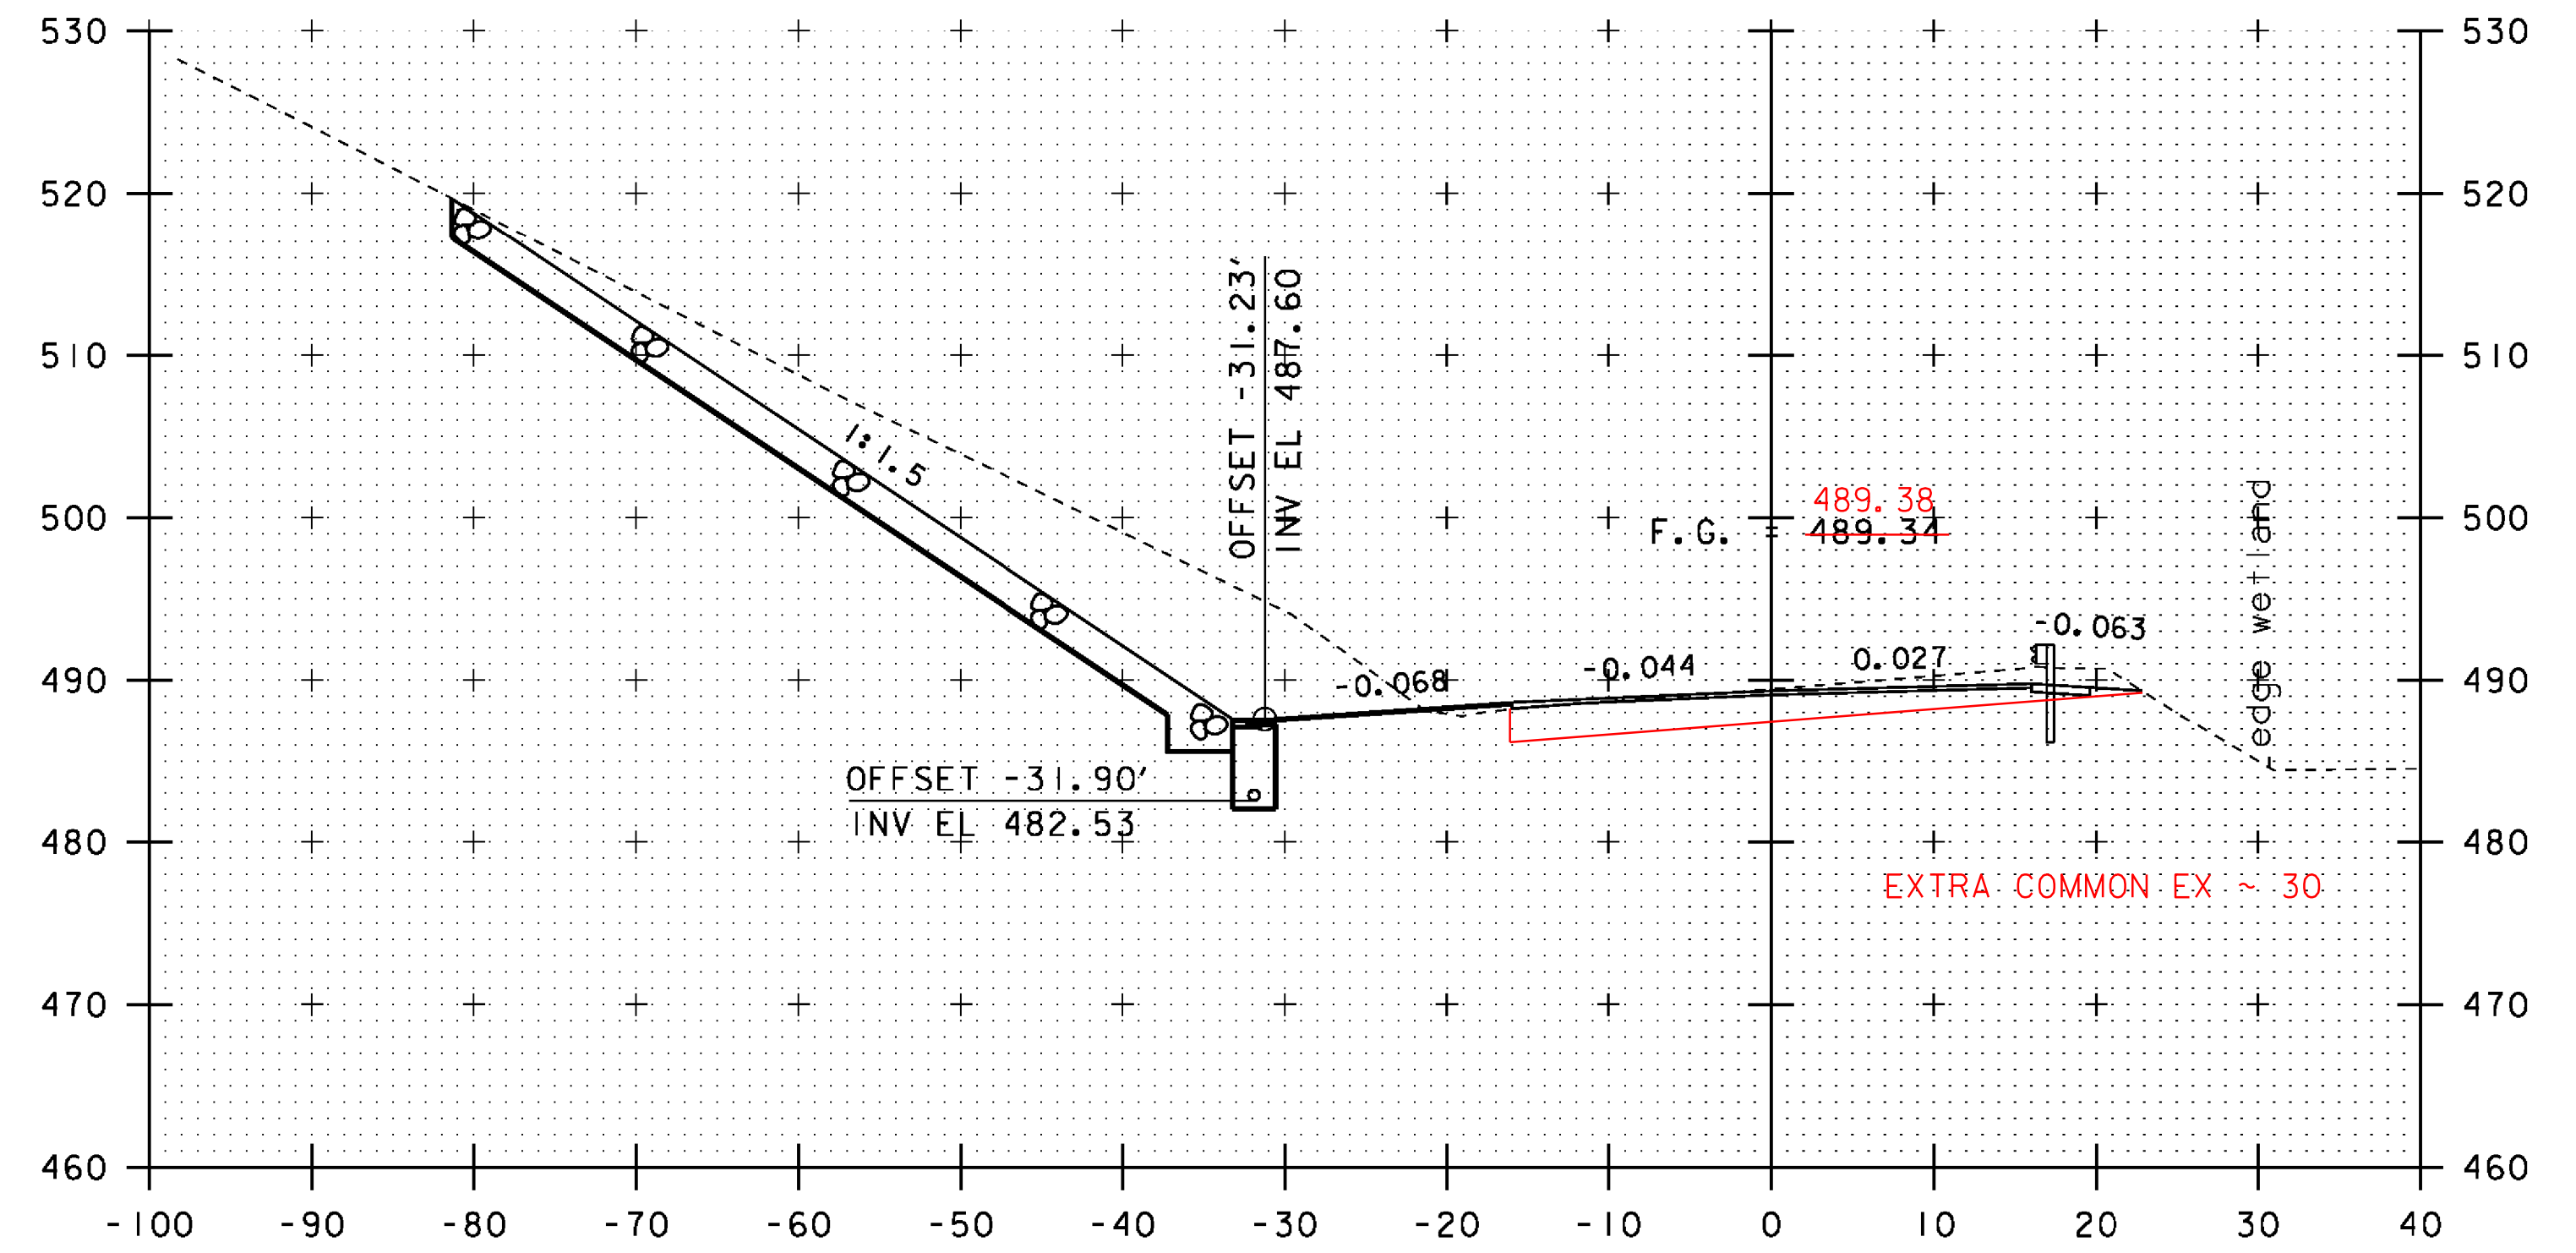


91+25

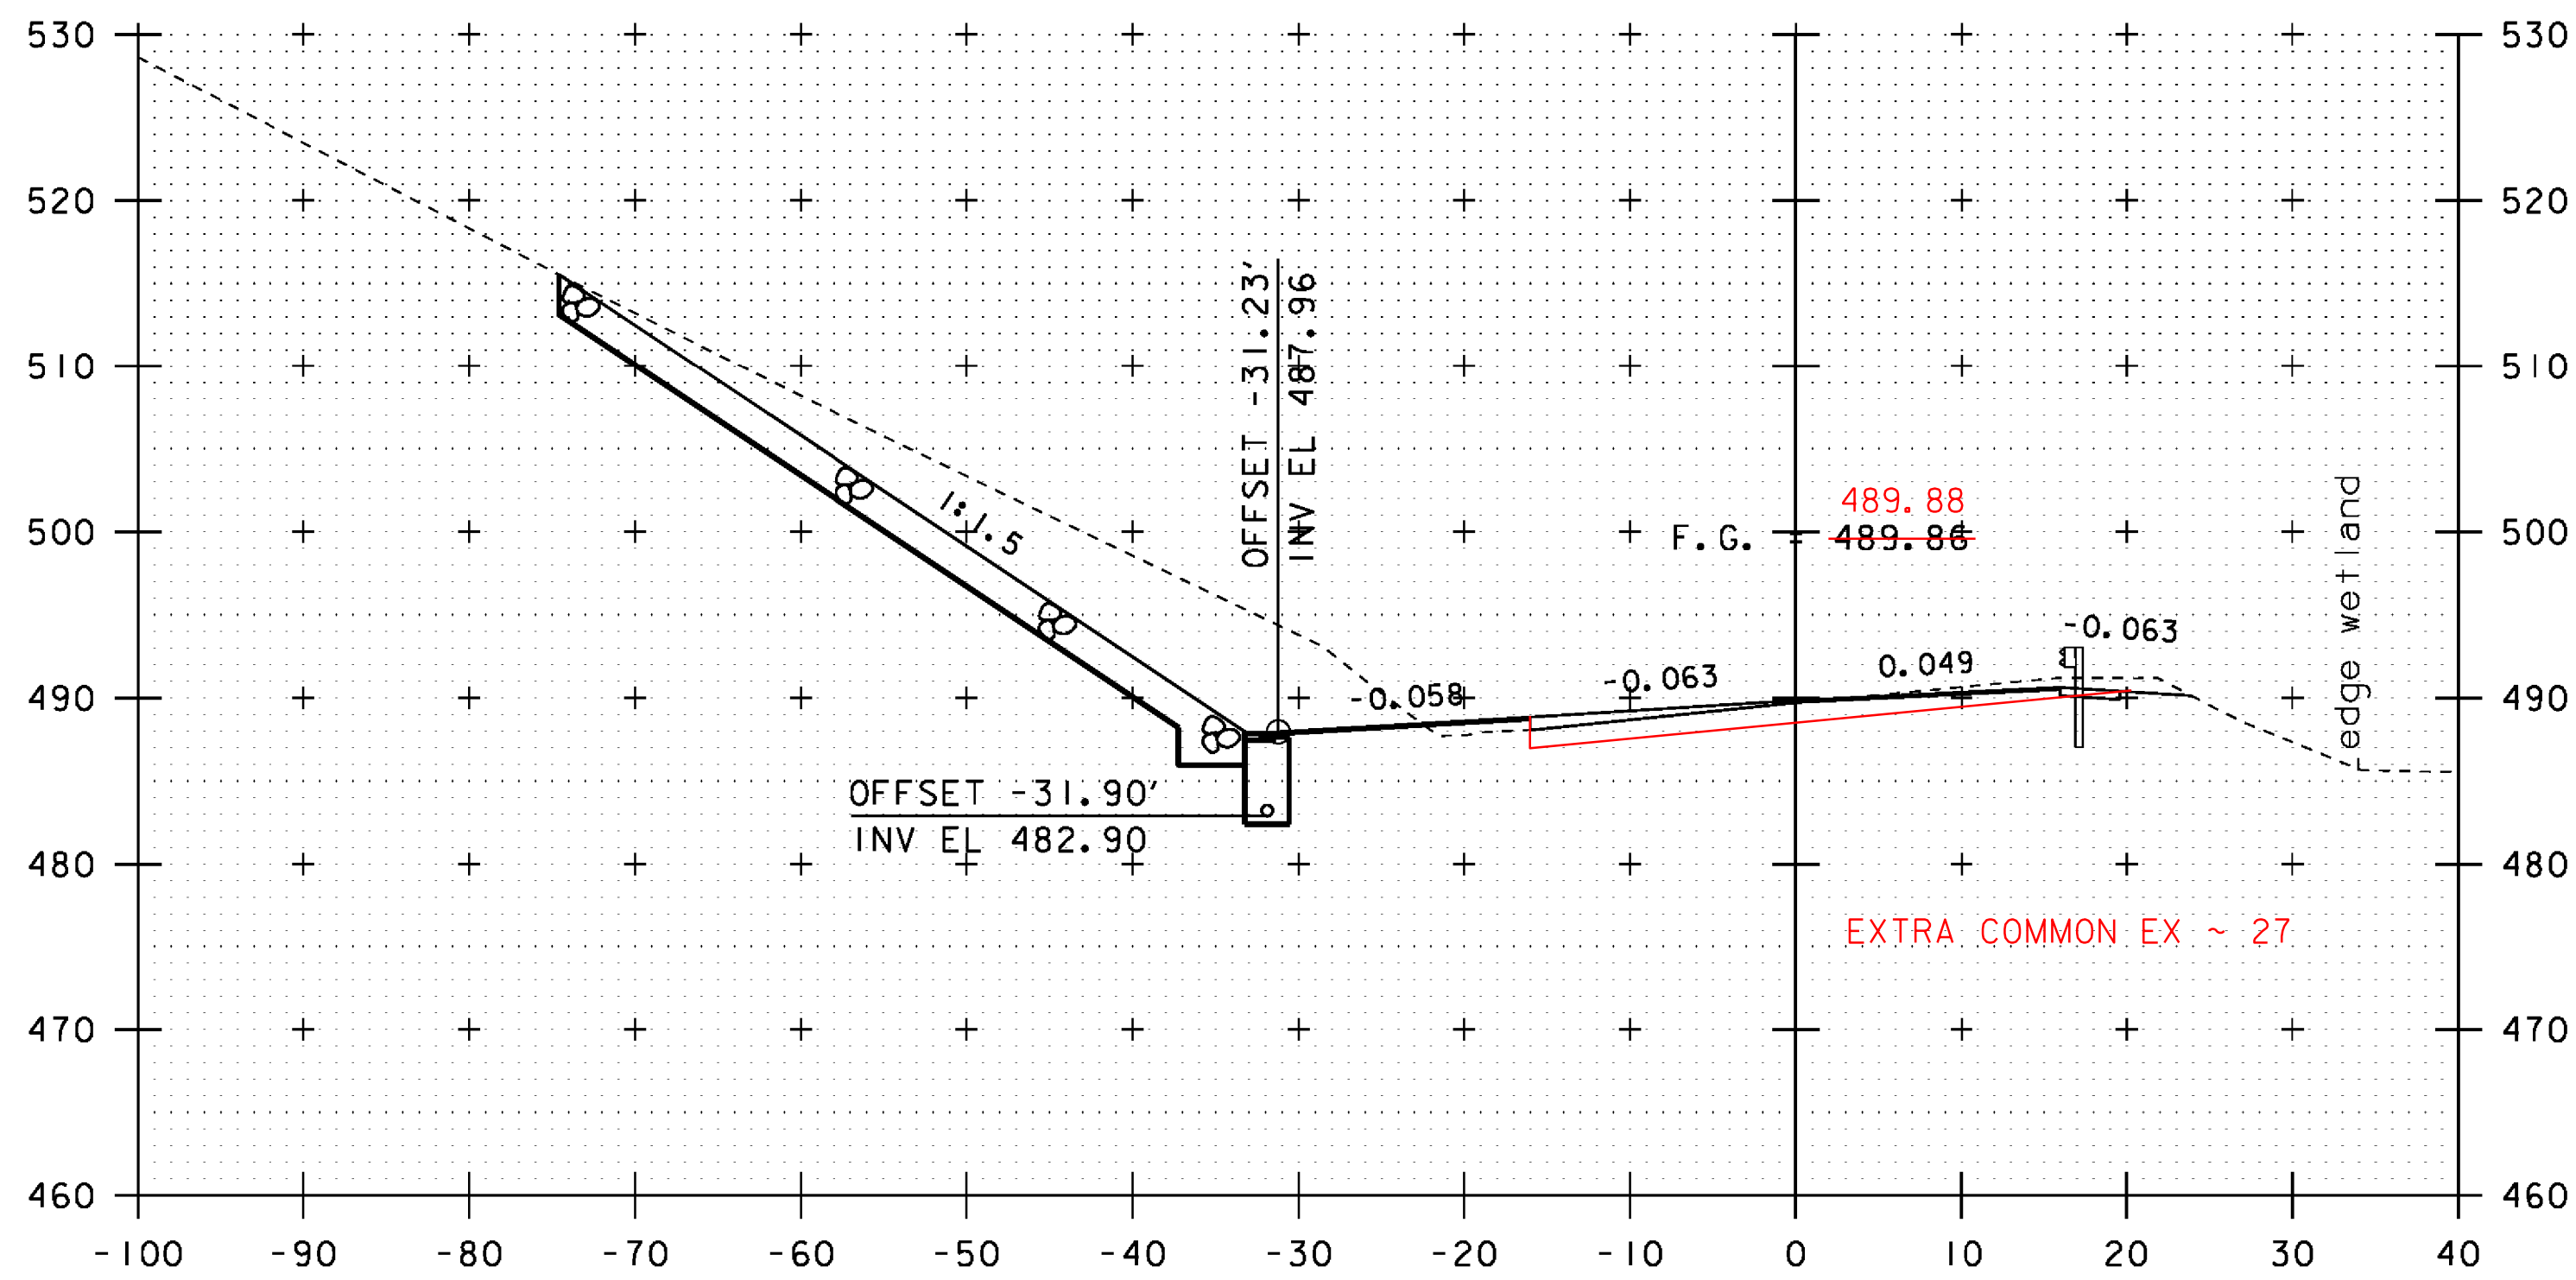

90+50

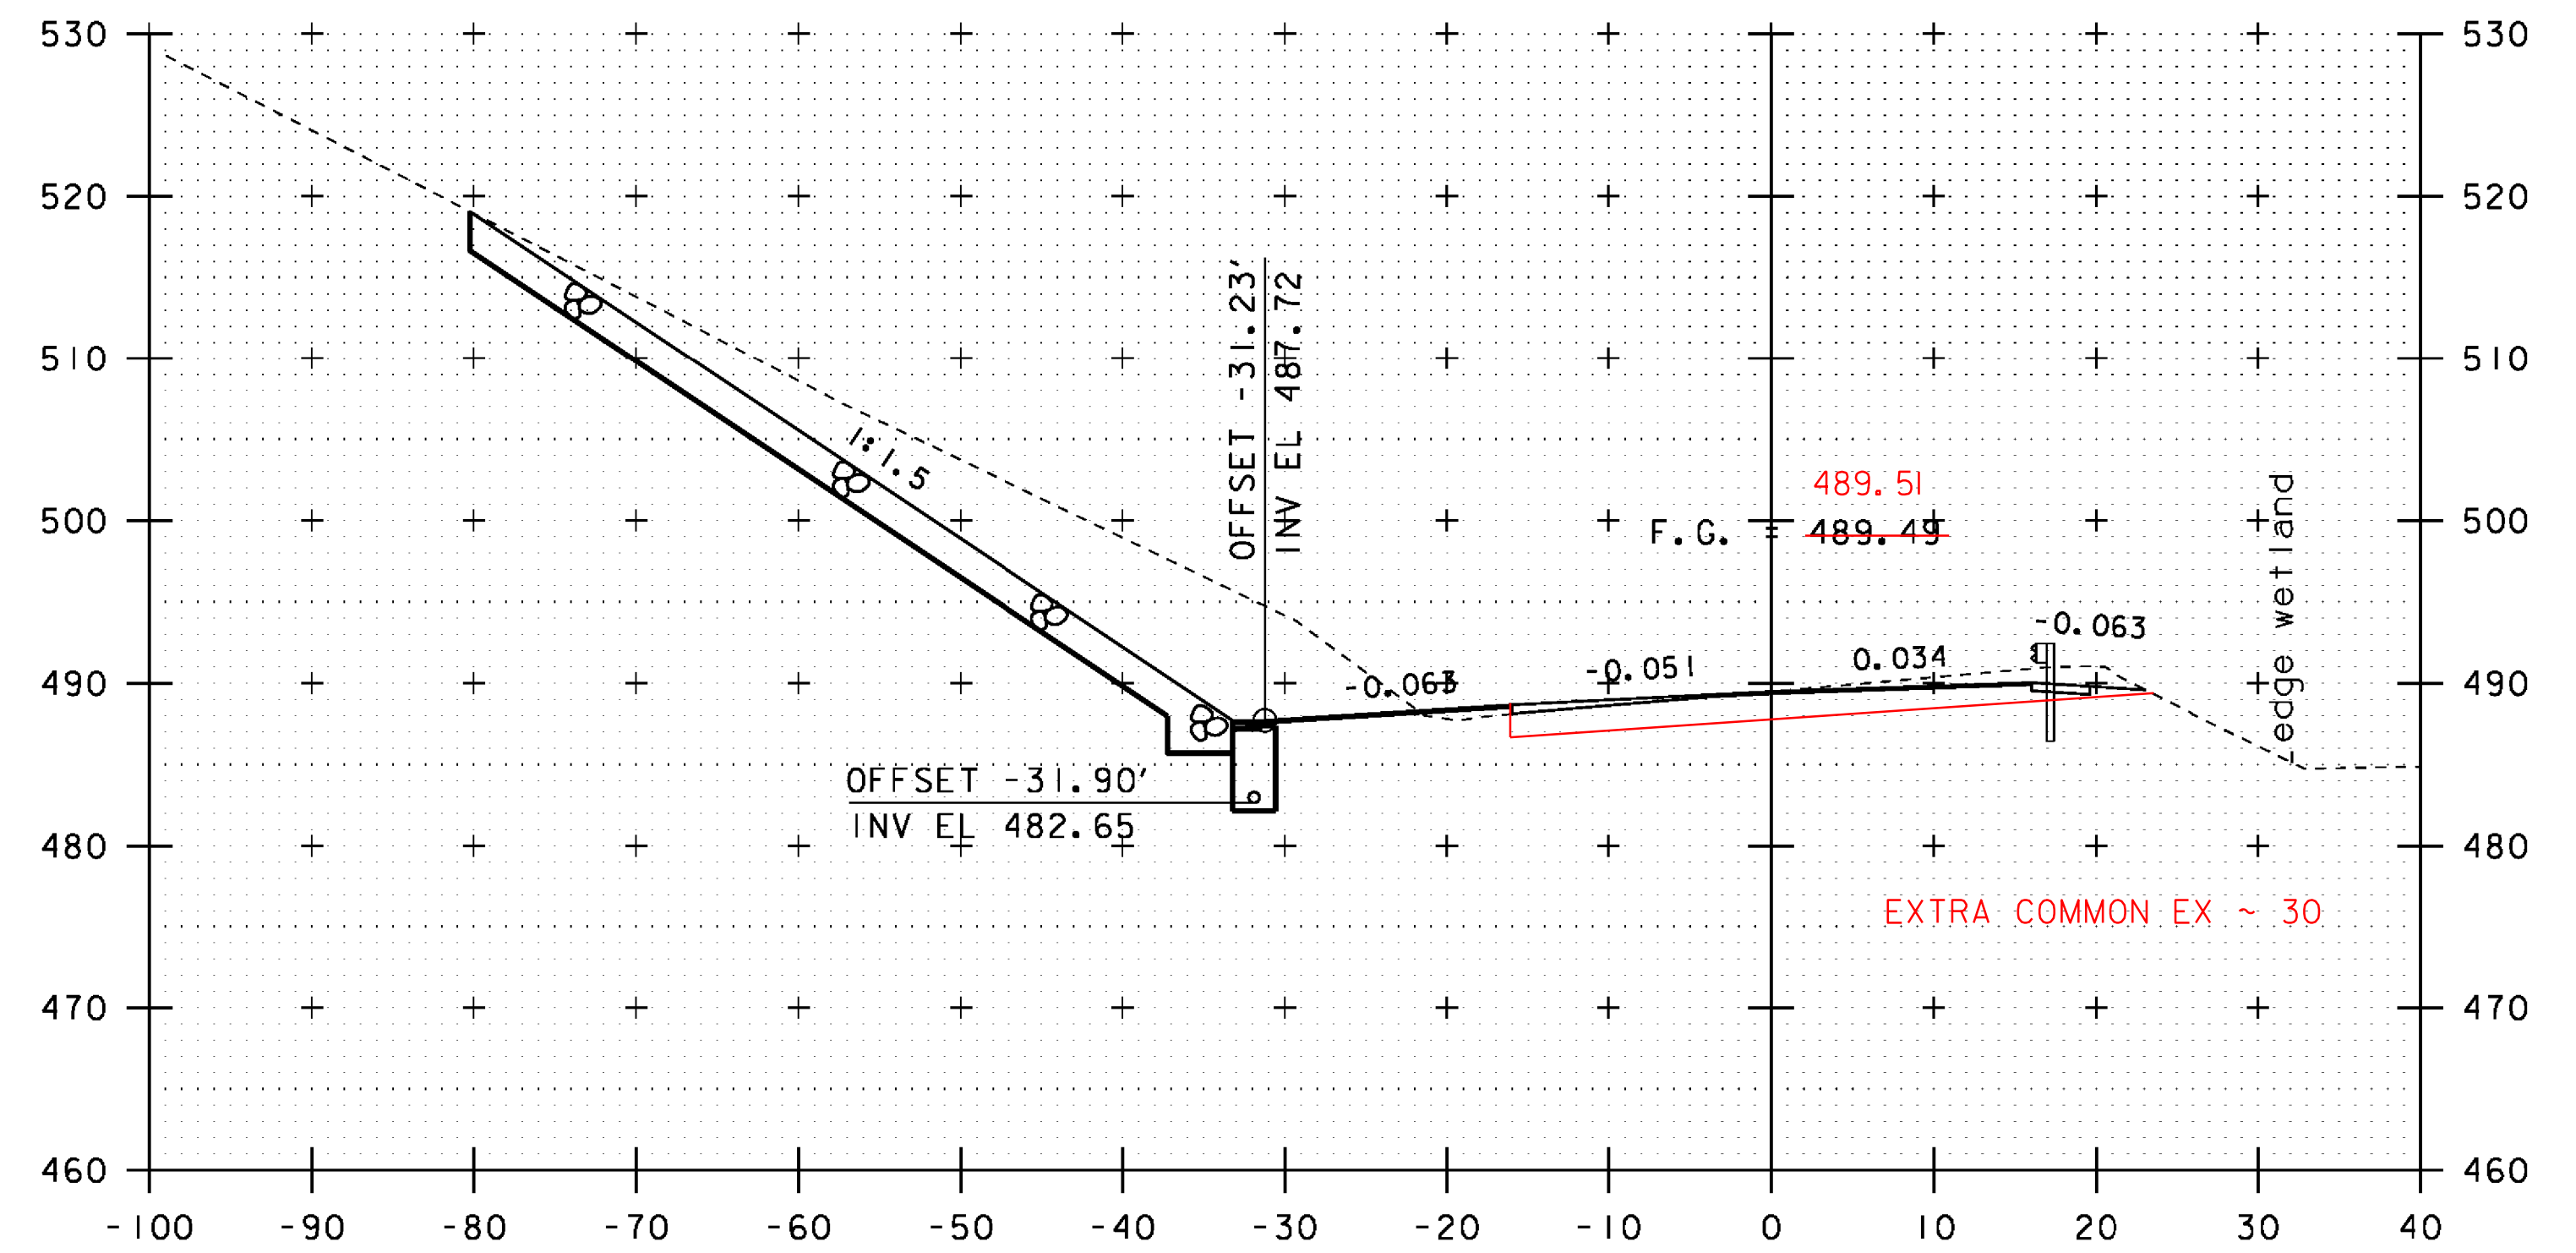

91+00

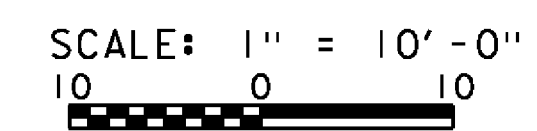


STA. 90+50 TO STA. 91+25


PROJECT NAME: JOHNSON  
PROJECT NUMBER: BRF 030-2(26)

FILE NAME: s88bi93xsl.dgn  
PROJECT LEADER: C. CARLSON  
DESIGNED BY: H. SALLS  
VT 15 CROSS SECTIONS (3)


PLOT DATE: 10-JUN-2014  
DRAWN BY: G. ROY  
CHECKED BY: H. SALLS  
SHEET 44 OF 69

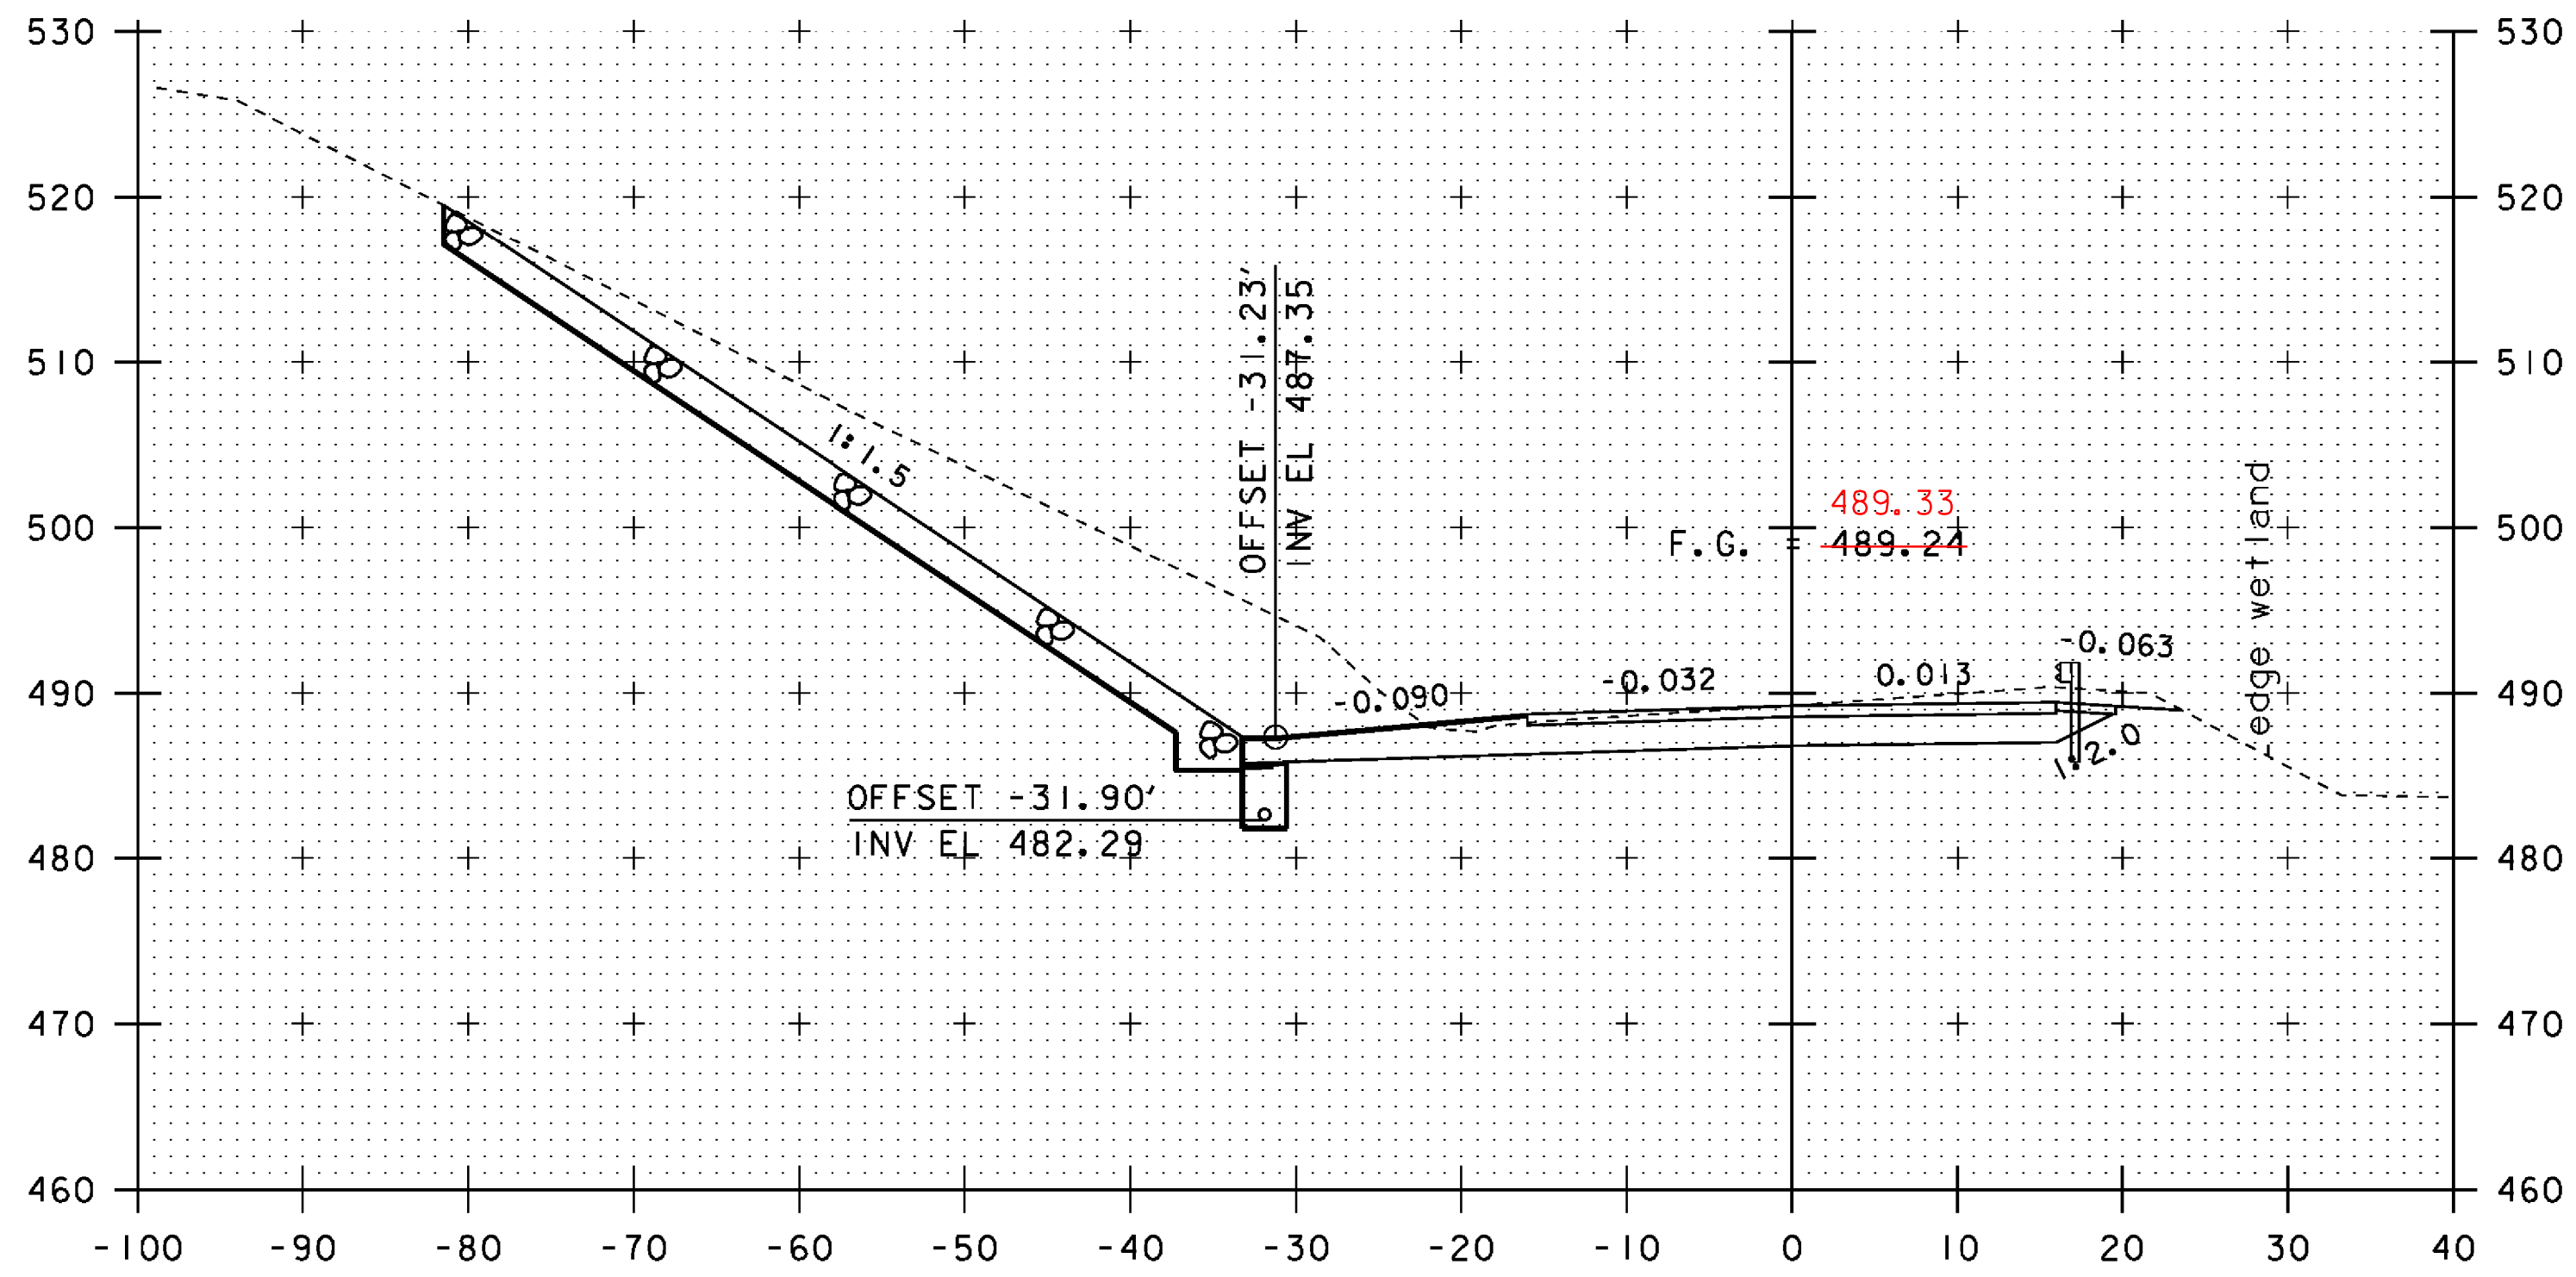


91+75

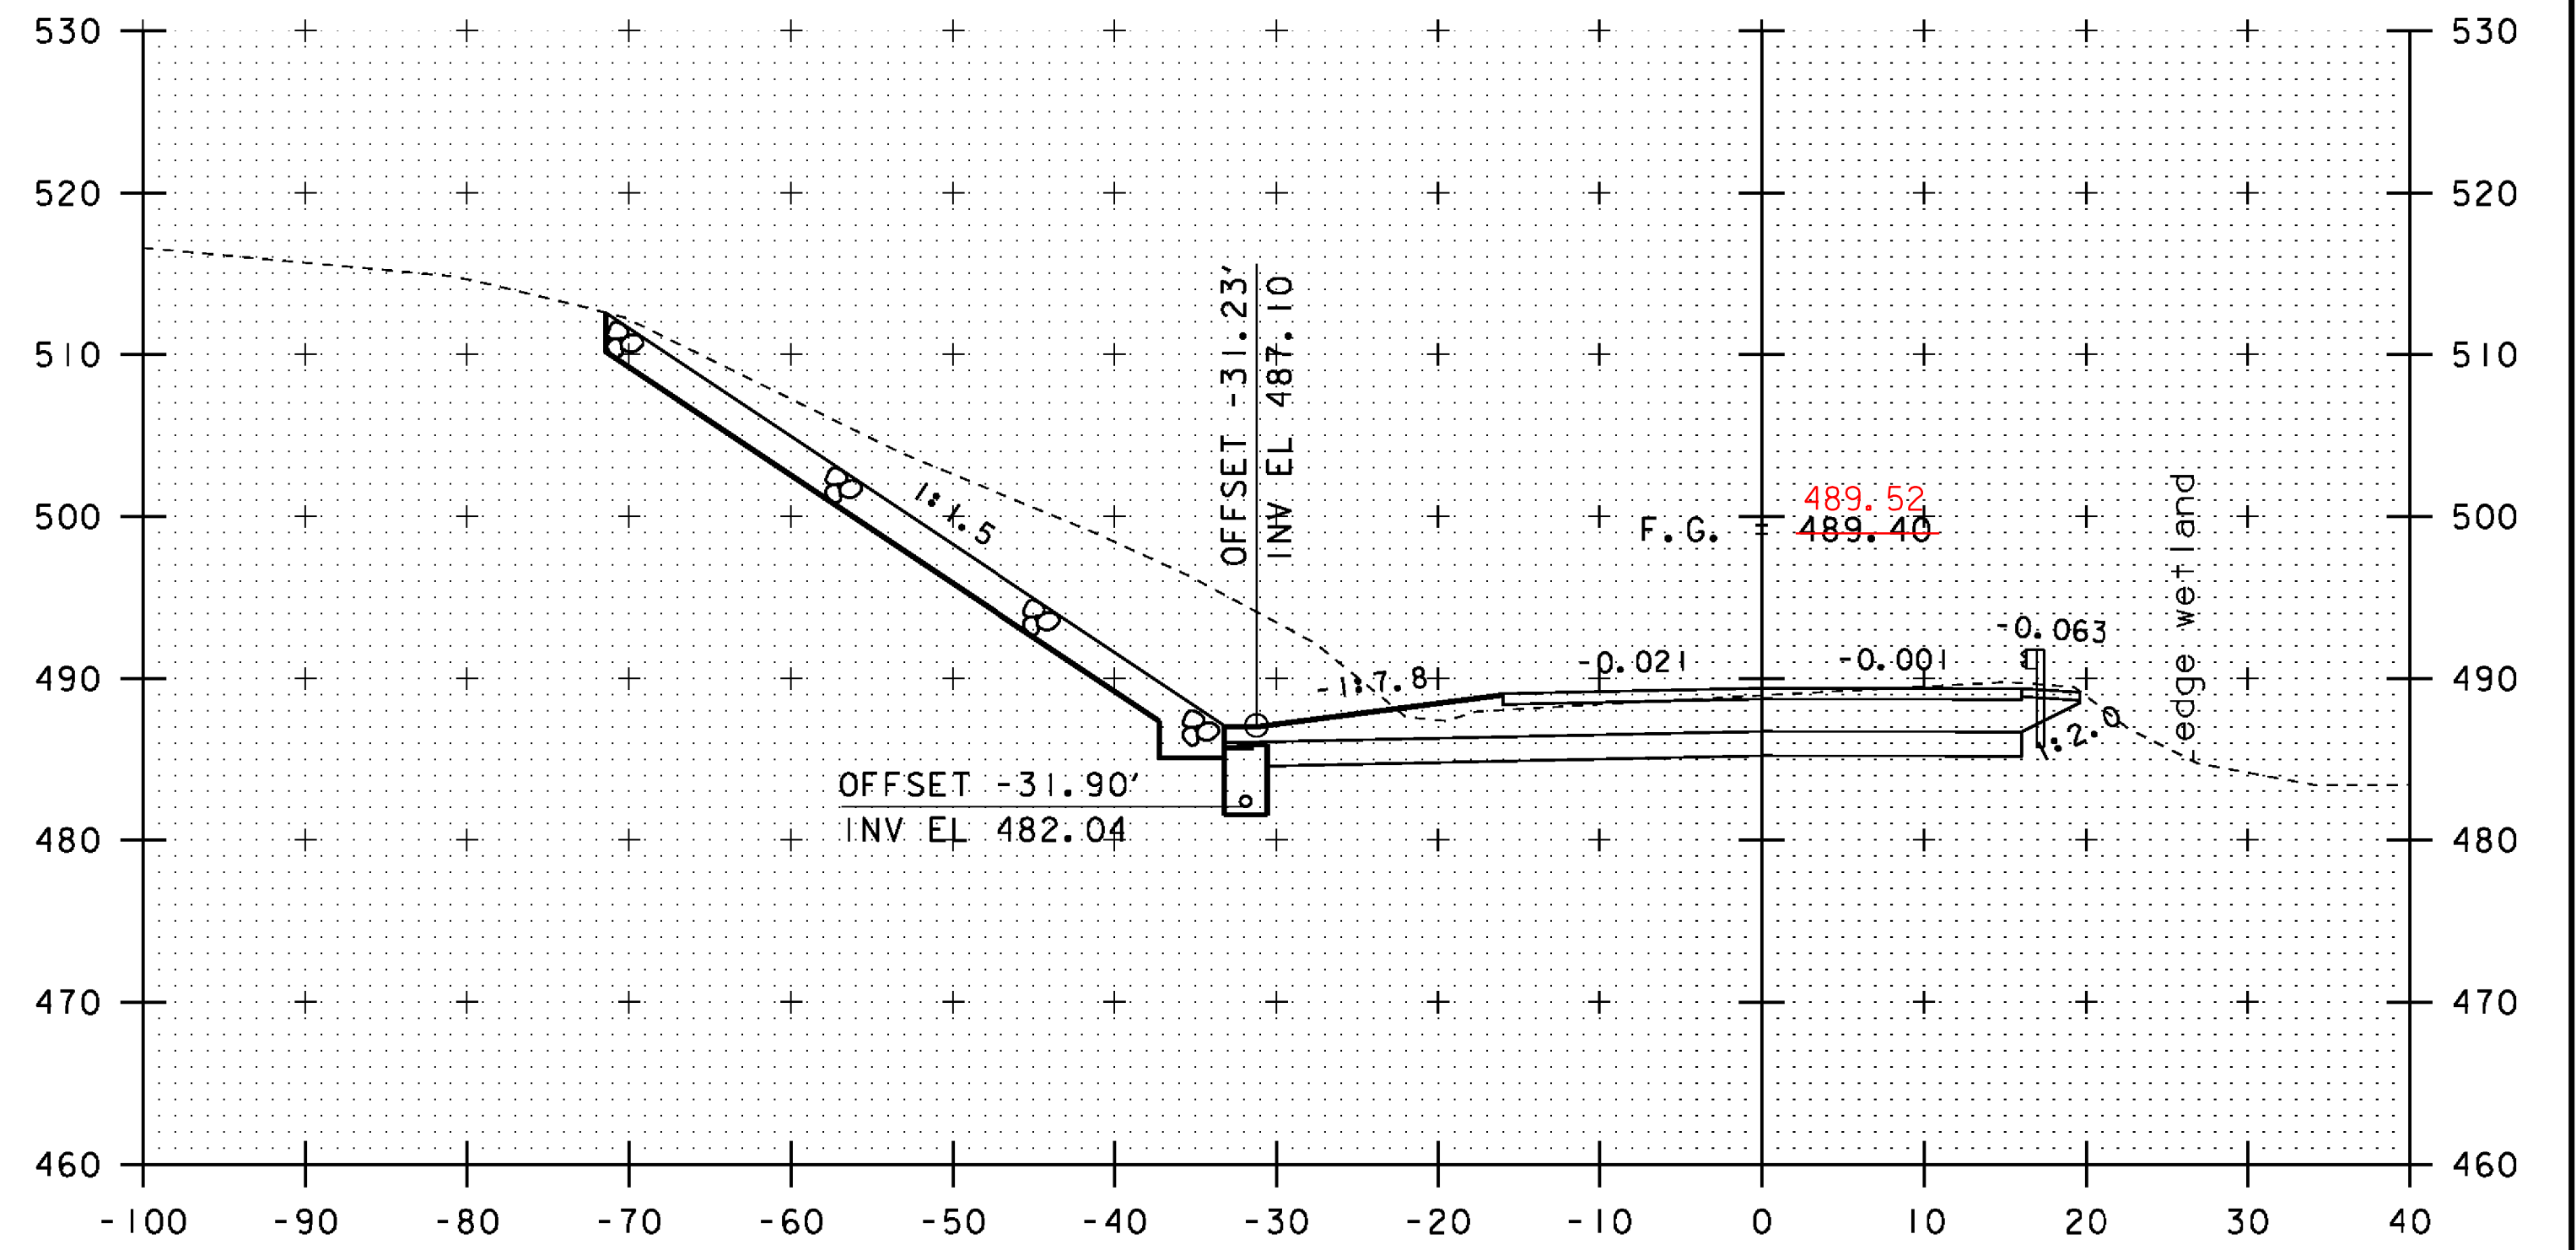

92+25

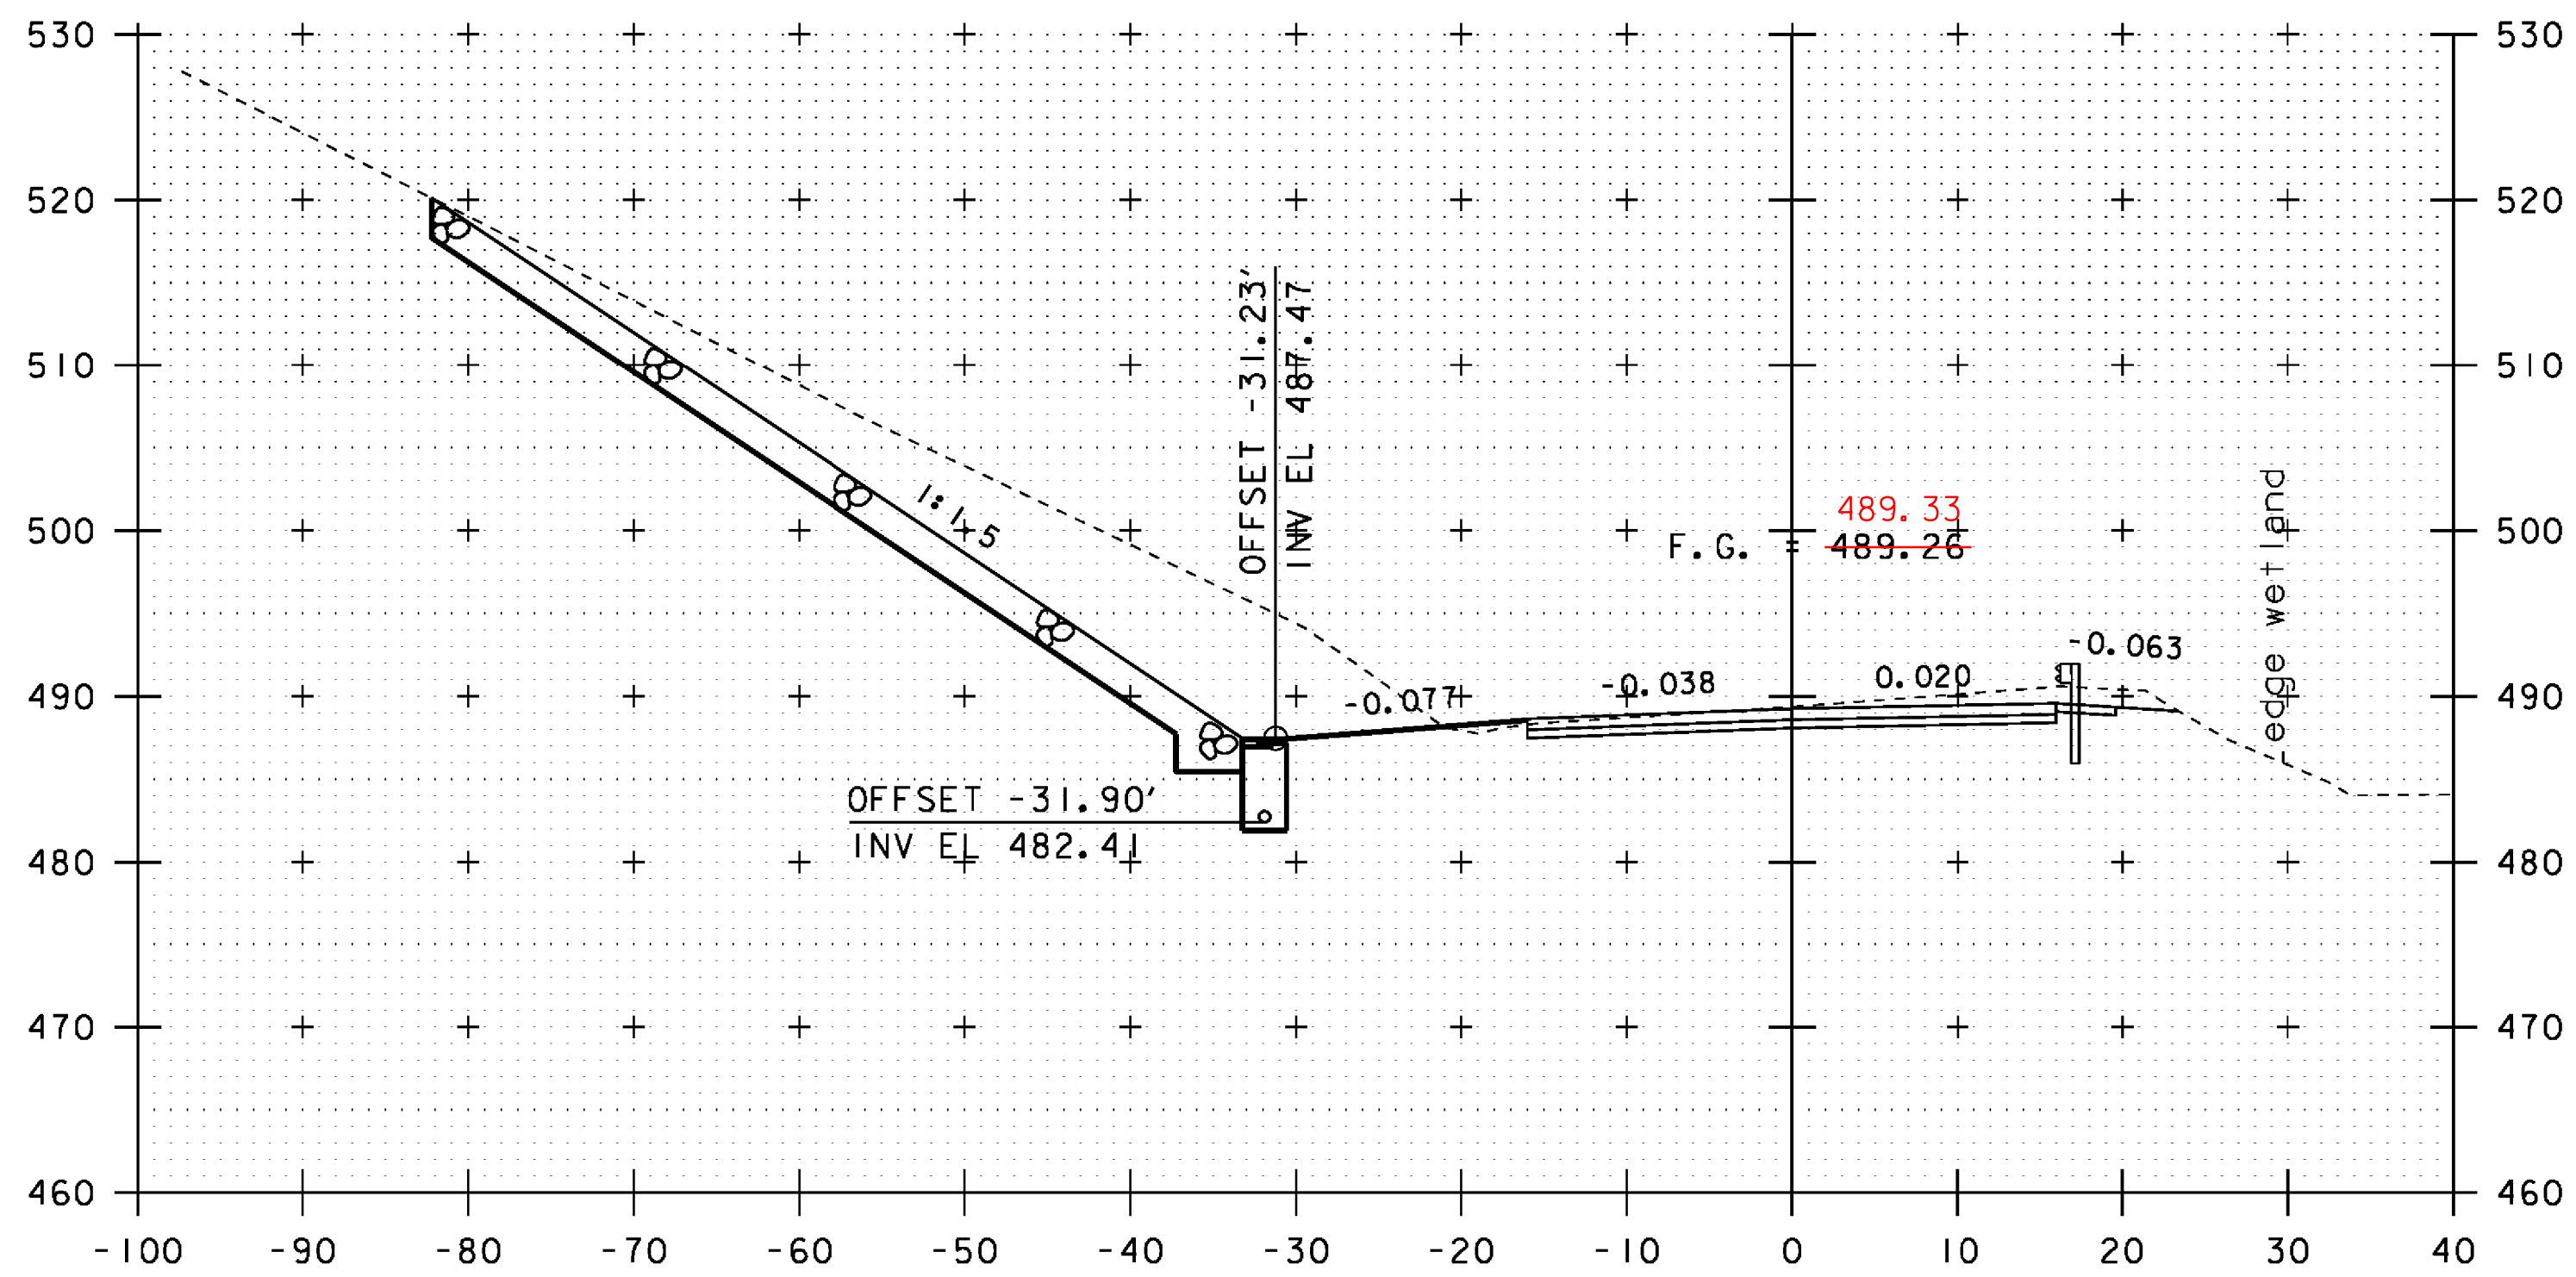

91+50

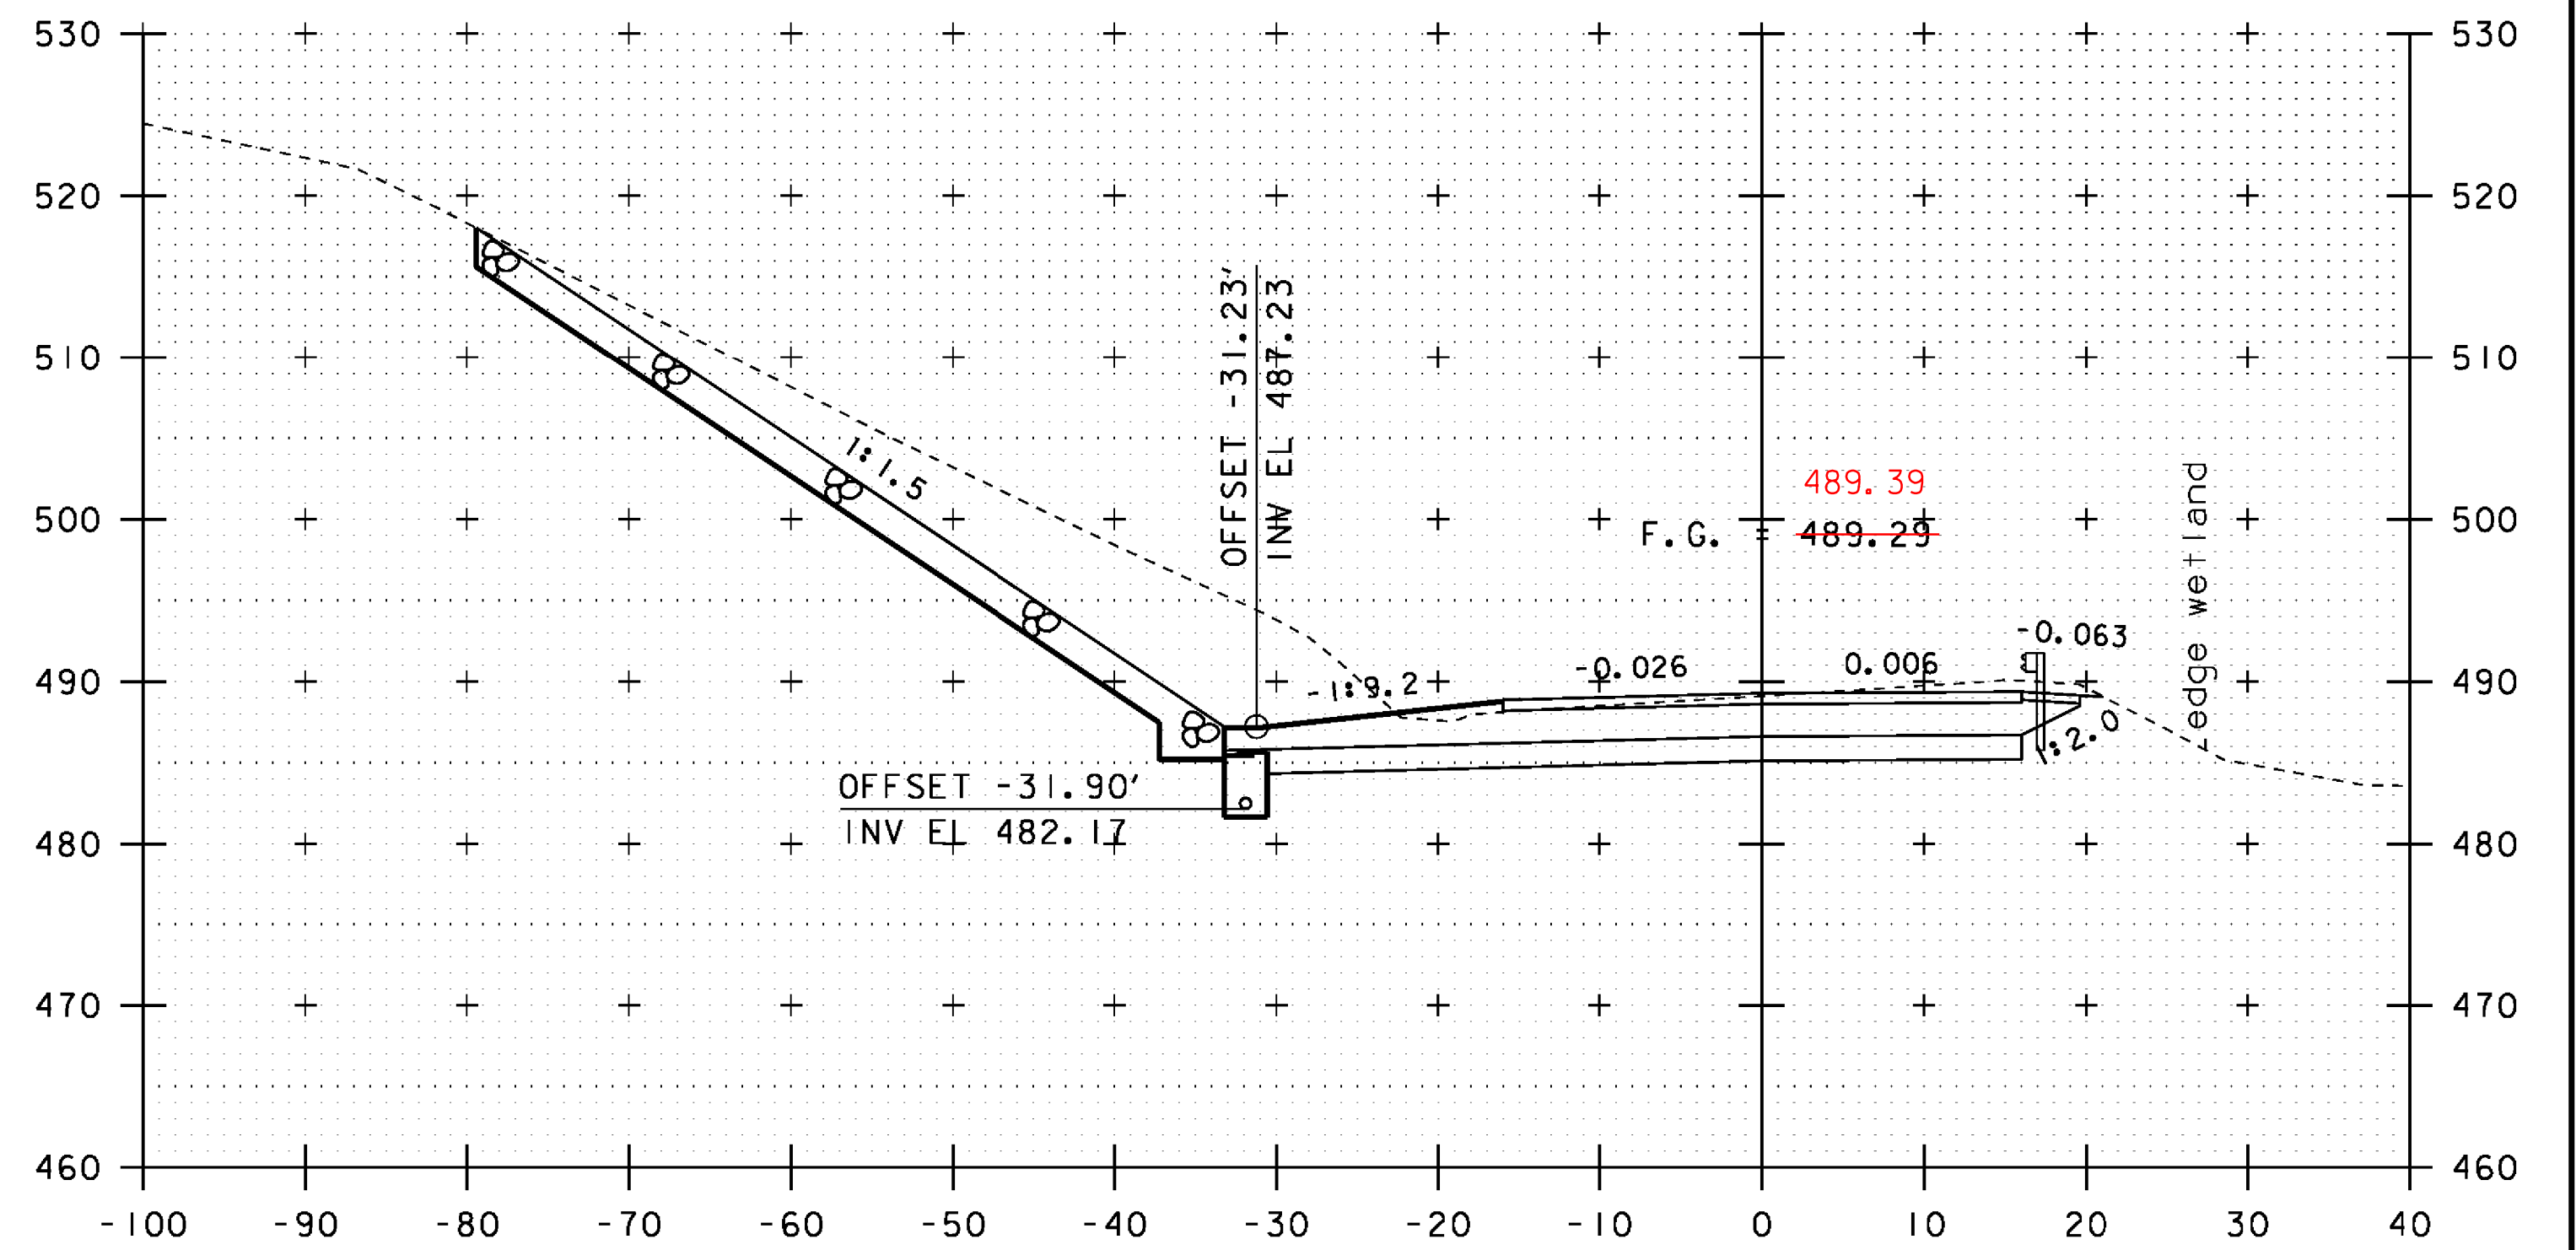

92+00



STA 92+00.00  
END APPROACH  
BEGIN PROJECT

SCALE: 1" = 10'-0"





STA. 91+50 TO STA. 92+25

PROJECT NAME: JOHNSON	PLOT DATE: 10-JUN-2014
PROJECT NUMBER: BRF 030-2(26)	DRAWN BY: G. ROY
FILE NAME: s88bi93xsl.dgn	CHECKED BY: H. SALLS
PROJECT LEADER: C. CARLSON	SHEET 45 OF 69
DESIGNED BY: H. SALLS	
VT 15 CROSS SECTIONS (4)	

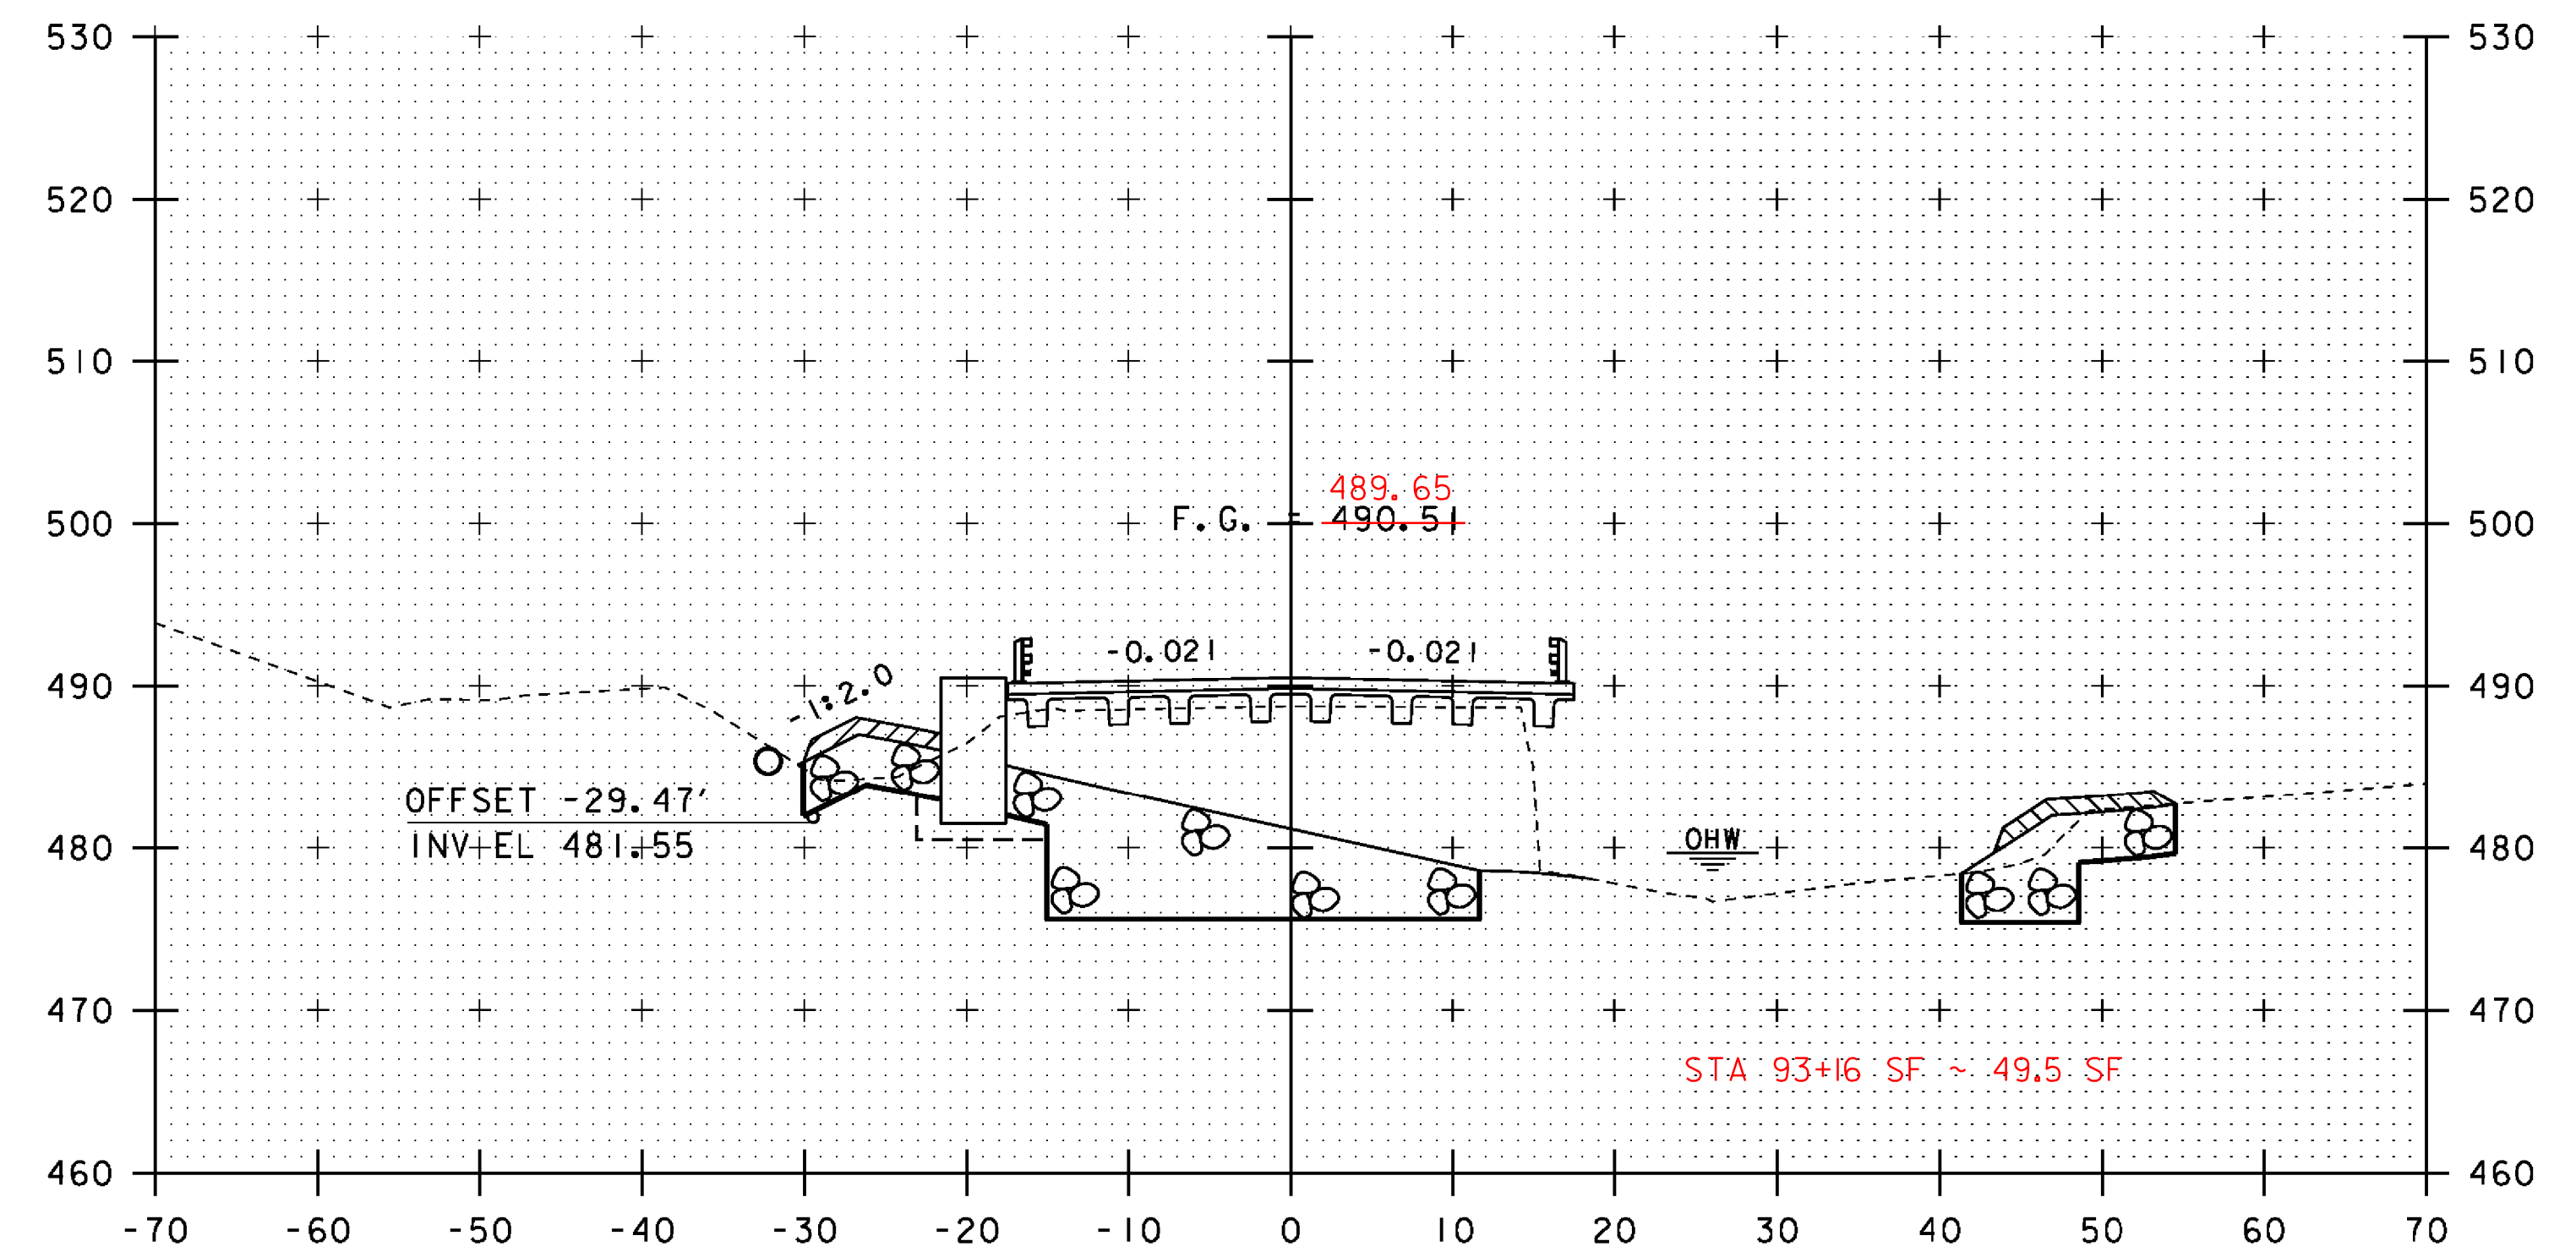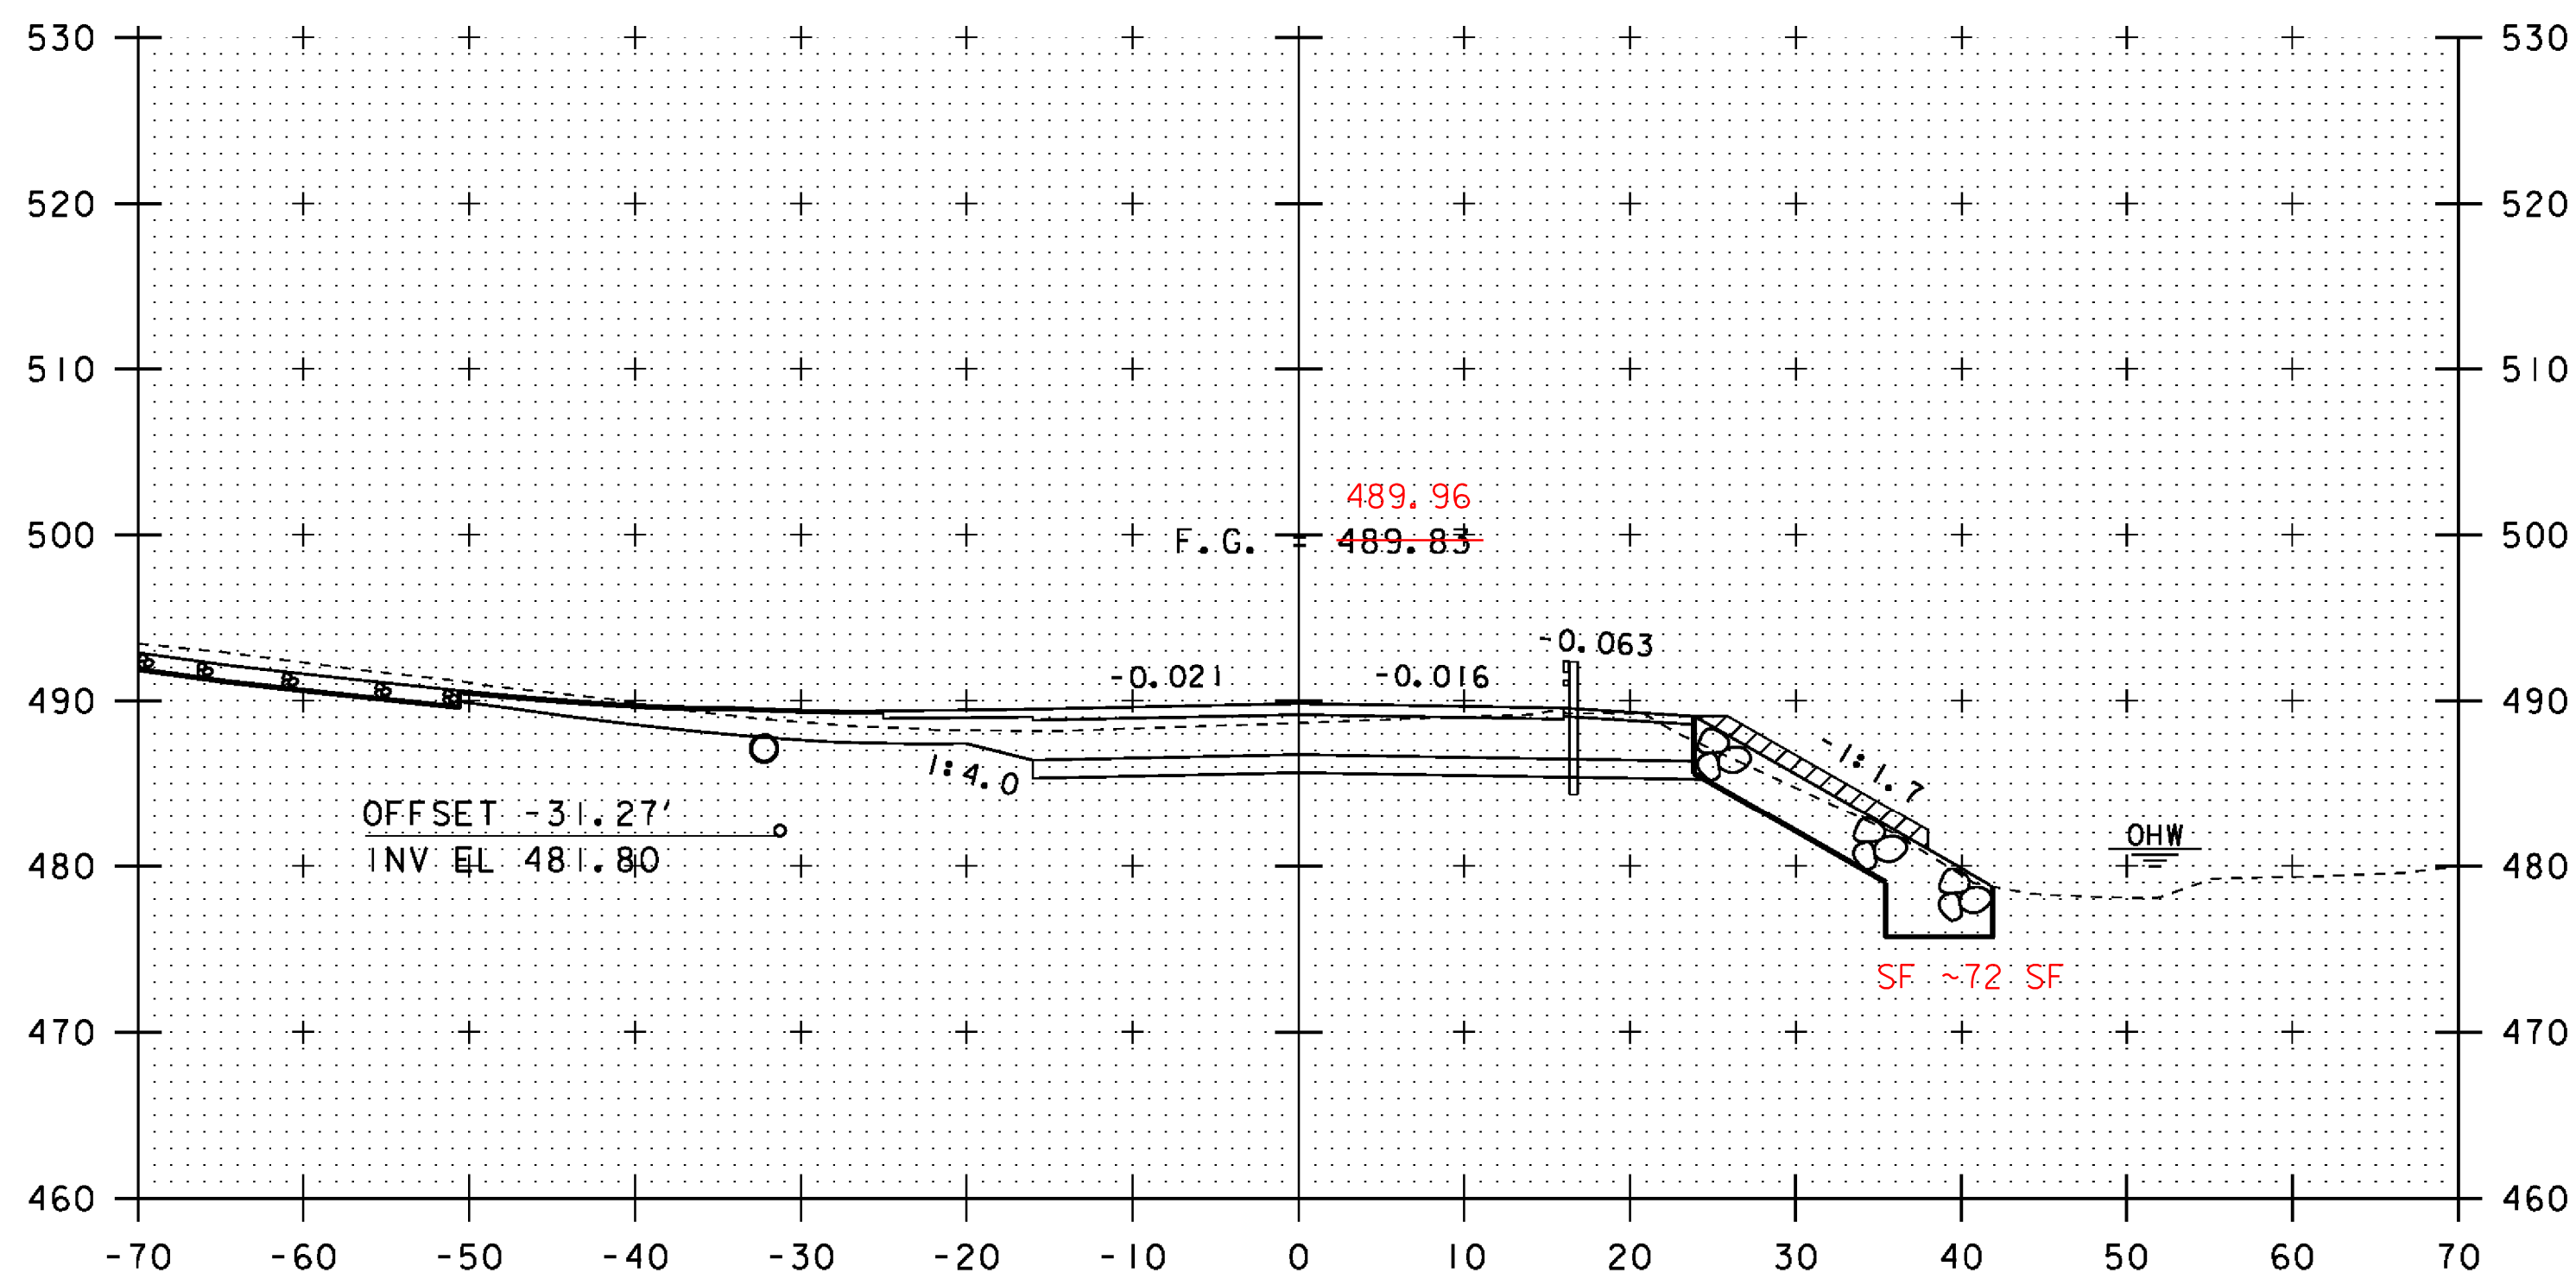

STA 92+58.0 LT - STA 93+34.1 LT  
 NEW 8 INCH UNDERDRAIN CARRIER PIPE  
 W/ YIELDING MARKER POST AT OUTLET  
 92+75  
 STA 92+68 RT  
 BEGIN SF TYPE III

STA 93+16.11  
 STOP ROADWAY  
 BEGIN BRIDGE  
 93+25  
 END STONE FILL  
 TYPE III RT

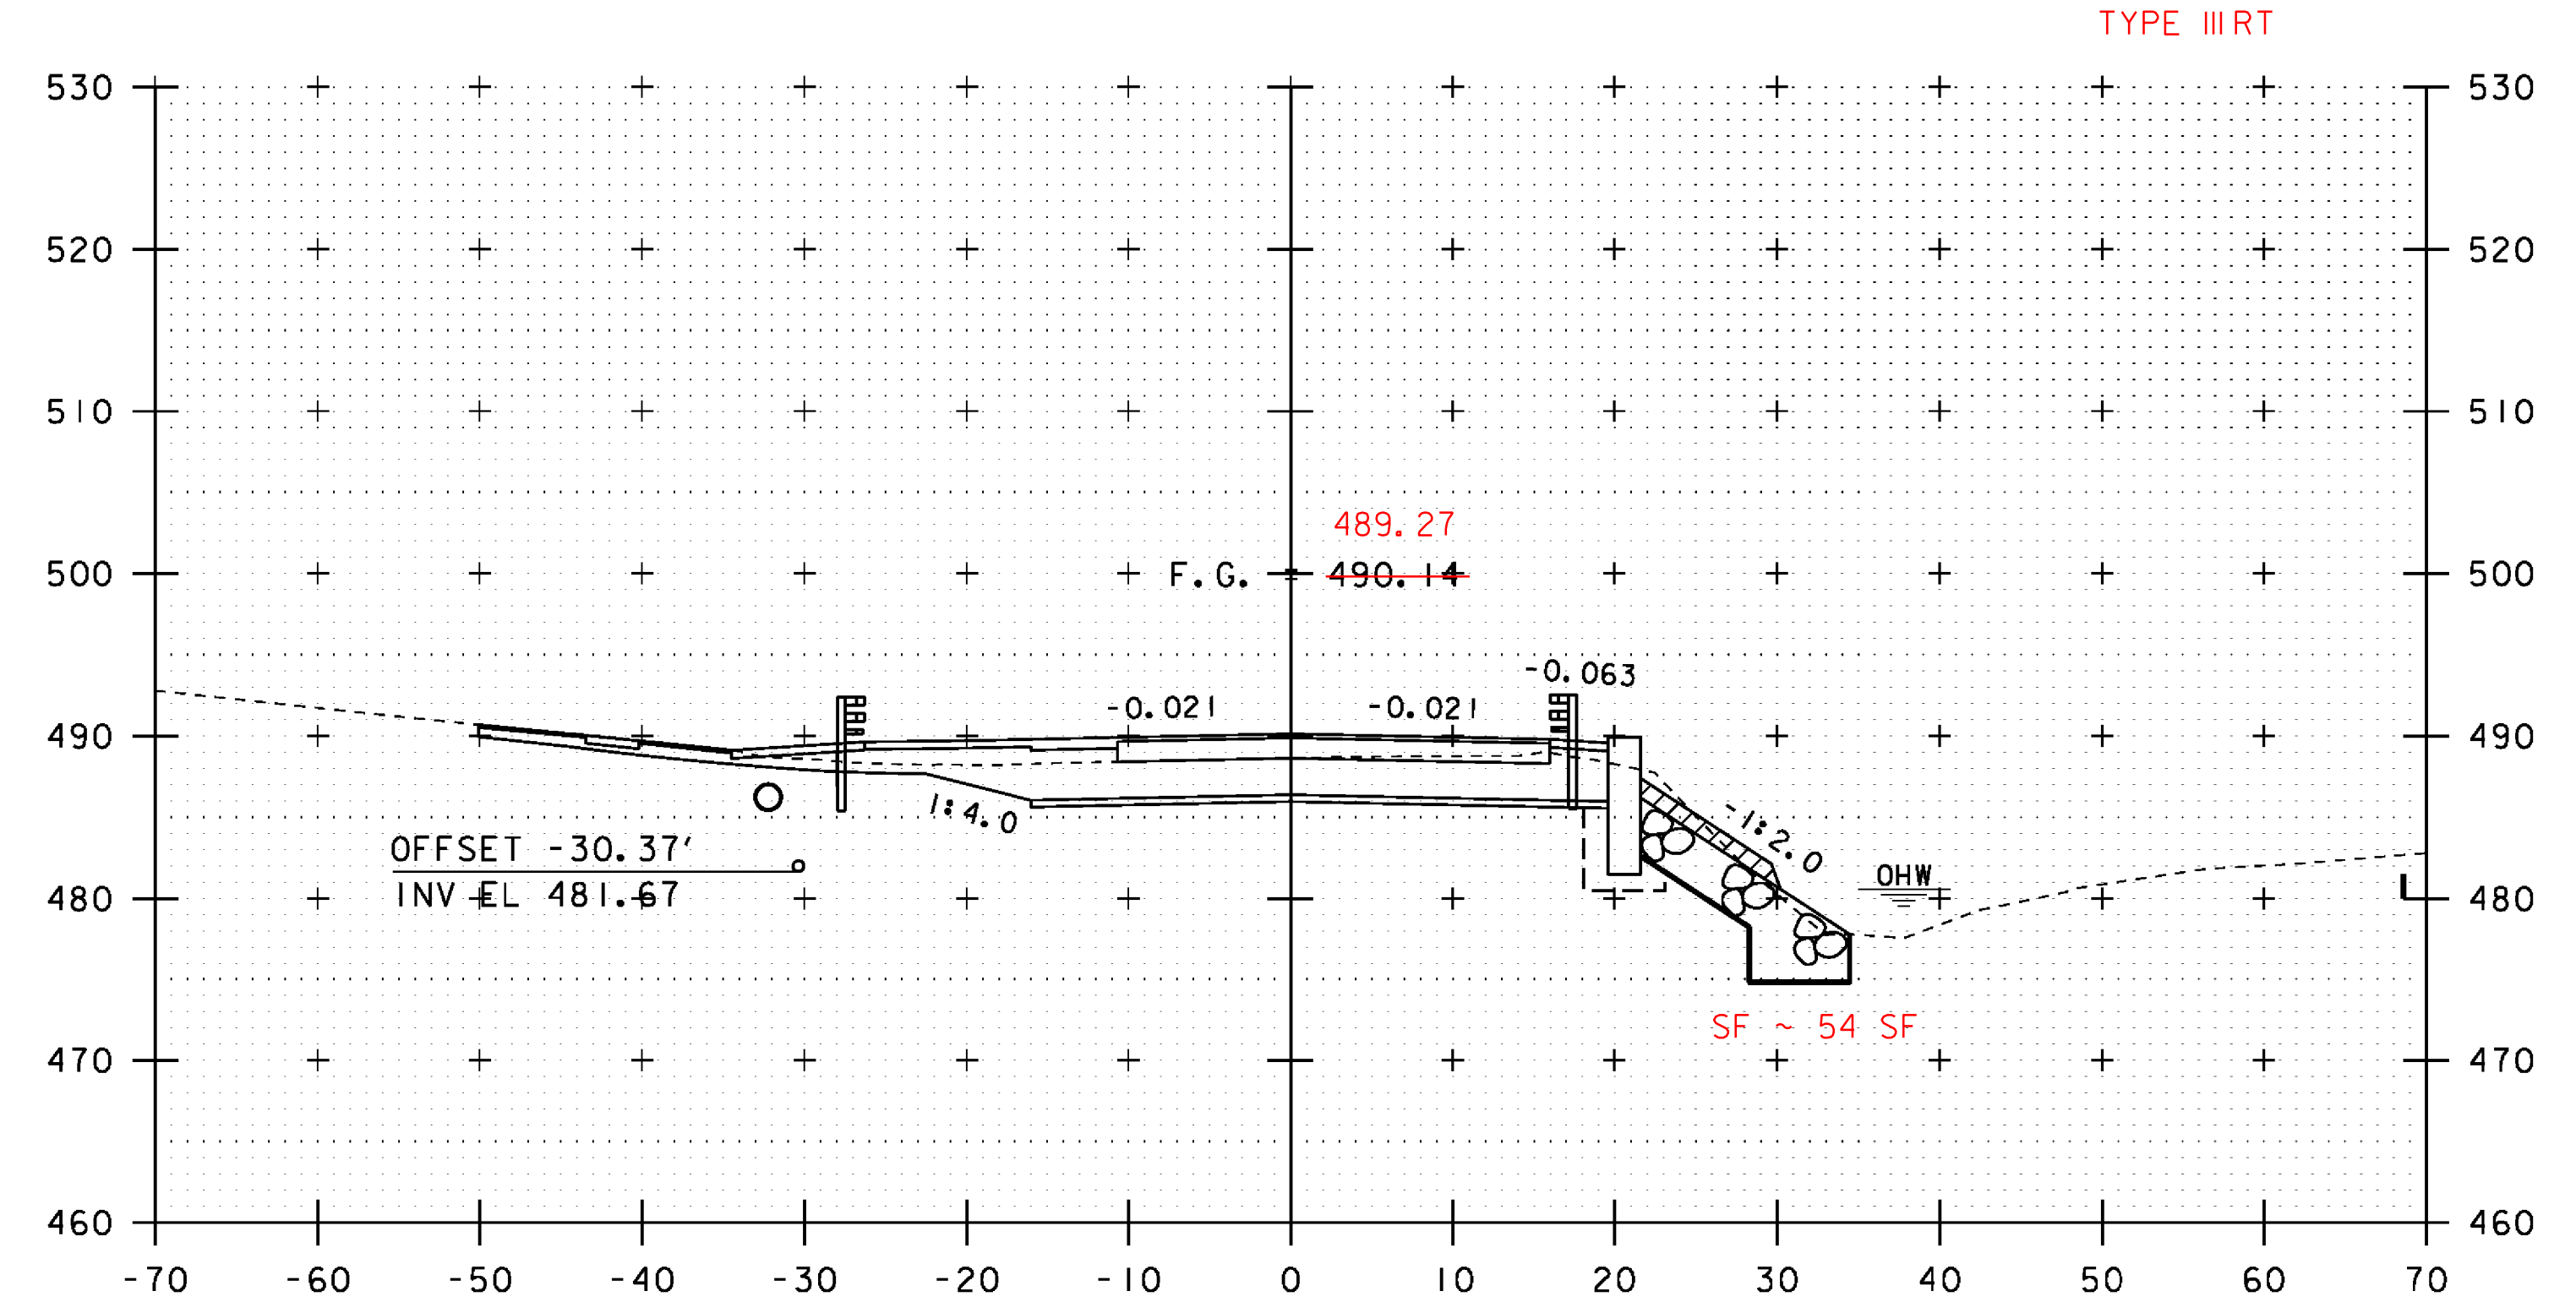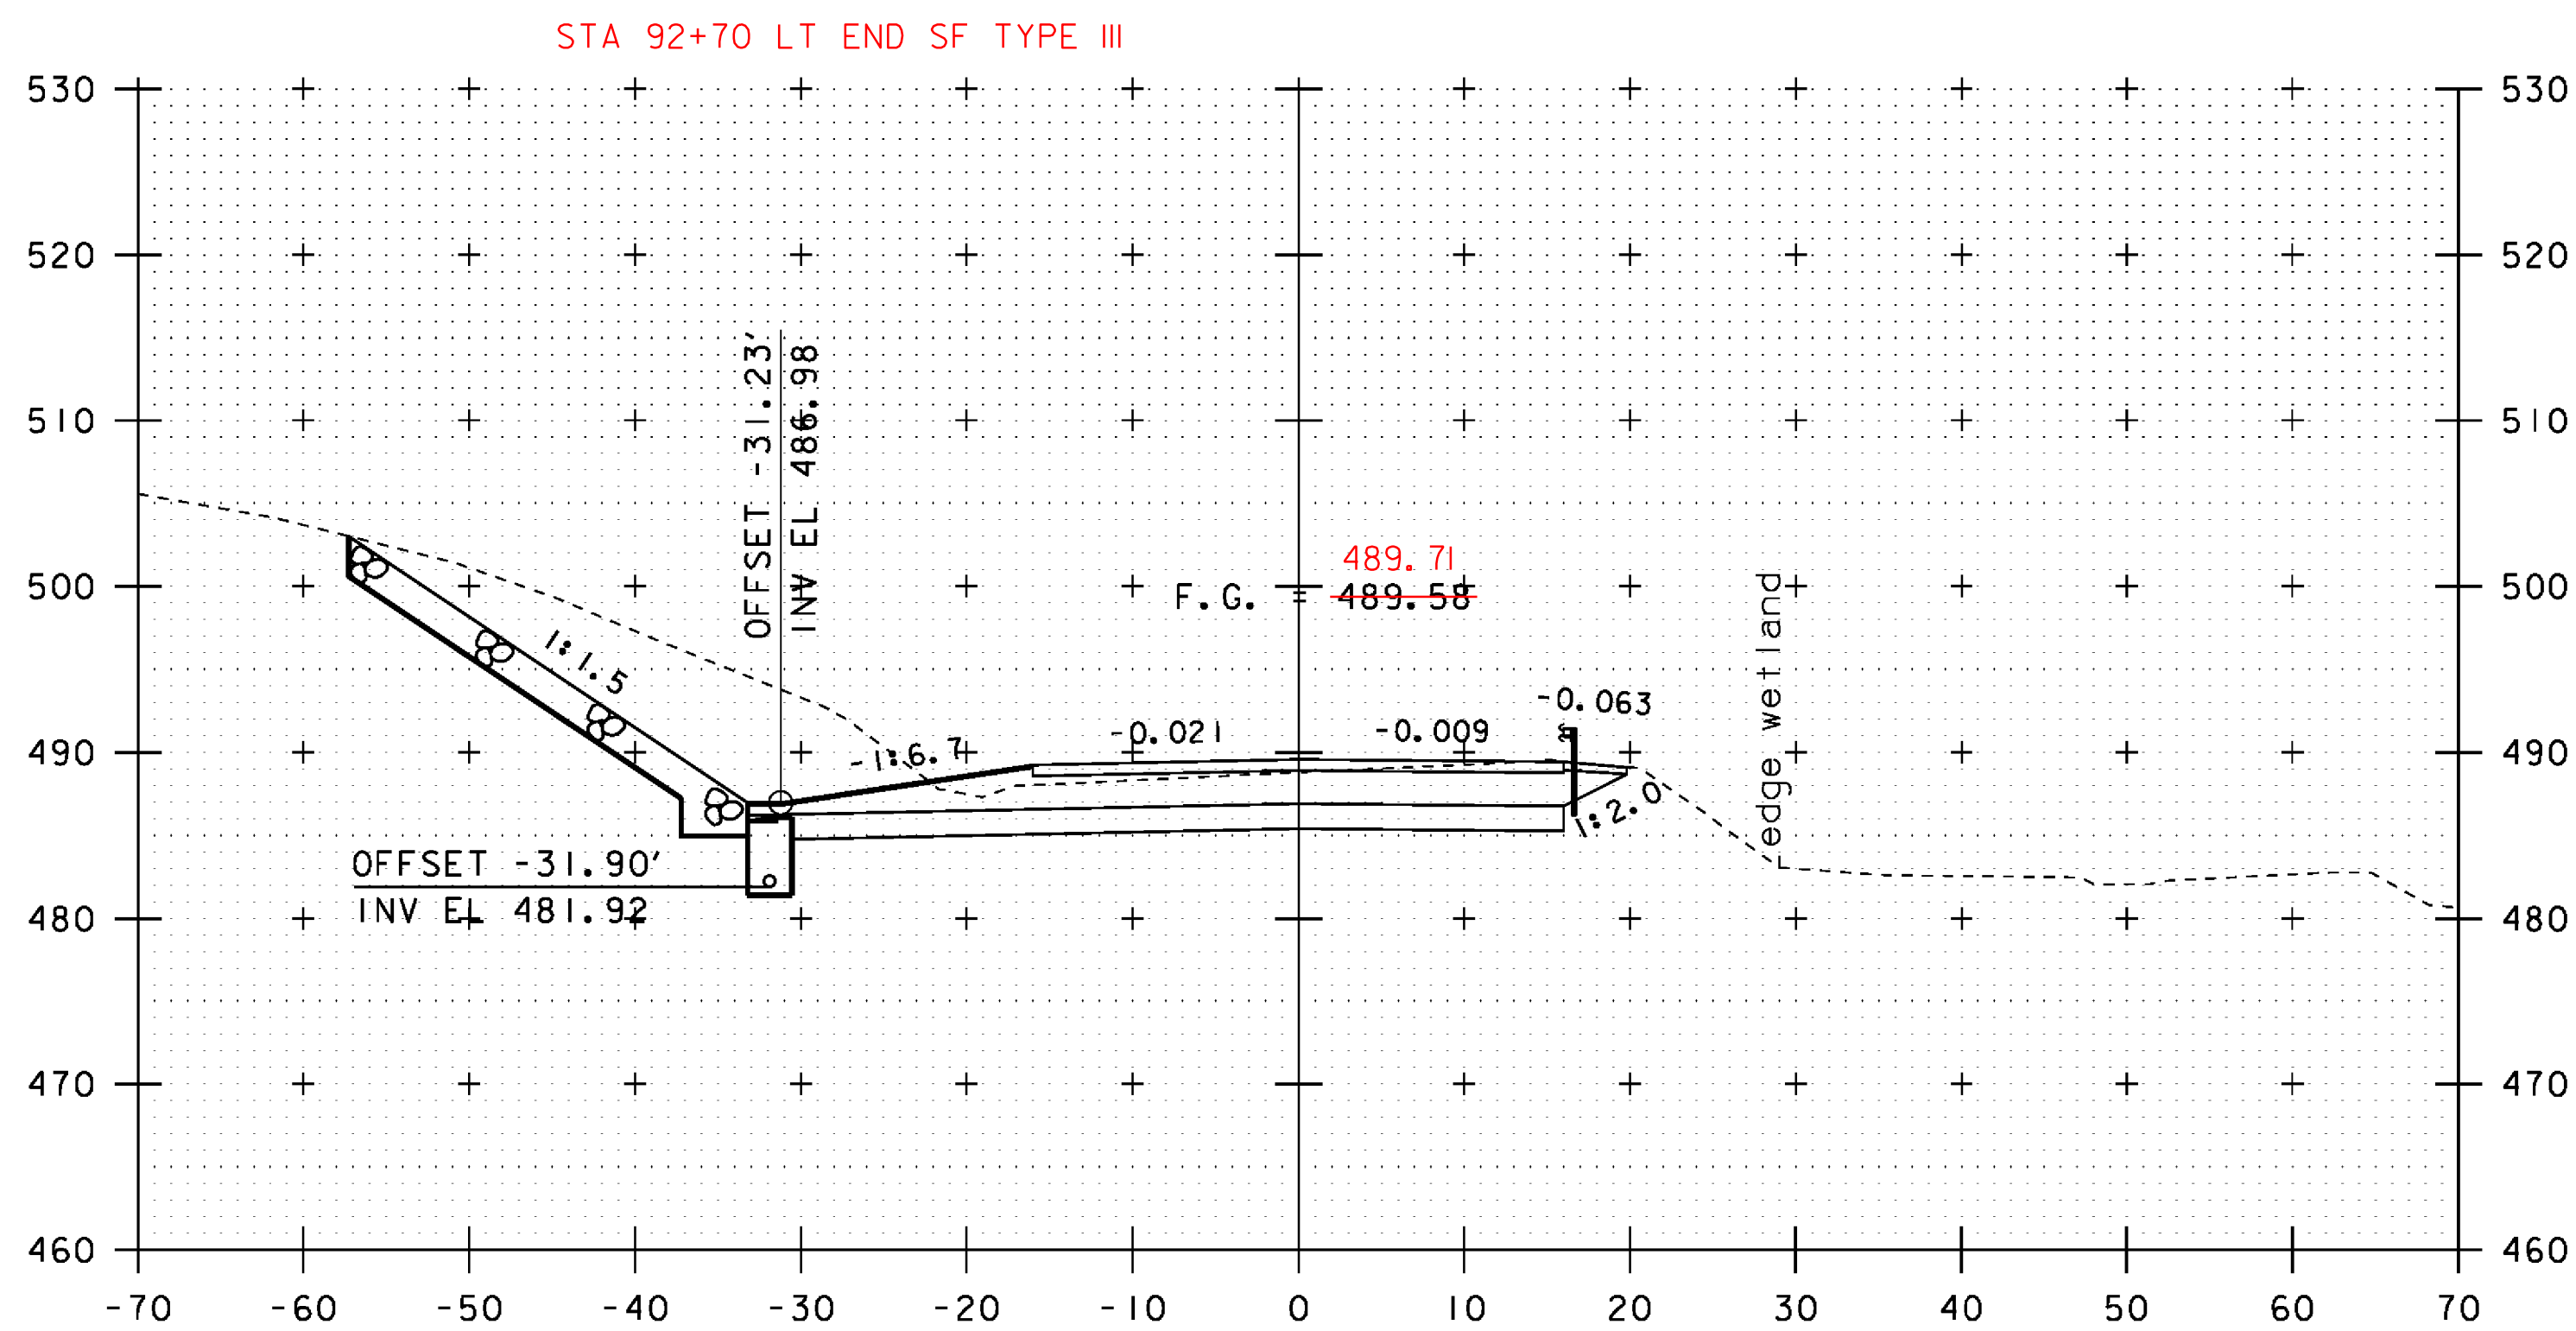


92+50

93+00

PROJECT NAME: JOHNSON  
 PROJECT NUMBER: BRF 030-2(26)  
 FILE NAME: s88bi93xsl.dgn  
 PROJECT LEADER: C. CARLSON  
 DESIGNED BY: H. SALLS  
 VT 15 CROSS SECTIONS (5)


PLOT DATE: 10-JUN-2014  
 DRAWN BY: G. ROY  
 CHECKED BY: H. SALLS  
 SHEET 46 OF 69

SCALE: 1" = 10'-0"  
 10 0 10  
 STA. 92+50 TO STA. 93+25

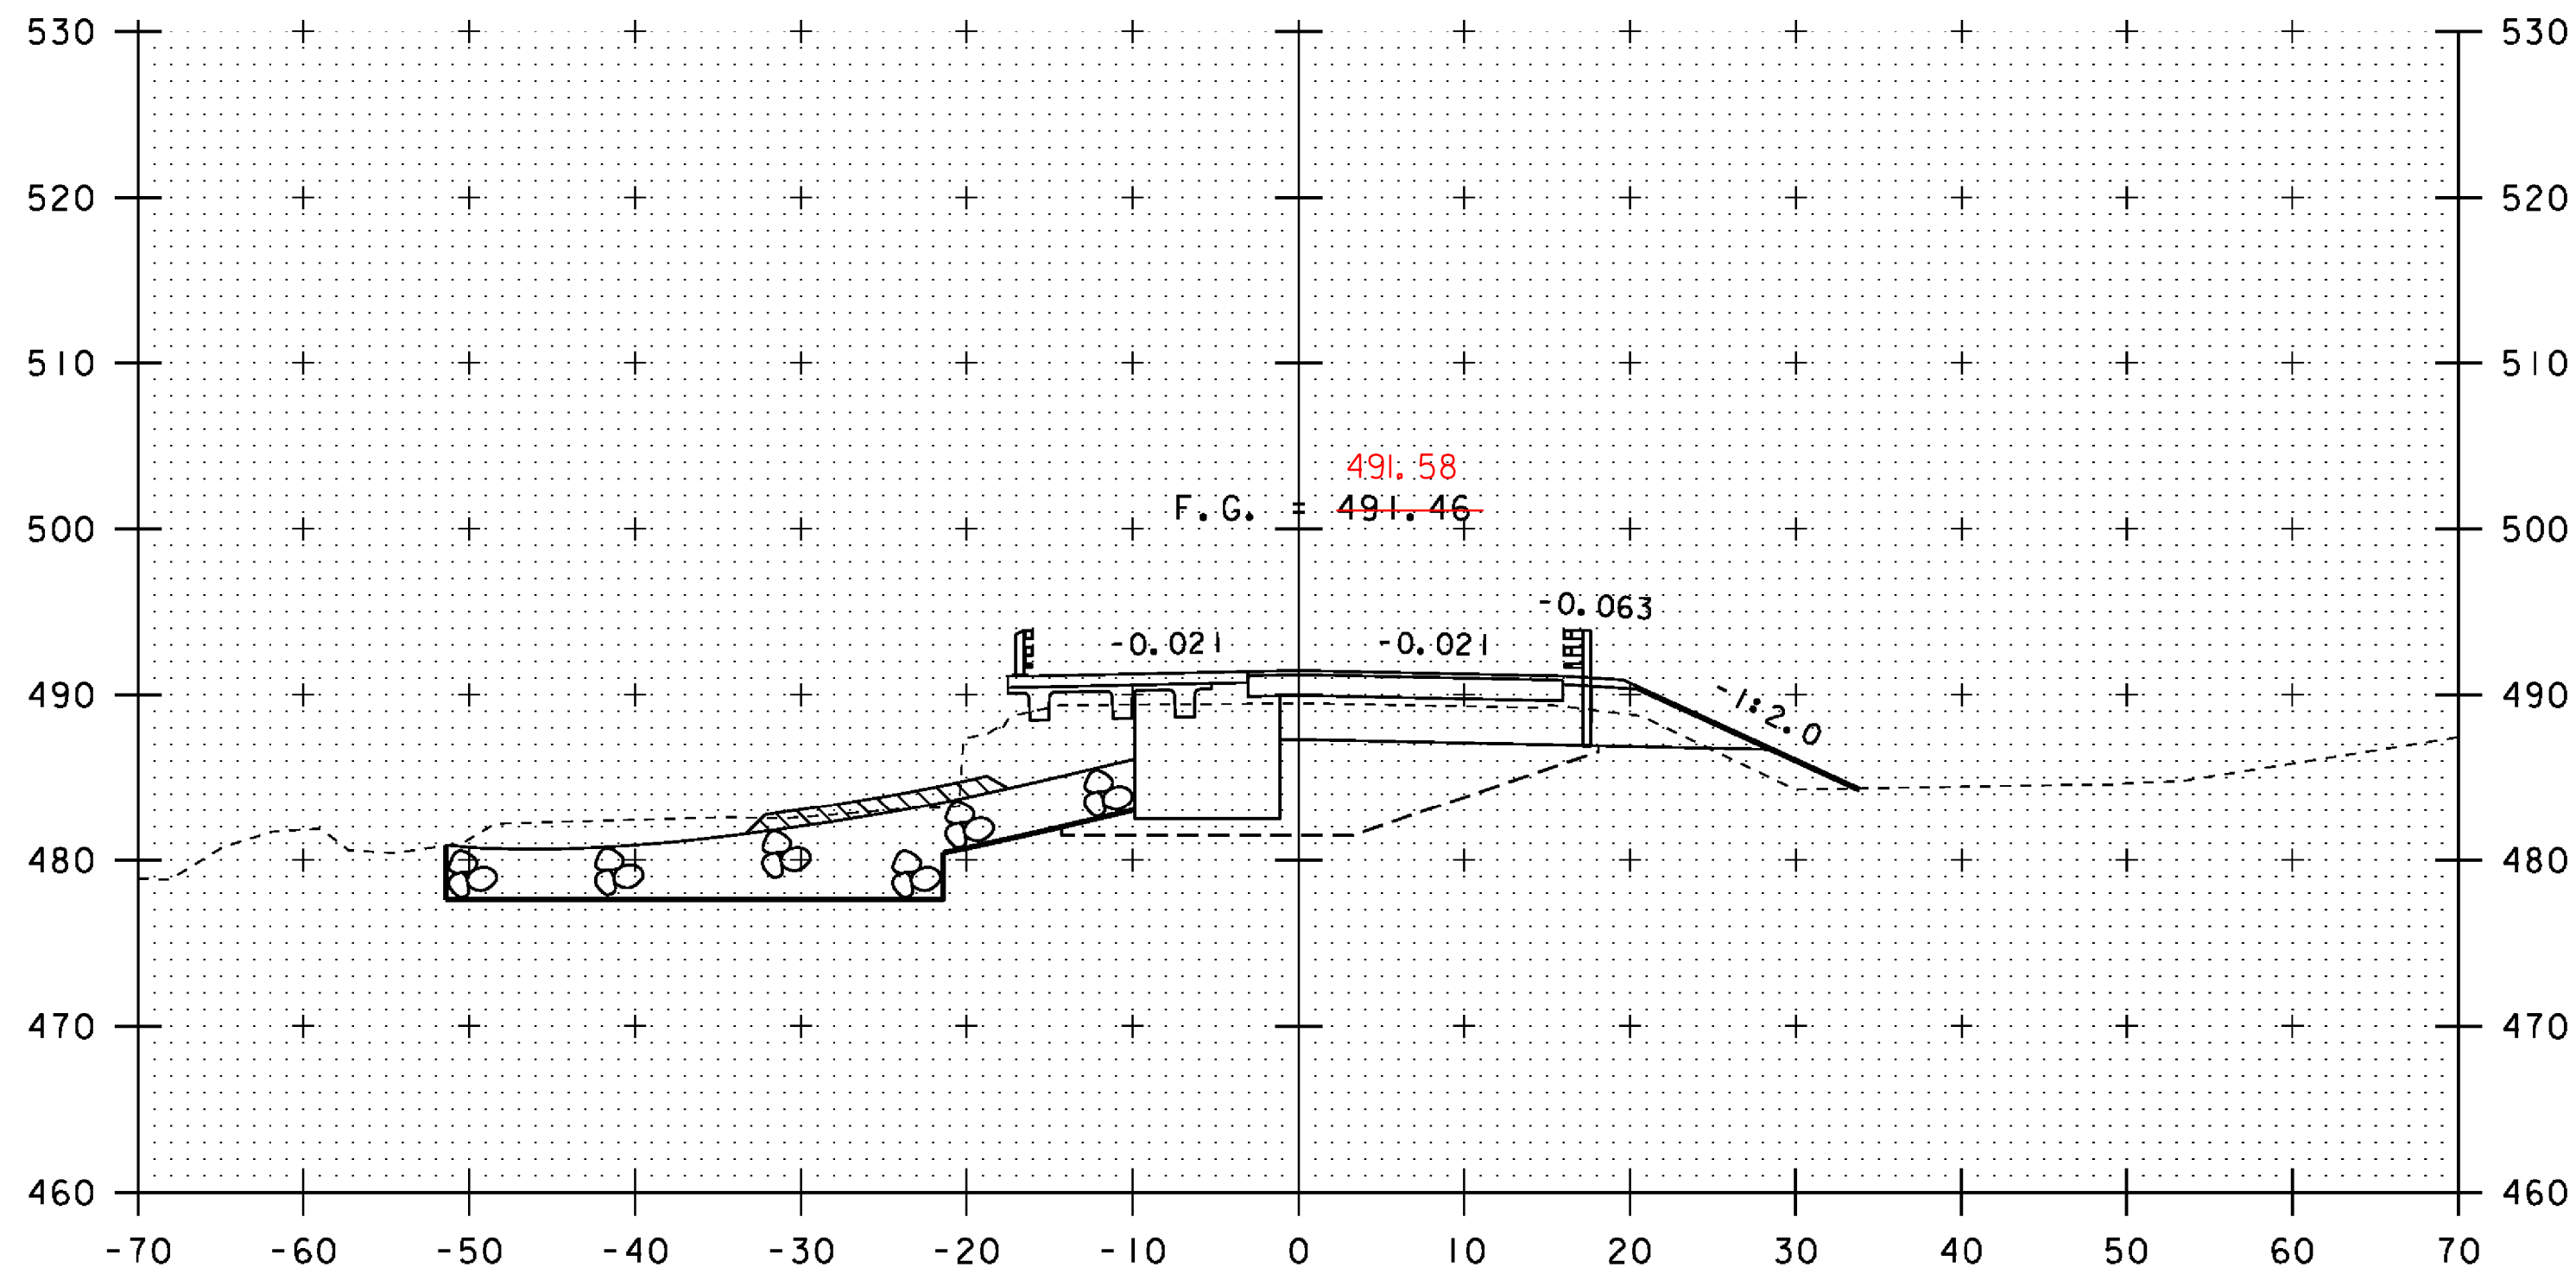


93+75


STA 93+73.89  
END BRIDGE  
RESUME ROADWAY

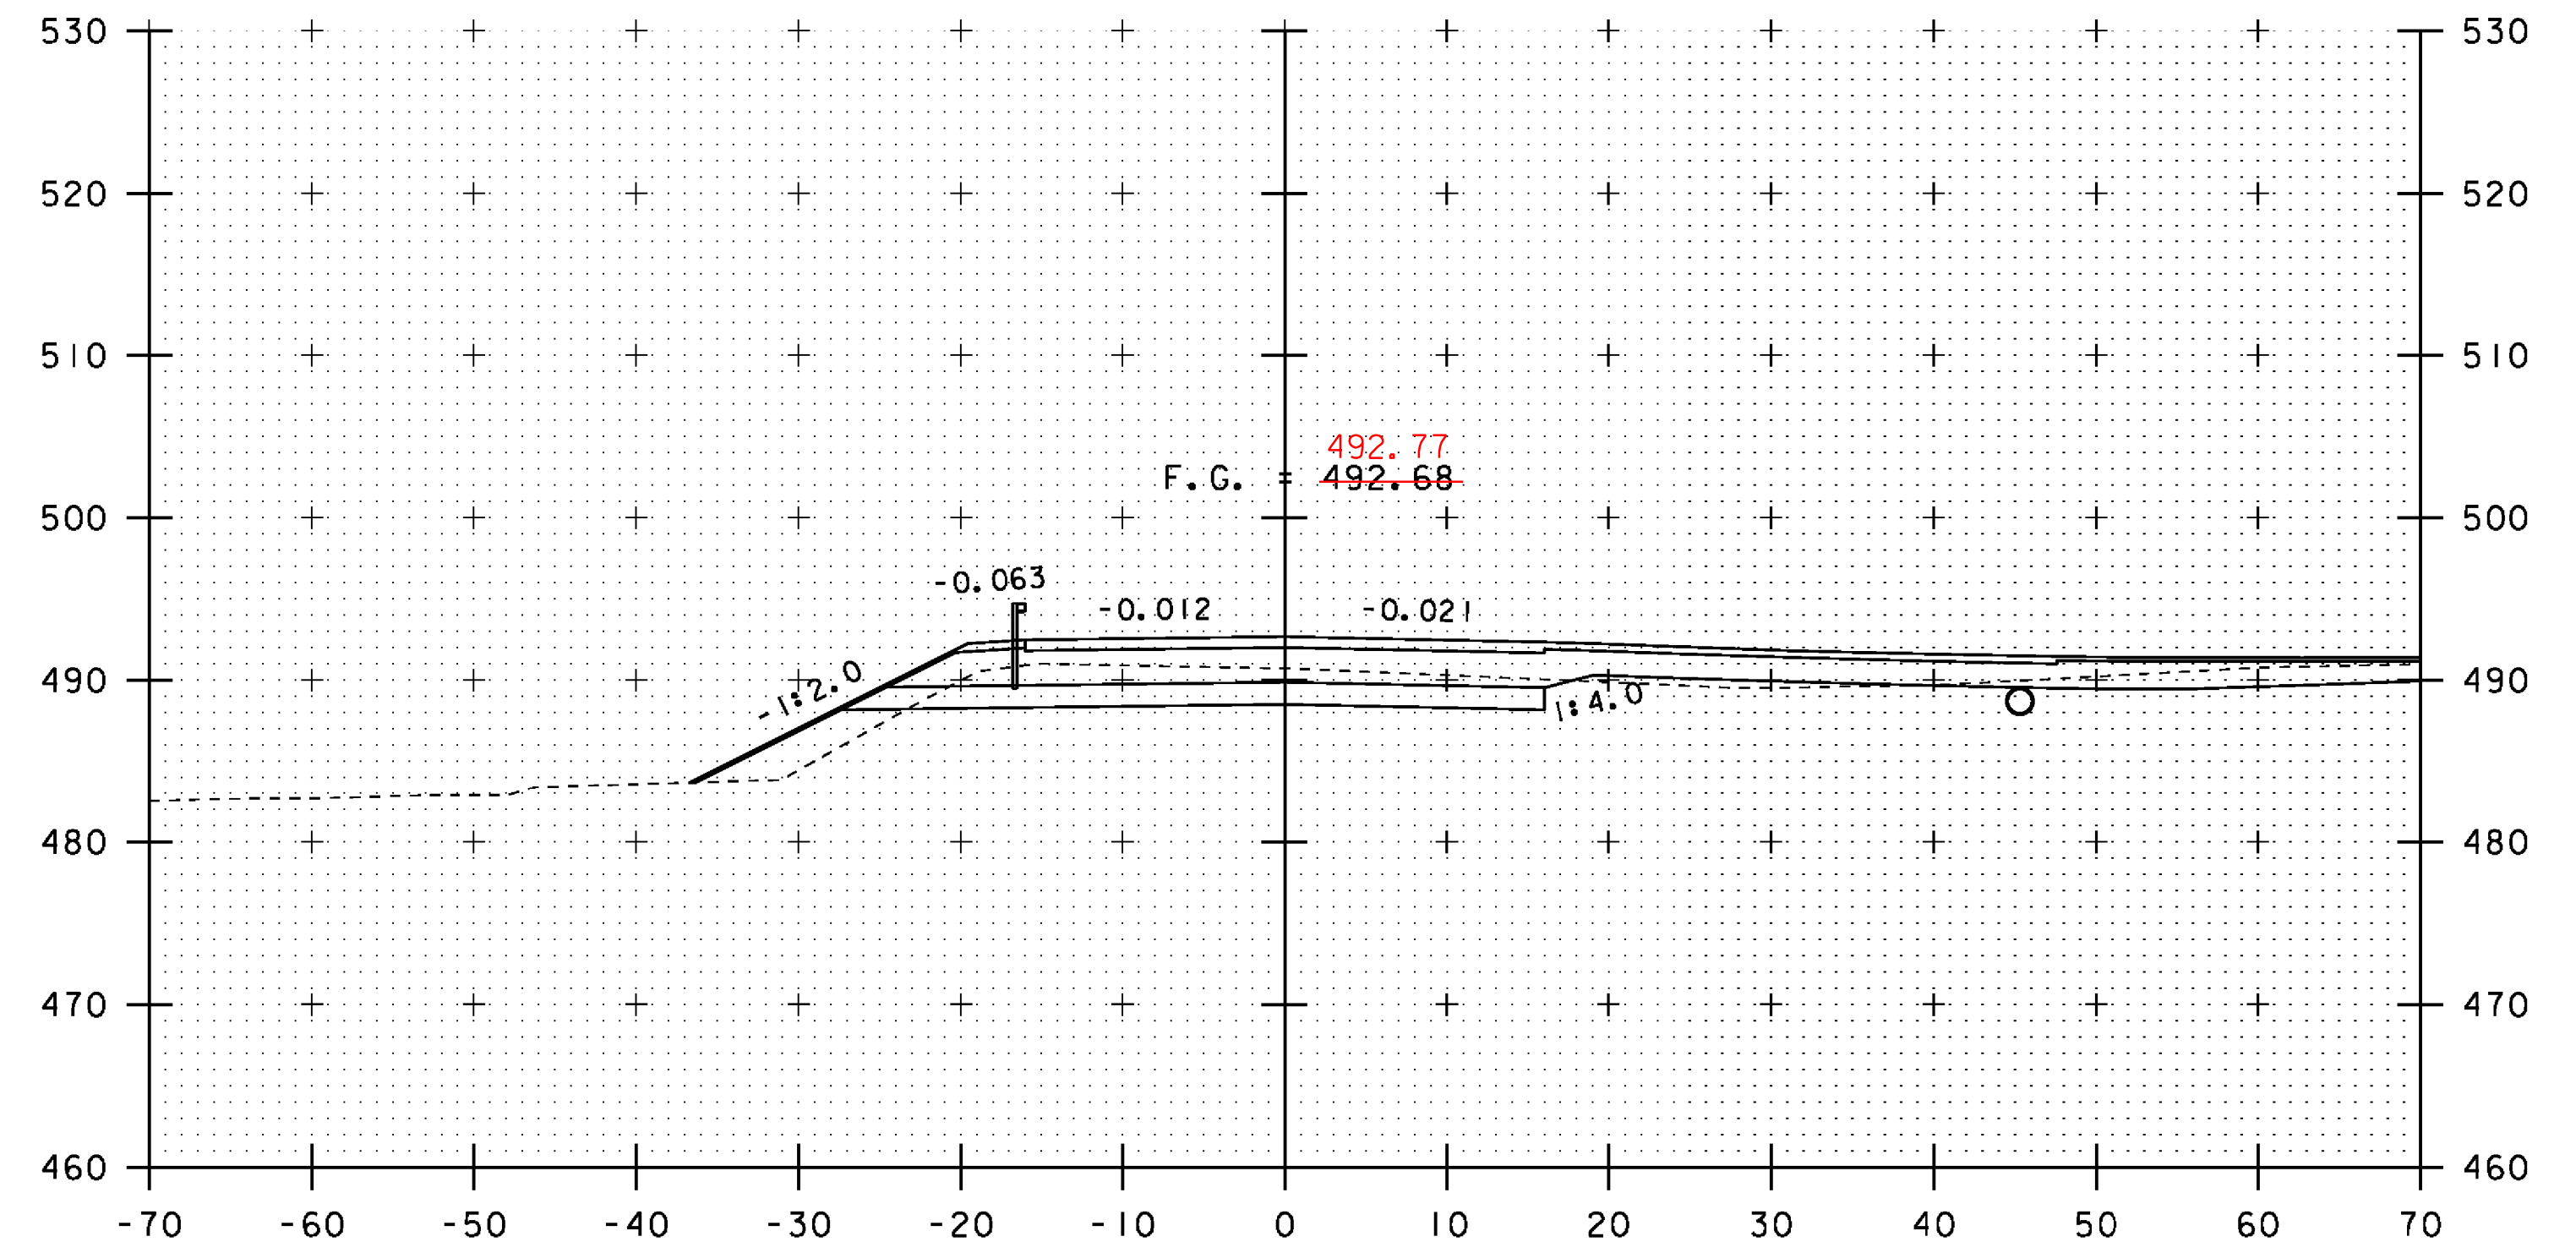

94+25

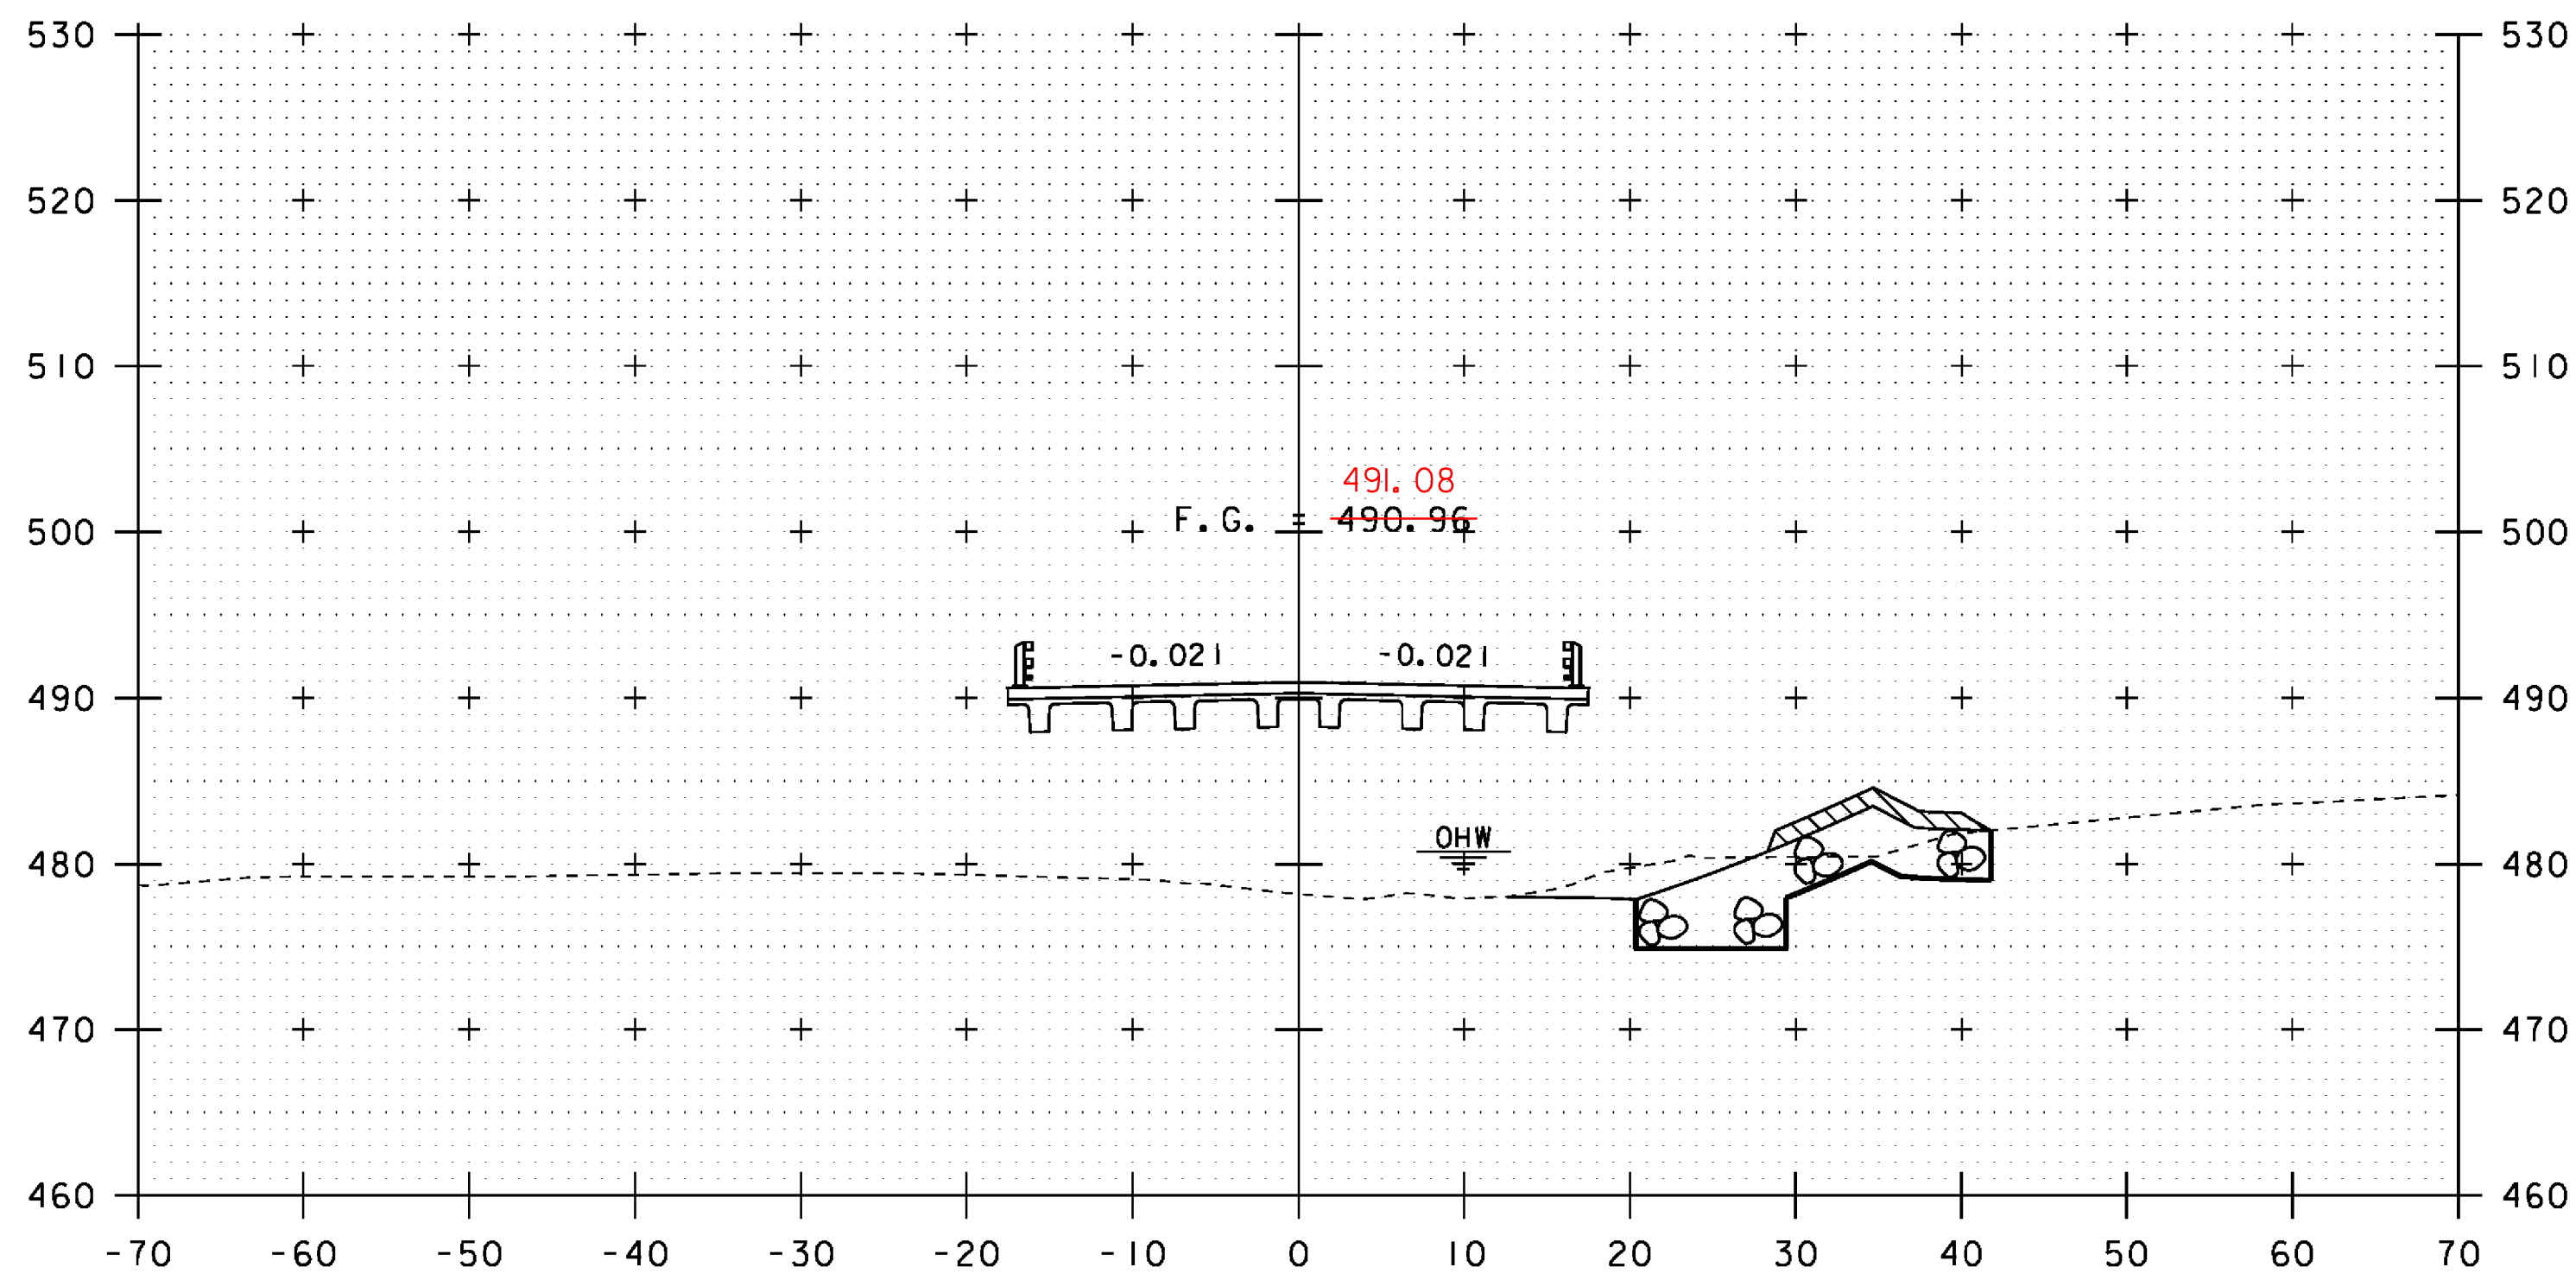

93+50

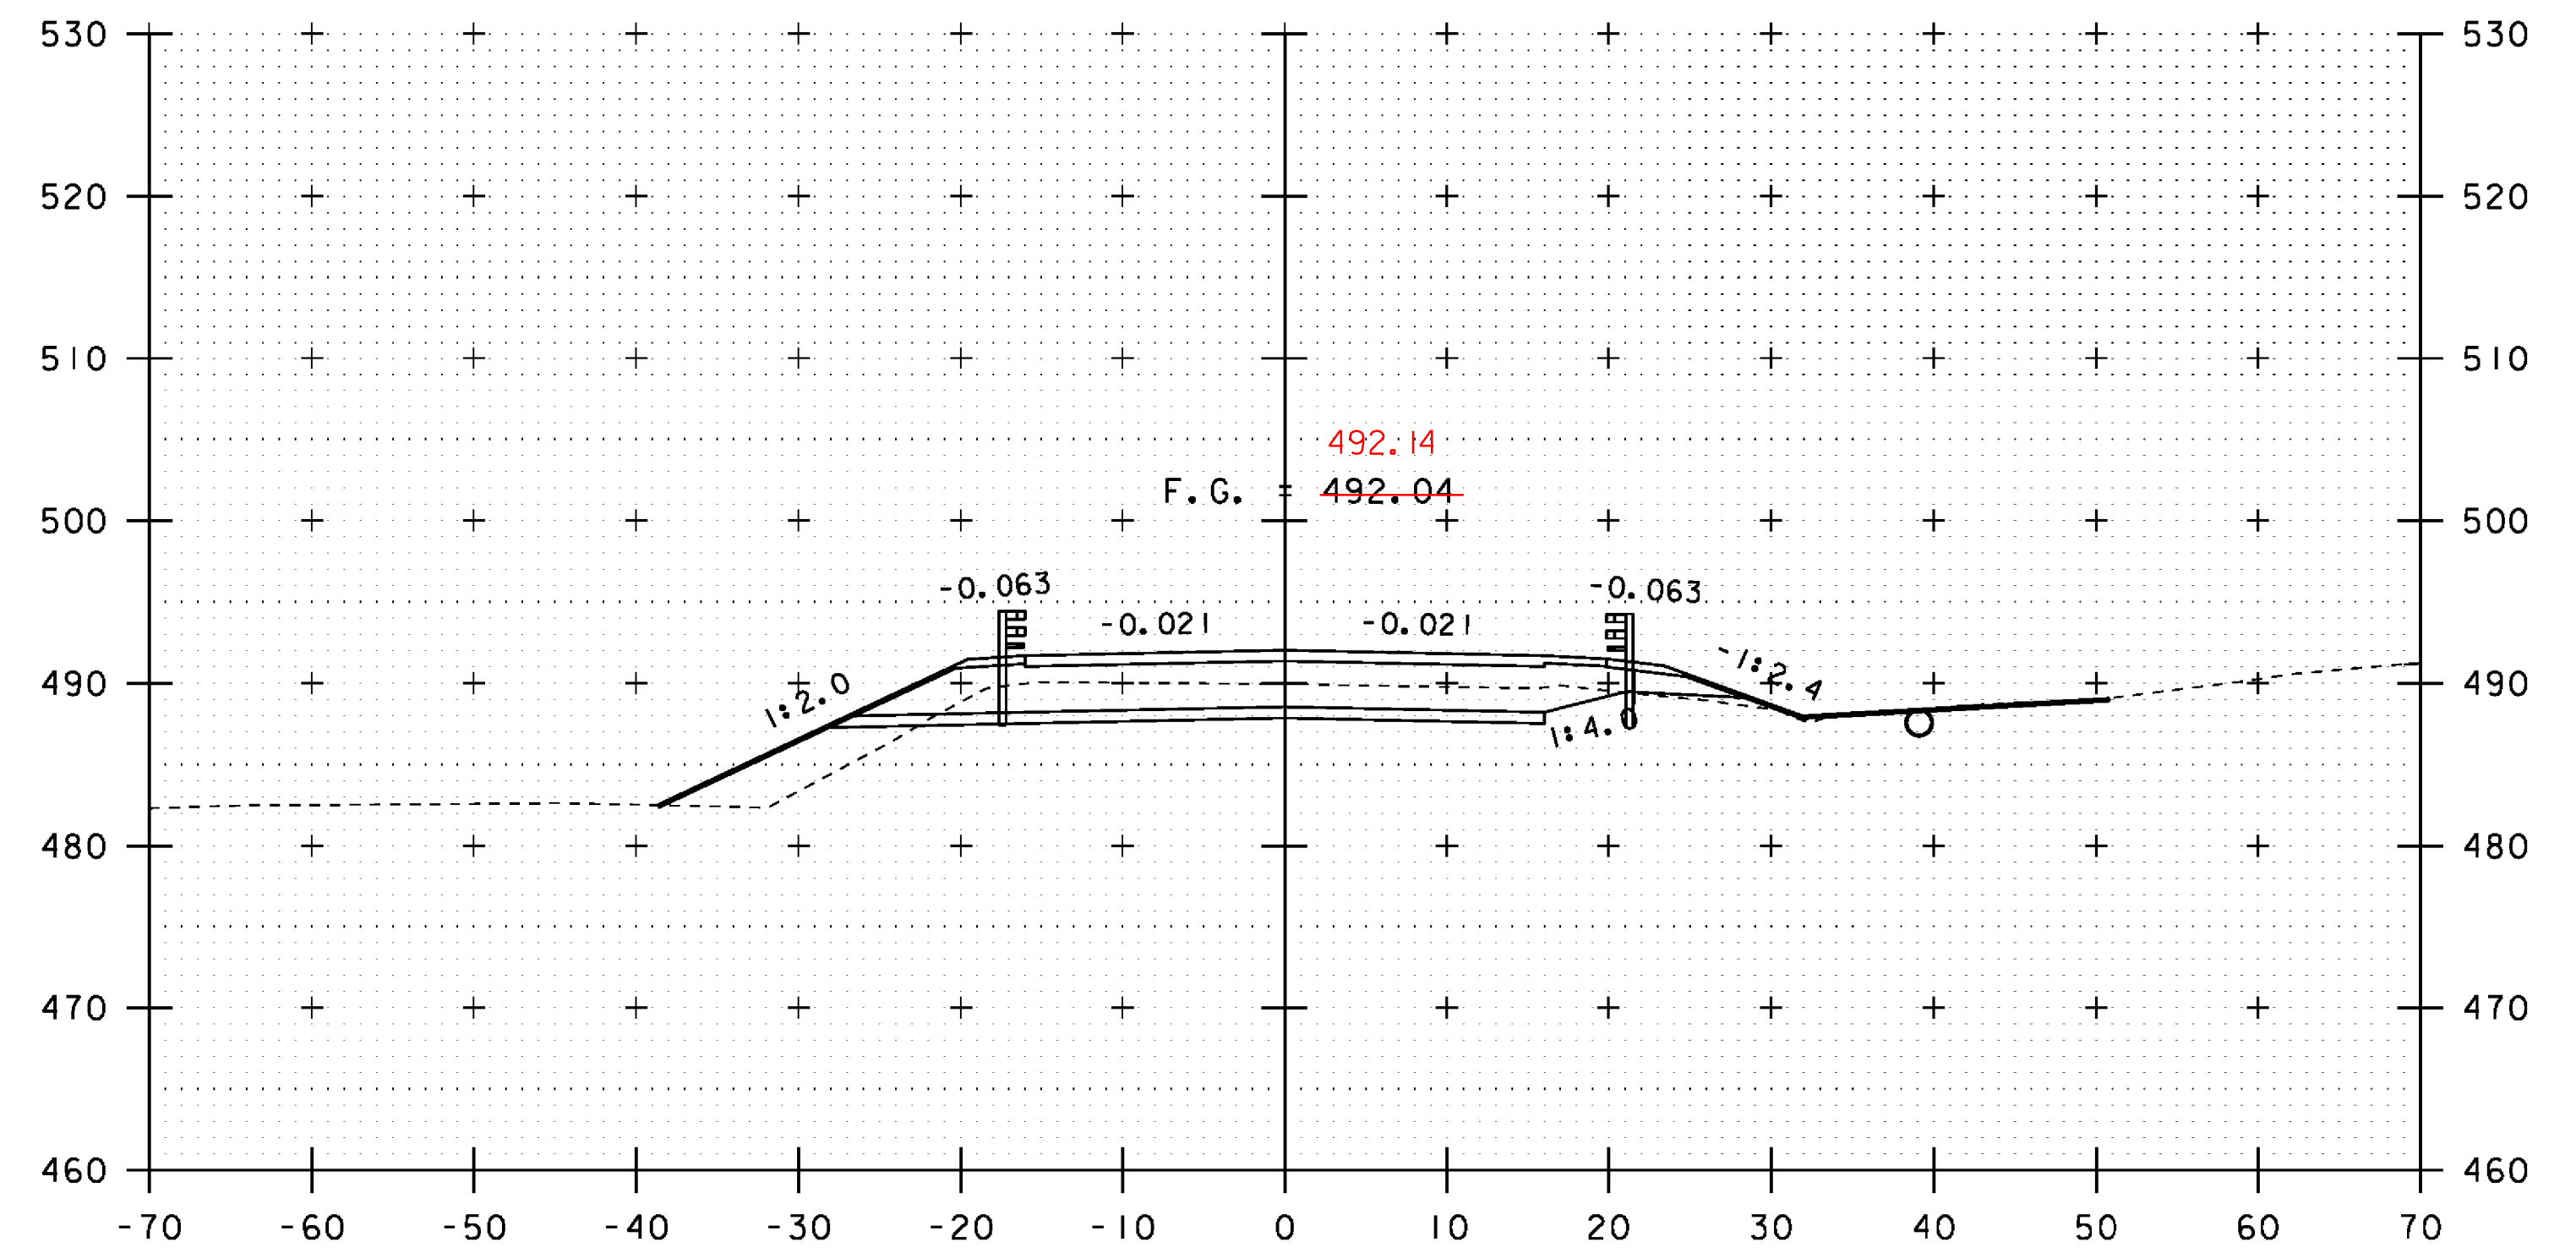

94+00


SCALE: 1" = 10'-0"  
10 0 10

STA. 93+50 TO STA. 94+25


PROJECT NAME: JOHNSON  
PROJECT NUMBER: BRF 030-2(26)

FILE NAME: s88bi93xsl.dgn  
PROJECT LEADER: C. CARLSON  
DESIGNED BY: H. SALLS  
VT 15 CROSS SECTIONS (6)


PLOT DATE: 10-JUN-2014  
DRAWN BY: G. ROY  
CHECKED BY: H. SALLS  
SHEET 47 OF 69

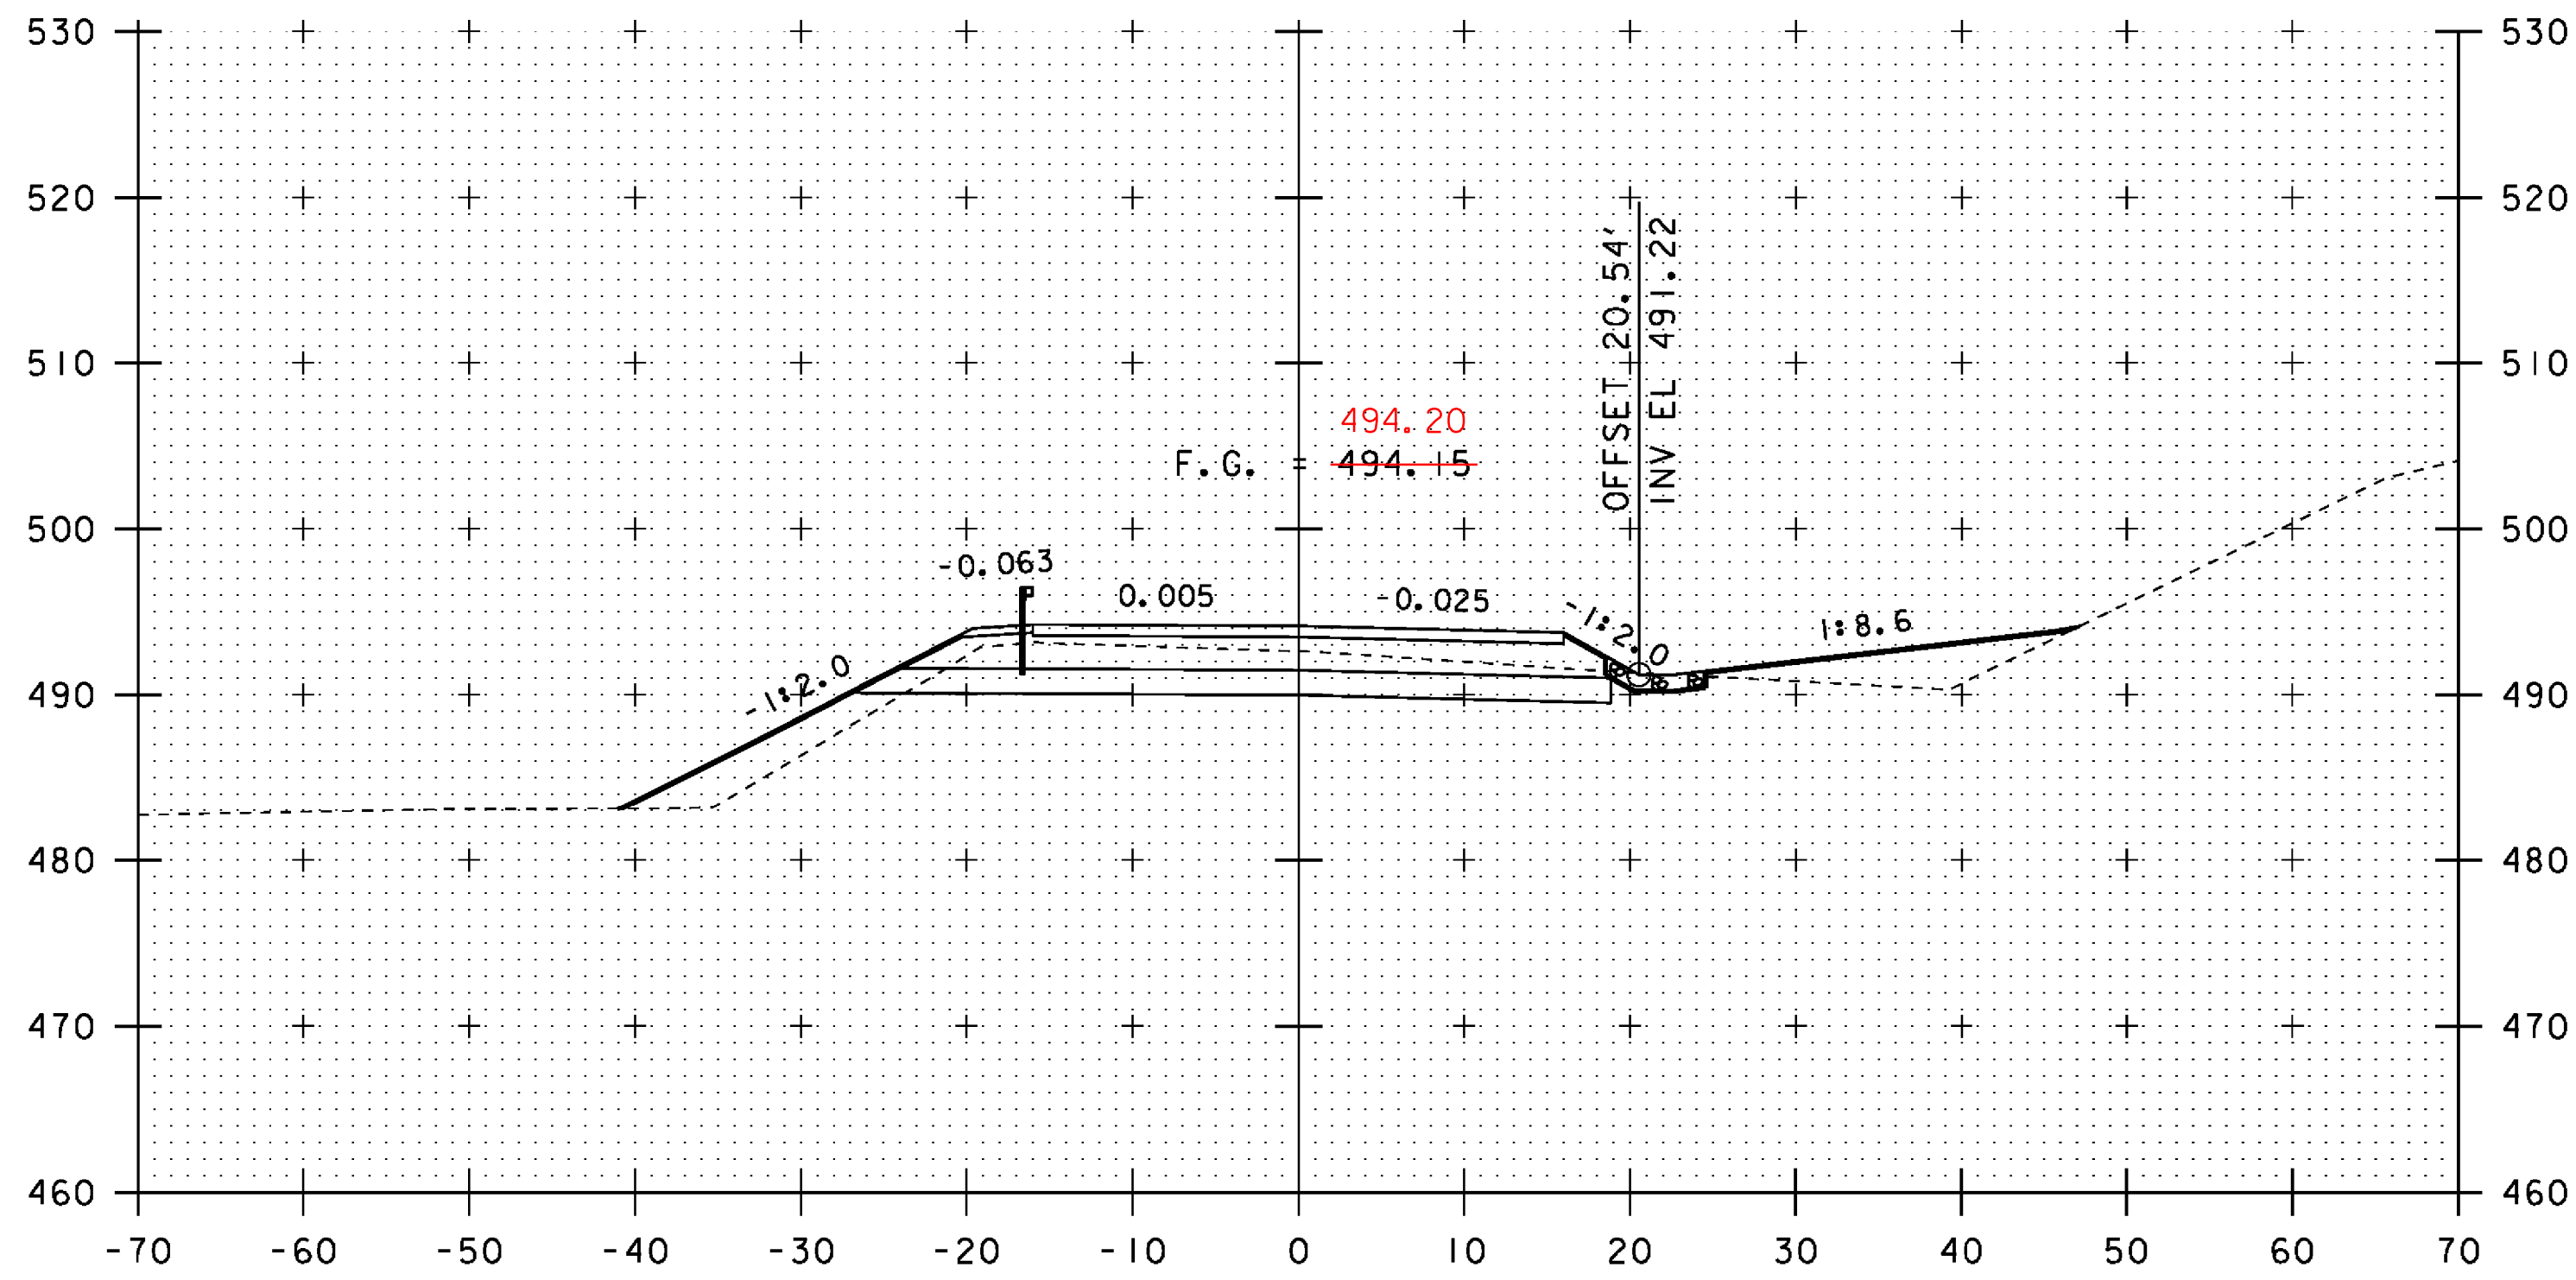

94+75

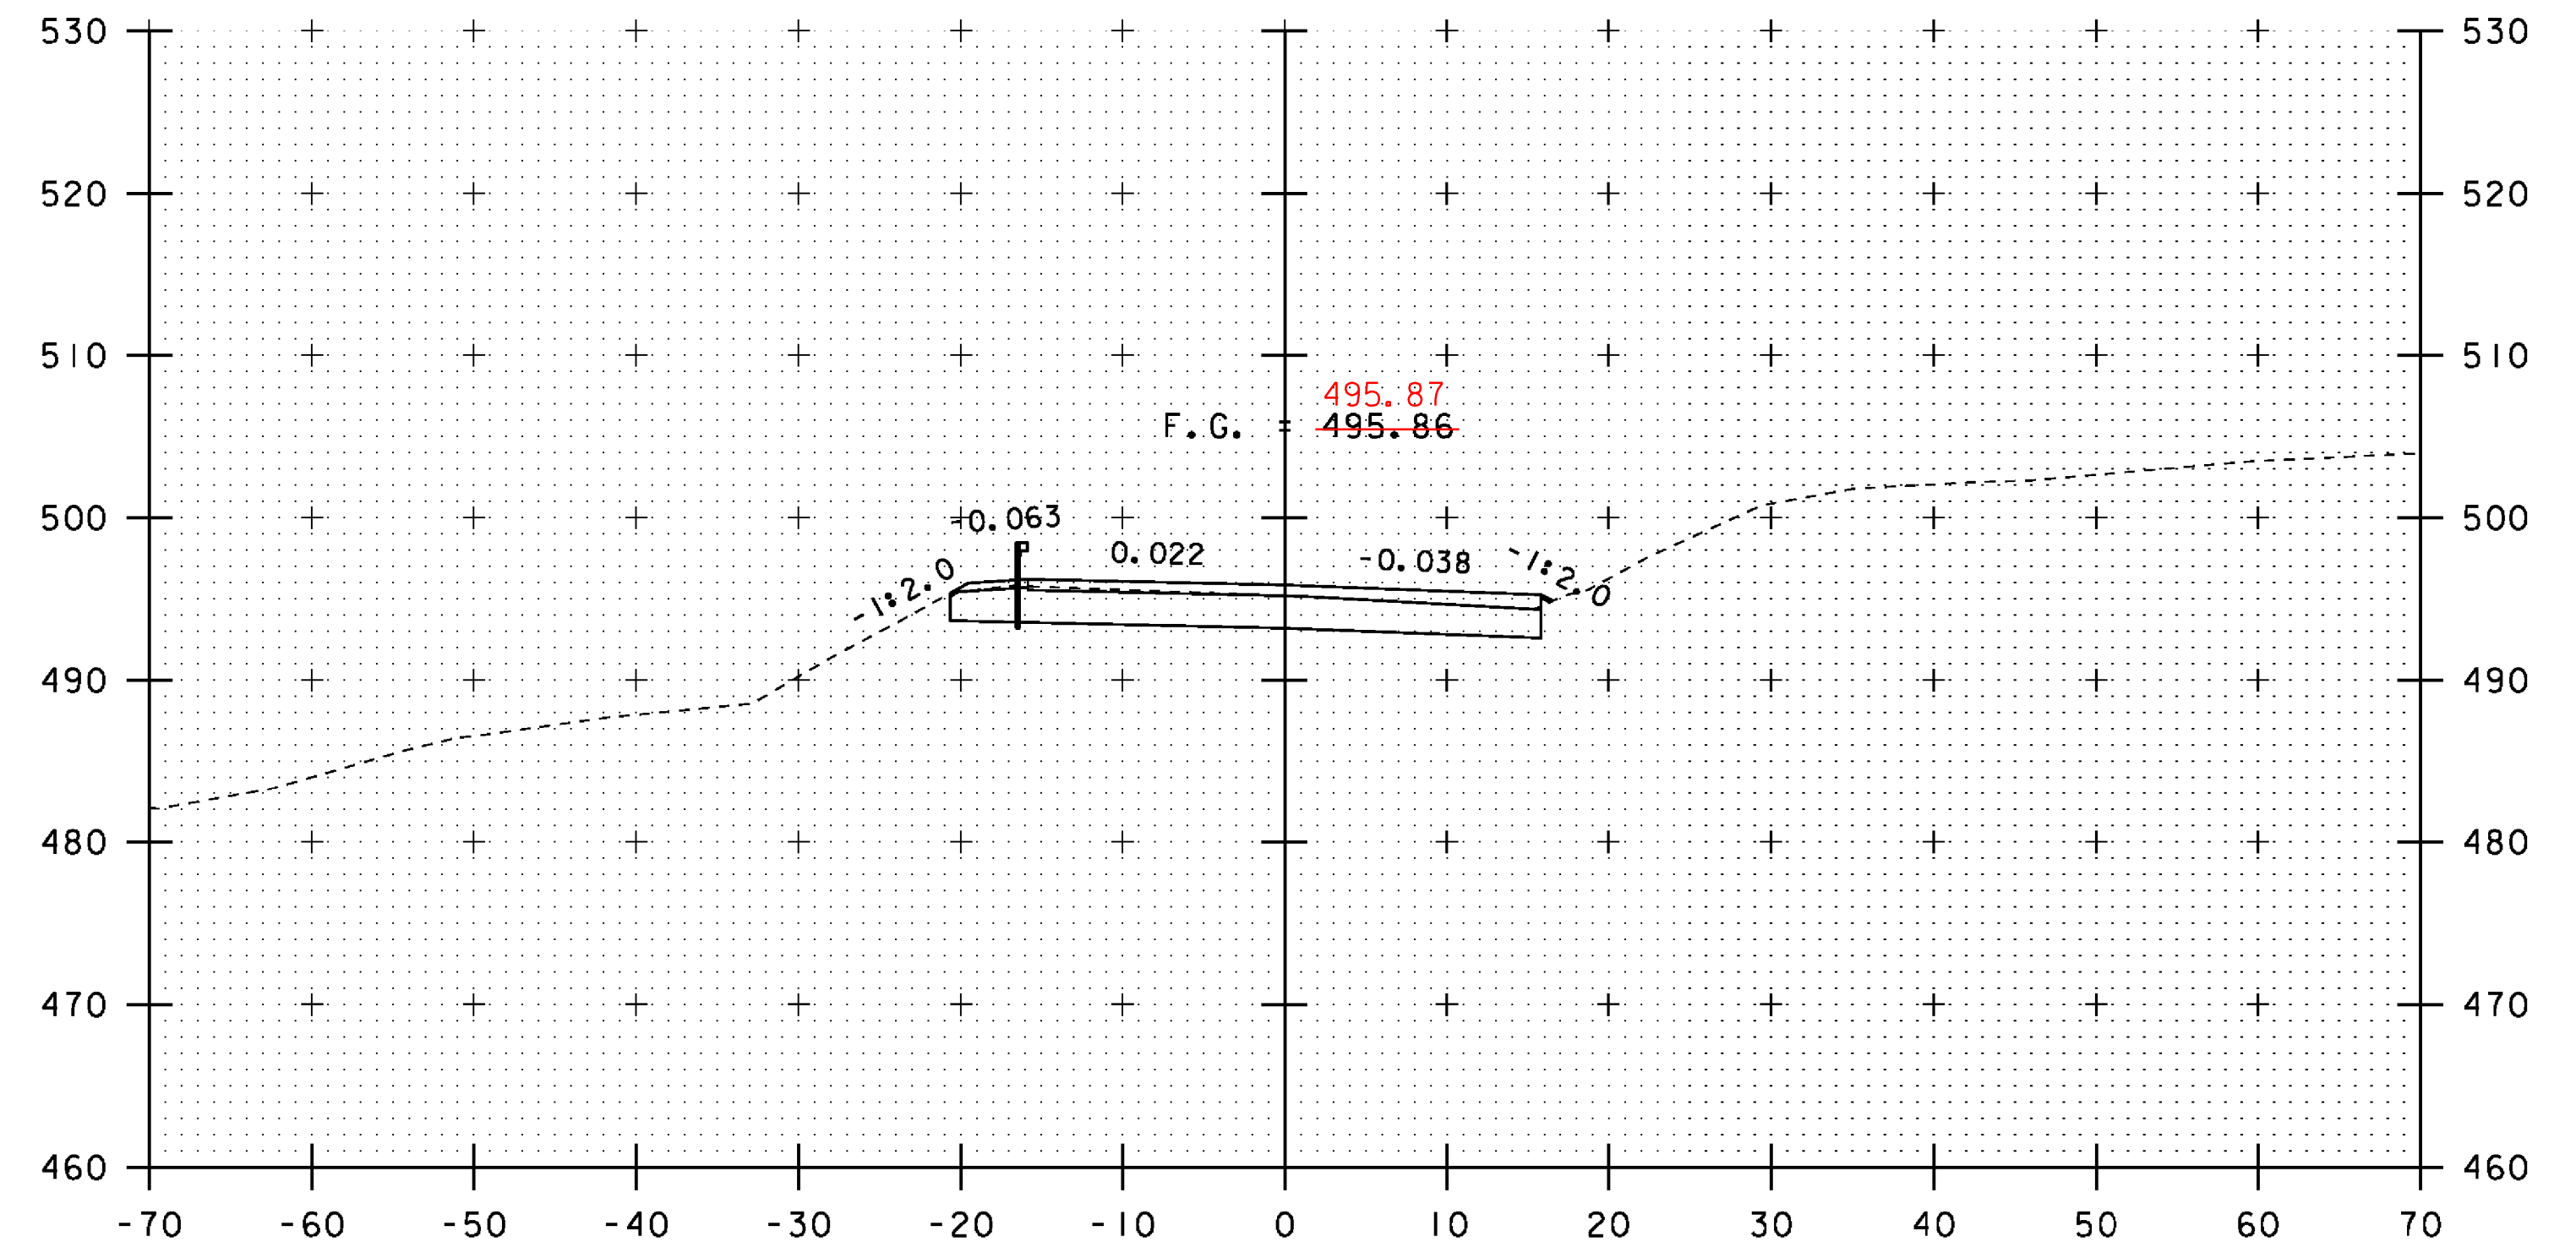


95+25

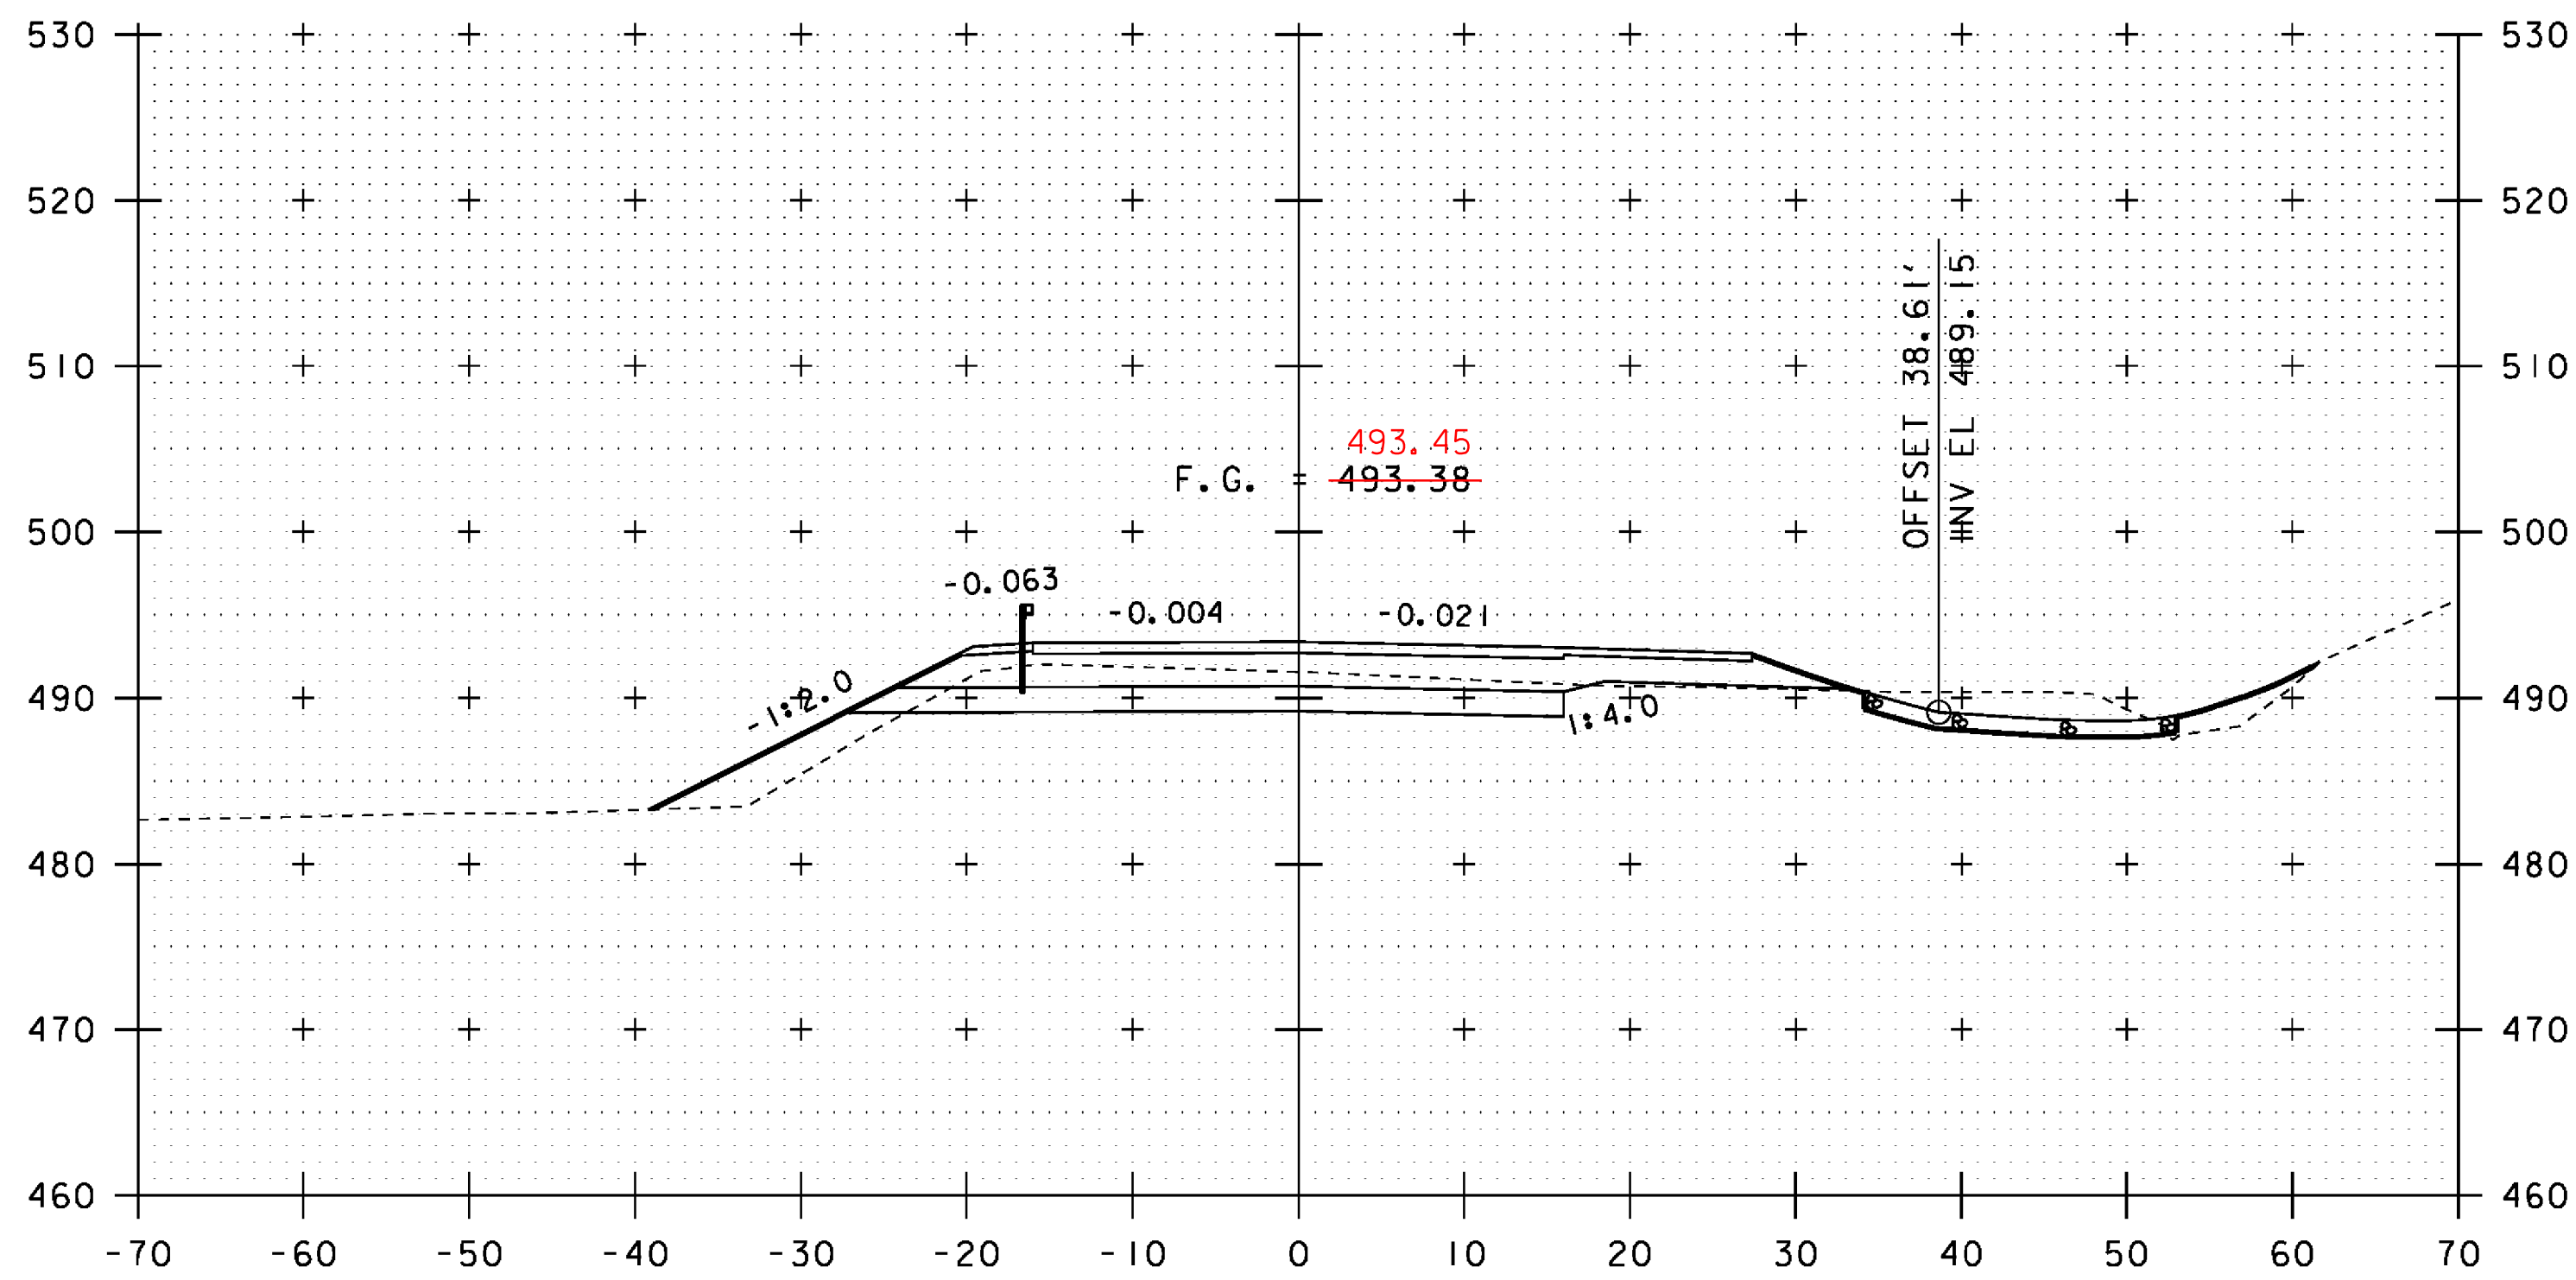


94+50

STA 94+47.0 RT - STA 95+06.0 RT  
CONSTRUCT STONE-LINED DITCH, TYPE I

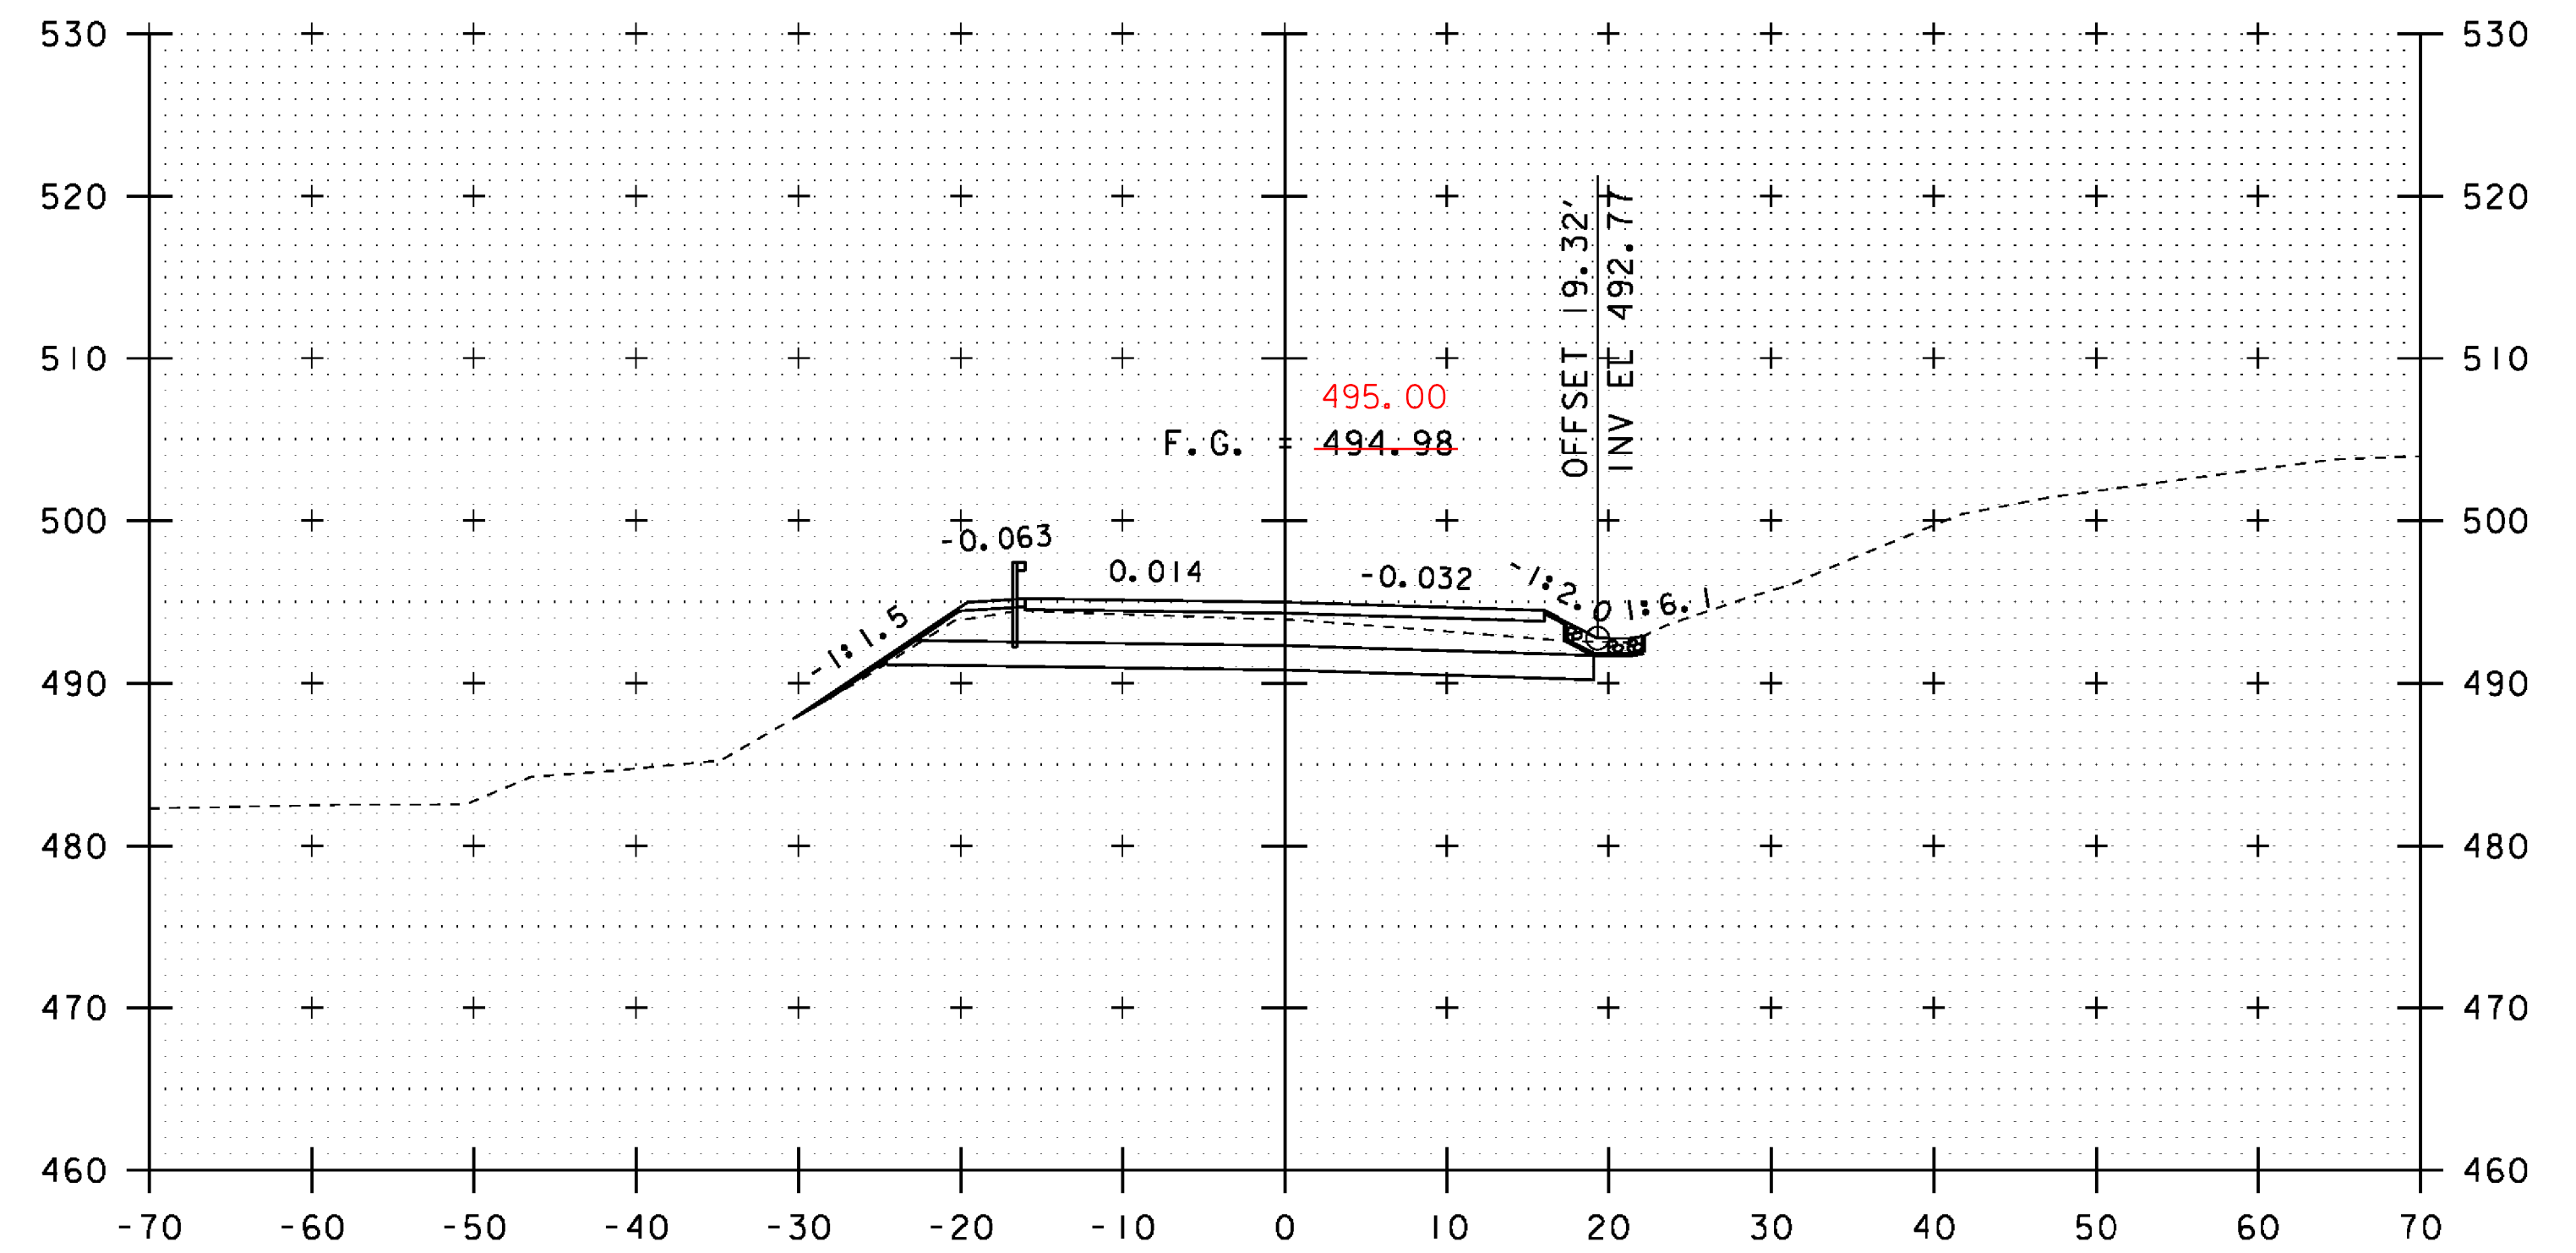

95+00

STA 95+00.00  
END PROJECT  
BEGIN APPROACH

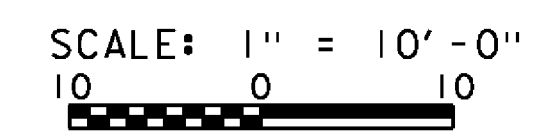


STA. 94+50 TO STA. 95+25


PROJECT NAME: JOHNSON  
PROJECT NUMBER: BRF 030-2(26)

FILE NAME: s88bi93xsl.dgn  
PROJECT LEADER: C. CARLSON  
DESIGNED BY: H. SALLS  
VT 15 CROSS SECTIONS (7)


PLOT DATE: 10-JUN-2014  
DRAWN BY: G. ROY  
CHECKED BY: H. SALLS  
SHEET 48 OF 69

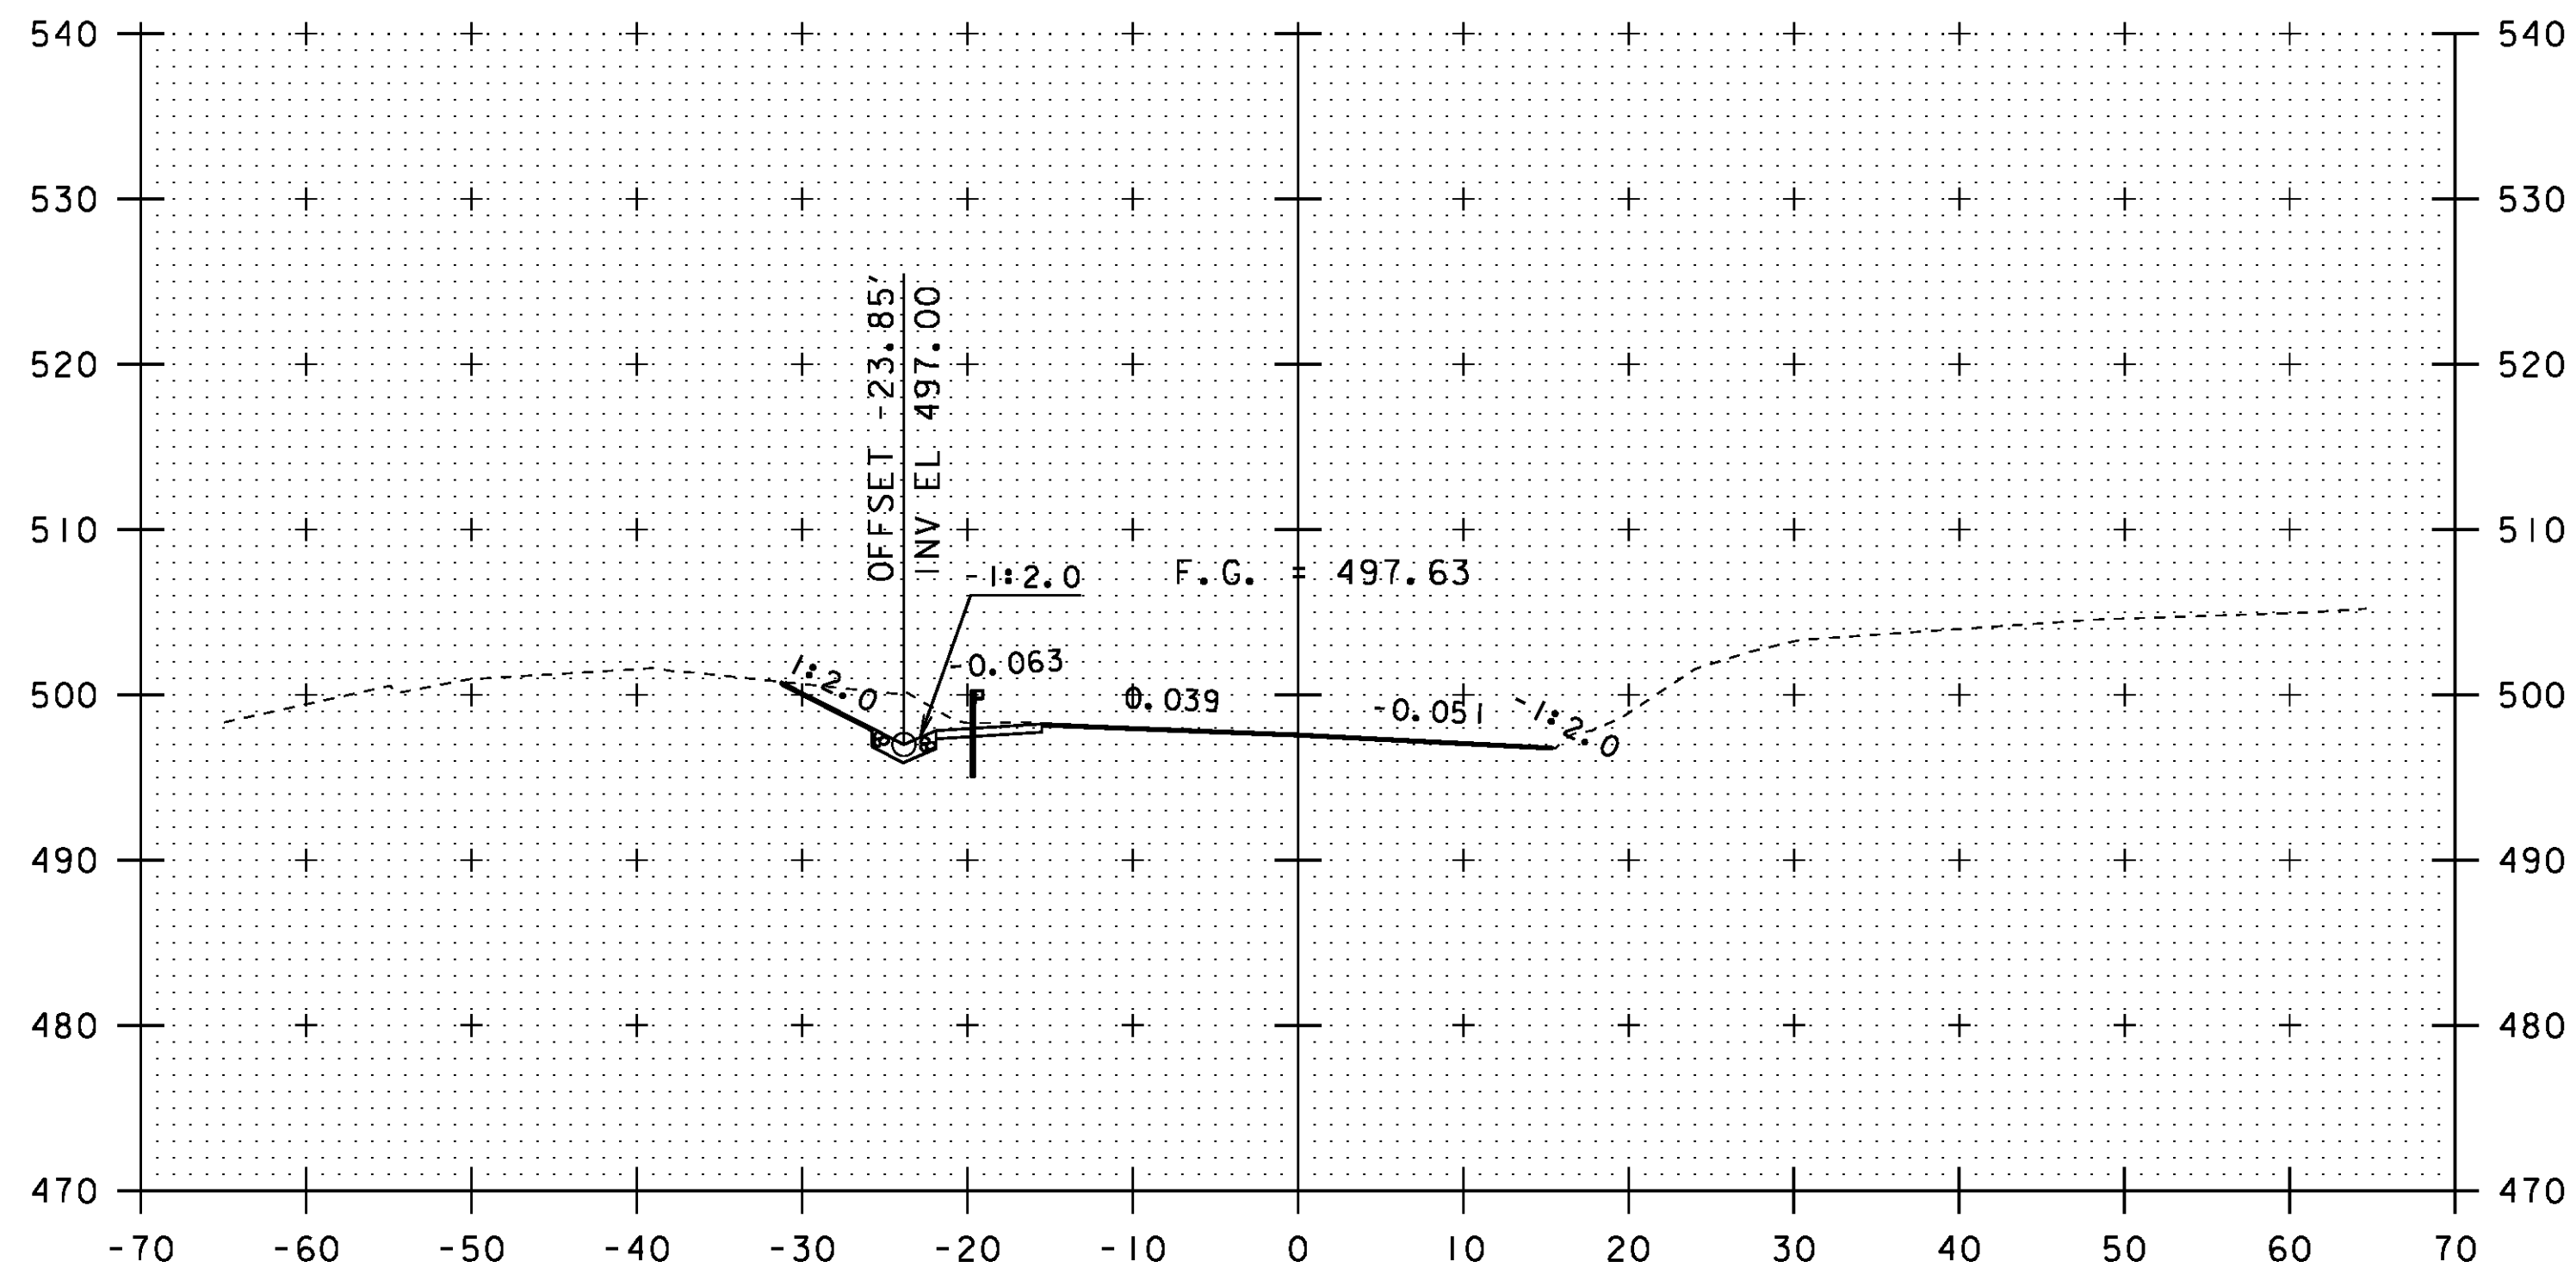


95+75

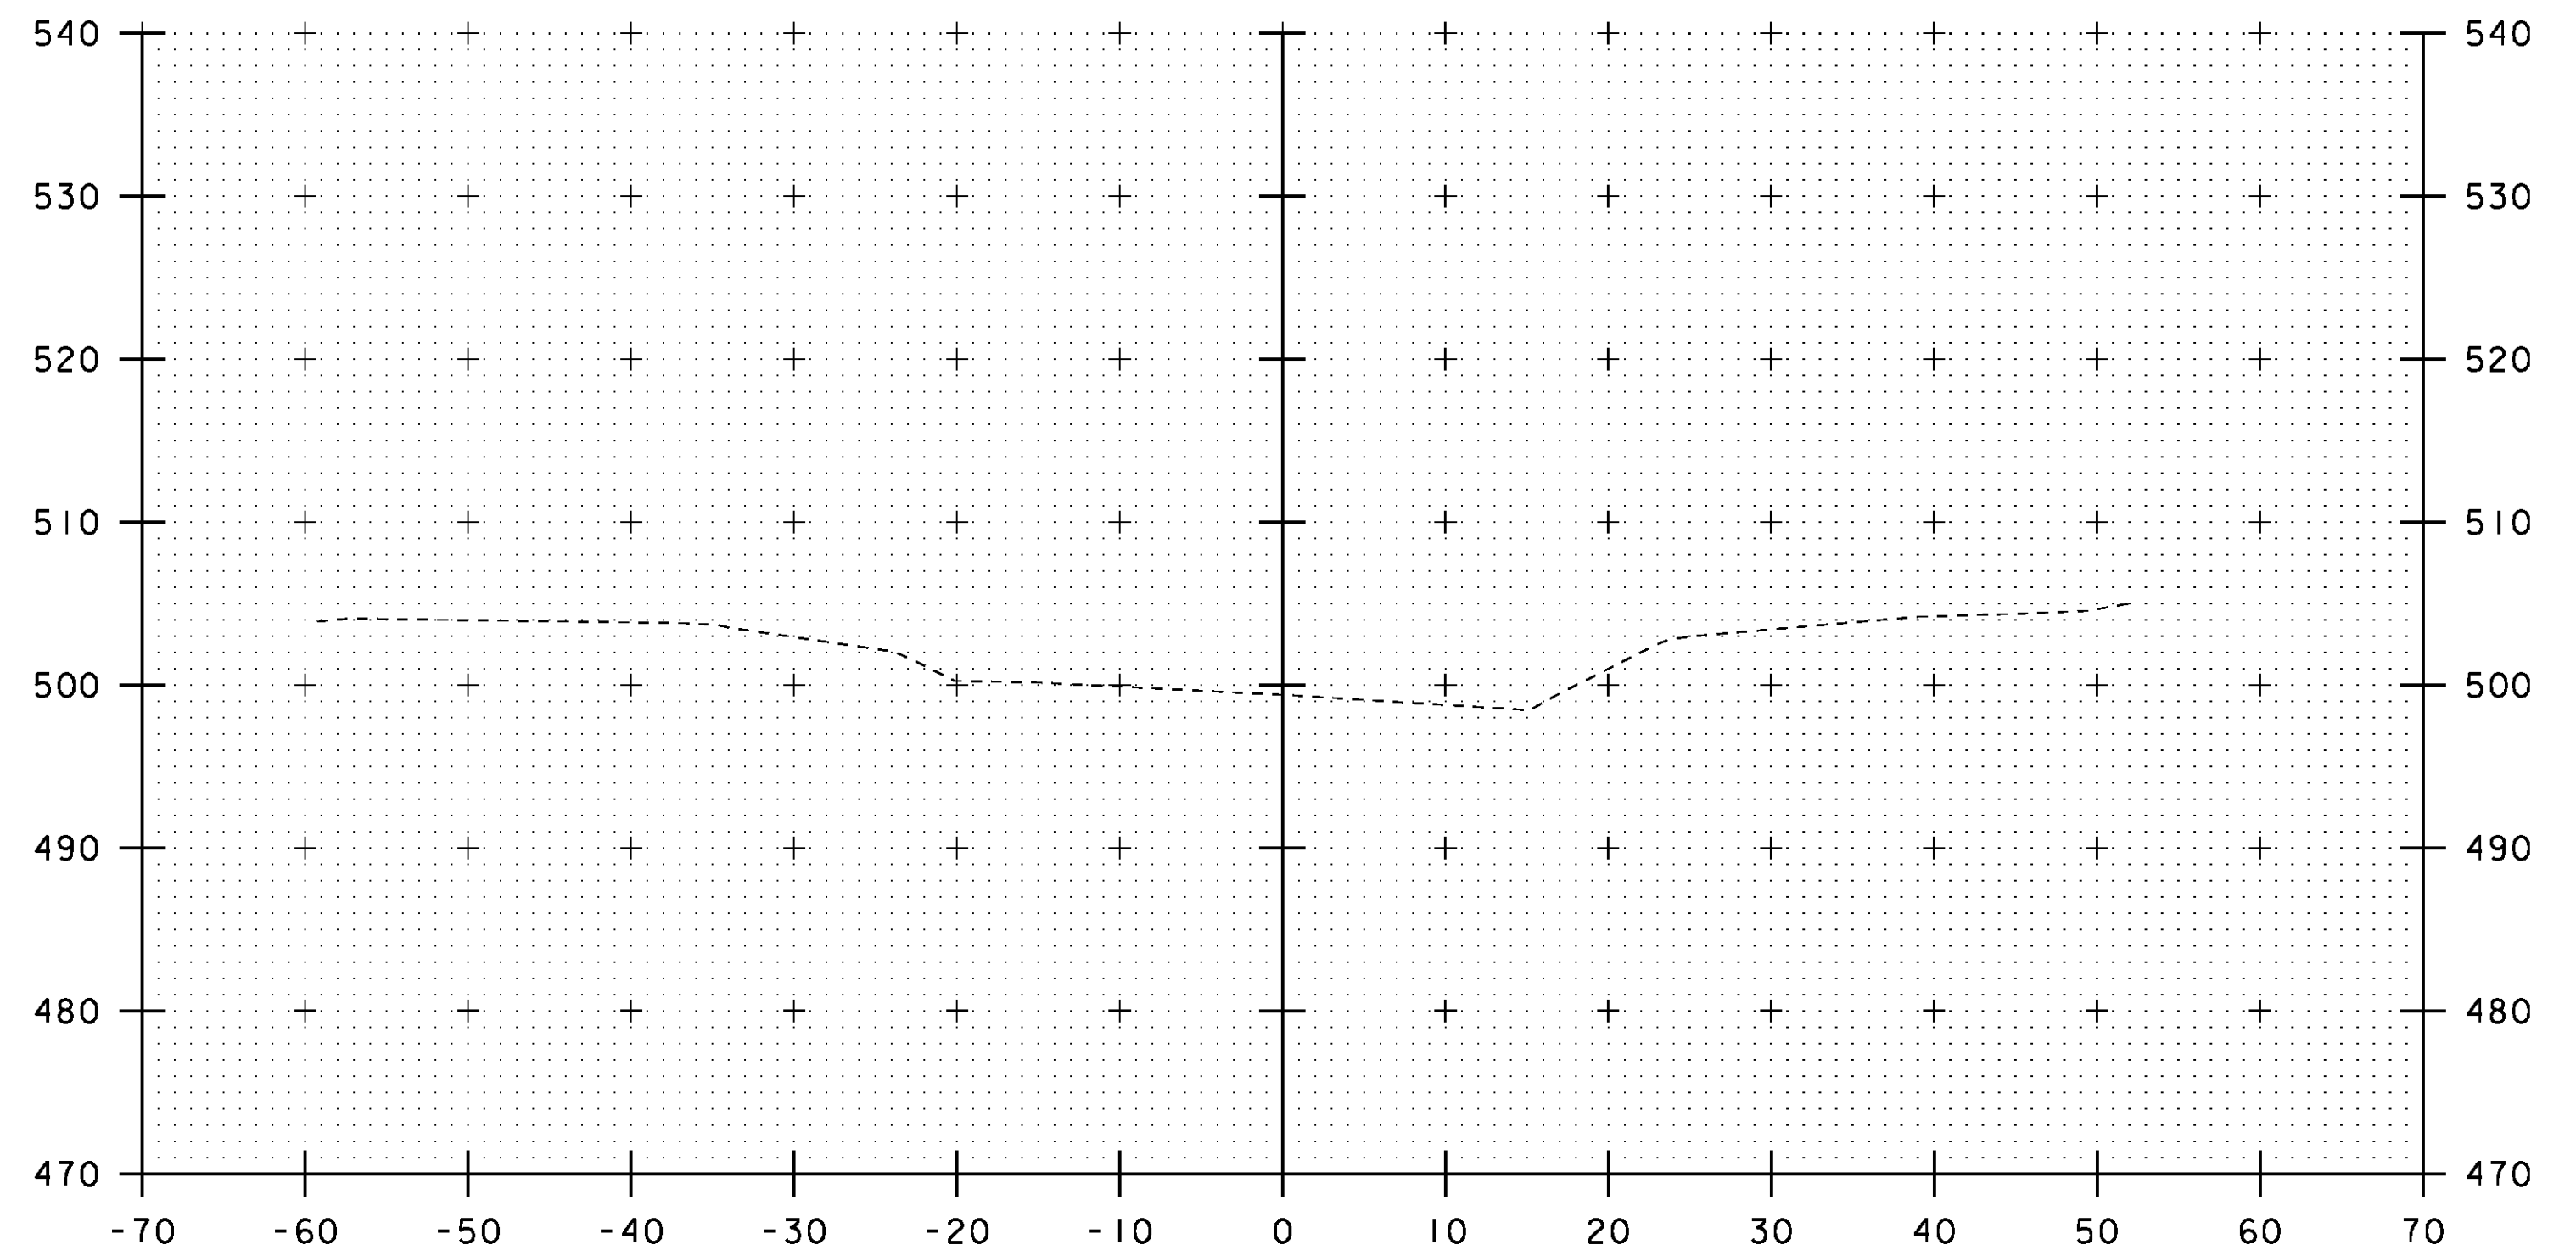

96+25

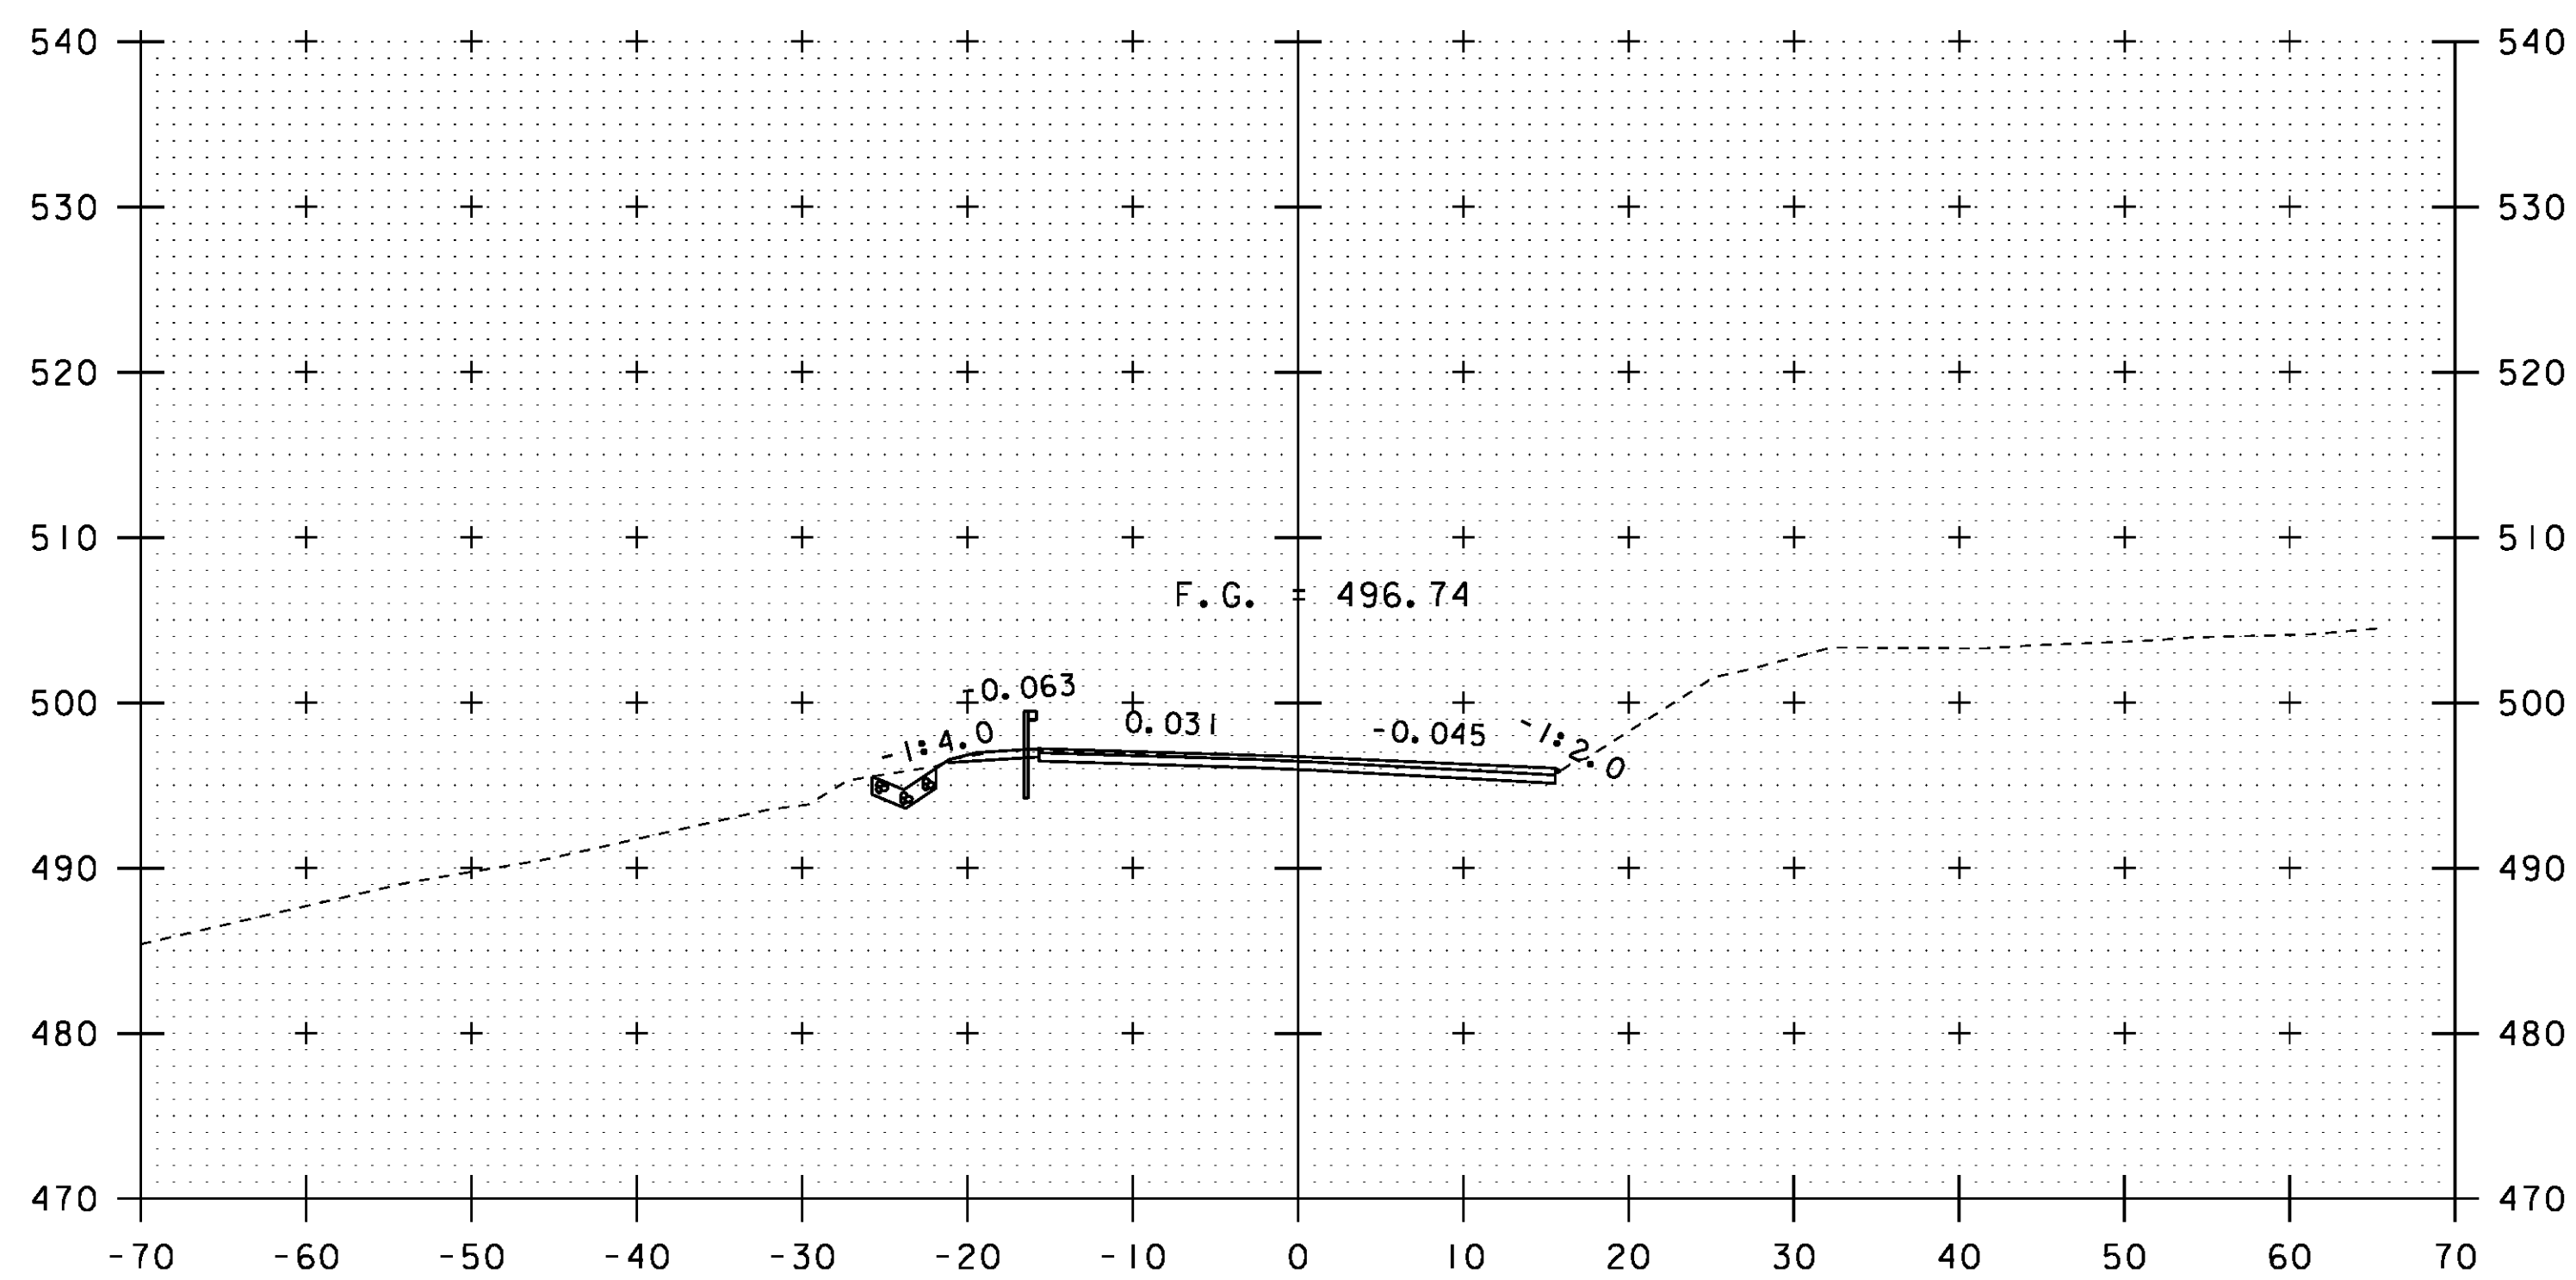

95+50

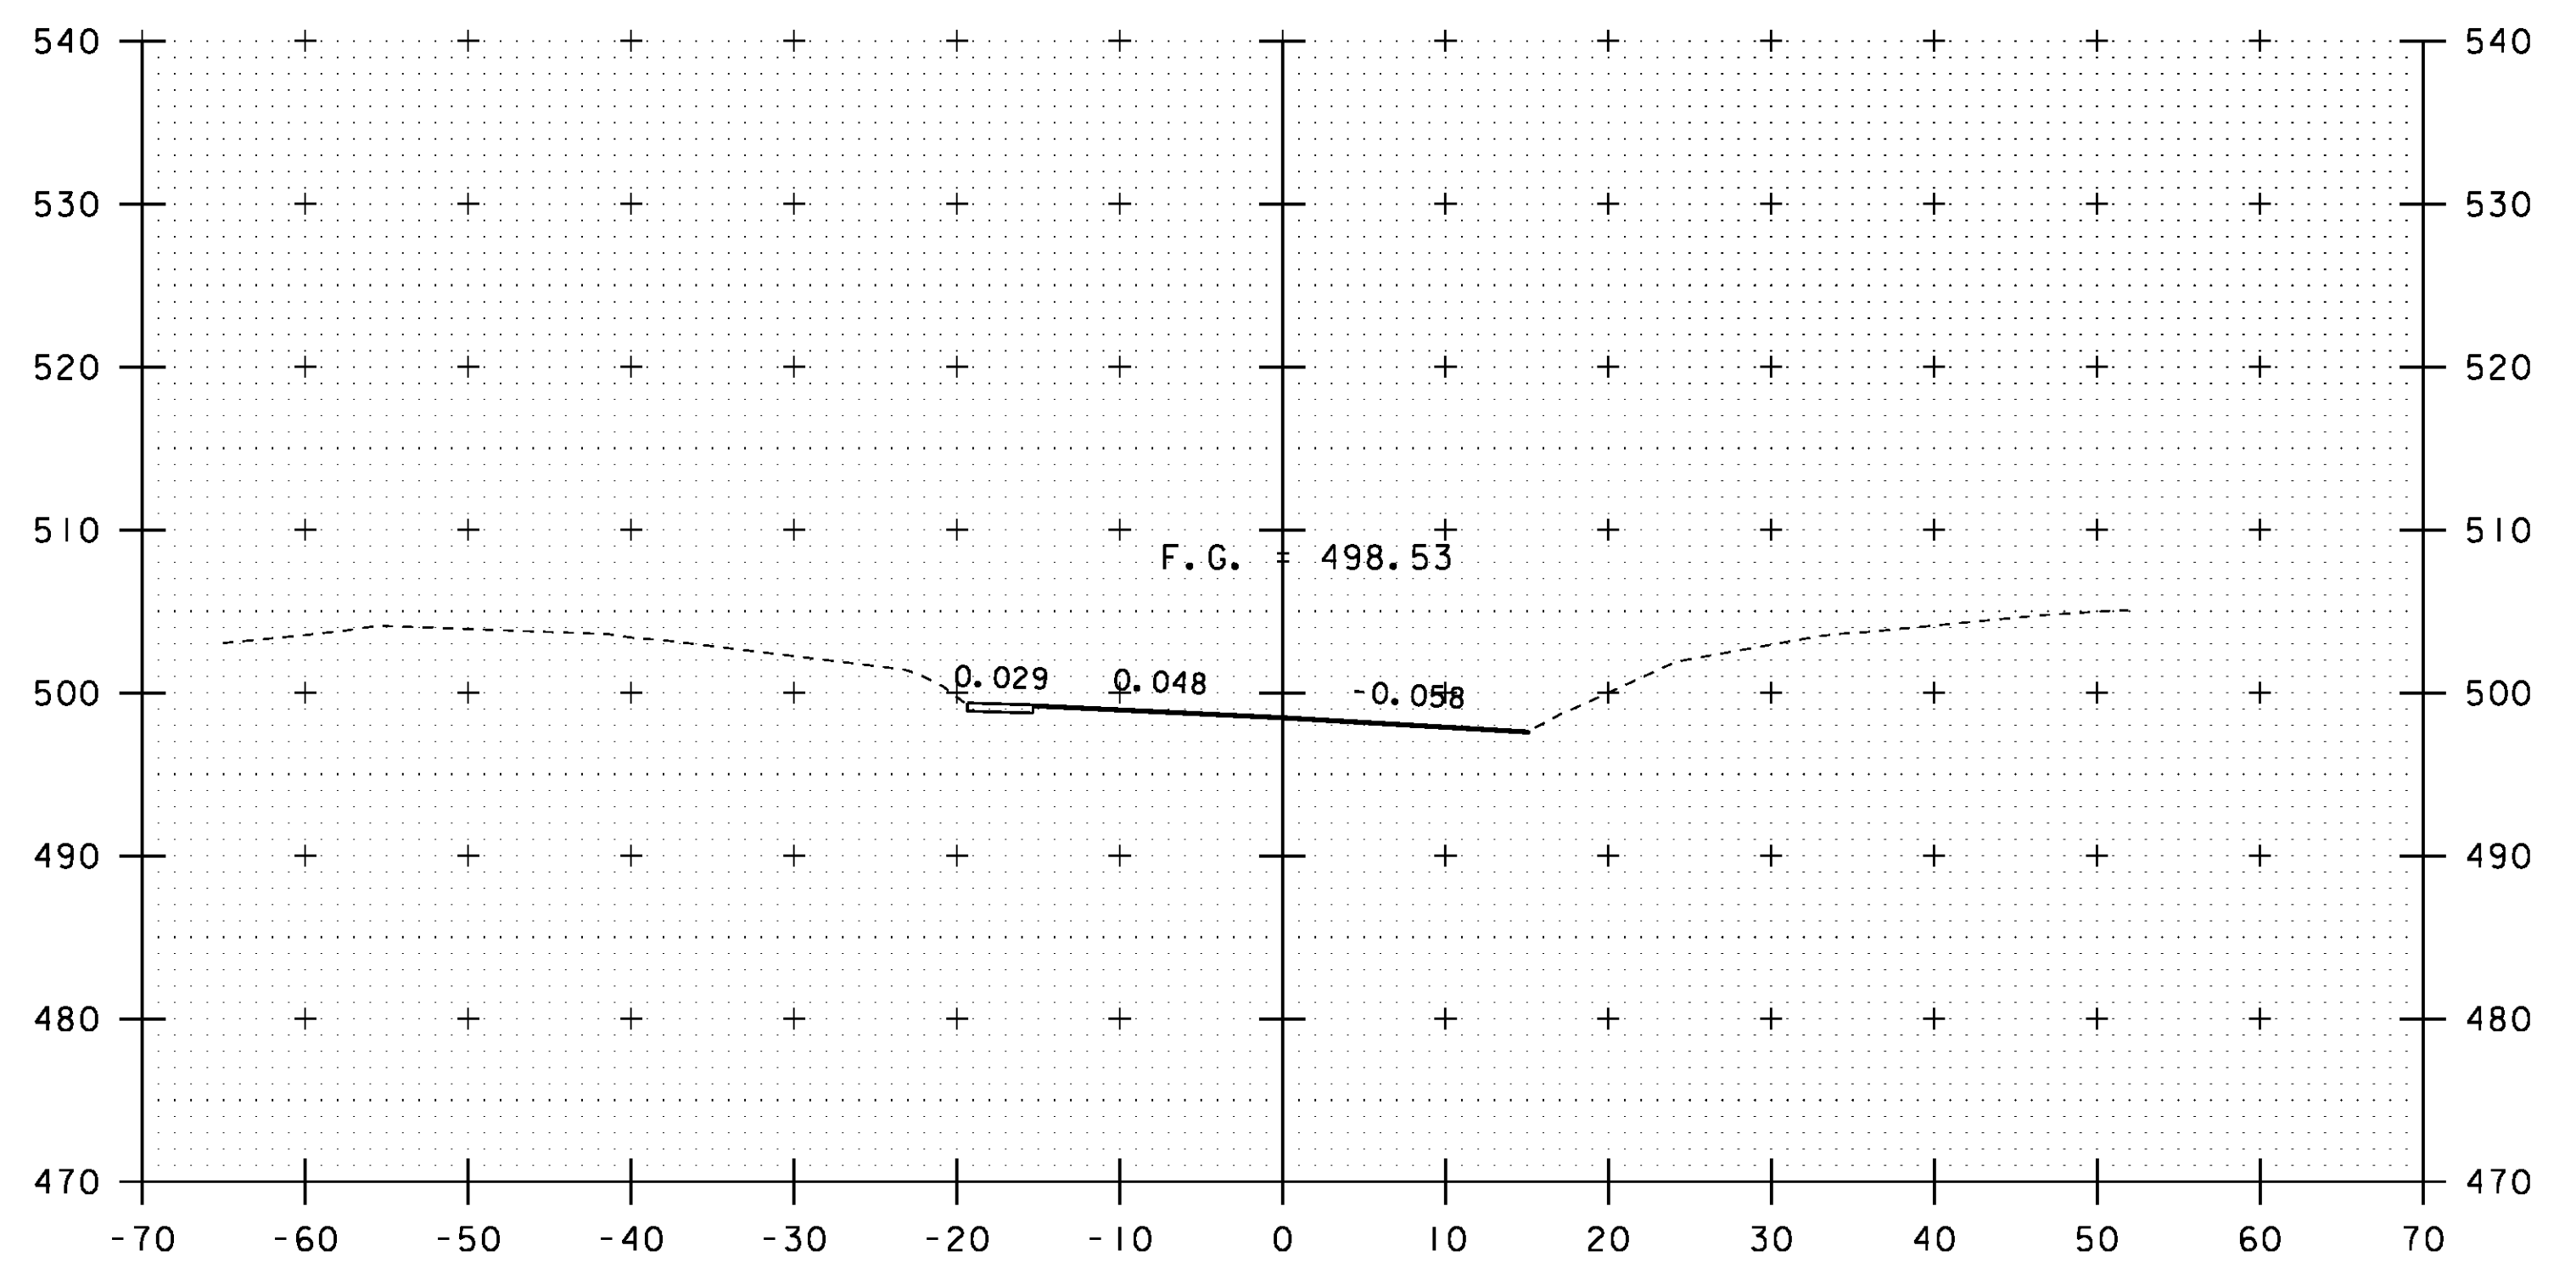

96+00

STA 95+50.0 LT - STA 96+00.0 LT  
CONSTRUCT STONE-LINED DITCH, TYPE I

STA 96+00.00  
END APPROACH  
MATCH EXISTING


SCALE: 1" = 10'-0"  
10 0 10

STA. 95+50 TO STA. 96+25

PROJECT NAME: JOHNSON  
PROJECT NUMBER: BRF 030-2(26)

FILE NAME: s88bl93xsl.dgn  
PROJECT LEADER: C. CARLSON  
DESIGNED BY: H. SALLS  
VT 15 CROSS SECTIONS (8)


PLOT DATE: 10-JUN-2014  
DRAWN BY: G. ROY  
CHECKED BY: H. SALLS  
SHEET 49 OF 69

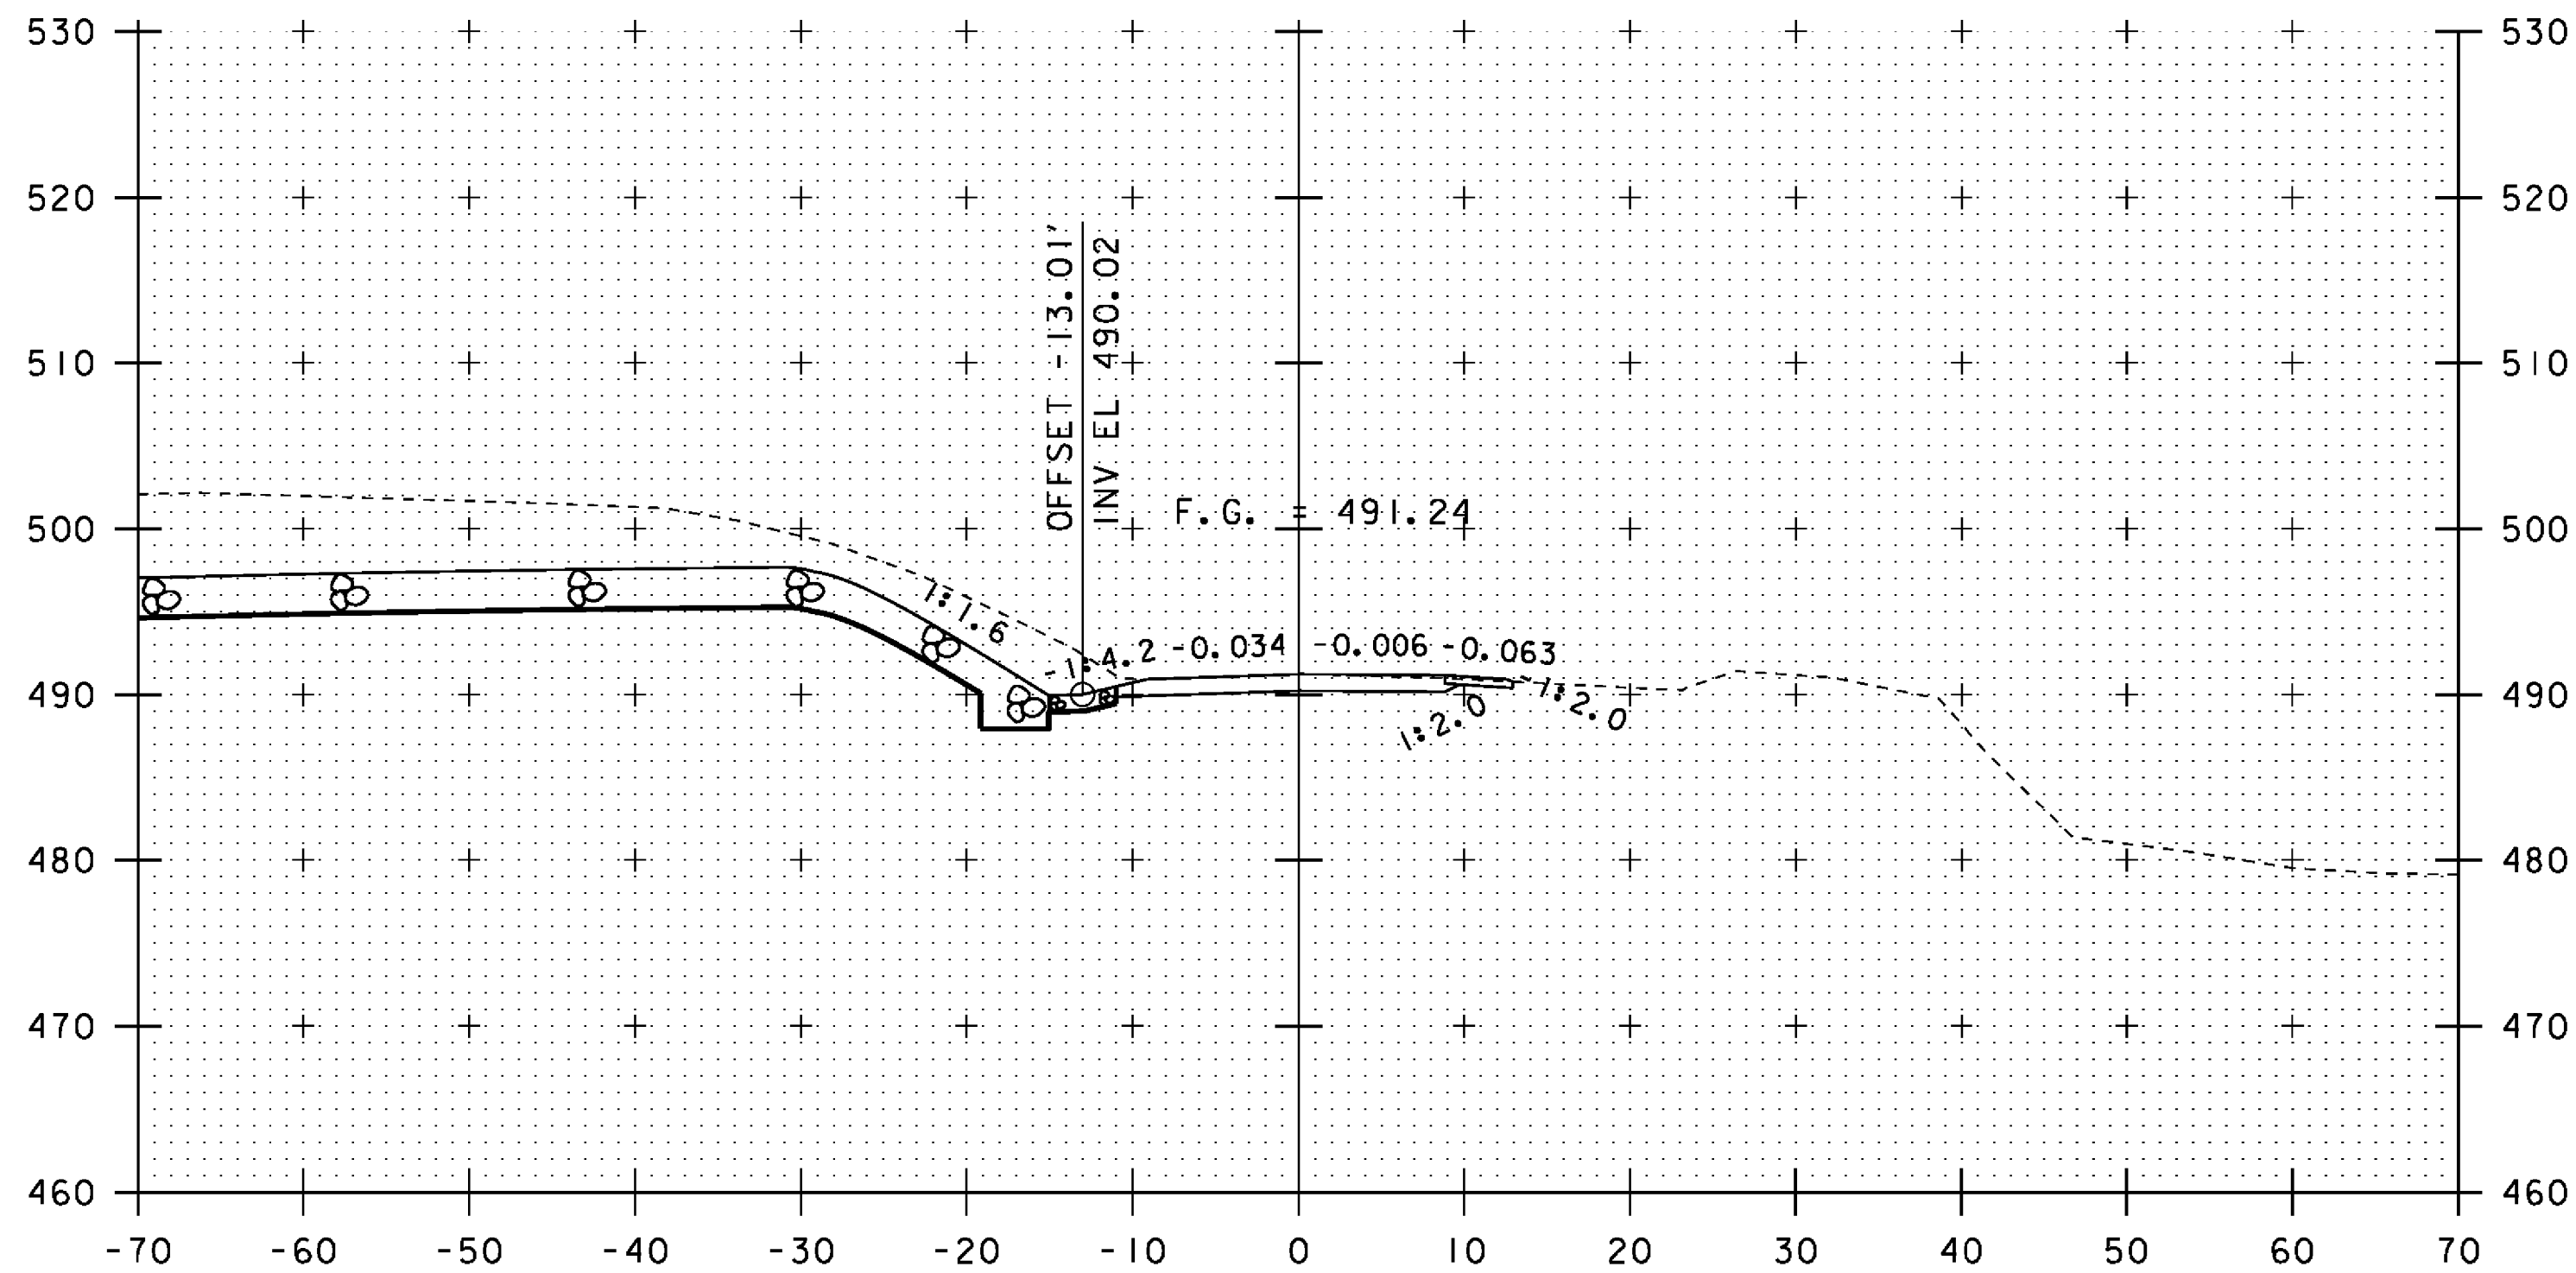


30+25.0  
 STA 30+29.2 LT - STA 30+75.0 LT  
 CONSTRUCT STONE-LINED DITCH, TYPE I

30+25.0  
 STA 30+33.3 LT - STA 30+75.0 LT  
 CONSTRUCT STONE FILL, TYPE II BANK SLOPE

30+50

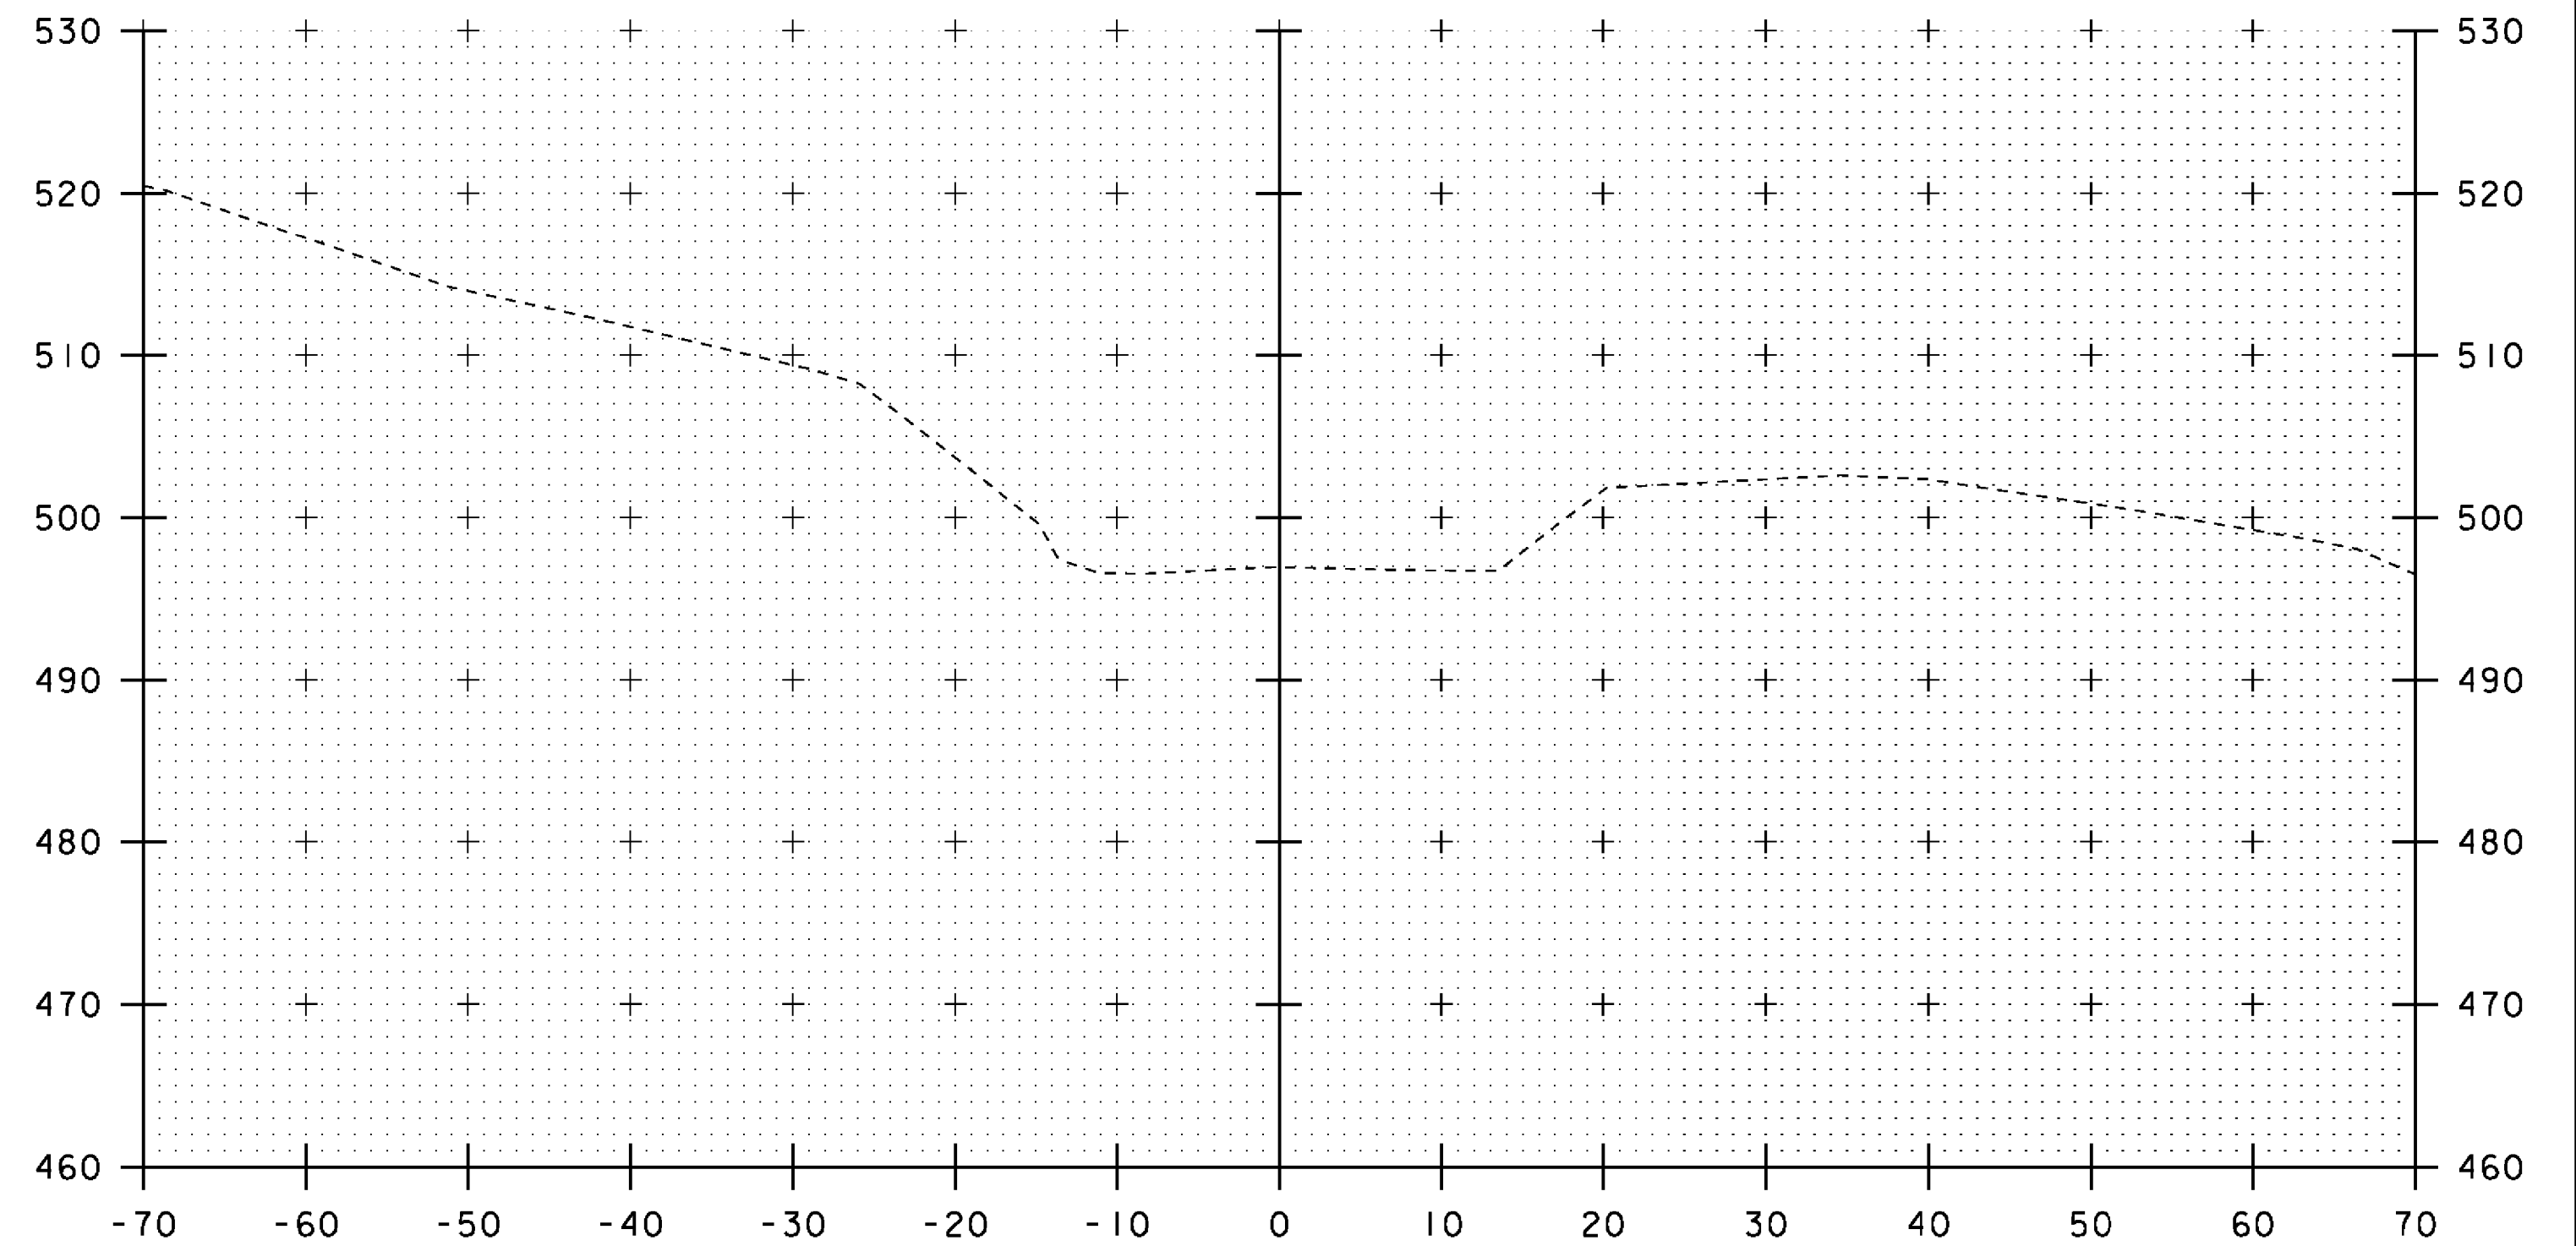


31+00

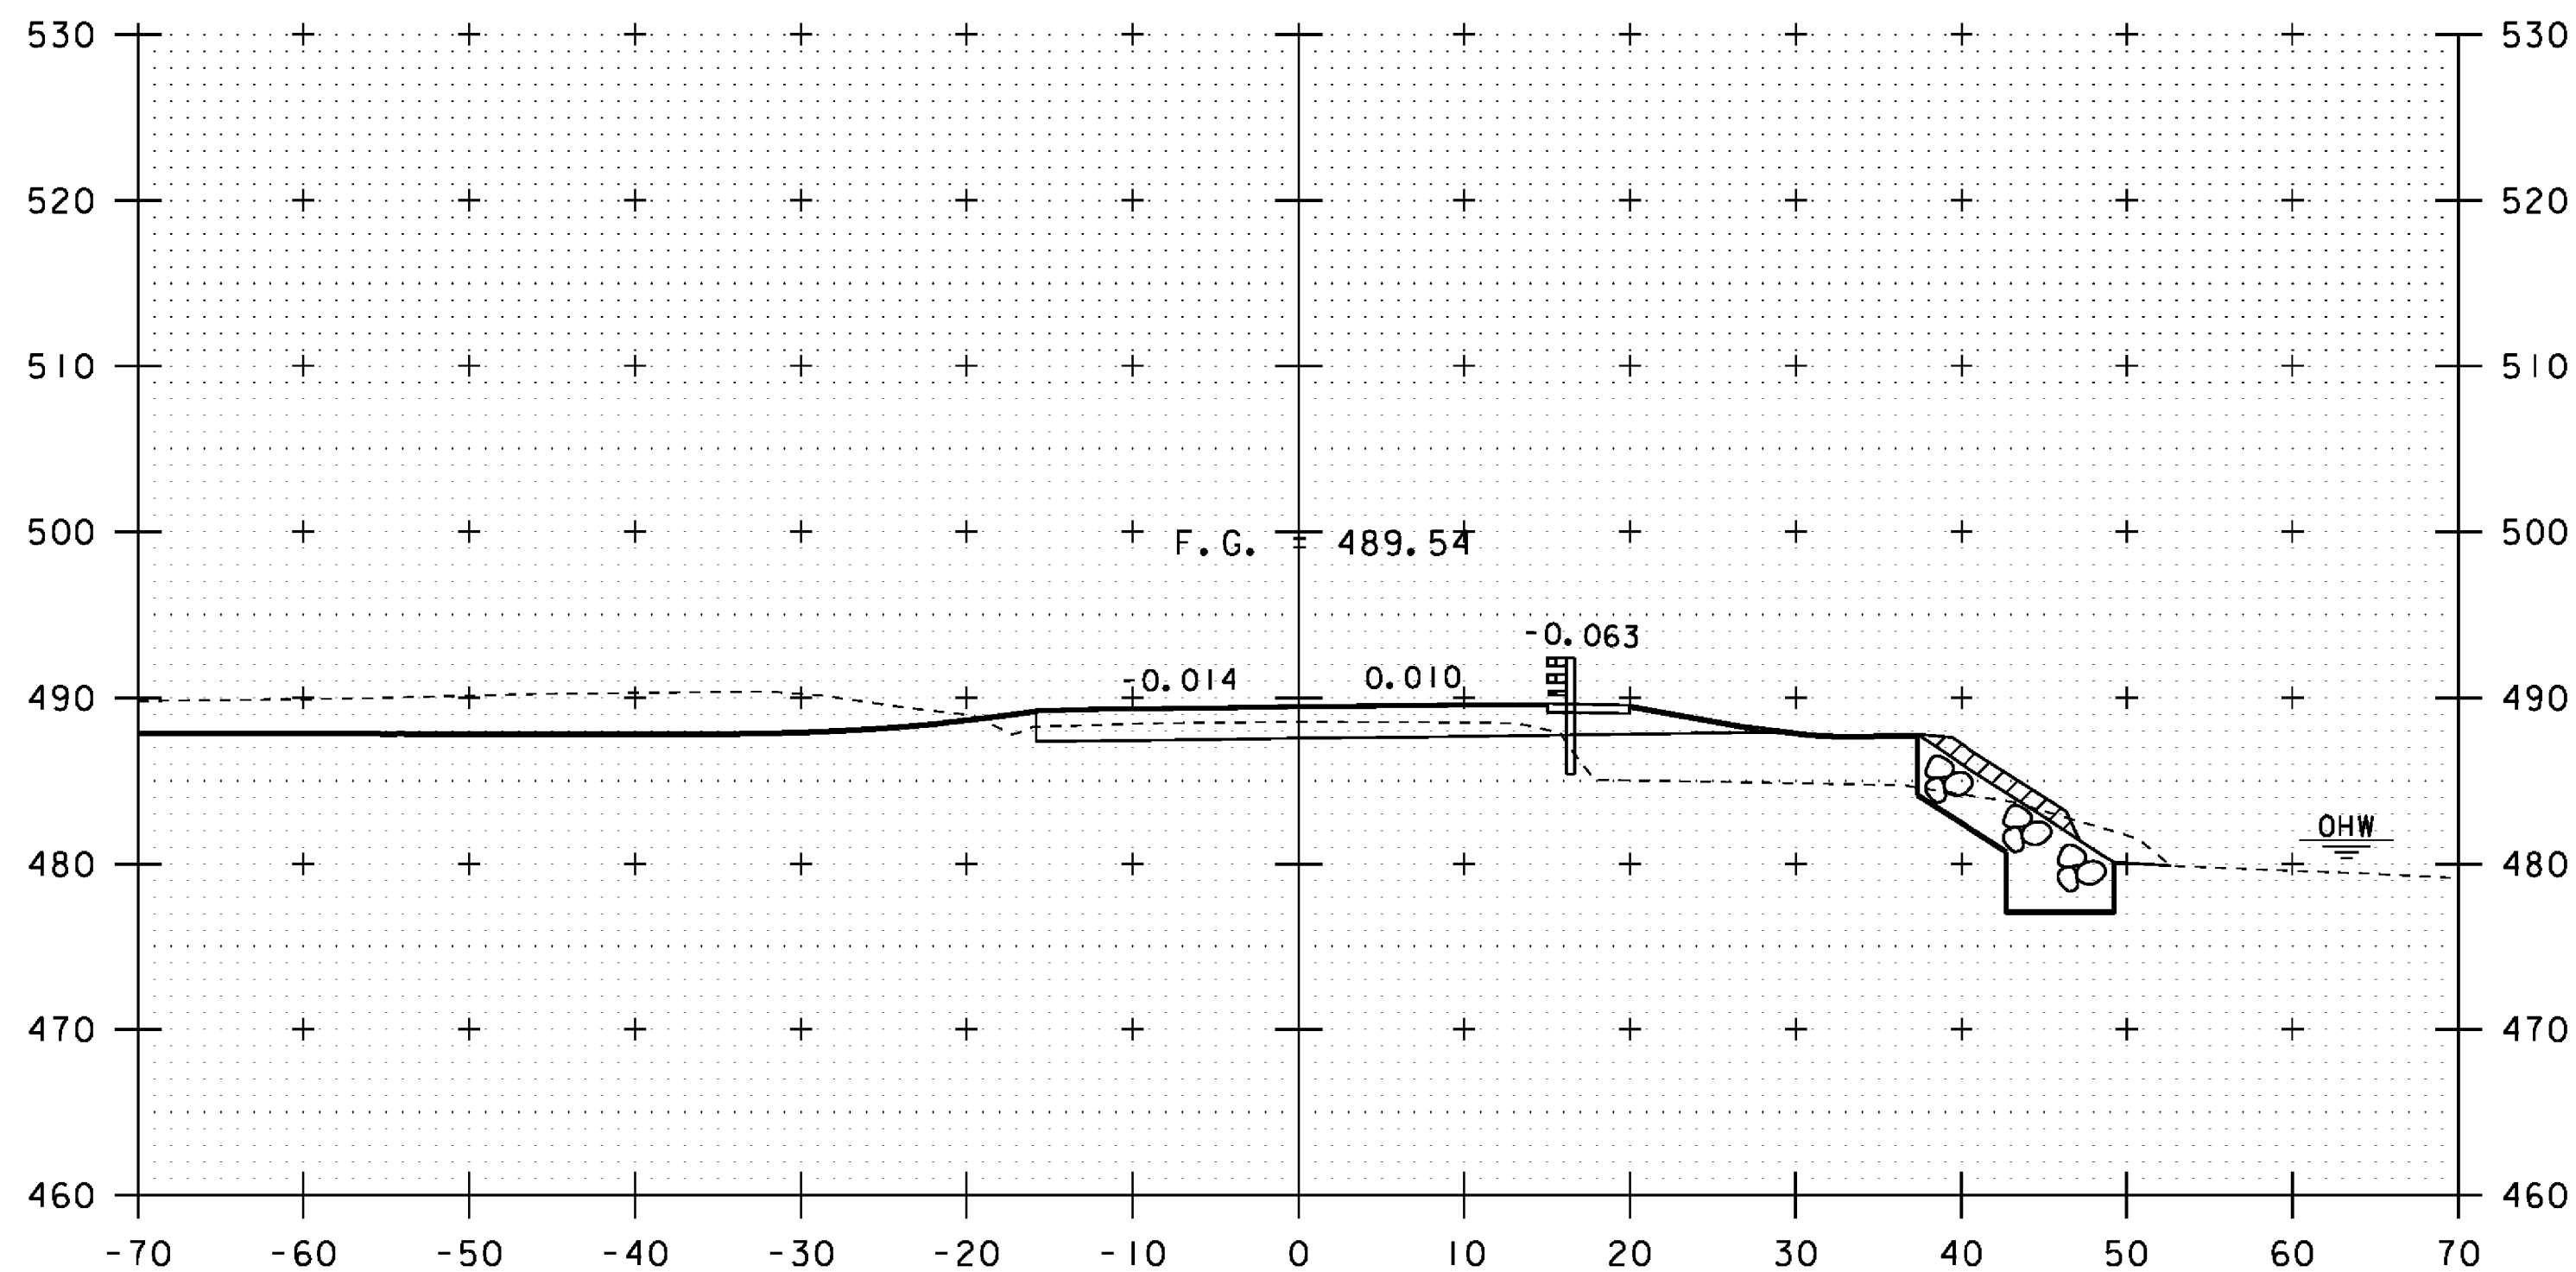

STA 30+16.00  
 BEGIN SIDELINE ROADWAY

30+25

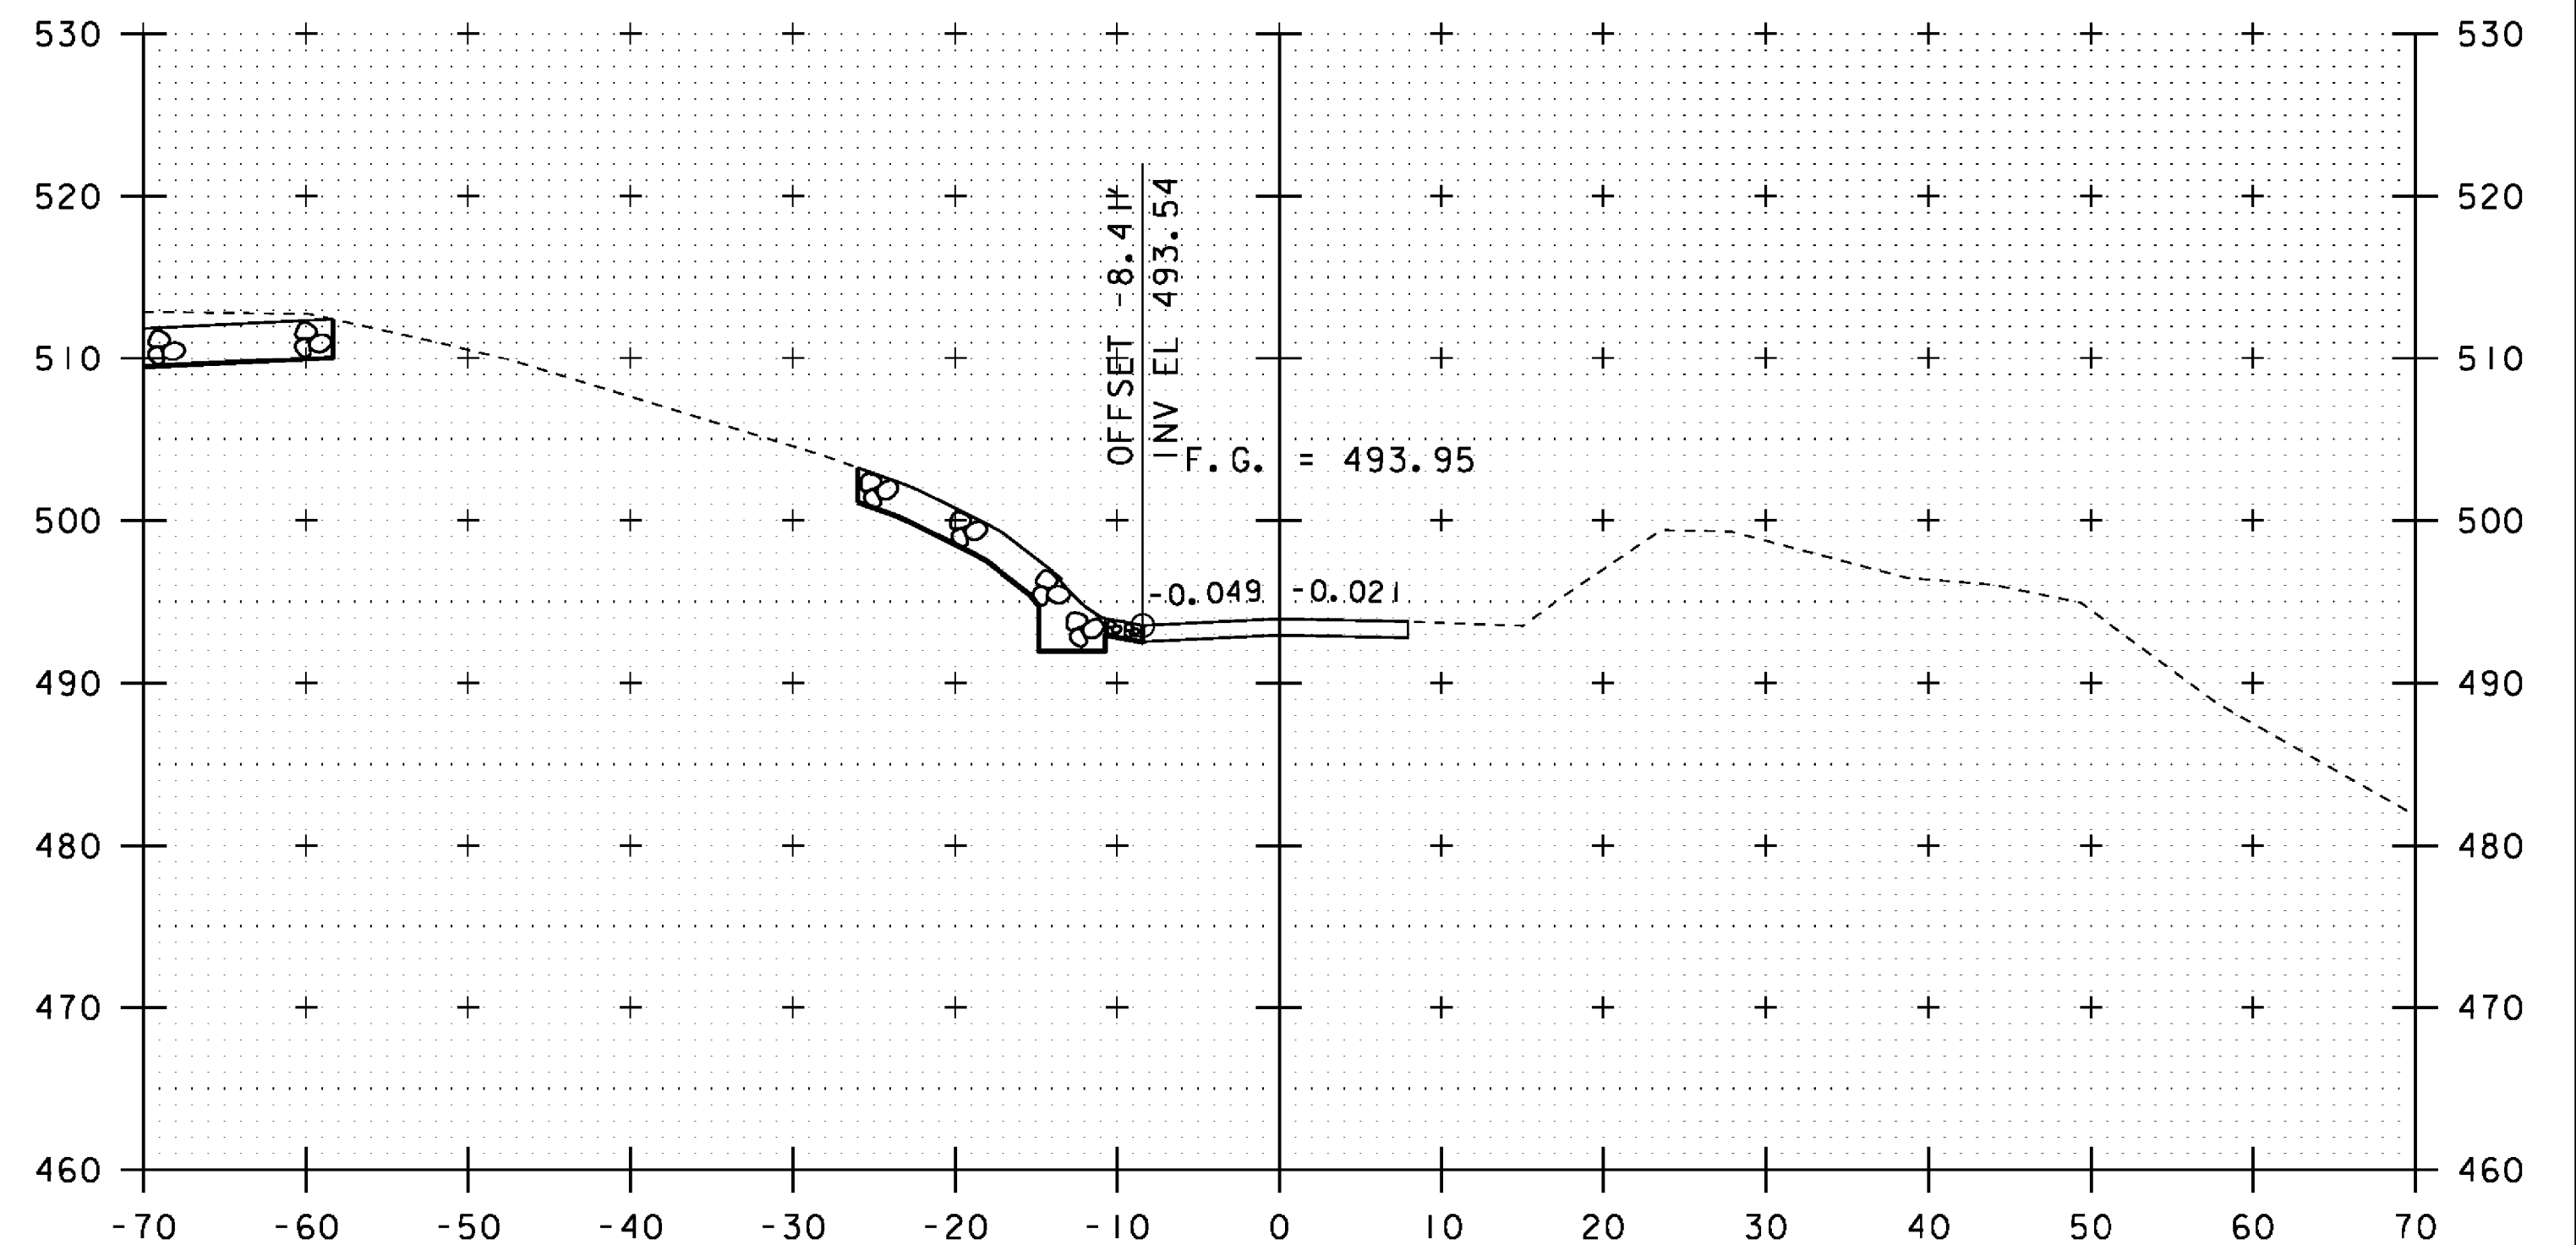

STA 30+75.00  
 END SIDELINE ROADWAY  
 MATCH EXISTING

30+75


SCALE: 1" = 10'-0"

STA. 30+25 TO STA. 31+00

PROJECT NAME: JOHNSON  
 PROJECT NUMBER: BRF 030-2(26)


FILE NAME: s88bi93xsl.dgn  
 PROJECT LEADER: C. CARLSON  
 DESIGNED BY: H. SALLS  
 TH 71 CROSS SECTIONS

PLOT DATE: 10-JUN-2014  
 DRAWN BY: G. ROY  
 CHECKED BY: H. SALLS  
 SHEET 50 OF 69

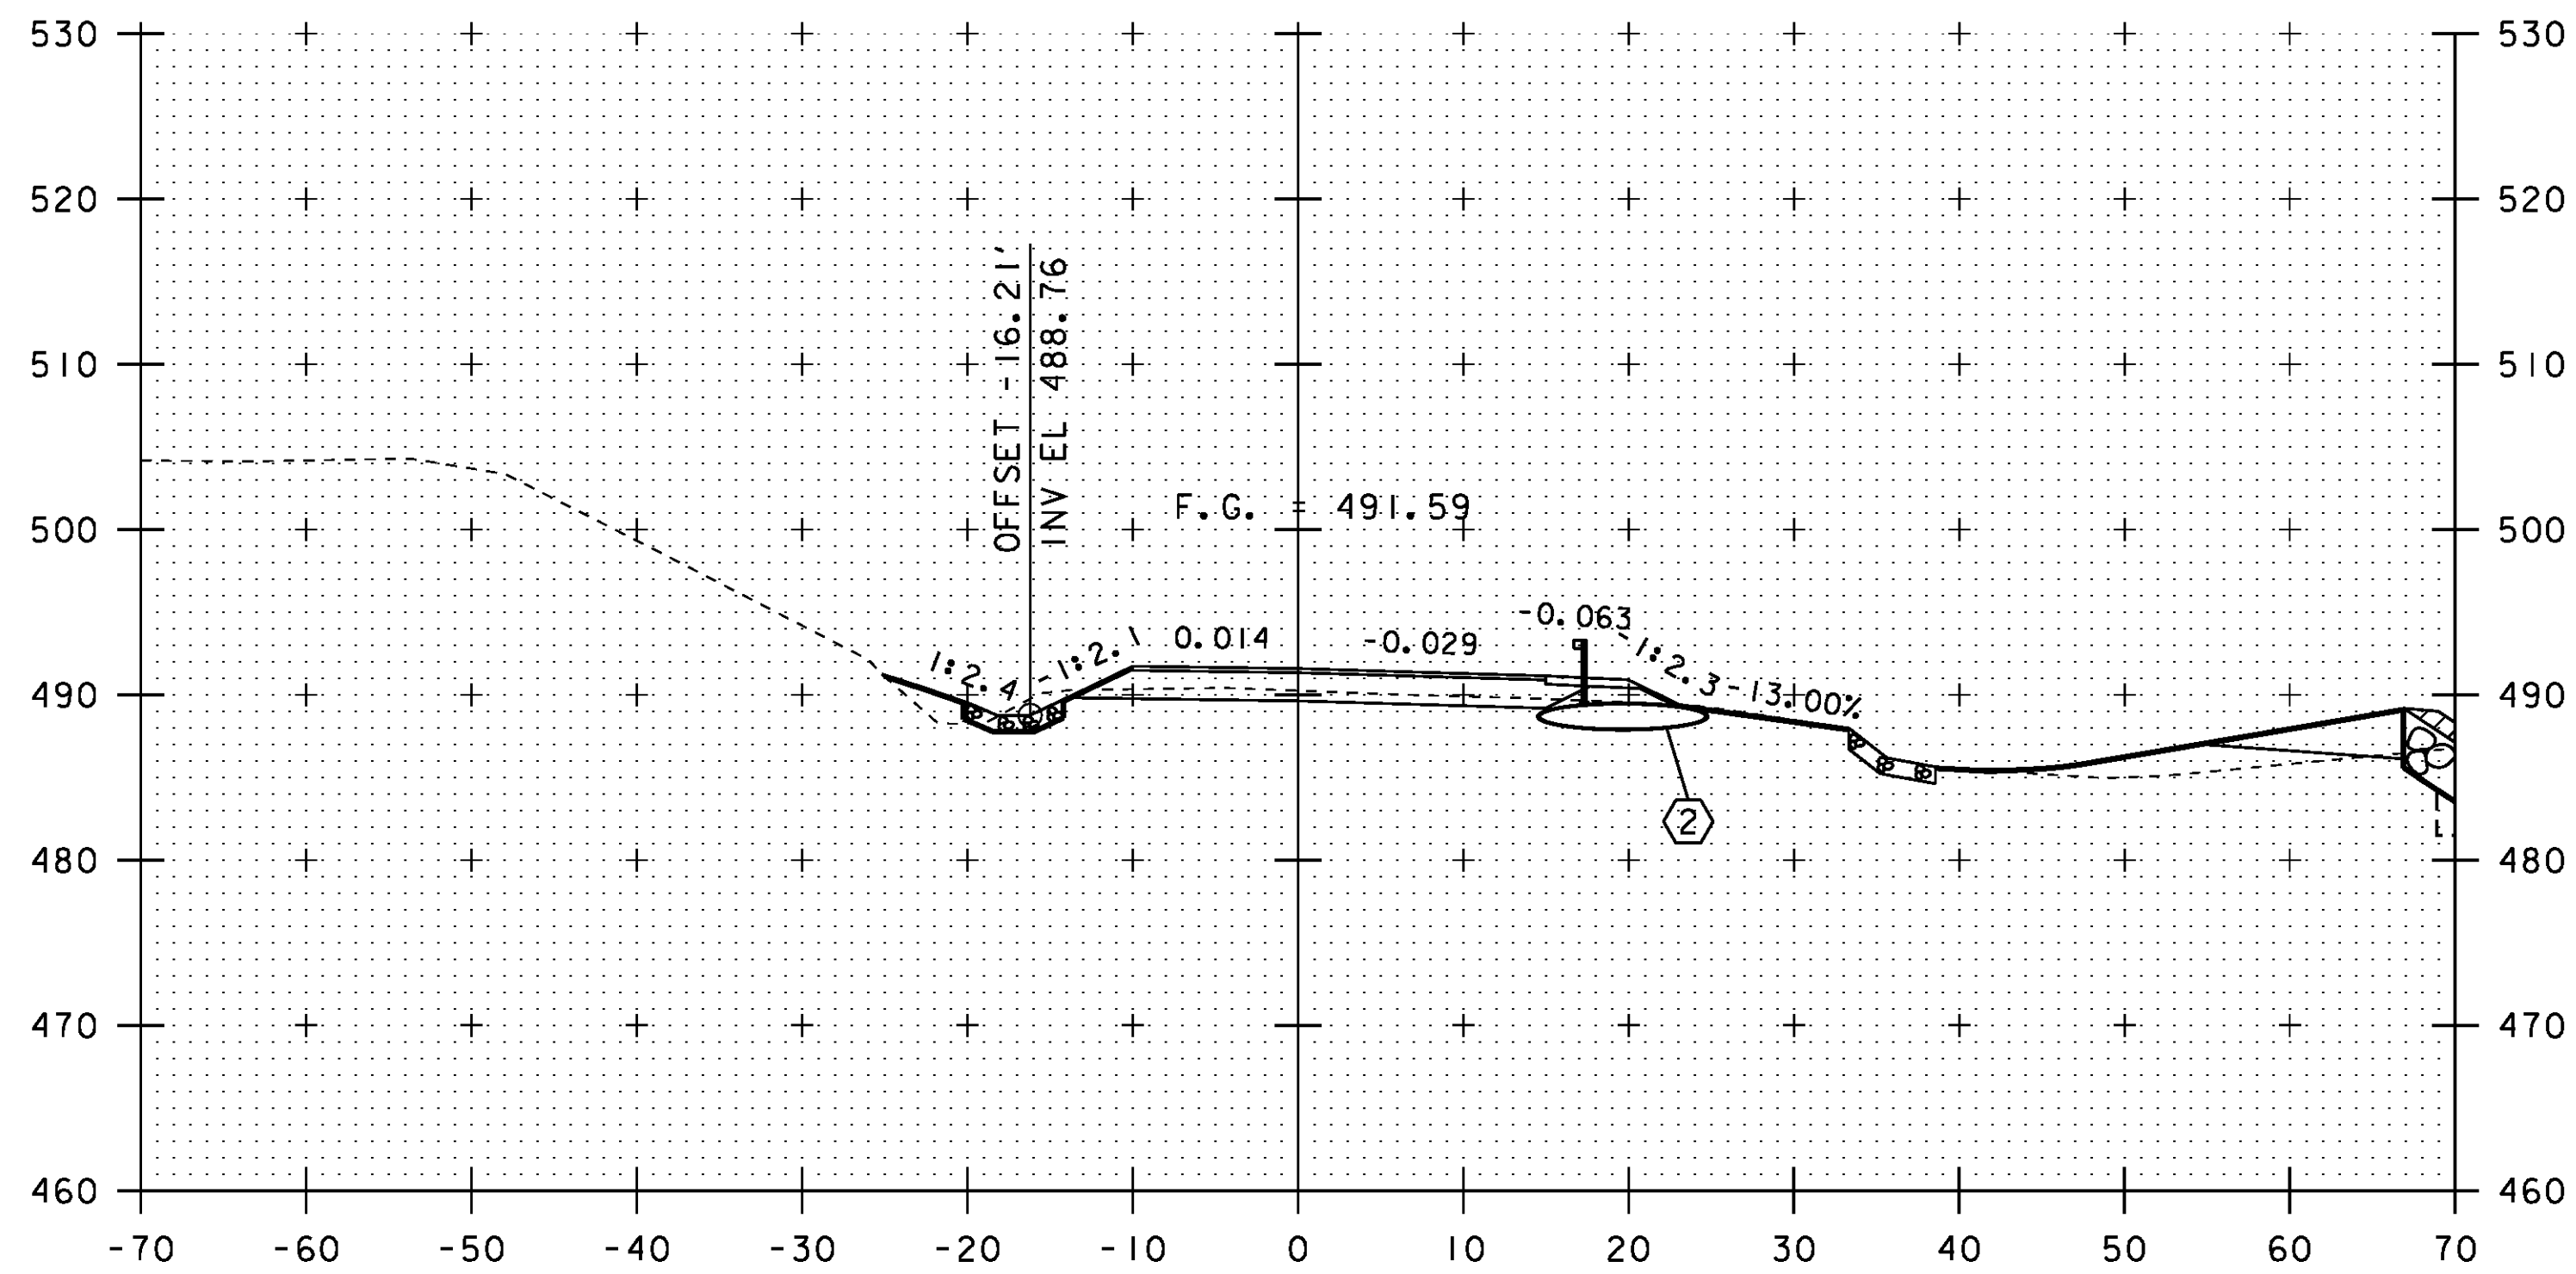


STA 40+45.6 LT - STA 40+90.0 LT  
 CONSTRUCT STONE-LINED DITCH, TYPE I

40+50

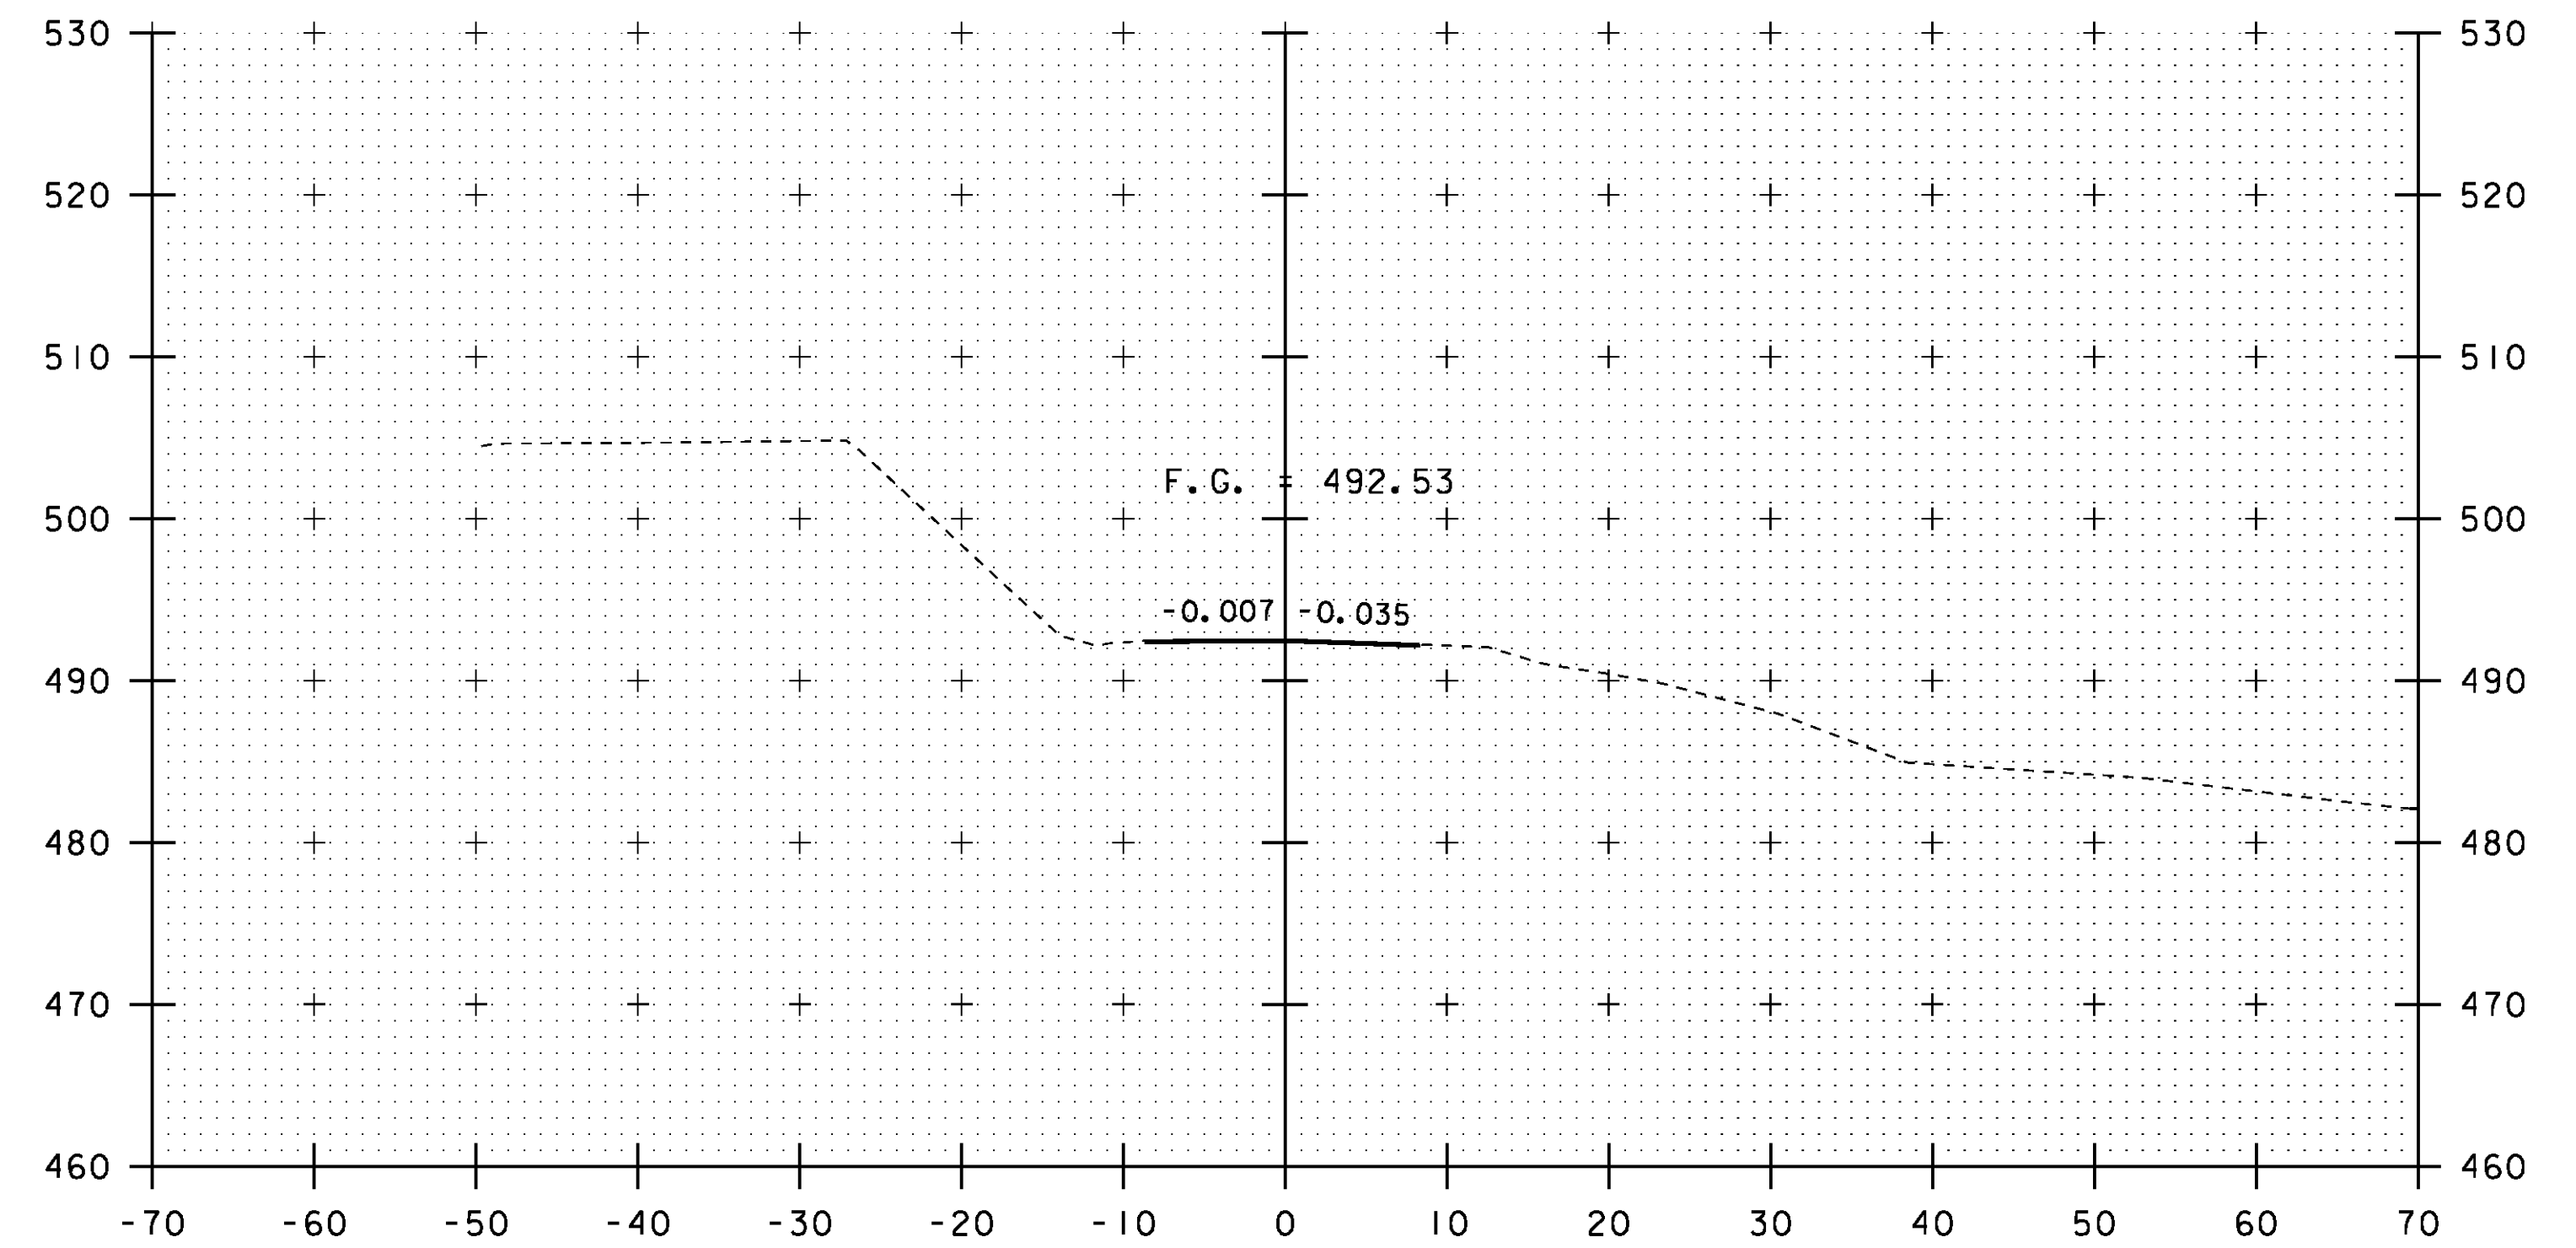


STA 41+00.00  
 END SIDELINE ROADWAY  
 MATCH EXISTING

41+00

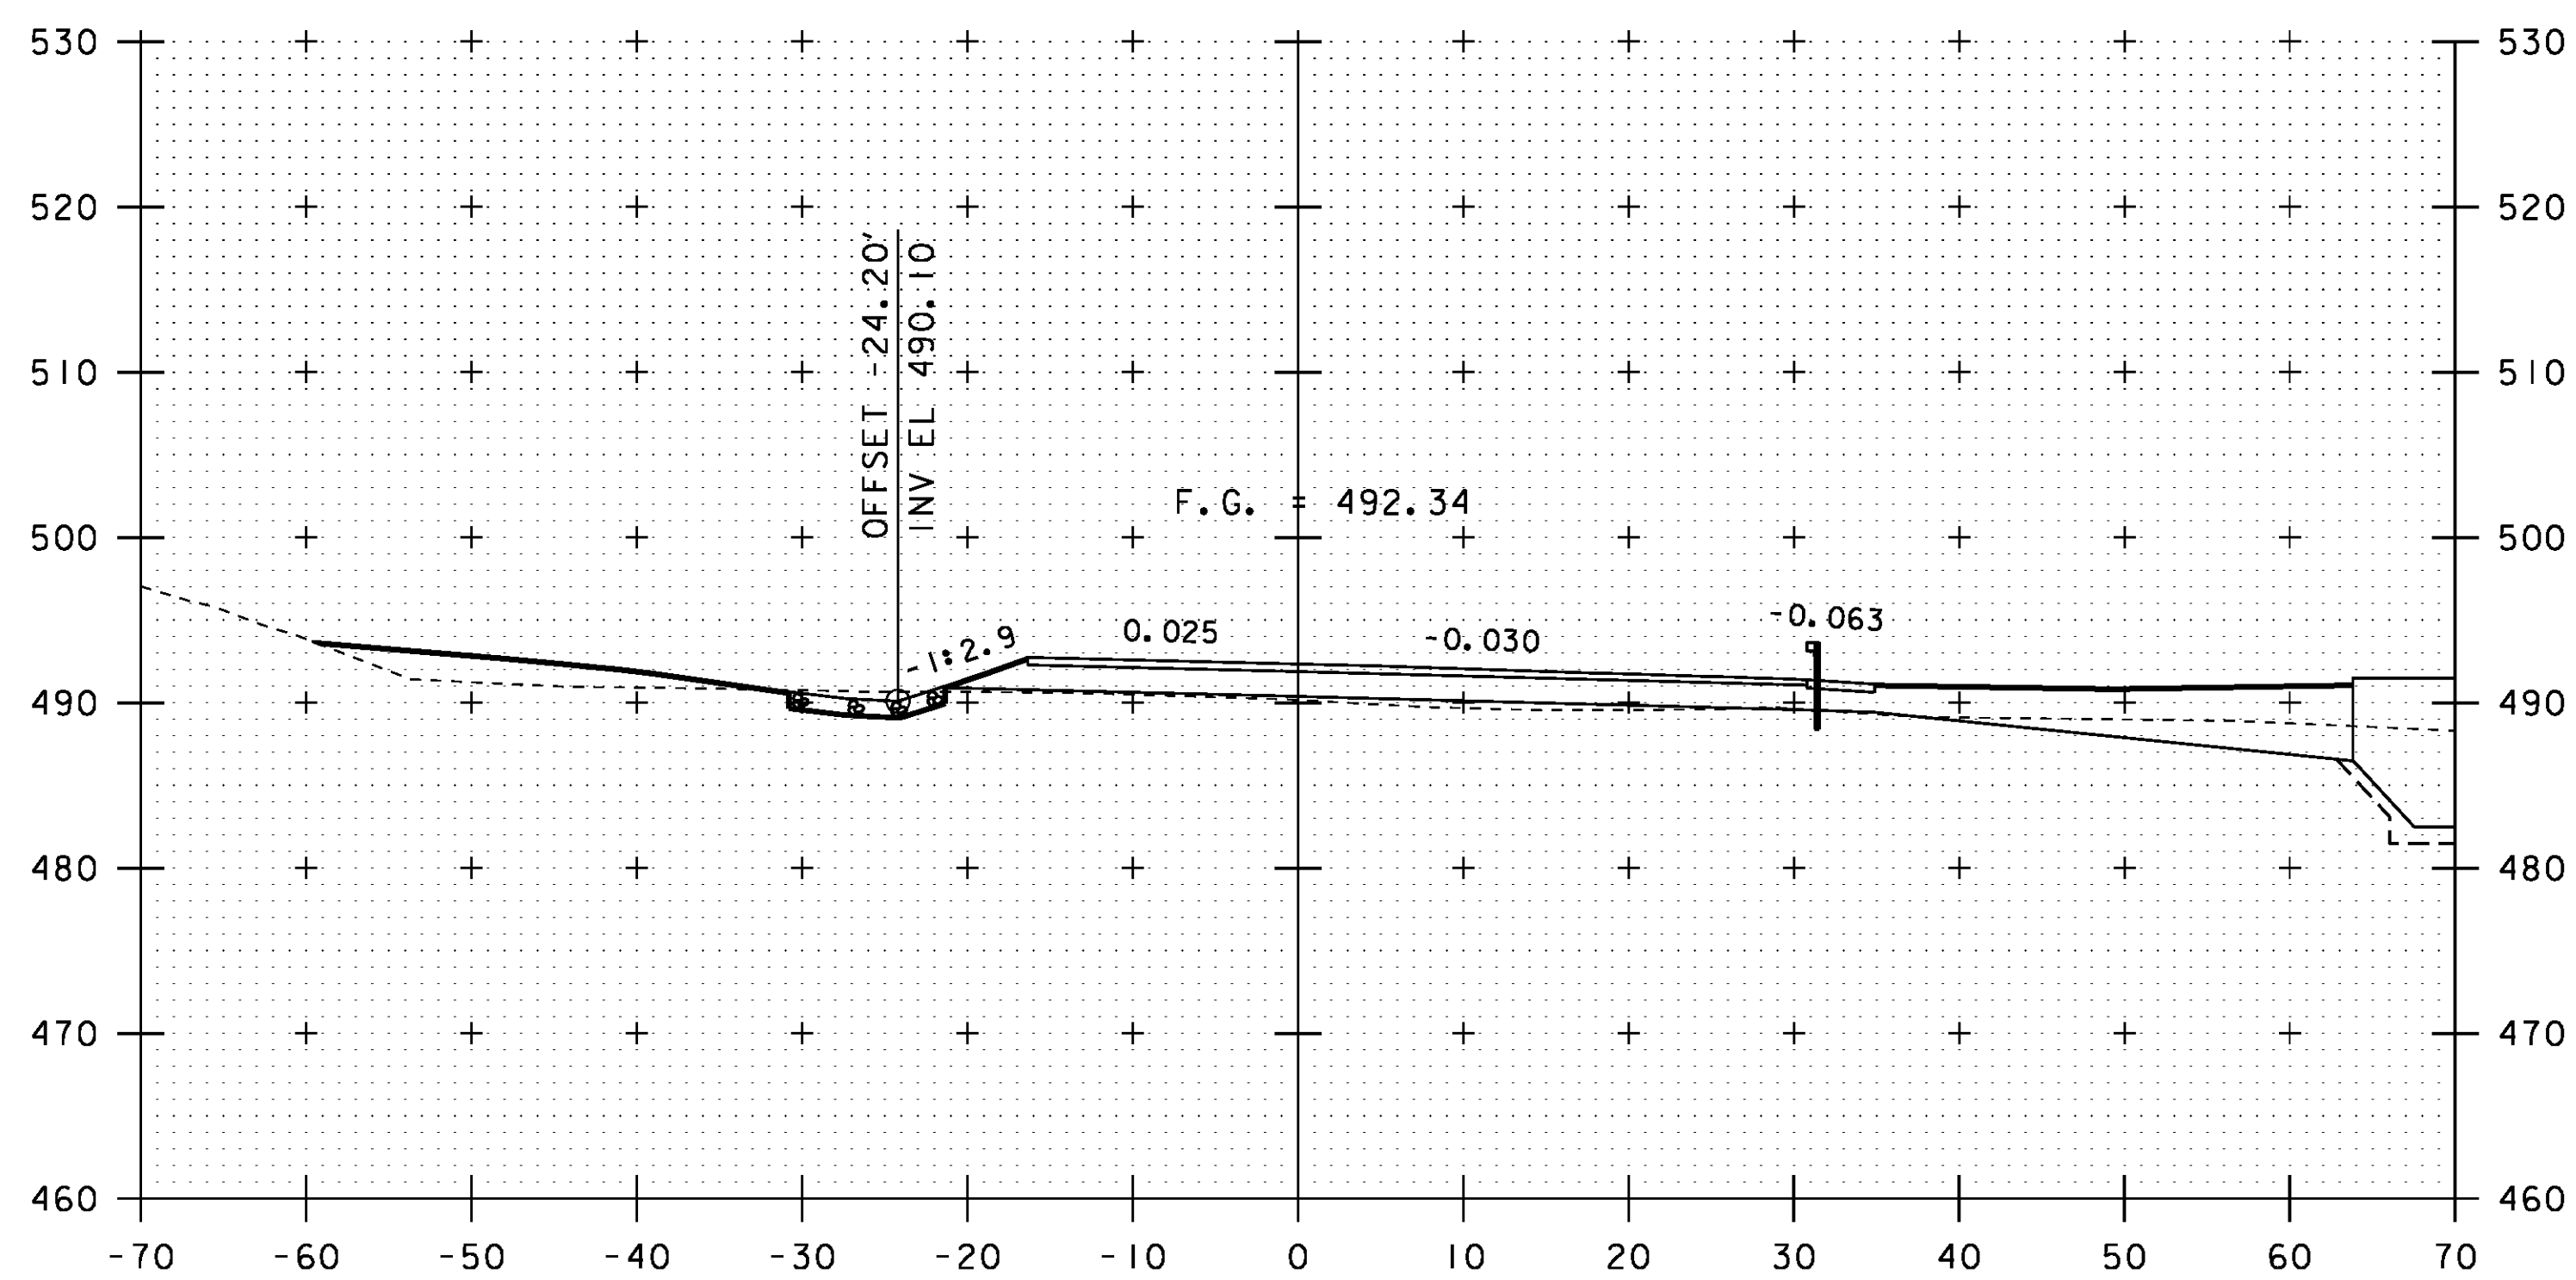

STA 40+16.00  
 BEGIN SIDELINE ROADWAY

40+25

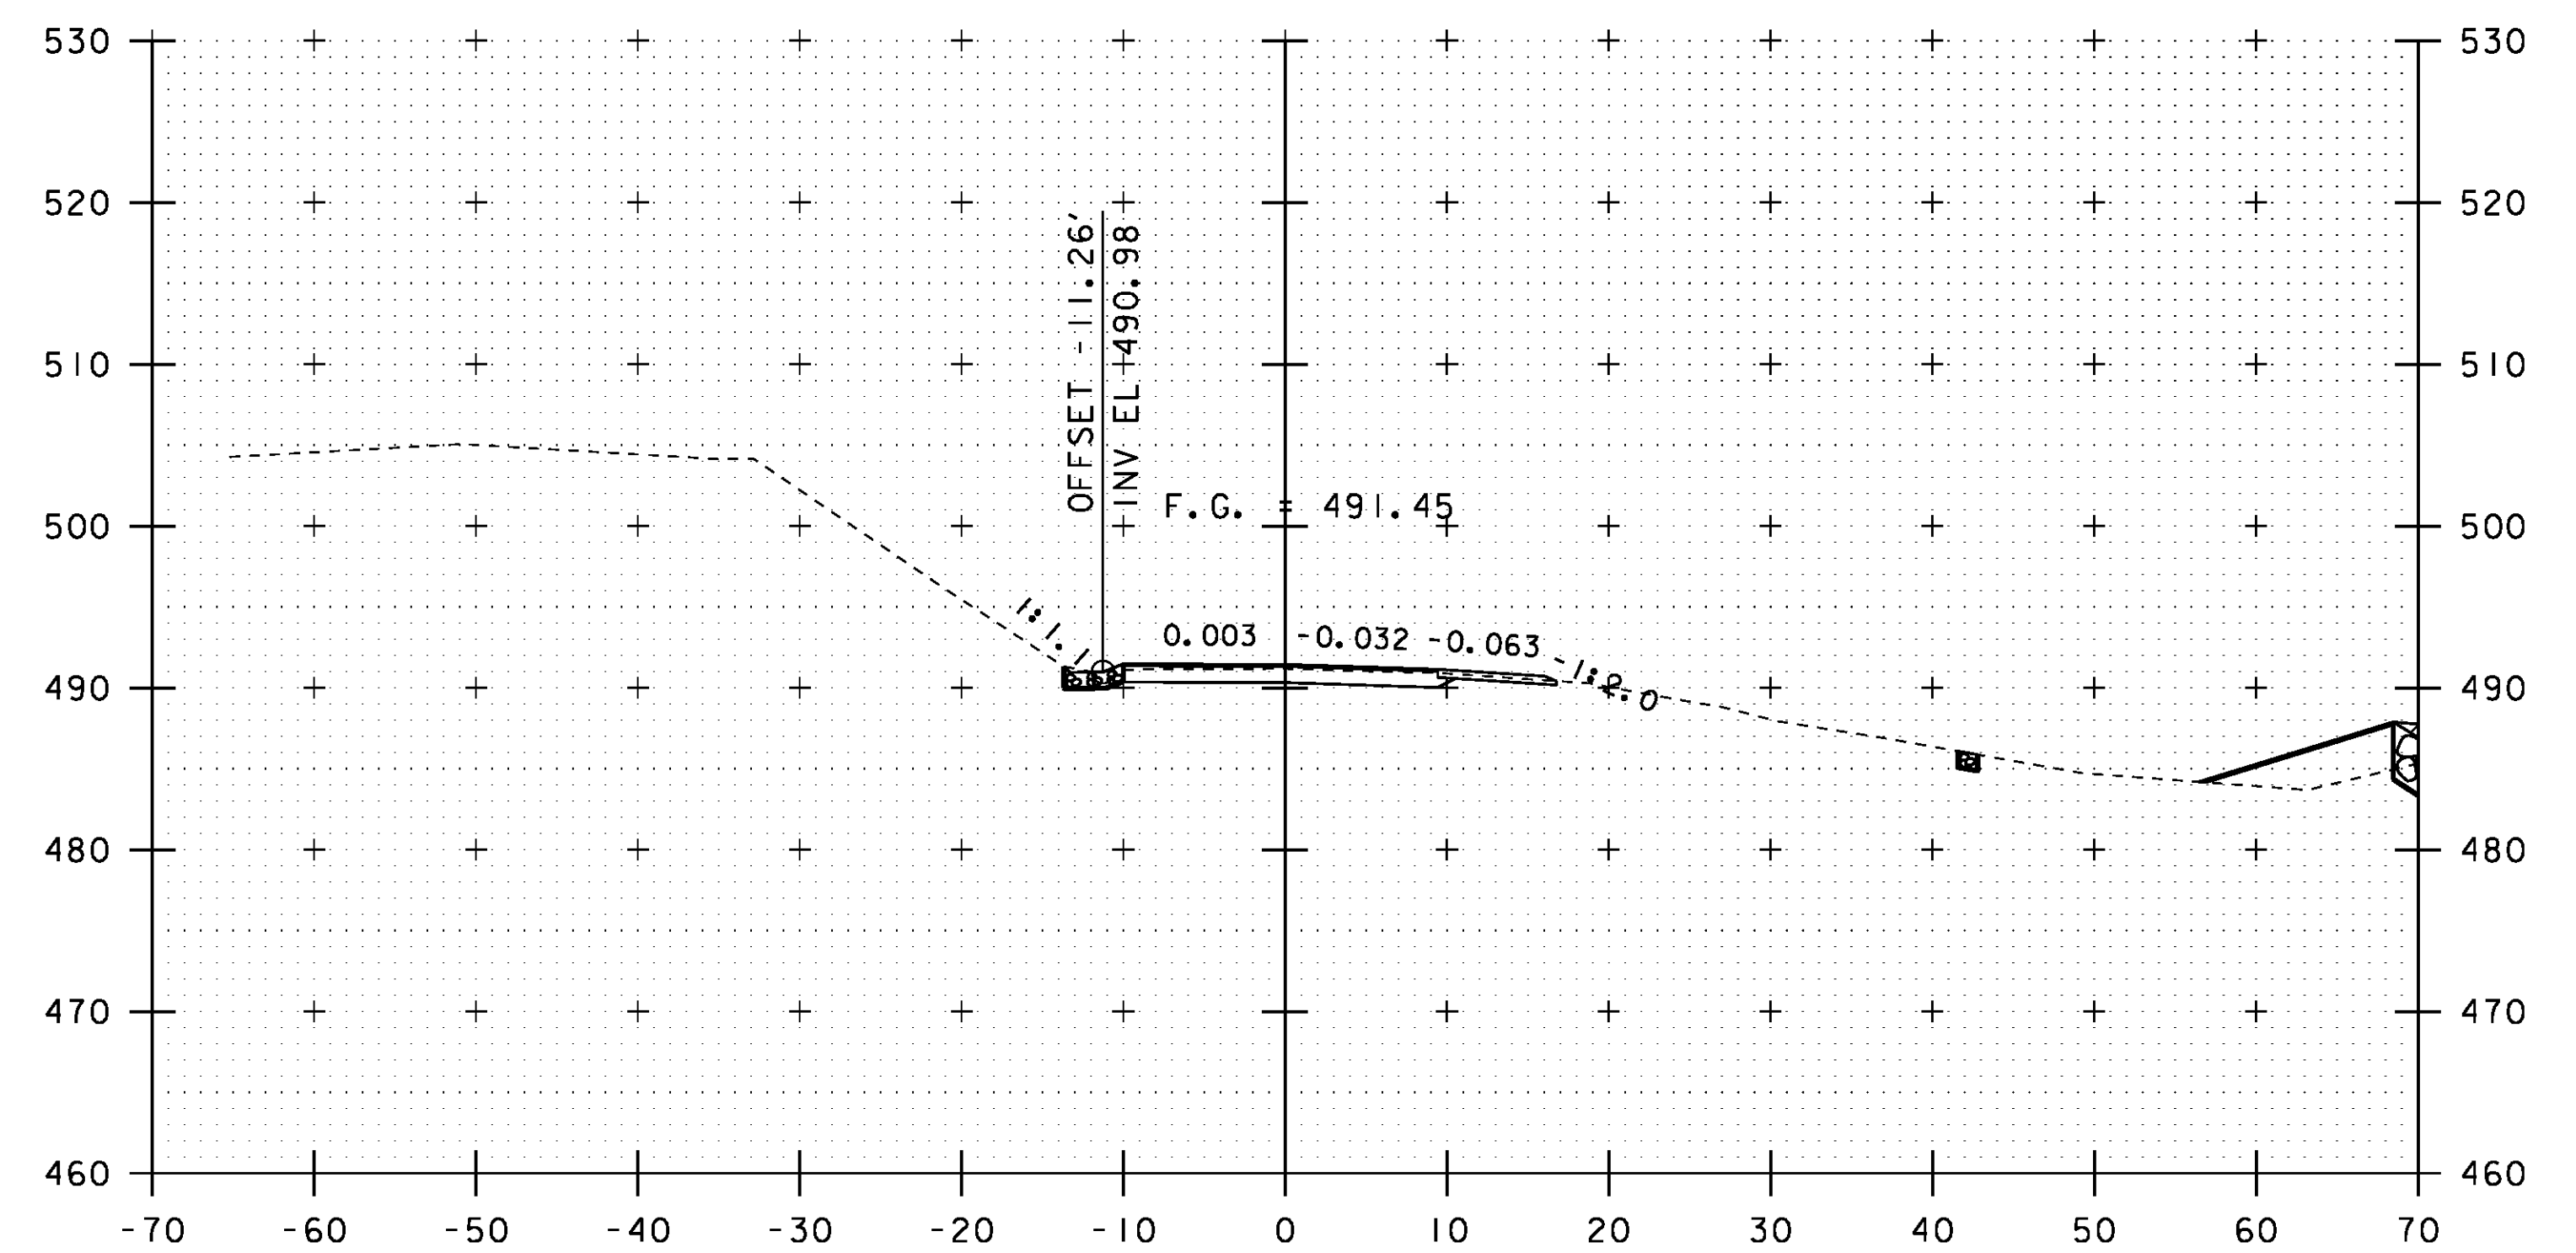

40+75


SCALE: 1" = 10'-0"

STA. 40+25 TO STA. 41+00


PROJECT NAME: JOHNSON  
 PROJECT NUMBER: BRF 030-2(26)

FILE NAME: s88bl93xsl.dgn  
 PROJECT LEADER: C. CARLSON  
 DESIGNED BY: H. SALLS  
 TH 43 CROSS SECTIONS


PLOT DATE: 10-JUN-2014  
 DRAWN BY: G. ROY  
 CHECKED BY: H. SALLS  
 SHEET 51 OF 69

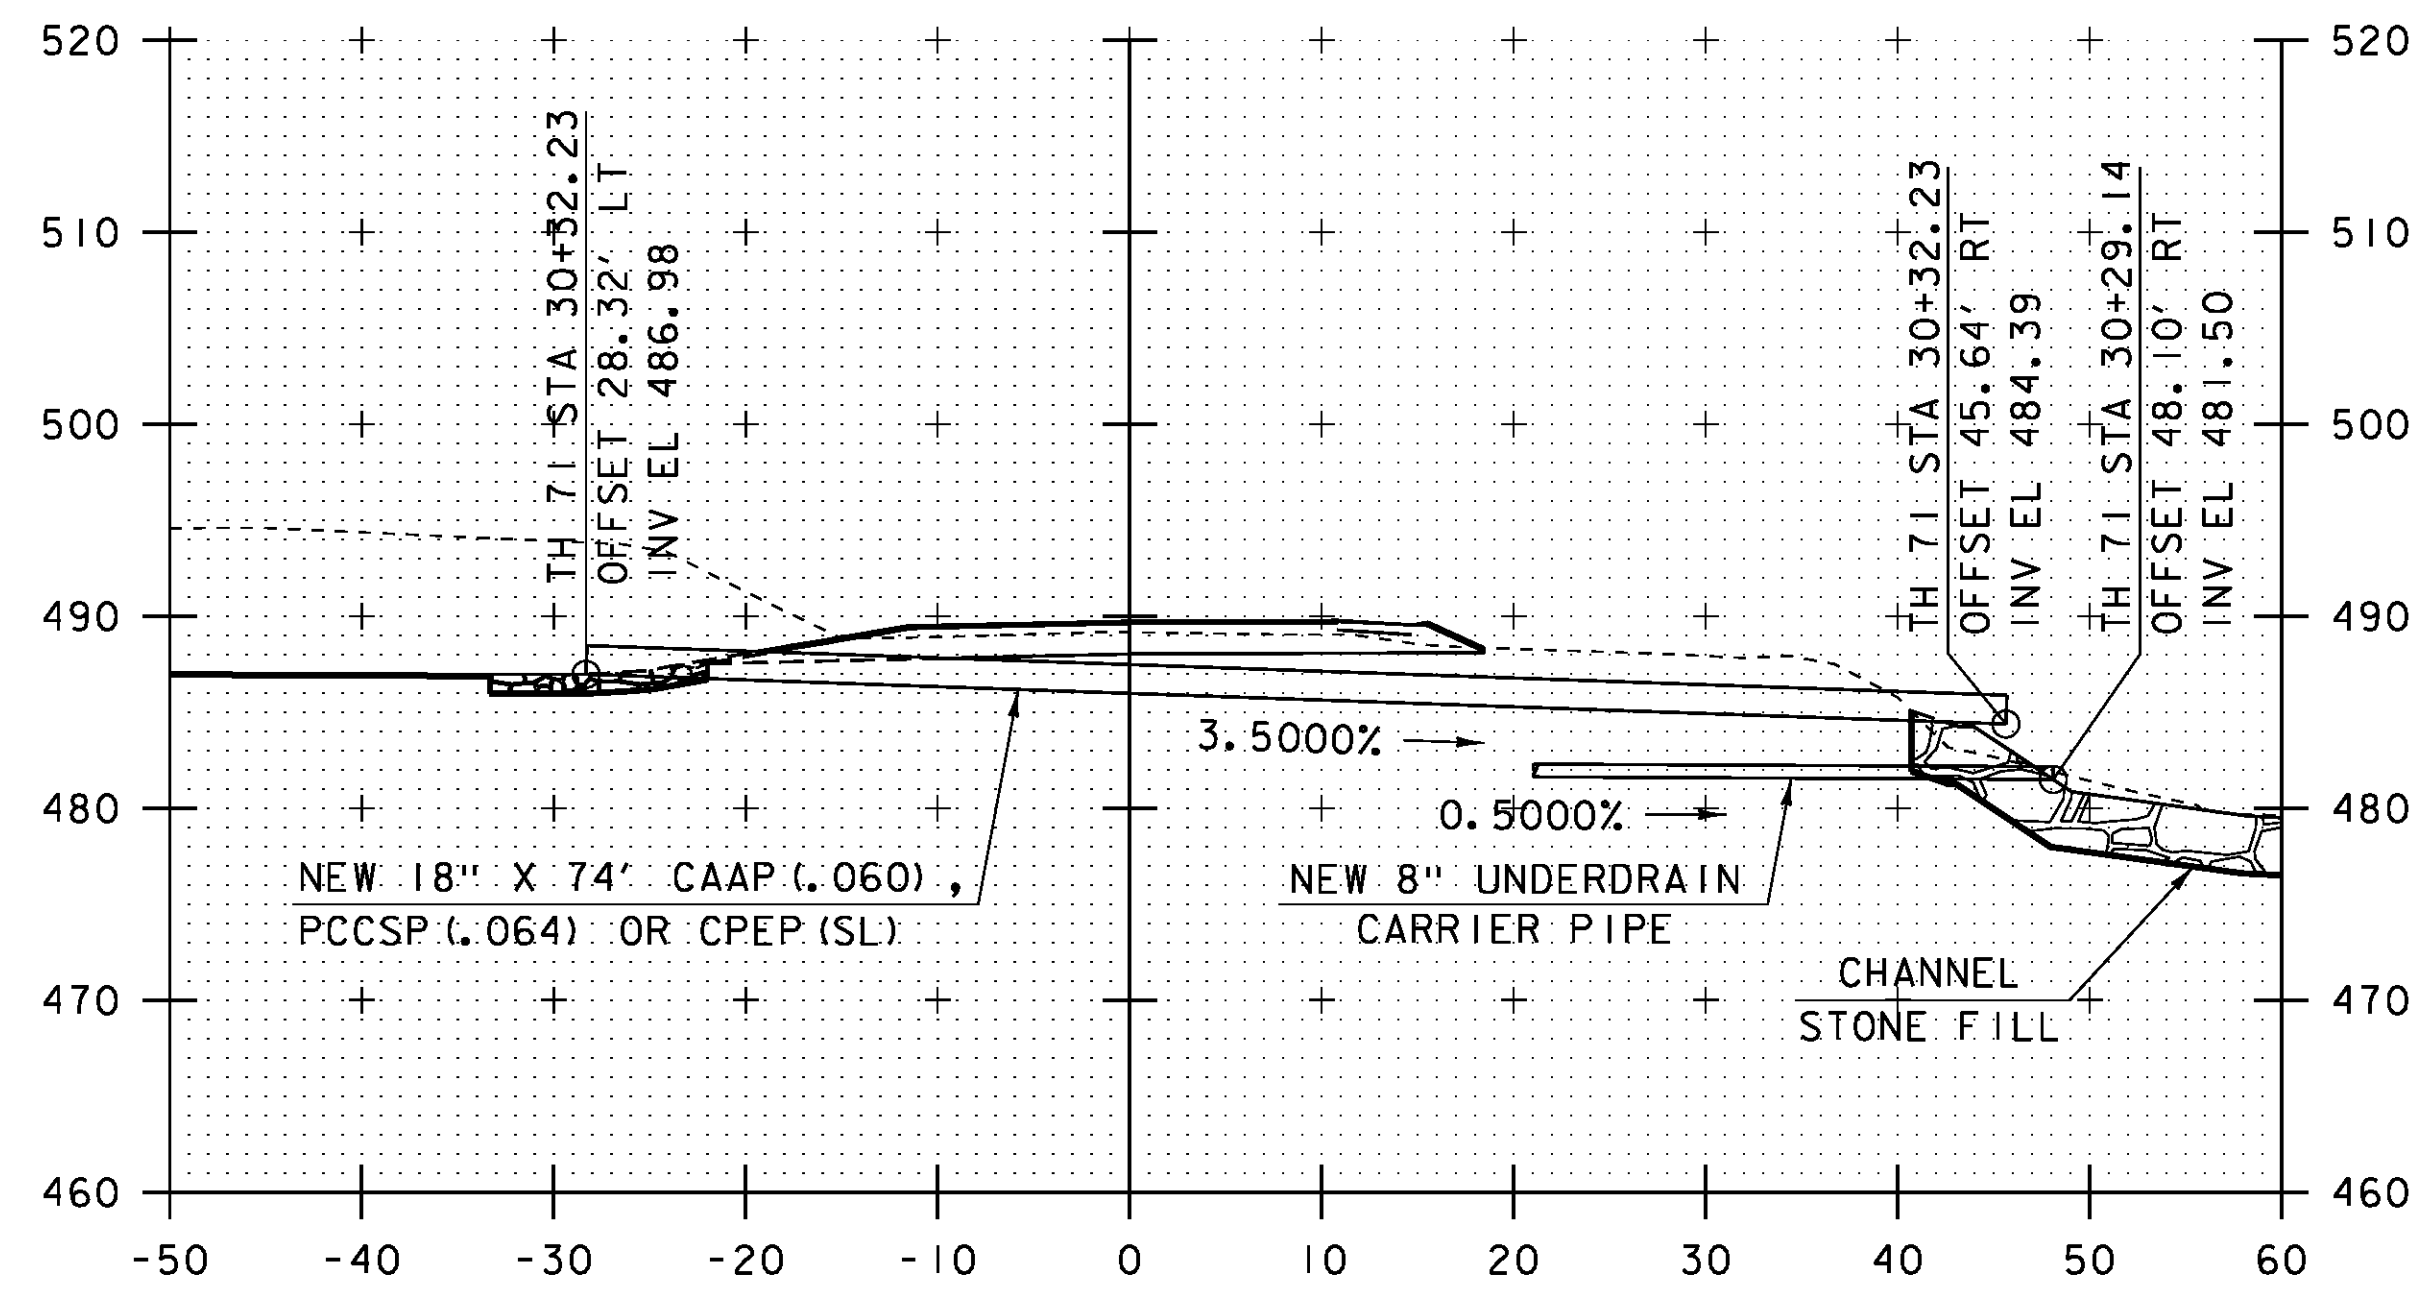


PIPE NO. 1 PROFILE

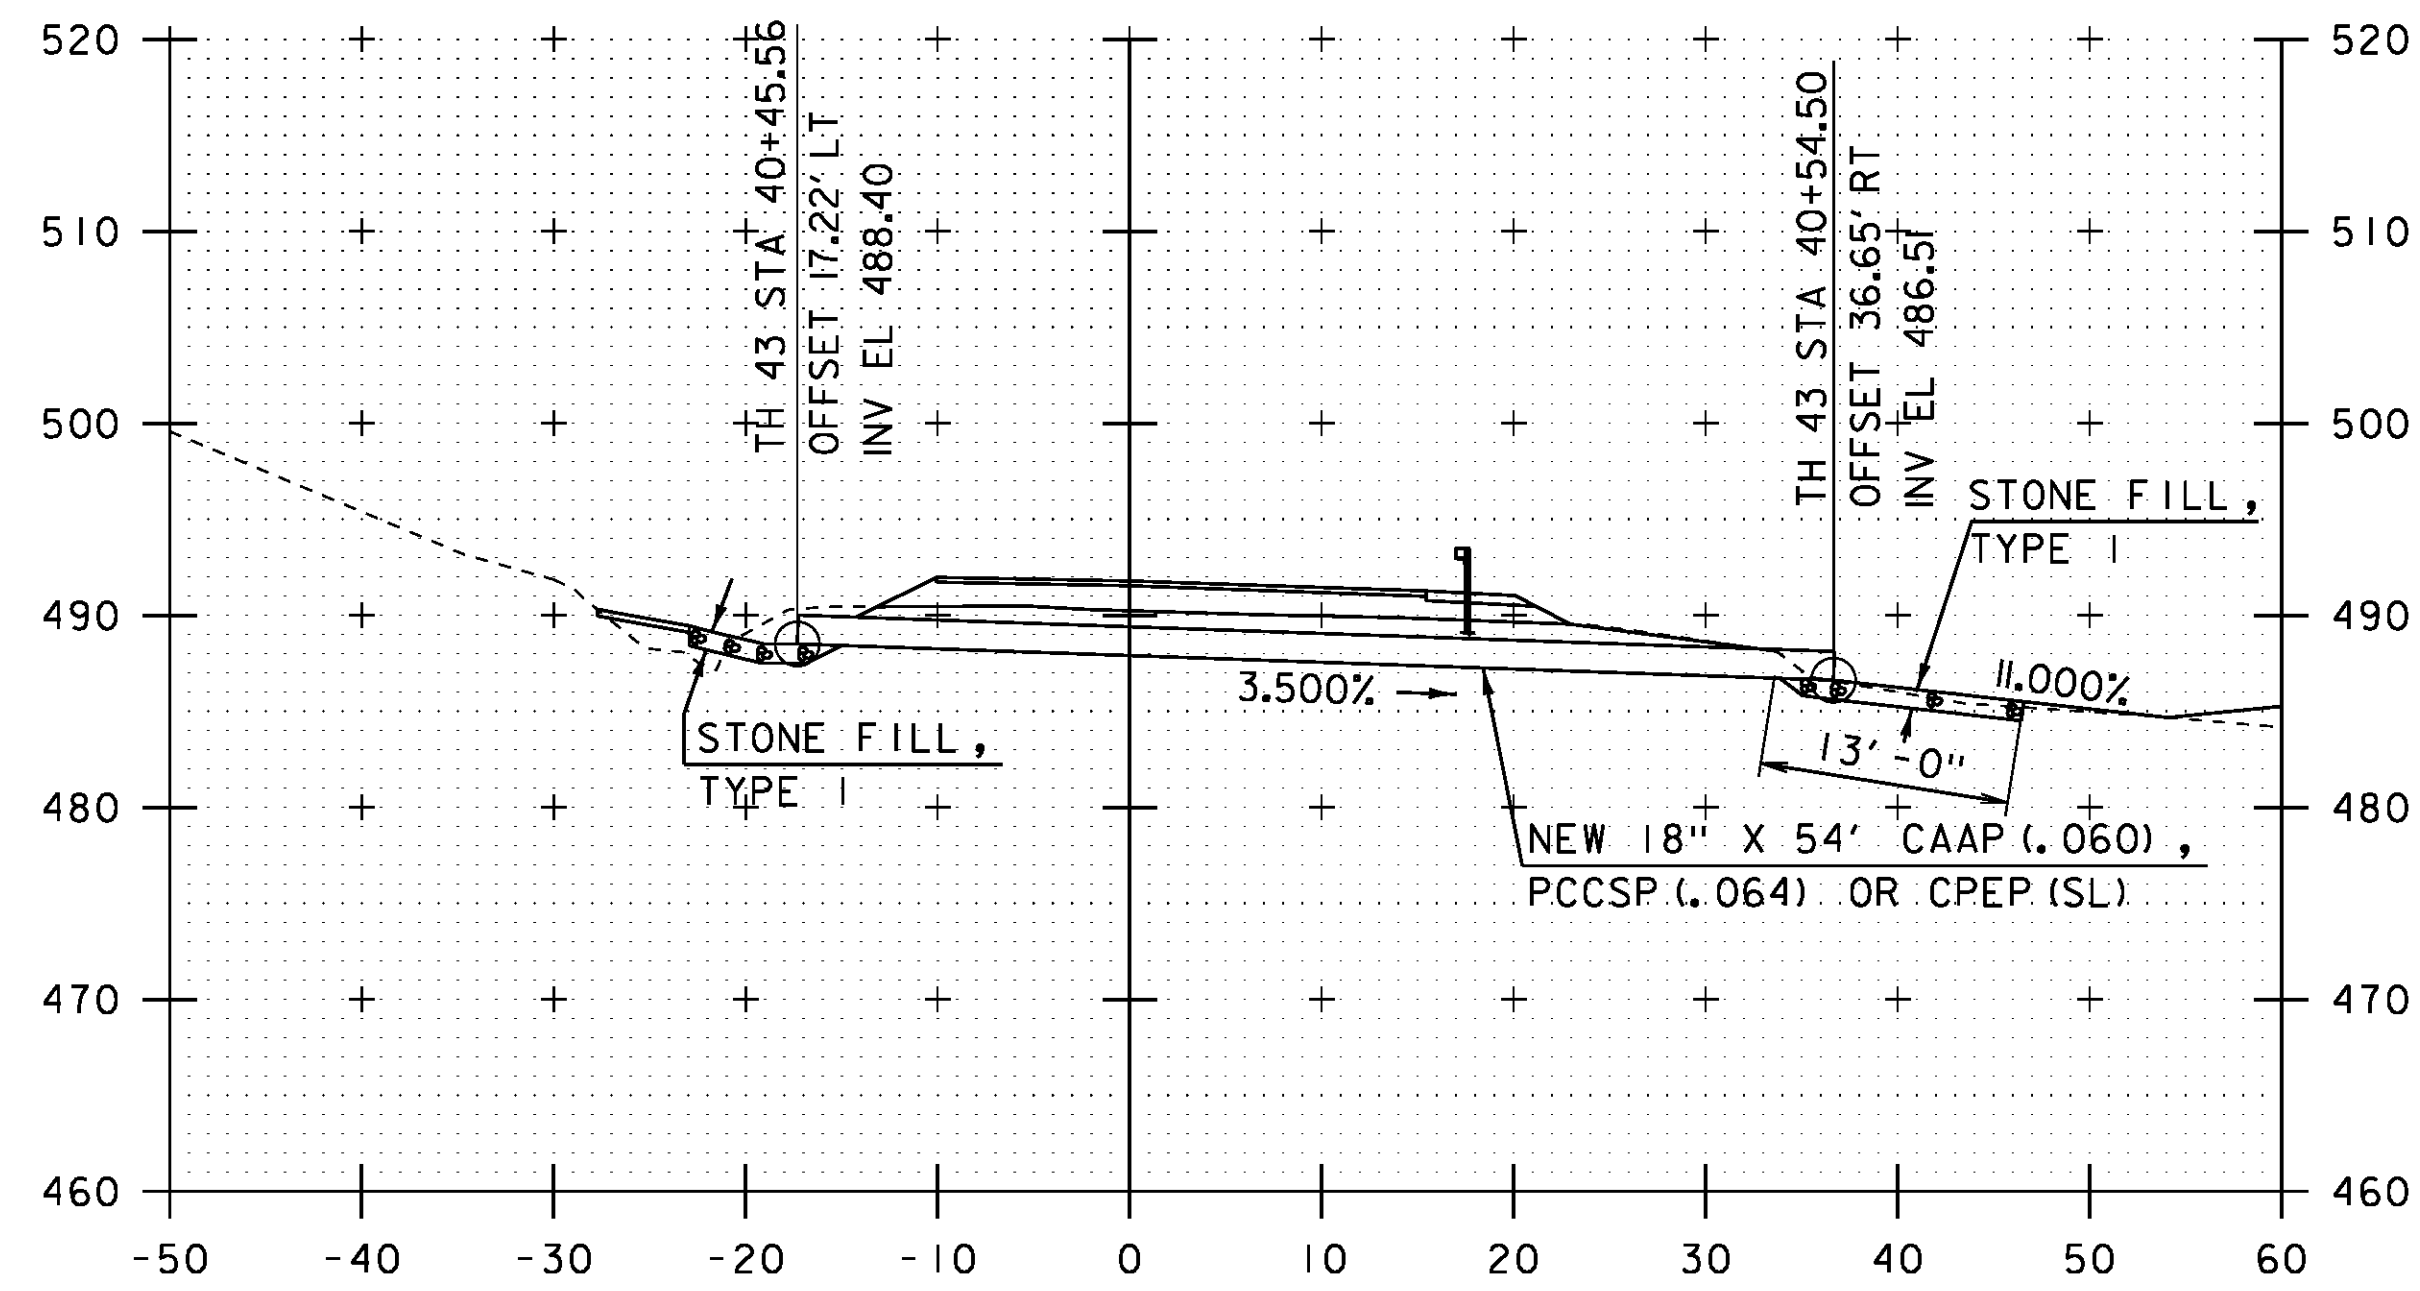

PIPE NO. 2 PROFILE

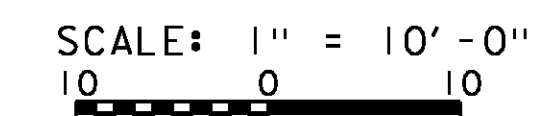


PROJECT NAME: JOHNSON	PLOT DATE: 10-JUN-2014
PROJECT NUMBER: BRF 030-2(26)	DRAWN BY: G. ROY
FILE NAME: s88bl93xsl.dgn	CHECKED BY: H. SALLS
PROJECT LEADER: C. CARLSON	SHEET 52 OF 69
DESIGNED BY: H. SALLS	
PIPE PROFILES	

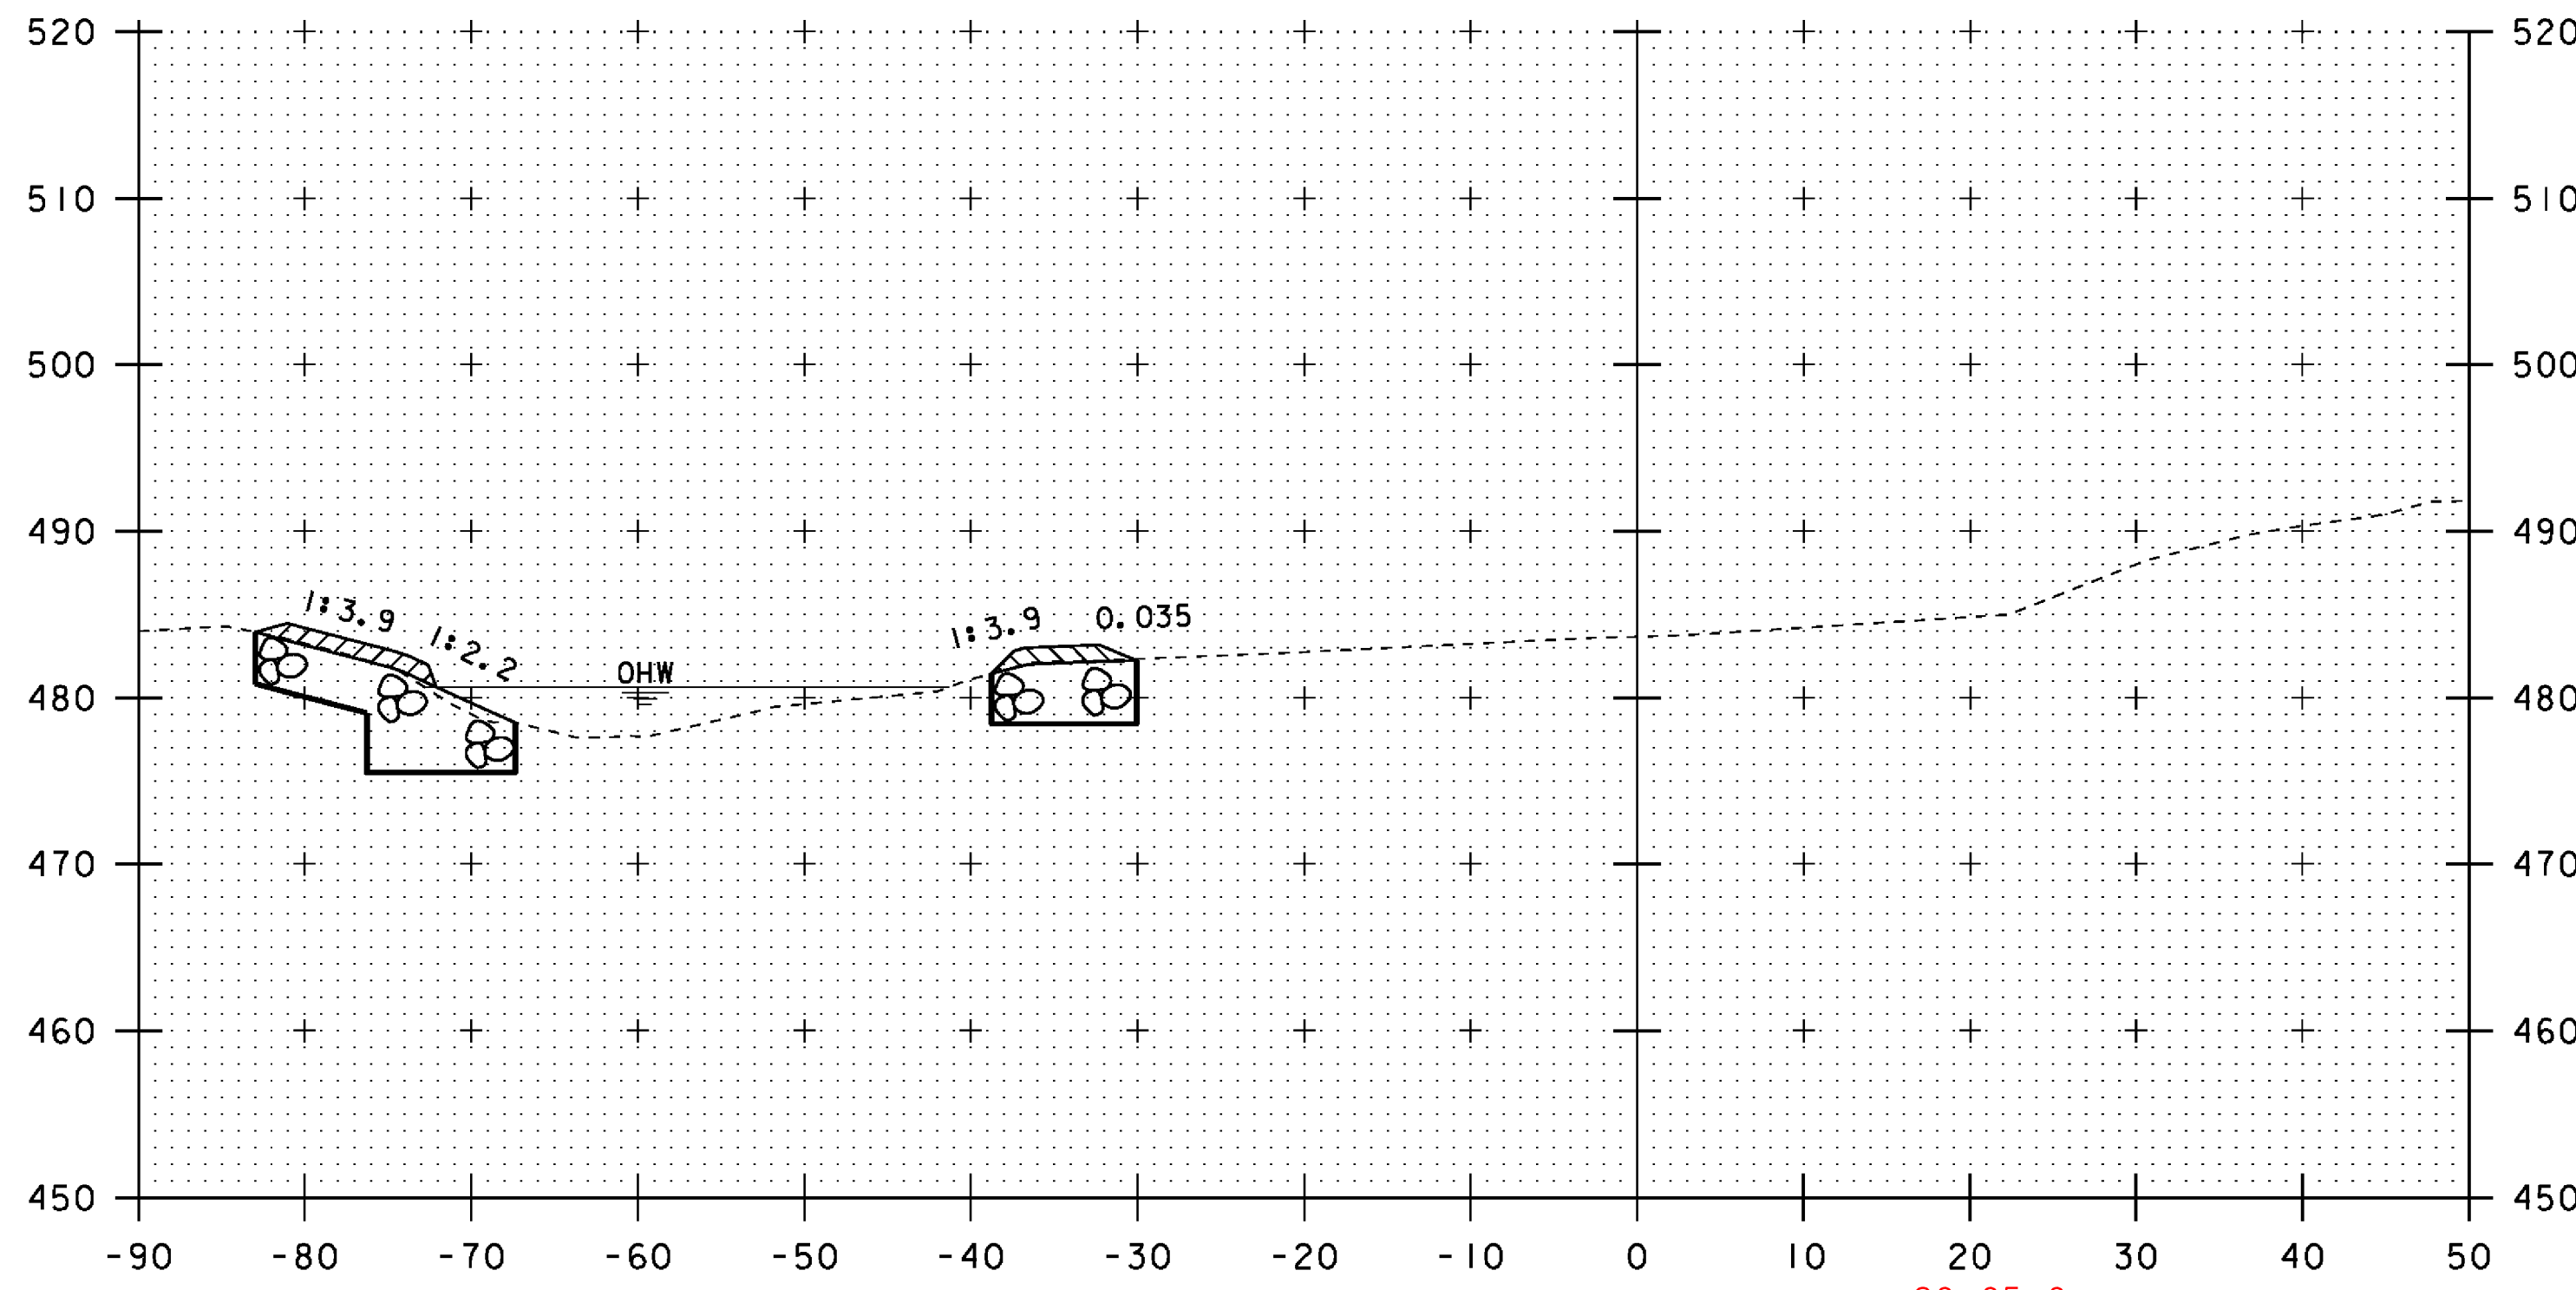

CHANNEL STA 20+00.00 FAR LT  
 BEGIN UNCLASSIFIED CHANNEL EXCAVATION  
 GEOTEXTILE UNDER STONE FILL  
 STONE FILL, TYPE III  
 GRUBBING MATERIAL


20+10

CHANNEL STA 20+05.0  
 20+07.4 LT  
 BEGIN UNCLASSIFIED CHANNEL EXCAVATION  
 GEOTEXTILE UNDER STONE FILL  
 STONE FILL, TYPE III  
 GRUBBING MATERIAL

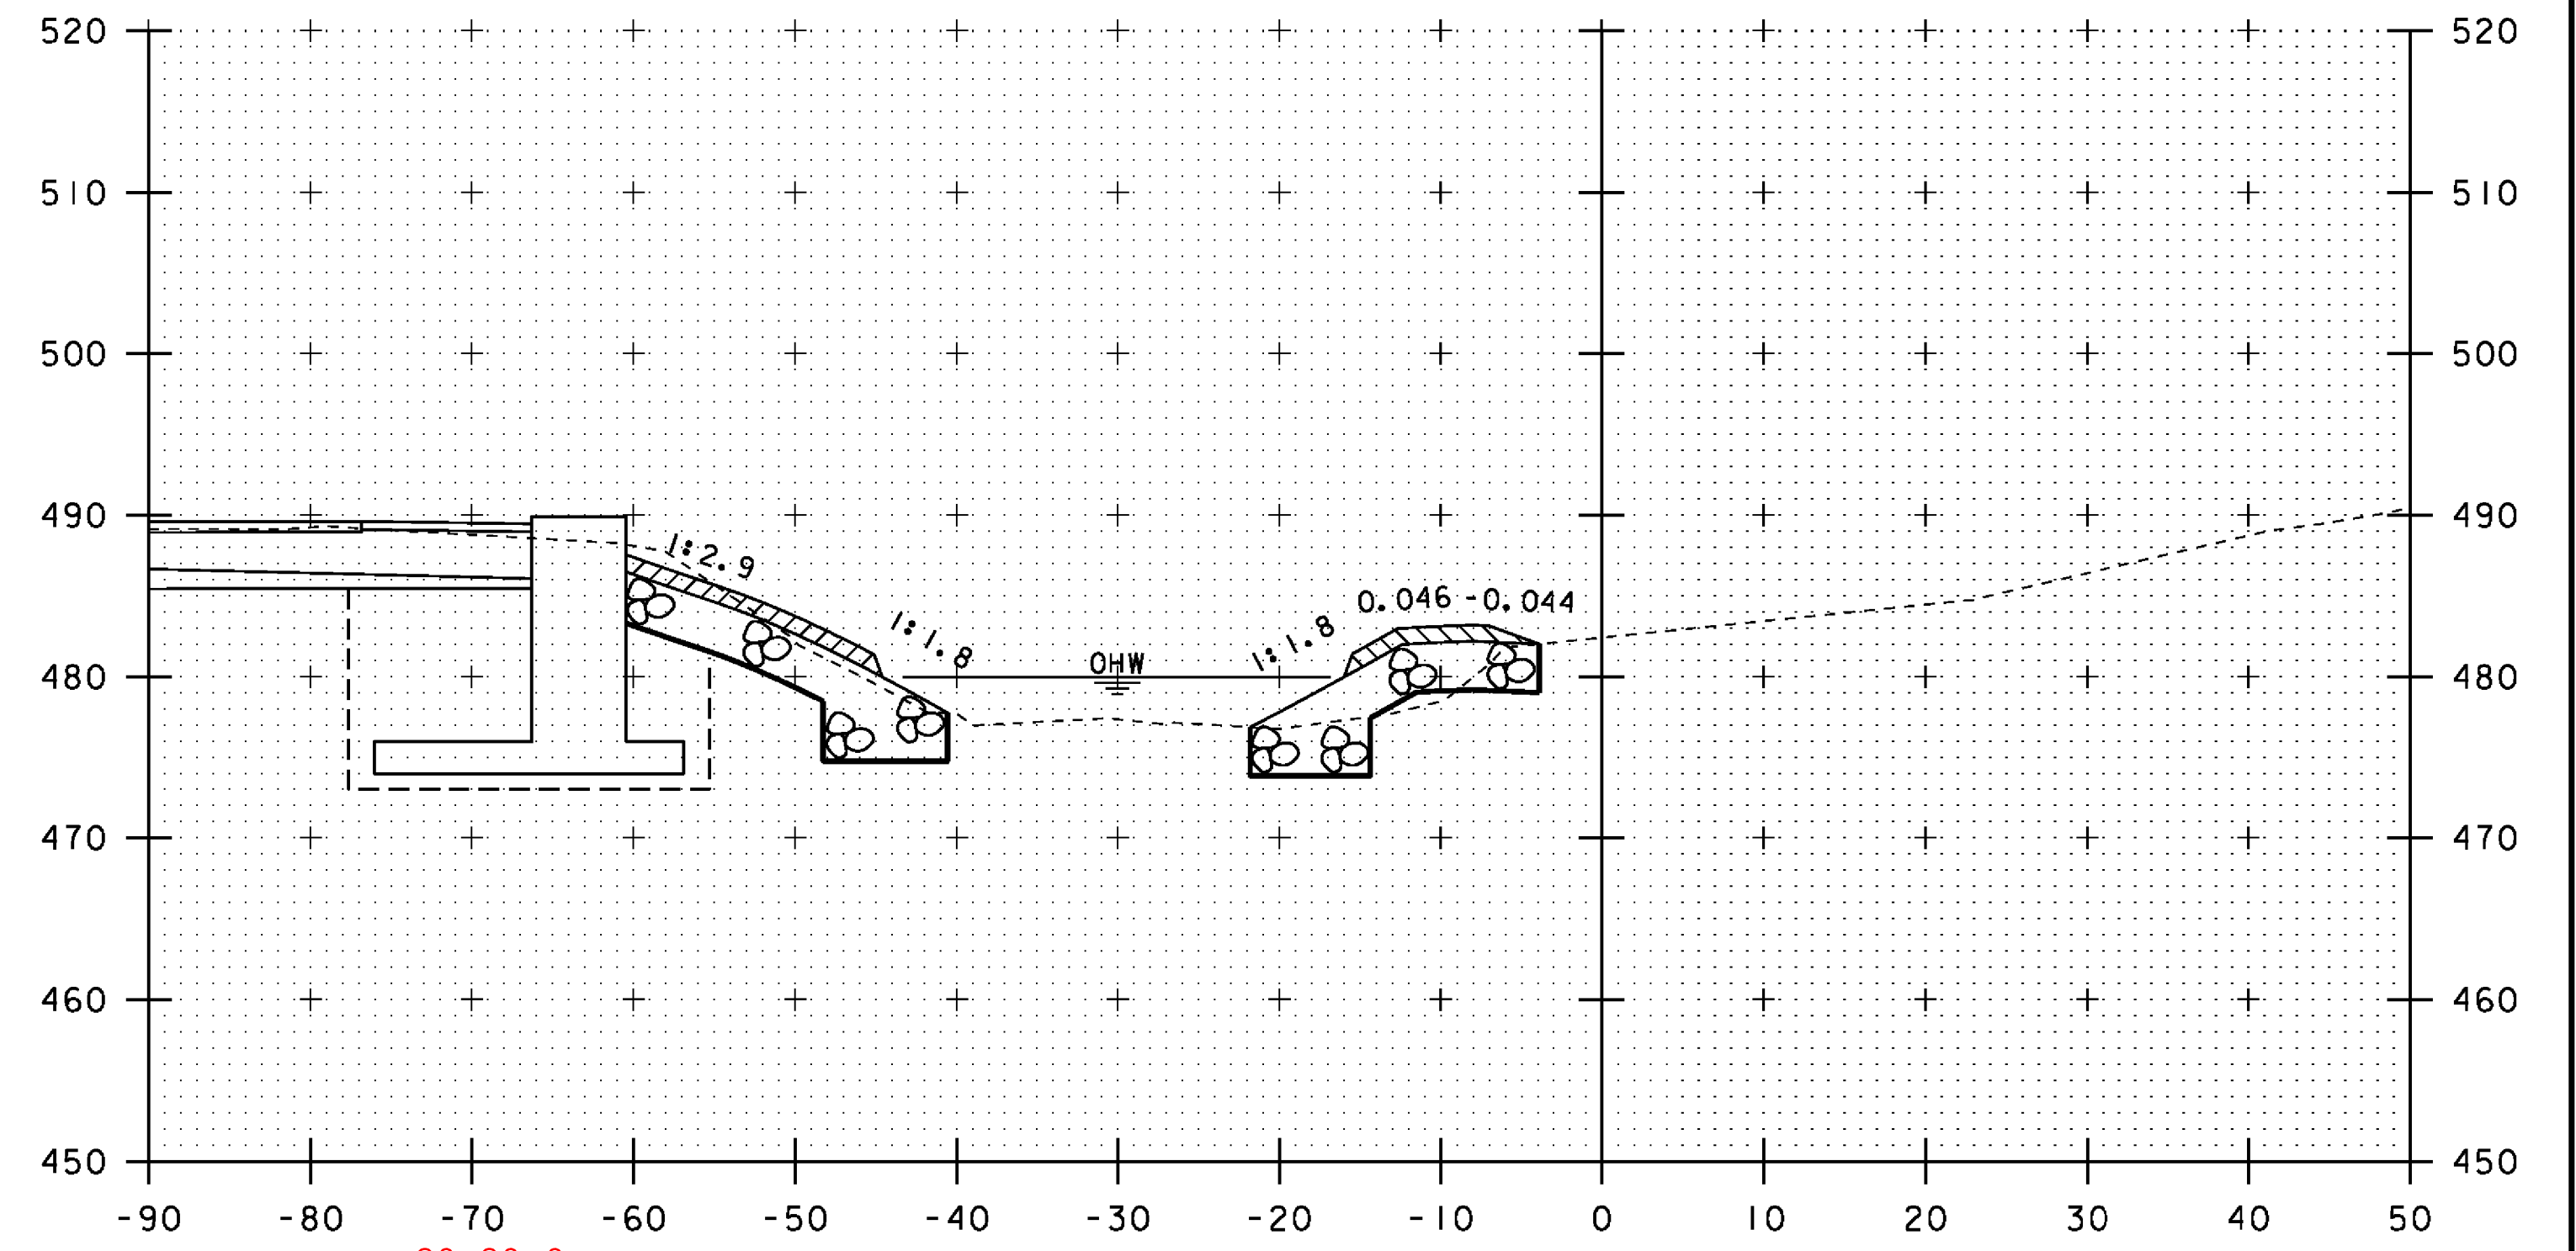


CHANNEL STA 20+20.0  
 20+21.2 FAR LT  
 BEGIN STRUCTURE EXCAVATION  
 GRANULAR BACKFILL FOR STRUCTURES

20+30

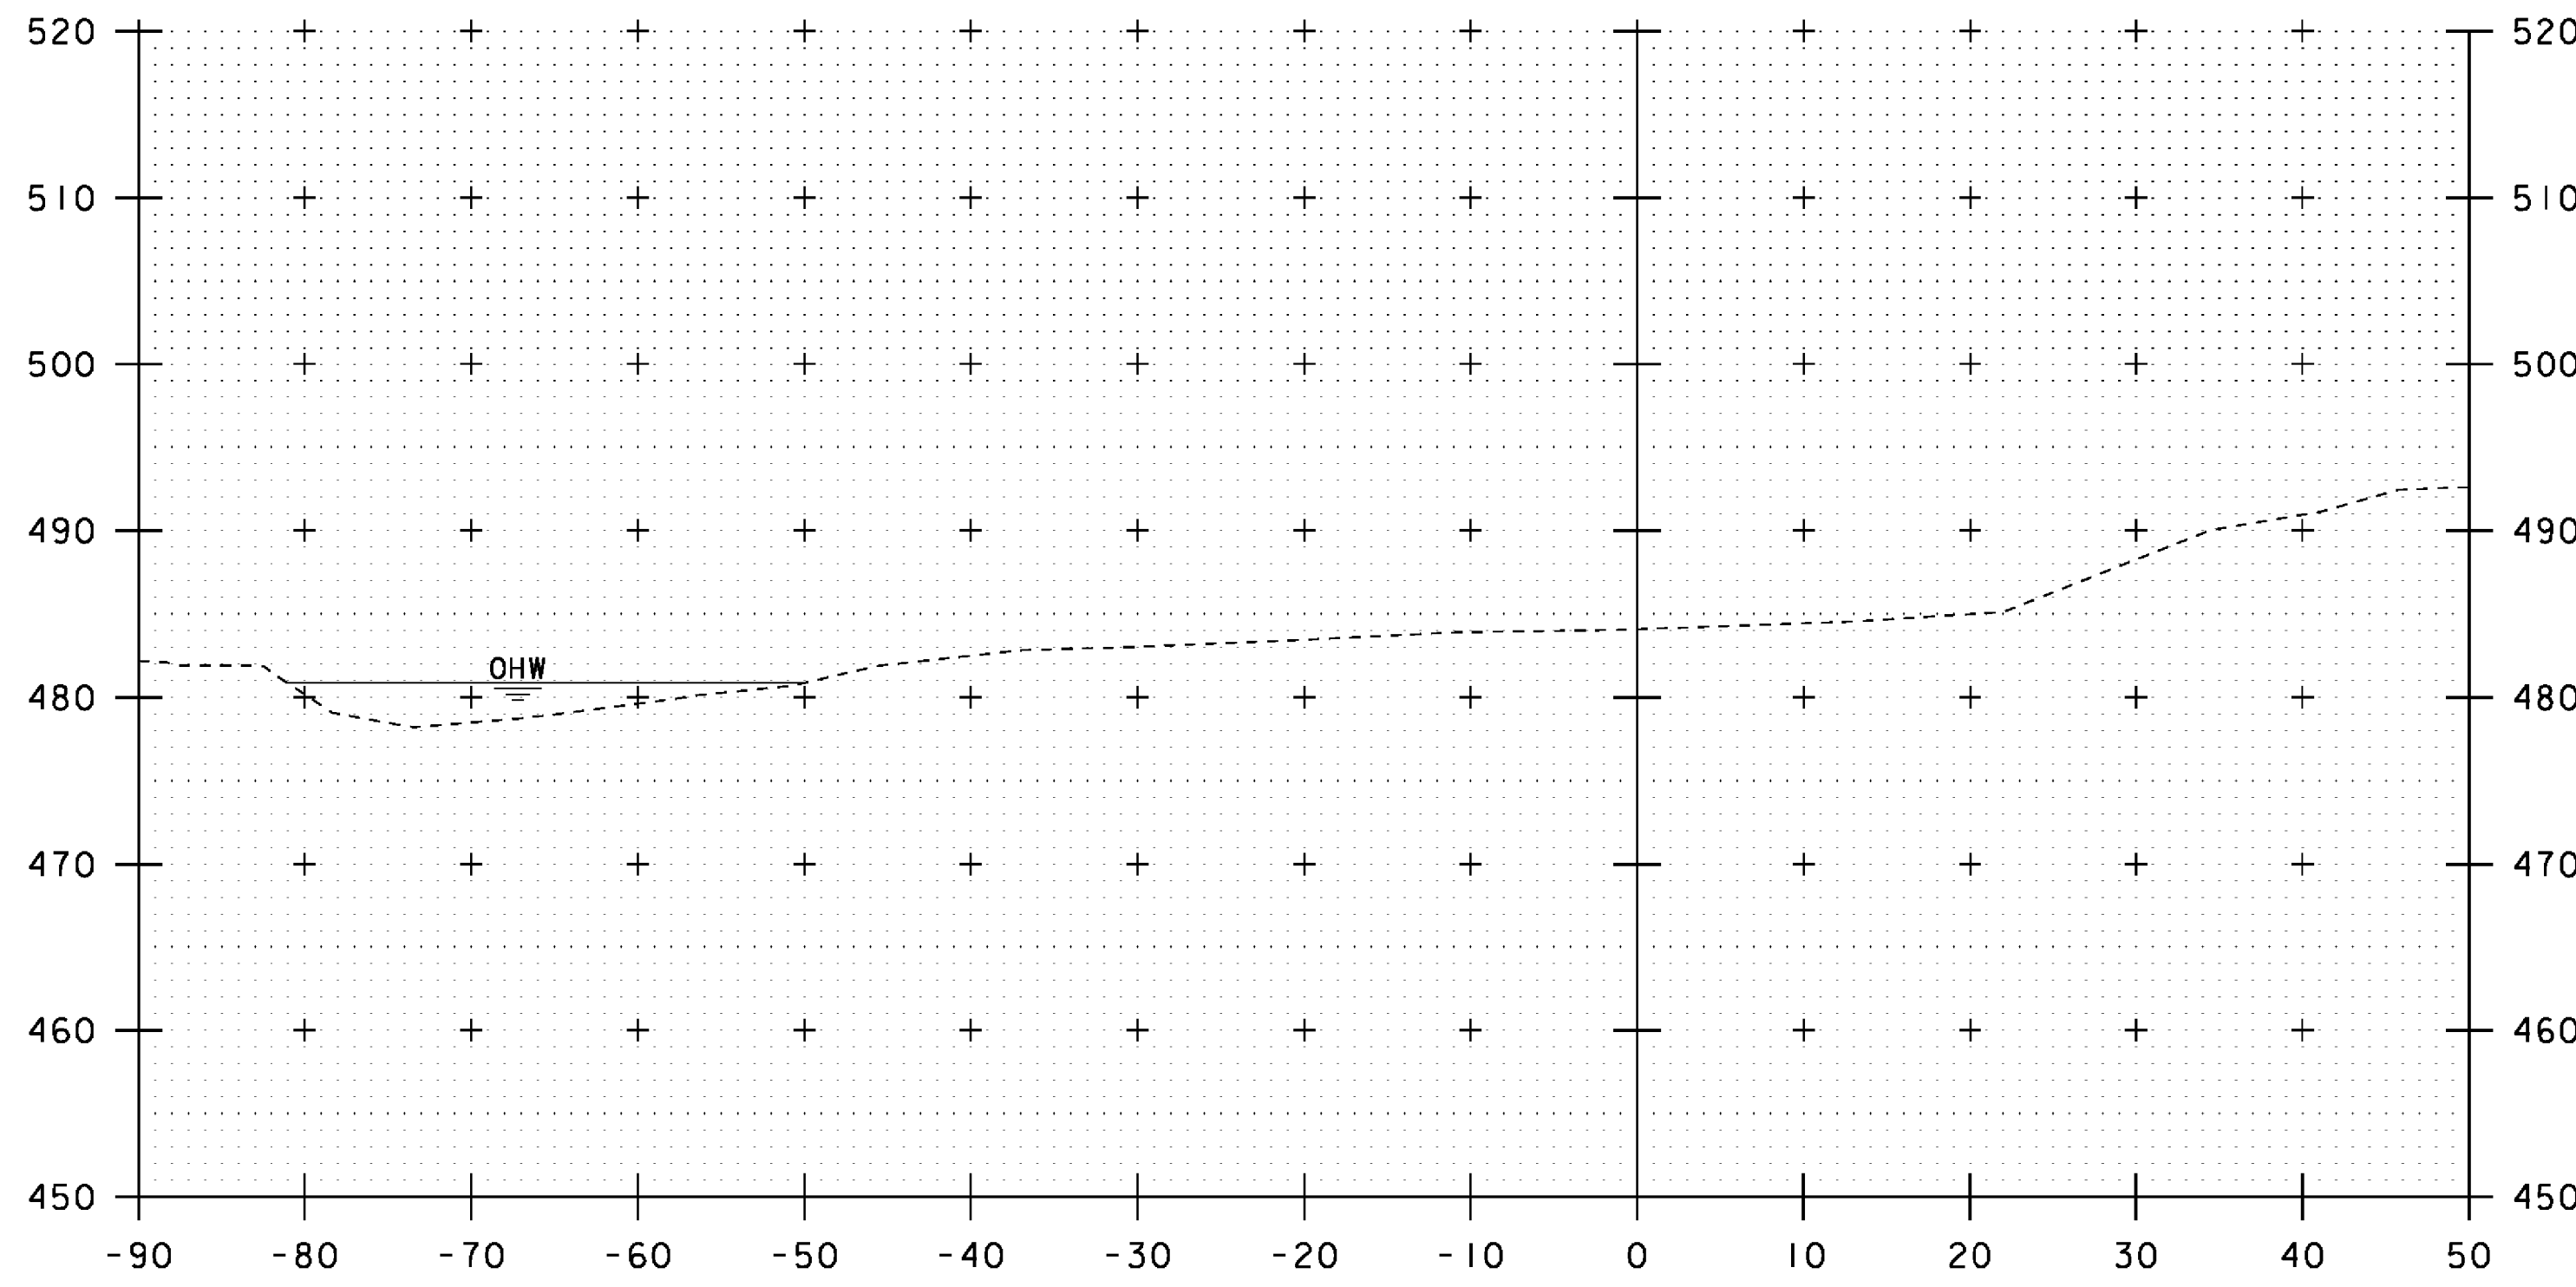

20+00

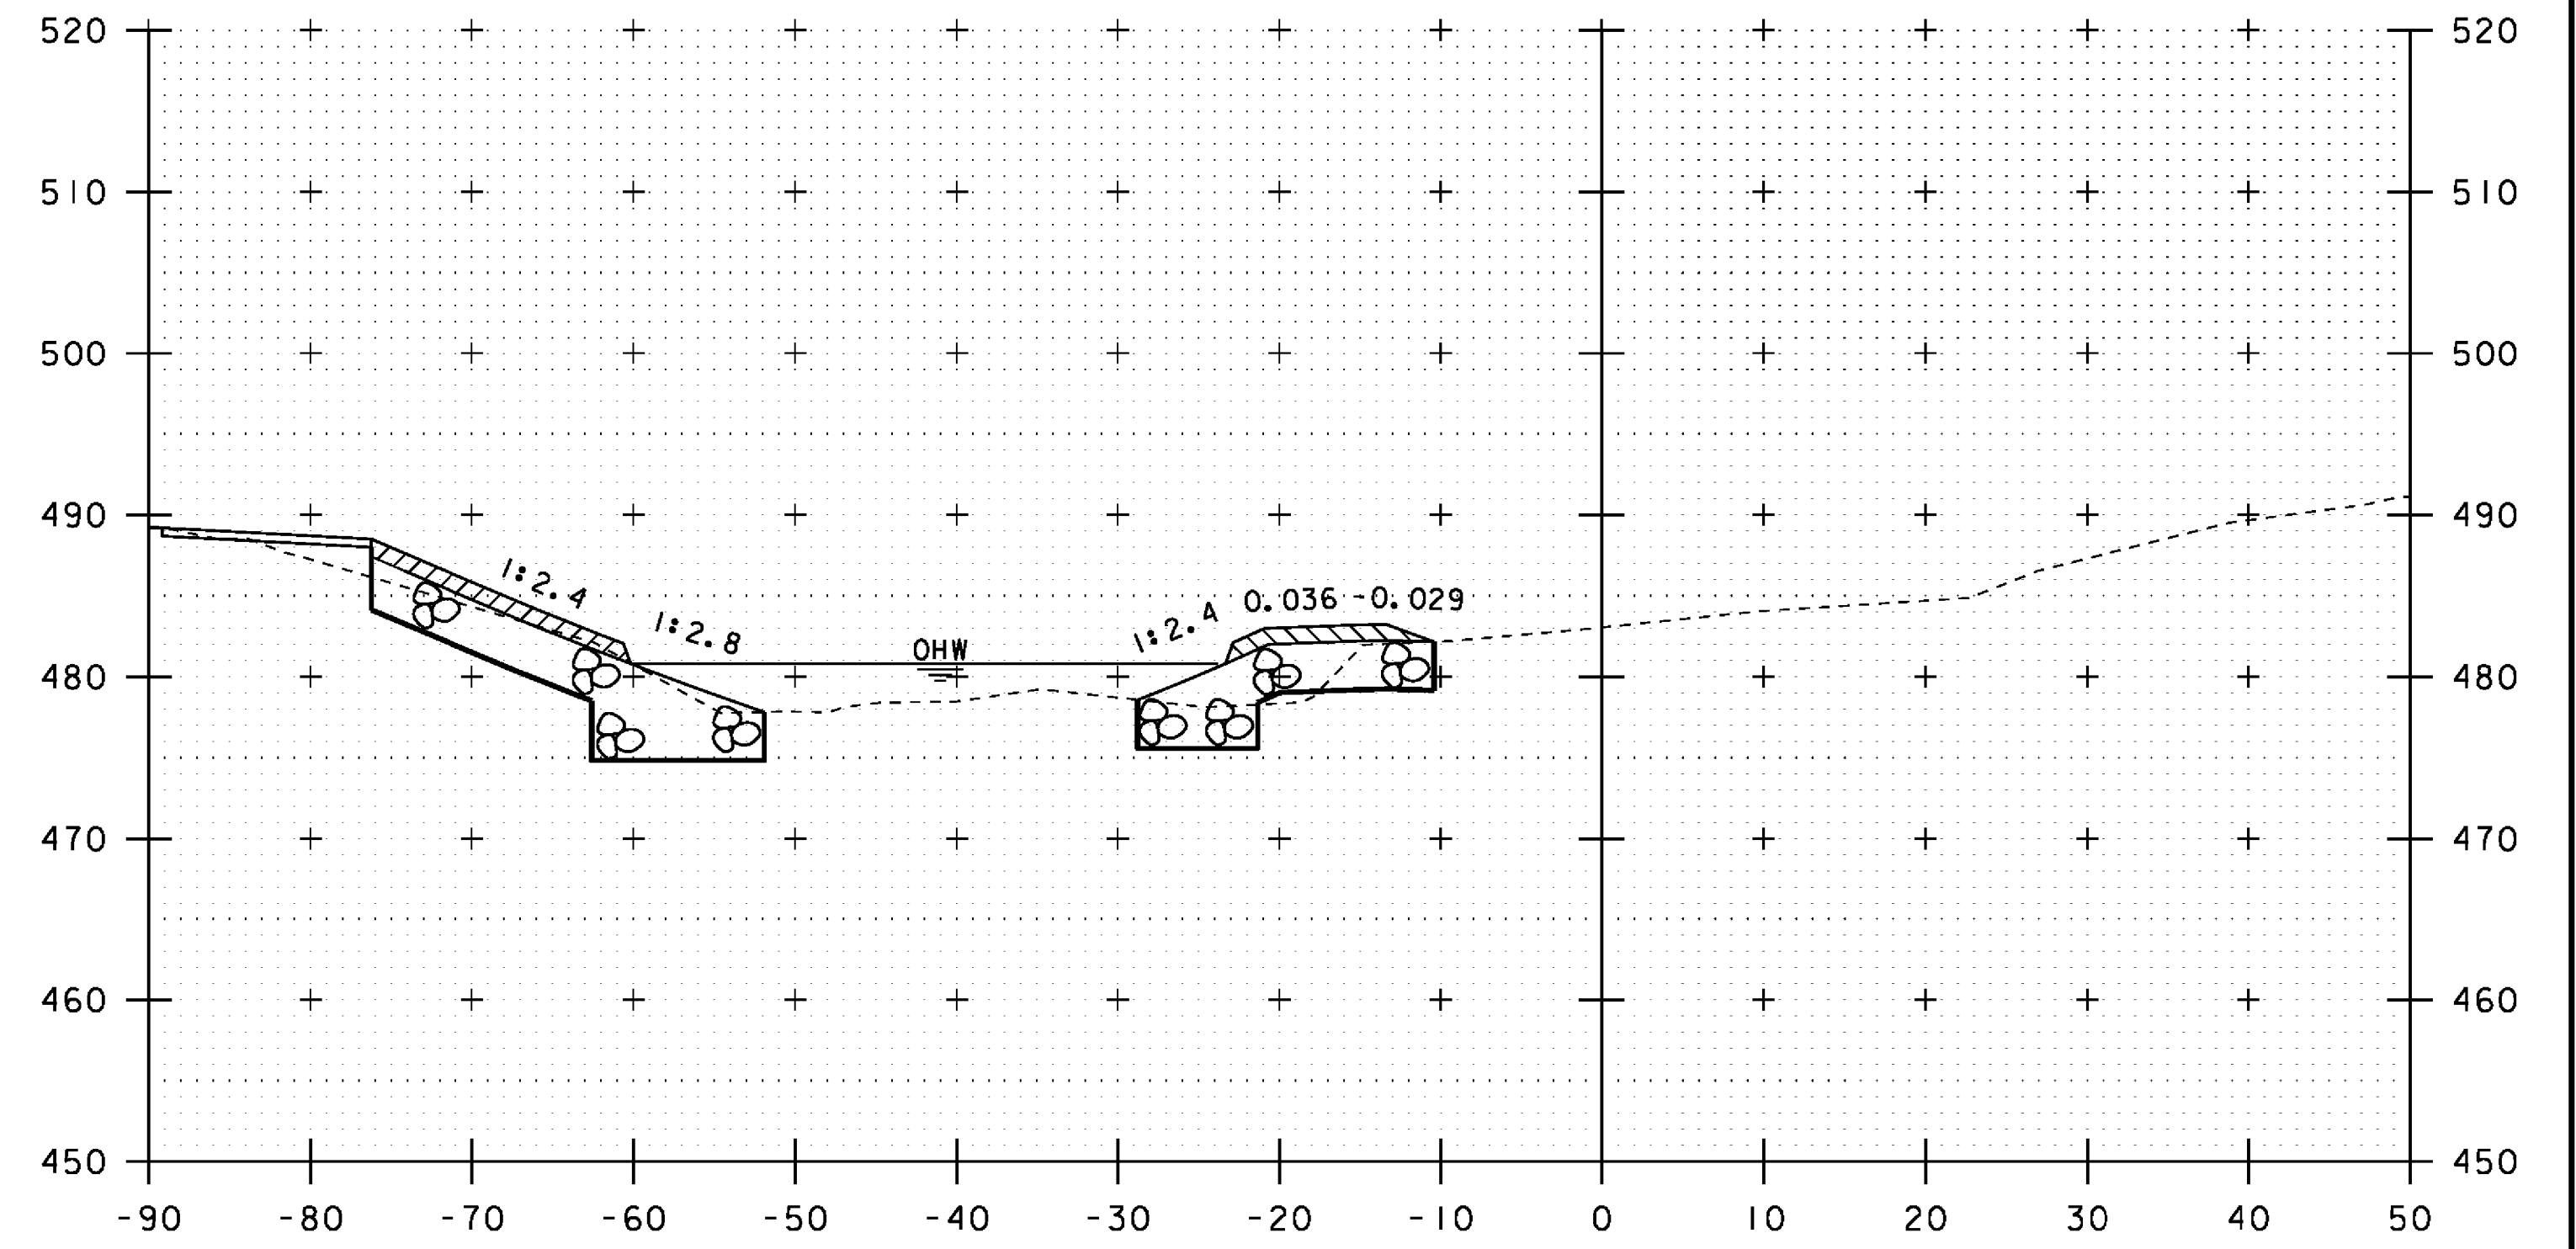


20+20

SCALE: 1" = 10'-0"

STA. 20+00 TO STA. 20+30


PROJECT NAME: JOHNSON	PLOT DATE: 10-JUN-2014
PROJECT NUMBER: BRF 030-2(26)	DRAWN BY: G. ROY
FILE NAME: s88bi93xsl.dgn	CHECKED BY: H. SALLS
PROJECT LEADER: C. CARLSON	SHEET 53 OF 69
DESIGNED BY: H. SALLS	

CHANNEL CROSS SECTIONS (1)

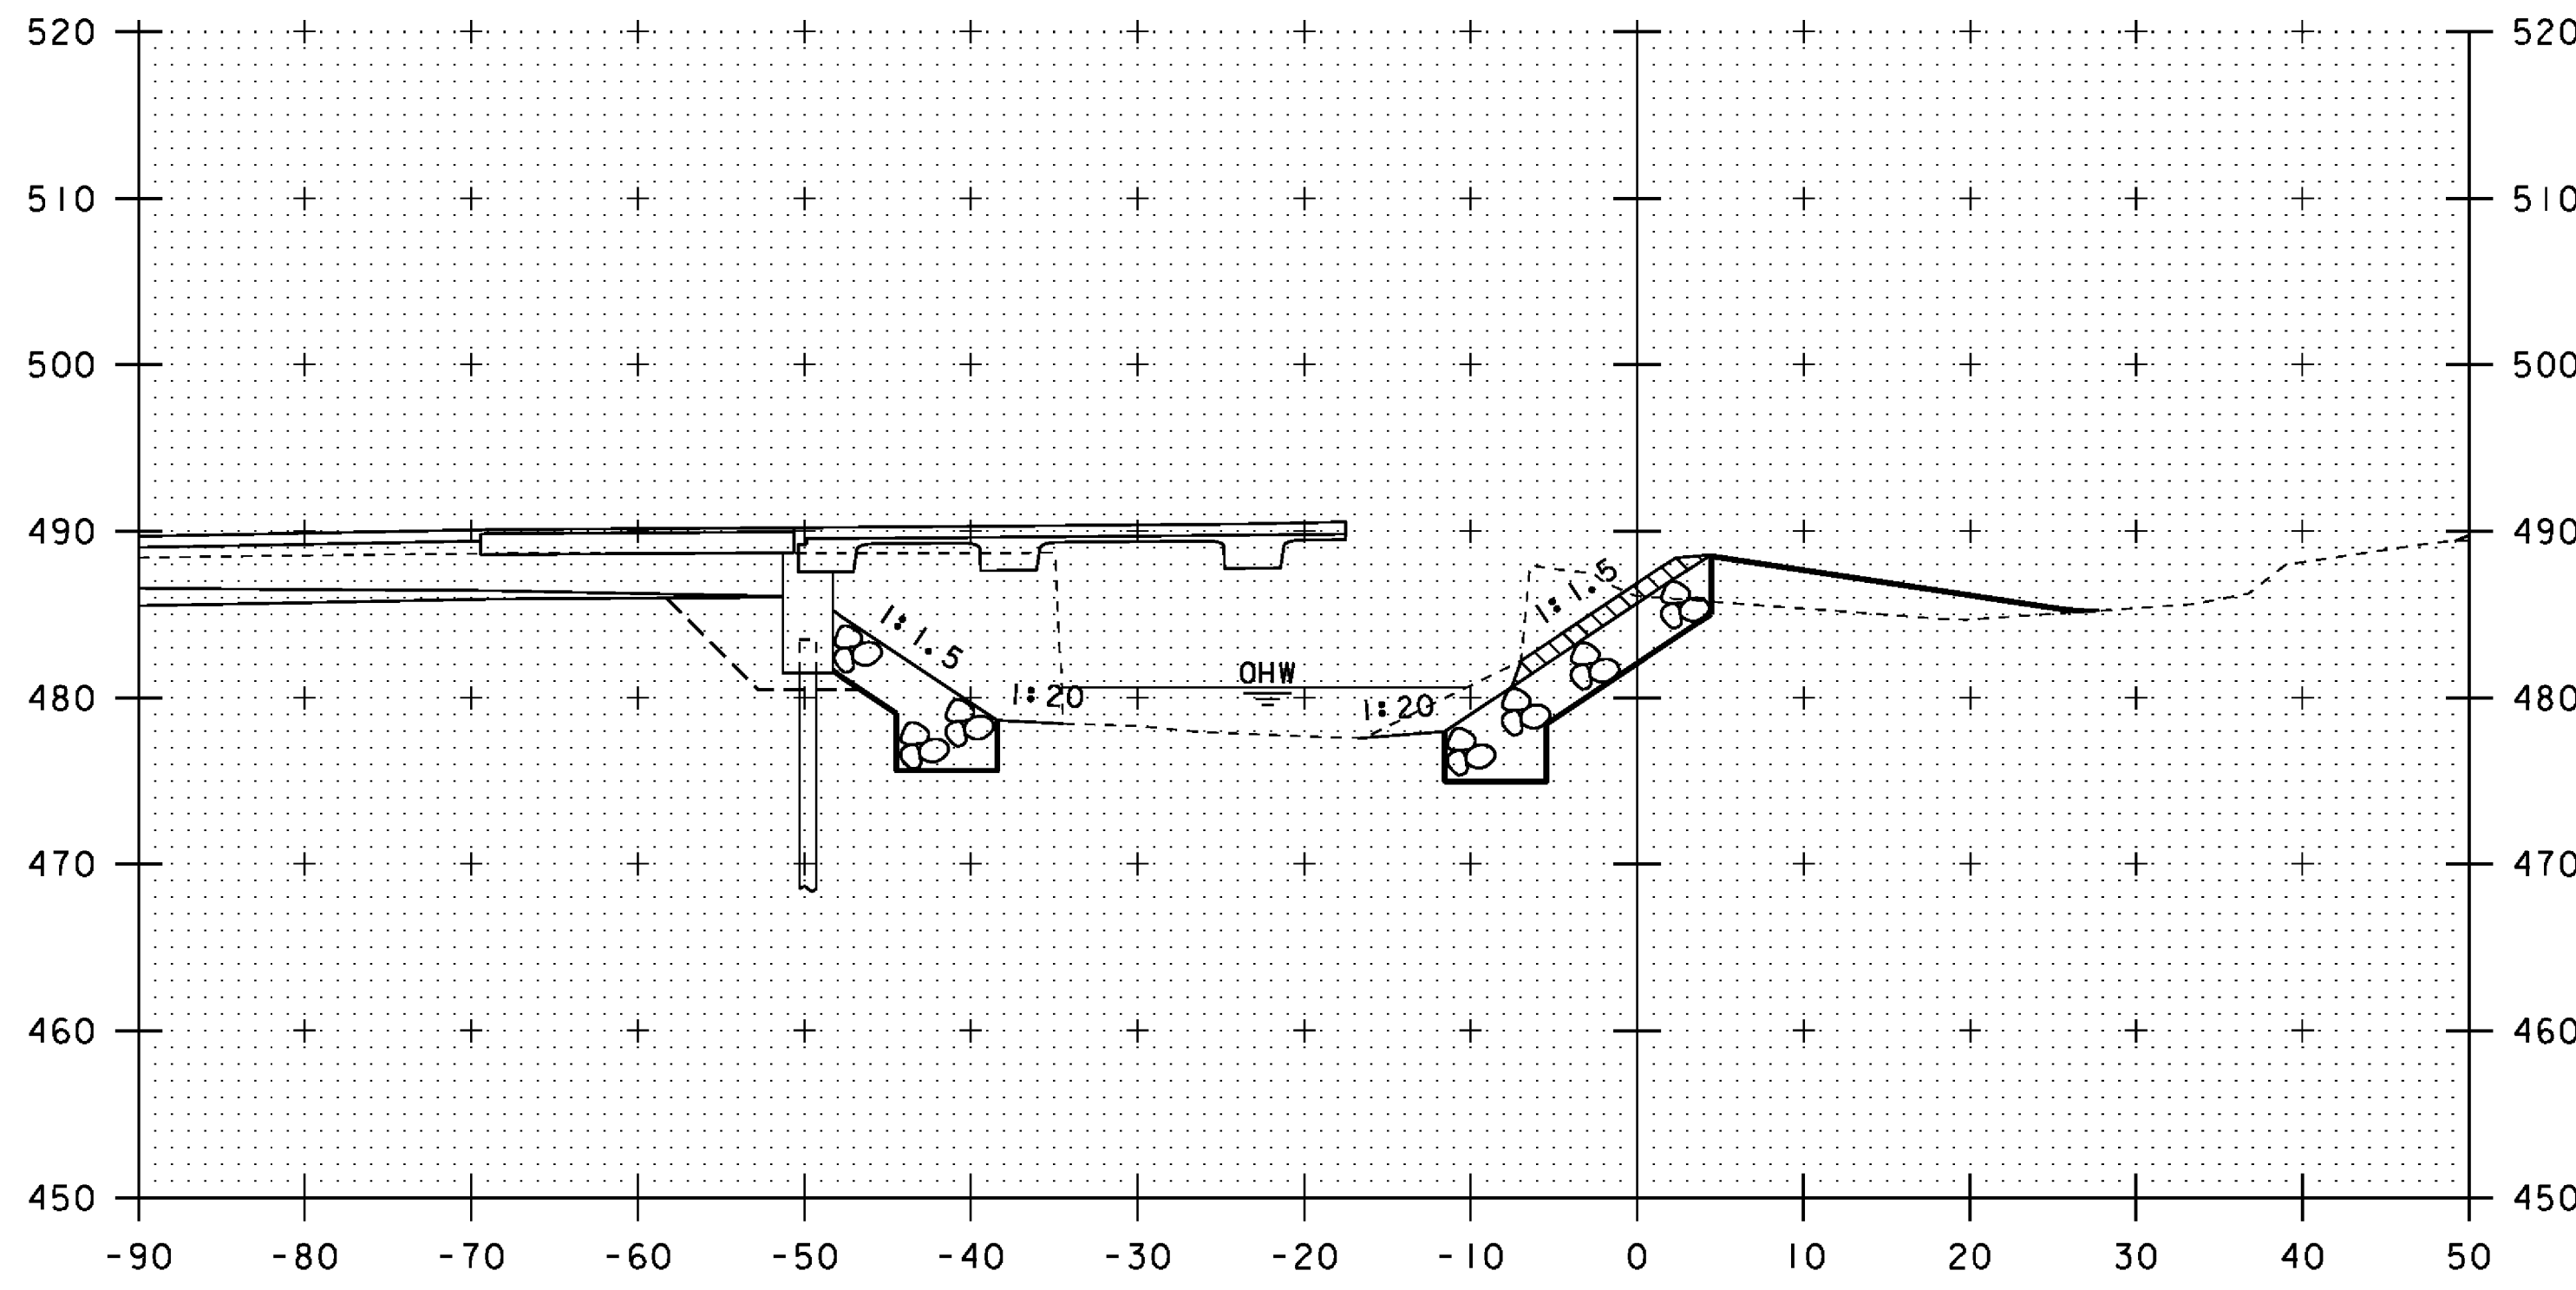


20+50


STA 20+50 BEGIN STRUCTURE EXCAVATION, RT

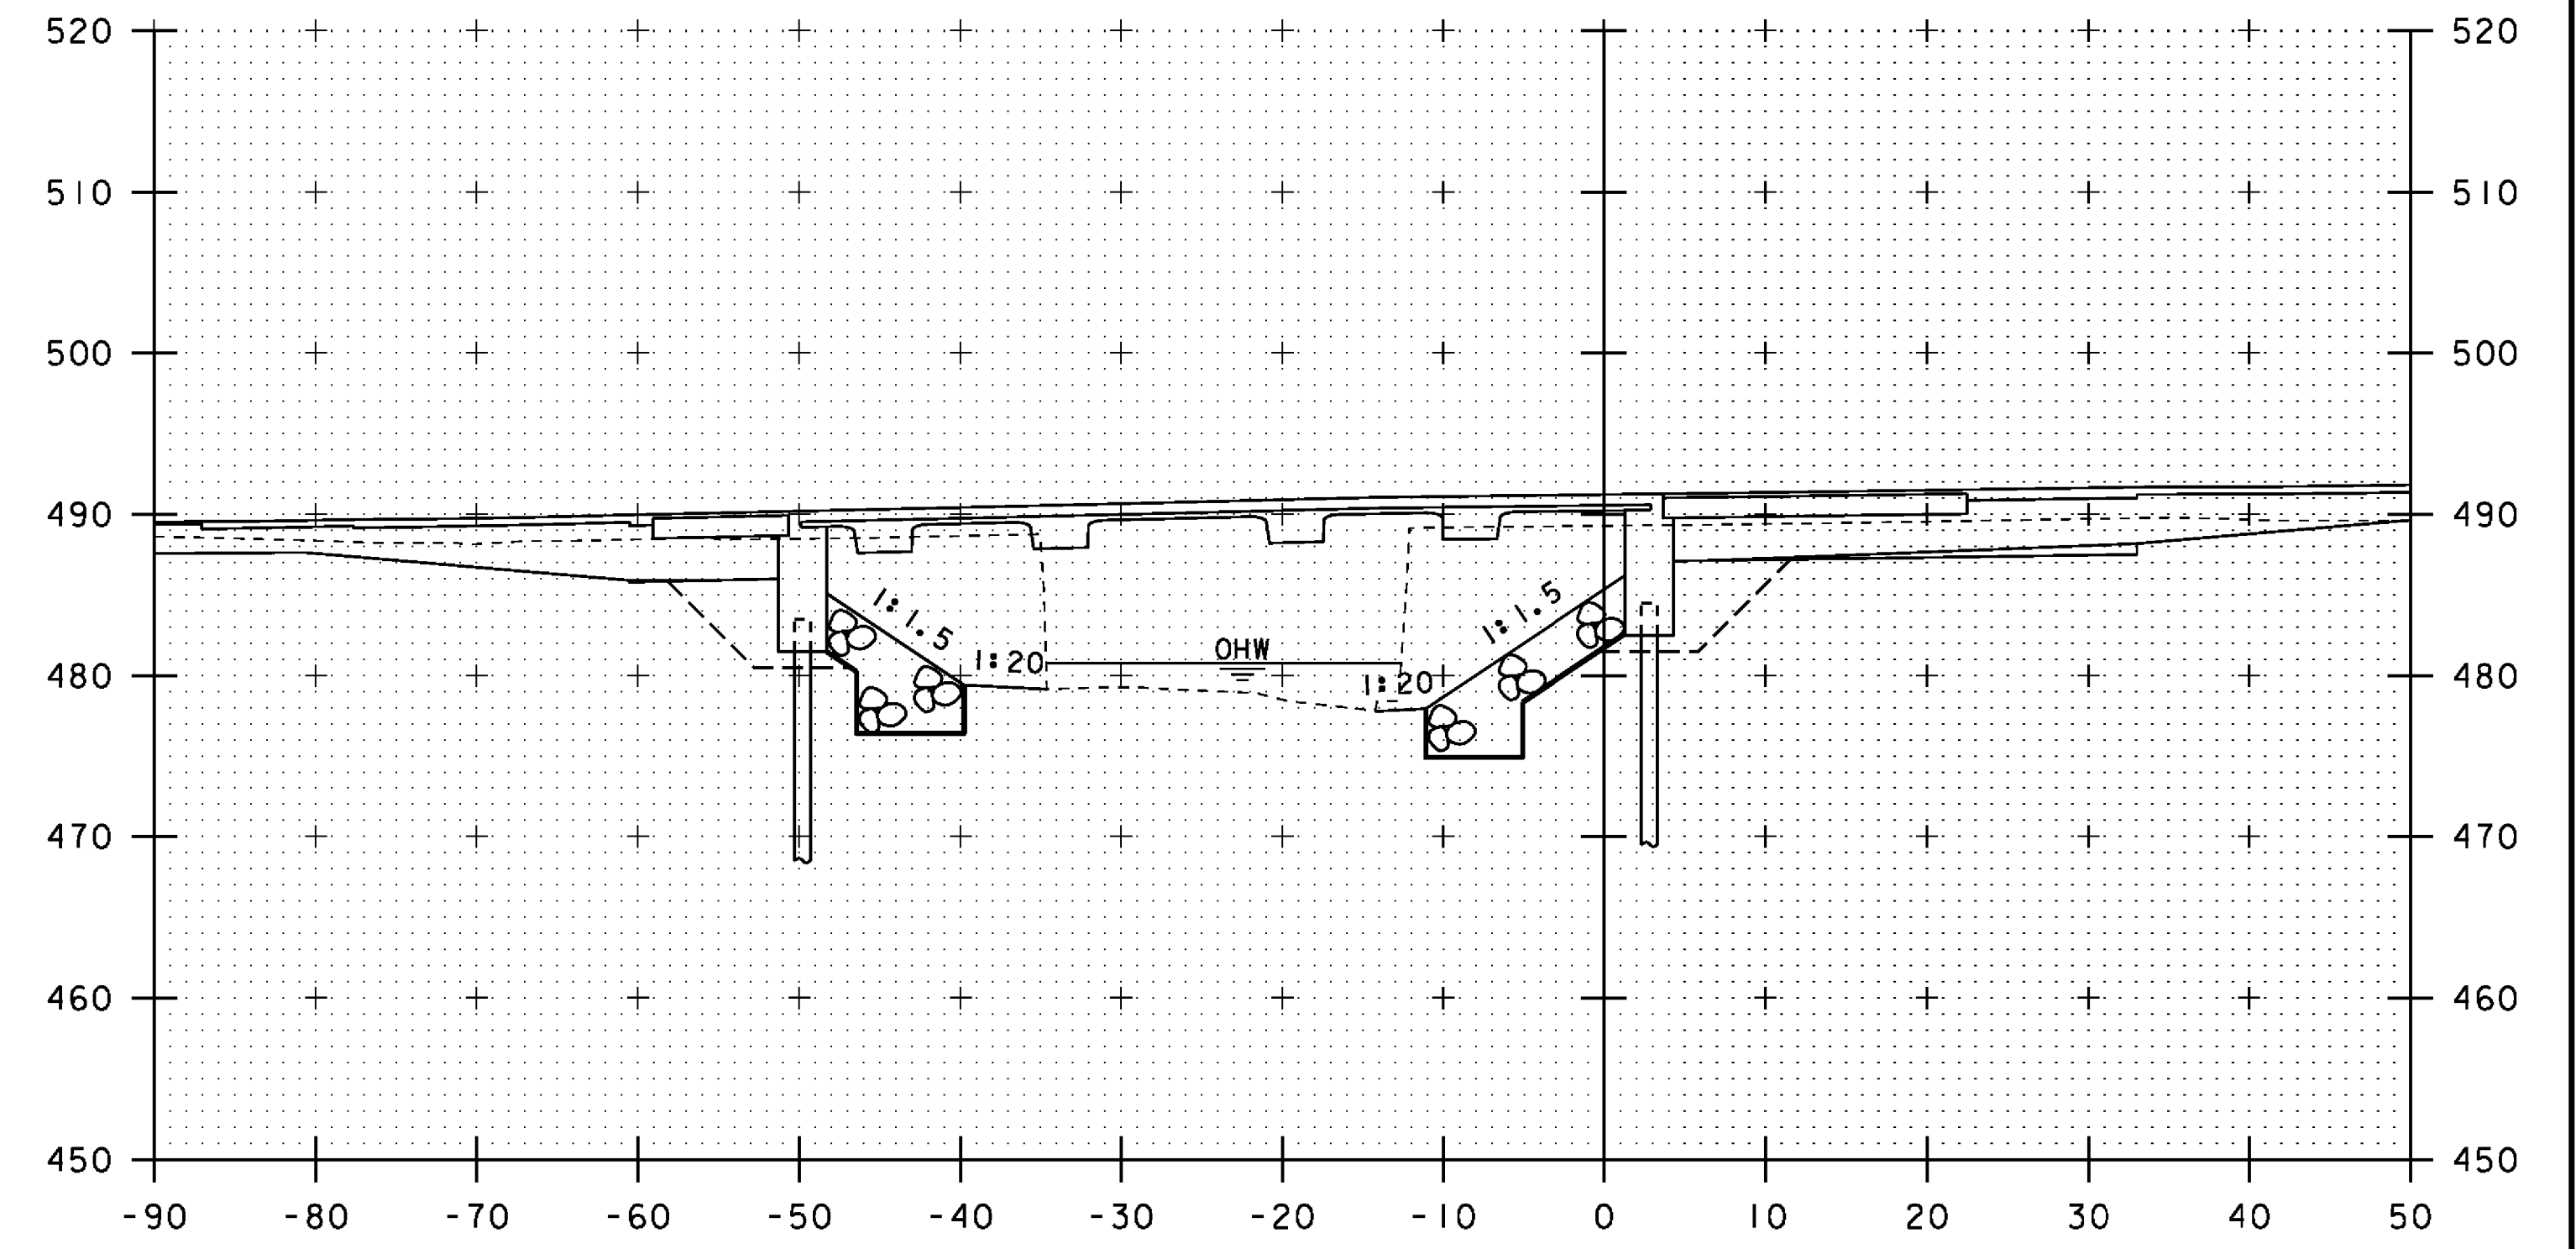

20+70

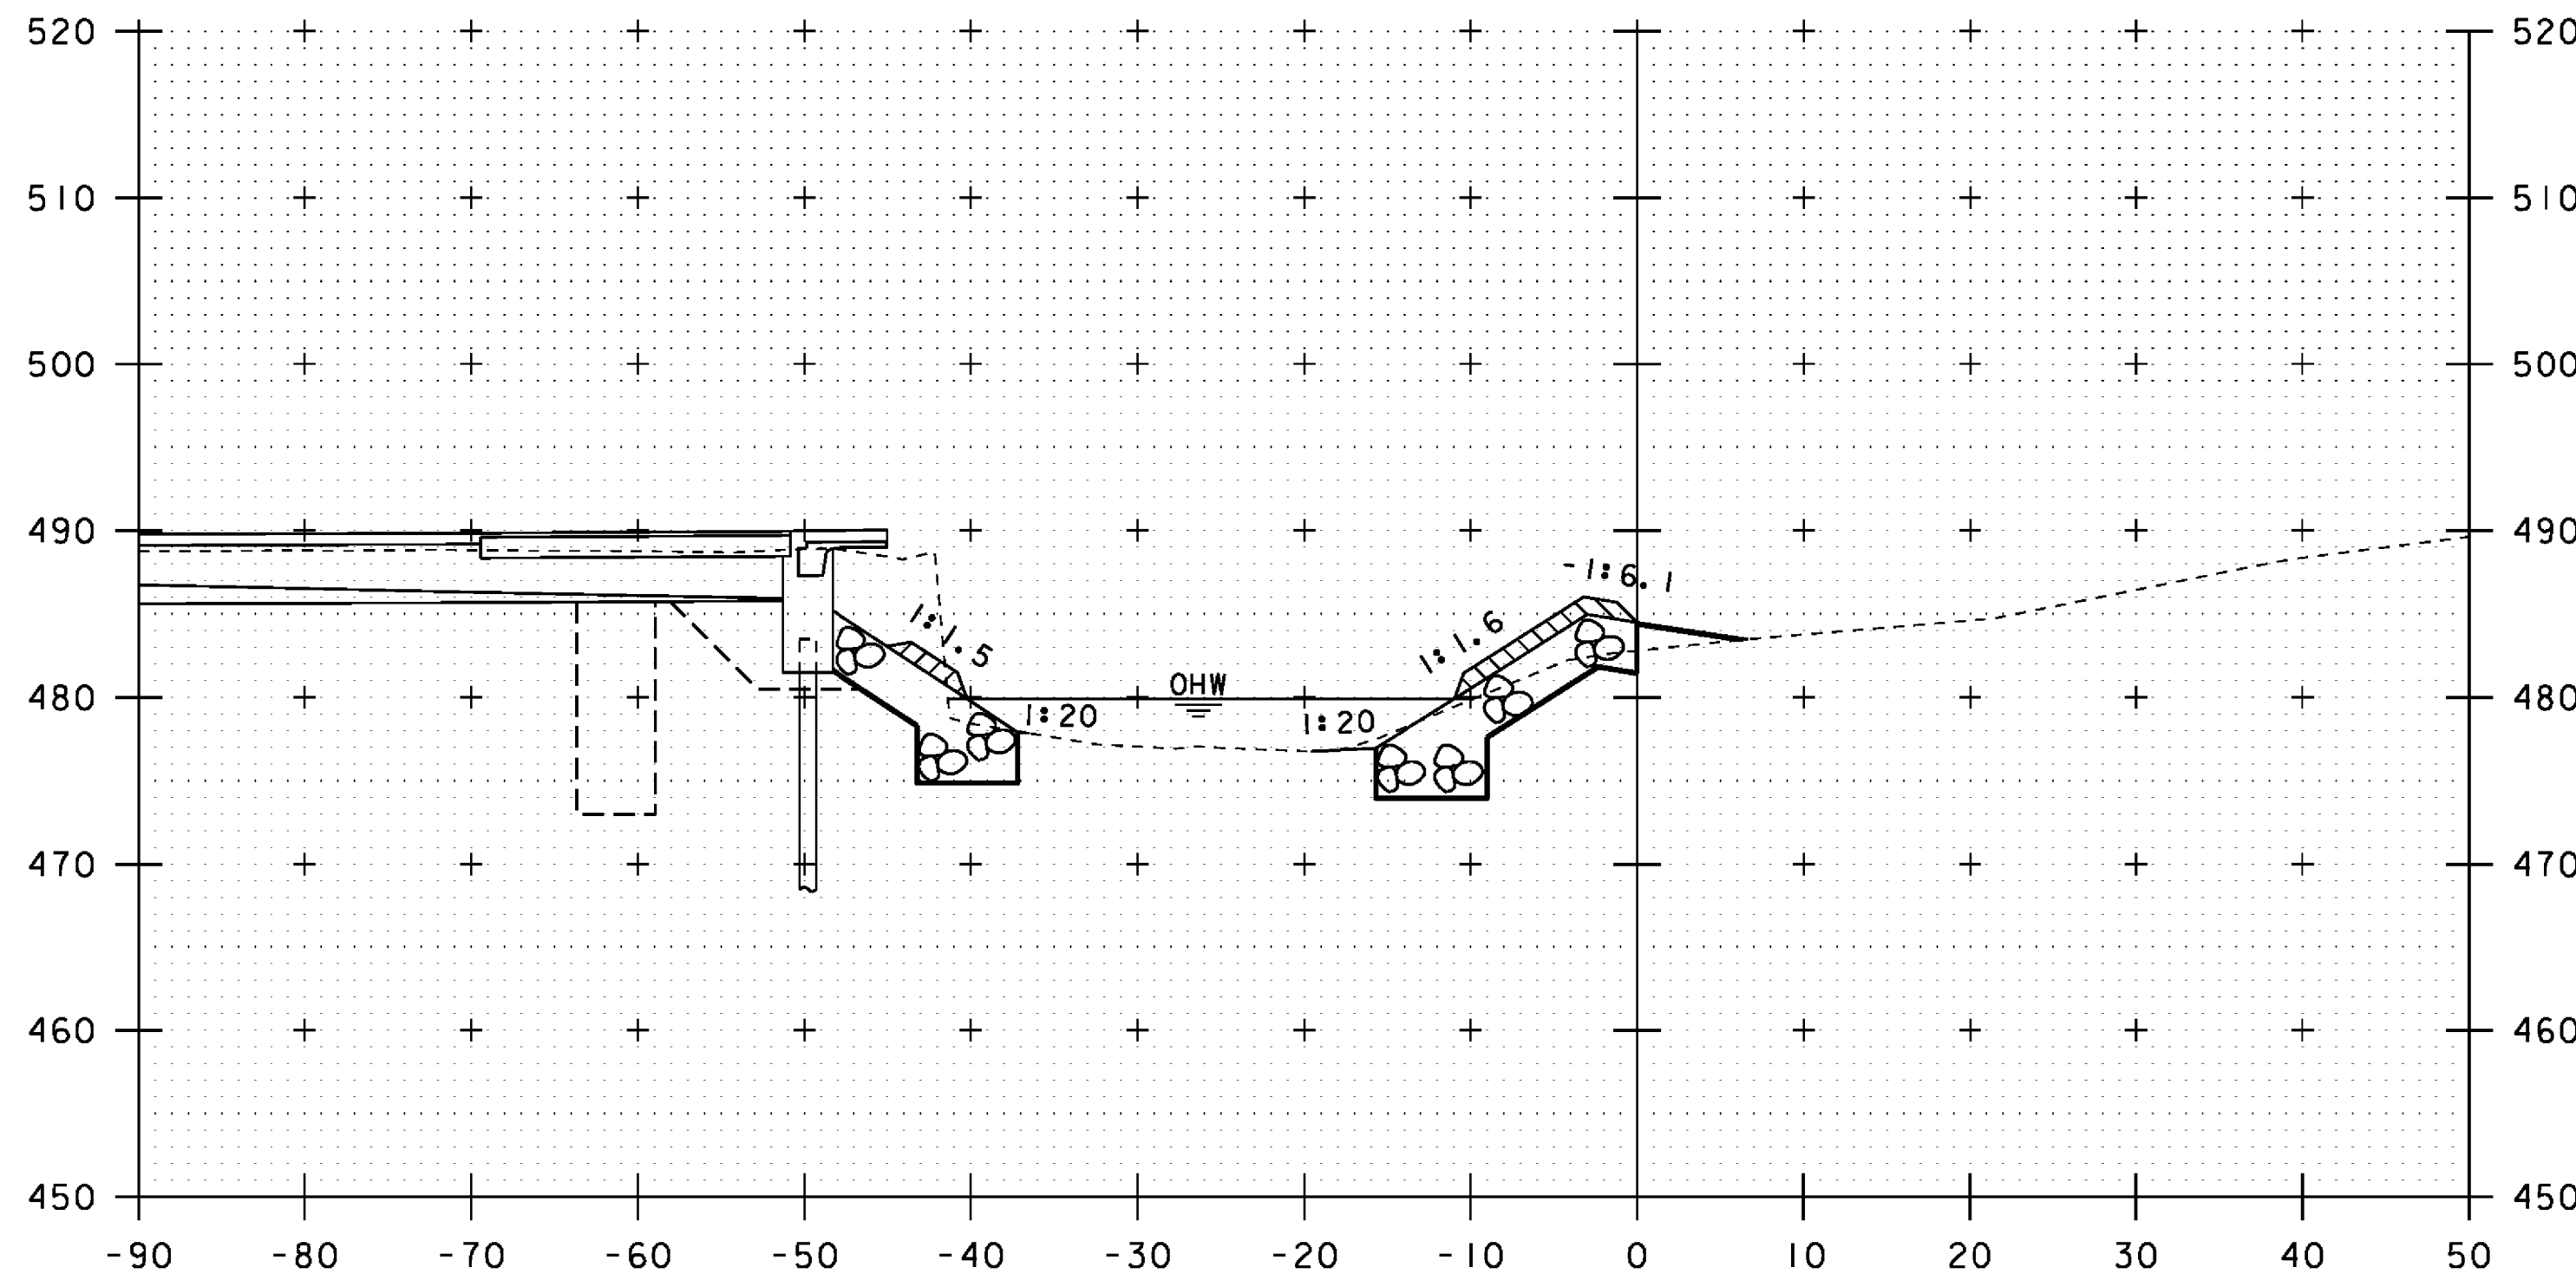


20+40

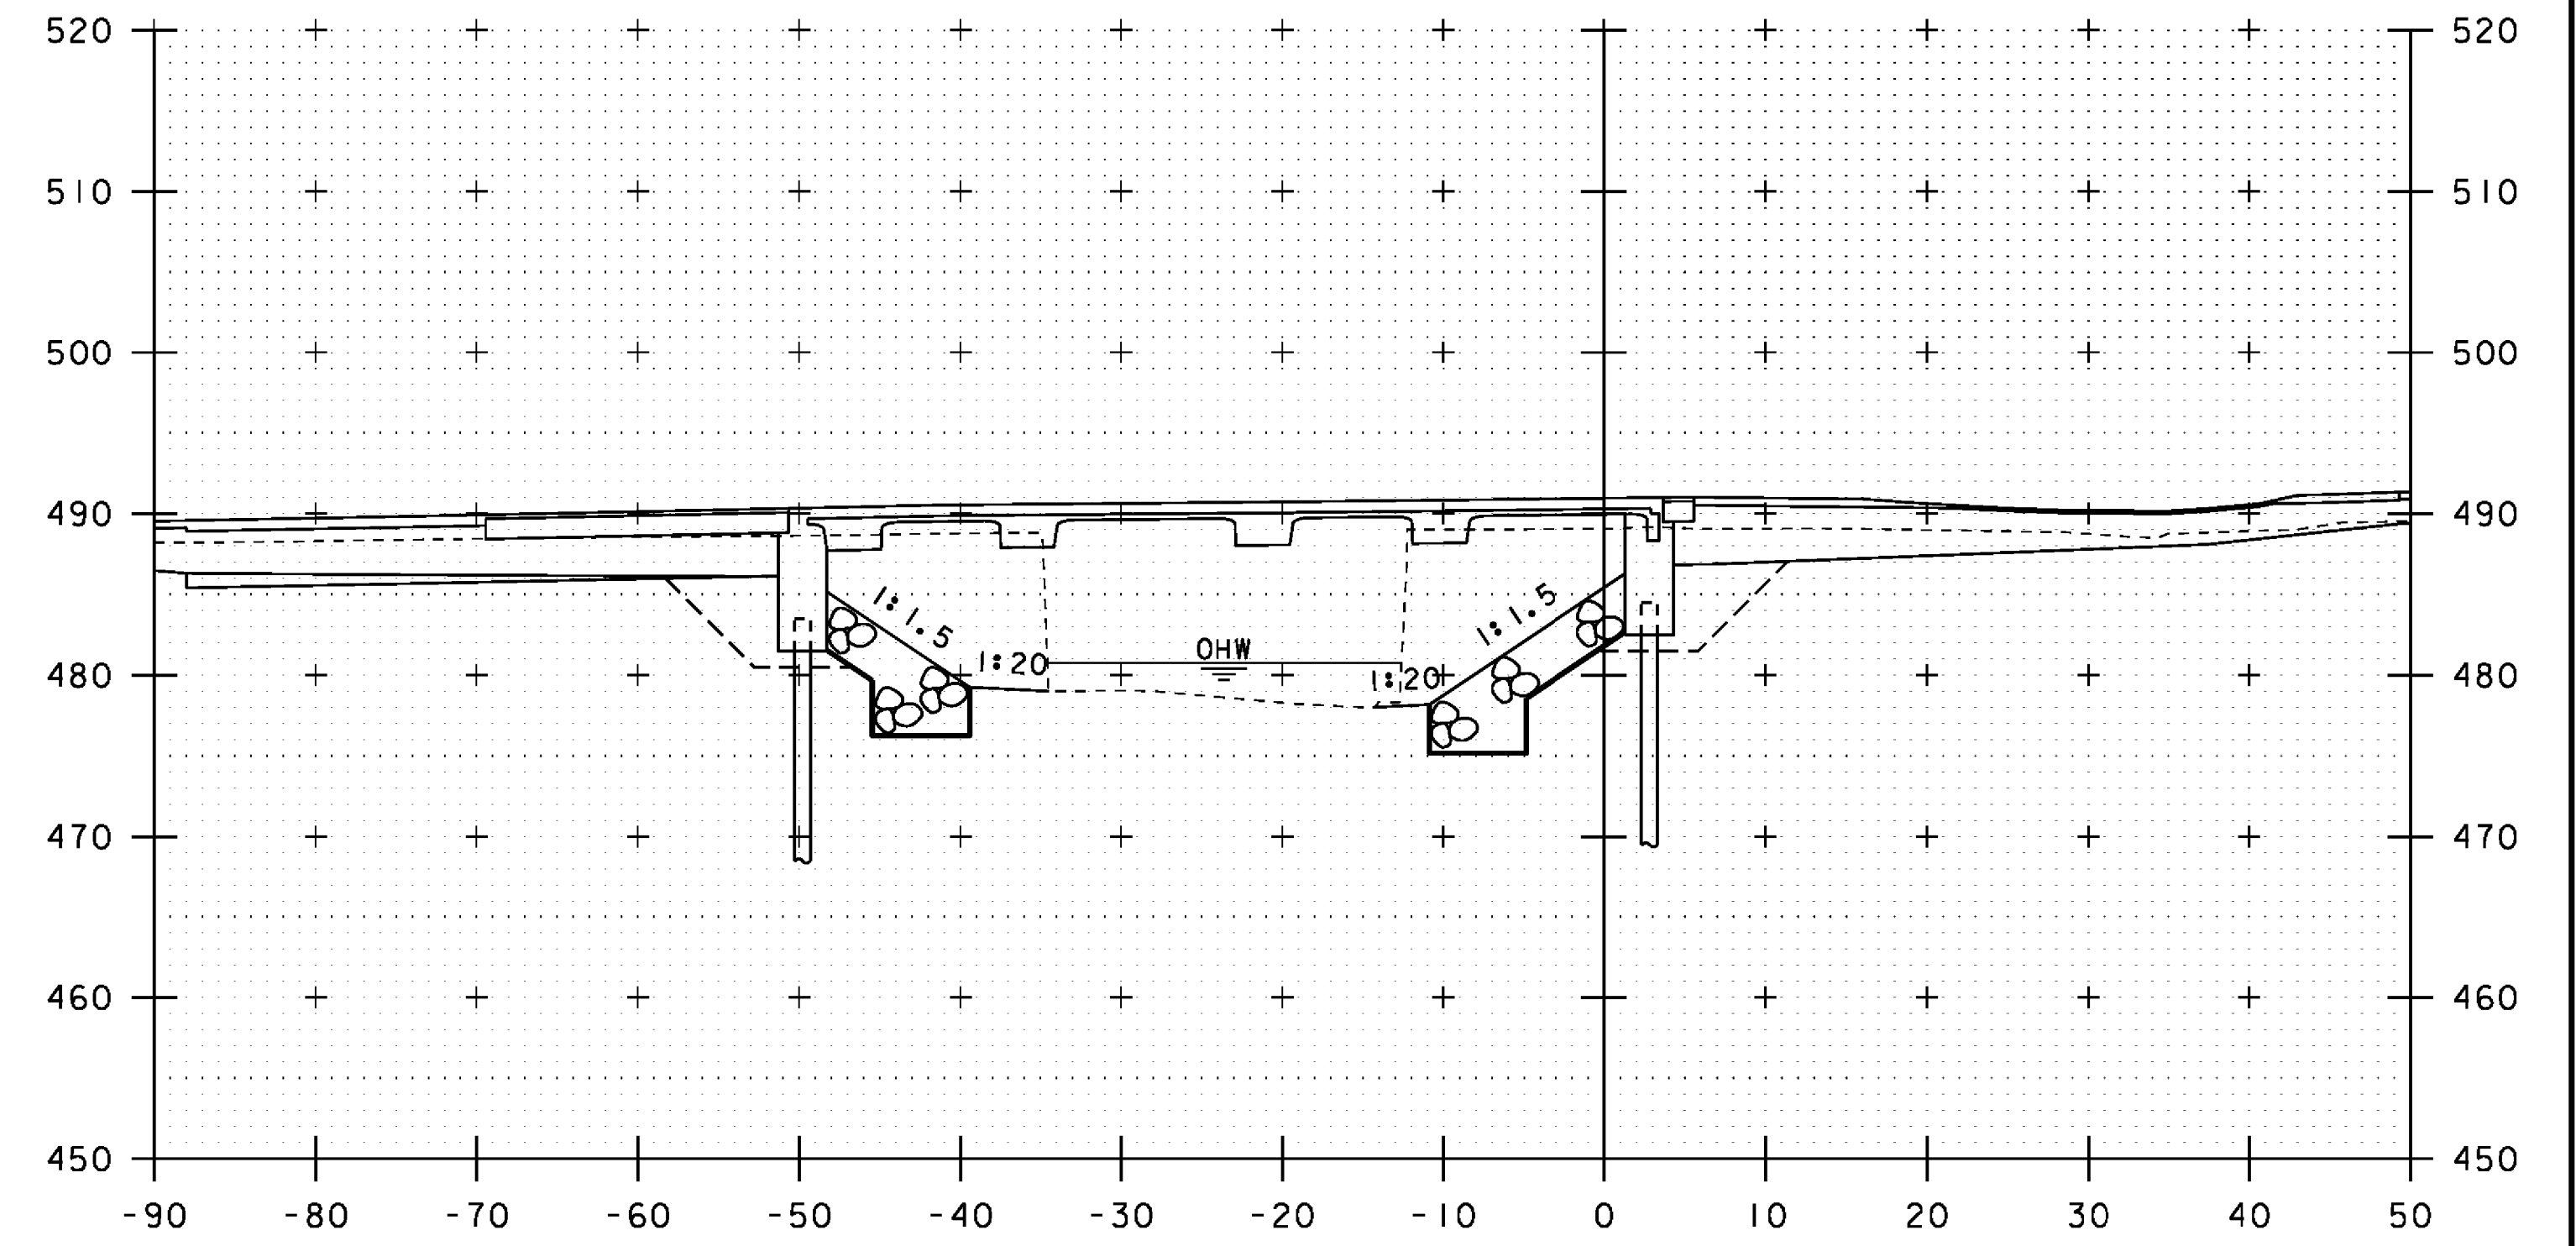


20+60

CHANNEL STA 20+50.0 LT  
 BEGIN STRUCTURE EXCAVATION  
 GRANULAR BACKFILL FOR STRUCTURES

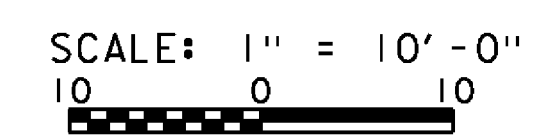


STA. 20+40 TO STA. 20+70

PROJECT NAME:	JOHNSON	PLOT DATE:	10-JUN-2014
PROJECT NUMBER:	BRF 030-2(26)	DRAWN BY:	G. ROY
FILE NAME:	s88bi93xsl.dgn	CHECKED BY:	H. SALLS
PROJECT LEADER:	C. CARLSON	SHEET	54 OF 69
DESIGNED BY:	H. SALLS	CHANNEL CROSS SECTIONS (2)	

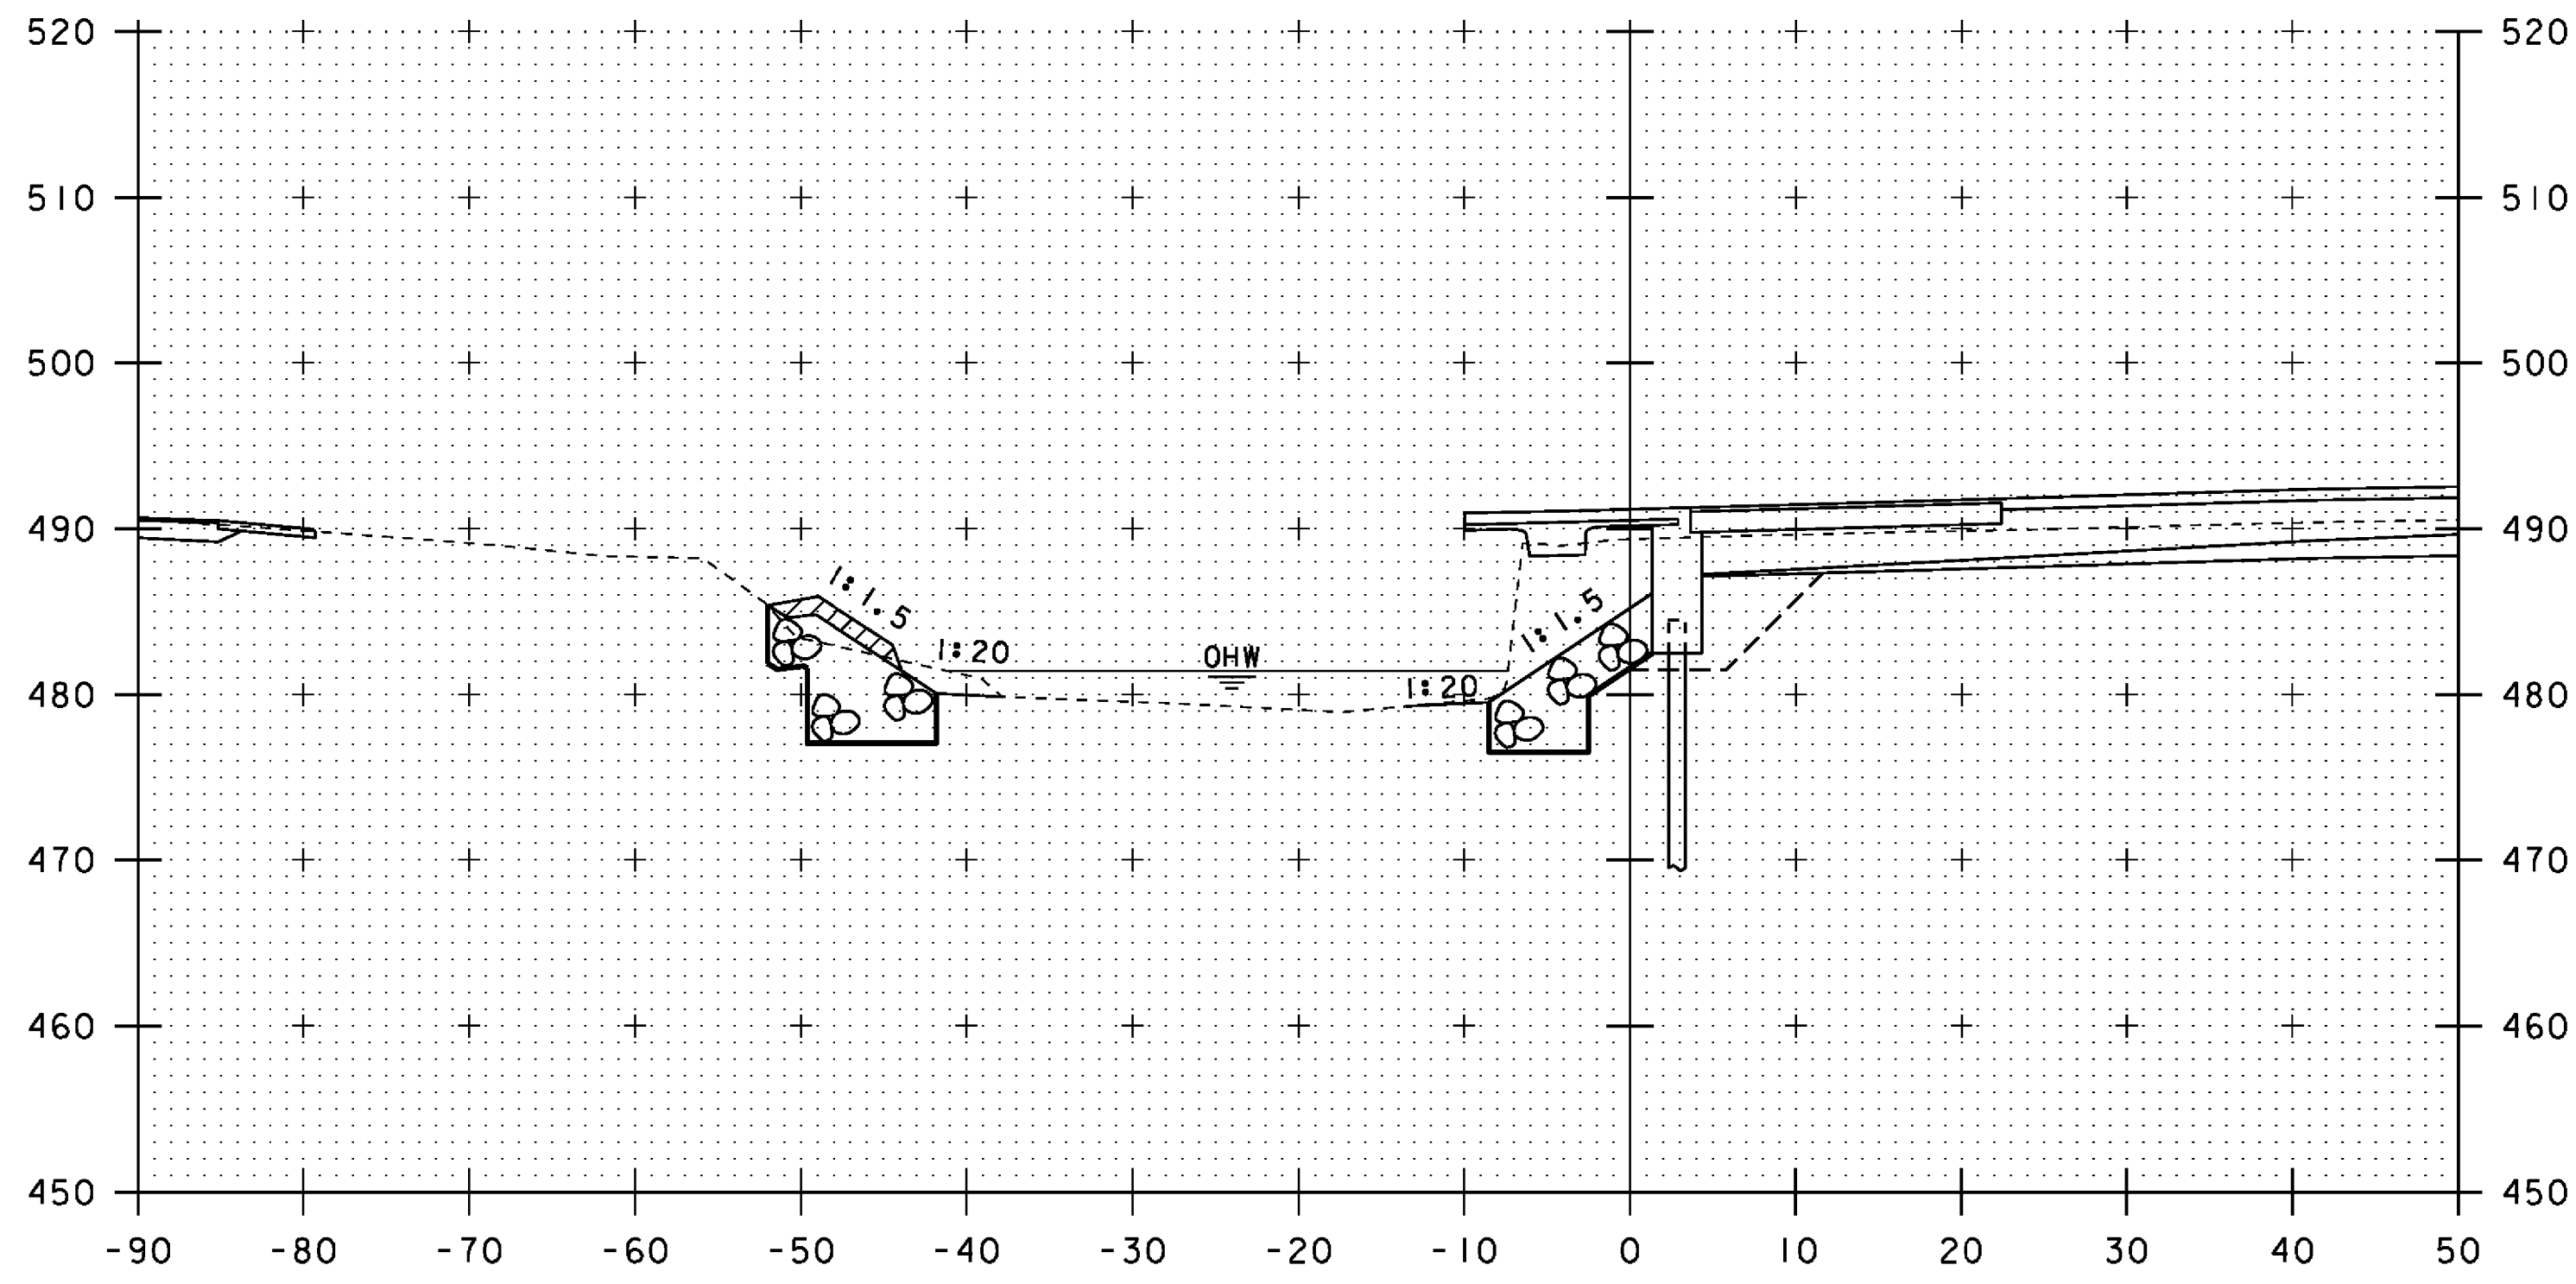

CHANNEL STA 20+83.0 FAR LT  
 END STRUCTURE EXCAVATION  
 GRANULAR BACKFILL FOR STRUCTURES


20+90

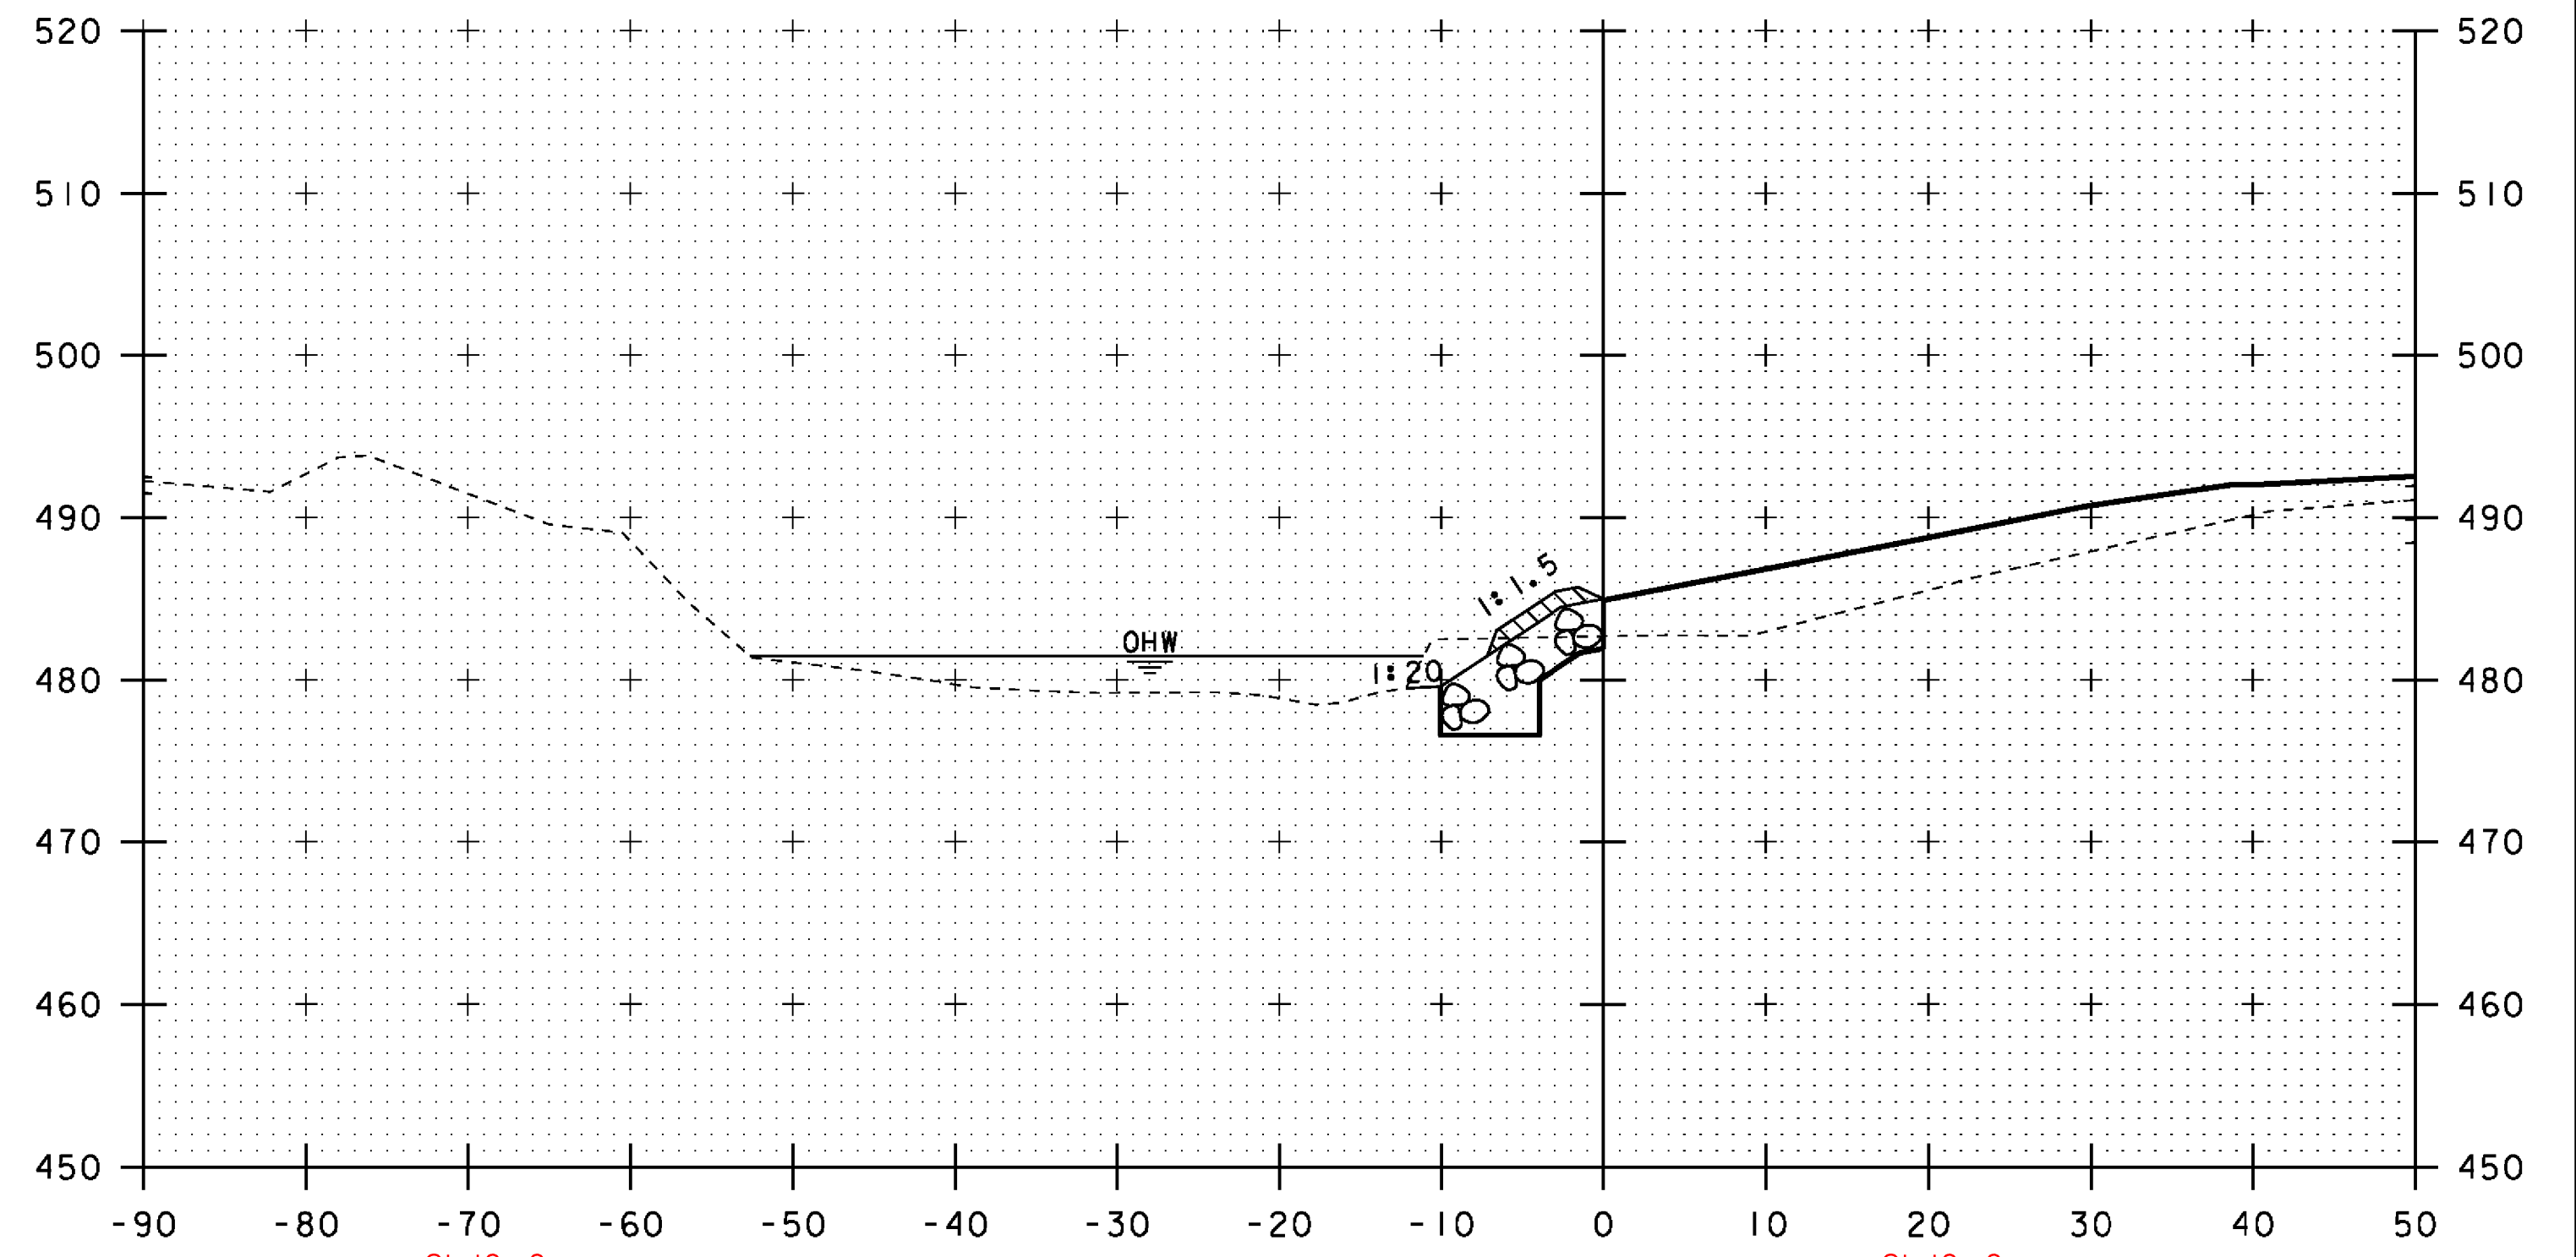


CHANNEL STA ~~21+05.0~~ ^{21+10.0} FAR LT  
 END UNCLASSIFIED CHANNEL EXCAVATION  
 GEOTEXTILE UNDER STONE FILL  
 STONE FILL, TYPE III  
 GRUBBING MATERIAL

21+10

CHANNEL STA ~~21+03.0~~ ^{21+10.0} LT  
 END STRUCTURE EXCAVATION  
 GRANULAR BACKFILL FOR STRUCTURES

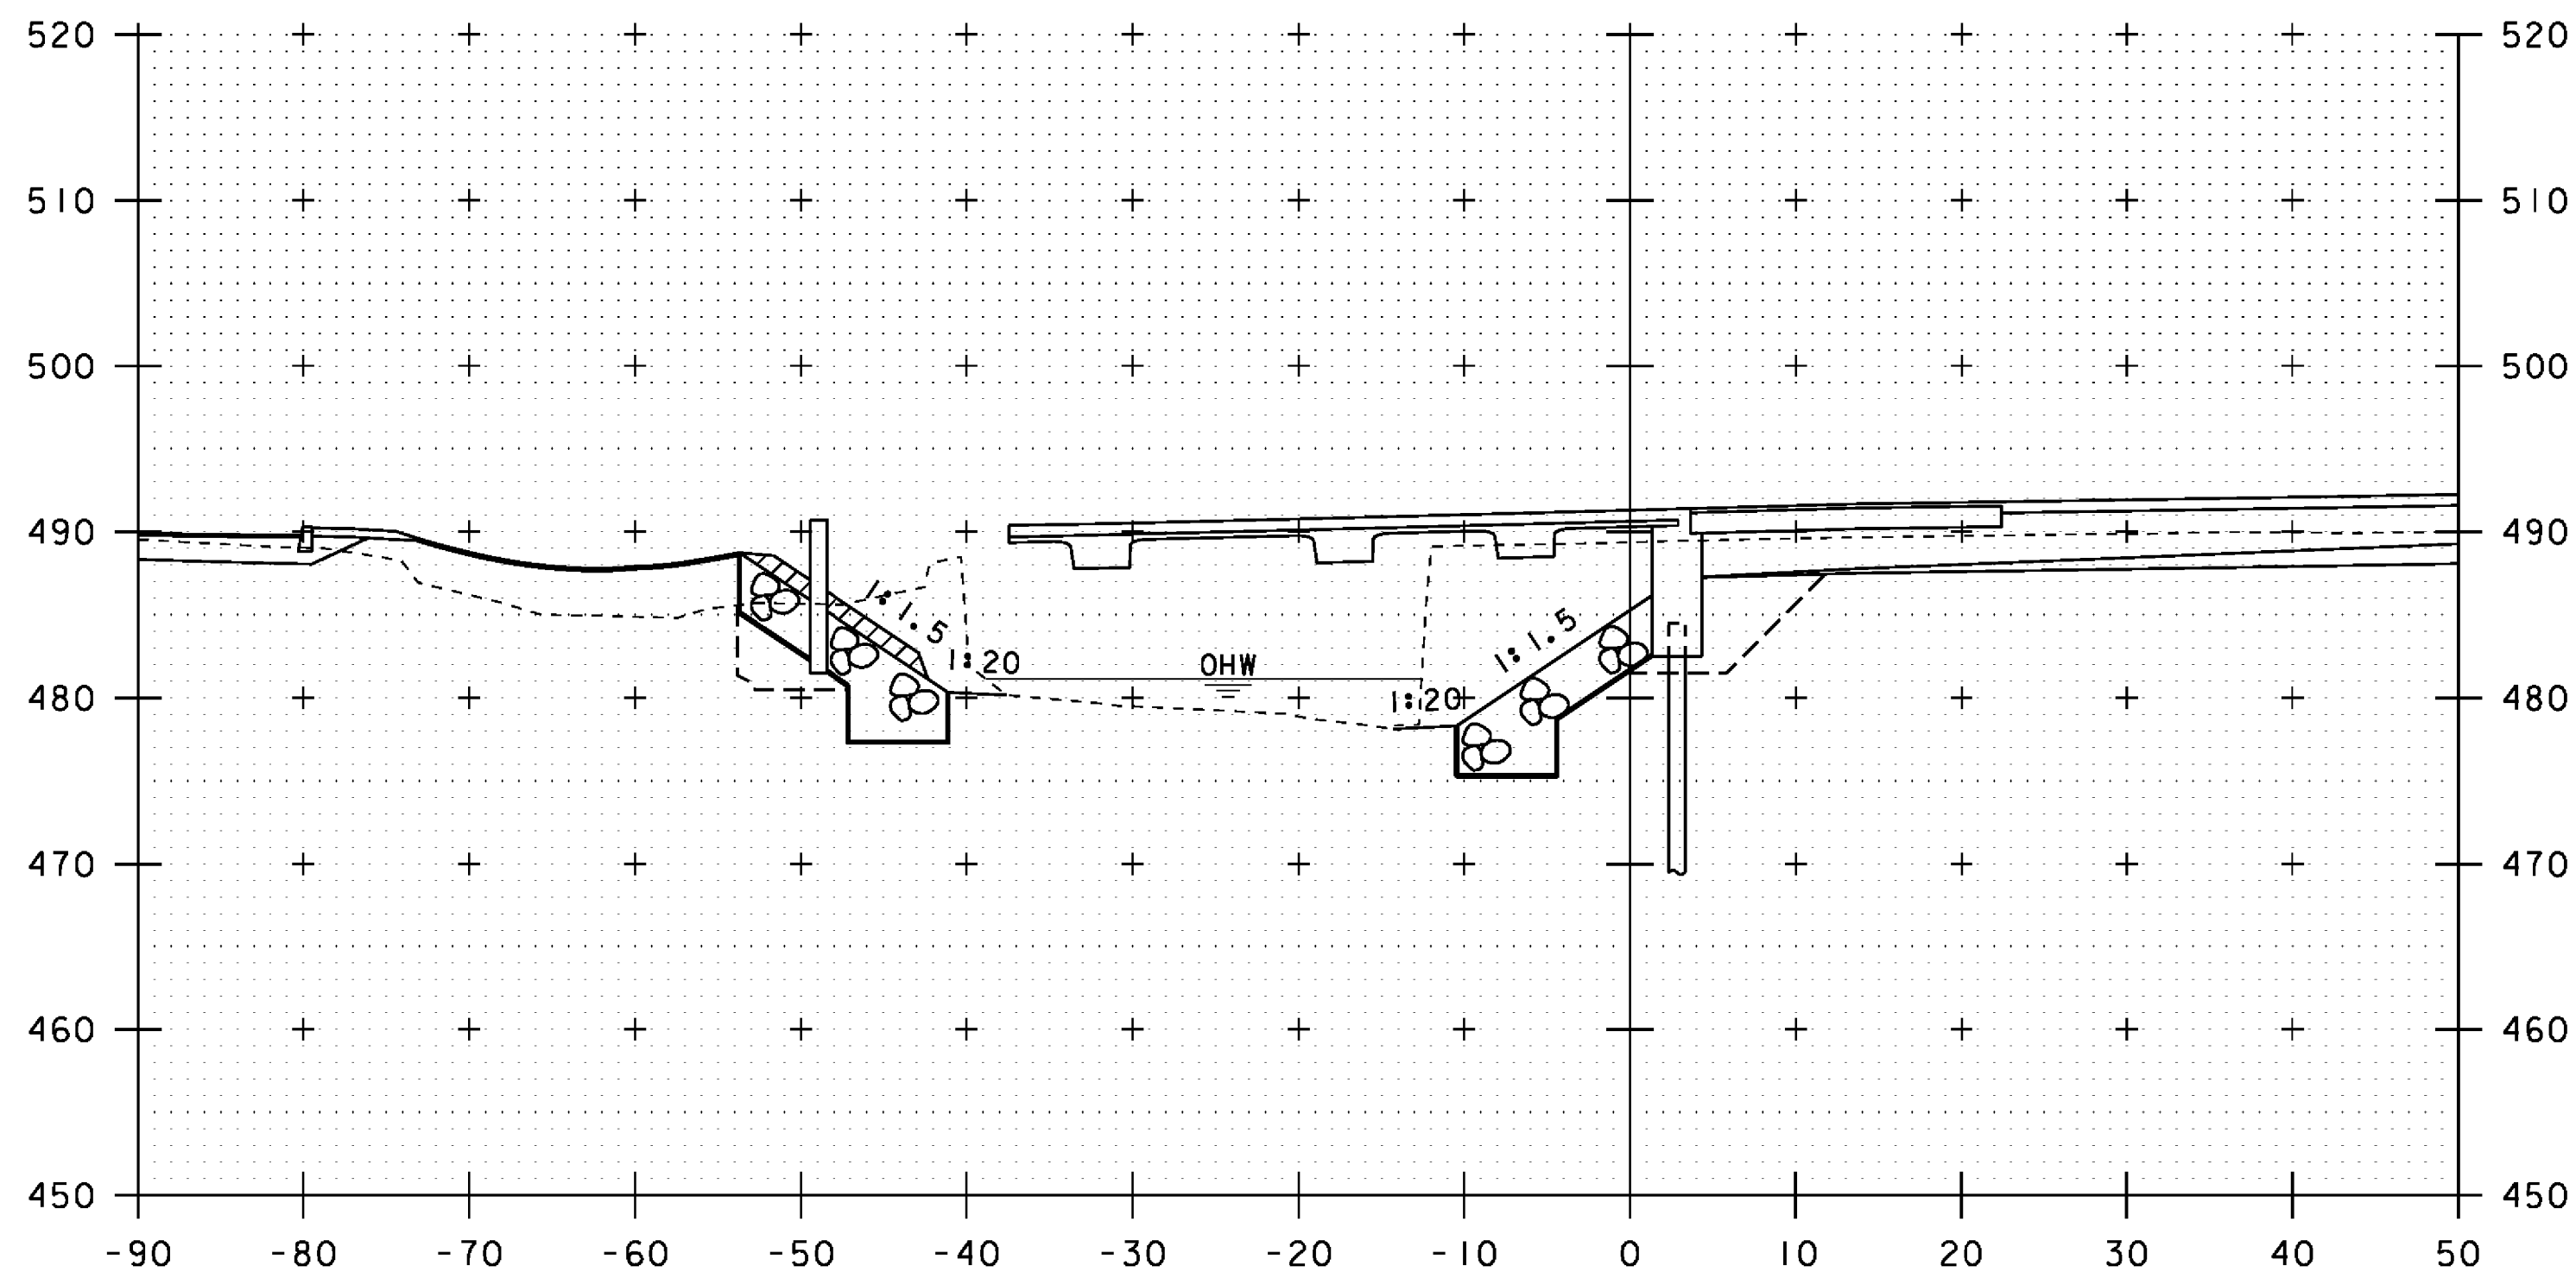

20+80

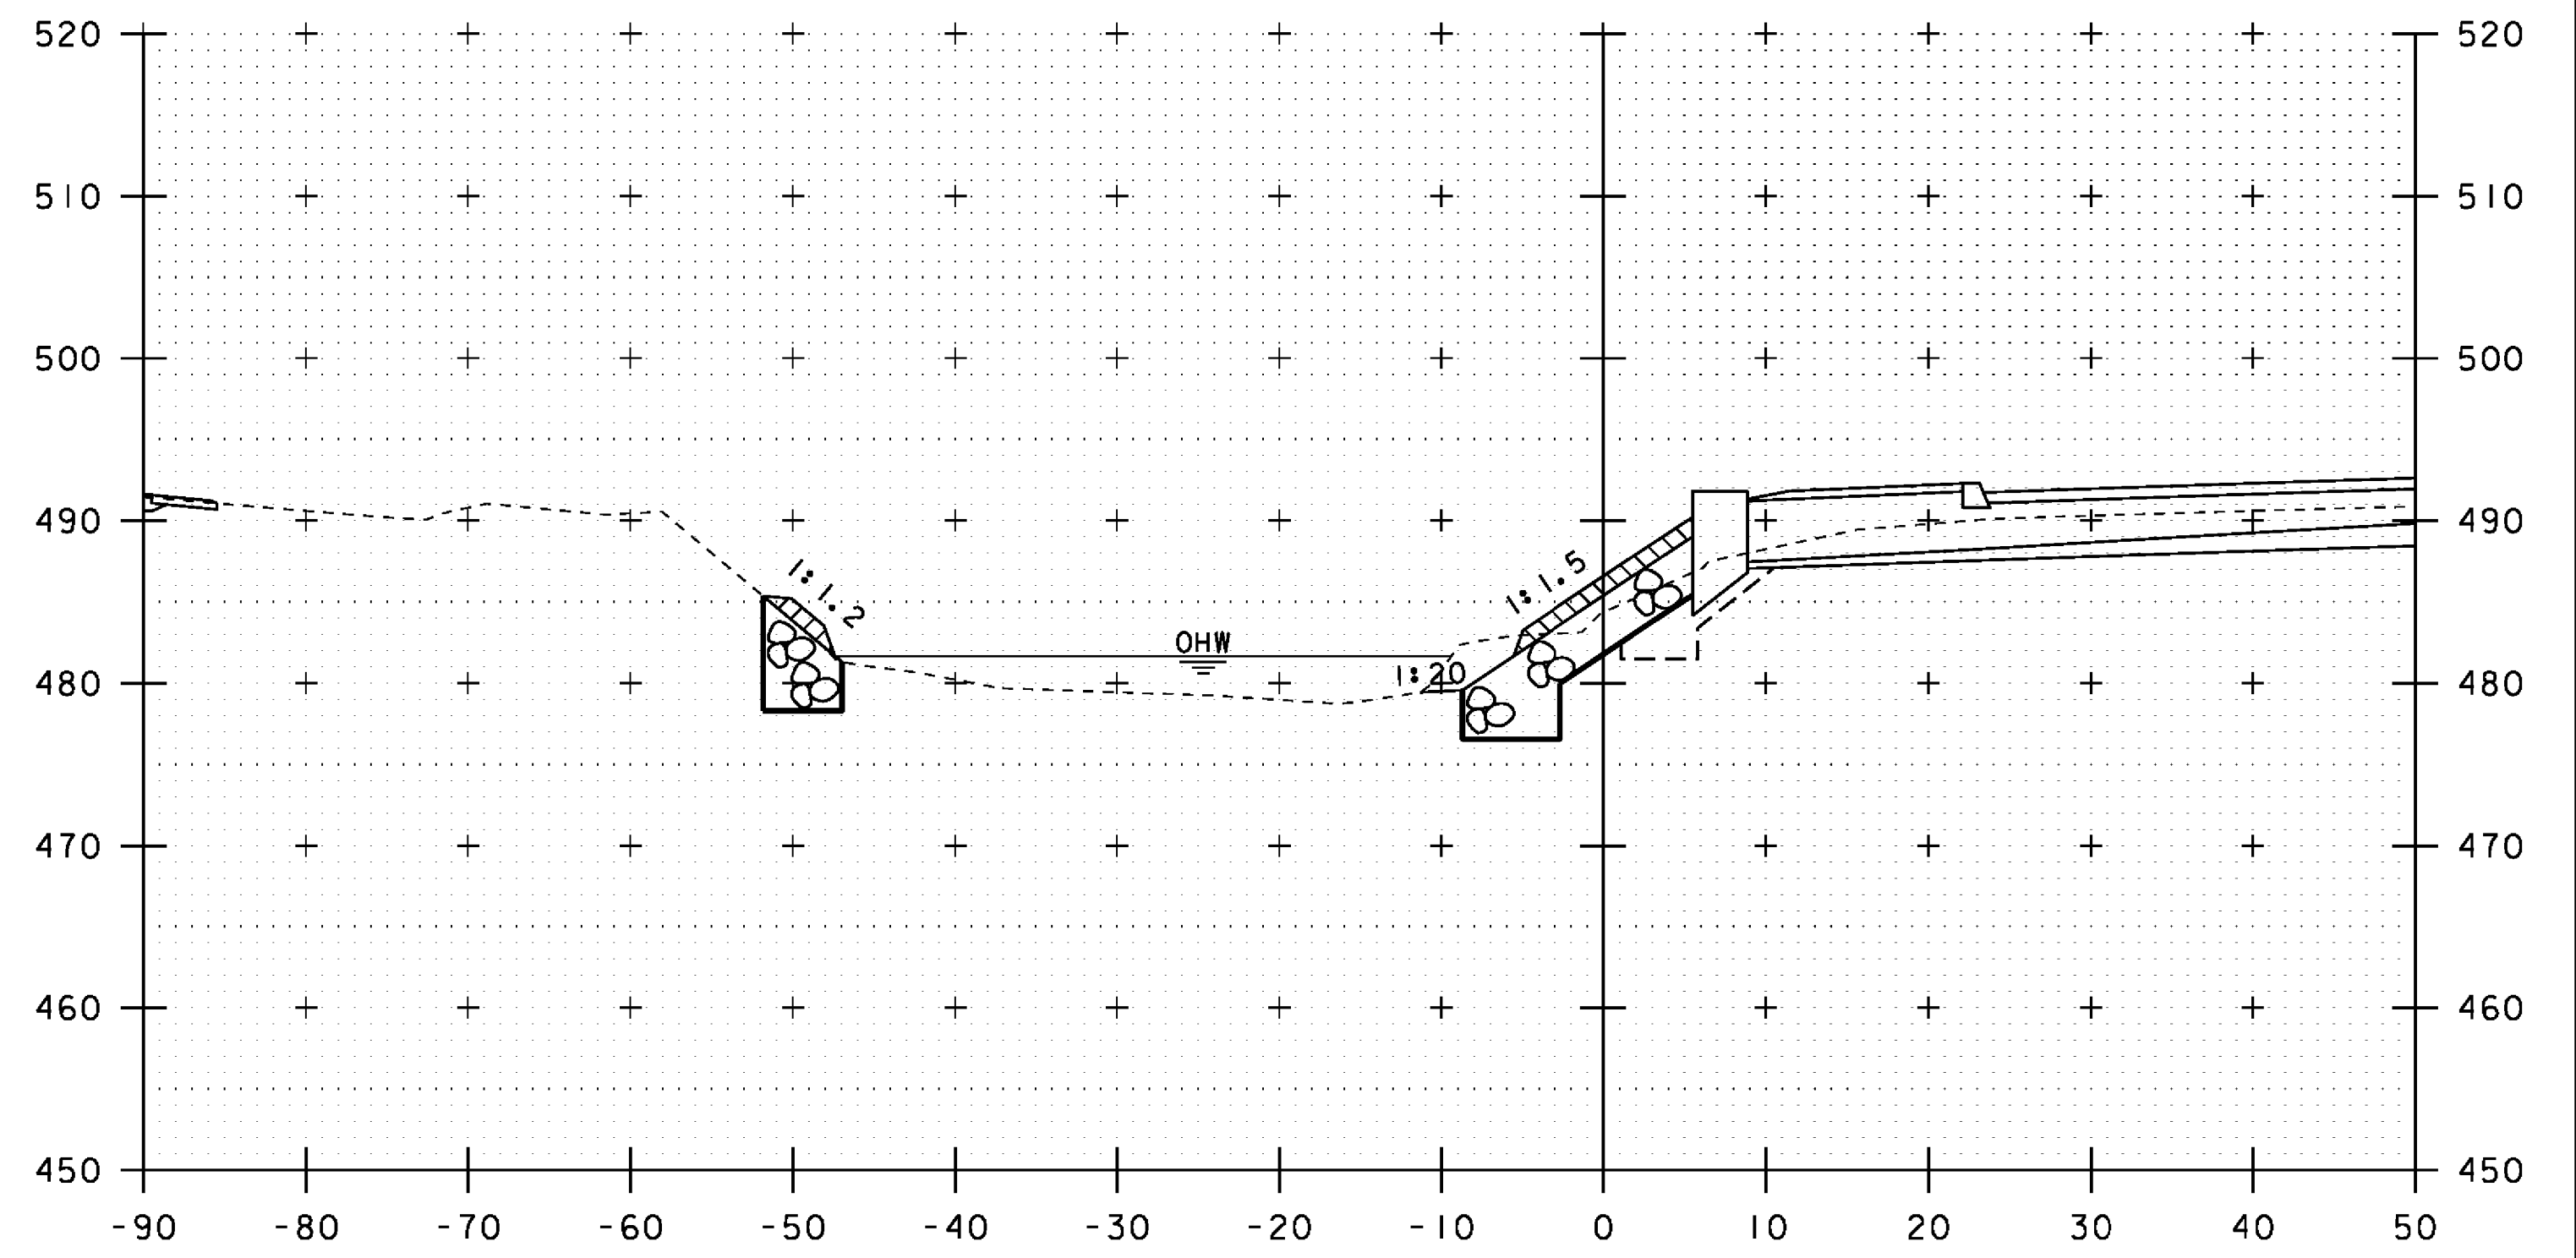

21+00


SCALE: 1" = 10'-0"

STA. 20+80 TO STA. 21+10

PROJECT NAME: JOHNSON  
 PROJECT NUMBER: BRF 030-2(26)


FILE NAME: s88bi93xsl.dgn  
 PROJECT LEADER: C. CARLSON  
 DESIGNED BY: H. SALLS  
 CHANNEL CROSS SECTIONS (3)

PLOT DATE: 10-JUN-2014  
 DRAWN BY: G. ROY  
 CHECKED BY: H. SALLS  
 SHEET 55 OF 69

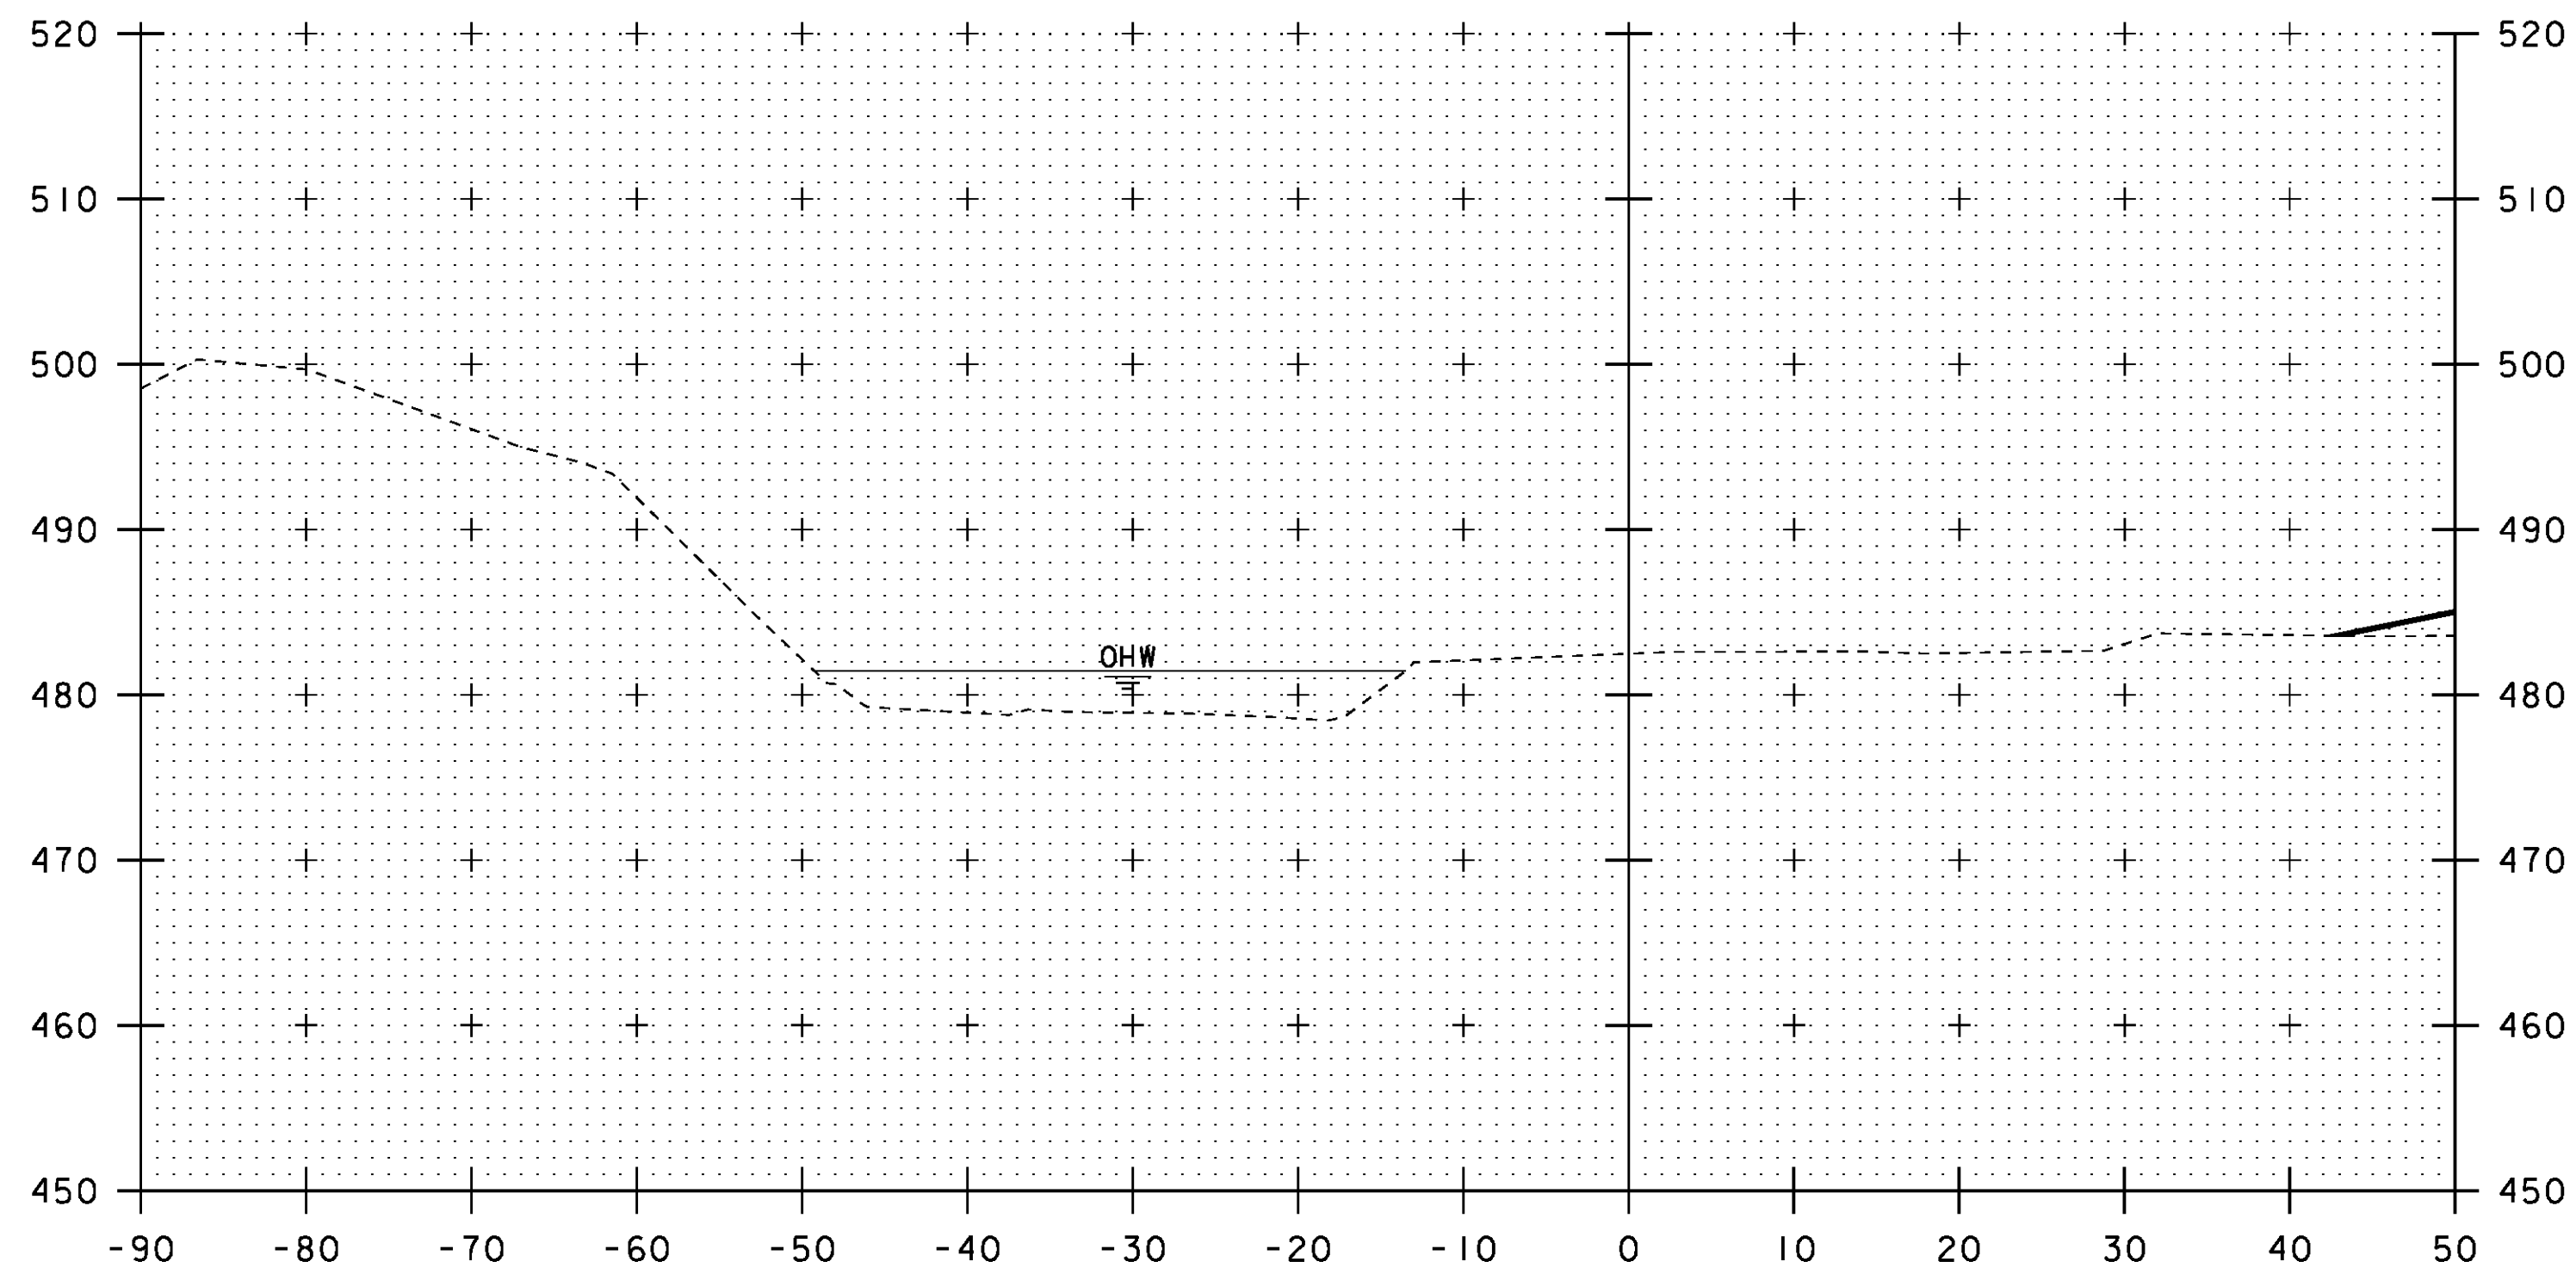

21+30

CHANNEL STA 21+25.0 LT  
 END UNCLASSIFIED CHANNEL EXCAVATION  
 GEOTEXTILE UNDER STONE FILL  
 STONE FILL, TYPE III  
 GRUBBING MATERIAL

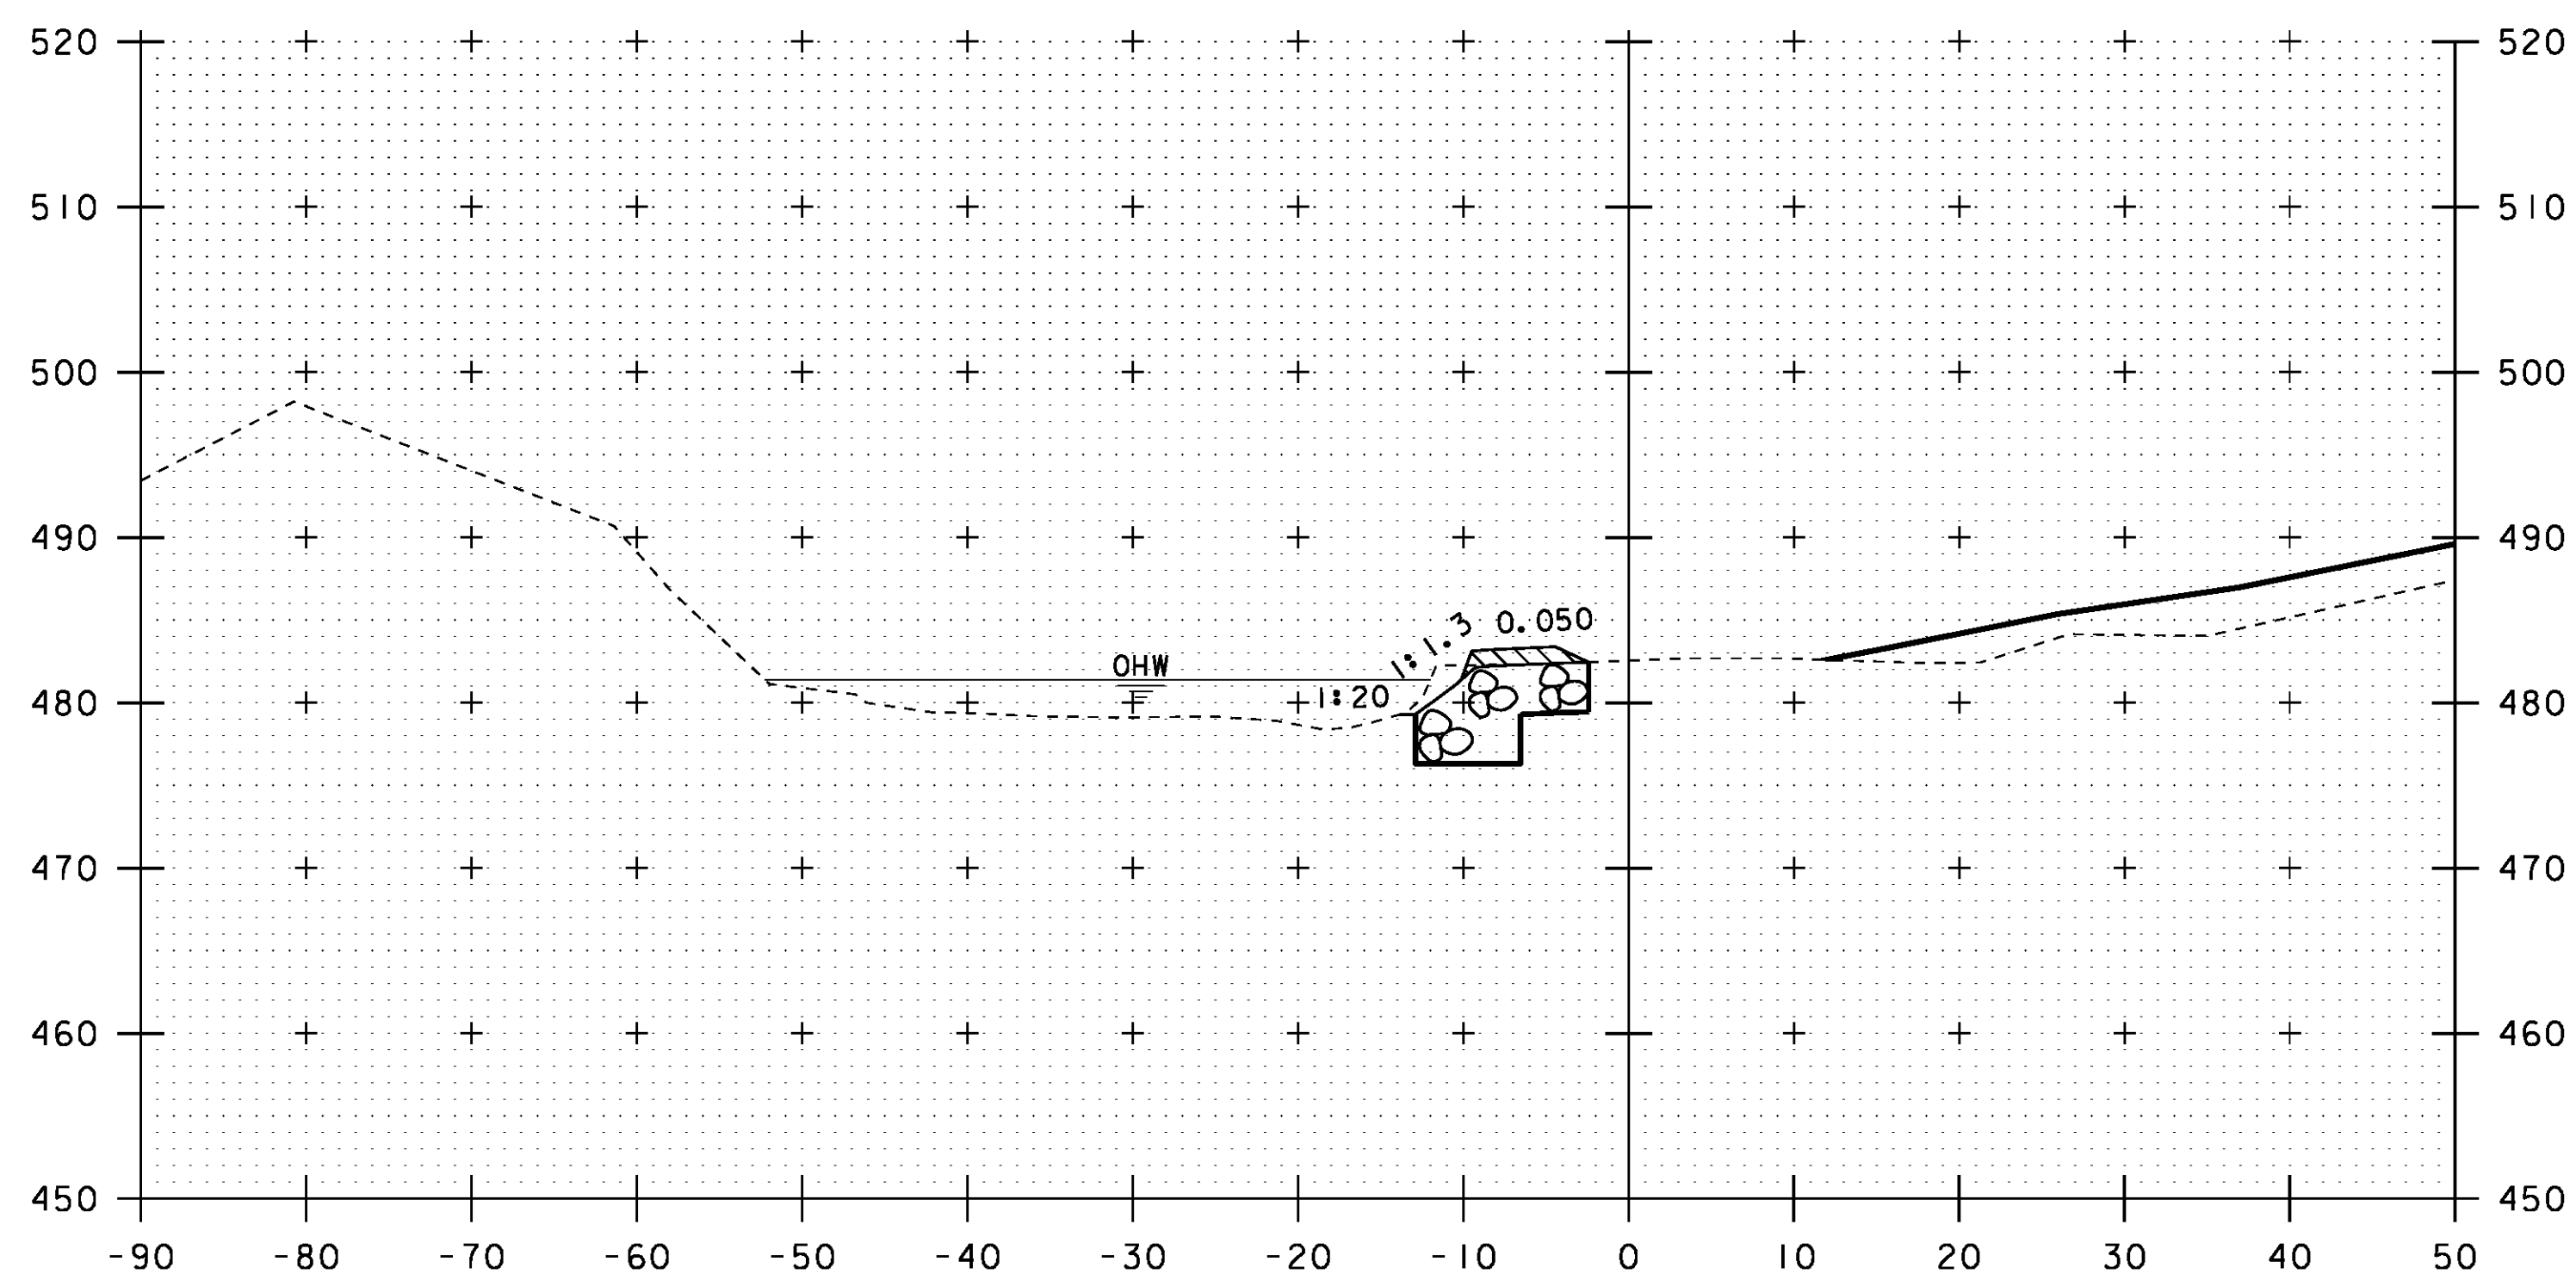

21+20

SCALE: 1" = 10'-0"

STA. 21+20 TO STA. 21+30

PROJECT NAME: JOHNSON  
 PROJECT NUMBER: BRF 030-2(26)

FILE NAME: s88bl93xsl.dgn  
 PROJECT LEADER: C. CARLSON  
 DESIGNED BY: H. SALLS  
 CHANNEL CROSS SECTIONS (4)

PLOT DATE: 10-JUN-2014  
 DRAWN BY: G. ROY  
 CHECKED BY: H. SALLS  
 SHEET 56 OF 69

## EPSC PLAN NARRATIVE

### 1.1 PROJECT DESCRIPTION

JOHNSON BR 030-2(26) INVOLVES THE REPLACEMENT OF BRIDGE 32 CARRYING VT 15 OVER THE SMITH BROOK IN JOHNSON, VT. THE BRIDGE WILL BE REPLACED ON THE EXISTING ALIGNMENT WITH MINIMAL WIDENING AND APPROACH WORK NECESSARY TO MATCH IN TO THE EXISTING ROADWAY. TWO-WAY TRAFFIC WILL BE MAINTAINED DURING CONSTRUCTION ON A TEMPORARY BRIDGE TO BE CONSTRUCTED NORTH (DOWNSTREAM) OF THE EXISTING BRIDGE.

NOTE: AREA OF DISTURBANCE INCLUDES LIMITS OF EARTH DISTURBANCE WITHIN THE PROJECT AREA, AS WELL AS WASTE, BORROW AND STAGING AREAS, AND OTHER EARTH DISTURBING ACTIVITIES WITHIN OR DIRECTLY ADJACENT TO THE PROJECT LIMITS AS SHOWN ON THE ATTACHED EPSC PLAN.

TOTAL AREA OF DISTURBANCE AS SHOWN ON THE ATTACHED EPSC PLAN IS APPROXIMATELY 1.33 ACRES.

IT IS ANTICIPATED THAT THIS PROJECT WILL OCCUR DURING TWO CONSTRUCTION SEASONS.

### 1.2 SITE INVENTORY

#### 1.2.1 TOPOGRAPHY

THE TOPOGRAPHY OF THE AREA IS A SADDLE THAT IS MOSTLY WELL ESTABLISHED FOREST WITH OCCASIONAL OPEN AREAS. VT ROUTE 15, SWEETSER RD (TH 71), AND WEST SETTLEMENT RD (TH 43) ARE WITHIN THE PROJECT SITE. THERE IS A RESIDENCE ON THE EAST SIDE OF THE PROJECT, AND A FEW HOUSES UP SLOPE TO THE WEST WITH GRASS AND TREE BUFFERS.

#### 1.2.2 DRAINAGE, WATERWAYS, BODIES OF WATER, AND PROXIMITY TO NATURAL OR MAN-MADE WATER FEATURES

SMITH BROOK IS THE ONLY WATER SOURCE ON THE PROJECT SITE. AN ASSOCIATED CLASS III WETLAND IS LOCATED SOUTHWEST OF THE BRIDGE.

DRAINAGE DITCHES ARE LOCATED ON THE NORTHWEST AND SOUTHEAST SIDES OF VT ROUTE 15 IN THE PROJECT AREA. A 12-INCH AND A 15-INCH CGMP CARRY SURFACE WATER FROM THESE DRAINAGE DITCHES UNDER TH 71 AND TH 43, RESPECTIVELY, TO THE SMITH BROOK. THESE CULVERTS WILL BE REPLACED AS PART OF THIS PROJECT. DUE TO THE NATURE OF THE SURROUNDING TERRAIN, THE PROJECT SITE COULD RECEIVE RUNOFF WATER FROM A FEW NEARBY SLOPES.

#### 1.2.3 VEGETATION

THE VEGETATION IN THE PROJECT AREA CONSISTS OF HARDWOOD TREES AND UNDERGROWTH. THE IMPACT TO VEGETATION WILL BE LIMITED TO THAT WHICH IS DIRECTLY AFFECTED BY REPLACEMENT OF THE EXISTING BRIDGE, THE CONSTRUCTION OF THE TEMPORARY BRIDGE AND THE BANK CUT. UPON PROJECT COMPLETION, THE CHANNEL WILL BE ARMORED WITH STONE FILL TYPE III AS SPECIFIED ON THE PLANS AND THE NORTH WEST BANK WILL BE ARMORED WITH STONE FILL TYPE II. DISTURBED VEGETATION WILL BE REESTABLISHED WITH STANDARD SEED AND MULCH PRACTICES UNLESS OTHERWISE NOTED.

#### 1.2.4 SOILS

ALL SOIL DATA CAME FROM THE U.S. DEPARTMENT OF AGRICULTURE SOIL CONSERVATION SERVICE FOR LAMOILLE COUNTY, VERMONT. SOILS ON THE PROJECT SITE ARE ADAMS LOAMY FINE SAND, 2 TO 8 PERCENT SLOPES AND 25 TO 60 PERCENT SLOPES,  $K_w$  FACTOR = 0.17; AND PODUNK FINE SANDY LOAM,  $K_w$  FACTOR = 0.24.

NOTE: K-VALUES GENERALLY INDICATE THE FOLLOWING:

0.0-0.23 = LOW EROSION POTENTIAL  
0.24-0.36 = MODERATE EROSION POTENTIAL  
0.37 AND HIGHER = HIGH EROSION POTENTIAL

#### 1.2.5 SENSITIVE RESOURCE AREAS

CRITICAL HABITATS: YES, FISH & WILDLIFE  
HISTORICAL OR ARCHAEOLOGICAL AREAS: NO  
PRIME AGRICULTURAL LAND: NO  
THREATENED AND ENDANGERED SPECIES: NO  
WATER RESOURCE: SMITH BROOK  
WETLANDS: YES, CLASS III WETLAND SOUTHWEST OF THE BRIDGE.

### 1.3 RISK EVALUATION

THIS PROJECT FALLS UNDER THE JURISDICTION OF GENERAL PERMIT 3-9020 FOR STORMWATER RUNOFF FROM CONSTRUCTION SITES FOR LOW RISK PROJECTS. ANY MODIFICATIONS TO THE PROJECT THAT INCREASE THE RISK TO ENVIRONMENTAL RESOURCES SHALL BE EVALUATED IN ACCORDANCE WITH THE PERMIT REQUIREMENTS. THE CONTRACTOR WILL BE RESPONSIBLE FOR ANY ADDITIONAL PERMITTING.

### 1.4 EROSION PREVENTION AND SEDIMENT CONTROL

THE EROSION CONTROL PLANS ARE MEANT AS A GUIDELINE FOR PREVENTING EROSION AND CONTROLLING SEDIMENT TRANSPORT. THE PRINCIPLES OUTLINED IN THIS NARRATIVE CONSIST OF APPLYING MEASURES THROUGHOUT CONSTRUCTION OF THE PROJECT IN ORDER TO MINIMIZE SEDIMENT TRANSPORT TO THE RECEIVING WATERS. THE MEASURES INCLUDE STABILIZATION AND STRUCTURAL PRACTICES, STORM WATER CONTROLS AND OTHER POLLUTION PREVENTION PRACTICES. THEY HAVE BEEN PROPOSED BY THE DESIGNER AS A BASIS FOR PROTECTING RESOURCES AND WILL NEED TO BE BUILT UPON BASED ON THE SPECIFIC MEANS AND METHODS OF THE CONTRACTOR. REFER TO THE LOW RISK SITE HANDBOOK AND APPROPRIATE DETAIL SHEETS FOR SPECIFIC GUIDANCE AND CONSTRUCTION DETAILING.

ALL MEASURES SHALL BE REGULARLY MAINTAINED AND SHALL BE CHECKED FOR SEDIMENT BUILD-UP. SEDIMENT SHALL BE DISPOSED OF AT AN APPROVED SITE WHERE IT WILL NOT BE SUBJECT TO EROSION.

#### 1.4.1 MARK SITE BOUNDARIES

SITE BOUNDARIES AND AREAS CONSTRUCTION EQUIPMENT CAN ACCESS SHALL BE DELINEATED.

PROJECT DEMARCATION FENCING (PDF) SHALL BE USED TO PHYSICALLY MARK SITE BOUNDARIES.

#### 1.4.2 LIMIT DISTURBANCE AREA

PREVENTING INITIAL SOIL EROSION BY MINIMIZING THE EXPOSED AREA IS MUCH MORE EFFECTIVE THAN TREATING ERODED SEDIMENT. EARTH DISTURBANCE CAN BE MINIMIZED THROUGH CONSTRUCTION PHASING BY ONLY OPENING UP EARTH AS NECESSARY. THIS CAN LIMIT THE AREA THAT WILL BE DISTURBED AND EXPOSED TO EROSION. EMPLOY TEMPORARY CONSTRUCTION STABILIZATION PRACTICES IN INCREMENTAL STAGES AS PHASES CHANGE. FOR PROJECTS WHICH FALL UNDER THE CONSTRUCTION GENERAL PERMIT, ONLY THE ACREAGE LISTED ON THE PERMIT AUTHORIZATION MAY BE EXPOSED AT ANY GIVEN TIME.

MAINTAINING VEGETATED BUFFERS ALONG STREAM BANKS, WETLANDS OR OTHER SENSITIVE AREAS IS A CRUCIAL EROSION AND SEDIMENT CONTROL MEASURE THAT SHOULD BE ESTABLISHED WHEREVER POSSIBLE.

#### 1.4.3 SITE ENTRANCE/EXIT STABILIZATION

TRACKING OF SEDIMENT ONTO PUBLIC HIGHWAYS SHALL BE MINIMIZED TO REDUCE THE POTENTIAL FOR RUNOFF ENTERING RECEIVING WATERS. INSTALLATION SHALL COINCIDE WITH THE CONTRACTOR'S PROGRESS SCHEDULE.

STABILIZED CONSTRUCTION ENTRANCES SHALL BE INSTALLED AS PROPOSED ON THE EPSC PLAN AND ANYWHERE EQUIPMENT WILL BE GOING FROM AREAS OF EXPOSED SOILS TO PAVED SURFACES.

#### 1.4.4 INSTALL SEDIMENT BARRIERS

SEDIMENT BARRIERS SHALL BE UTILIZED TO INTERCEPT RUNOFF AND ALLOW SUSPENDED SEDIMENT TO SETTLE OUT. THEY SHALL BE INSTALLED PRIOR TO ANY UP SLOPE WORK.

SILT FENCE AND PIPE INLET PROTECTION WILL BE INSTALLED AS PROPOSED ON THE EPSC PLAN.

FILTER CURTAIN WILL BE INSTALLED AS PROPOSED ON THE EPSC PLAN.

#### 1.4.5 DIVERT UPLAND RUNOFF

DIVERSIONARY MEASURES SHALL BE USED TO INTERCEPT RUNOFF FROM ABOVE THE CONSTRUCTION AND DIRECT IT AROUND THE DISTURBED AREA SO THAT CLEAN WATER DOES NOT BECOME MUDDIED WHILE TRAVELING OVER EXPOSED SOILS ON THE CONSTRUCTION SITE.

THE PROJECT AREA IS RELATIVELY FLAT. THEREFORE IT IS NOT ANTICIPATED THAT DIVERSION MEASURES WILL BE NECESSARY.

#### 1.4.6 SLOW DOWN CHANNELIZED RUNOFF

CHECK STRUCTURES SHALL BE UTILIZED TO REDUCE THE VELOCITY, AND THUS THE EROSION POTENTIAL, OF CONCENTRATED FLOW IN CHANNELS.

STONE CHECK DAMS WILL BE INSTALLED AS PROPOSED ON THE EPSC PLAN.

#### 1.4.7 CONSTRUCT PERMANENT CONTROLS

PERMANENT STORMWATER TREATMENT DEVICES SHALL BE INSTALLED AS SHOWN ON THE PLANS AND IN ACCORDANCE WITH PERMIT CONDITIONS.

NO PERMANENT CONTROLS ON THIS PROJECT.

#### 1.4.8 STABILIZE EXPOSED SOILS DURING CONSTRUCTION

ALL AREAS OF DISTURBANCE MUST HAVE TEMPORARY STABILIZATION IN PLACE WITHIN 48 HOURS OF DISTURBANCE OR IN ACCORDANCE WITH THE CONSTRUCTION GENERAL PERMIT 3-9020 AUTHORIZATION.

SURFACE ROUGHENING OF ALL EXPOSED SLOPES, COMBINED WITH TEMPORARY MULCHING, SHALL BE UTILIZED ON A REGULAR BASIS. BIODEGRADABLE EROSION CONTROL MATTING OR AN EQUIVALENT SHALL BE USED TO STABILIZE ALL SLOPES STEEPER THAN 1:3.

THE FORECAST OF RAINFALL EVENTS SHALL TRIGGER IMMEDIATE PROTECTION OF EXPOSED SOILS.

#### 1.4.9 WINTER STABILIZATION

VARIOUS MEASURES SPECIFIC TO WINTER MAY BE NECESSARY SHOULD THE PROJECT EXTEND INTO WINTER (OCTOBER 15 THROUGH APRIL 15). REFER TO THE LOW RISK SITE HANDBOOK FOR GUIDANCE.

#### 1.4.10 STABILIZE SOIL AT FINAL GRADE

EXPOSED SOIL MUST BE STABILIZED WITHIN 48 HOURS OF REACHING FINAL GRADE.

SEED, MULCH, FERTILIZER AND LIME SHALL BE USED TO ESTABLISH PERMANENT VEGETATION. FOR SLOPES STEEPER THAN 1:3, BIODEGRADABLE EROSION CONTROL MATTING OR AN EQUIVALENT SHALL BE USED INSTEAD OF MULCH.

#### 1.4.11 DE-WATERING ACTIVITIES

DISCHARGE FROM DEWATERING ACTIVITIES THAT FLOWS OFF OF THE CONSTRUCTION SITE MUST NOT CAUSE OR CONTRIBUTE TO A VIOLATION OF THE VERMONT WATER QUALITY STANDARDS.

#### 1.4.12 INSPECT YOUR SITE

INSPECT THE PROJECT SITE BASED ON SPECIAL PROVISION REQUIREMENTS OR CONSTRUCTION GENERAL PERMIT AUTHORIZATION STIPULATIONS.

### 1.5 SEQUENCE AND STAGING

THIS SECTION WILL BE DEVELOPED BY THE CONTRACTOR USING THE GUIDANCE OUTLINED IN THE VTRANS EPSC PLAN CONTRACTOR CHECKLIST.

#### 1.5.1 CONSTRUCTION SEQUENCE

#### 1.5.2 OFF-SITE ACTIVITIES

IN ADDITION TO THE CONTRACTOR CHECKLIST ANY ACTIVITIES OUTSIDE THE CONSTRUCTION LIMITS SHALL FOLLOW SUBSECTIONS 105.25- 105.29 OF THE STANDARD SPECIFICATIONS FOR CONSTRUCTION.

PROJECT NAME: JOHNSON  
PROJECT NUMBER: BR 030-2(26)

FILE NAME: s88bl93eronotes.dgn  
PROJECT LEADER: C. CARLSON  
DESIGNED BY: C. MOONEY  
EPSC NARRATIVE


PLOT DATE: 11-JUL-2014  
DRAWN BY: R. PELLET  
CHECKED BY: H. SALLS  
SHEET 57 OF 69

**N/F  
LEHOULLIER, ALAN J. & PATRICIA TRUSTEES  
OF THE PATRICIA E. LEHOULLIER FAMILY TRUST**

**N/F MANCHESTER**


AdE ADAMS LOAMY FINE SAND  
WITH 25% TO 60% SLOPES  
"K FACTOR" = 0.17

**STATE OF  
VERMONT**

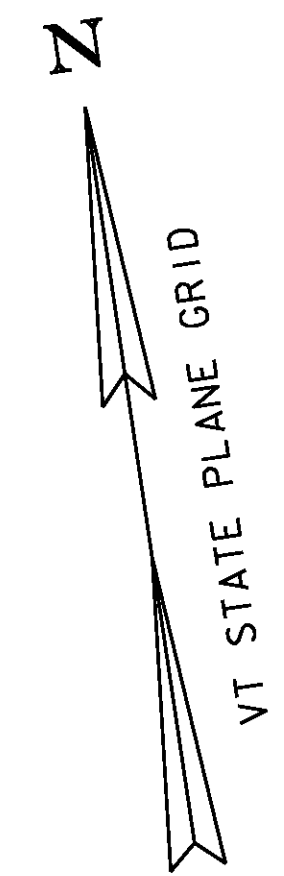

MATCHLINE

STA 92+00.00

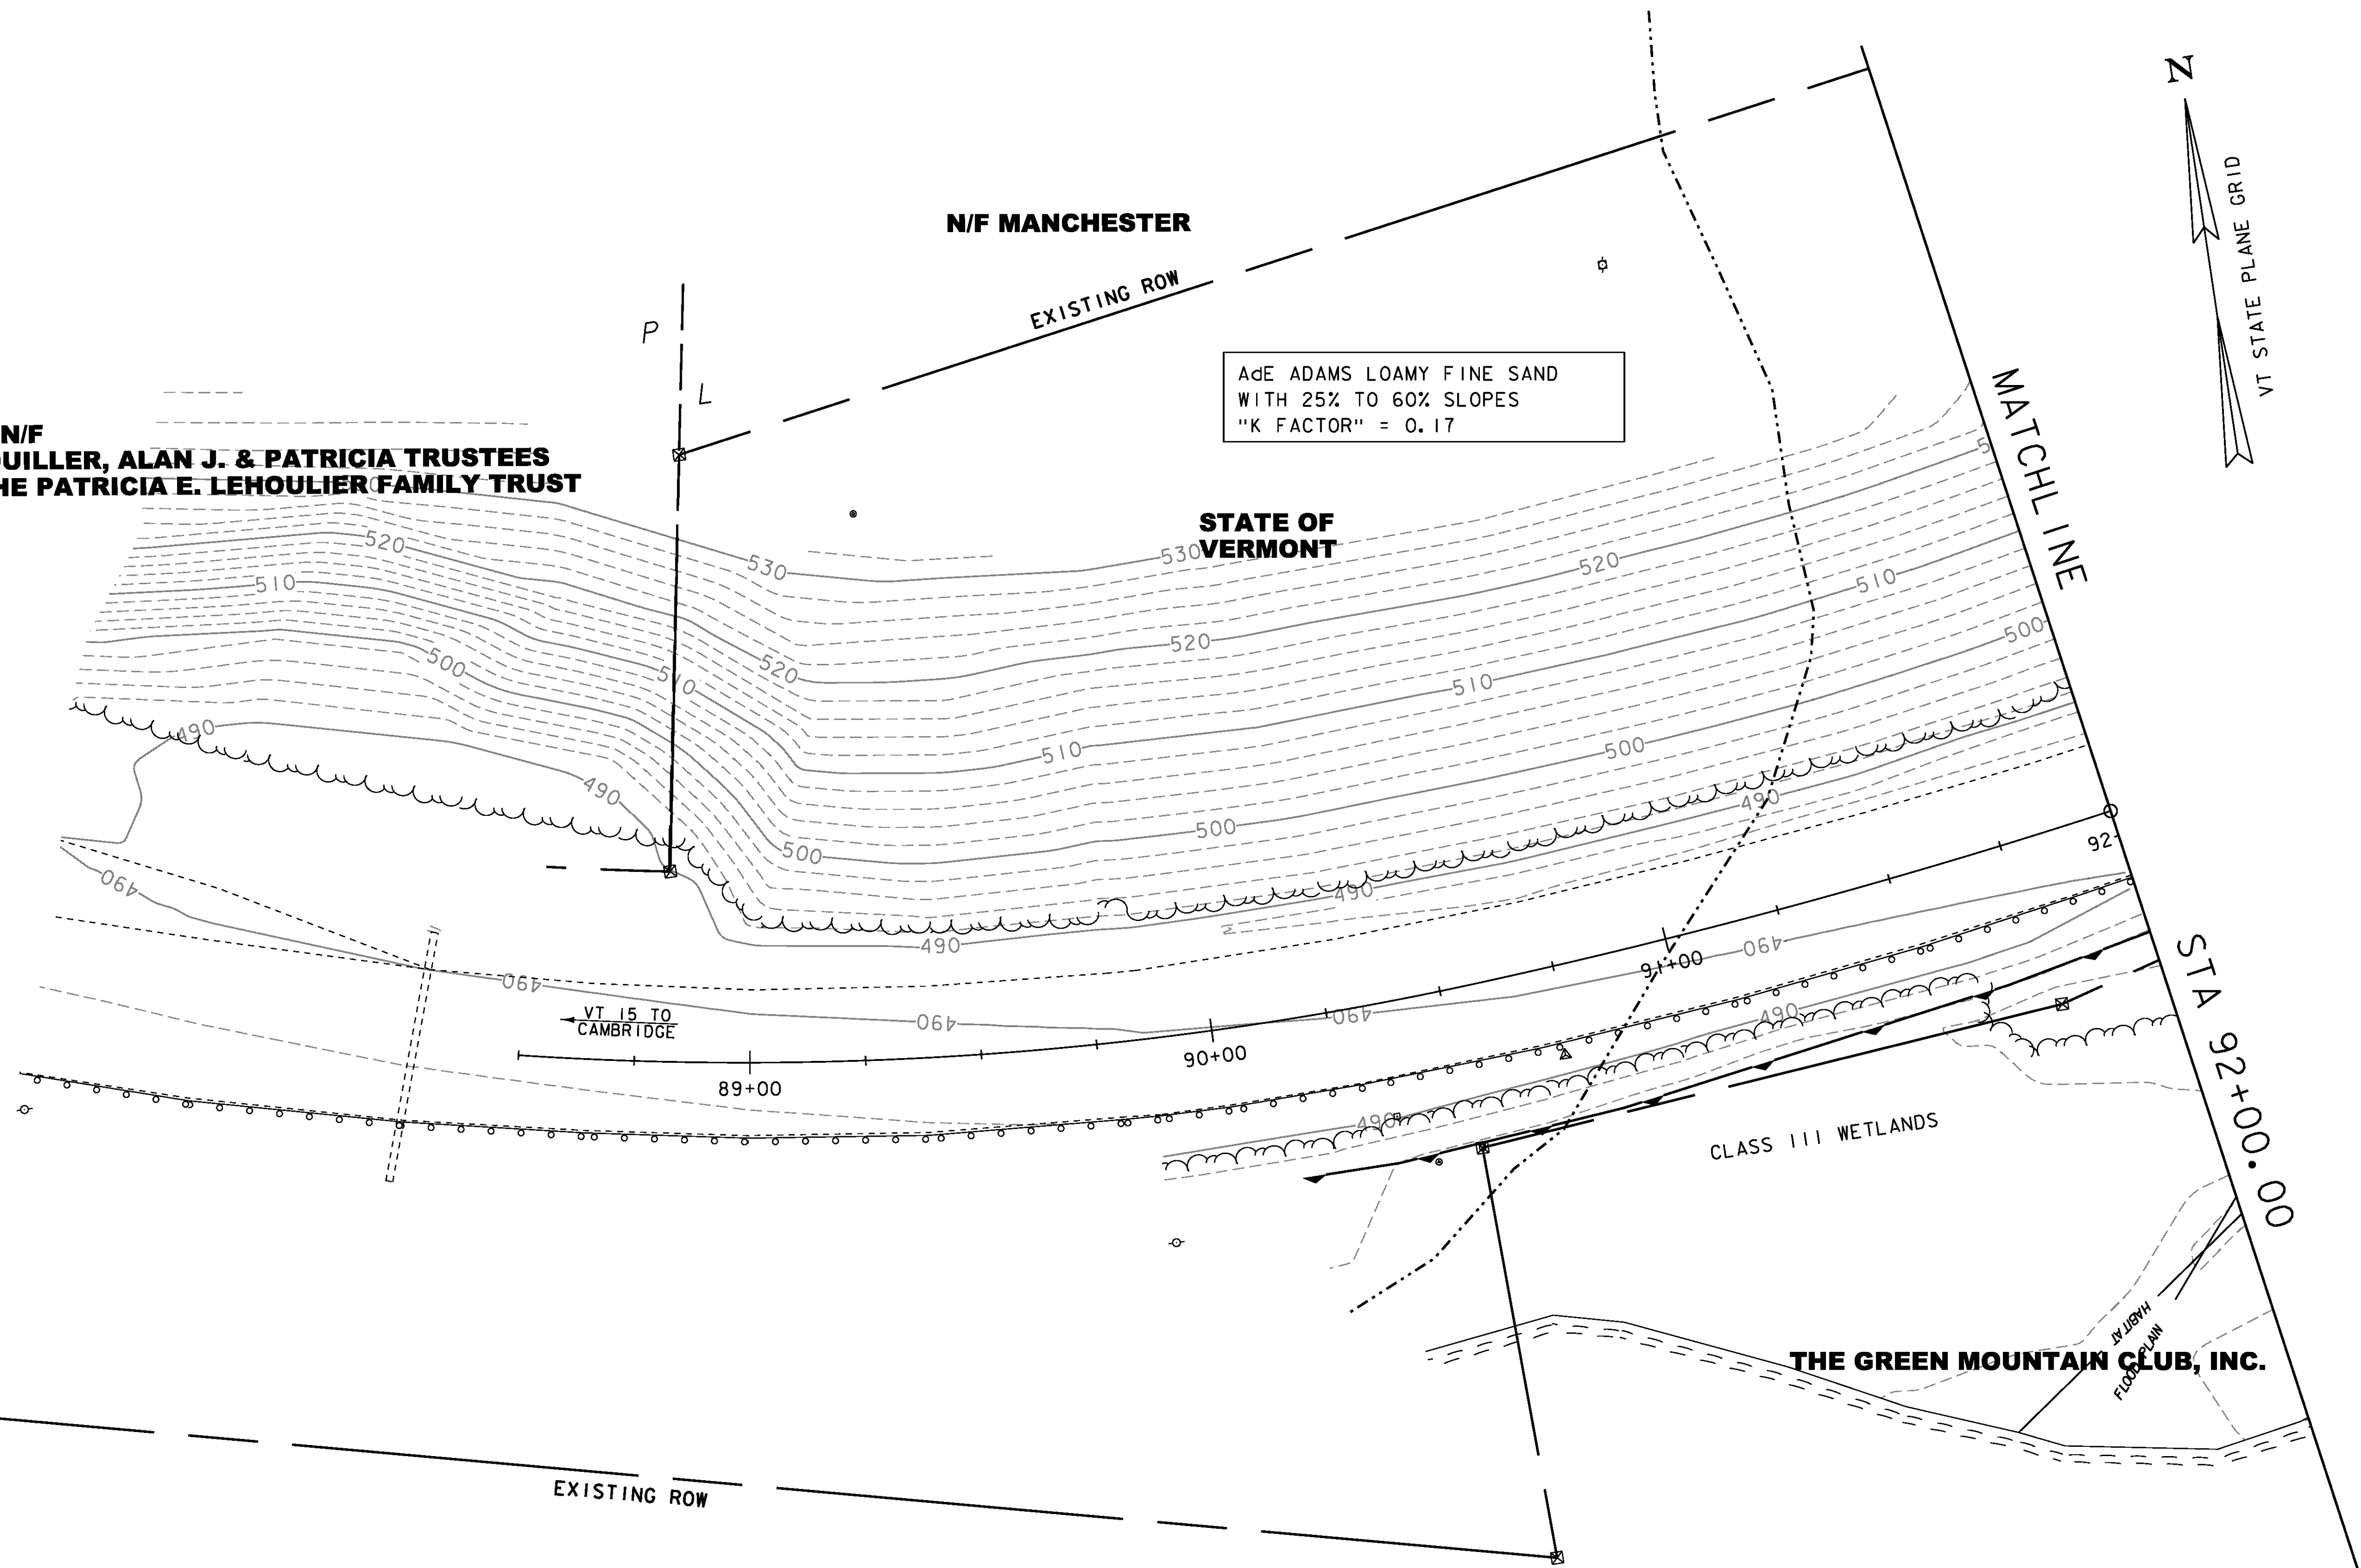


EXISTING ROW

CLASS III WETLANDS

**THE GREEN MOUNTAIN CLUB, INC.**



NOTE: SEE EPSC DETAILS &  
CONVENTIONAL SYMBOLOLOGY-LEGEND

PROJECT NAME: JOHNSON	PLOT DATE: 27-JUN-2014
PROJECT NUMBER: BRF 030-2(26)	DRAWN BY: R. PELLETT
FILE NAME: s88b193eroex.dgn	CHECKED BY: H. SALLS
PROJECT LEADER: C. CARLSON	EPSC EXISTING CONDITIONS (1)
DESIGNED BY: H. SALLS	SHEET 58 OF 69

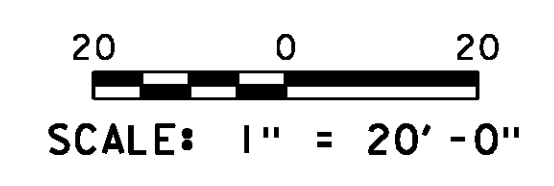

Po PODUNK FINE SANDY LOAM  
 WITH 0% TO 3% SLOPES  
 "K FACTOR" = 0.24

AdB ADAMS LOAMY FINE SAND  
 WITH 2% TO 8% SLOPES  
 "K FACTOR" = 0.17

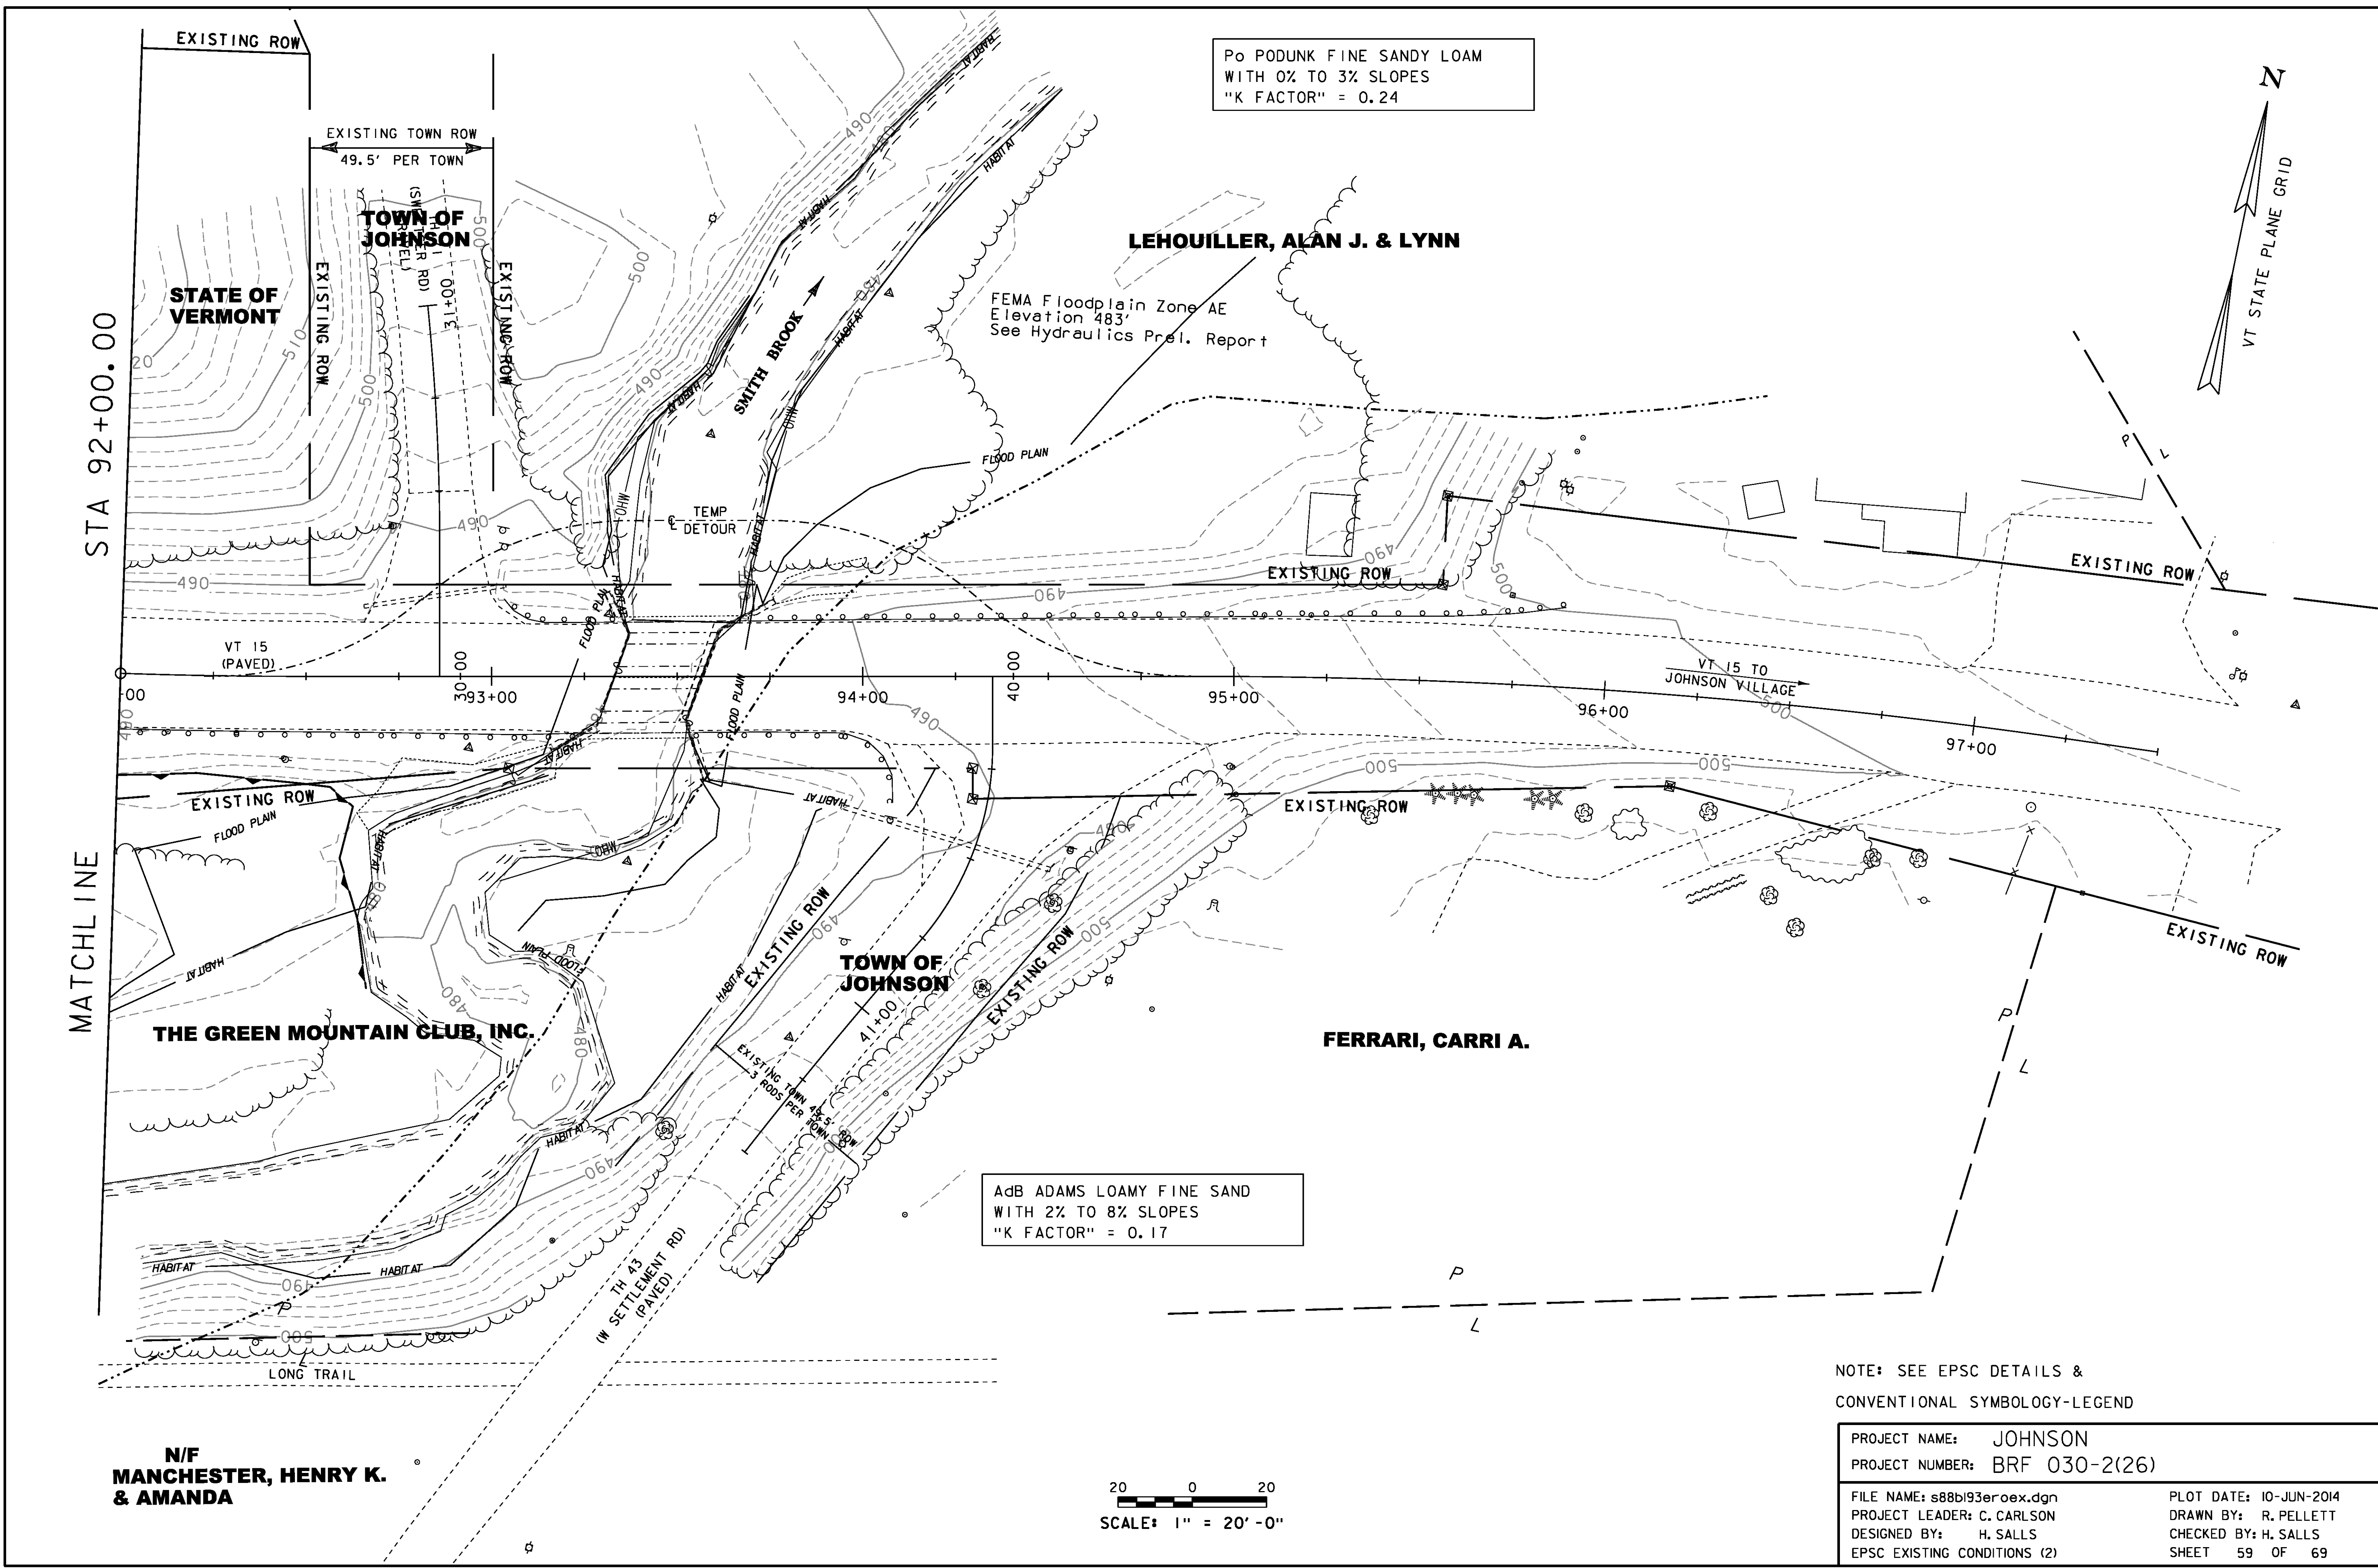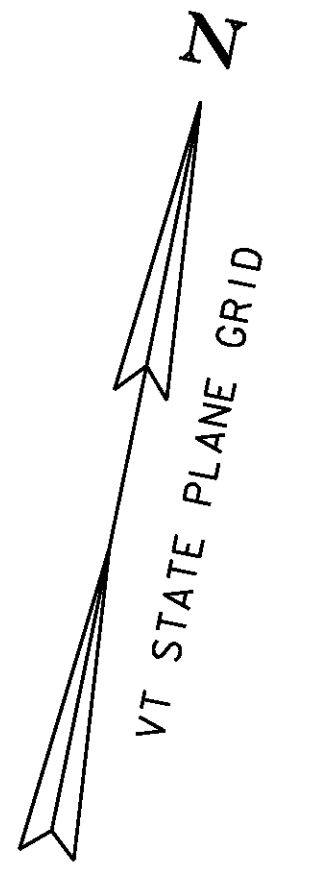


STA 92+00.00




MATCHLINE

NOTE: SEE EPSC DETAILS &  
 CONVENTIONAL SYMBOLOLOGY-LEGEND

PROJECT NAME:	JOHNSON	PLOT DATE:	10-JUN-2014
PROJECT NUMBER:	BRF 030-2(26)	DRAWN BY:	R. PELLETT
FILE NAME:	s88b193eroex.dgn	DESIGNED BY:	H. SALLS
PROJECT LEADER:	C. CARLSON	EPSC EXISTING CONDITIONS (2)	CHECKED BY: H. SALLS
			SHEET 59 OF 69


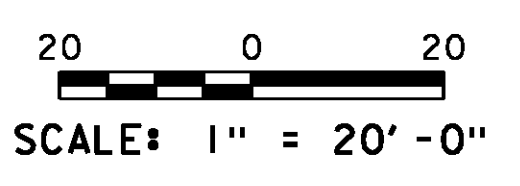


N/F  
**MANCHESTER, HENRY K.  
 & AMANDA**

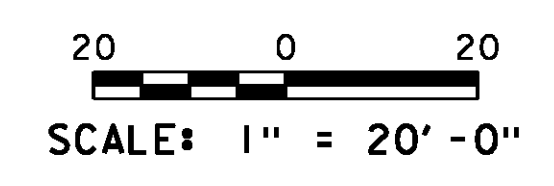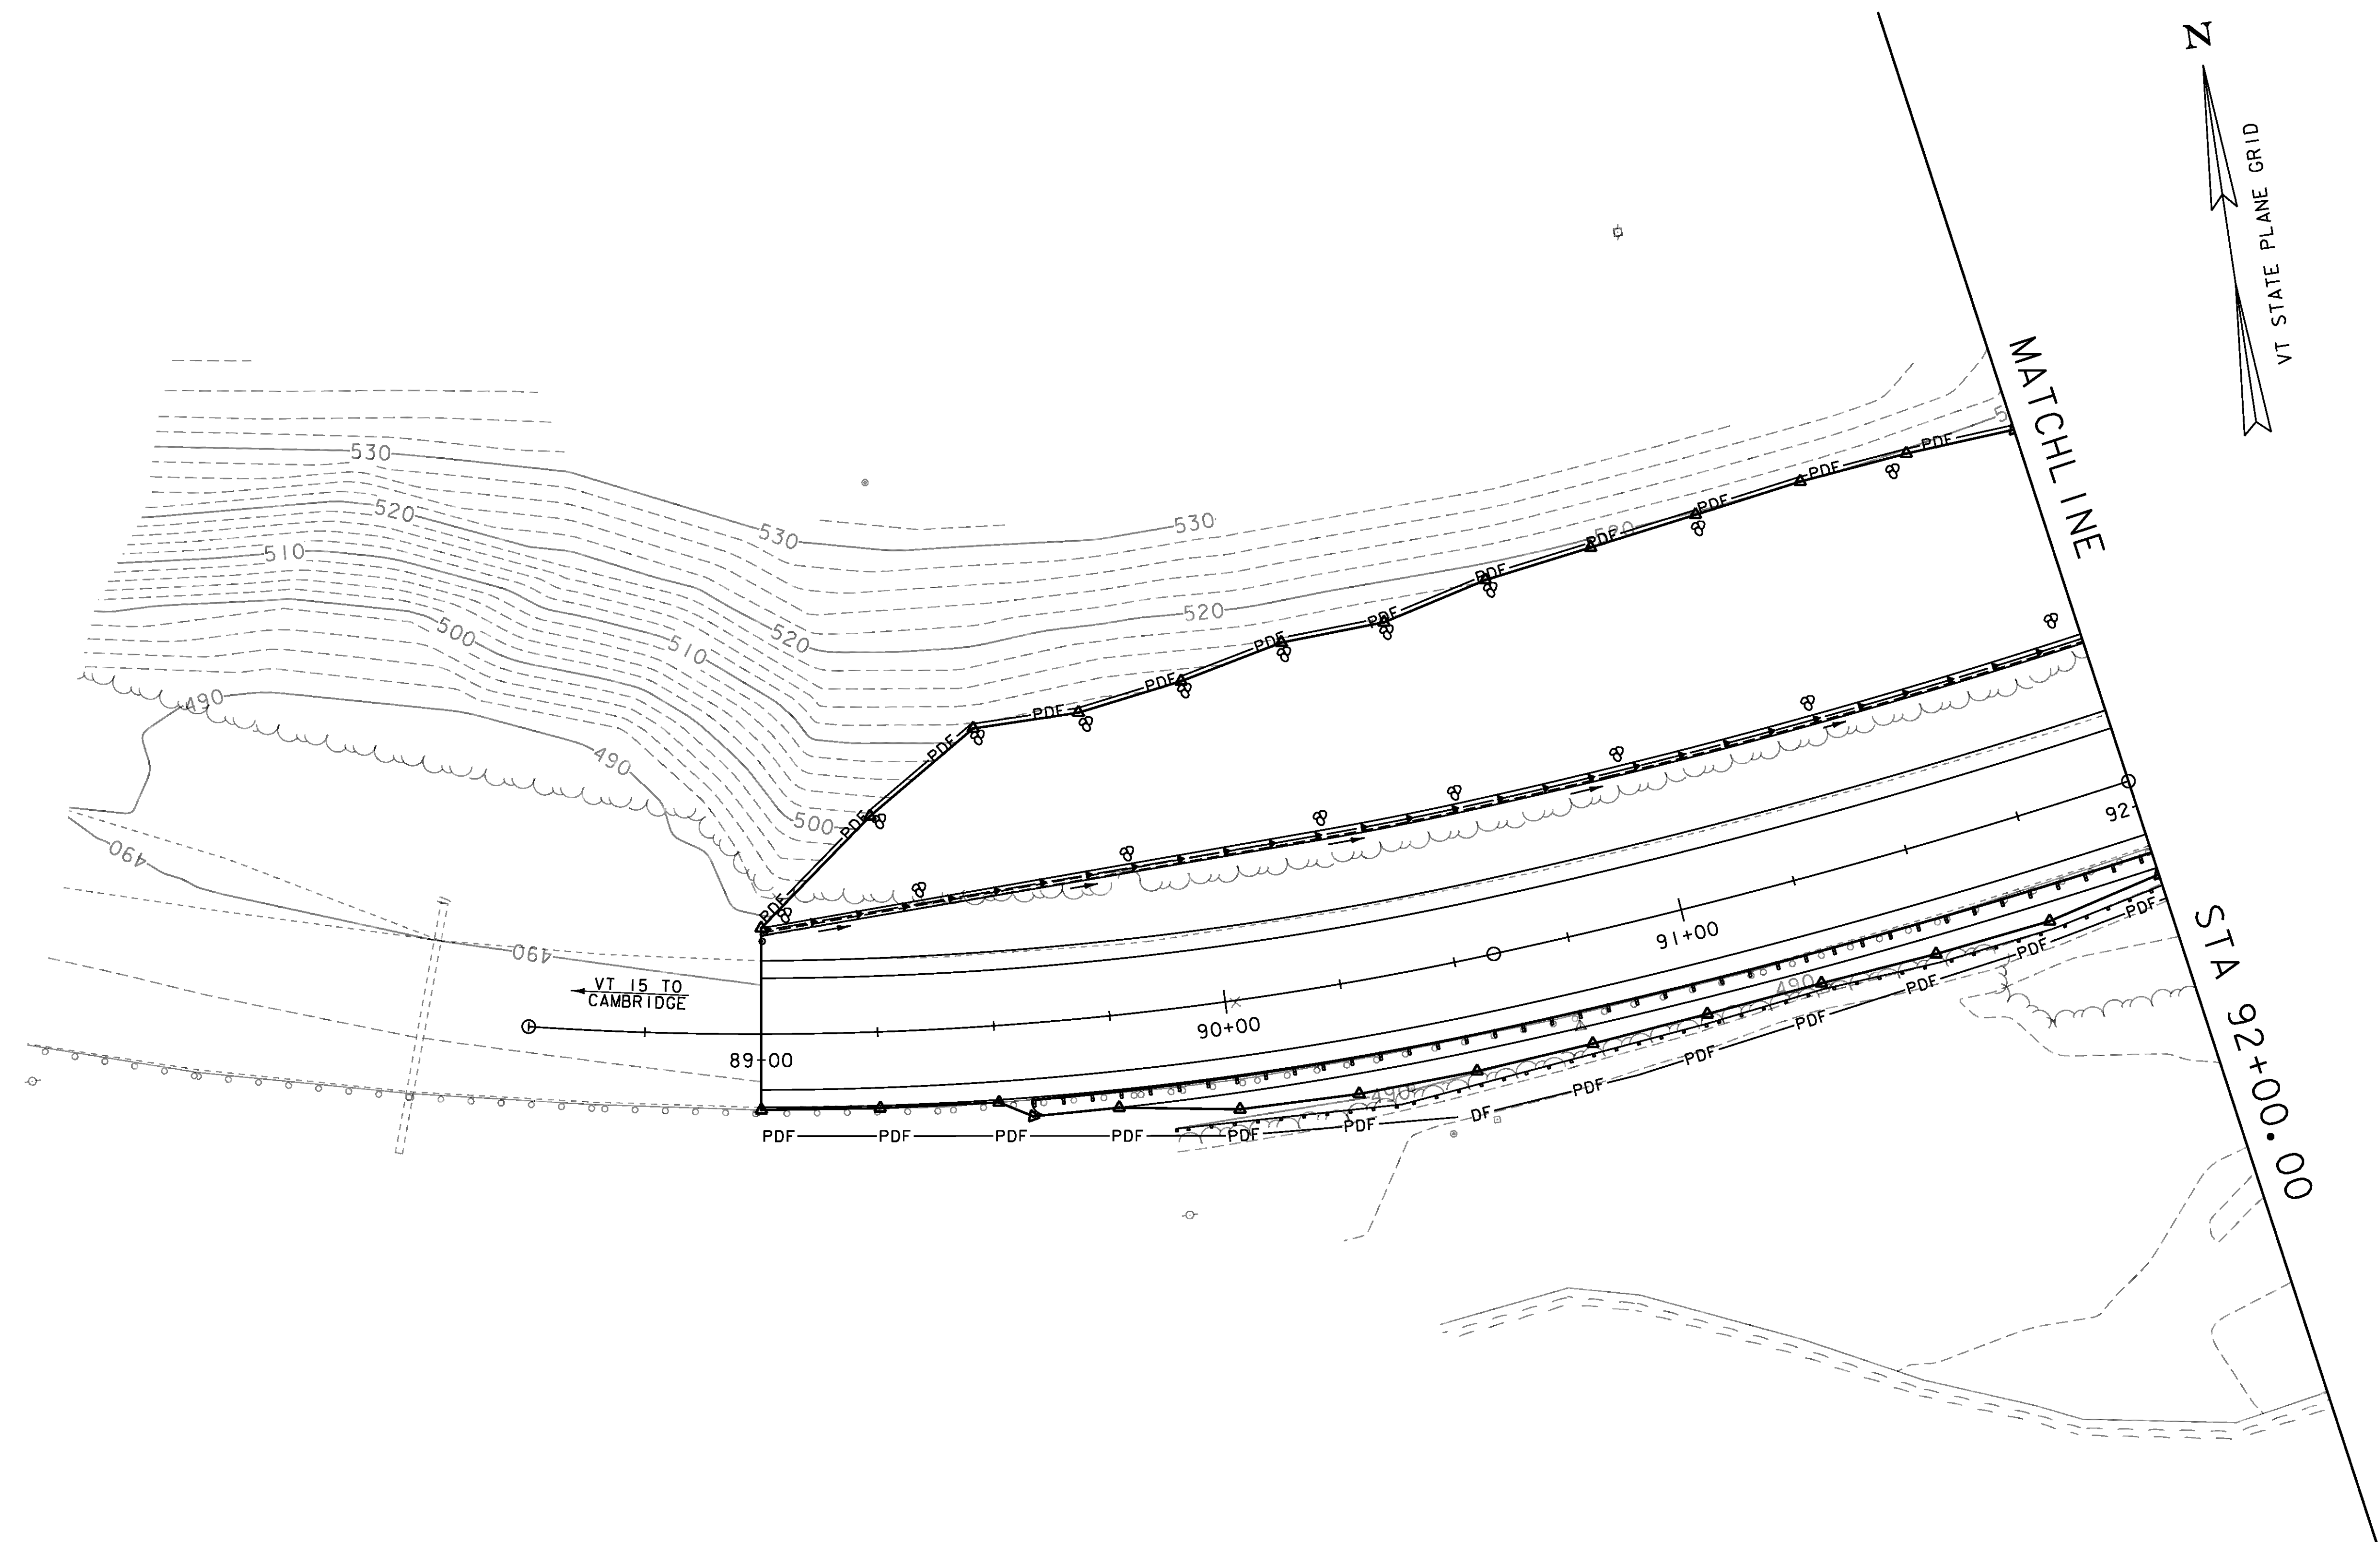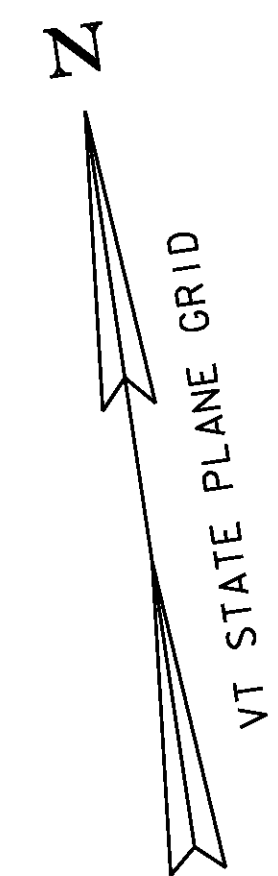

NOTE: SEE EPSC DETAILS &  
CONVENTIONAL SYMBOLOLOGY-LEGEND

PROJECT NAME: JOHNSON	PLOT DATE: 10-JUN-2014
PROJECT NUMBER: BRF 030-2(26)	DRAWN BY: R. PELLETT
FILE NAME: s88b193erodur.dgn	CHECKED BY: H. SALLS
PROJECT LEADER: C. CARLSON	SHEET 60 OF 69
DESIGNED BY: H. SALLS	
EPSC CONSTRUCTION CONDITIONS (1)	

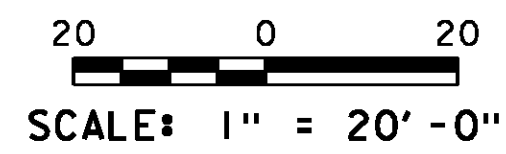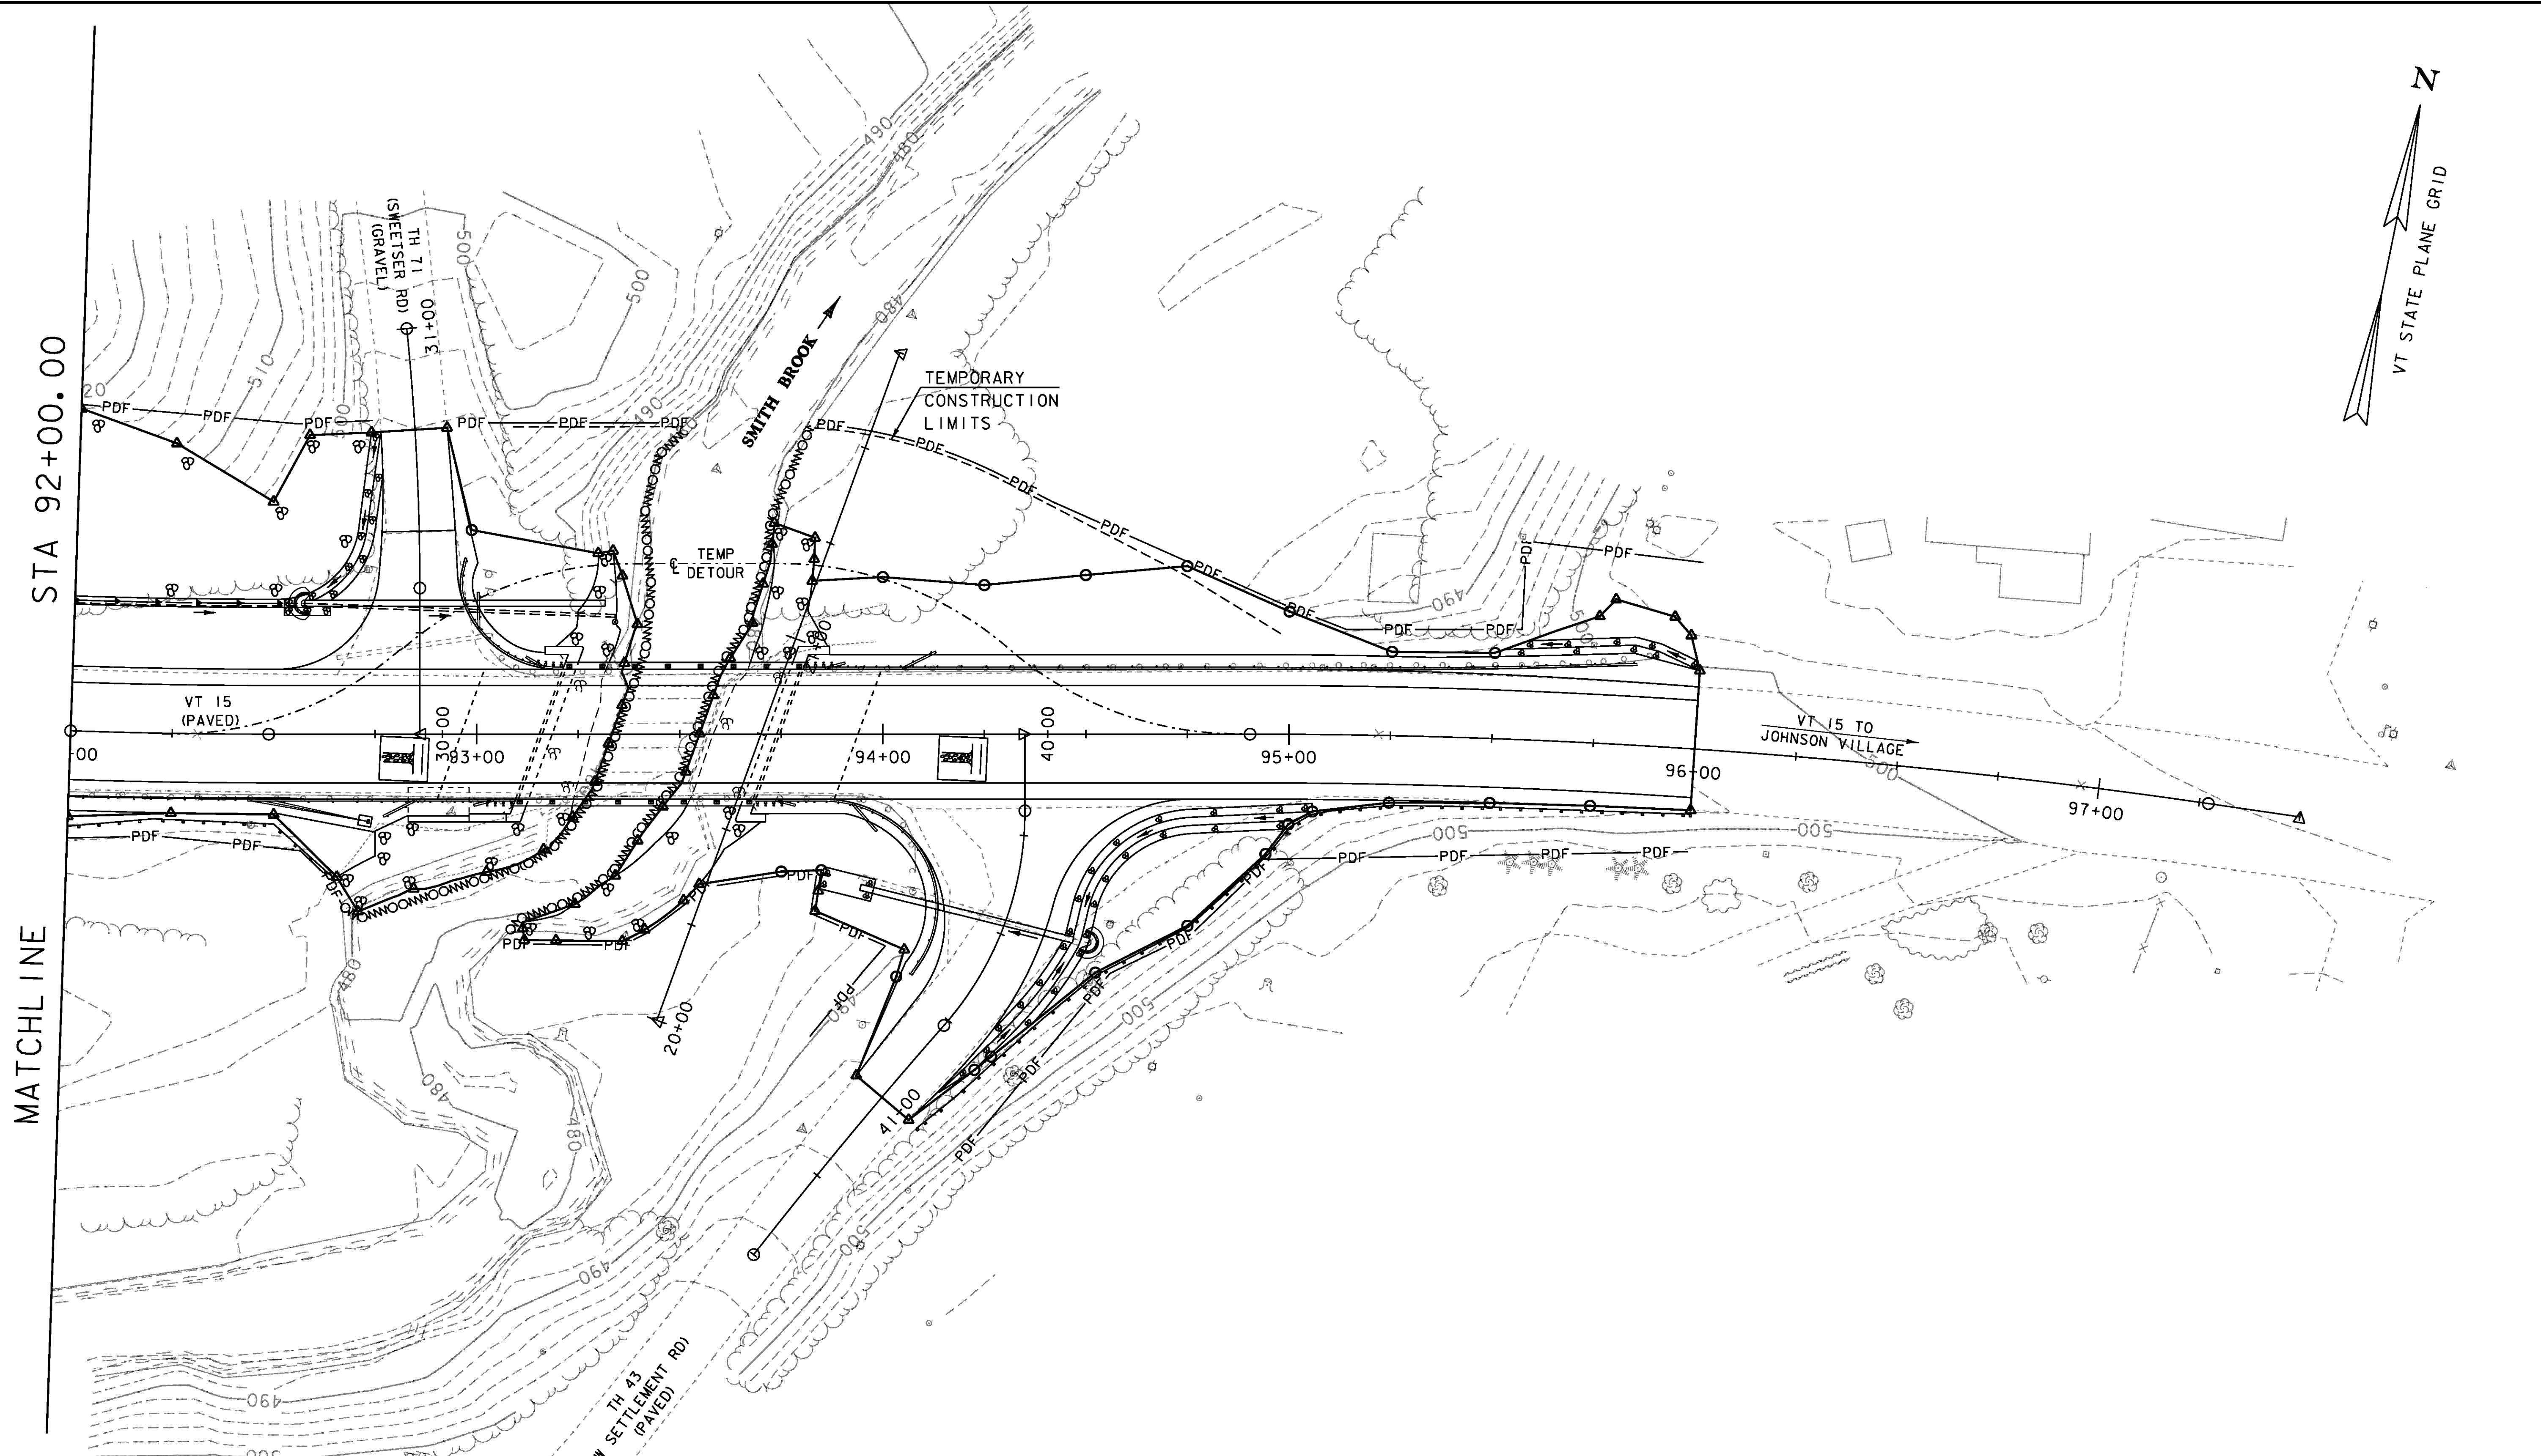


NOTE: SEE EPSC DETAILS &  
CONVENTIONAL SYMBOLGY-LEGEND

PROJECT NAME: JOHNSON  
PROJECT NUMBER: BRF 030-2(26)

FILE NAME: s88bi93erodur.dgn  
PROJECT LEADER: C. CARLSON  
DESIGNED BY: H. SALLS  
EPSC CONSTRUCTION CONDITIONS (2)

PLOT DATE: 10-JUN-2014  
DRAWN BY: R. PELLETT  
CHECKED BY: H. SALLS  
SHEET 61 OF 69

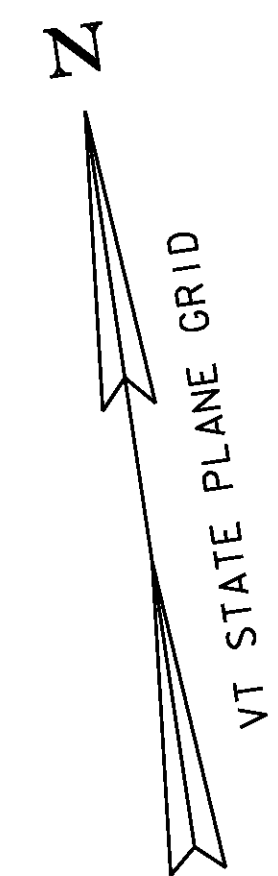


MATCHLINE

STA 92+00.00

ASSUMED  
POLE  
LOCATION


EXISTING ROW

EXISTING ROW

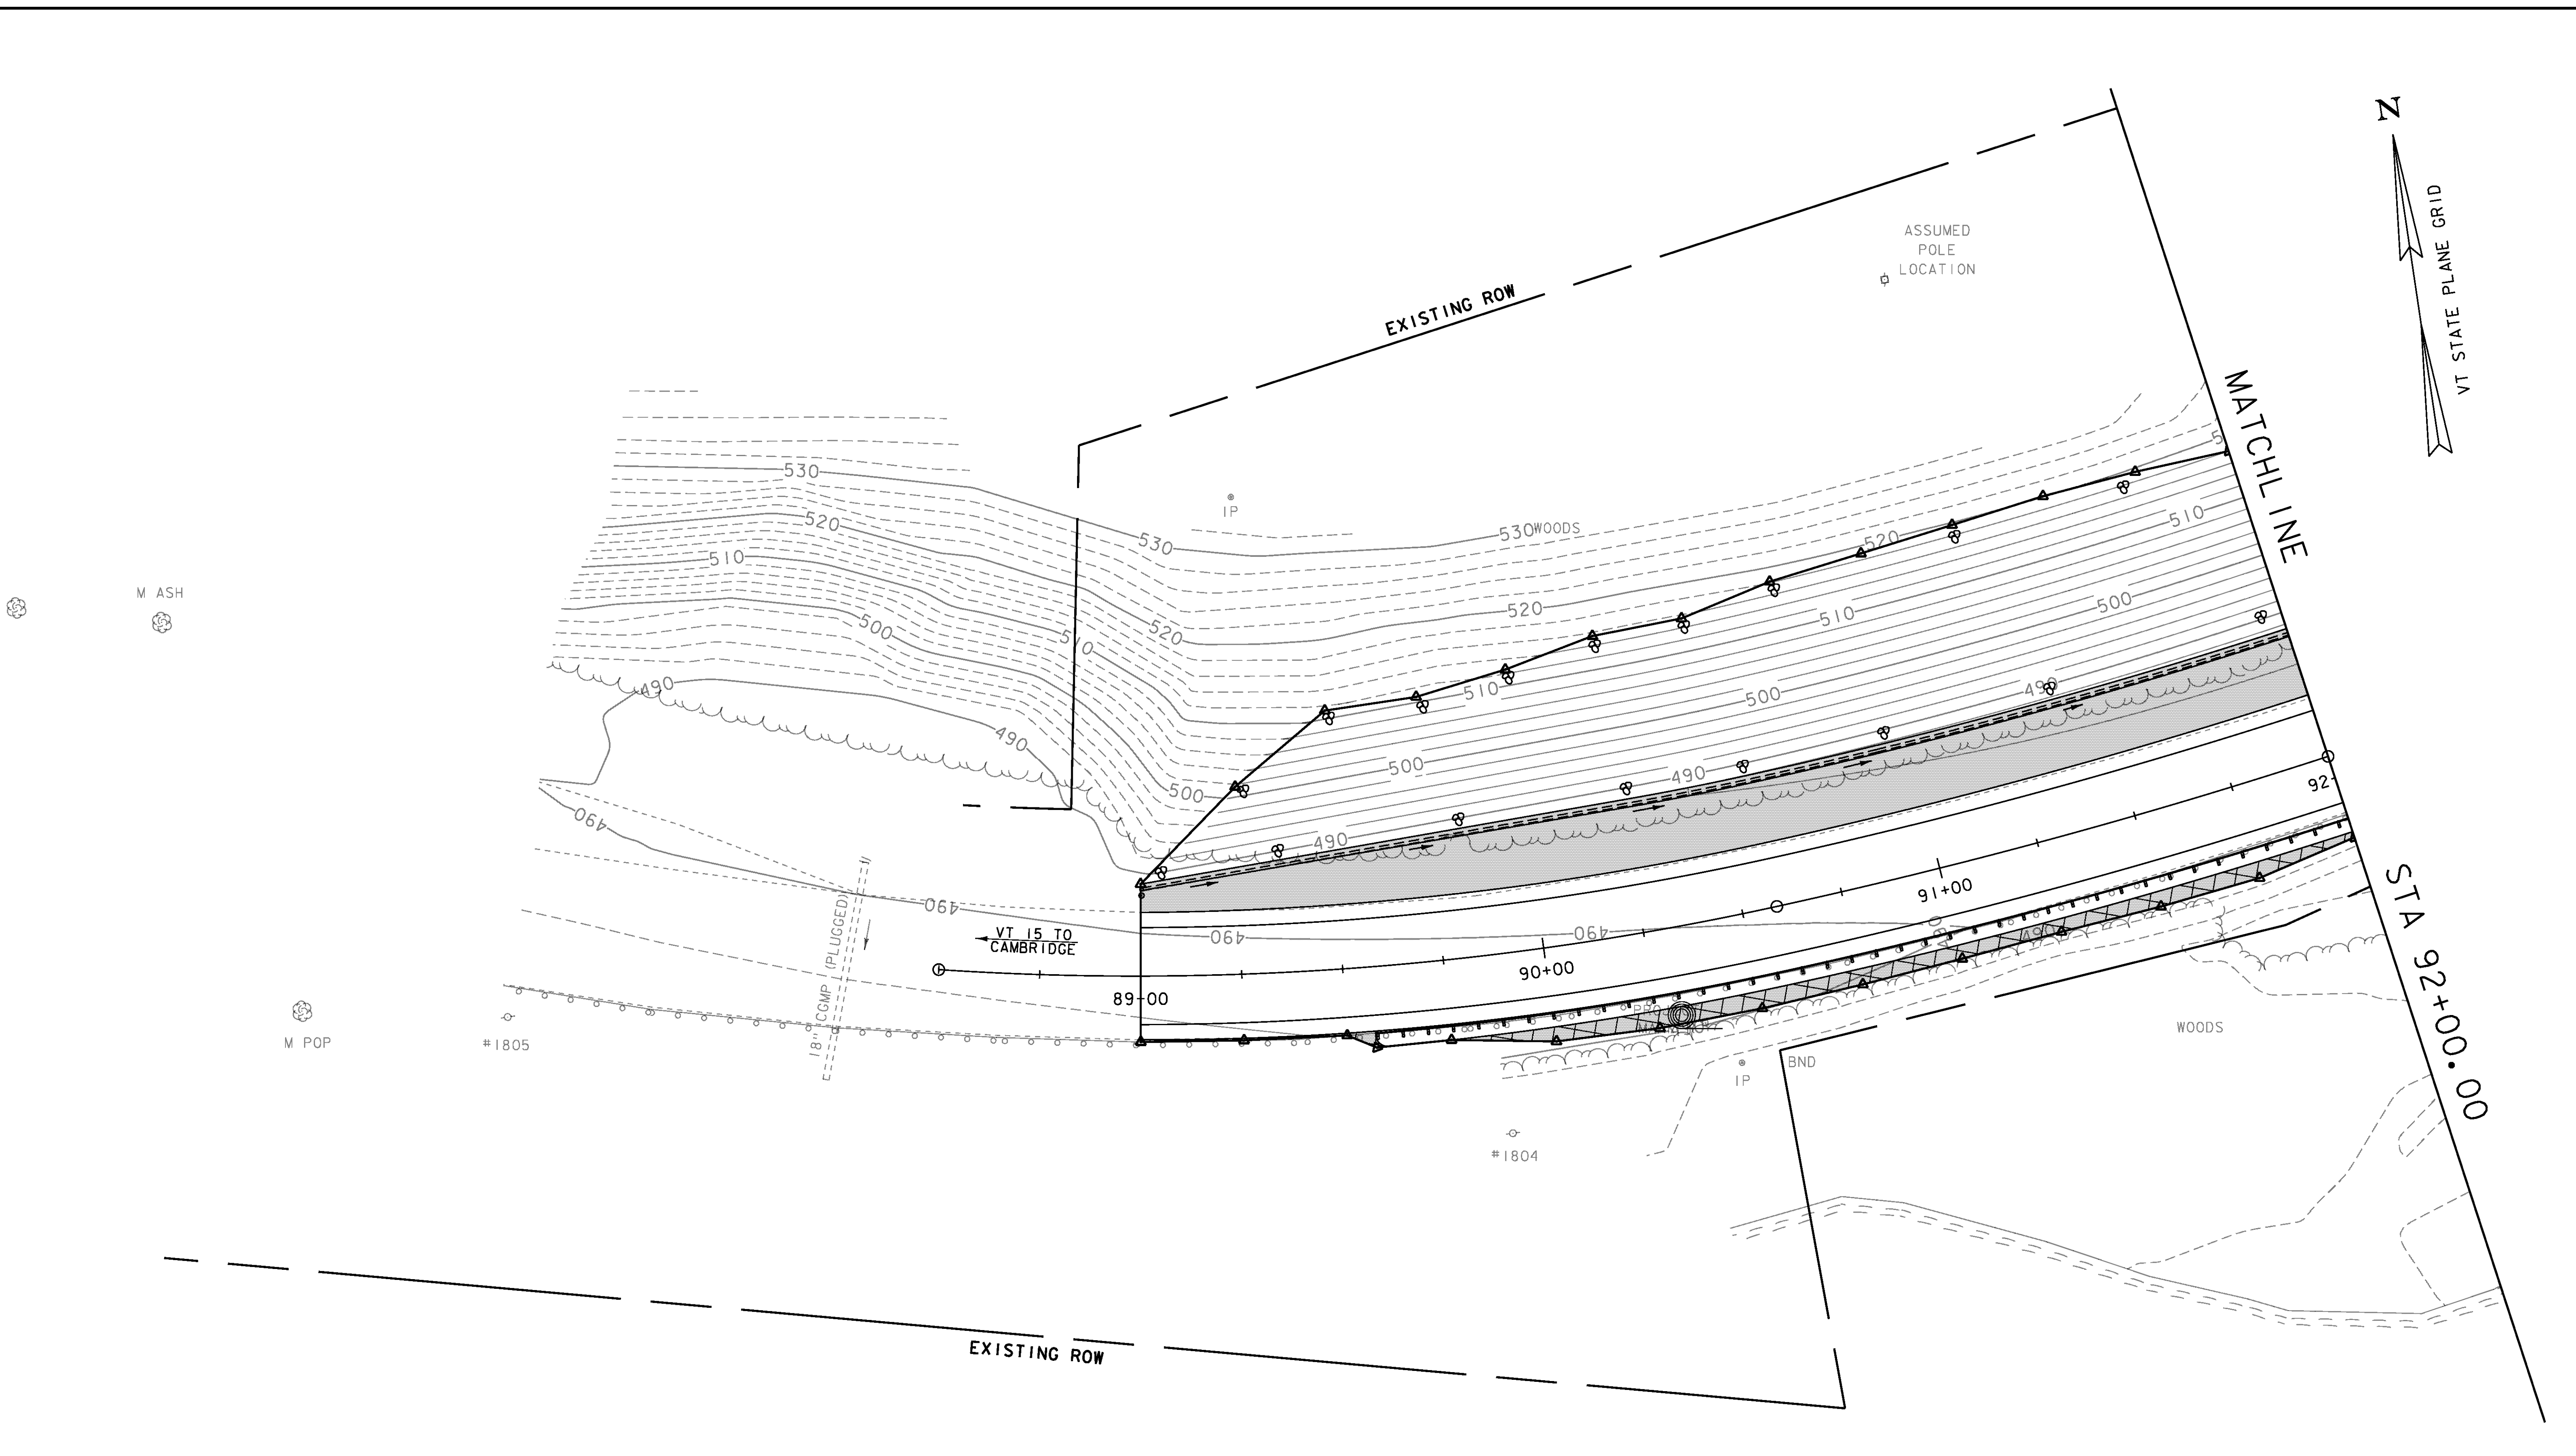

NOTE: SEE EPSC DETAILS &  
CONVENTIONAL SYMBOLOLOGY-LEGEND

PROJECT NAME: JOHNSON	PLOT DATE: 10-JUN-2014
PROJECT NUMBER: BRF 030-2(26)	DRAWN BY: R. PELLETT
FILE NAME: s88b193erofin.dgn	CHECKED BY: H. SALLS
PROJECT LEADER: C. CARLSON	SHEET 62 OF 69
DESIGNED BY: H. SALLS	
EPSC FINAL CONDITIONS (1)	

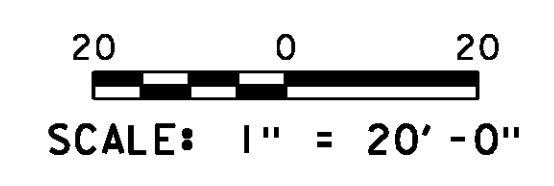

M ASH

M POP

#1805

#1804




WOODS

IP

BND


VT 15 TO  
CAMBRIDGE

18\"/>

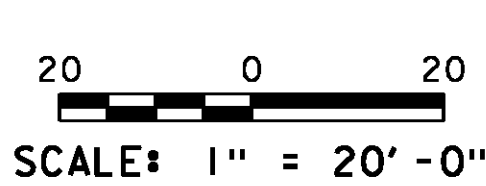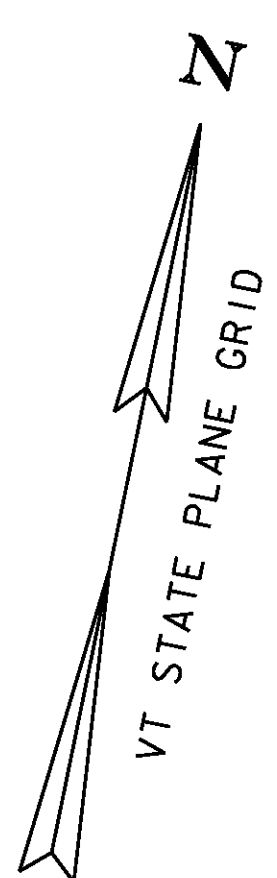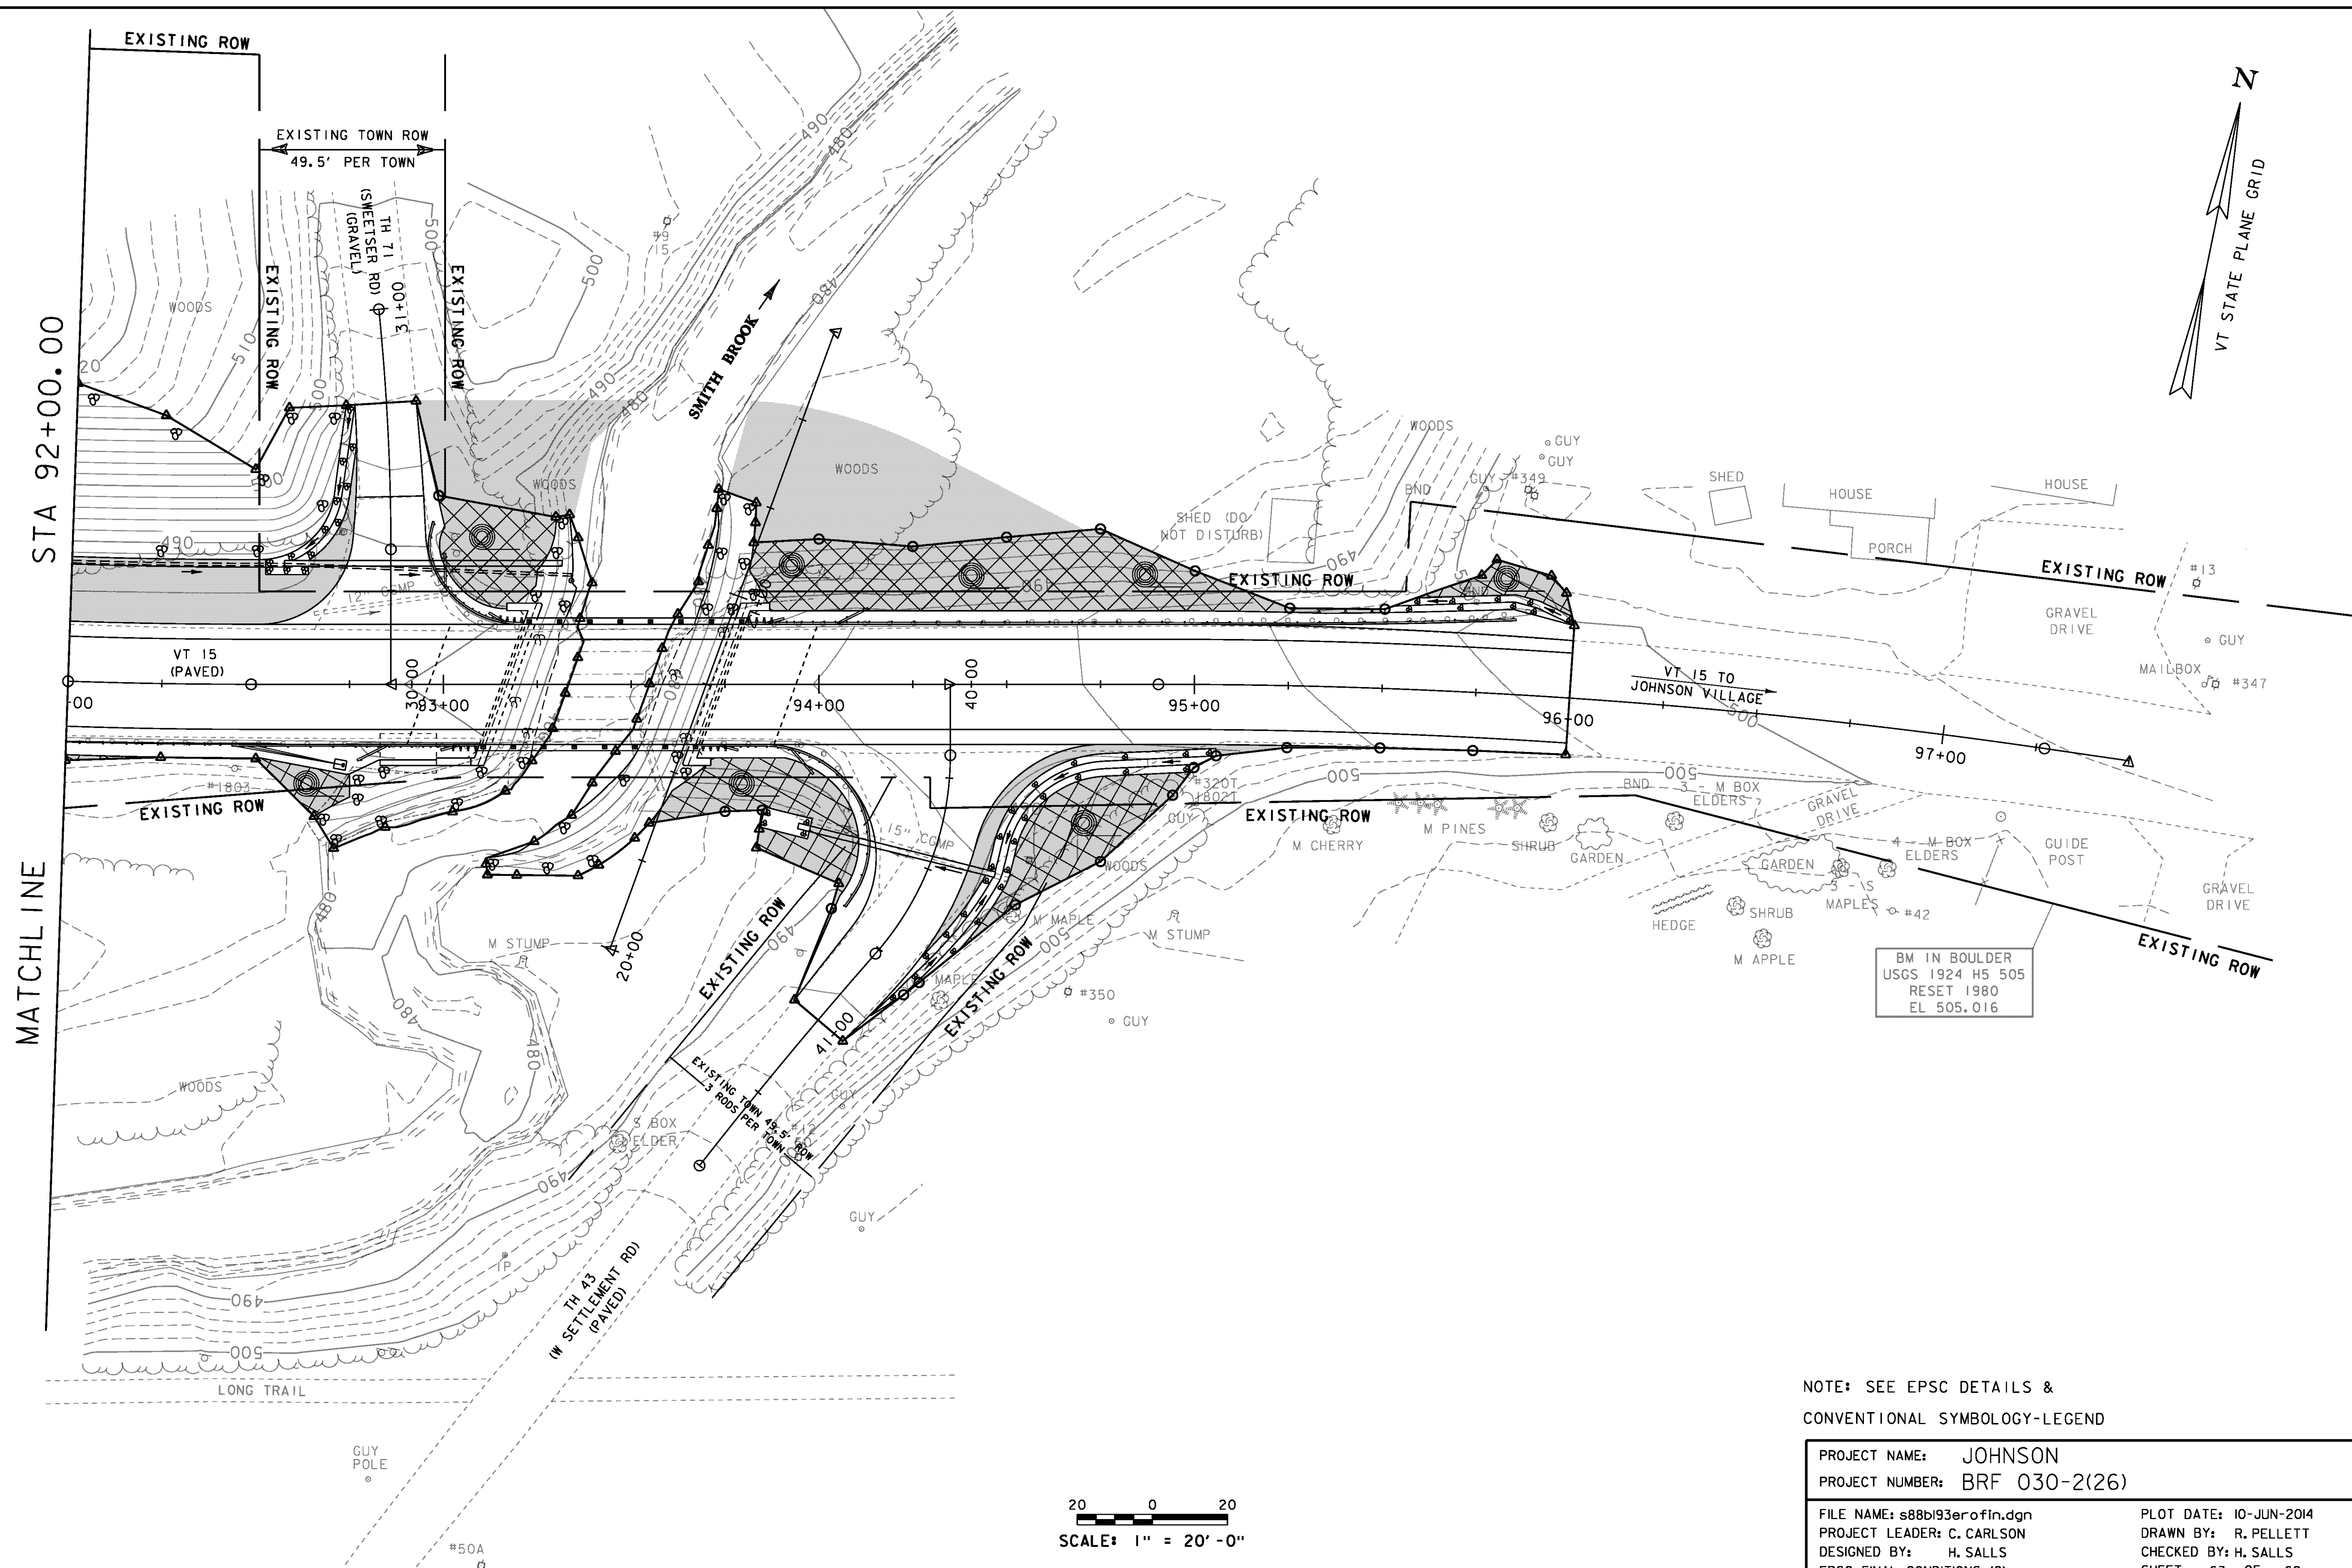

NOTE: SEE EPSC DETAILS &  
CONVENTIONAL SYMBOLOLOGY-LEGEND

PROJECT NAME: JOHNSON	PLOT DATE: 10-JUN-2014
PROJECT NUMBER: BRF 030-2(26)	DRAWN BY: R. PELLETT
FILE NAME: s88b193erofin.dgn	CHECKED BY: H. SALLS
PROJECT LEADER: C. CARLSON	EPSC FINAL CONDITIONS (2)
DESIGNED BY: H. SALLS	SHEET 63 OF 69

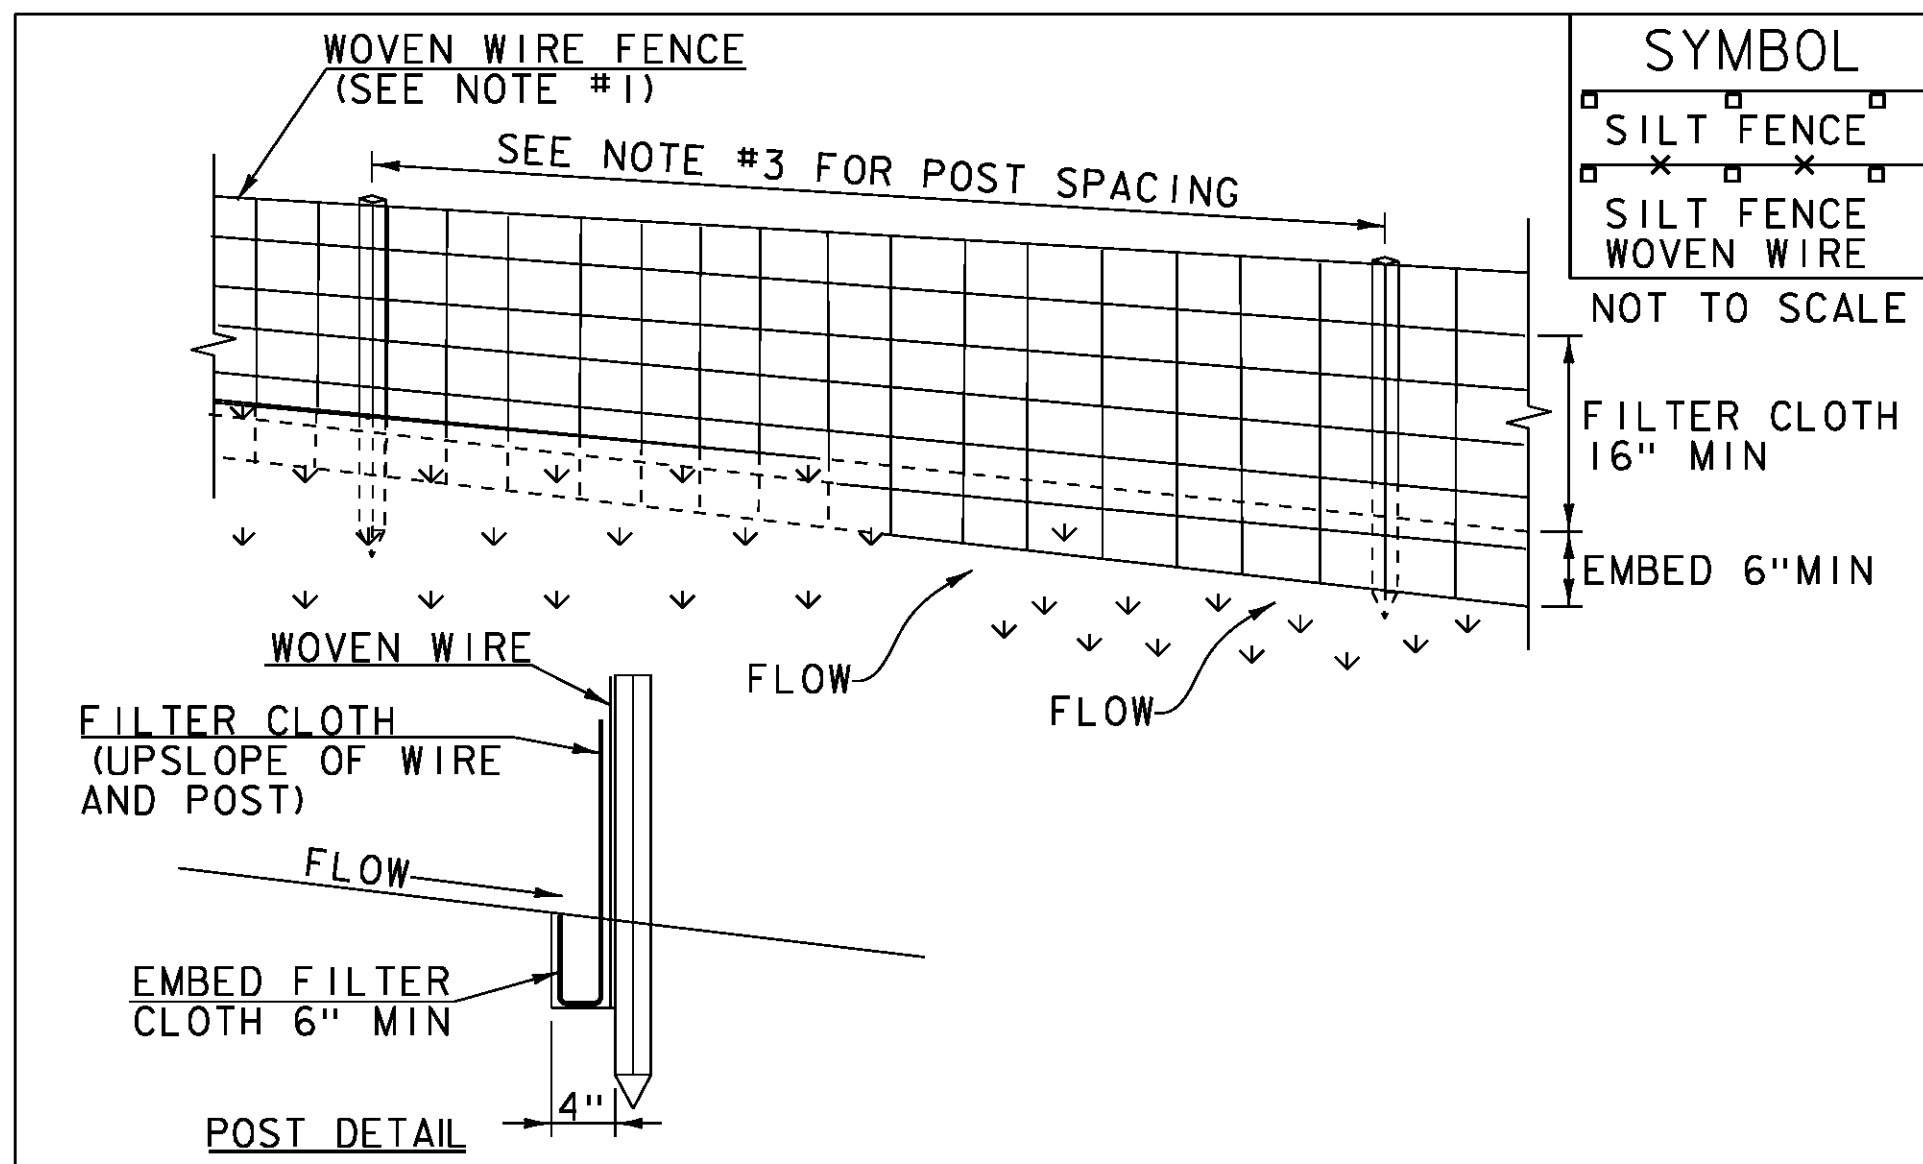

SYMBOL	
[Symbol]	SILT FENCE
[Symbol]	SILT FENCE WOVEN WIRE

**CONSTRUCTION SPECIFICATIONS**

1. WOVEN WIRE REINFORCED FENCE IS REQUIRED WITHIN 100' UPSLOPE OF RECEIVING WATERS WHEN THE PROJECT FALLS UNDER A CONSTRUCTION STORMWATER PERMIT. WOVEN WIRE SHALL BE A MIN. 14 GAUGE WITH A 6" MAX. MESH OPENING.
2. FILTER CLOTH SHALL BE EITHER FILTER X, MIRAF1100X, STABILINKA T140N OR APPROVED EQUIVALENT.
3. POST SPACING FOR WIRE-BACKED FENCE SHALL BE 10' MAXIMUM. FOR FILTER-CLOTH FENCE, WHEN ELONGATION IS >50%, POST SPACING SHALL NOT EXCEED 4' AND WHEN ELONGATION IS <50%, POST SPACING SHALL NOT EXCEED 6'.
4. WOVEN WIRE FENCE IS TO BE FASTENED SECURELY TO FENCE POSTS WITH WIRE TIES. FILTER CLOTH IS TO BE FASTENED SECURELY TO WOVEN WIRE FENCE WITH TIES SPACED EVERY 24" AT TOP AND MID SECTION.
5. WHEN TWO SECTIONS OF FILTER CLOTH ADJOIN EACH OTHER THEY SHALL BE OVER-LAPPED BY 6" AND FOLDED.
6. MAINTENANCE SHALL BE PERFORMED AS NEEDED AND MATERIAL REMOVED WHEN SEDIMENT REACHES HALF OF FABRIC HEIGHT.


ADAPTED FROM DETAILS PROVIDED BY: NEW YORK STATE DEC  
 ORIGINALLY DEVELOPED BY USDA-NRCS  
 VERMONT DEPARTMENT OF ENVIRONMENTAL CONSERVATION

**SILT FENCE**

NOTES:  
 REFER TO "THE VERMONT STANDARDS & SPECIFICATIONS FOR EROSION PREVENTION & SEDIMENT CONTROL -2006-" FROM THE VT AGENCY OF NATURAL RESOURCES FOR ADDITIONAL GUIDANCE.

REVISIONS	
MARCH 21, 2008	WHF
DECEMBER 11, 2008	WHF
JANUARY 13, 2009	WHF

THIS WORK SHALL BE PERFORMED IN ACCORDANCE WITH SECTION 649 AND AS SHOWN IN THE PLANS FOR GEOTEXTILE FOR SILT FENCE (PAY ITEM 649.5) OR GEOTEXTILE FOR SILT FENCE, WOVEN WIRE REINFORCED (PAY ITEM 649.515).

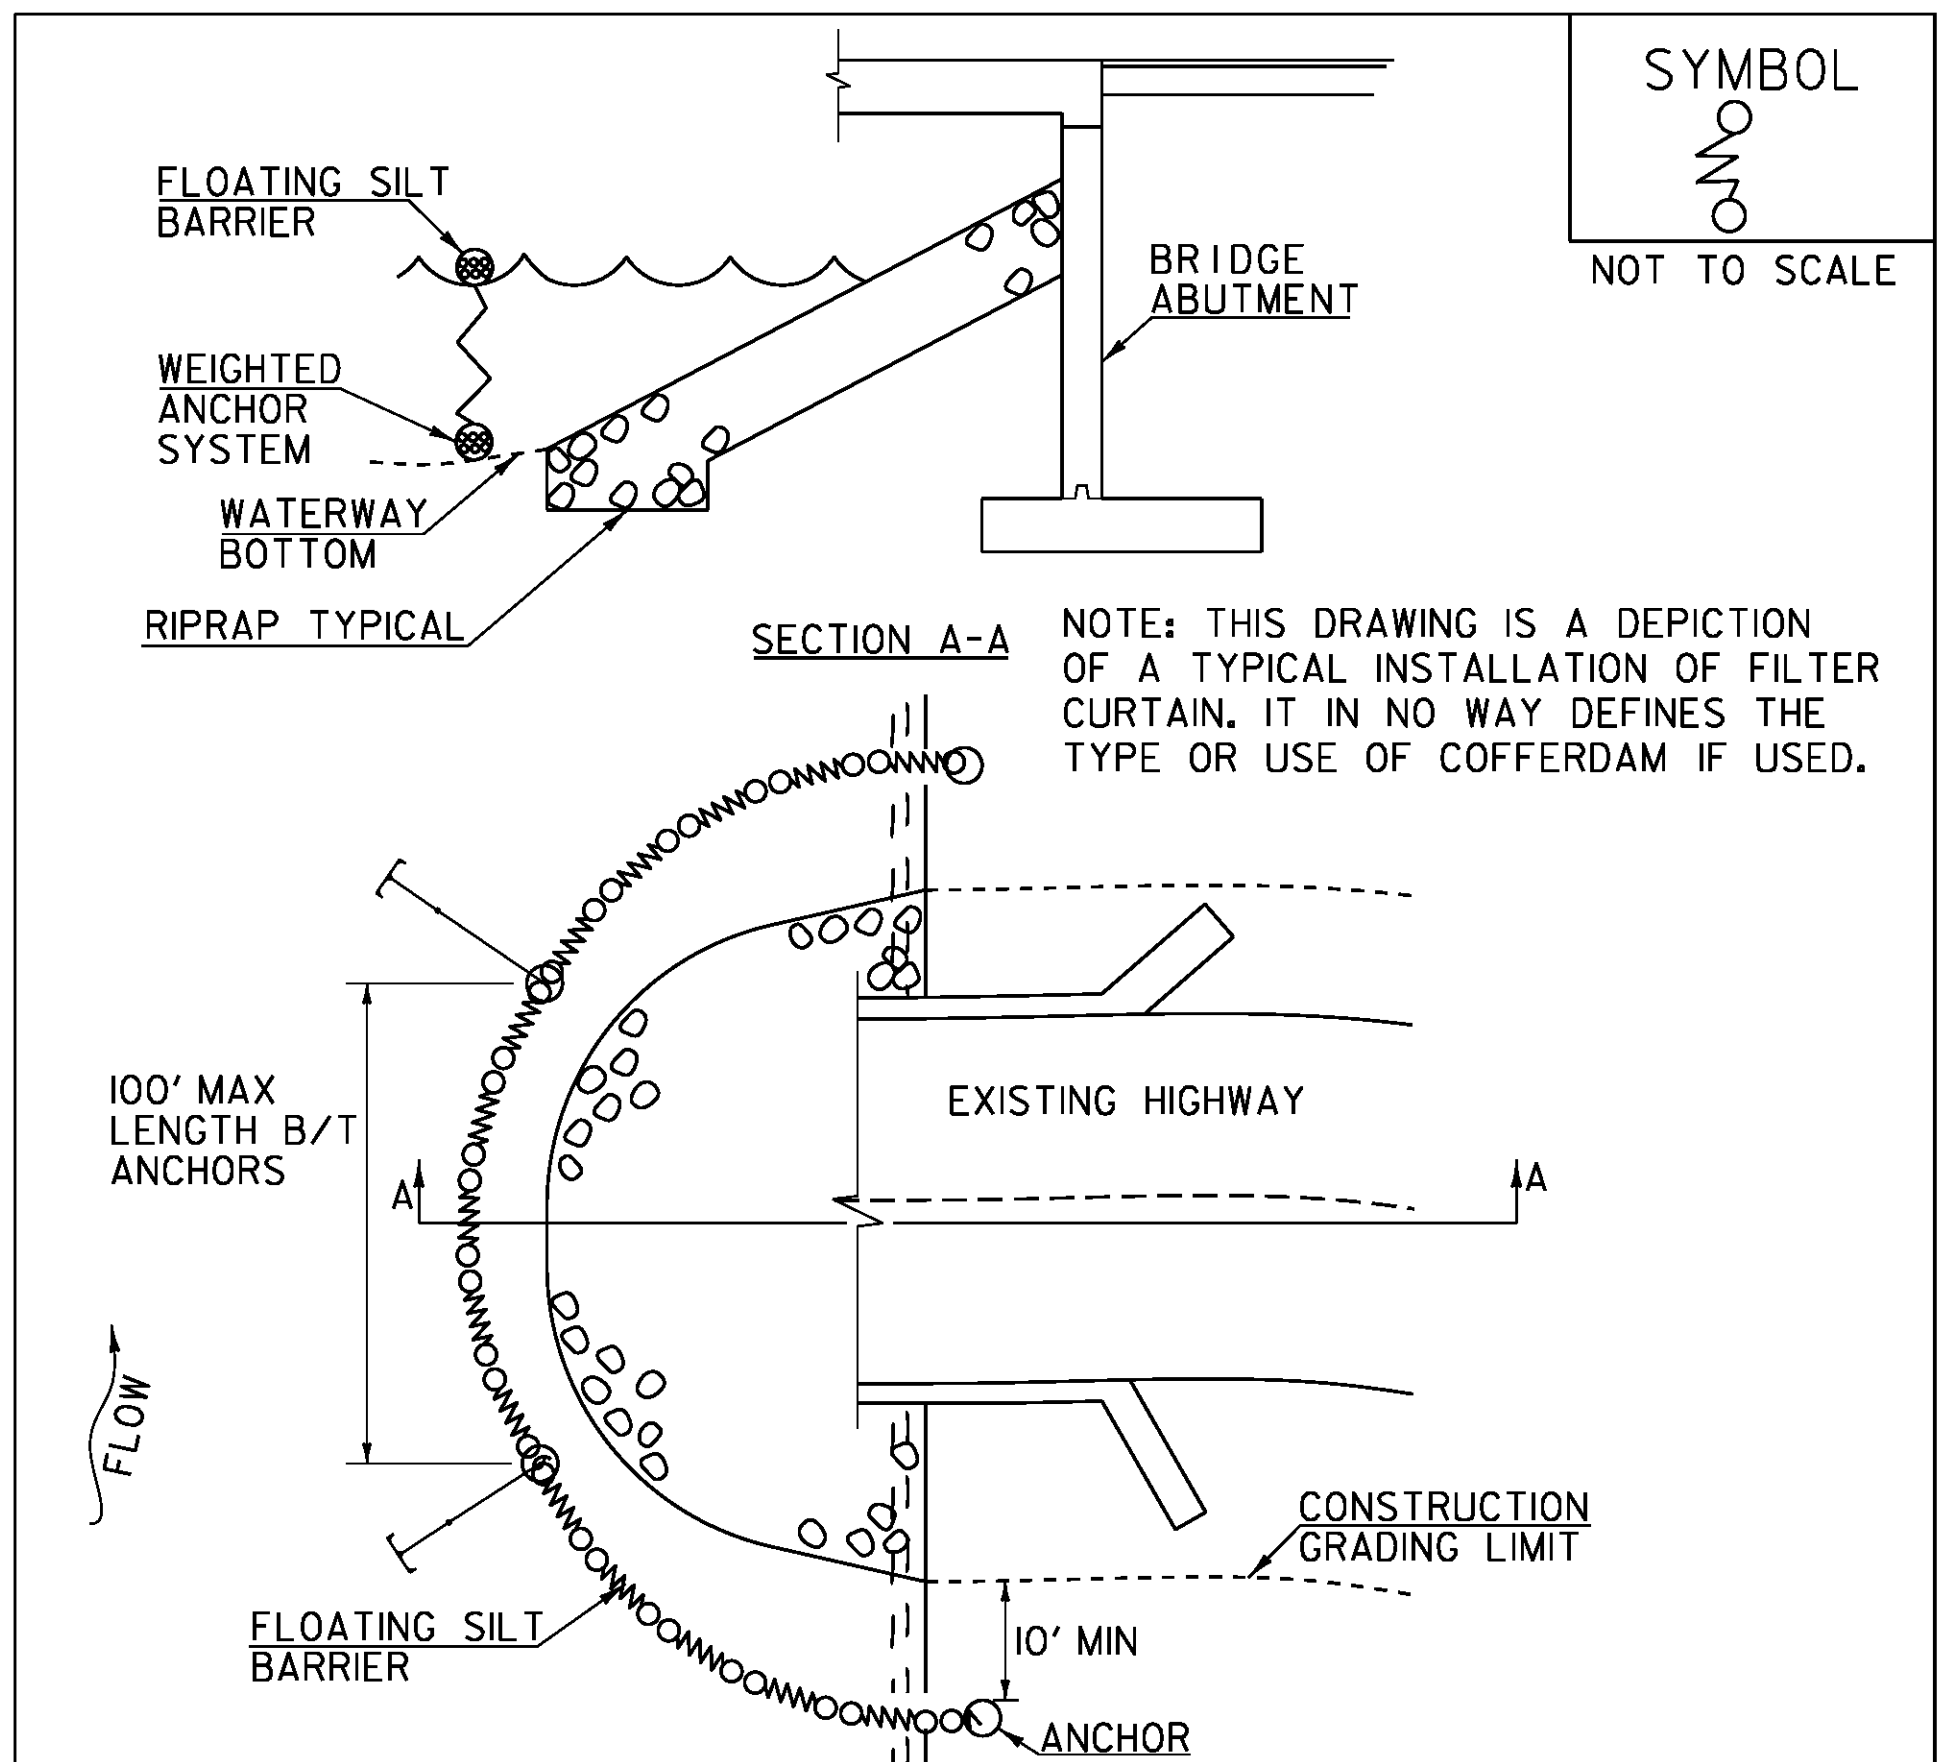

SYMBOL	
[Symbol]	FILTER CURTAIN

**CONSTRUCTION SPECIFICATIONS**


1. FILTER CURTAIN SHALL NOT BE PLACED ACROSS A FLOWING WATERWAY, OR IN A WATERWAY WITH STREAM VELOCITIES GREATER THAN 1.5 FEET/SECOND.
2. MAXIMUM 100' LENGTH BETWEEN ANCHORS.
3. LAST SECTION SHALL TERMINATE A MINIMUM OF 10' BEYOND LIMIT OF DISTURBANCE.
4. THE WEIGHTED ANCHOR SYSTEM SHALL BE A TYPE WHICH ALLOWS THE CURTAIN TO CONFORM TO THE BOTTOM OF THE WATERWAY.
5. THE CURTAIN SHALL BE REMOVED BY SLOWLY PULLING TOWARD THE SHORE MINIMIZING THE ESCAPE OF SEDIMENTS INTO WATERWAY.

**FILTER CURTAIN**

REVISIONS	
APRIL 1, 2008	WHF
JANUARY 13, 2009	WHF
SEPTEMBER 4, 2009	WHF

THIS WORK SHALL BE PERFORMED IN ACCORDANCE WITH SECTION 649 FOR GEOTEXTILE FOR FILTER CURTAIN (PAY ITEM 649.6).

PROJECT NAME:	JOHNSON	PLOT DATE:	10-JUN-2014
PROJECT NUMBER:	BRF 030-2(26)	DRAWN BY:	R. PELLETT
FILE NAME:	s88b193EPSC_details.dgn	CHECKED BY:	H. SALLS
PROJECT LEADER:	C. CARLSON	SHEET	64 OF 69
DESIGNED BY:	H. SALLS		
EPSC DETAILS (1)			

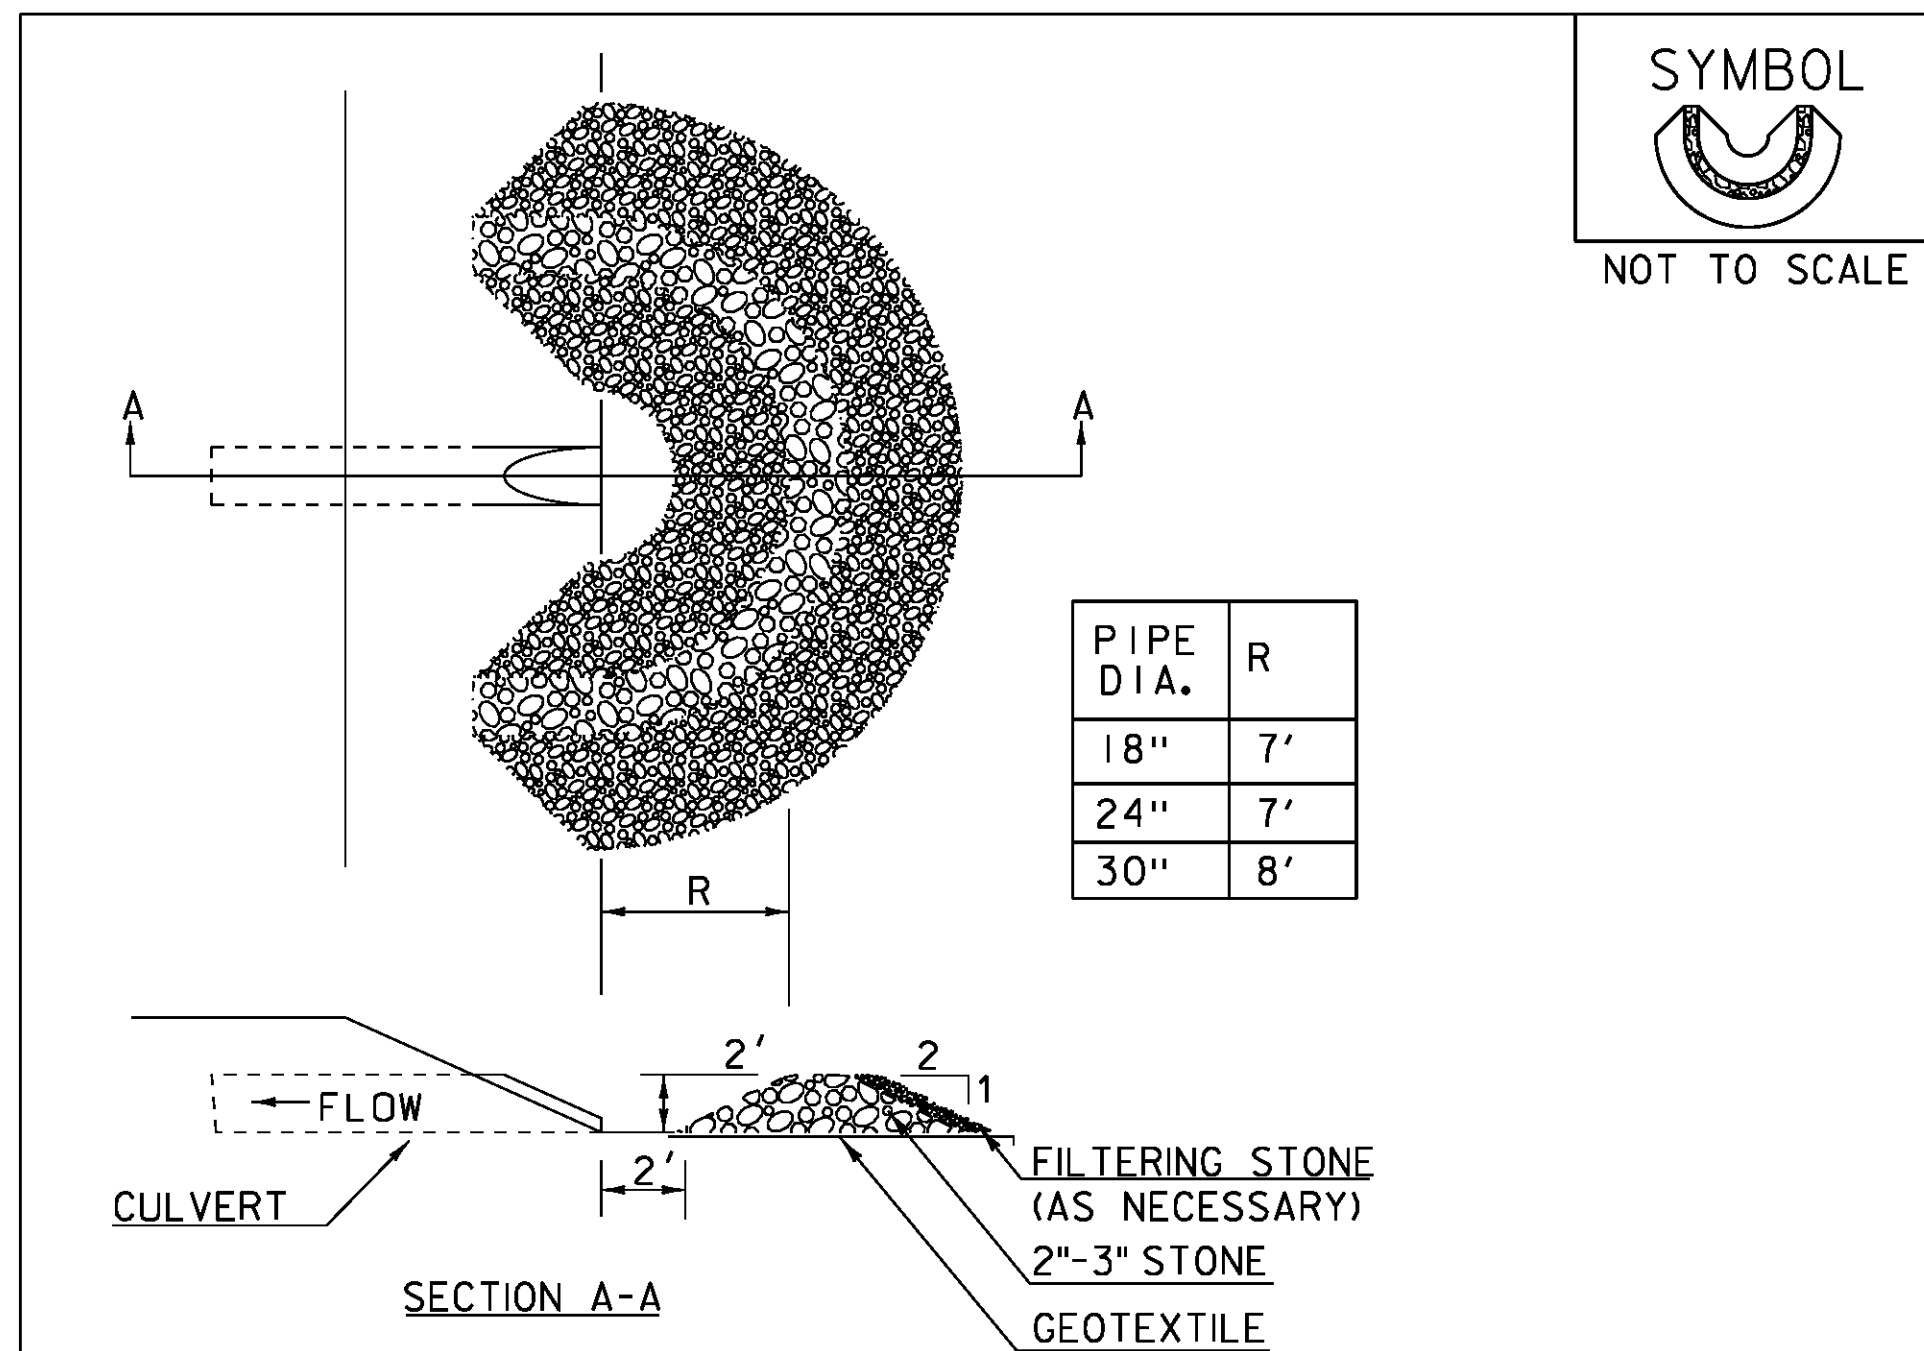

**CONSTRUCTION SPECIFICATIONS**


1. USE 2" TO 3" STONE. FILTERING STONE SHALL BE 3/4".
2. PLACE STONE OVER GEOTEXTILE.
3. ONCE THE AREAS UPSTREAM FROM THE CHECK DAM ARE STABILIZED WITH VEGETATION, THE SEDIMENT TRAPPED BEHIND THE DAM SHALL BE DISPOSED OF IN AN APPROVED WASTE AREA.
4. THE CHECK DAM(S) SHALL BE FLATTENED AND GRADED IN A MANNER WHICH PROTECTS THE AREA FROM EROSION AND CHANNEL BLOCKAGE. (GEOTEXTILE MUST BE REMOVED).
5. THE GEOTEXTILE MUST BE DISPOSED OF APPROPRIATELY.
6. THE AREA CONTRIBUTING TO THE CHECK DAM SHALL NOT EXCEED 4 ACRES.

ADAPTED FROM DETAILS PROVIDED BY: ILLINOIS USDA-NRCS  
ORIGINALLY DEVELOPED BY USDA-NRCS

**PIPE INLET PROTECTION**

REVISIONS	
MARCH 6, 2008	WHF
JANUARY 13, 2009	WHF

THIS WORK SHALL BE PERFORMED IN ACCORDANCE WITH SECTION 653 FOR INLET PROTECTION DEVICE, TYPE 1 (PAY ITEM 653.40).

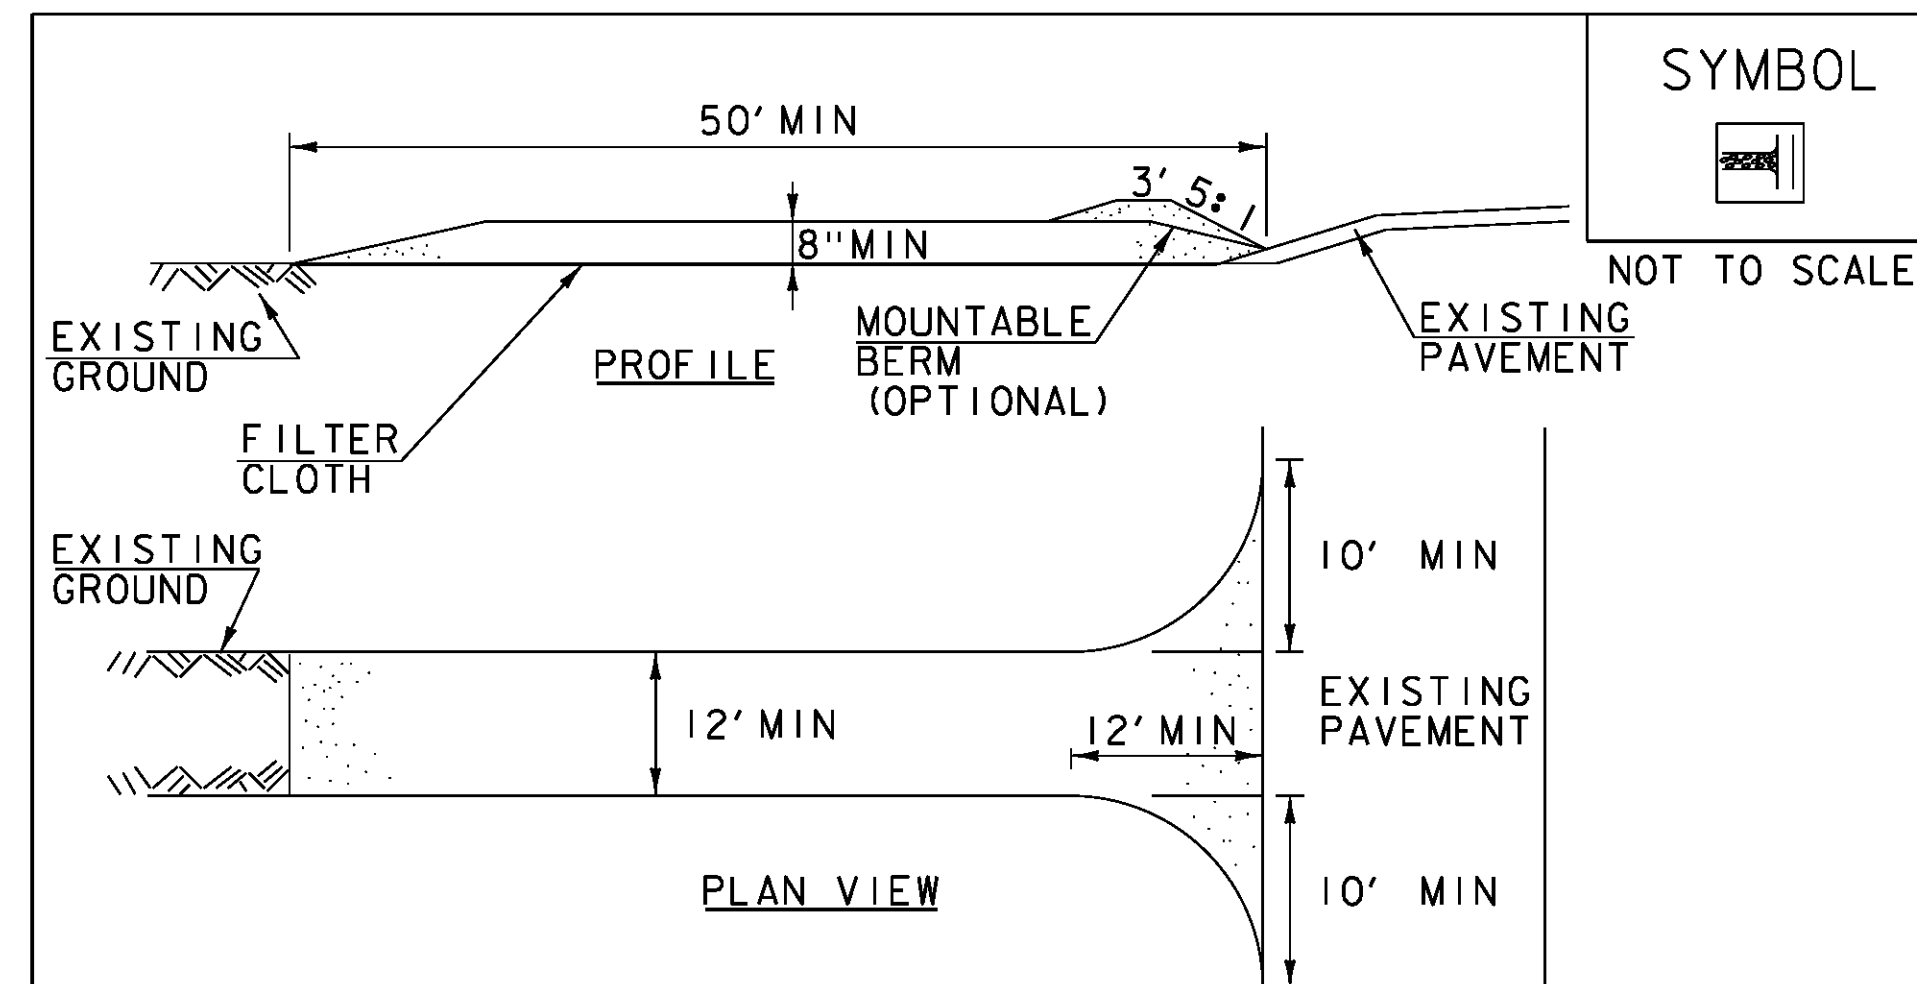

**CONSTRUCTION SPECIFICATIONS**

1. STONE SIZE- USE 1-4" STONE, RECLAIMED OR RECYCLED CONCRETE EQUIVALENT.
2. LENGTH- NOT LESS THAN 50' (EXCEPT ON A SINGLE RESIDENCE LOT WHERE A 30' MINIMUM LENGTH APPLIES).
3. THICKNESS- NOT LESS THAN 8".
4. WIDTH- 12' MINIMUM, BUT NOT LESS THAN THE FULL WIDTH AT POINTS WHERE INGRESS OR EGRESS OCCURS. 24' IF SINGLE ENTRANCE TO SITE.
5. GEOTEXTILE MUST BE PLACED OVER THE ENTIRE AREA PRIOR TO PLACING STONE.
6. SURFACE WATER- ALL SURFACE WATER FLOWING OR DIVERTED TOWARD CONSTRUCTION ENTRANCES SHALL BE PIPED BENEATH THE ENTRANCE. IF PIPING IS IMPRACTICAL, A MOUNTABLE BERM WITH 5:1 SLOPES WILL BE PERMITTED.
7. MAINTENANCE- THE ENTRANCE SHALL BE MAINTAINED IN A CONDITION WHICH WILL PREVENT TRACKING OR FLOWING OF SEDIMENT ONTO PUBLIC RIGHTS-OF-WAY, ALL SEDIMENT SPILLED, DROPPED, WASHED OR TRACKED ONTO PUBLIC RIGHTS-OF-WAY MUST BE REMOVED IMMEDIATELY.
8. WHEN WASHING IS REQUIRED, IT SHALL BE DONE ON AN AREA STABILIZED WITH STONE AND WHICH DRAINS INTO AN APPROVED SEDIMENT TRAPPING DEVICE.
9. PERIODIC INSPECTION AND NEEDED MAINTENANCE SHALL BE PROVIDED ACCORDING TO PERMIT REQUIREMENTS.


ADAPTED FROM DETAILS PROVIDED BY: NEW YORK STATE DEC  
ORIGINALLY DEVELOPED BY USDA-NRCS  
VERMONT DEPARTMENT OF ENVIRONMENTAL CONSERVATION

**STABILIZED CONSTRUCTION ENTRANCE**

REVISIONS	
MARCH 24, 2008	WHF
JANUARY 13, 2009	WHF

NOTES:  
REFER TO "THE VERMONT STANDARDS & SPECIFICATIONS FOR EROSION PREVENTION & SEDIMENT CONTROL -2006- "FROM THE VT AGENCY OF NATURAL RESOURCES FOR ADDITIONAL GUIDANCE.

THIS WORK SHALL BE PERFORMED IN ACCORDANCE WITH SECTION 653 FOR VEHICLE TRACKING PAD (PAY ITEM 653.35) OR AS SPECIFIED IN THE CONTRACT.

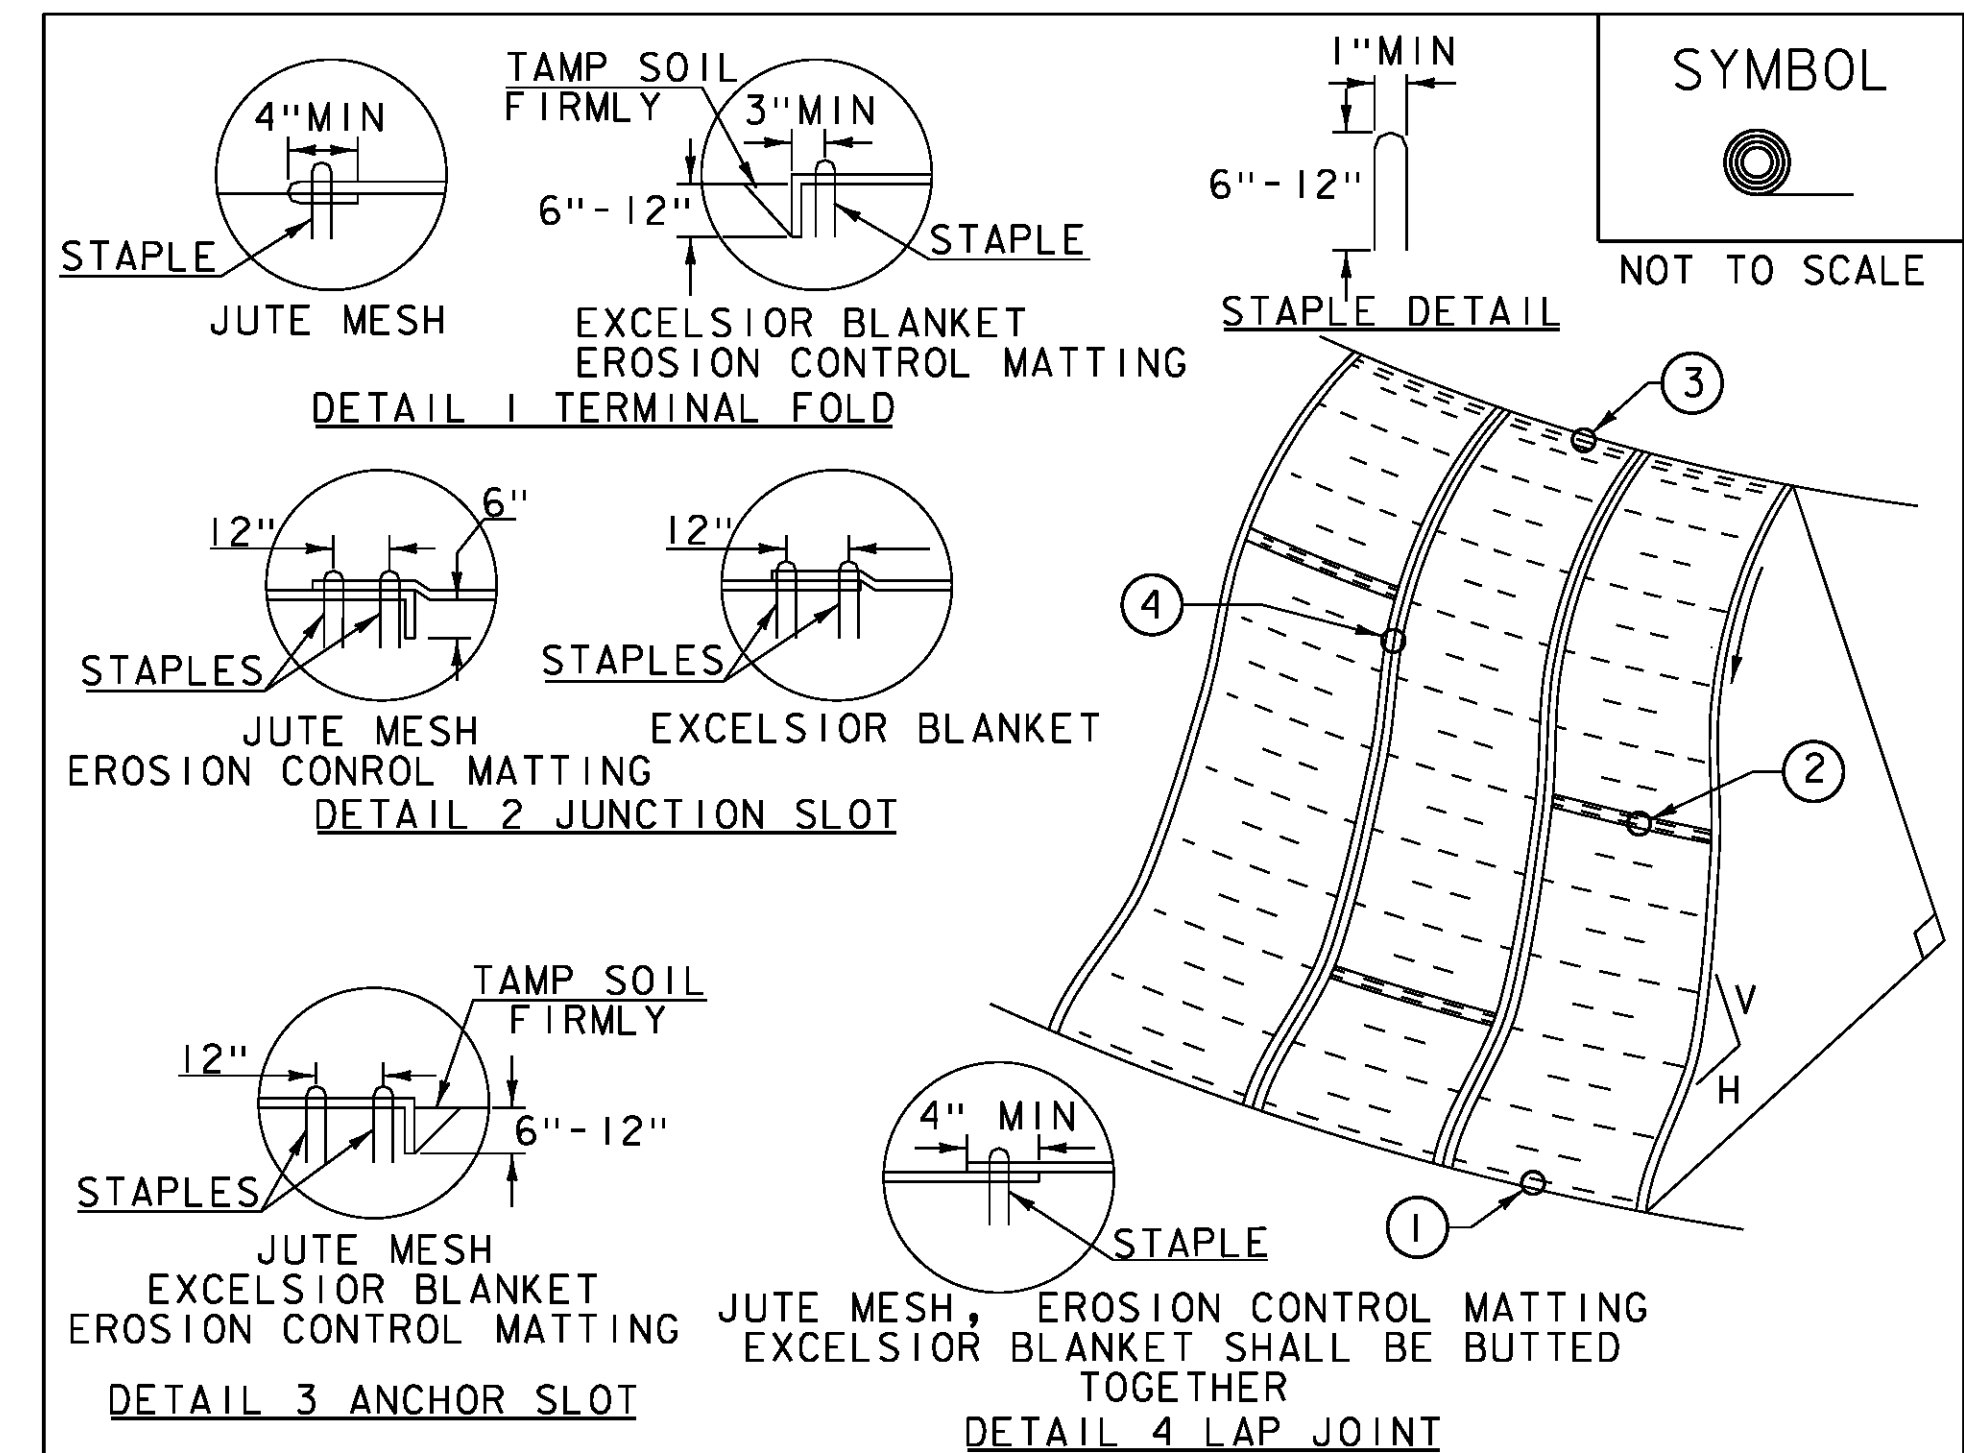

**CONSTRUCTION SPECIFICATIONS**

1. APPLY TO SLOPES GREATER THAN 3H:1V OR WHERE NECESSARY TO AID IN ESTABLISHING VEGETATION.
2. APPLY FERTILIZER, LIME SEED PRIOR TO PLACING MATTING.
3. STAPLES ARE TO BE PLACED ALTERNATELY, IN COLUMNS APPROXIMATELY 2' APART AND IN ROWS APPROXIMATELY 3' APART. APPROXIMATELY 175 STAPLES ARE REQUIRED PER 4'X225' ROLL OF MATERIAL AND 125 STAPLES ARE REQUIRED PER 4'X150' ROLL OF MATERIAL.
4. DISTURBED AREAS SHALL BE SMOOTHLY GRADED. EROSION CONTROL MATERIAL SHALL BE PLACED LOOSELY OVER GROUND SURFACE. DO NOT STRETCH.
5. ALL TERMINAL ENDS AND TRANSVERSE LAPS SHALL BE STAPLED AT APPROXIMATELY 12" INTERVALS.

ADAPTED FROM DETAILS PROVIDED BY: NEW YORK STATE DEC  
ORIGINALLY DEVELOPED BY USDA-NRCS  
VERMONT DEPARTMENT OF ENVIRONMENTAL CONSERVATION

**ROLLED EROSION CONTROL PRODUCT (RECP) SIDE SLOPE**


REVISIONS	
APRIL 16, 2007	JMF
JANUARY 13, 2009	WHF

NOTES:  
REFER TO "THE VERMONT STANDARDS & SPECIFICATIONS FOR EROSION PREVENTION & SEDIMENT CONTROL -2006- "FROM THE VT AGENCY OF NATURAL RESOURCES FOR ADDITIONAL GUIDANCE.  
THIS WORK SHALL BE PERFORMED IN ACCORDANCE WITH SECTION 653 AND AS SHOWN IN THE PLANS FOR TEMPORARY EROSION MATTING (PAY ITEM 653.20) OR PERMANENT EROSION MATTING (PAY ITEM 653.21).

PROJECT NAME: JOHNSON  
PROJECT NUMBER: BRF 030-2(26)

FILE NAME: s88bi93EPSC_details.dgn  
PROJECT LEADER: C. CARLSON  
DESIGNED BY: H. SALLS  
EPSC DETAILS (2)

PLOT DATE: 10-JUN-2014  
DRAWN BY: R. PELLET  
CHECKED BY: H. SALLS  
SHEET 65 OF 69

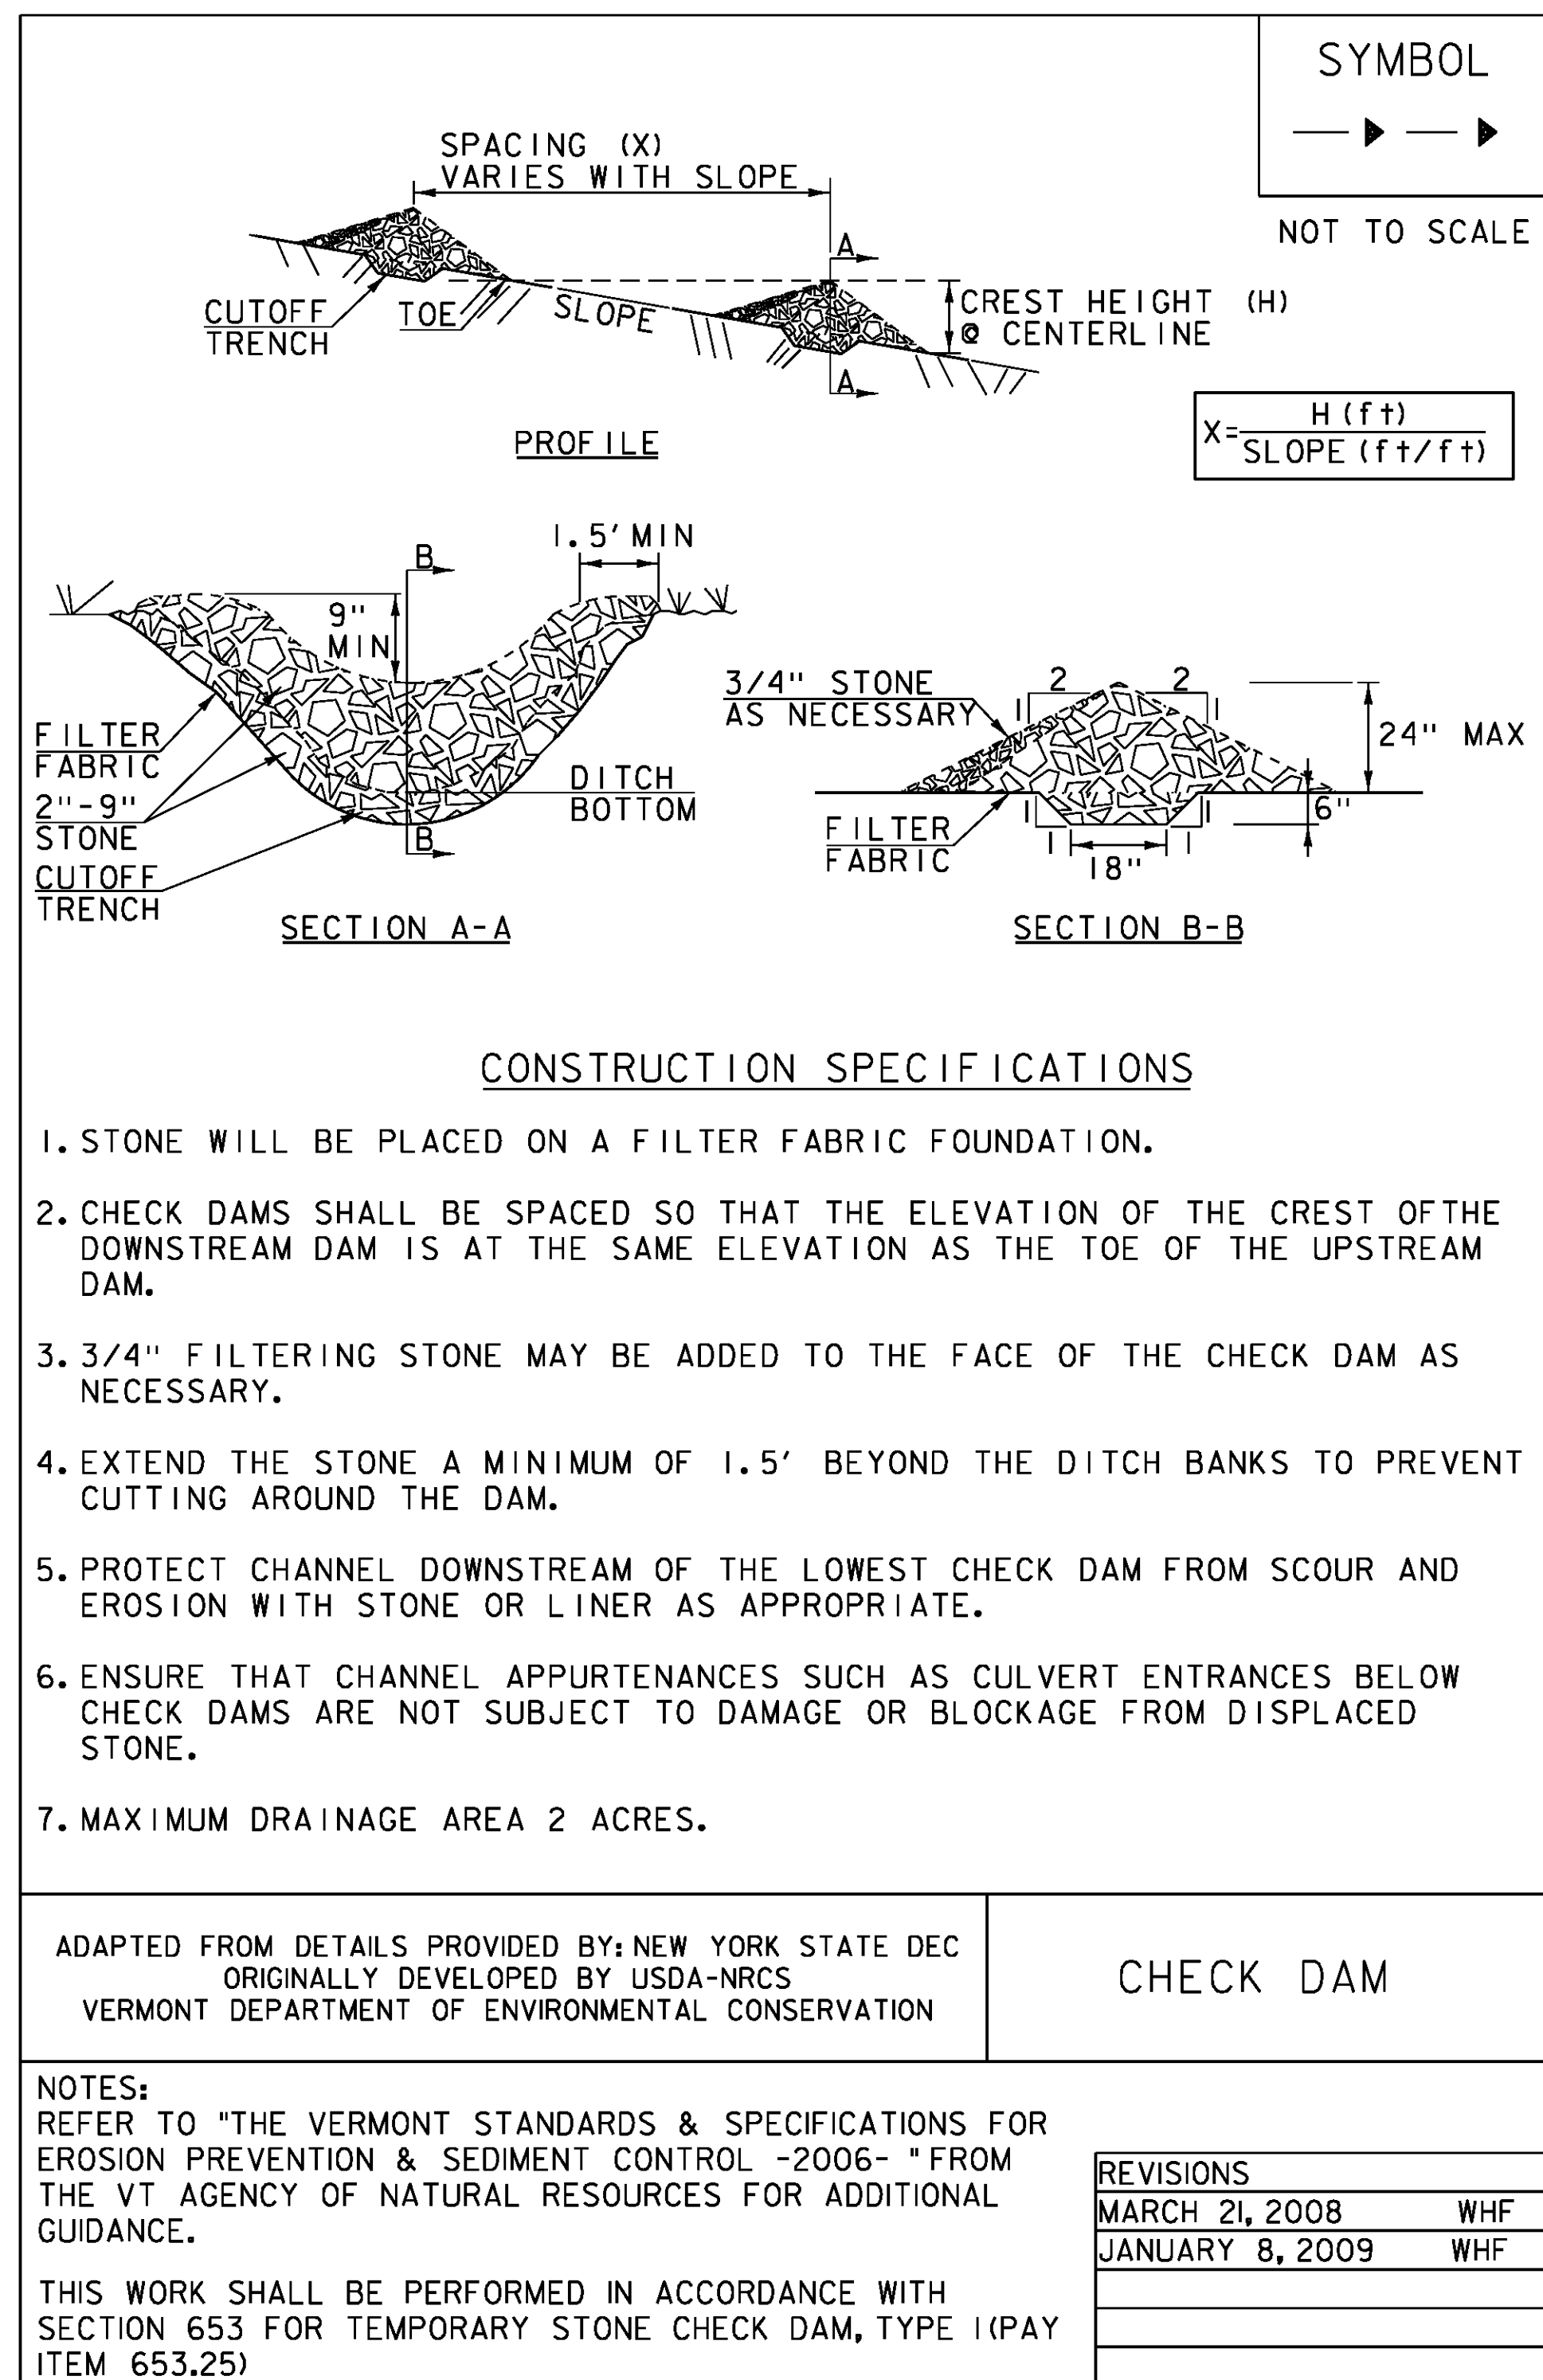

VAOT RURAL AREA MIX					
	LBS/AC				
% WEIGHT	BROADCAST	HYDROSEED	NAME	GERM %	PURITY %
37.5%	22.5	45	CREeping RED FESCUE	85%	98%
37.5%	22.5	45	TALL FESCUE	90%	95%
5.0%	3	6	RED TOP	90%	95%
15.0%	9	18	BIRDSFOOT TREFOIL	85%	98%
5.0%	3	6	ANNUAL RYE GRASS	85%	95%
100%	60	120			

VAOT URBAN AREA MIX					
	LBS/AC				
% WEIGHT	BROADCAST	HYDROSEED	NAME	GERM %	PURITY %
42.5%	34	68	CREeping RED FESCUE	85%	98%
10.0%	8	16	PERENNIAL RYE GRASS	90%	95%
42.5%	34	68	KENTUCKY BLUE GRASS	85%	85%
5.0%	4	8	ANNUAL RYE GRASS	85%	95%
100%	80	160			

SOIL AMENDMENT GUIDANCE			
FERTILIZER		LIME	
BROADCAST	HYDROSEED	BROADCAST	HYDROSEED
10-20-10	FOLLOW	PELLETIZED	FOLLOW
500 LBS/AC	MANUFACTURER	2 TONS/AC	MANUFACTURER

- CONSTRUCTION GUIDANCE**
1. RURAL SEED MIX: USE AS INDICATED IN THE PLANS AND/OR FOR ALL ESTABLISHED UPLAND (NON WETLAND) AREAS DISTURBED BY THE CONTRACTOR.
  2. URBAN SEED MIX: USE AS INDICATED IN THE PLANS AND/OR FOR ALL ESTABLISHED LAWN AREAS DISTURBED BY THE CONTRACTOR.
  3. ALL SEED MIXTURES: SHALL NOT HAVE A WEED CONTENT EXCEEDING 0.40% BY WEIGHT AND SHALL BE FREE OF ALL NOXIOUS SEED.
  4. FERTILIZER AND LIMESTONE: SHALL FOLLOW RATES SHOWN ON PLAN OR AS DIRECTED BY THE ENGINEER
  5. HAY MULCH: TO BE PLACED ON EARTH SLOPES AT THE RATE OF 2 TONS/ACRE, ACHIEVE 90% GROUND COVER OR AS DIRECTED BY THE ENGINEER.
  6. TOPSOIL: TO BE USED WITH SEED AS INDICATED ON THE PLANS, OR AS DIRECTED BY THE ENGINEER.
  7. HYDROSEEDING: ALTHOUGH GUIDANCE IS GIVEN ABOVE THE SITE CONDITIONS AND THE TYPE OF HYDROSEED WILL ULTIMATELY DICTATE THE AMOUNTS AND TYPES OF SOIL AMENDMENTS TO BE APPLIED
  8. TURF ESTABLISHMENT: PLACING SEED, FERTILIZER, LIME AND MULCH PRIOR TO SEPTEMBER 15 AND AFTER APRIL 15 CAN BETTER ENSURE A VIGOROUS GROWTH OF GRASS.

ADAPTED FROM VTRANS TECHNICAL LANDSCAPE MANUAL FOR ROADWAYS AND TRANSPORTATION FACILITIES

**TURF ESTABLISHMENT**

THIS WORK SHALL BE PERFORMED IN ACCORDANCE WITH SECTION 651

REVISIONS	
JUNE 23, 2009	WHF
JANUARY 15, 2010	WHF
FEBRUARY 16, 2011	WHF

PROJECT NAME: JOHNSON  
PROJECT NUMBER: BRF 030-2(26)

FILE NAME: s88bi93EPSC_details.dgn  
PROJECT LEADER: C. CARLSON  
DESIGNED BY: H SALLS  
EPSC DETAILS (3)

PLOT DATE: 11-JUL-2014  
DRAWN BY: R. PELLET  
CHECKED BY: H. SALLS  
SHEET 66 OF 69

# RIGHT - OF - WAY DETAIL SHEET


TABLE OF PROPERTY ACQUISITION

PARCEL NO.	PROPERTY OWNER	SHEET NO.	BEGINNING STATION	ENDING STATION	TAKE AREA±	REMAINDER AREA±	RIGHT			RECORDING DATA				REMARKS
							TYPE	(T)/(P)	AREA ±	TITLE	DATE	TOWN / CITY	BOOK	
1	THE GREEN MOUNTAIN CLUB INC.	1,2	92+50 RT 93+08 RT 93+11 RT	94+19.61 RT 93+37 RT 93+36 RT	4,087 SF		INSTALL CHANNEL	(T)	79 SF			JOHNSON		PDF INCL. STONE FILL
2	FERRARI, CARRI A.	2	94+57 RT 94+59 RT	94+94 RT 94+92 RT			CONST. EASE. SLOPE	(T)	85 SF 293 SF			JOHNSON		INCL. PDF & EC
3	LeHOULLIER, ALAN J. & LYNN	2	93+00.46 LT 93+00.46 LT 93+00.46 LT 93+52 LT 94+00.00 LT 95+91 LT	94+00.00 LT 96+27 LT 95+55.37 LT 95+14 LT	2,812 SF		UTILITY EASEMENT DETOUR INSTALL & MAINTAIN SLOPE INSTALL & MAINTAIN	(P)	0.20 A 3,997 SF 1,357 SF			JOHNSON		8,904SF INCL. PDF, EC & FILTER CURTAIN GUY WIRE AND ANCHOR
4	DELETED													
5A	TOWN OF JOHNSON	2	TH 71 30+24.75 CL TH 71 30+43 RT 92+50.96 LT 92+50.96 LT 92+50.96 LT 92+50.96 LT 92+53 LT	TH 71 30+75 CL 93+00.46 LT 92+74 LT 92+74 LT 93+00.46 LT 93+00.46 LT TH71 30+75 LT			APPROACH INSTALL & MAIN. INSTALL SLOPE CULV., DITCH & DRAIN DETOUR DITCH	(T)				JOHNSON		TH #71 LENGTH = 50.25' GUARDRAIL PDF
5B		2	TH 43 40+25.00 CL 94+09 RT 94+08 RT 94+10 RT TH 43 40+46 LT TH 43 40+69 RT TH 43 40+48 RT	TH 43 41+00.00 CL 94+51 RT 94+69.47 RT TH 43 40+72 RT TH 43 40+90 LT TH 43 41+00 RT TH 43 41+00 RT			APPROACH REMOVE CULV., DITCH & DRAIN INSTALL & MAINTAIN DITCH INSTALL CONST.	(T)						TH # 43 LENGTH = 75.00' CULVERT GUARDRAIL PDF INCL. PDF & EC
6	VERMONT ELECTRIC COOPERATIVE		92+50.96 LT	96+27 LT										UTILITY
7	TELEPHONE OPERATING COMPANY OF VERMONT, LLC		92+50.96 LT	96+27 LT										UTILITY
8	COMCAST OF CONNECTICUT/GEORGIA/MASSACHUSETTS/NEW HAMPSHIRE/NEW YORK/NORTH CAROLINA/VERMONT, LLC		92+50.96 LT	96+27 LT										UTILITY
	MAINTENANCE AGREEMENT #1 TH #71	2	TH 71 30+14.53 CL	TH 71 30+24.75 CL										LENGTH= 10.22'
	MAINTENANCE AGREEMENT #2 TH #43	2	TH 43 40+18.22 CL	TH 43 40+33.00 CL										LENGTH = 14.78'

TABLE OF REVISIONS

REVISION NO.	SHEET NO.	DESCRIPTION	DATE
1	5	PARCEL NO. 2 FERRARI. CHANGE AREA OF CONST. (T) FROM 377 SF± TO 85 SF±. PER C.O. 9833 MADE BY: MR APPROVED BY: RC	10/21/13
2	3,5	PARCEL NO. 3 LEHOULLIER. ADJUST ROW LINE ON TH 71. CHANGE BEGINNING STA. OF TAKE AREA TO 93+00.46 LT. CHANGE TAKE AREA TO 2,800 SF± PER C.O. 9847 MADE BY: JB APPROVED BY: RC	11/27/13
3		PARCEL NO. 4 MANCHESTER. DELETE PARCEL PER C.O. 9848 MADE BY: JB APPROVED BY: RC	11/27/13
4		PARCEL 5A TOWN OF JOHNSON. ADJUST ROW LINE ON TH 71. ADD DITCH (T) STA. VT 15 92+53 LT ~ TH 71 30+75 LT. ADD SLOPE RIGHT (T) STA. 92+15 LT ~ 92+14 LT; 706 SF±. ADD CULVERT, DITCH & DRAINAGE (P) STA. 92+51 LT. ~ 93+00.46 LT. CHANGE APPROACH LENGTH TO 50.25' PER C.O. 9849 MADE BY: JB APPROVED BY: RC	11/27/13
5		PARCEL 5B TOWN OF JOHNSON. ADD INSTALL & MAINTAIN (P) FOR GUARDRAIL STA. 94+10 RT ~ STA. TH 43 40+72 RT. ADD DITCH (T) STA. TH 43 40+48 RT ~ TH 43 40+90 RT. ADD CULVERT, DITCH & DRAINAGE (P) STA. 94+08 RT ~ 94+84 RT. ADD REMOVE (T) FOR EXISTING CULVERT STA. 94+08 RT ~ 94+51 RT. CHANGE LENGTH OF APPROACH TO 75.00' PER C.O. 9850 MADE BY: JB APPROVED BY: RC	11/27/13
6	5	PARCEL NO. 2 FERRARI. CHANGE BEGINNING OF SLOPE RIGHT TO 94+59 RT. CHANGE ENDING OF SLOPE RIGHT TO STA. 94+92 RT. PER C.O. 9853 MADE BY: JB APPROVED BY: RC	12/17/13
7	3,5	PARCEL NO. 3 LEHOULLIER. CHANGE TAKING AREA TO 2,812 SF±. CHANGE BEGINNING OF DETOUR TO STA. 93+00.46 LT. DELETE THE RIGHT FOR THE CHANNEL (P). CHANGE ENDING STA. OF SLOPE RIGHT TO 95+14 LT. PER C.O. 9854 MADE BY: JB APPROVED BY: RC	12/17/13
8	3,5	PARCEL 5A TOWN OF JOHNSON. ADD INSTALL (T) AT STA. 92+50.96 LT ~ 92+74 LT. INCLUDES PDF. CHANGE BEGINNING OF SLOPE RIGHT TO STA. 92+50.96 LT. CHANGE BEGINNING OF CULV., DIT. & DR. TO STA. 92+50.96 LT. WITH AN AREA OF 400 SF±. ADD AREA OF 275 SF± TO DITCH (T). CHANGE STATIONING OF INSTALL & MAINTAIN TO TH 71 30+43 RT ~ 93+00.46 LT. ADD DETOUR (T) AT STA. 92+50.96 ~ 93+00.46; 50 SF±. PER C.O. 9855 MADE BY: JB APPROVED BY: RC	12/17/13
9	3,5	PARCEL NO. 5B TOWN OF JOHNSON CHANGE BEGINNING STATION OF REMOVE (T) TO STA. 94+09 RT. CHANGE ENDING STATION OF CULV., DIT. & DR. TO 94+69.47. CHANGE OFFSET DIRECTION OF DITCH (T) TO BE LEFT NOT RT. ADD INSTALL (T) STA. TH 43 40+69 RT ~ TH 43 41+00 RT; INCLUDES PDF & EC. ADD CONST. (T) AT STA. TH 43 40+48 RT ~ TH 43 41+00 RT; 530 SF±. PER C.O. 9856 MADE BY: JB APPROVED BY: RC	12/17/13
10	3,5	PARCEL NO. 3 LEHOULLIER. ADD UE(P) STA. 93+00.46 LT. ~ 96+27 LT.; 0.20A±; 8,904 S F ± ADD I&M(P) STA. 93+52 LT. ~ 95+91 LT. FOR GUY WIRE & ANCHOR. CHANGE END OF PROJECT TO 96+27; 45.69' LT. CHANGE LENGTH OF ROW PROJECT TO 376.04' PER C.O. 9863 MADE BY: JB APPROVED BY: RC	02/14/14

PLOT DATE 02/14/14

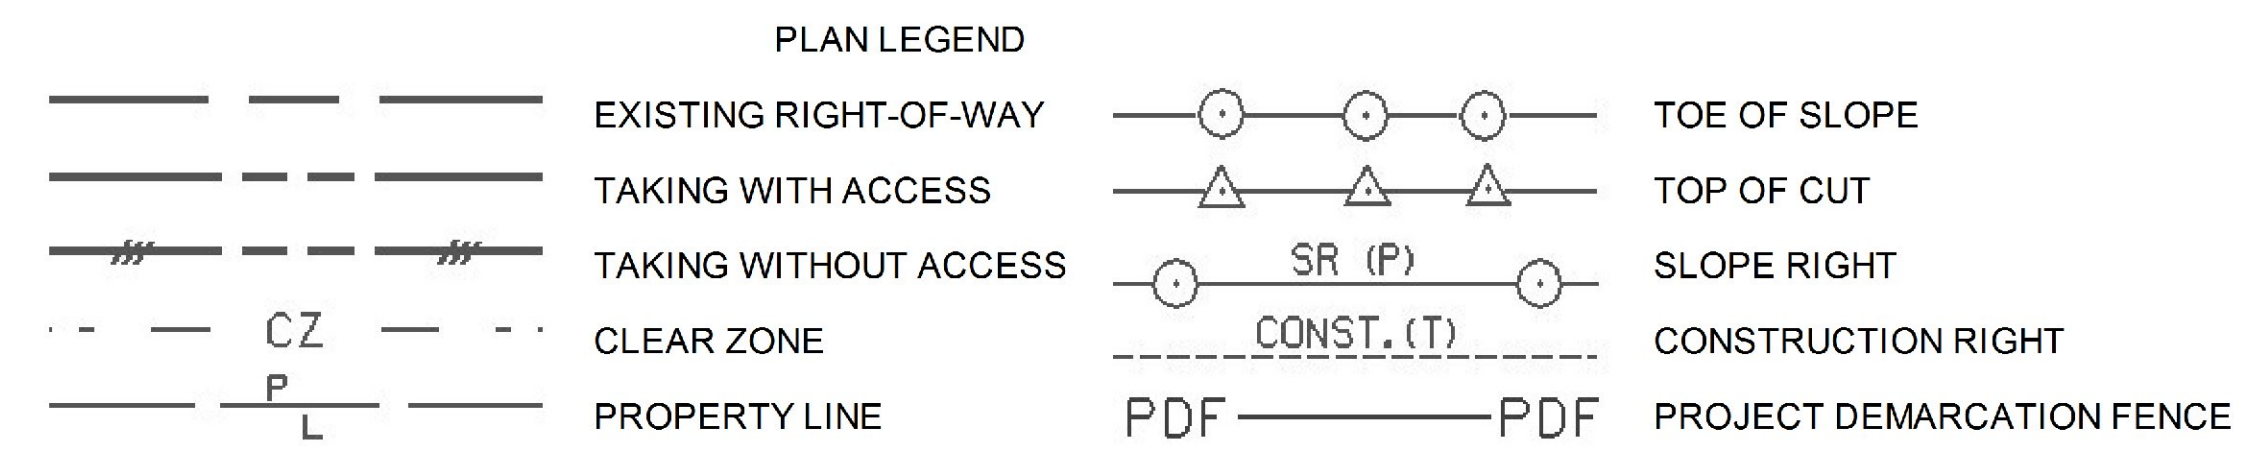

- EC -EROSION CONTROL
- (P) -PERMANENT
- (T) -TEMPORARY
- DR. -DRAINAGE RIGHT
- DIT. -DITCHING RIGHT
- CH. -CHANNEL RIGHT
- DRIVE -DRIVE RIGHT
- CUL. -CULVERT RIGHT
- C&T -CLEARING & TRIMMING RIGHT
- SR -SLOPE RIGHT
- UE -UTILITY EASEMENT

R & R - REMOVE & RESET  
I & M - INSTALL & MAINTAIN

APPROVED: RYAN CLOUTIER DATE: 9-30-13  
CHIEF, PLANS & TITLES

PROJECT NAME:	<b>JOHNSON</b>	PLOT DATE:	02/14/14
PROJECT NUMBER:	<b>BRF 030-2 (26)</b>	DRAWN BY:	<b>MR</b>
FILE NAME:	r88B193detail.xls	CHECKED BY:	<b>BF</b>
PROJECT LEADER:	<b>C. CARLSON</b>	SHEET	<b>67</b> OF <b>69</b>
DESIGNED BY:	<b>G. ROY</b>		
R.O.W. DETAIL SHEET #1			

**CONSTRUCT STONE FILL, TYPE II BANK SLOPE**  
 VT 15 STA 89+00.0 LT - VT 15 STA 92+00.0 LT  
**CONSTRUCT GRASS-LINED DITCH**  
 VT 15 STA 89+00.0 LT - VT 15 STA 92+00.0 LT  
**HD STEEL BEAM GUARDRAIL, GALVANIZED**  
 VT 15 STA 89+59.8 RT - VT 15 STA 92+00.0 RT  
**REMOVAL AND DISPOSAL OF GUARDRAIL**  
 VT 15 STA 89+59.8 RT - VT 15 STA 92+00.00 RT

① VT 15 STA 89+00.0 LT - VT 15 STA 92+00.0 LT  
 NEW 8 INCH UNDERDRAIN PIPE W/ UNDERDRAIN FLUSHING  
 BASIN AND YIELDING MARKER POST AT INDET.


**N/F  
 LEHOULLIER, ALAN J. & PATRICIA TRUSTEES  
 OF THE PATRICIA E. LEHOULLIER FAMILY TRUST**

**N/F MANCHESTER**

APPROXIMATE RELOCATION OF AERIAL  
 UTILITY FACILITIES OWNED BY COMCAST  
 (TO BE DONE BY OTHERS)

**STATE OF VERMONT**

APPROXIMATE RELOCATION OF AERIAL UTILITY  
 FACILITIES OWNED BY TELEPHONE OPERATING  
 COMPANY OF VERMONT, L.L.C. AND COMCAST

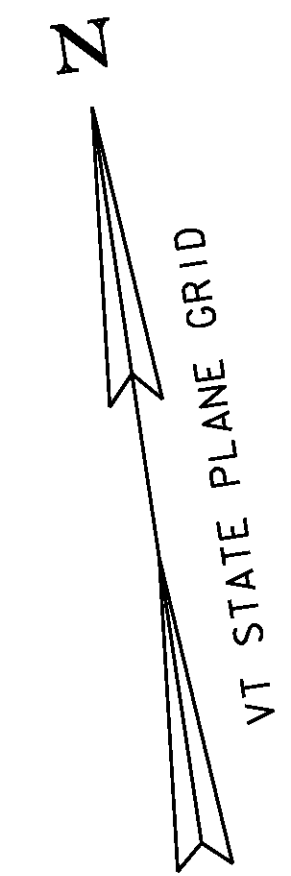

**MATCHLINE**

**STA 92+00.00**

88+81.71  
 131.08LT. =  
 PROJECT FAP 85B(1)  
 334+00 LT. IPPE  
 N781014.34  
 E1582288.26

88+81.87  
 41.08LT.

STA 89+00.00  
 BEGIN APPROACH  
 MATCH EXISTING

91+77.70 WOODS  
 36.58RT. =  
 PROJECT FAP 85 B (1)  
 336+95RT.  
 N780853.09  
 E1582566.17

**① THE GREEN MOUNTAIN CLUB, INC.**

20 0 20  
 SCALE: 1" = 20'-0"


**FOR R.O.W.  
 USE ONLY**

LINE SHOWN ON THIS PLAN AS EXISTING  
 PROPERTY LINES P/L ARE BELIEVED TO  
 BE ACCURATE BUT SHOULD NOT BE RELIED  
 UPON FOR PURPOSES UNRELATED TO THE  
 STATE OF VERMONT'S ACQUISITION OF LAND  
 AND RIGHTS FOR THIS PROJECT.

PROJECT NAME: JOHNSON  
 PROJECT NUMBER: BRF 030-2(26)


FILE NAME: s88b193bdr.dgn  
 PROJECT LEADER: C. CARLSON  
 DESIGNED BY: G. ROY  
 ROW LAYOUT I

PLOT DATE: 11-JUL-2014  
 DRAWN BY: G. ROY  
 CHECKED BY: H. SALLS  
 SHEET 68 OF 69

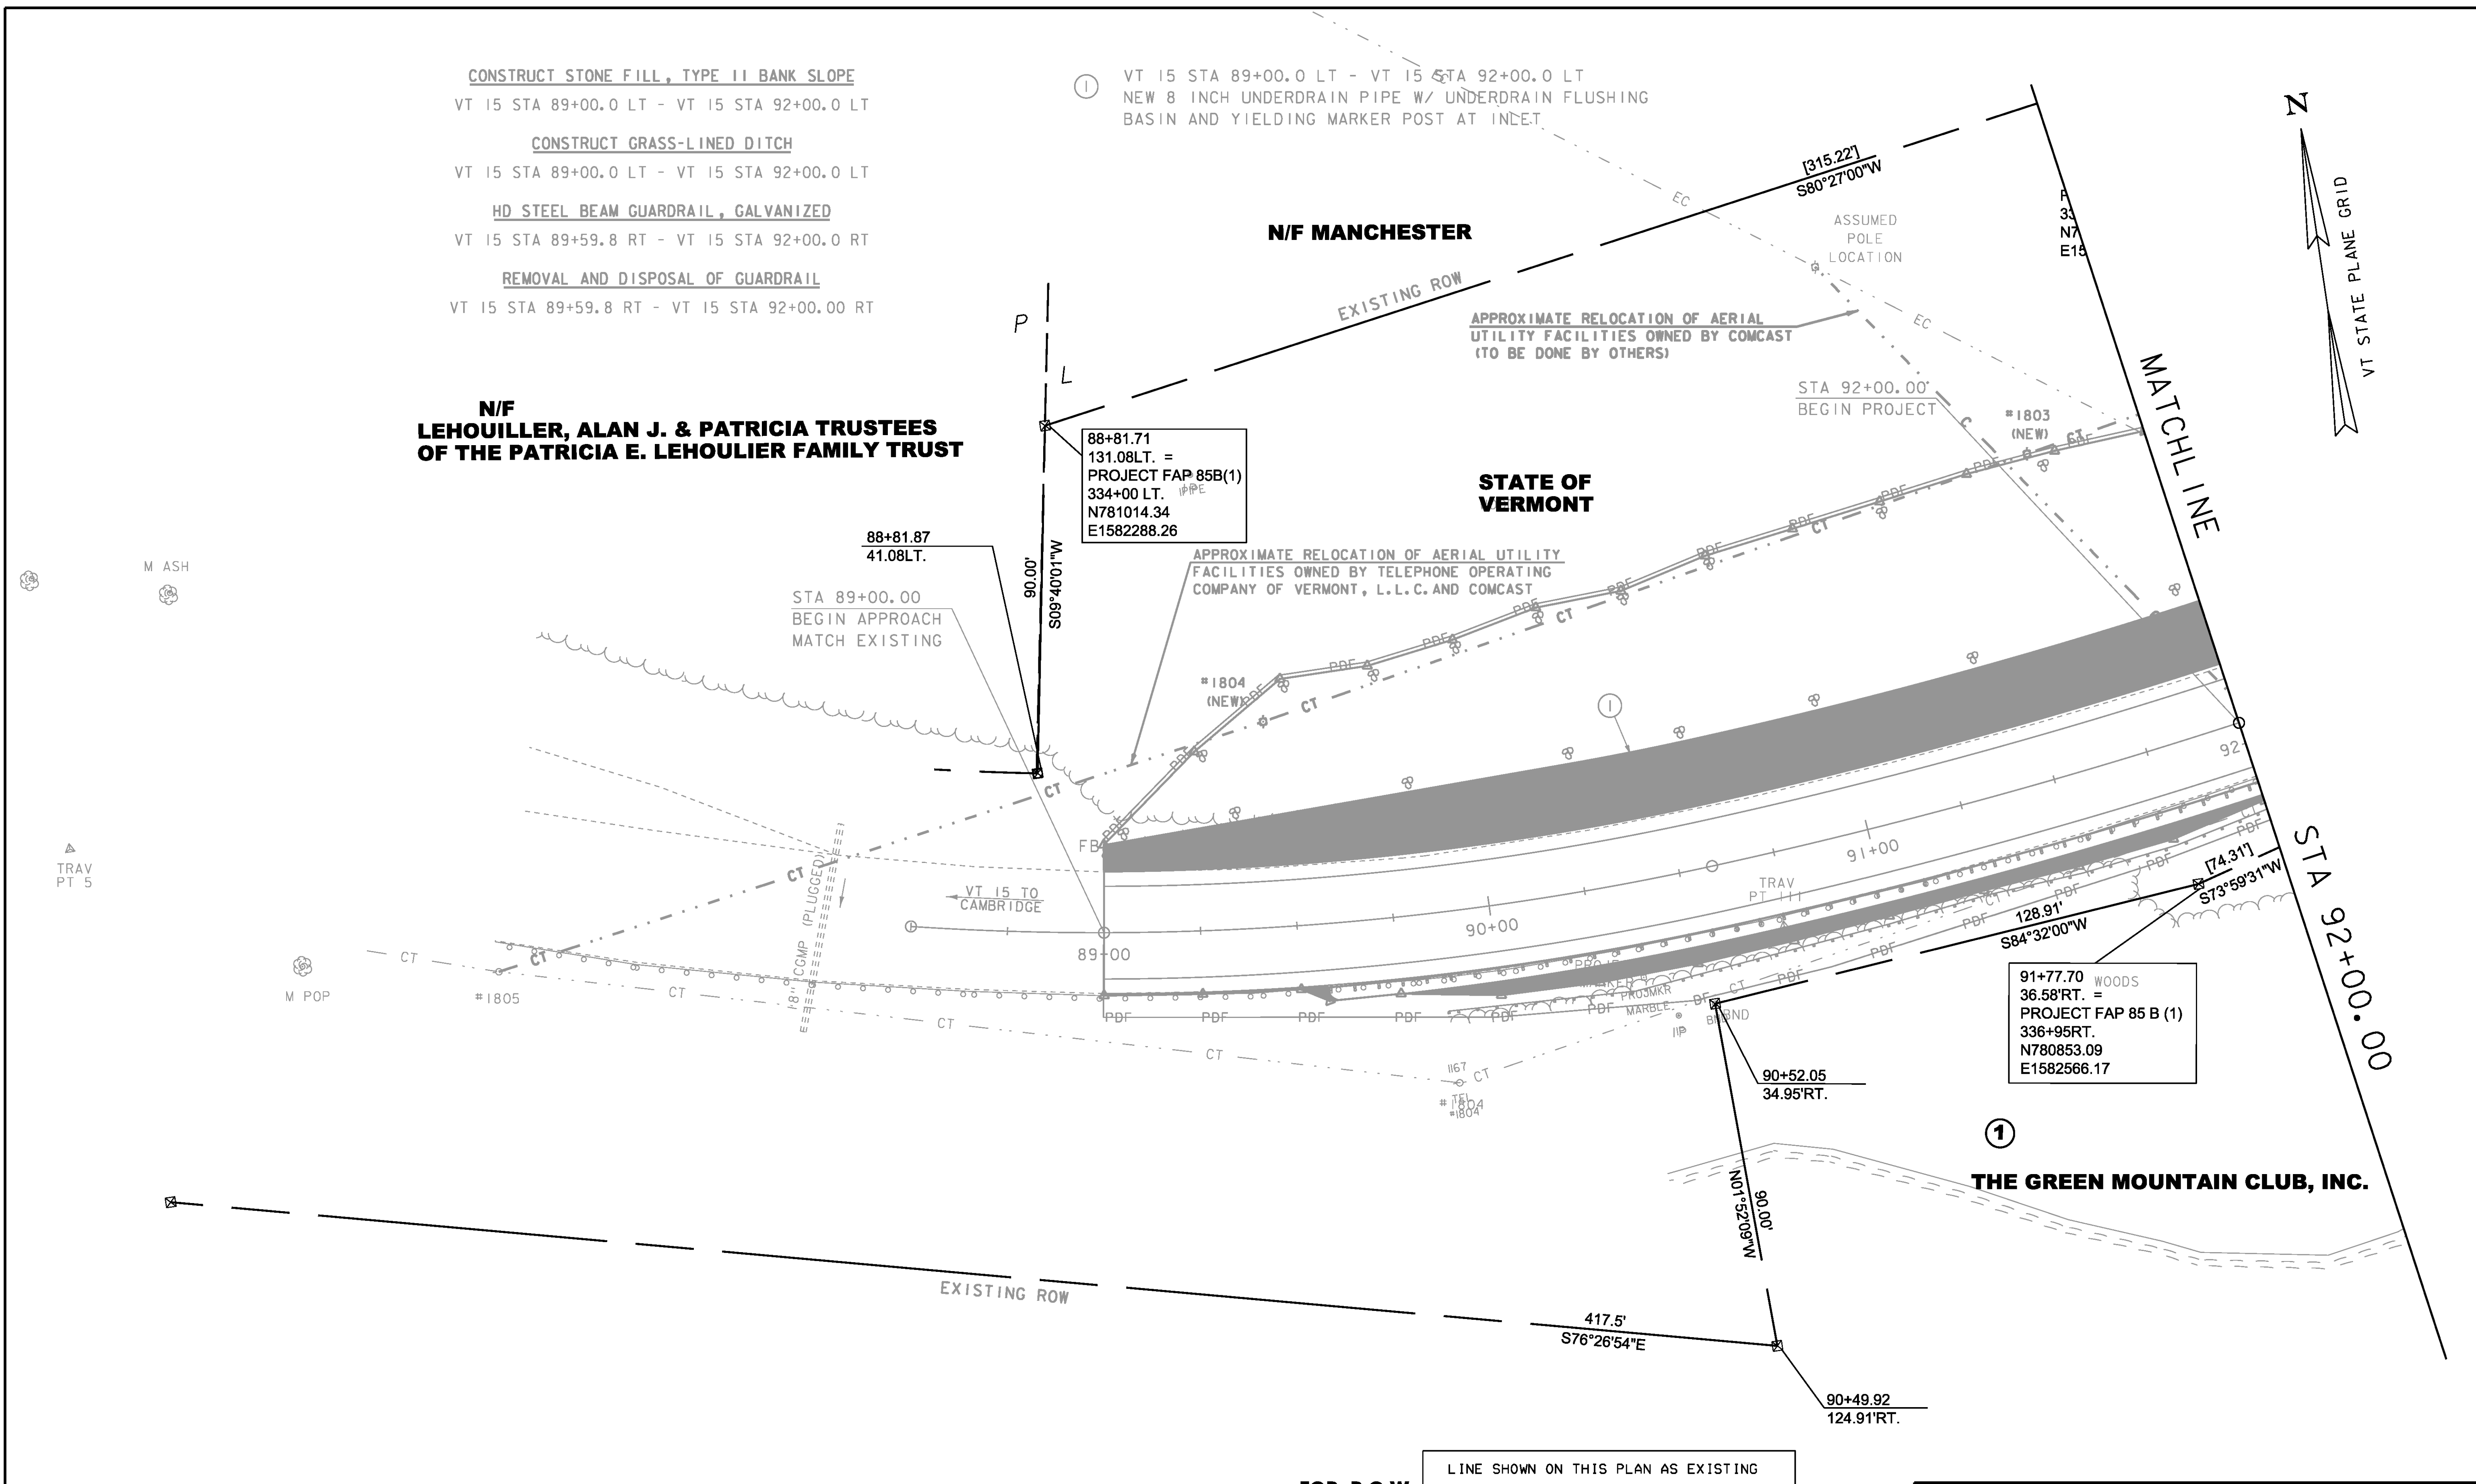


STA 92+00.00

MATCHLINE

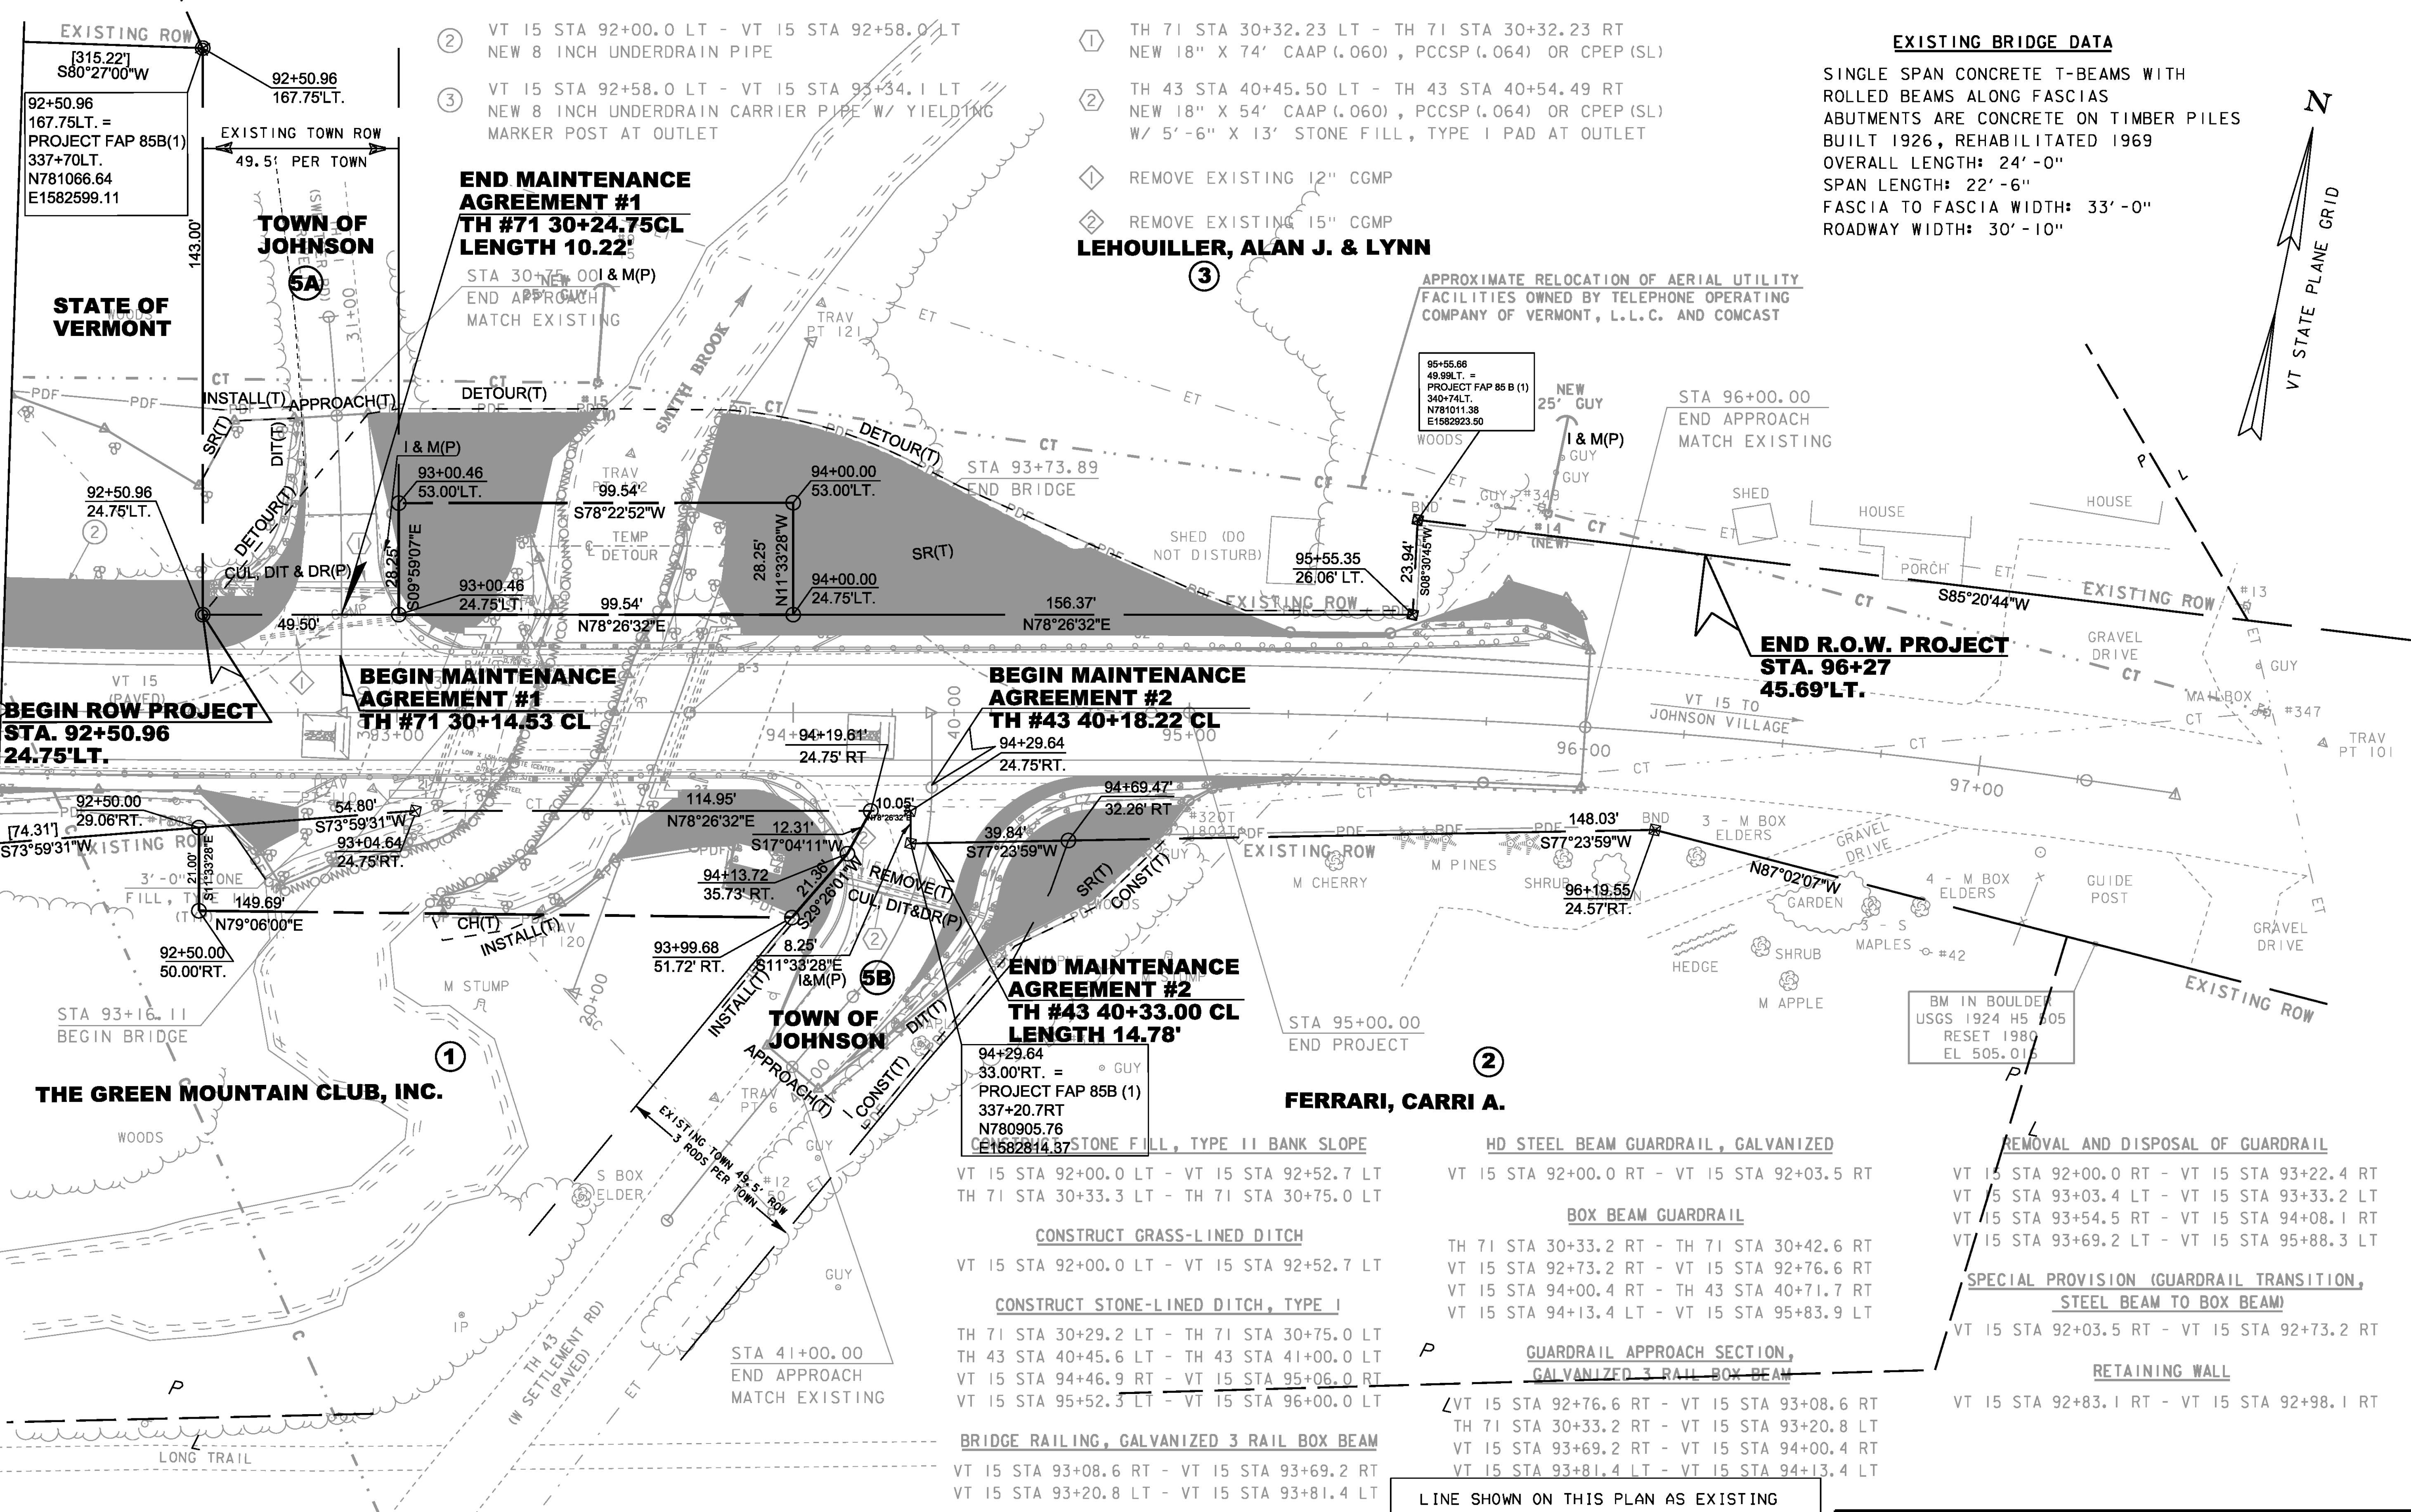

**EXISTING BRIDGE DATA**

SINGLE SPAN CONCRETE T-BEAMS WITH ROLLED BEAMS ALONG FASCIAS  
 ABUTMENTS ARE CONCRETE ON TIMBER PILES BUILT 1926, REHABILITATED 1969  
 OVERALL LENGTH: 24'-0"  
 SPAN LENGTH: 22'-6"  
 FASCIA TO FASCIA WIDTH: 33'-0"  
 ROADWAY WIDTH: 30'-10"

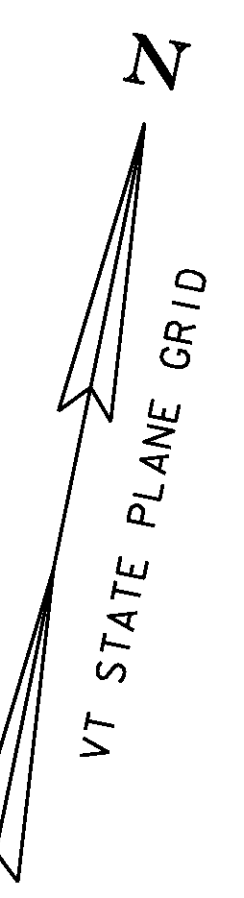

- ② VT 15 STA 92+00.0 LT - VT 15 STA 92+58.0 LT  
NEW 8 INCH UNDERDRAIN PIPE
- ③ VT 15 STA 92+58.0 LT - VT 15 STA 93+34.1 LT  
NEW 8 INCH UNDERDRAIN CARRIER PIPE W/ YIELDING MARKER POST AT OUTLET

- ① TH 71 STA 30+32.23 LT - TH 71 STA 30+32.23 RT  
NEW 18" X 74' CAAP (.060), PCCSP (.064) OR CPEP (SL)
- ② TH 43 STA 40+45.50 LT - TH 43 STA 40+54.49 RT  
NEW 18" X 54' CAAP (.060), PCCSP (.064) OR CPEP (SL)  
W/ 5'-6" X 13' STONE FILL, TYPE I PAD AT OUTLET

- ① REMOVE EXISTING 12" CGMP
- ② REMOVE EXISTING 15" CGMP
- ③ **LEHOULLIER, ALAN J. & LYNN**

APPROXIMATE RELOCATION OF AERIAL UTILITY FACILITIES OWNED BY TELEPHONE OPERATING COMPANY OF VERMONT, L.L.C. AND COMCAST

**END MAINTENANCE AGREEMENT #1**  
**TH #71 30+24.75CL**  
**LENGTH 10.22'**

**BEGIN MAINTENANCE AGREEMENT #1**  
**TH #71 30+14.53 CL**

**BEGIN MAINTENANCE AGREEMENT #2**  
**TH #43 40+18.22 CL**

**END MAINTENANCE AGREEMENT #2**  
**TH #43 40+33.00 CL**  
**LENGTH 14.78'**

**END R.O.W. PROJECT**  
**STA. 96+27**  
**45.69'LT.**

**BEGIN ROW PROJECT**  
**STA. 92+50.96**  
**24.75'LT.**

STONE FILL, TYPE II BANK SLOPE  
 VT 15 STA 92+00.0 LT - VT 15 STA 92+52.7 LT  
 TH 71 STA 30+33.3 LT - TH 71 STA 30+75.0 LT

CONSTRUCT GRASS-LINED DITCH  
 VT 15 STA 92+00.0 LT - VT 15 STA 92+52.7 LT

CONSTRUCT STONE-LINED DITCH, TYPE I  
 TH 71 STA 30+29.2 LT - TH 71 STA 30+75.0 LT  
 TH 43 STA 40+45.6 LT - TH 43 STA 41+00.0 LT  
 VT 15 STA 94+46.9 RT - VT 15 STA 95+06.0 RT  
 VT 15 STA 95+52.3 LT - VT 15 STA 96+00.0 LT

BRIDGE RAILING, GALVANIZED 3 RAIL BOX BEAM  
 VT 15 STA 93+08.6 RT - VT 15 STA 93+69.2 RT  
 VT 15 STA 93+20.8 LT - VT 15 STA 93+81.4 LT

HD STEEL BEAM GUARDRAIL, GALVANIZED  
 VT 15 STA 92+00.0 RT - VT 15 STA 92+03.5 RT


BOX BEAM GUARDRAIL  
 TH 71 STA 30+33.2 RT - TH 71 STA 30+42.6 RT  
 VT 15 STA 92+73.2 RT - VT 15 STA 92+76.6 RT  
 VT 15 STA 94+00.4 RT - TH 43 STA 40+71.7 RT  
 VT 15 STA 94+13.4 LT - VT 15 STA 95+83.9 LT

GUARDRAIL APPROACH SECTION, GALVANIZED 3 RAIL BOX BEAM  
 VT 15 STA 92+76.6 RT - VT 15 STA 93+08.6 RT  
 TH 71 STA 30+33.2 RT - VT 15 STA 93+20.8 LT  
 VT 15 STA 93+69.2 RT - VT 15 STA 94+00.4 RT  
 VT 15 STA 93+81.4 LT - VT 15 STA 94+13.4 LT

REMOVAL AND DISPOSAL OF GUARDRAIL  
 VT 15 STA 92+00.0 RT - VT 15 STA 93+22.4 RT  
 VT 15 STA 93+03.4 LT - VT 15 STA 93+33.2 LT  
 VT 15 STA 93+54.5 RT - VT 15 STA 94+08.1 RT  
 VT 15 STA 93+69.2 LT - VT 15 STA 95+88.3 LT

SPECIAL PROVISION (GUARDRAIL TRANSITION, STEEL BEAM TO BOX BEAM)  
 VT 15 STA 92+03.5 RT - VT 15 STA 92+73.2 RT

RETAINING WALL  
 VT 15 STA 92+83.1 RT - VT 15 STA 92+98.1 RT

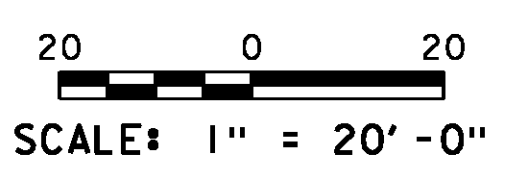


LINE SHOWN ON THIS PLAN AS EXISTING PROPERTY LINES P/L ARE BELIEVED TO BE ACCURATE BUT SHOULD NOT BE RELIED UPON FOR PURPOSES UNRELATED TO THE STATE OF VERMONT'S ACQUISITION OF LAND AND RIGHTS FOR THIS PROJECT.

PROJECT NAME: JOHNSON	PLOT DATE: 11-JUL-2014
PROJECT NUMBER: BRF 030-2(26)	DRAWN BY: G. ROY
FILE NAME: s88b193bdr.dgn	CHECKED BY: H. SALLS
PROJECT LEADER: C. CARLSON	SHEET 69 OF 69
DESIGNED BY: G. ROY	
ROW LAYOUT 2	

N/F  
**MANCHESTER, HENRY K. & AMANDA**


**CONCRETE GENERAL NOTES**

1. ALL EXPOSED EDGES OF CONCRETE SHALL BE CHAMFERED 1" x 1"
2. REINFORCING STEEL SIZE AND SPACING SHOWN IN THE PLANS IS BASED ON 60 KSI STEEL, UNLESS NOTED OTHERWISE. WITH THE ENGINEER'S PERMISSION, BAR SIZE AND SPACING MAY BE MODIFIED ACCORDING TO THE LATEST AASHTO LRFD BRIDGE DESIGN SPECIFICATION AND STRUCTURES DESIGN MANUAL WHEN USING HIGHER STRENGTH STEEL.

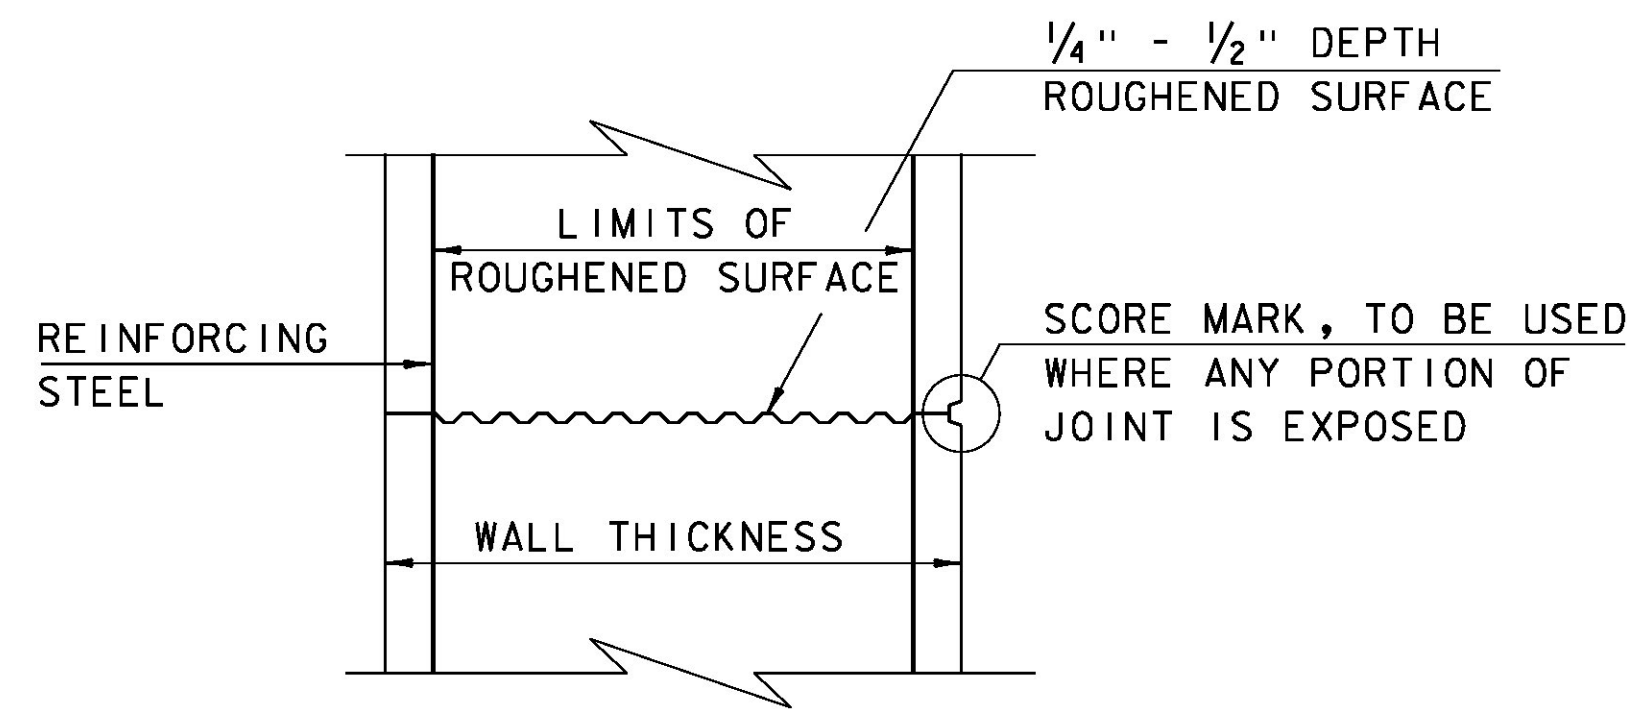


**TYPICAL HORIZONTAL CONSTRUCTION JOINT**  
(NOT TO SCALE)


1. THE SURFACE OF THE CONCRETE CONSTRUCTION JOINTS SHALL BE CLEANED AND FREE OF LAITANCE.
2. IMMEDIATELY BEFORE NEW CONCRETE IS PLACED, ALL CONSTRUCTION JOINTS SHALL BE WETTED AND STANDING WATER REMOVED.

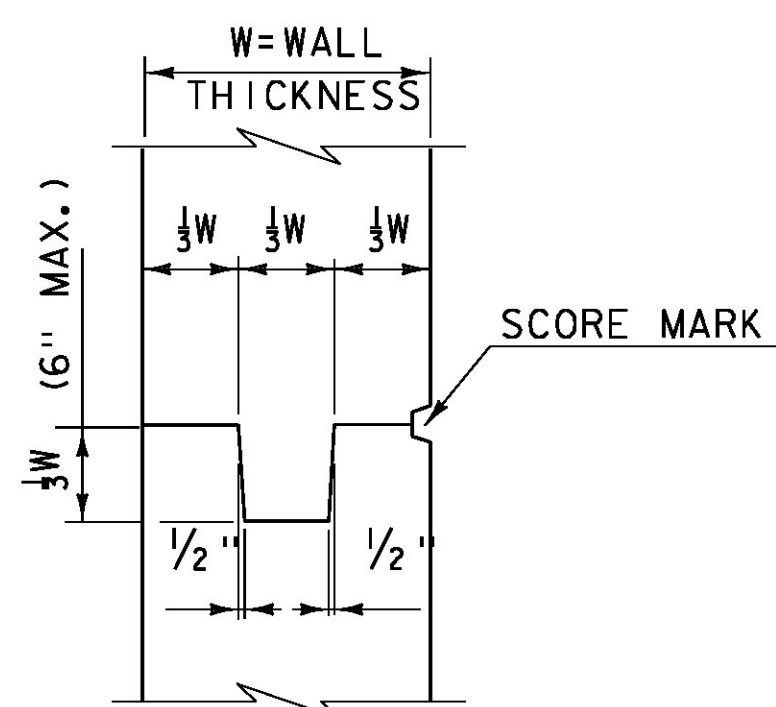


**TYPICAL CONCRETE CONSTRUCTION JOINT**  
(NOT TO SCALE)

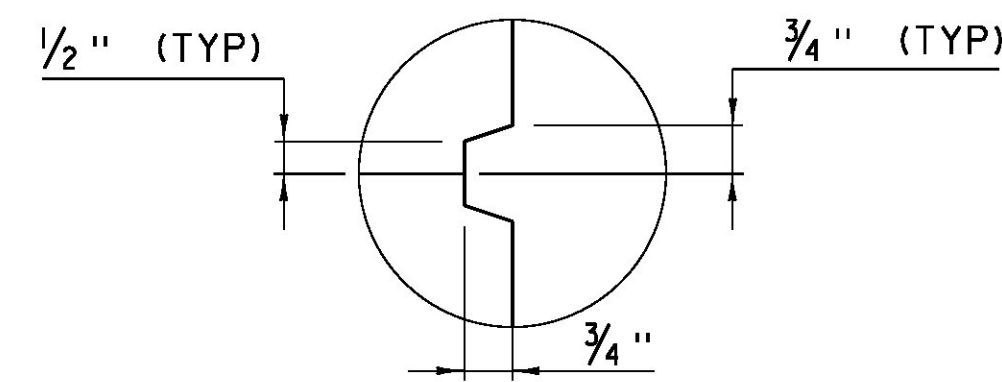


**SCORE MARK DETAIL**  
(NOT TO SCALE)

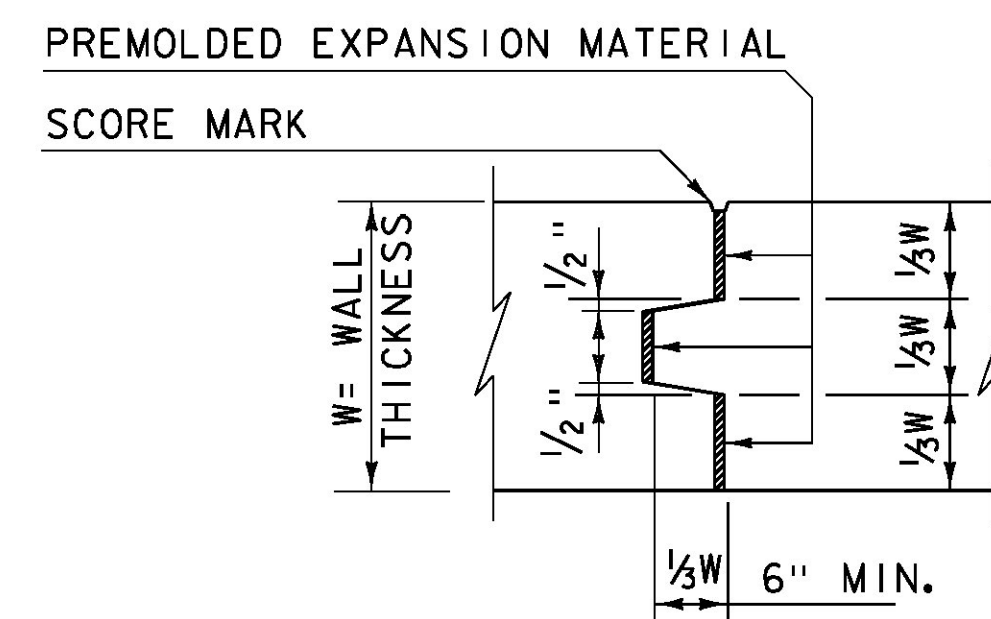

**TYPICAL CONCRETE EXPANSION JOINT**  
(NOT TO SCALE)

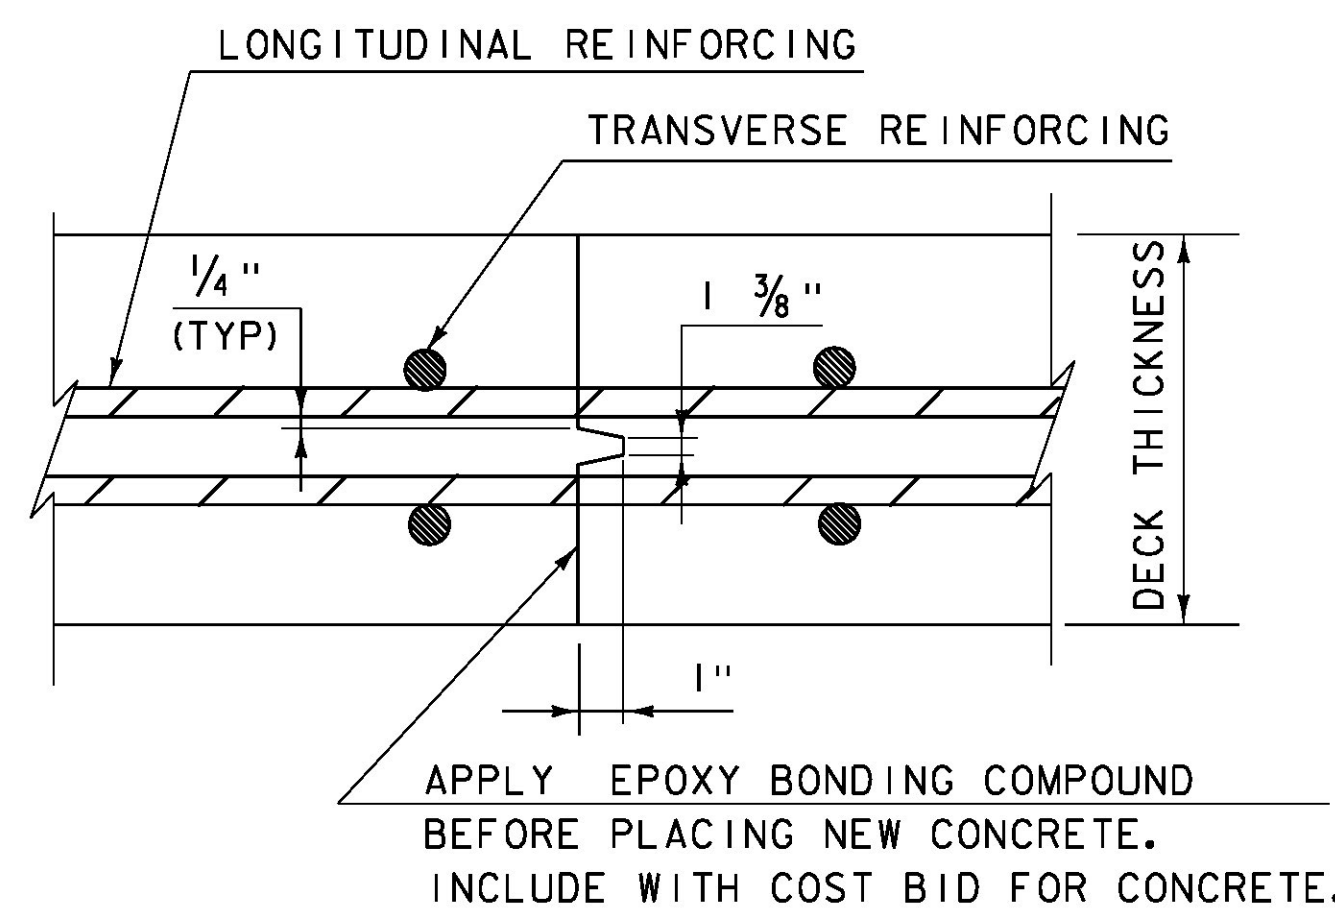


**TRANSVERSE BRIDGE SLAB CONSTRUCTION JOINT DETAILS**  
(NOT TO SCALE)

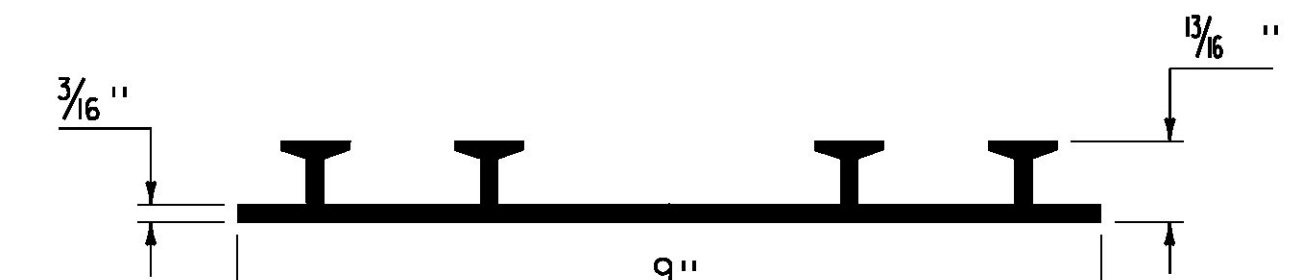

**P.V.C. WATERSTOP FOR CONSTRUCTION JOINTS**  
(NOT TO SCALE)

PAYMENT FOR THE P.V.C. WATERSTOP SHALL BE INCIDENTAL TO THE UNIT BID PRICE FOR THE ADJACENT CONCRETE.


OTHER CONFIGURATIONS OF WATERSTOP MAY BE USED UPON APPROVAL OF THE ENGINEER.

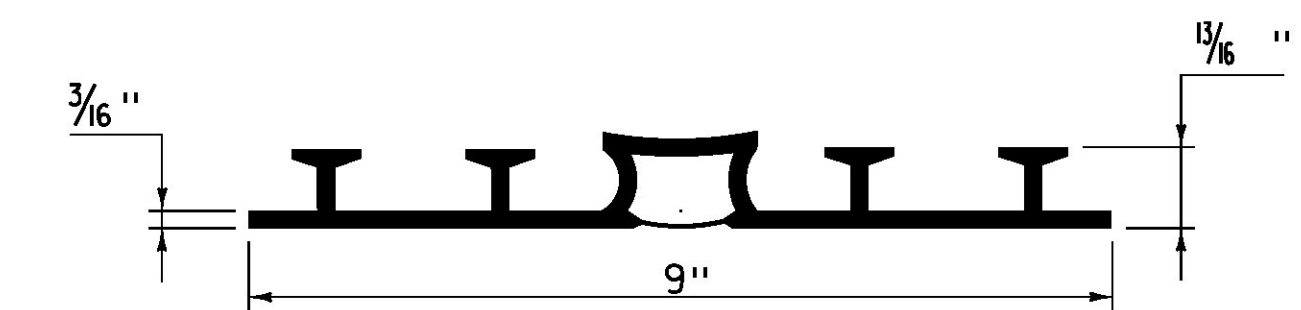

**P.V.C. WATERSTOP FOR EXPANSION JOINTS**  
(NOT TO SCALE)

PAYMENT FOR THE P.V.C. WATERSTOP SHALL BE INCIDENTAL TO THE UNIT BID PRICE FOR THE ADJACENT CONCRETE.

OTHER CONFIGURATIONS OF WATERSTOP MAY BE USED UPON APPROVAL OF THE ENGINEER.

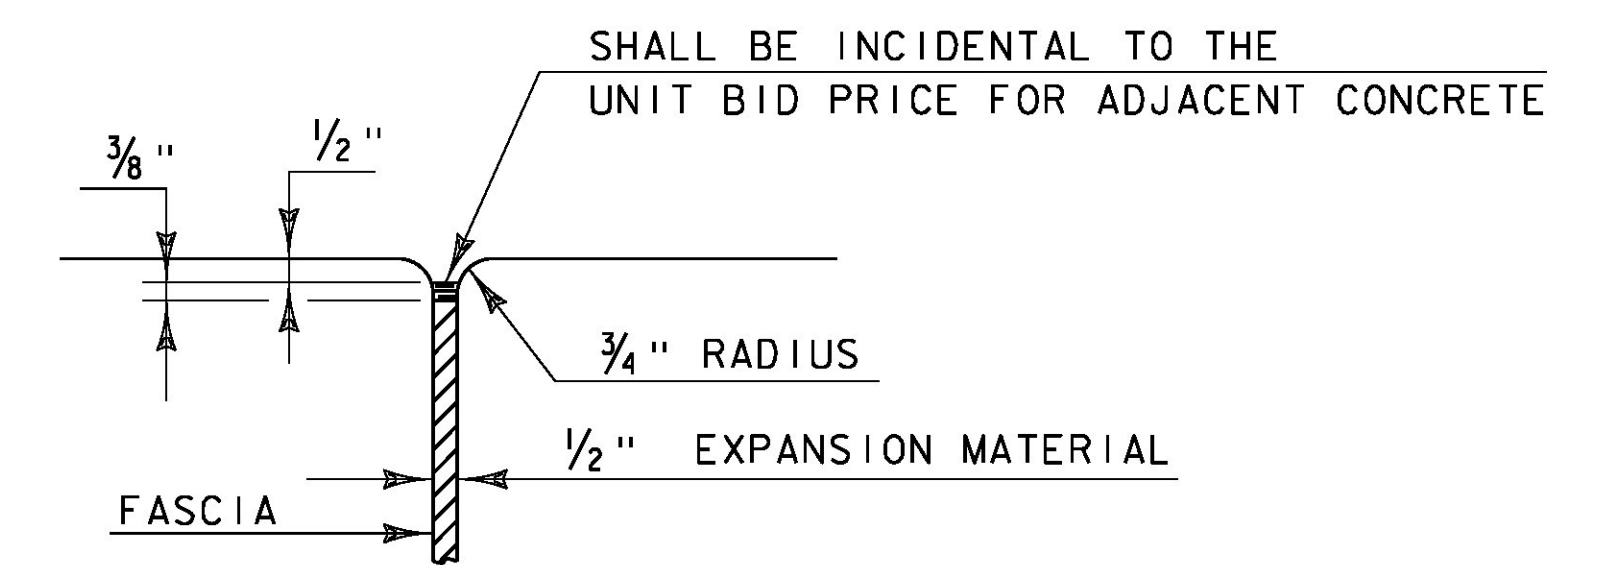


**JOINT BETWEEN FASCIA AND WINGWALL**  
(NOT TO SCALE)


**REVISIONS**

MAY 7, 2010	APPROVED FOR USE BY VAOT STRUCTURES SECTION
FEBRUARY 9, 2012	REBAR SUBSTITUTION ALLOWANCE ADDED TO CONCRETE GENERAL NOTES.


**CONCRETE  
DETAILS AND NOTES**

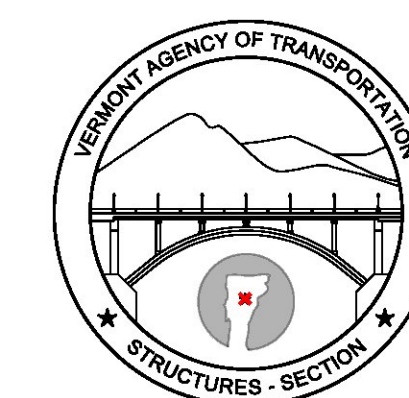



**STRUCTURES  
DETAIL  
SD-501.00**

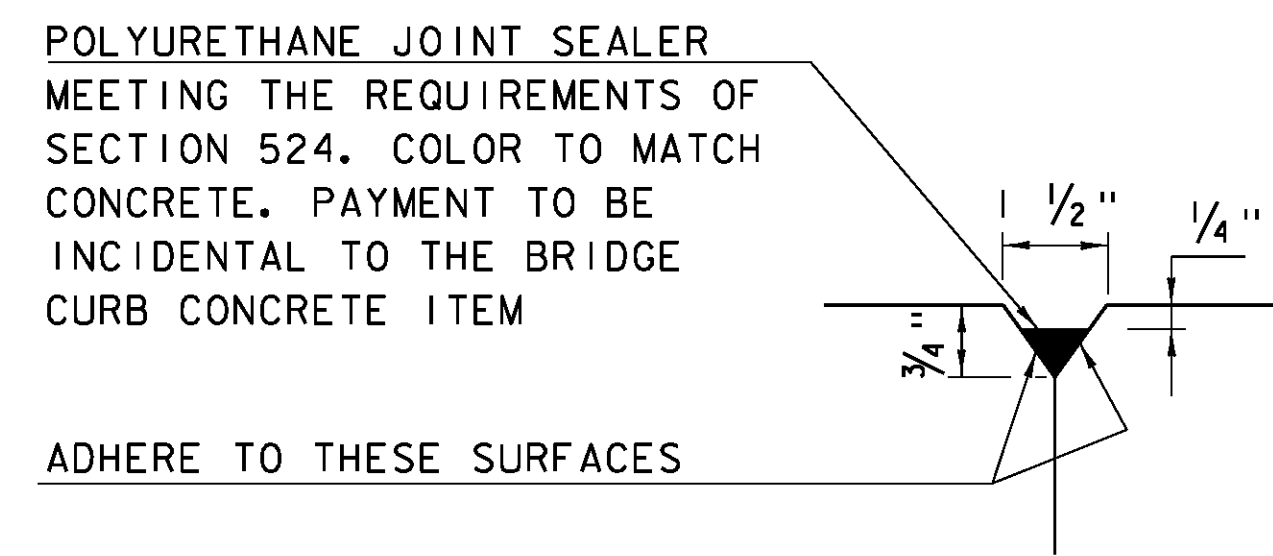

DETAIL "B"  
(NOT TO SCALE)

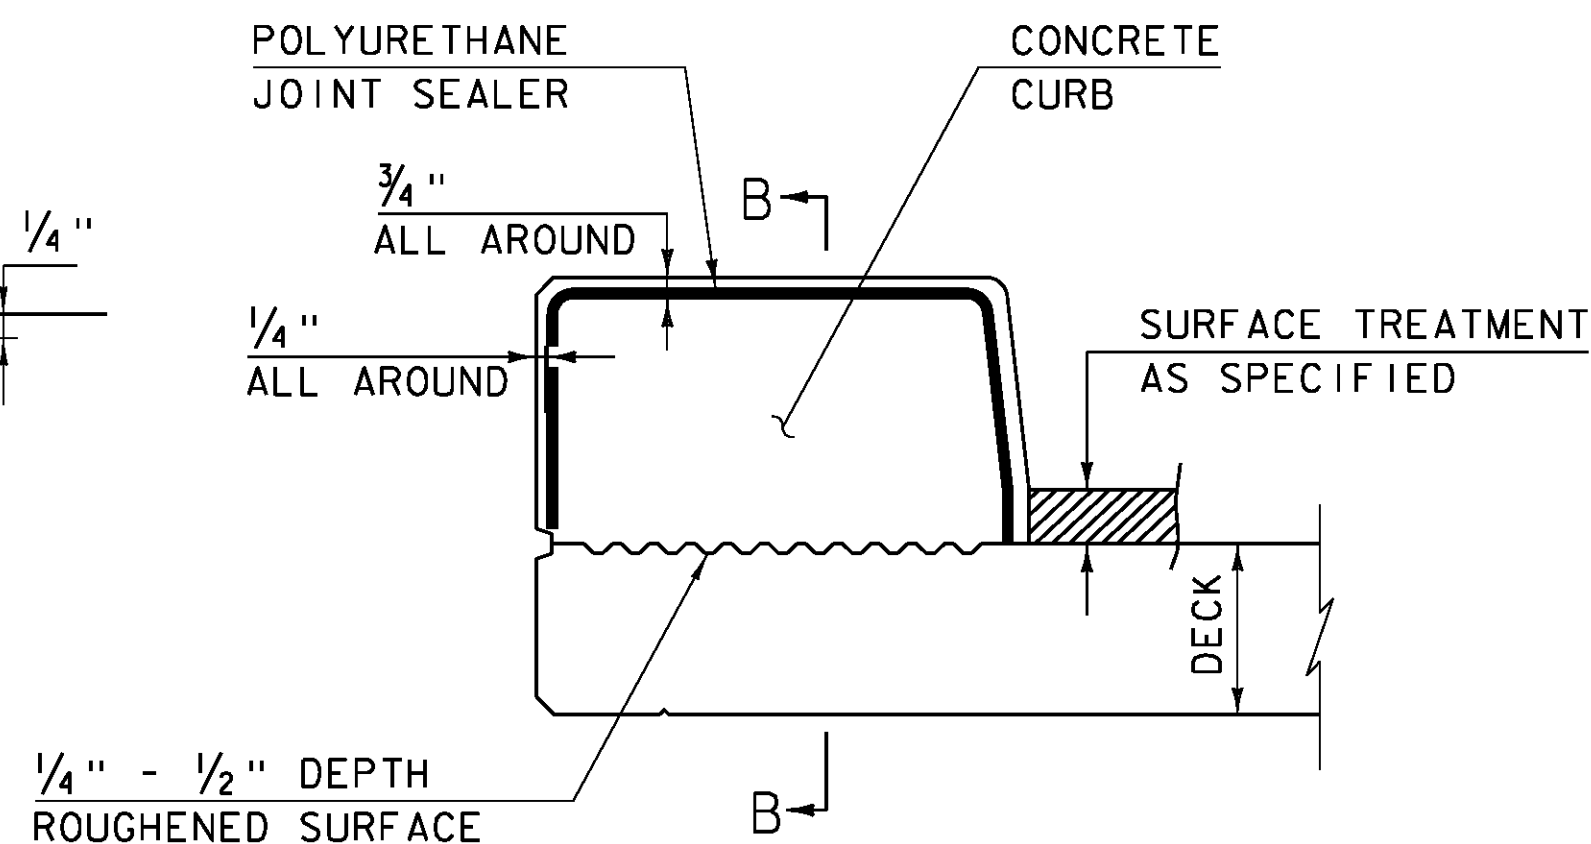


CONCRETE CURB JOINT SECTION  
(NOT TO SCALE)

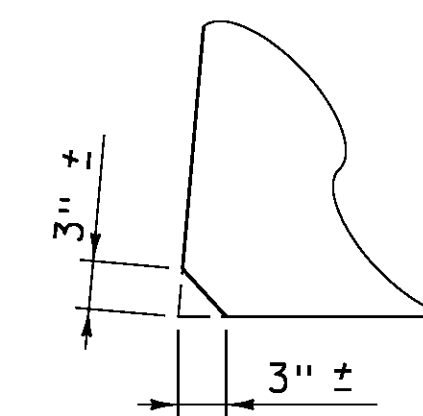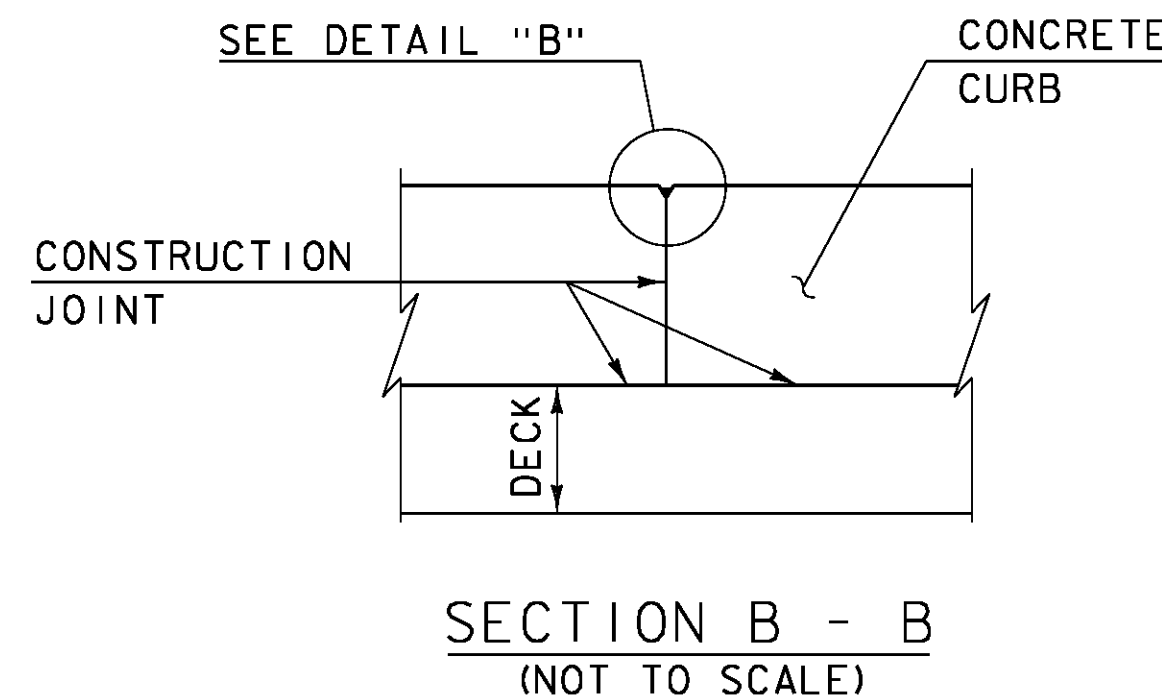


ACUTE ANGLE  
CLIP DETAIL  
(NOT TO SCALE)



1. SEE TYPICAL HORIZONTAL CONSTRUCTION JOINT DETAIL FOR ADDITIONAL INFORMATION

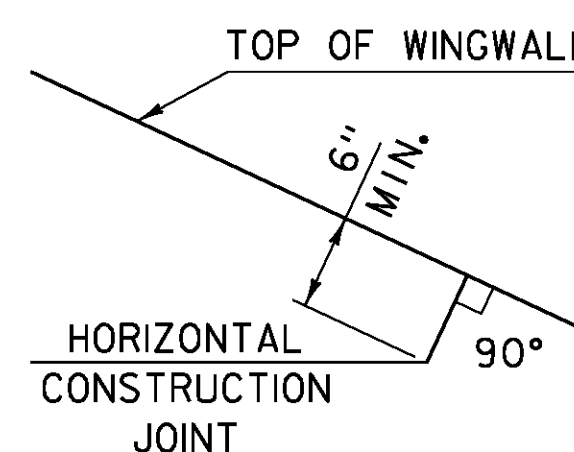

HORIZONTAL WINGWALL  
CONSTRUCTION JOINT  
(NOT TO SCALE)

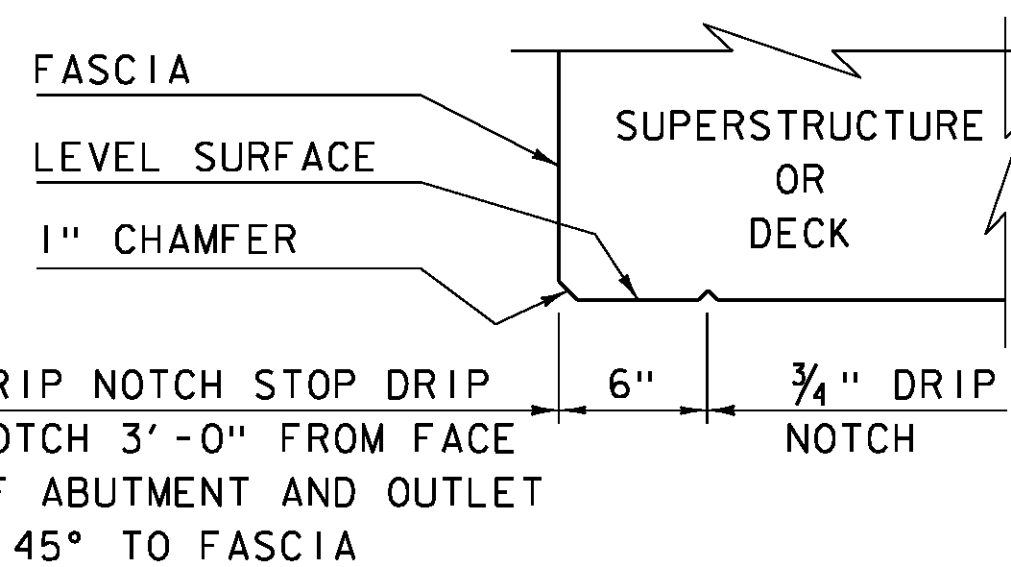

DRIP NOTCH DETAIL  
(NOT TO SCALE)

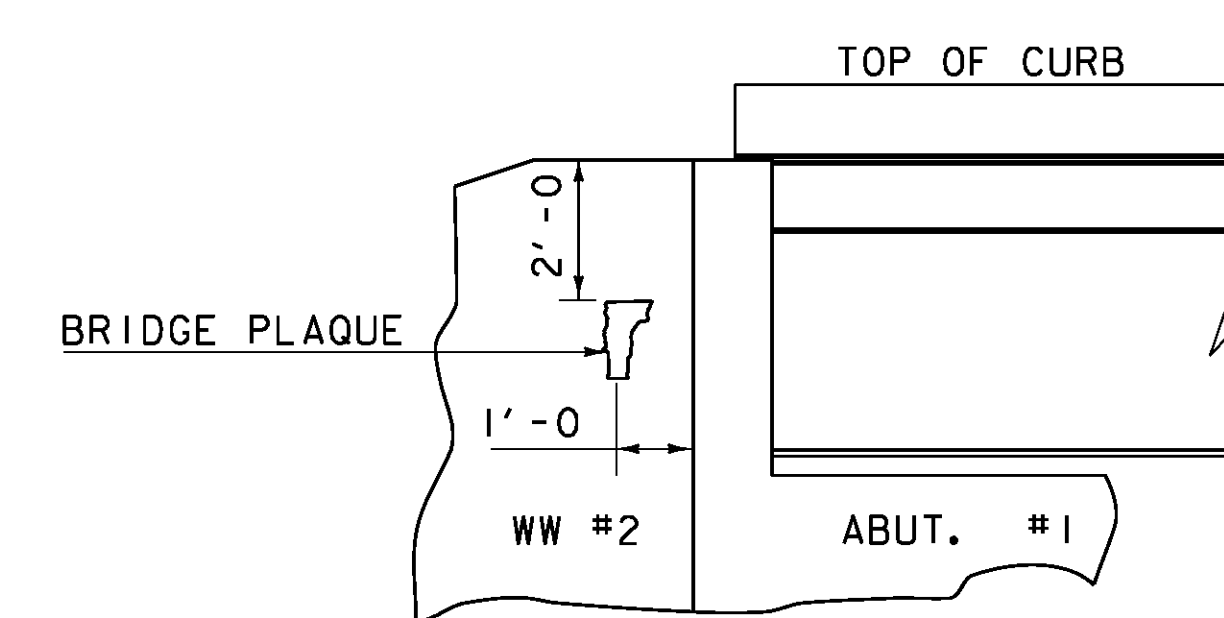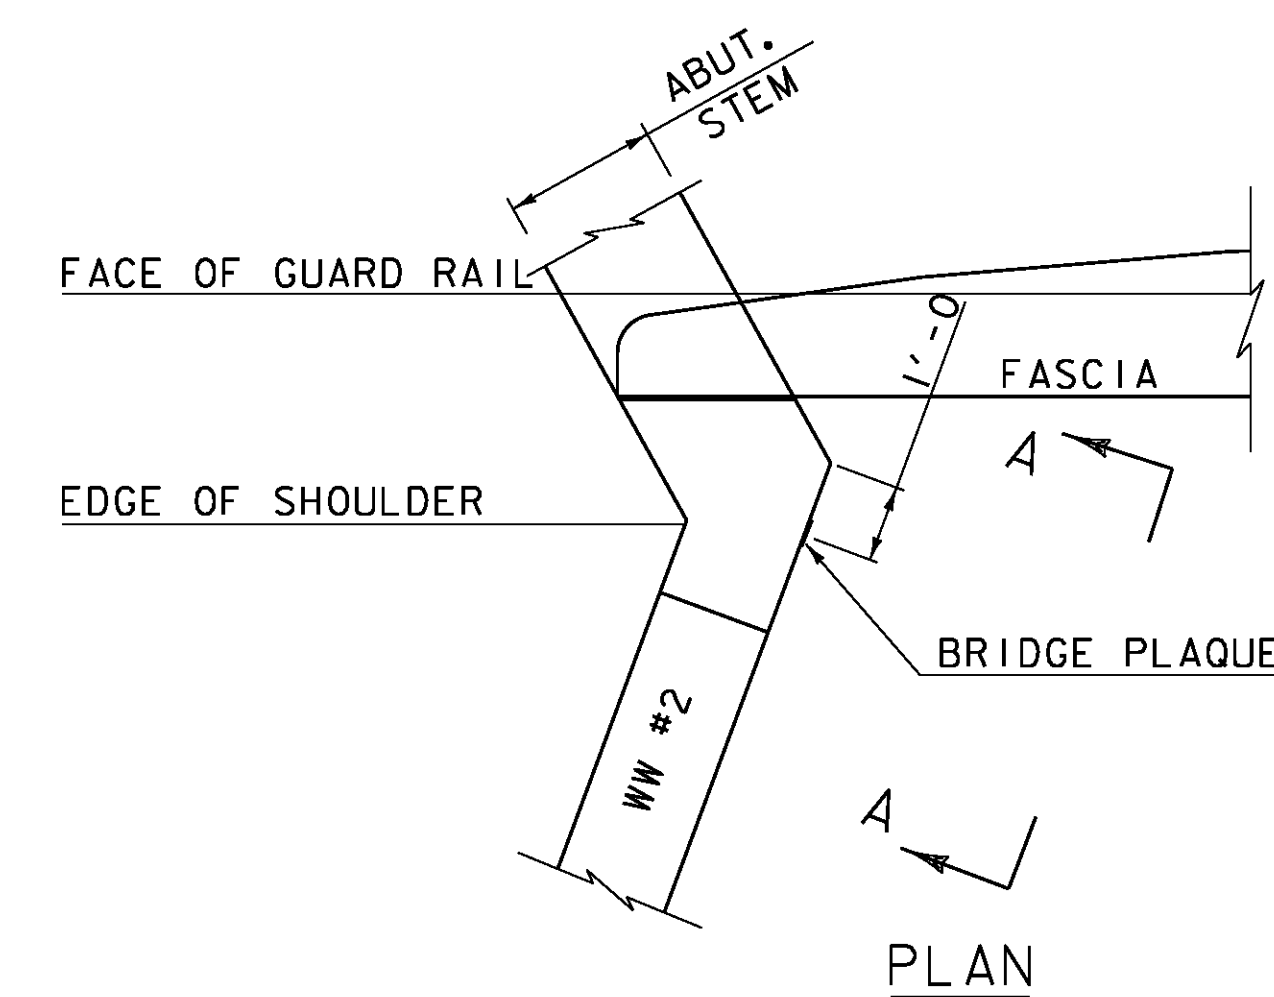

VIEW "A - A"  
BRIDGE PLAQUE  
(NOT TO SCALE)

THE BRIDGE PLAQUE WILL BE SUPPLIED BY THE AGENCY OF TRANSPORTATION AND SHALL BE INSTALLED BY THE CONTRACTOR AT ABUTMENT #1 ON THE RIGHT SIDE AS SHOWN OR AS DIRECTED BY THE ENGINEER.

PAYMENT FOR INSTALLATION OF THE BRIDGE PLAQUE SHALL BE INCIDENTAL TO THE ADJACENT CONCRETE.


CONCRETE CURB JOINT NOTES

1. CONCRETE CURBS MAY BE PLACED IN ONE CONTINUOUS OPERATION IF AN APPROVED SHRINKAGE REDUCING ADMIXTURE LISTED IN THE SPECIAL PROVISIONS IS USED WITH THE CONCRETE MIX DESIGN. PAYMENT FOR THE SHRINKAGE REDUCING ADMIXTURE WILL BE INCIDENTAL TO THE BRIDGE CURB CONCRETE ITEM.
2. IF THE CONTRACTOR CHOOSES NOT TO USE AN APPROVED SHRINKAGE REDUCING ADMIXTURE, THE CURBS SHALL BE CONSTRUCTED WITH CONSTRUCTION JOINTS SPACED AT A MAXIMUM OF 15'-0" CENTER TO CENTER AND 2'-0" MINIMUM FROM THE CENTER OF NEAREST BRIDGE RAILING POST.
3. ON MULTI-SPAN CONTINUOUS SUPERSTRUCTURES, REGARDLESS OF WHETHER APPROVED SHRINKAGE REDUCING ADMIXTURE IS USED, CURB JOINTS SHALL BE LOCATED OVER THE CENTERLINE OF PIERS AND 7'-0" EACH SIDE OF THE CENTERLINE OF EACH PIER.
4. WHEN CURB JOINTS ARE USED THE CURBS SHALL BE PLACED IN ALTERNATE SECTIONS WITH A MINIMUM OF 48 HOUR DELAY BETWEEN ADJACENT PLACEMENTS.
5. LONGITUDINAL REINFORCING SHALL BE CONTINUOUS THROUGH CURB CONSTRUCTION JOINTS. CURB STIRRUP BARS SHALL BE TURNED AS NECESSARY TO MAINTAIN COVER IN THE FLARED CURB ENDS.
6. THE JOINT SPACING AND DETAILS SHOWN SHALL APPLY TO SIDEWALKS WHEN SHOWN IN THE PLANS.


REVISIONS

MAY 7, 2010	APPROVED FOR USE BY VAOT STRUCTURES SECTION
JUNE 4, 2010	MODIFIED AND ADDED TWO DETAILS
OCTOBER 10, 2012	MODIFIED HORZ. JOINT WINGWALL ADD 6" MIN. DIMENSION

CONCRETE  
DETAILS AND NOTES

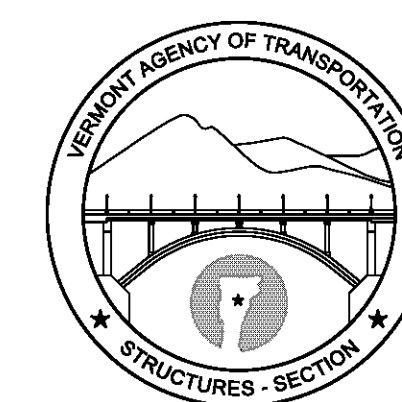


STRUCTURES  
DETAIL  
SD-502.00

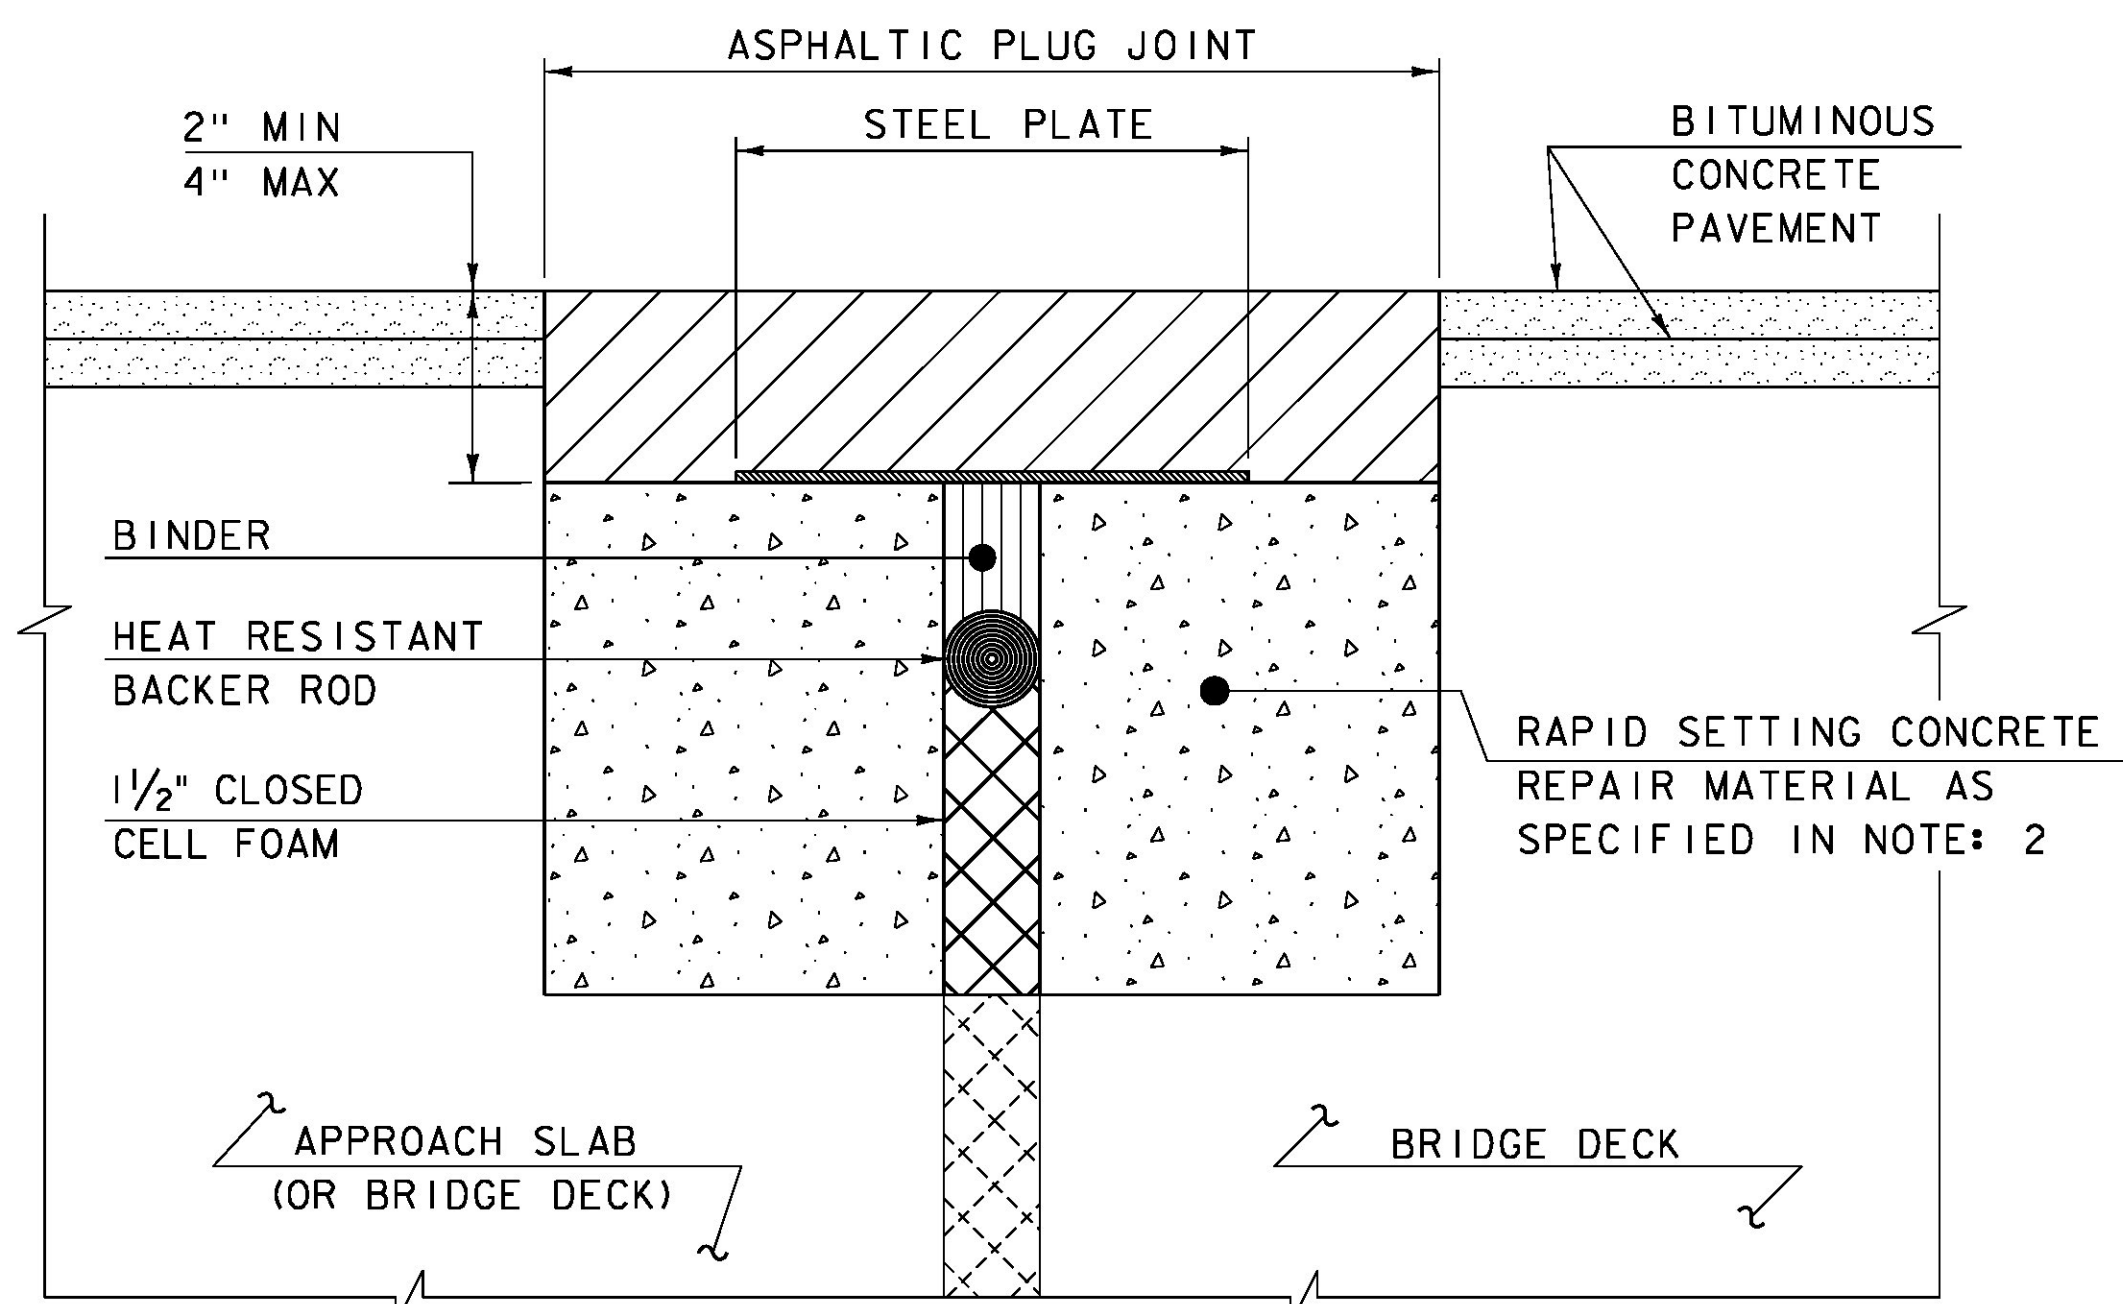

**ASPHALTIC PLUG JOINT DETAIL - REHAB**

**NOTES:**


1. THE CONTRACTOR SHALL REMOVE ALL ASPHALTIC PLUG JOINT MATERIAL AND DETERIORATED CONCRETE AS DIRECTED BY THE ENGINEER. REMOVAL OF THE FIRST 4 INCHES OF MATERIAL SHALL BE INCLUDED IN THE BID PRICE FOR ITEM 516.10 BRIDGE EXPANSION JOINT, ASPHALTIC PLUG. ANY REMOVAL OF MATERIAL GREATER THAN 4 INCHES SHALL BE INCLUDED IN THE BID PRICE OF ITEM 580.20 RAPID SETTING CONCRETE REPAIR MATERIAL WITH COARSE AGGREGATE.
2. THE CONTRACTOR SHALL REPLACE REMOVED MATERIAL THAT IS LESS THAN 4" FROM FINISHED GRADE WITH ASPHALTIC PLUG JOINT MATERIAL MEETING THE REQUIREMENTS OF SUBSECTION 707.15. ALL REMOVED MATERIAL THAT IS GREATER THAN 4 INCHES FROM FINISHED GRADE SHALL BE REPLACED WITH RAPID SETTING CONCRETE REPAIR MATERIAL WITH COARSE AGGREGATE MEETING THE REQUIREMENTS OF SUBSECTION 780.04.
3. REINFORCING STEEL NOT SHOWN FOR CLARITY.
4. PLACE 1/4" THICK BY 8" WIDE SECTIONS OF STEEL PLATE OVER THE CENTER OF THE MOVEMENT GAP. SECURE THE PLATES FROM MOVING BY INSERTING LOCATING PINS THROUGH THE PRE-STAMPED HOLES INTO BACKER ROD AND COVER WITH HOT BINDER. THE STEEL PLATES MAY BE OMITTED WHERE THE ENGINEER DETERMINES THAT THE APPROACH SLAB OR BRIDGE DECK WILL PROVIDE INADEQUATE SUPPORT AND WHERE VERTICAL MOVEMENT OF THE PLATES MIGHT OCCUR.

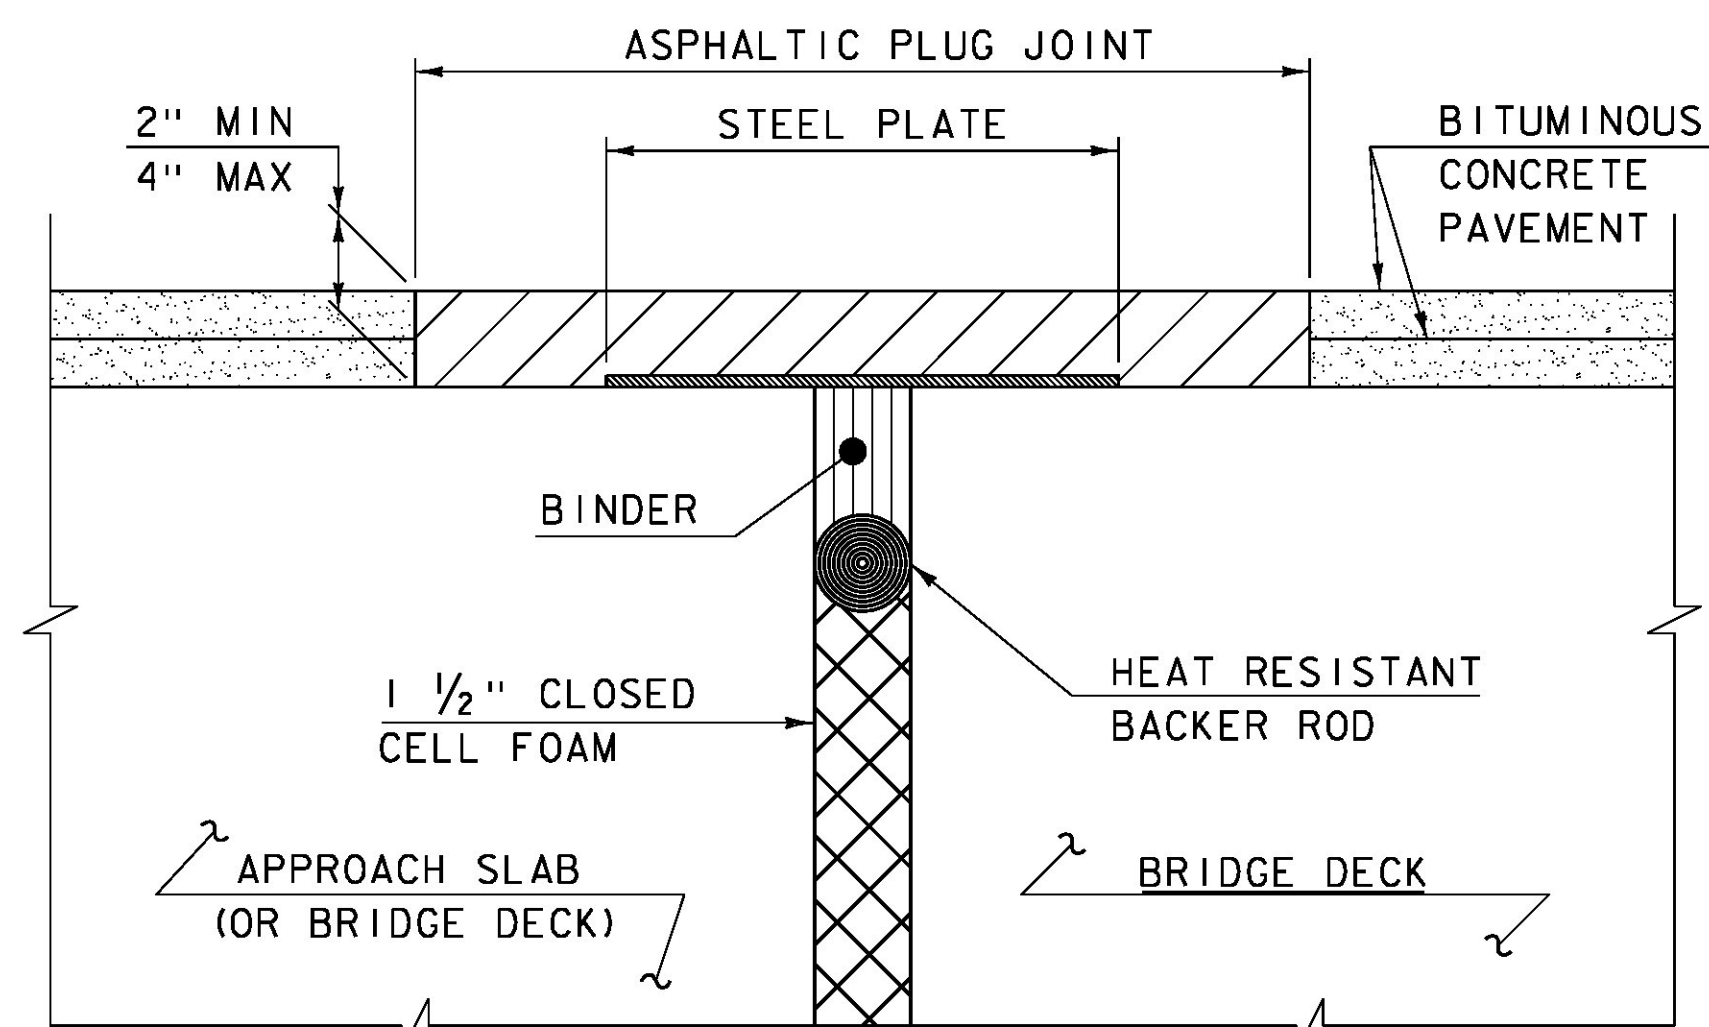

**ASPHALTIC PLUG JOINT DETAIL "A" - NEW**

**NOTE:**

PLACE 1/4" THICK BY 8" WIDE SECTIONS OF STEEL PLATE OVER THE CENTER OF THE MOVEMENT GAP. SECURE THE PLATES FROM MOVING BY INSERTING LOCATING PINS THROUGH THE PRE-STAMPED HOLES INTO BACKER ROD AND COVER WITH HOT BINDER.

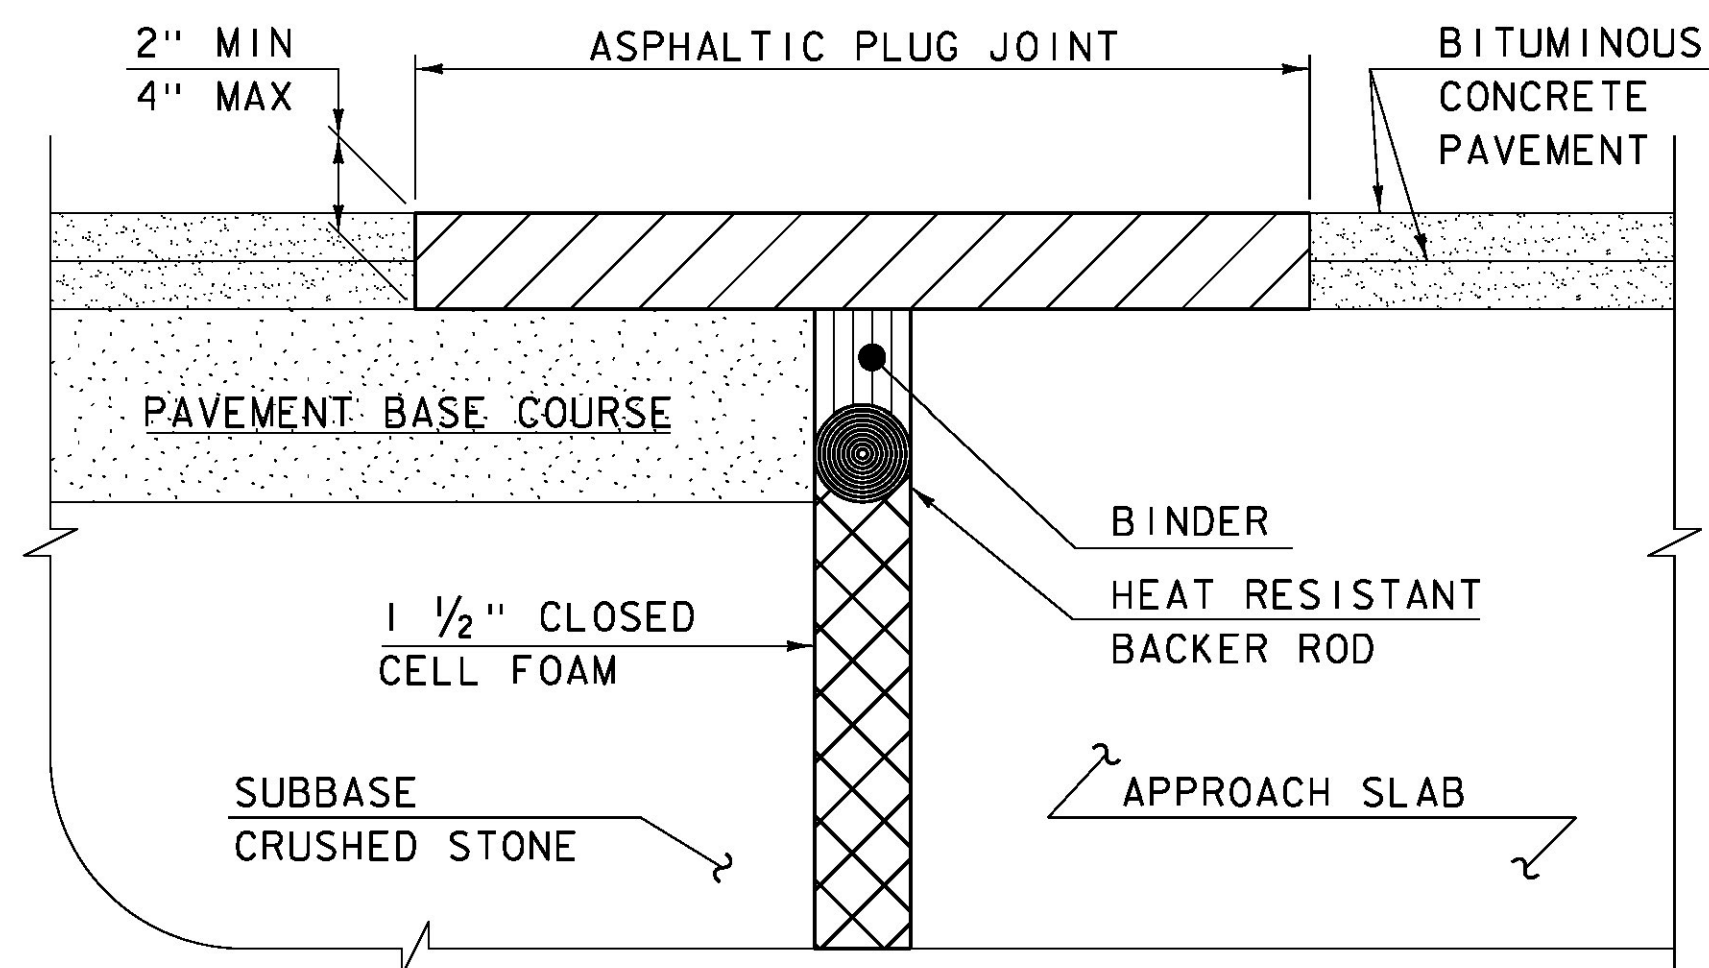

**ASPHALTIC PLUG JOINT DETAIL "B" - NEW**

**ASPHALTIC PLUG JOINT NOTES**

**INSTALLATION:**

1. LOCATE THE JOINT CENTRALLY OVER THE DECK OVERLAY EXPANSION GAP OR FIXED JOINT, MARKED OUT TO THE MANUFACTURER'S RECOMMENDED WIDTH.
2. REMOVE THE BITUMINOUS CONCRETE PAVEMENT FULL DEPTH AS SHOWN ON THE PLANS. THE PAVEMENT SHALL BE DRY AND SAW CUT TO THE LIMITS REQUIRED TO PLACE THE JOINT. A PNEUMATIC HAMMER AND CHISEL MAY BE USED ADJACENT TO THE CURB ONLY WHEN SAW CUTTING IS NOT POSSIBLE.
3. BLAST CLEAN THE JOINT AREA OF DEBRIS, ASPHALT AND SHEET MEMBRANE. THOROUGHLY DRY THE JOINT AREA WITH COMPRESSED AIR PRIOR TO APPLYING BINDER MATERIAL.
4. PLACE PROPERLY SIZED HEAT RESISTANT BACKER ROD IN THE MOVEMENT GAP ALLOWING FOR 1" +/- OF BINDER ABOVE THE ROD.
5. HEAT AND PLACE THE BINDER MATERIAL AS RECOMMENDED BY THE MANUFACTURER.
6. IMMEDIATELY AFTER TOP COATING, CAST AN ANTI-SKID MATERIAL OVER THE JOINT TO REDUCE THE RISK OF TRACKING.

**WEATHER LIMITATIONS**


APPLY BINDER MATERIAL ONLY WHEN THE FOLLOWING CONDITIONS PREVAIL OR AS RECOMMENDED BY THE MANUFACTURER:

1. THE AMBIENT AIR TEMPERATURE IS AT LEAST 10 DEG C (50 DEG F) AND RISING.
2. THE ROAD SURFACE IS DRY.
3. WEATHER CONDITIONS OR OTHER CONDITIONS ARE FAVORABLE AND ARE EXPECTED TO REMAIN SO FOR THE PERFORMANCE OF SATISFACTORY WORK.

DETAILS ON THIS SHEET ARE NOT TO SCALE.

REVISIONS	
MAY 7, 2010	APPROVED FOR USE BY VAOT STRUCTURES SECTION
AUGUST 29, 2011	ADD DETAIL "B" AND REV. NOTES


**BRIDGE JOINT  
ASPHALTIC PLUG**

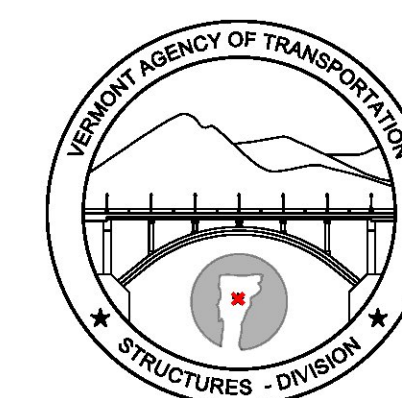

**STRUCTURES  
DETAIL  
SD-516.10**

**STRUCTURAL STEEL GENERAL NOTES:**


1. ALL FIELD CONNECTIONS SHALL BE MADE WITH 7/8" DIAMETER HIGH-STRENGTH BOLTS IN 15/16" DIAMETER HOLES, PER SUBSECTION 506.I9, UNLESS OTHERWISE SPECIFIED.
2. ALL HOLES IN THE WEBS OF THE FASCIA GIRDERS THAT ARE NOT OTHERWISE FILLED, SHALL BE FILLED WITH EITHER BUTTON HEAD OR HEX HEAD BOLTS. THESE BOLTS SHALL BE TIGHTENED IN ACCORDANCE WITH SUBSECTION 506.I9.
3. ALL WELDING SHALL CONFORM TO THE PROVISIONS OF SUBSECTION 506.I0.
4. ANY CONNECTIONS THAT ARE NOT DETAILED ON THE PLANS SHALL BE DETAILED BY THE FABRICATOR AND SUBMITTED TO THE STRUCTURES ENGINEER FOR APPROVAL.
5. STRUCTURAL STEEL MEMBERS DESIGNATED "CVN" IN THE PLANS SHALL BE CHARPY V-NOTCH TESTED IN ACCORDANCE WITH SUBSECTION 714.01 OF THE STANDARD SPECIFICATIONS.
6. ENDS OF GIRDERS ARE TO BE VERTICAL IN THEIR FINAL POSITION.
7. AFTER SUPERSTRUCTURE STEEL HAS BEEN ERECTED, ELEVATIONS ALONG THE TOP OF THE GIRDERS SHALL BE TAKEN AS DIRECTED BY THE RESIDENT ENGINEER FOR USE IN DETERMINING FINISHED GRADES.

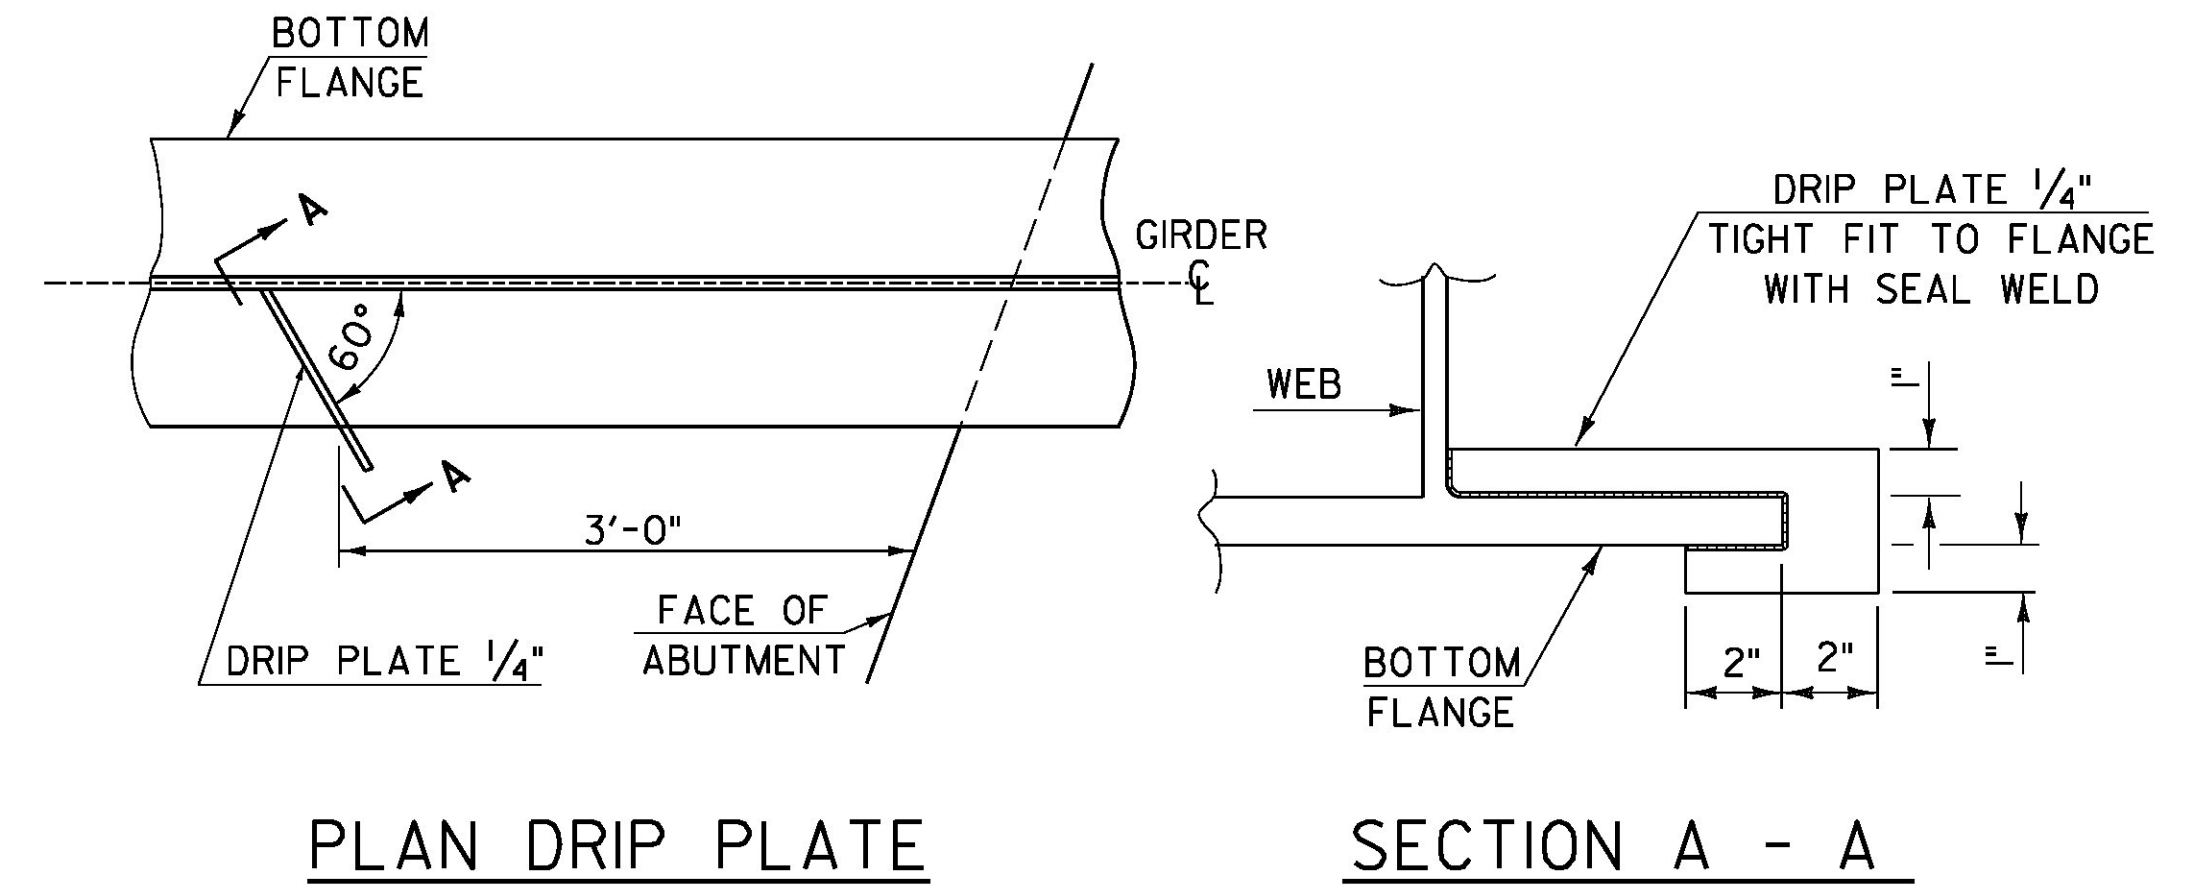

**PLAN DRIP PLATE**


**SECTION A - A**

NOTE: DRIP PLATES SHALL BE PLACED ON OUTSIDE EDGE OF FASCIA GIRDERS ON THE HIGH SIDE OF ALL PIERS AND ABUTMENTS OR AS INDICATED ON PROJECT PLANS.

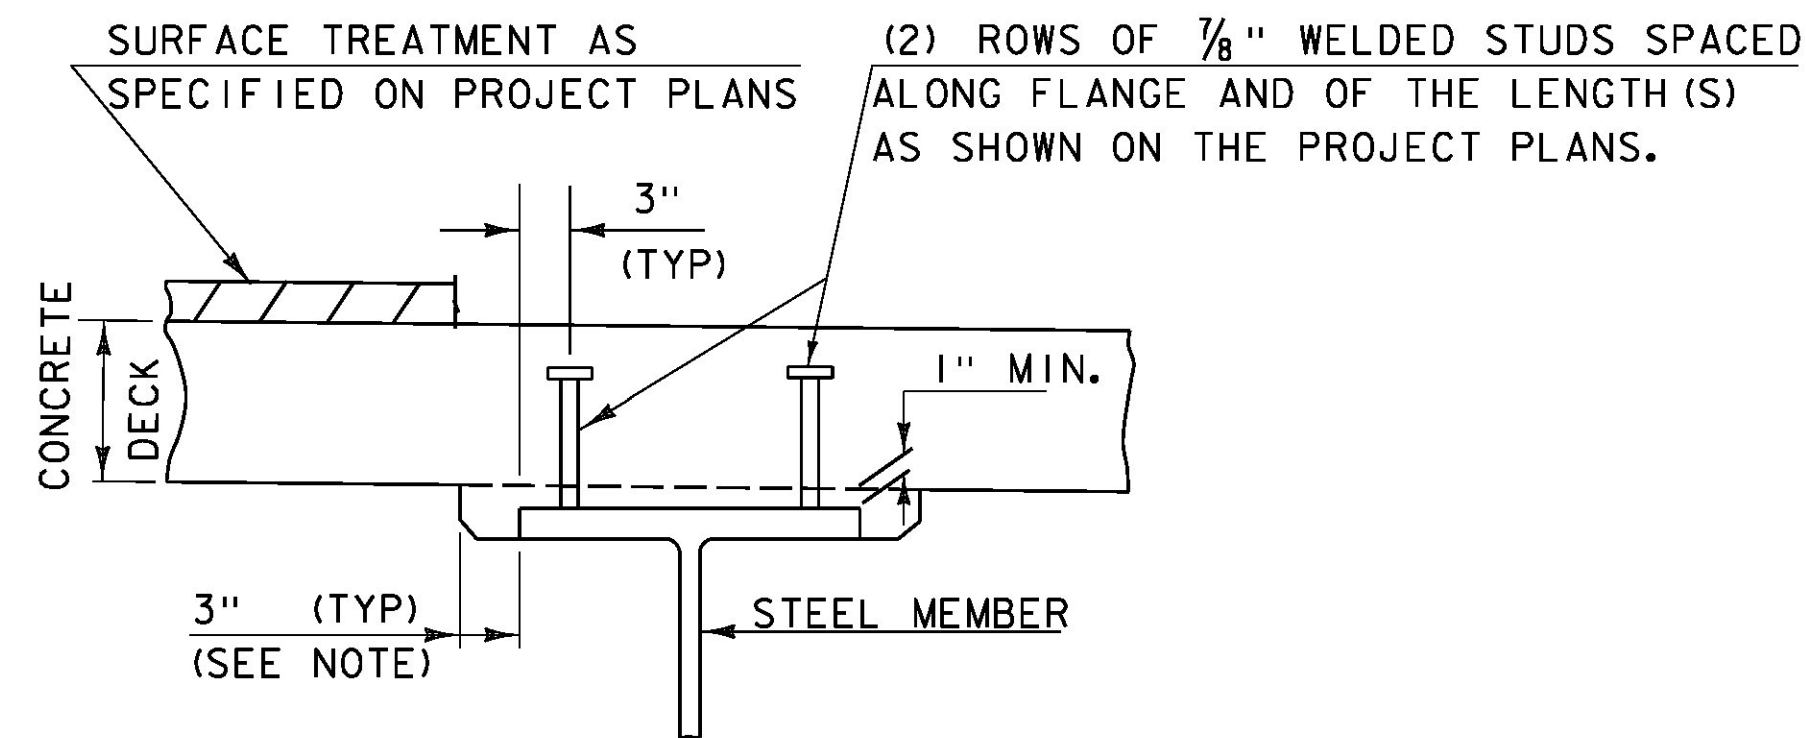

NOTE:  
THE 3" HORIZONTAL SECTION MAY BE ELIMINATED FOR FORMING SYSTEMS DESIGNED FOR THE CONSTRUCTION OF VERTICAL HAUNCHES. ANY VOIDS RESULTING FROM FORMING SYSTEM ELEMENTS SHALL BE FILLED WITH JOINT SEALER, POLYURETHANE MEETING THE REQUIREMENTS OF SECTION 524. THE COST OF THE JOINT SEALER, POLYURETHANE SHALL BE INCIDENTAL TO THE ADJACENT CONCRETE.


**HAUNCH AND SHEAR CONNECTOR DETAIL**

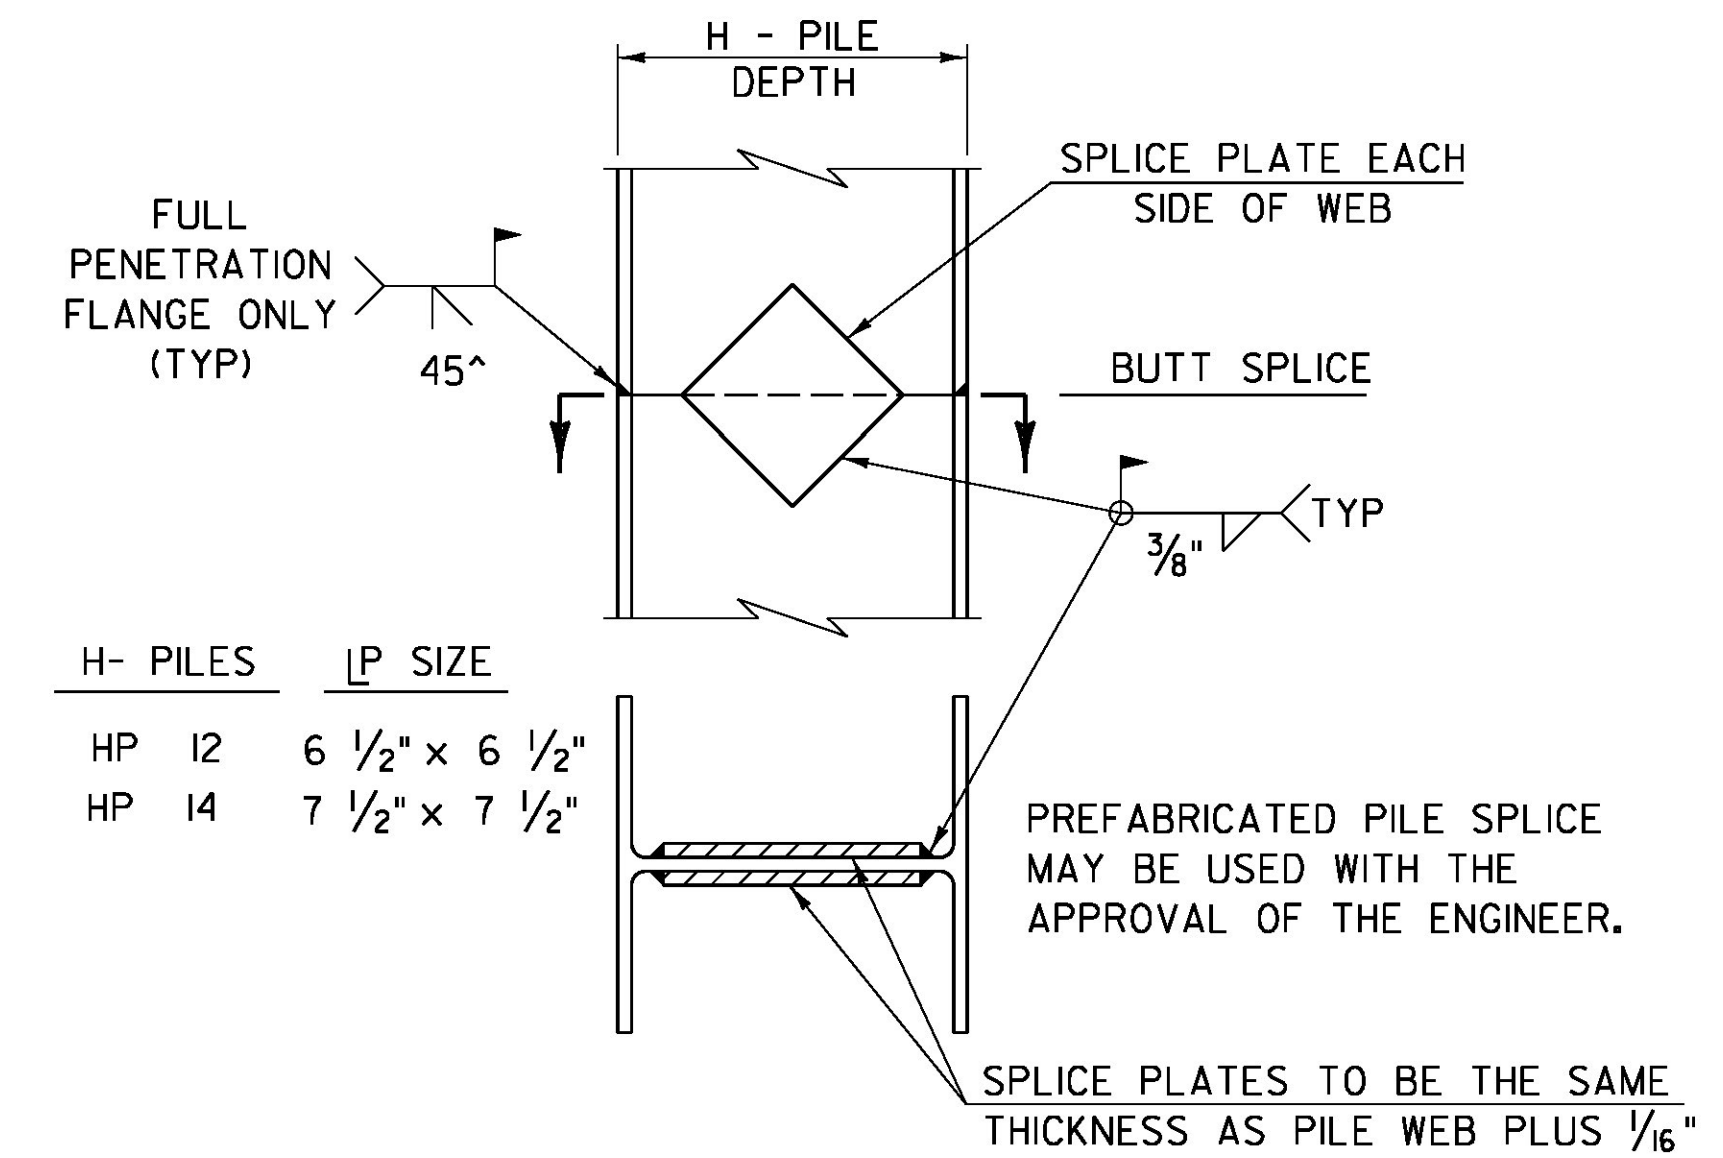

**DETAIL OF PILE SPLICE**


DETAILS ON THIS SHEET ARE "NOT TO SCALE" UNLESS NOTED OTHERWISE.

**STRUCTURAL STEEL  
DETAILS & NOTES**

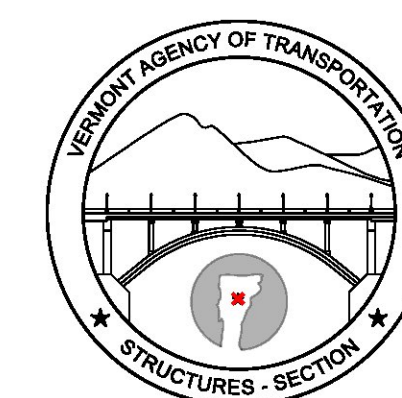

**STRUCTURES  
DETAIL  
SD-601.00**

REVISIONS	
MAY 7, 2010	APPROVED FOR USE BY VAOT STRUCTURES SECTION
JUNE 4, 2010	MODIFIED NOTES

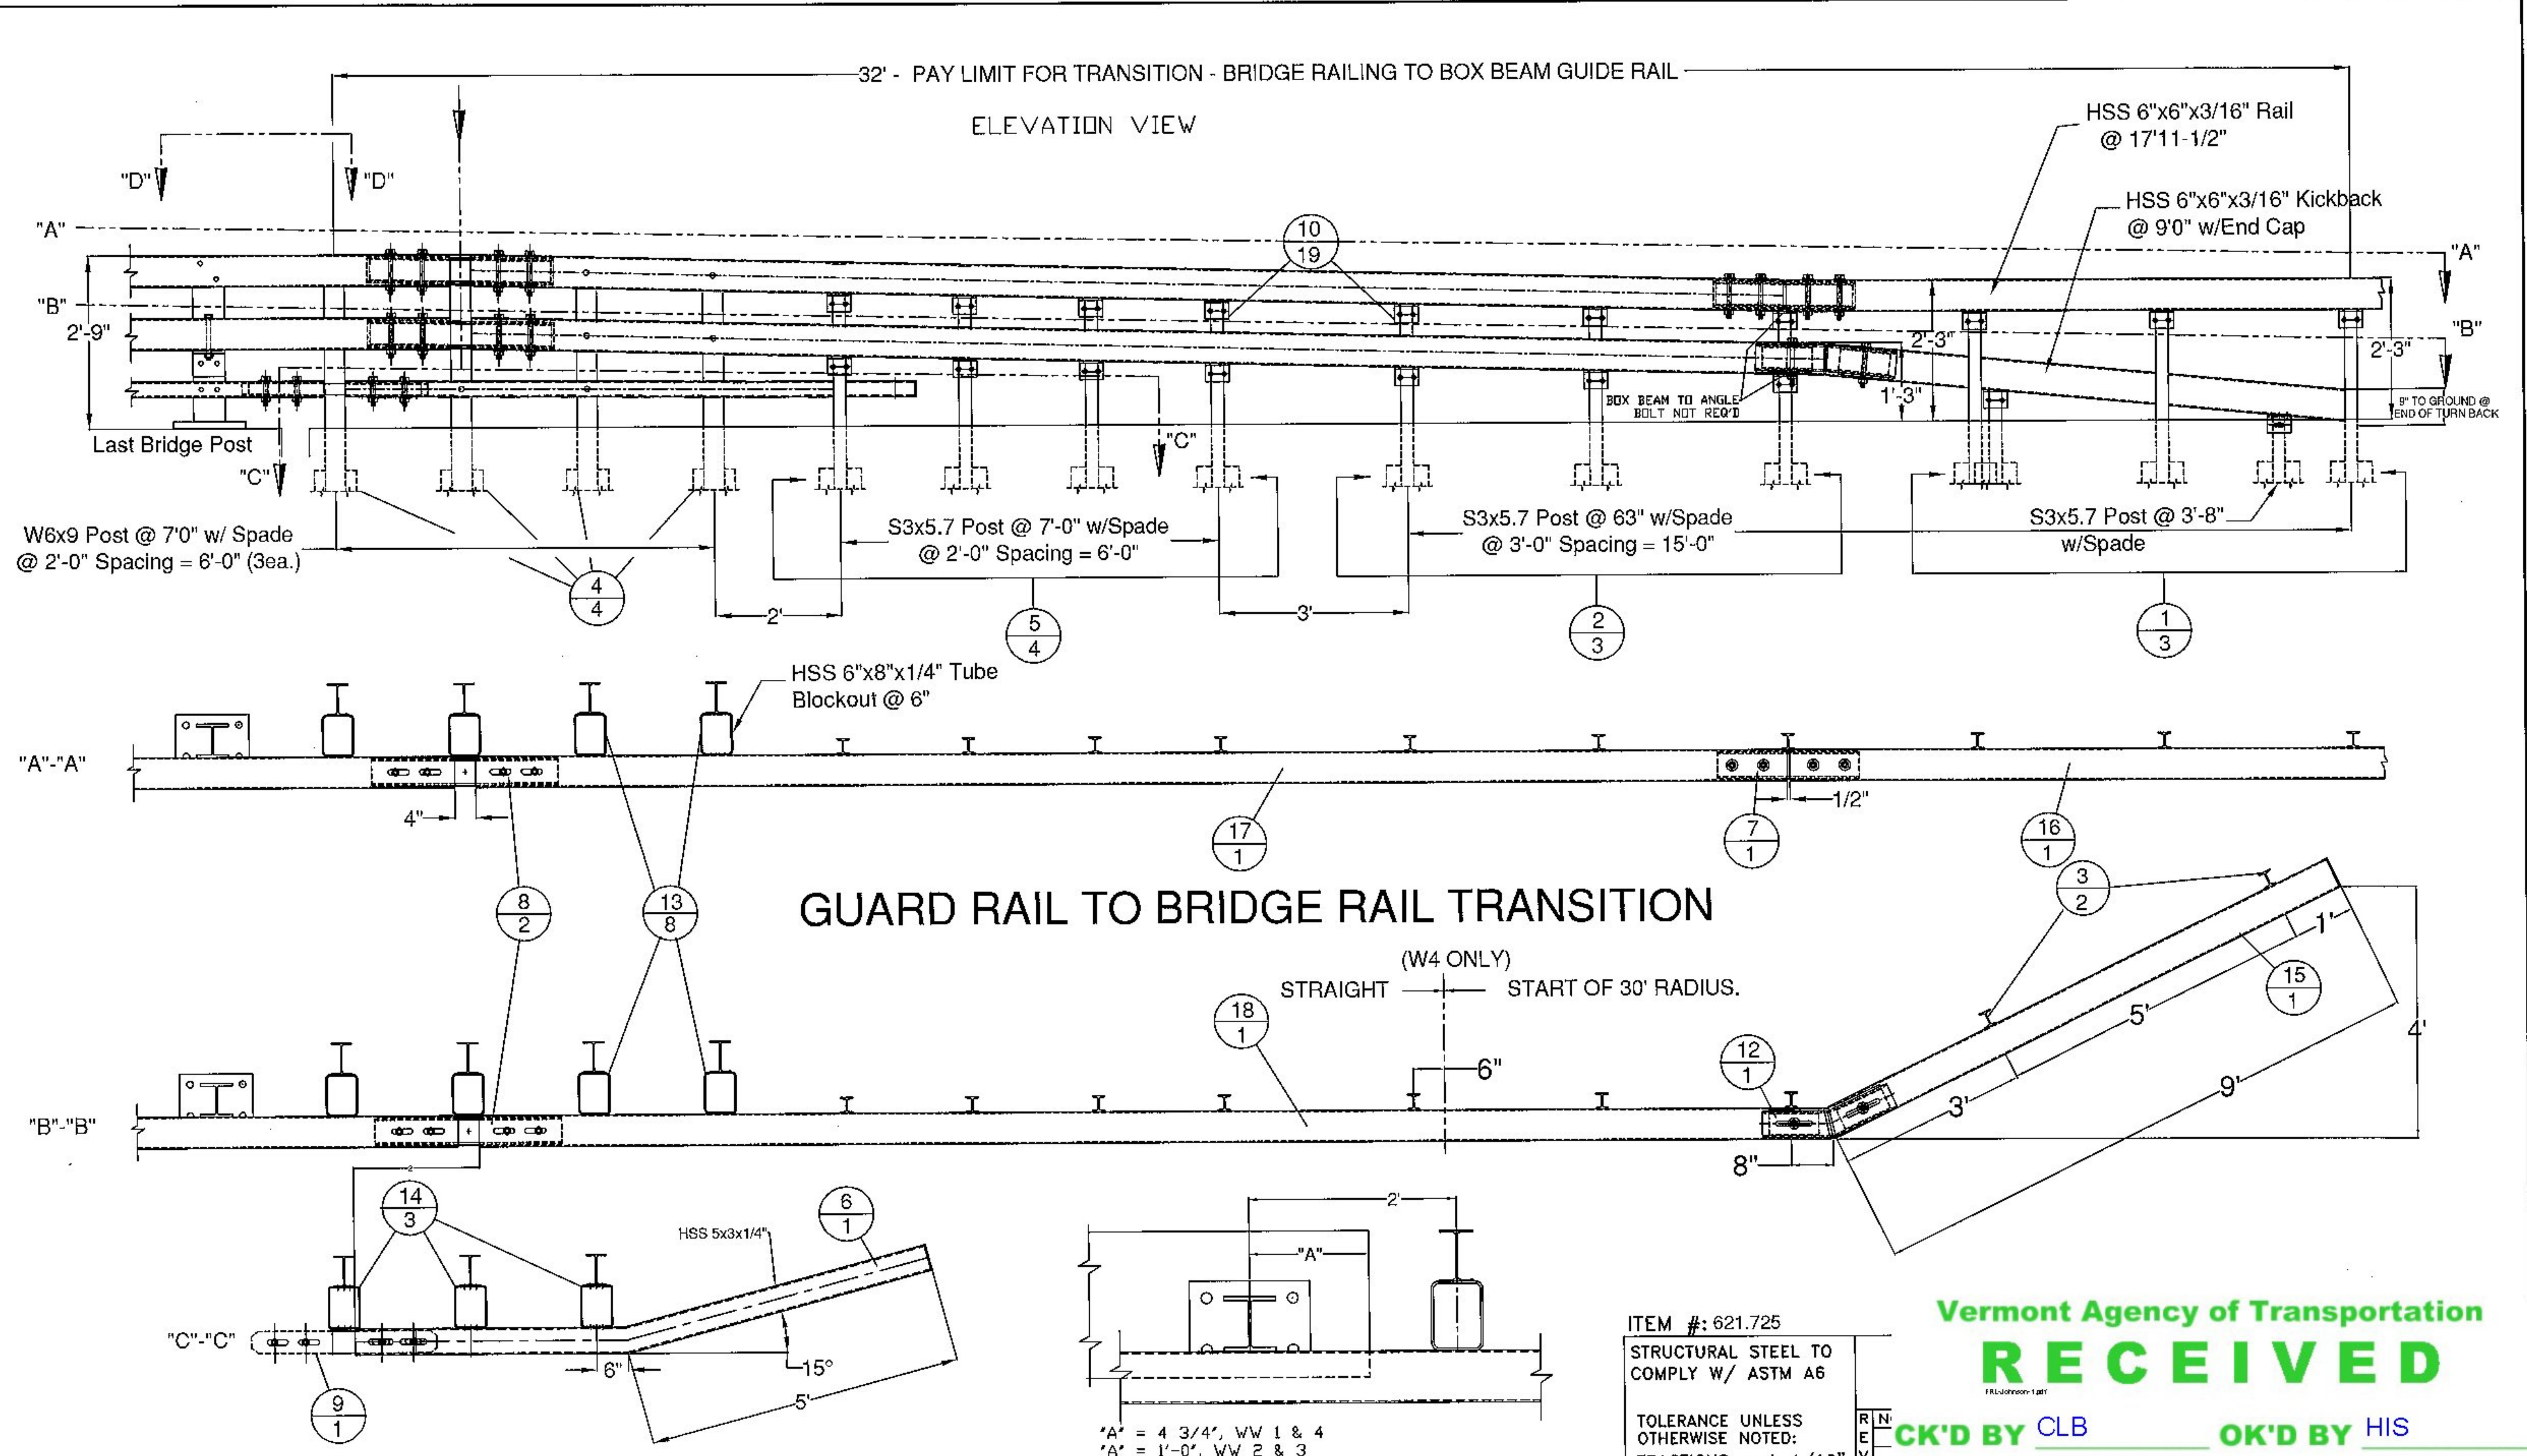

**GUARD RAIL TO BRIDGE RAIL TRANSITION**

ITEM #: 621.725  
 STRUCTURAL STEEL TO COMPLY W/ ASTM A6  
 TOLERANCE UNLESS OTHERWISE NOTED:  
 FRACTIONS = ± 1/16"  
 ANGLES = ± 1/2"  
 DIAMETERS = ± 1/32"

Vermont Agency of Transportation  
**RECEIVED**

CK'D BY CLB OK'D BY HIS


January 19, 2015

RESUBMIT NO Approved  
 BY C. CARLSON DATE 01/20/15

*A* = 4 3/4", WW 1 & 4  
 *A* = 1'-0", WW 2 & 3


VIEW "D"-"D"

PLAN VIEW

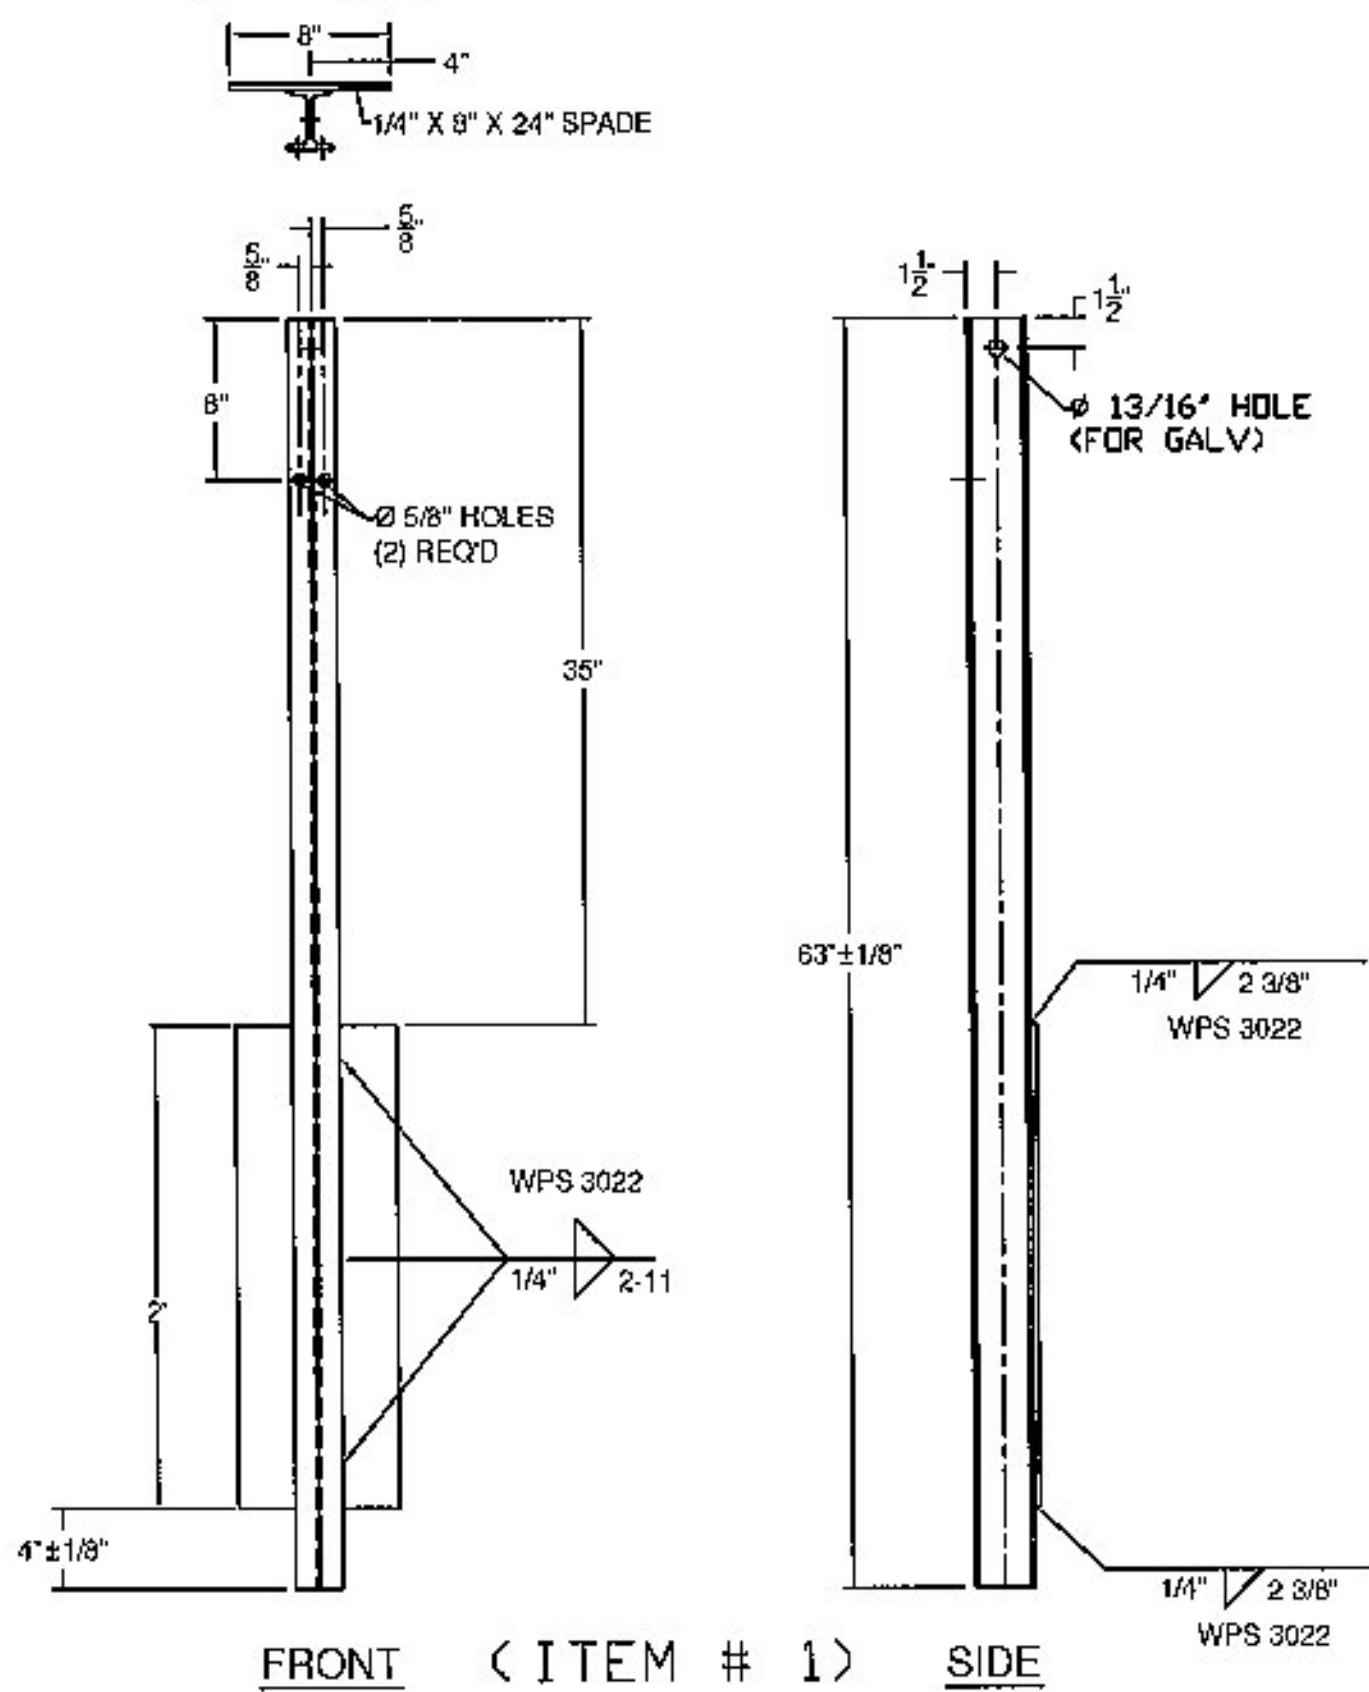


FRONT (ITEM # 1) SIDE

PLAN VIEW

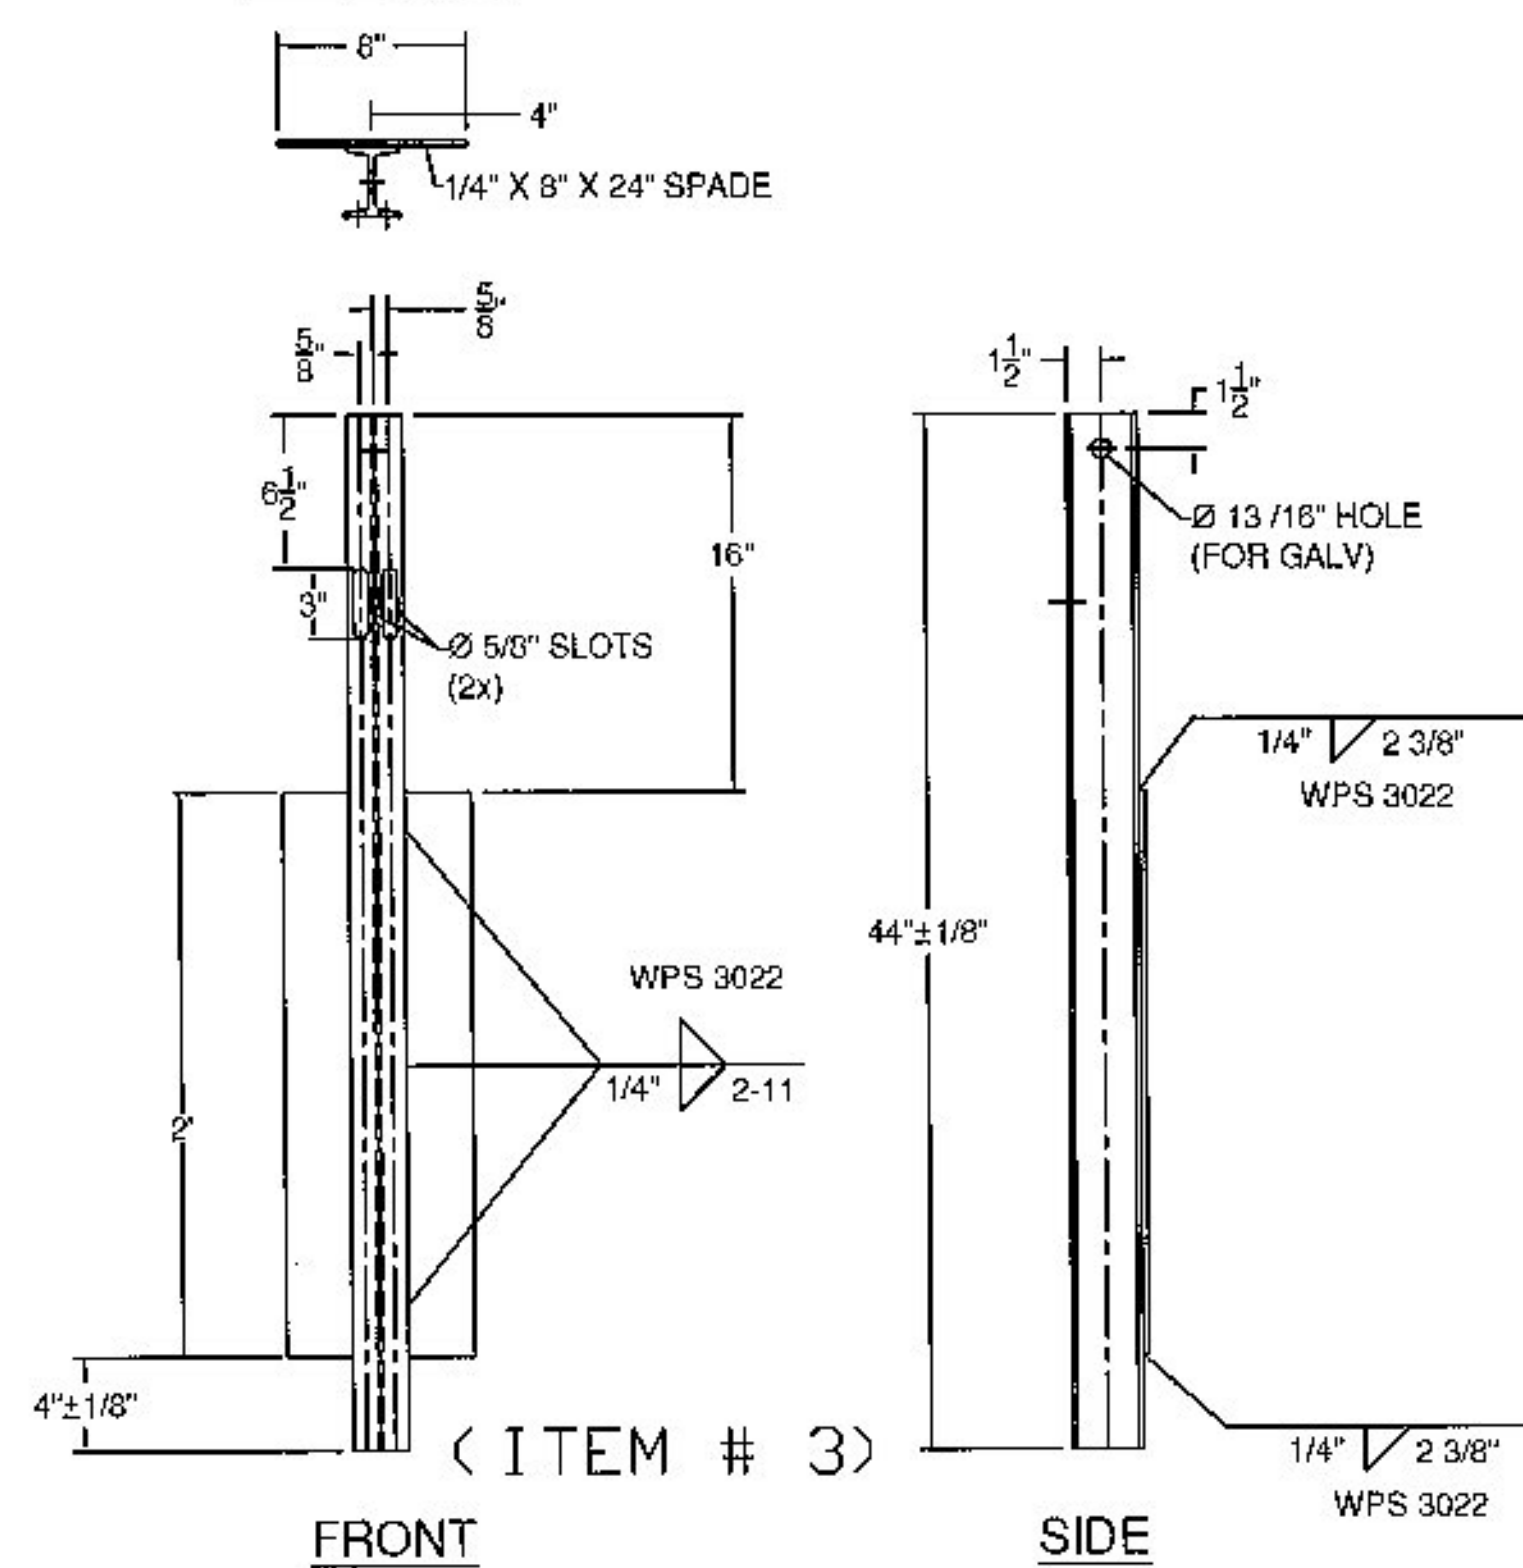


FRONT (ITEM # 3) SIDE

PLAN VIEW

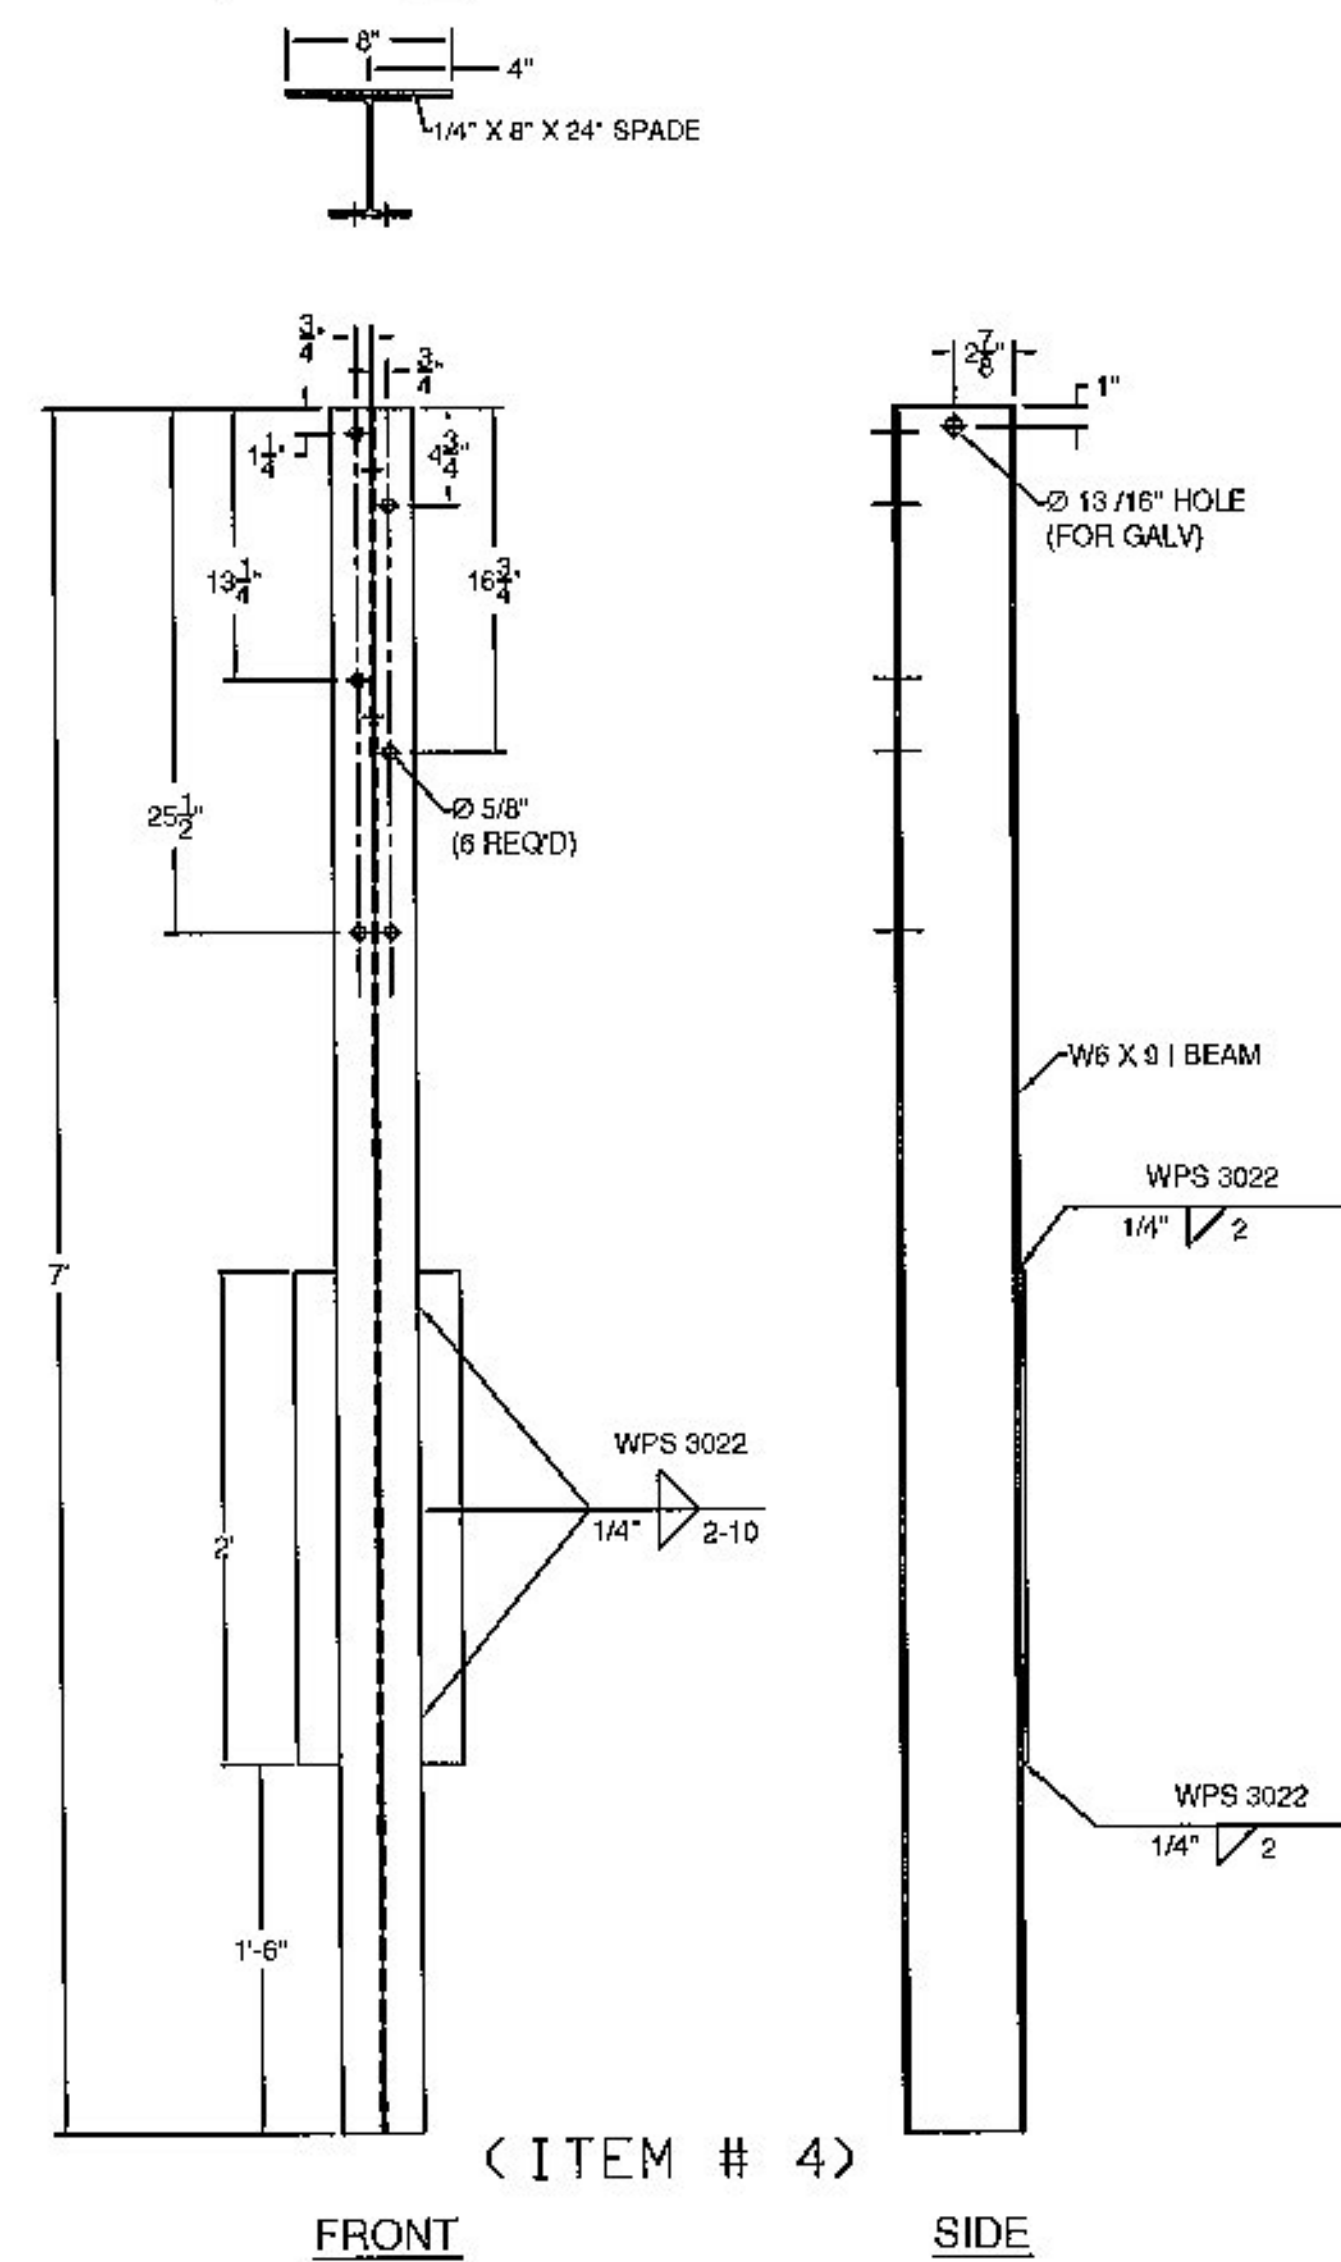


FRONT (ITEM # 4) SIDE

PLAN VIEW

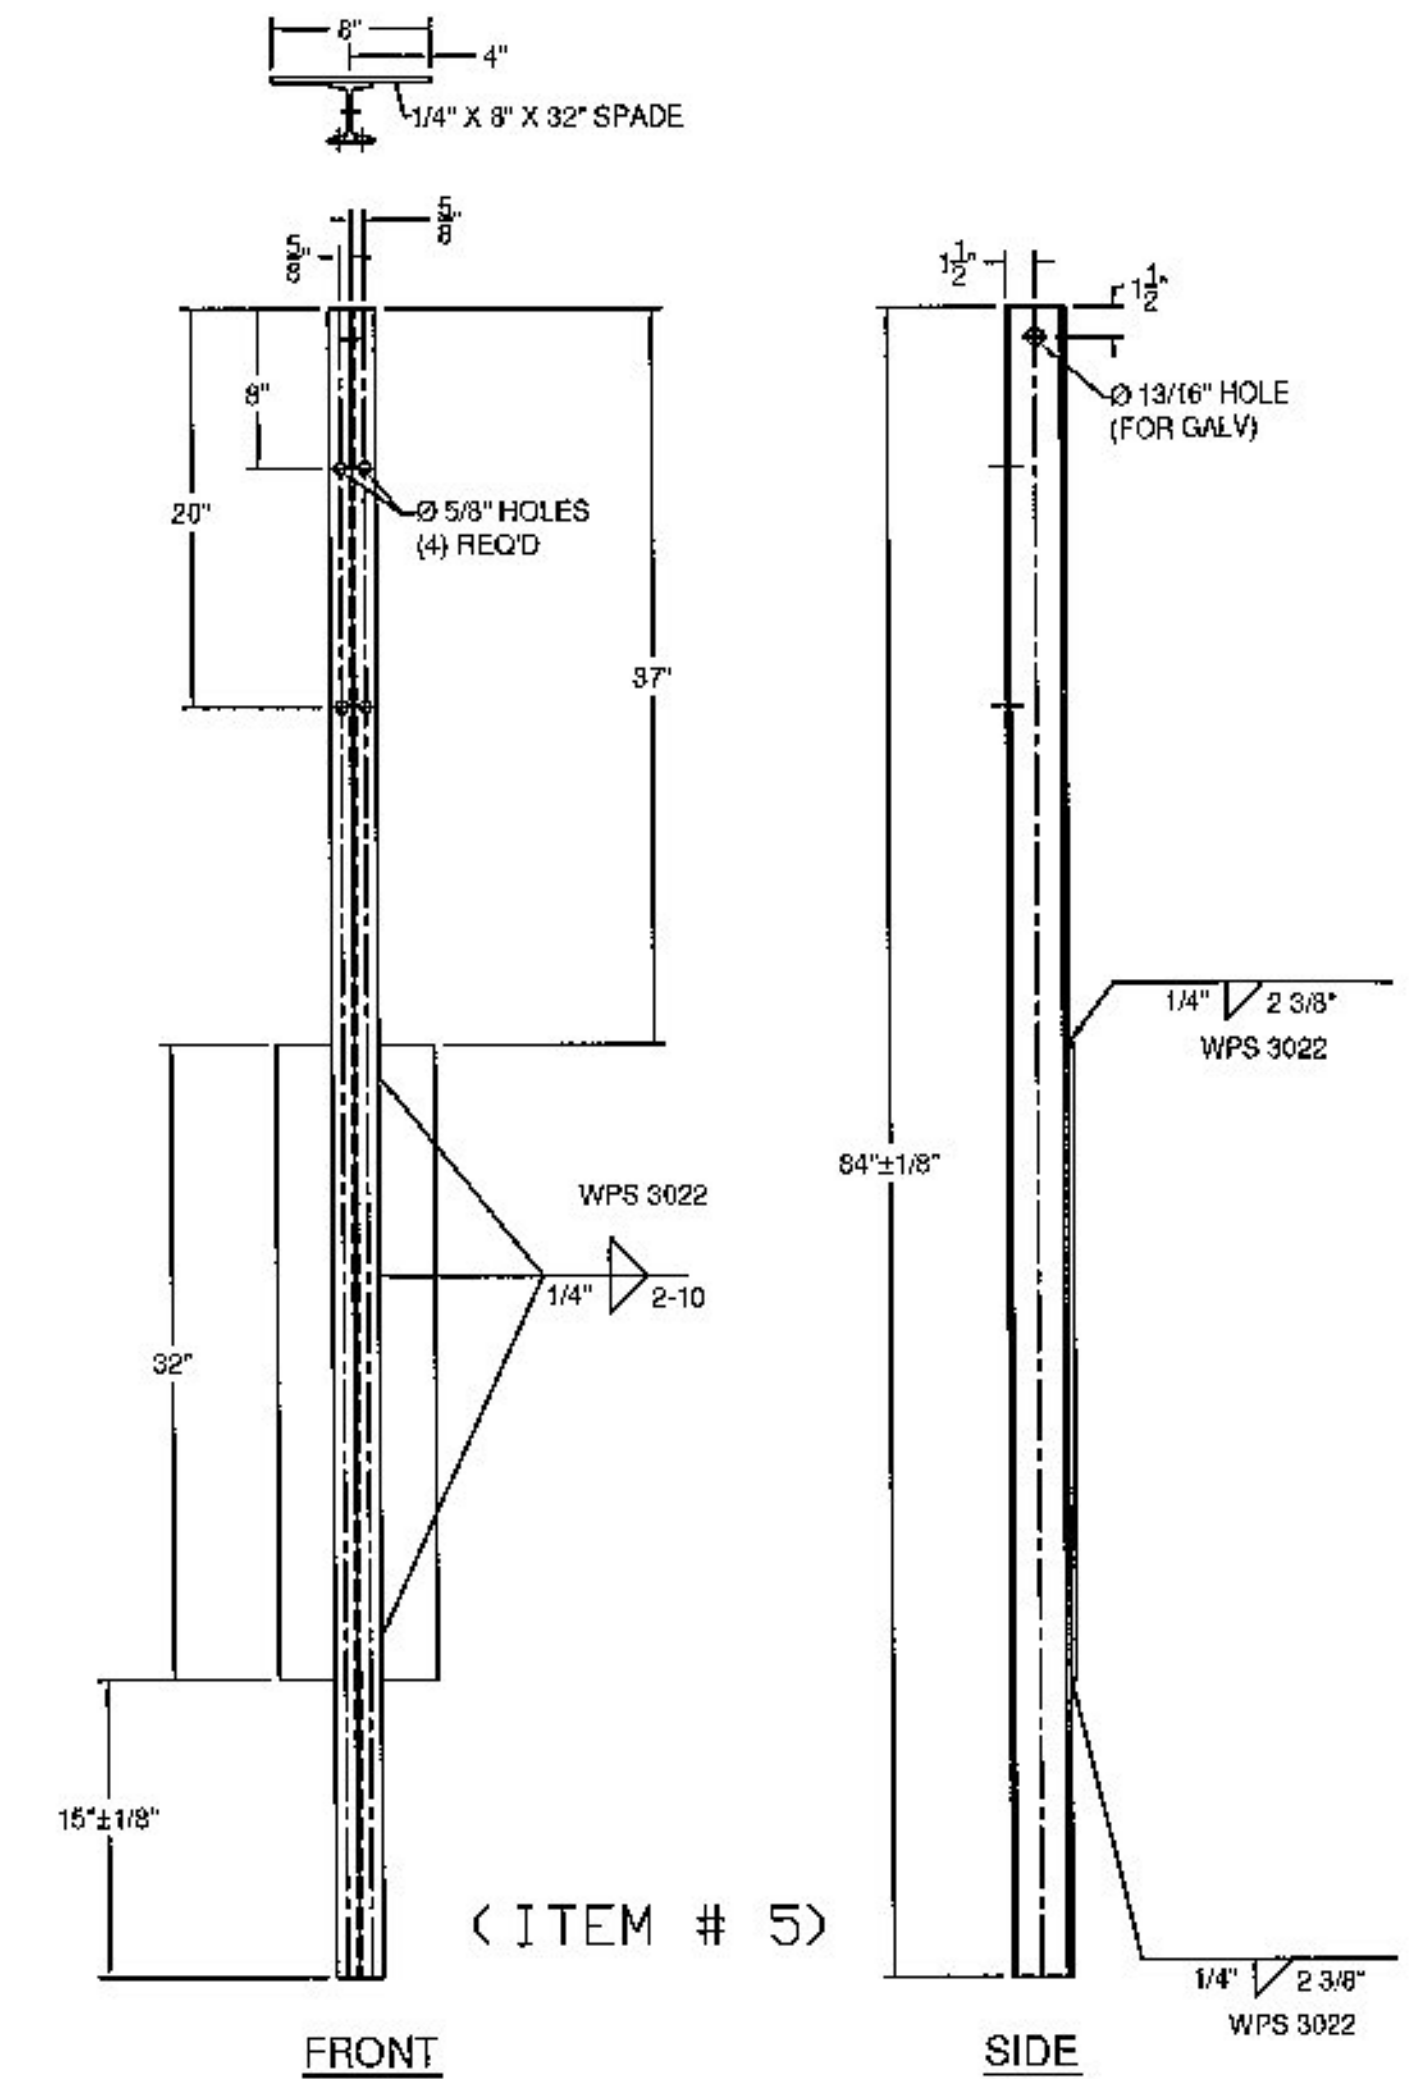

FRONT (ITEM # 5) SIDE

PLAN VIEW

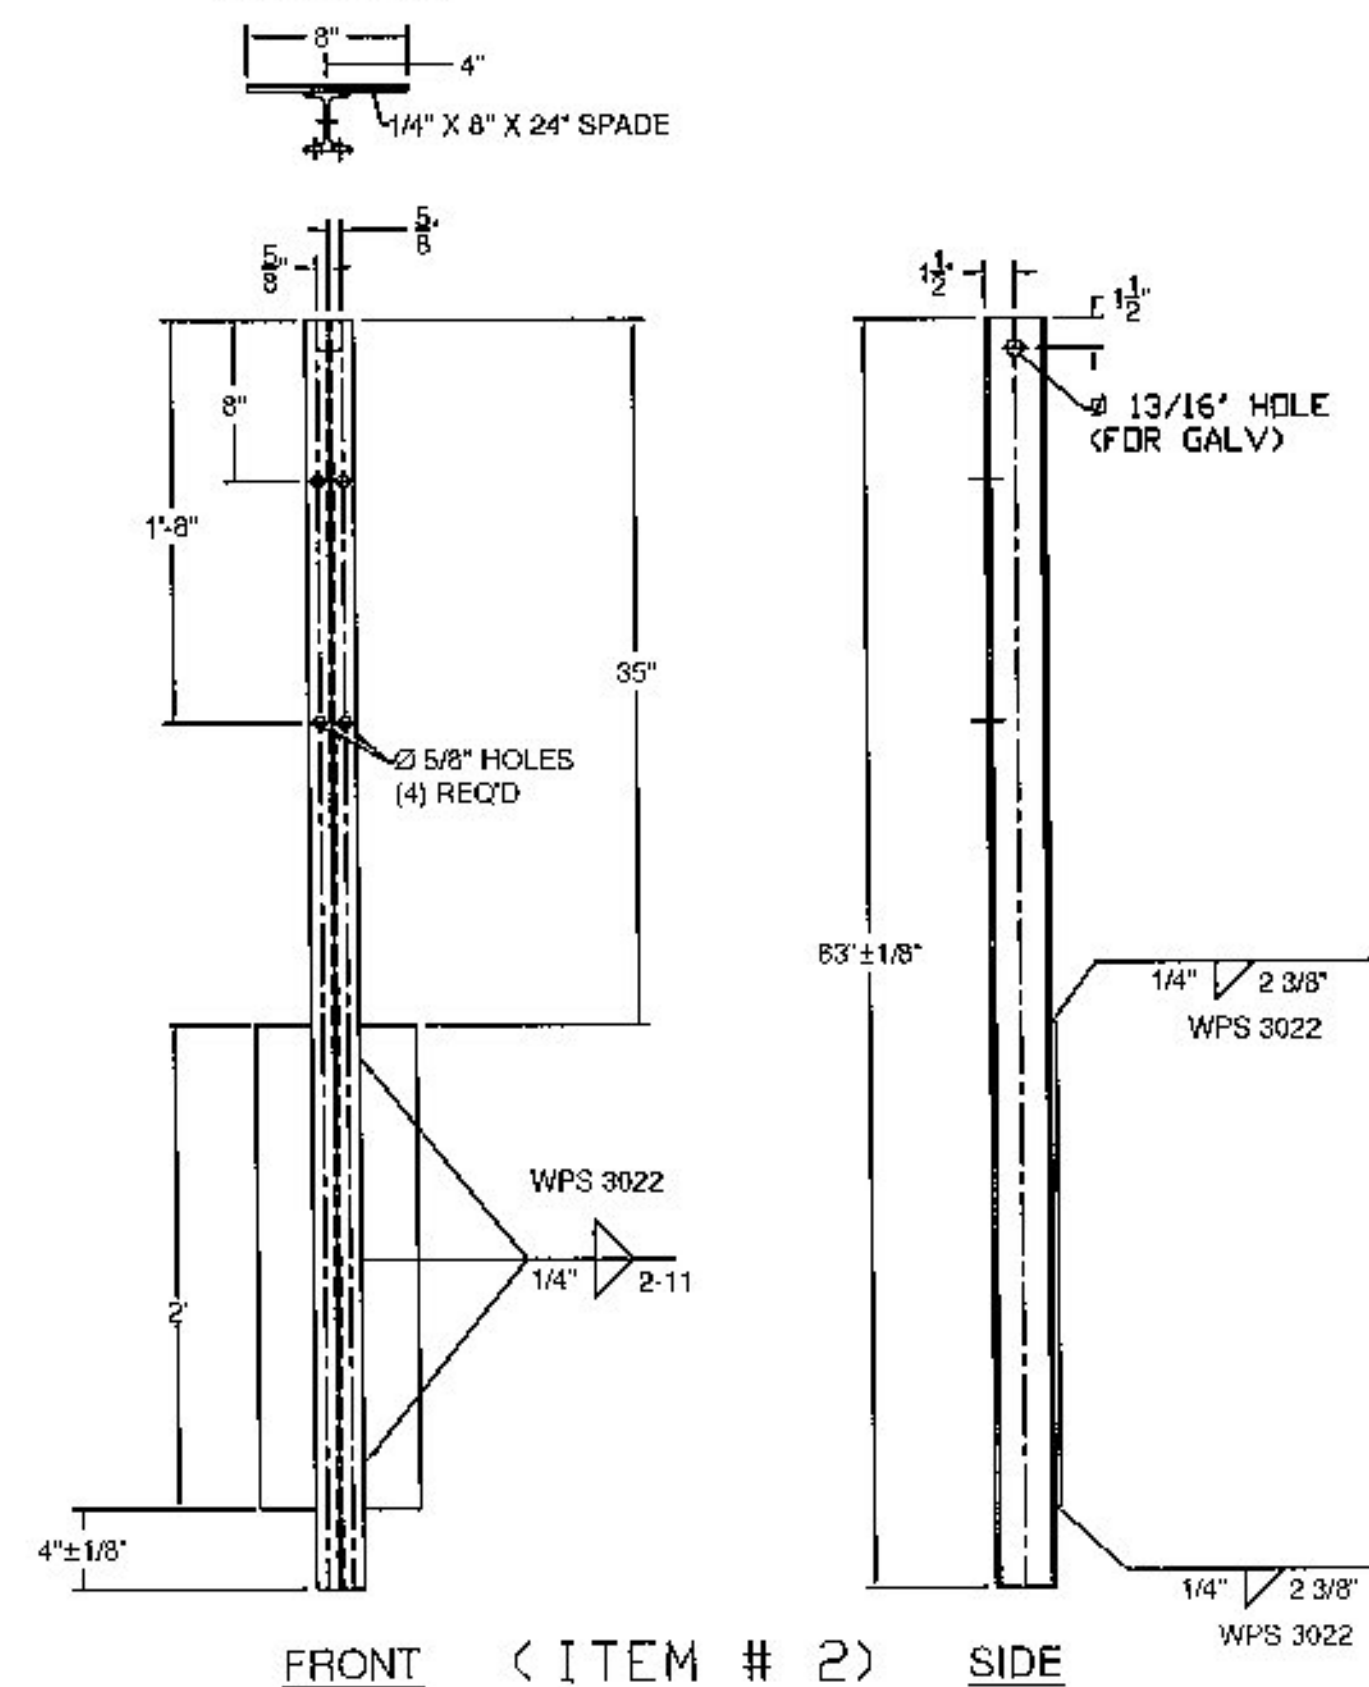

FRONT (ITEM # 2) SIDE

HARDWARE NOTES	
ITEM #	FUNCTION
19	BOLT RAIL TO SHELF ANGLE (ITEM #10)
20	BOLT SHELF ANGLE (ITEM #'S 10 & 11) TO POST
21	BOLT BLOCK-OUTS (ITEM #'S 13 & 14) TO HEAVY POST
22	(4) PER SPLICE BAR (ITEM #9)
23	(4) PER SPLICE TUBING (ITEM #'S 7 & 8)
24	BOLT RAIL (ITEMS #'S 6,17, & 18) TO BLOCK-OUTS (ITEM #'S 13 & 14) (WHERE FASTENED)
25	BOLT DOUBLE BEND SPLICE TUBE (ITEM #12) TO RAIL (ITEM #18) & KICKBACK (ITEM #15)

BILL OF MATERIALS (EACH CORNER)				
ITEM #	QTY.	COMPONENT #	DESCRIPTION	MATERIAL (ASTM)
1	3	0013.57021	3' I-POST, PUNCH 8" W/SPD @ 63" LG	ASTM A572 Gr. 50
2	3	0013.57025	3' I-POST, PUNCH 8", & 20" W/SPD @ 63" LG	ASTM A572 Gr. 50
3	2	0013.57060	3' I-END POST W/SPD @ 3'-8" LG	ASTM A572 Gr. 50
4	4	0013.09001	W6X9 POST @ 7" W/SPD @ 5/8" HOLES	ASTM A572 Gr. 50
5	4	0013.57010	3' I-POST, PUNCH 8" & 20", W/8X32" SPADE @ 7"	ASTM A572 Gr. 50
6	1	0033.80403	3X5" BTM TRANS RAIL W/5'-0" KB, EXP END (WV2-4)	A500 Gr. B
6	1	0033.91349	3X5" BTM TRANS RAIL W/5'-0" KB, EXP END & 22" ANGLE (WV1)	A500 Gr. B
7	1	0033.00640	HSS 5X5 TUBE SPLICE @ 27" LG W/ 1/4" SHIMS (WV2-4)	A500 Gr. B / A572 Gr. 50
7	1	0033.00606	HSS 5X5 TUBE SPLICE @ 27" LG W/ 1/4" SHIMS & 6" BEND (WV1)	A500 Gr. B / A572 Gr. 50
8	2	0033.00730	HSS 5X5 EXP TUBE SPLICE @ 36" LG W/ 1/4" SHIMS	A500 Gr. B / A572 Gr. 50
9	1	0033.00930	BR EXP BAR SPLICE 2-1/8" X 4-1/4" @ 36" LG	ASTM A572 Gr. 50
10	19	0054.00050	REG BB SHELF ANGLES @ 4-1/2"	ASTM A36
12	1	0054.00074	HSS 5X5 DBL BEND TUBE SPL @ 27" LG, (25" ANGLE WV2 & 3)	A500 Gr. B / A572 Gr. 50
12	1	0033.90408	HSS 5X5 DBL BEND TUBE SPL @ 27" LG, (40" ANGLE WV1)	A500 Gr. B / A572 Gr. 50
12	1	0033.90409	HSS 5X5 DBL BEND TUBE SPL @ 27" LG, (35" ANGLE WV4)	A500 Gr. B / A572 Gr. 50
13	8	0054.00563	6X8" TRANS. TUBE B/D @ 6" LG	A500 Gr. B
14	3	0054.00565	6X8" TRANS. TUBE B/D @ 3" LG	A500 Gr. B
15	1	0054.09000	6X6" BB @ 9'-0" KICKBACK, W/ CAP, & 13" ANGLE (WV2 & 3)	A500 Gr. B / A36
15	1	0033.91350	6X6" BB @ 9'-0" KICKBACK, W/ CAP, & 20" ANGLE (WV1)	A500 Gr. B / A36
15	1	0033.91351	6X6" BB @ 9'-0" KICKBACK, W/ CAP, & 18" ANGLE (WV4)	A500 Gr. B / A36
16	0.5	0054.18000	6X6" BB @ 17'-11 1/2", DRILL 3" CC (STRAIGHT - WV2 & 3)	A500 Gr. B
16	0.5	0057.90059	6X6" BB @ 18'-11 1/2", DRILL 3" CC (25" RADIUS - WV1) & DROP END	A500 Gr. B
16	0.5	0057.90058	6X6" BB @ 17'-11 1/2", DRILL 3" CC (30" RADIUS - WV4)	A500 Gr. B
17	1	0054.90092	6X6" BB TOP TRANS @ 20'-9 5/8" LG W/EXP END (STRAIGHT - WV2 & 3)	A500 Gr. B
17	1	0033.91332	6X6" BB TOP TRANS @ 20'-9 5/8" LG W/EXP END (25" RADIUS - WV1)	A500 Gr. B
17	1	0033.91353	6X6" BB TOP TRANS @ 20'-9 5/8" LG W/EXP END (30" PARTIAL RADIUS - WV4)	A500 Gr. B
18	1	0054.90093	6X6" BB BTM TRANS @ 21'-4 5/8" LG W/EXP END (STRAIGHT - WV2 & 3)	A500 Gr. B
18	1	0033.91354	6X6" BB BTM TRANS @ 21'-4 5/8" LG W/EXP END (25" RADIUS - WV1)	A500 Gr. B
18	1	0033.91355	6X6" BB BTM TRANS @ 21'-4 5/8" LG W/EXP END (30" PARTIAL RADIUS - WV4)	A500 Gr. B
19	18	0080.03355	3/8" X 7 1/2" BOLT, NUT, & 2 FW	A307
20	19	0080.04100	1/2" X 1-1/2" BOLT, NUT, & FW	A307
21	22	0080.04120	1/2" X 1-1/2" BOLT, NUT, 2 FW & LW	A307
22	4	0080.06255	3/4" X 4-1/2" BOLT, NUT, 2 FW	A325, A563, F436
23	12	0080.06340	3/4" X 7-1/2" BOLT, NUT, 2 FW	A325, A563, F436
24	6	0080.06370	3/4" X 8" CARR BOLT, NUT, FW & LW	A307
25	2	0080.06400	3/4" X 8" BOLT, NUT, 2 FW, & LW	A325, A563, F436


GENERAL NOTES:

- 1) ALL RAILING IS TO BE FABRICATED AND ERECTED ACCORDING TO SECTION 525 OF THE STANDARD SPECIFICATIONS.
- 2) BOLTS SHALL BE TORQUED SNUG TIGHT (APPROXIMATELY 100 FT-LB).
- 3) PROTRUSIONS CAUSED BY WELDING OR GALVANIZING ARE NOT PERMITTED ON THE ADJOINING SURFACES OF THE BOX BEAM RAILS, SPLICE TUBES AND FILL PLATES.
- 4) BOX BEAM TUBE AND STEEL POST MATERIALS, DIMENSION SIZES AND NOTES SHALL BE THE SAME AS THOSE OF THE BRIDGE RAIL, UNLESS OTHERWISE NOTED.
- 5) ANY BENDING OF RAIL SHALL BE DONE AT THE FABRICATION PLANT. RADII GREATER THAN 16' TO BE CURVED ON A TUBE BENDING MACHINE, RADII LESS THAN 16' TO BE "PIE CUT" AND WELDED. CURVED RAILING WILL HAVE AN 18" LENGTH ON EACH END STRAIGHT TO ACCOMMODATE SPLICES. "PIE CUTS" ARE LOCATED SO AS NOT CONFLICT WITH POST FASTENING HOLES. "PIE CUTS" WILL BE WELDED ACCORDING TO PROCEDURE WPS-3026.

ITEM #: 621.725

STRUCTURAL STEEL TO COMPLY W/ ASTM A6

TOLERANCE UNLESS OTHERWISE NOTED:  
 FRACTIONS = ± 1/16"  
 ANGLES = ± 1/2"  
 DIAMETERS = ± 1/32"

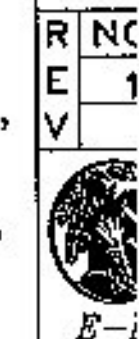

Vermont Agency of Transportation

**RECEIVED**

141-000001-001

RNC  
 E 1  
 V






CK'D BY CLB OK'D BY HIS

January 19, 2015

RESUBMIT NO  
 BY C. CARLSON

Approved

DATE 01/20/15

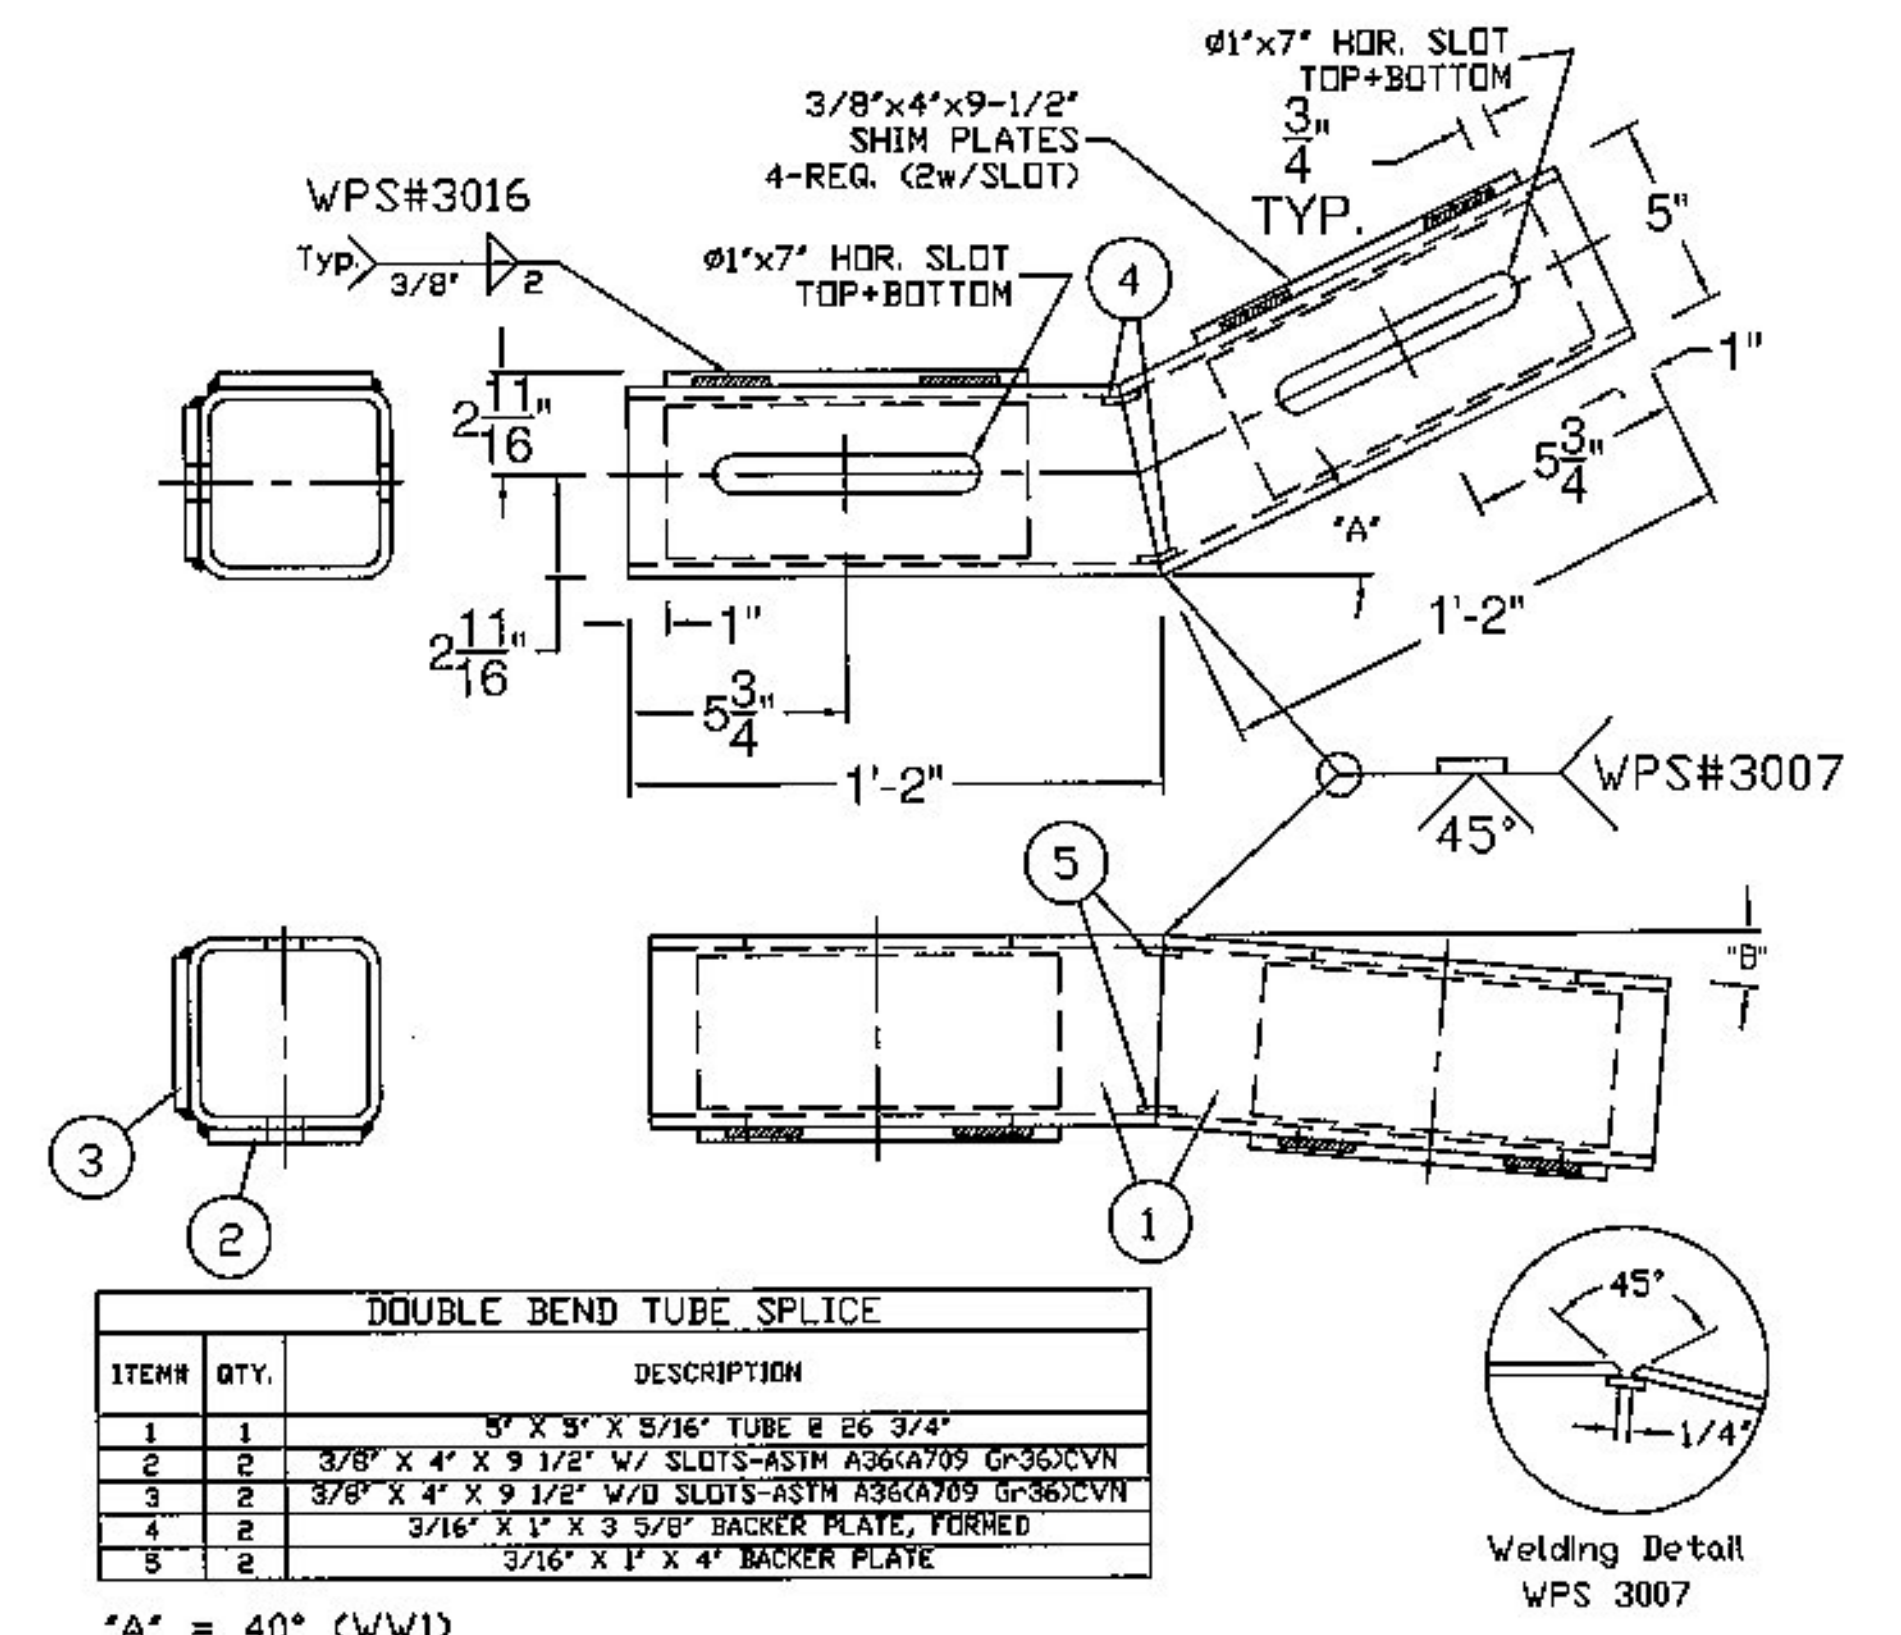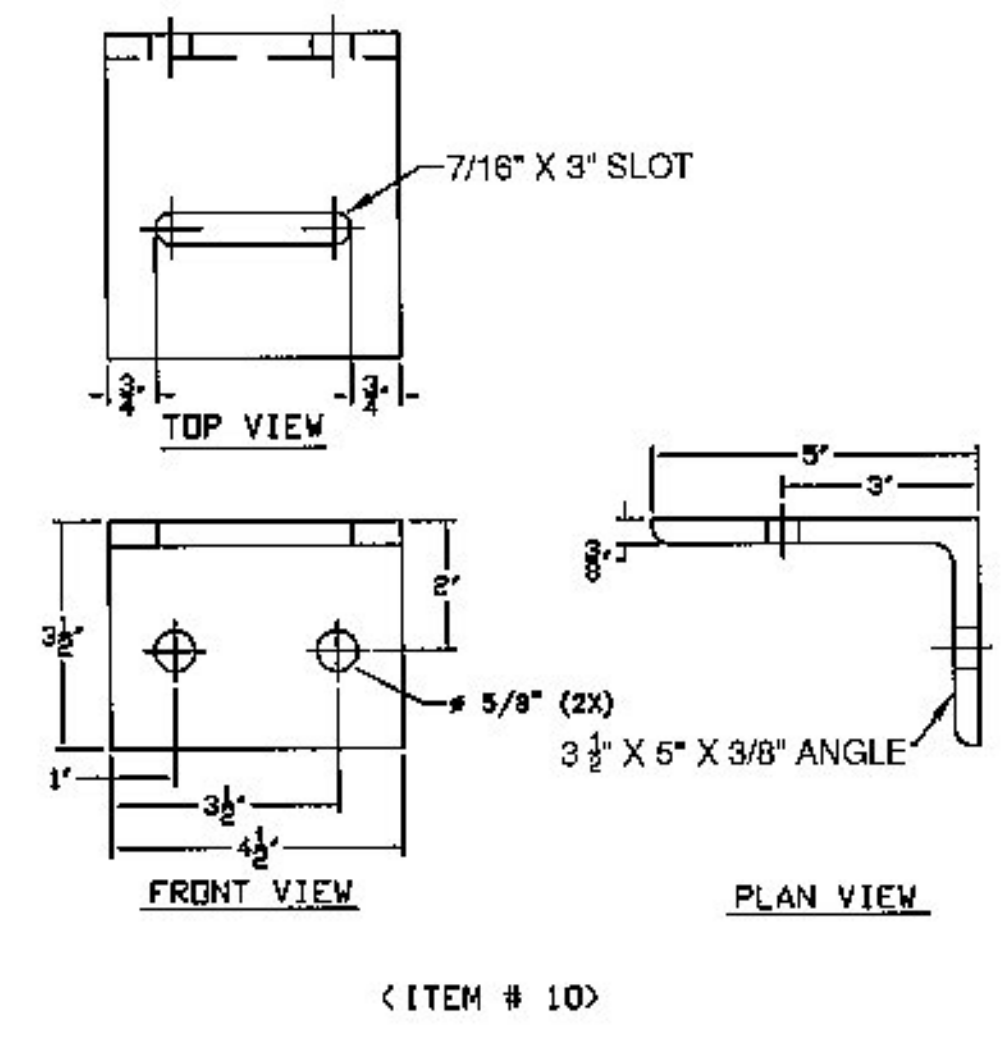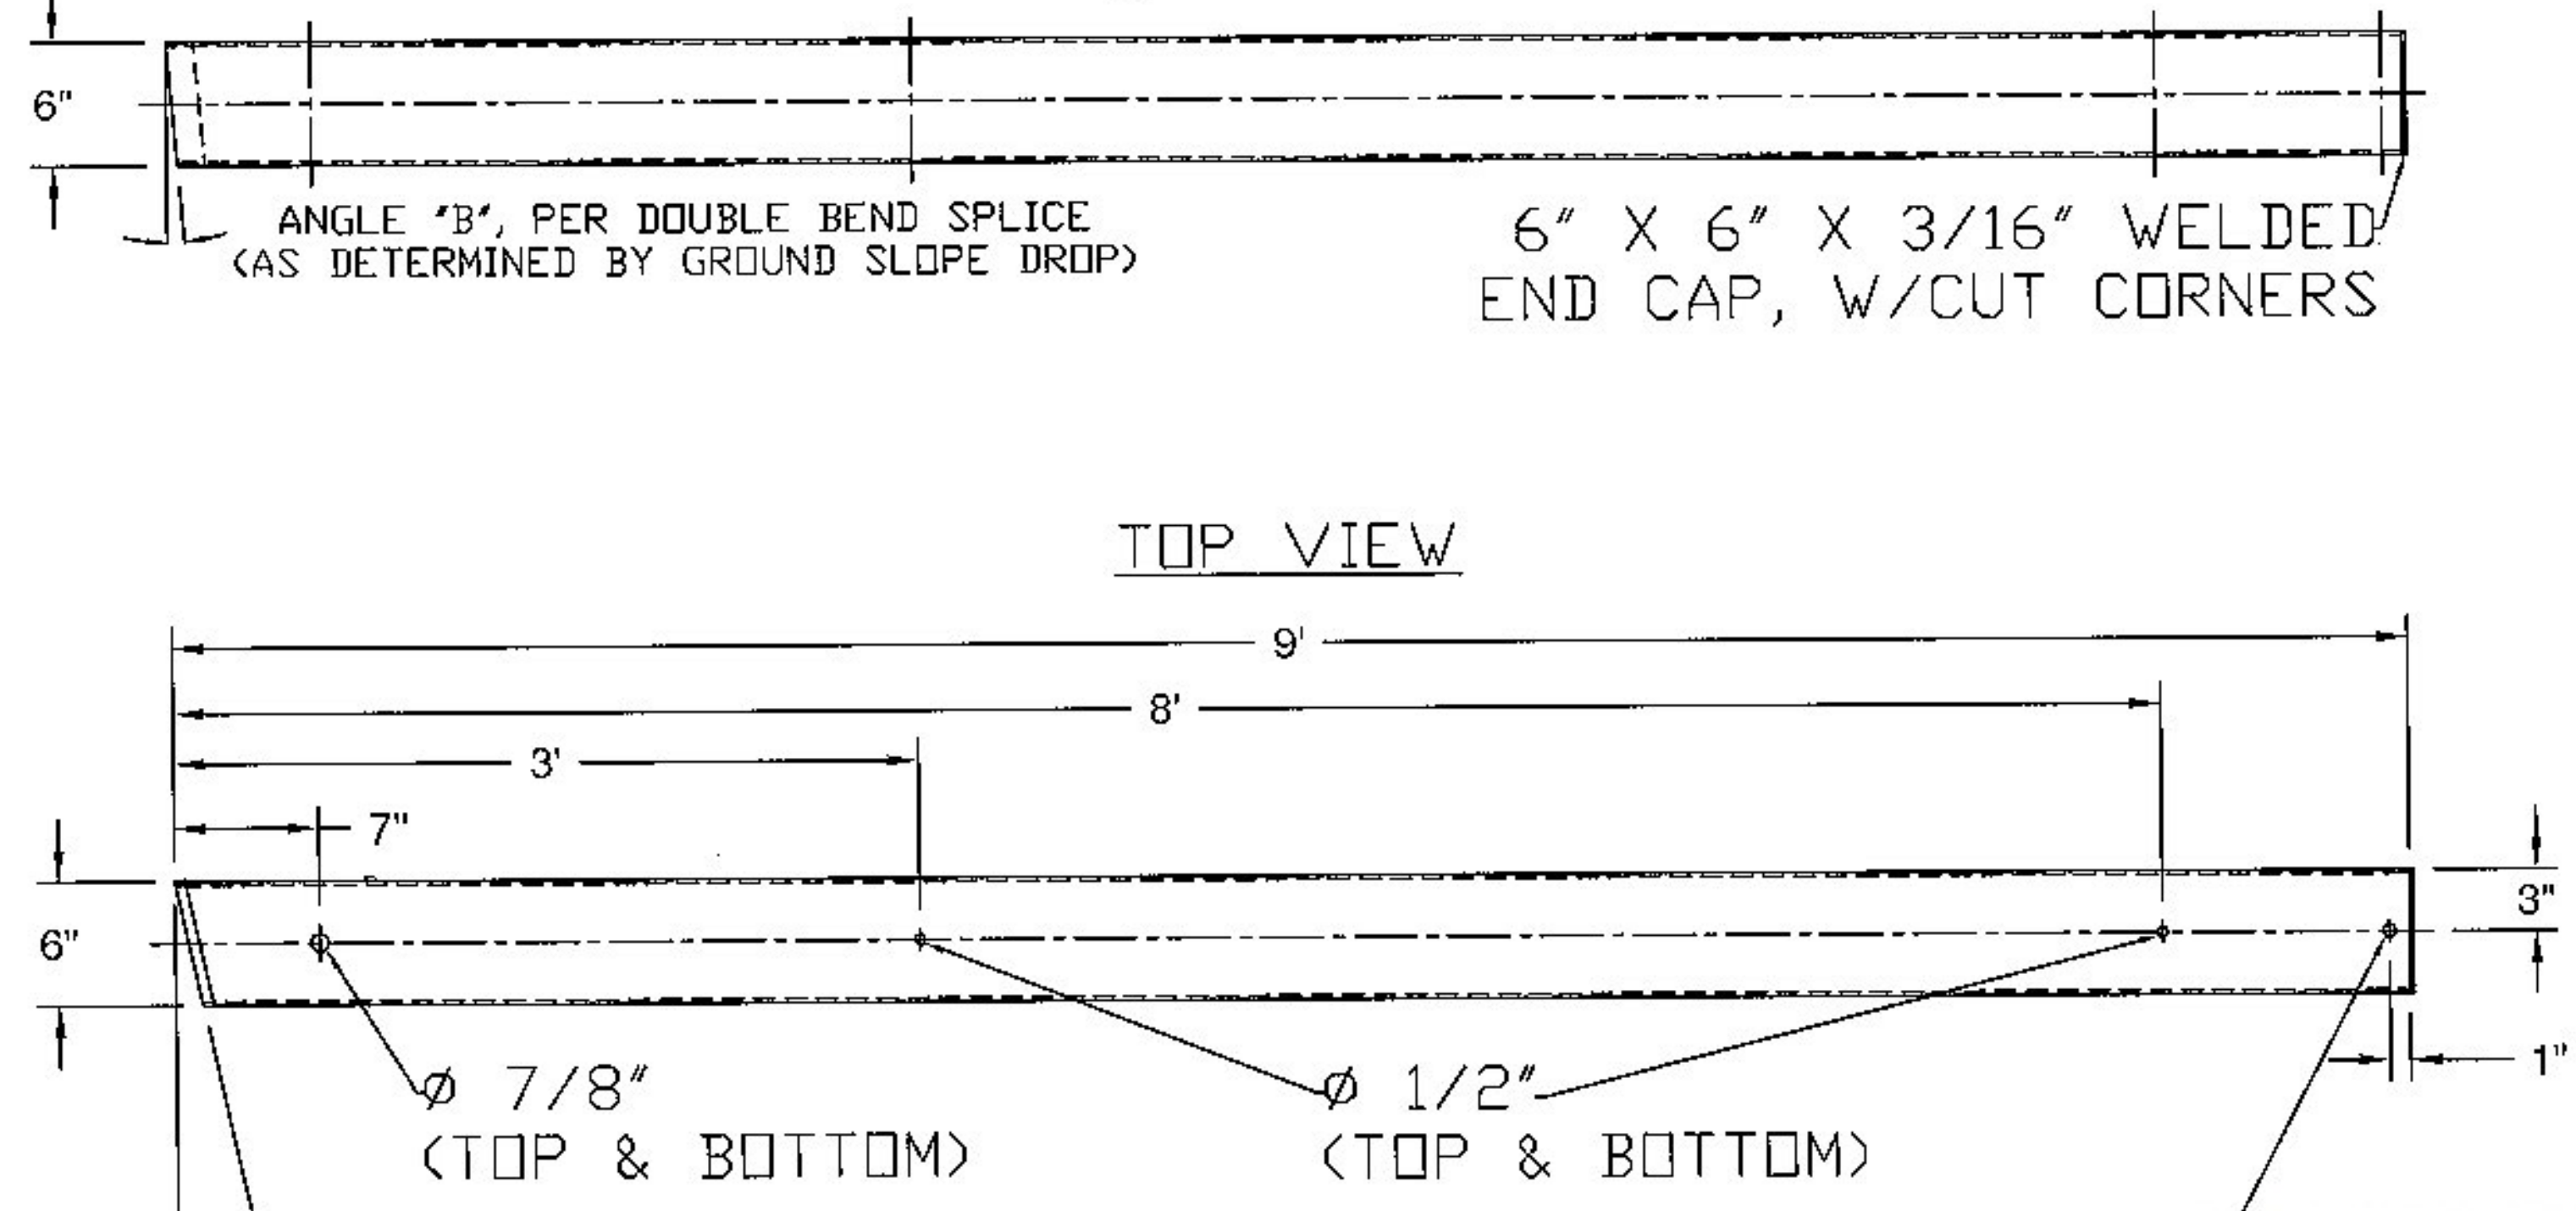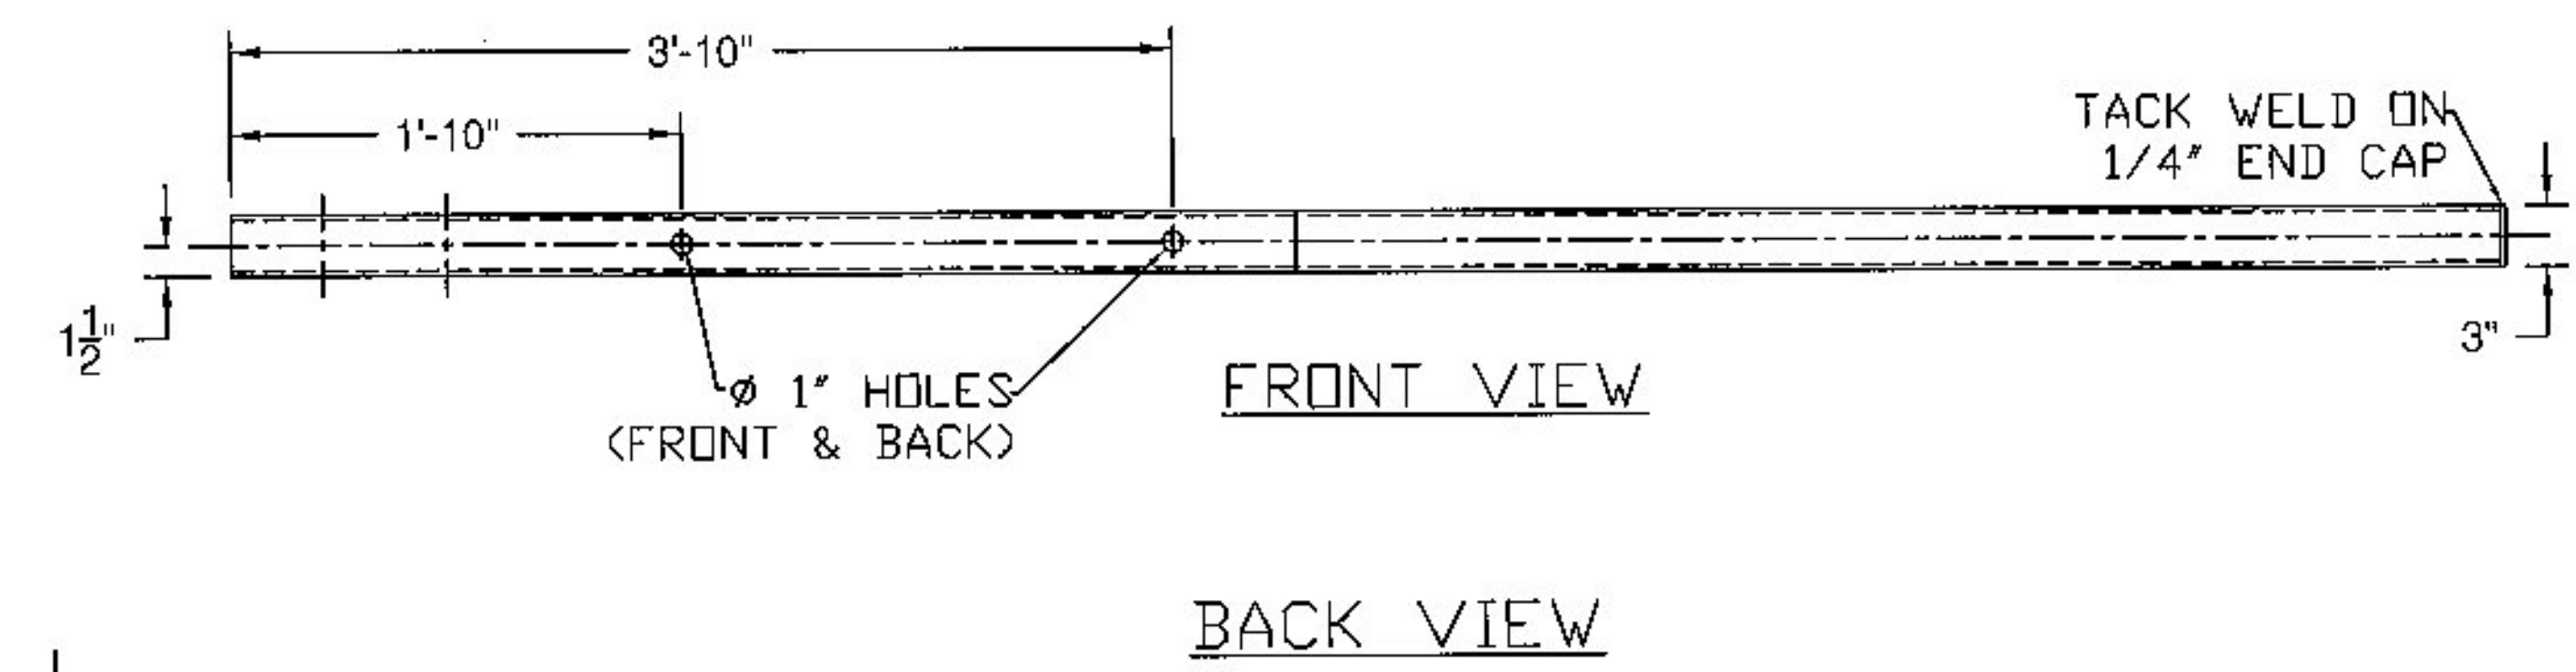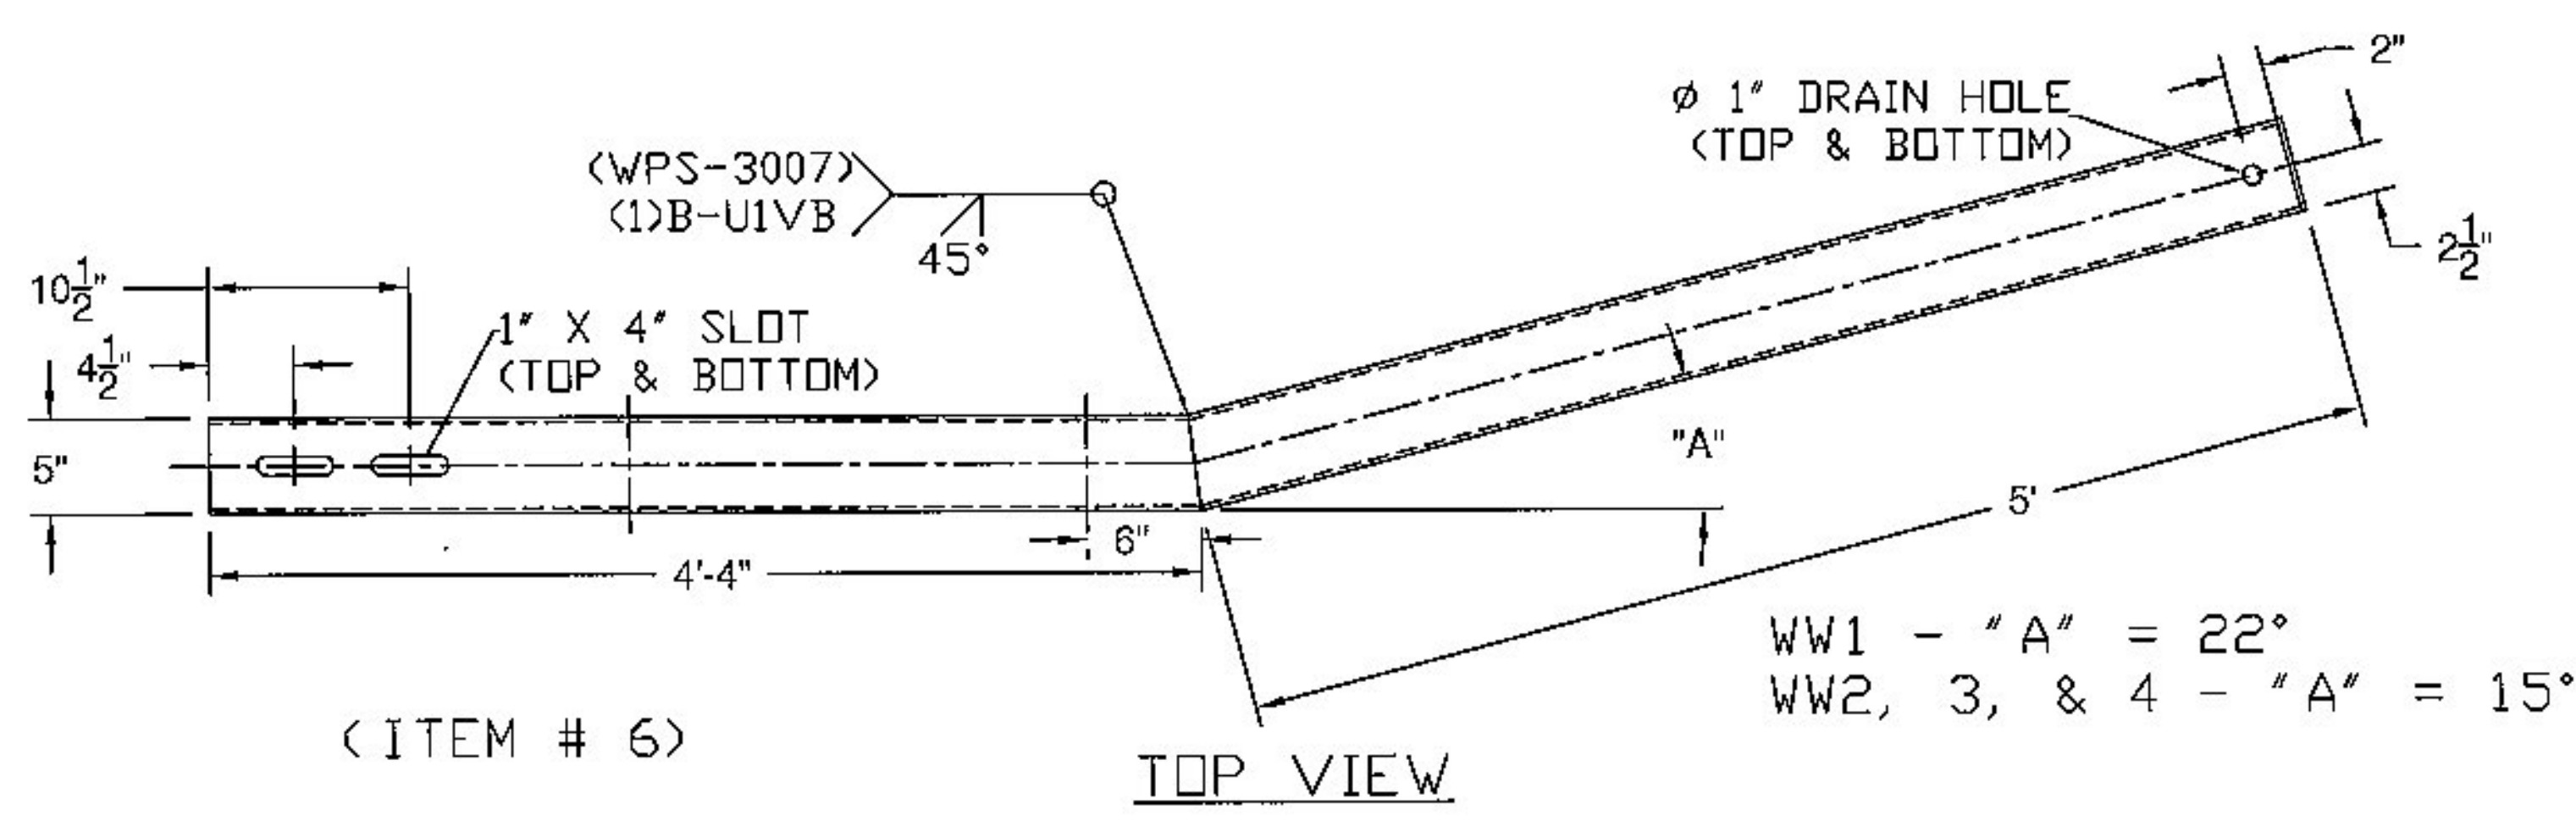

*A* = 40° (WW1)  
*A* = 26° (WW2 & 3)  
*A* = 35° (WW4)  
*B* - TURN DOWN ANGLE SET BY THE 9" MEASUREMENT AT THE END OF THE BOX BEAM.

Vermont Agency of Transportation  
**RECEIVED**

CK'D BY CLB OK'D BY HIS

January 19, 2015

RESUBMIT NO Approved  
BY C. CARLSON DATE 01/20/15

I #: 621.725  
STRUCTURAL STEEL TO PLY W/ ASTM A6  
PERMITS UNLESS OTHERWISE NOTED:  
DIMENSIONS = ± 1/16"  
DIMENSIONS = ± 1/2"  
DIMENSIONS = ± 1/32"


SHEET 3 OF 6

**GRAS, GLV 3 RAIL BOX BEAM**  
JOHNSON BRIDGE 030-2(26), VT ROUTE 15 (MINOR ARTERIAL), BRIDGE # 32  
TOWN OF JOHNSON, COUNTY OF LAMOILLE, VT.


R. NO.	DATE	DESCRIPTION	BY	R.	DATE	DESCRIPTION	BY
E 1	1/16/15	UPDATED PER 1/8/15 MARK-UP	EP	E			

ELDERLEE, INC.  
OAKS CORNERS, NEW YORK 14518  
E-Mail: dlong@elderlee.com / epeek@elderlee.com  
Tel: 315-789-6670 Fax: 315-789-6615

DRAWN	E.P.	12/23/14
CHECKED	D.L.	12/23/14
APPROVED		
SCALE	SCHEMATIC	
DRAWING NO. F.R. LAFAYETTE-JOHNSON		

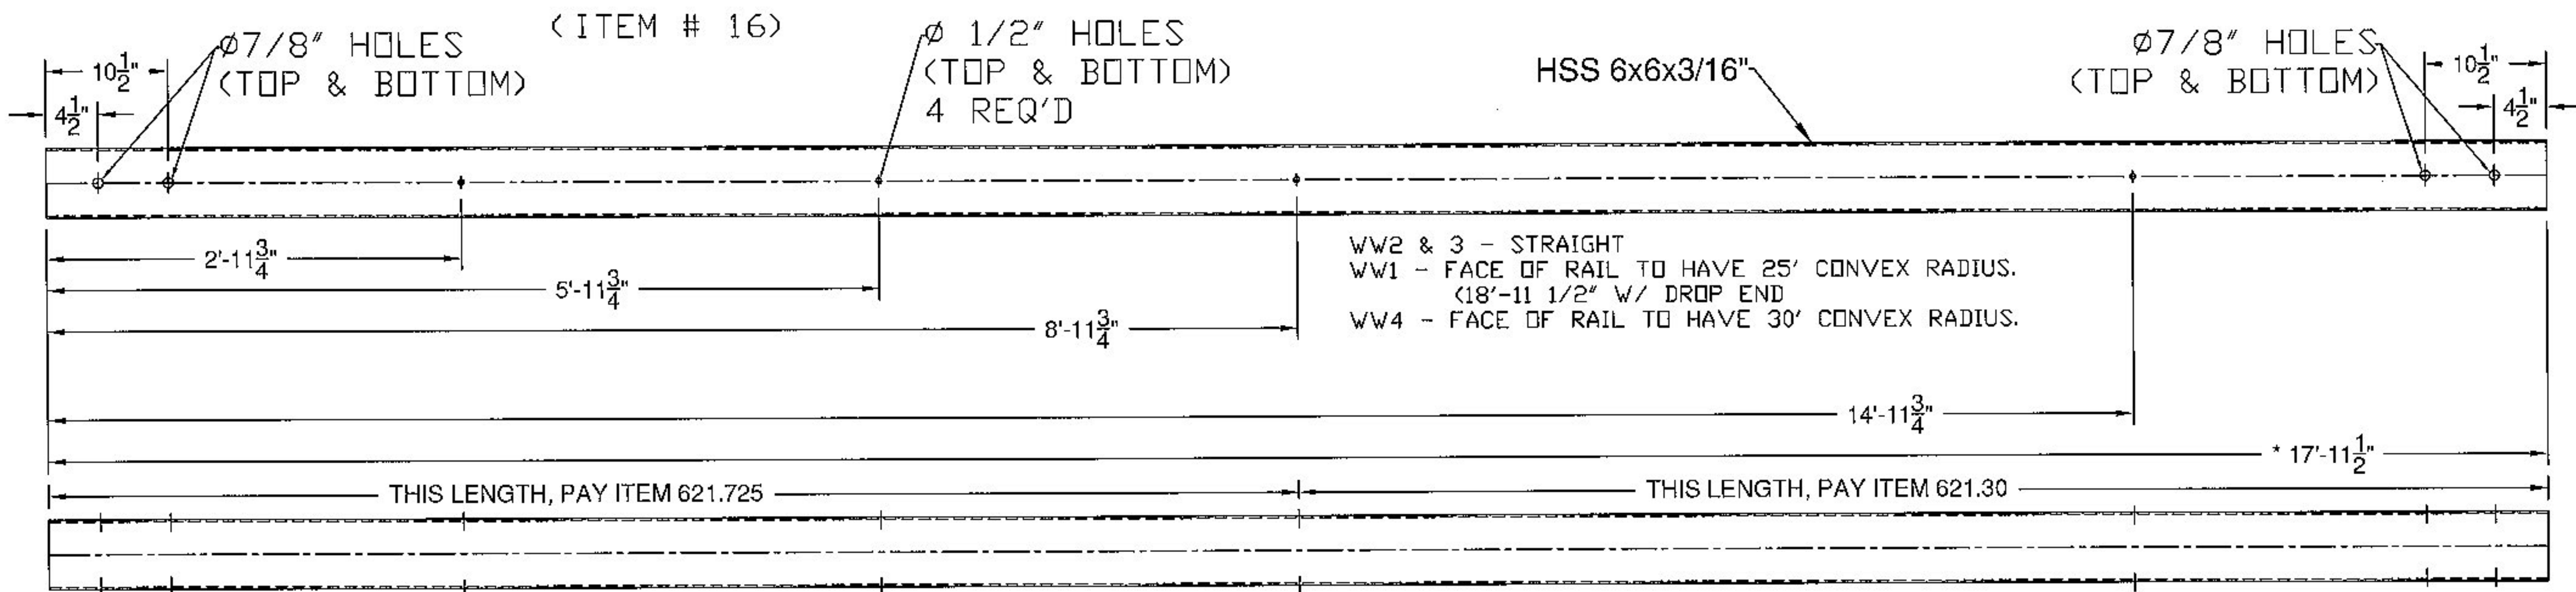



WW2 & 3 - STRAIGHT  
 WW1 - FACE OF RAIL TO HAVE 25' CONVEX RADIUS.  
 (18'-11 1/2" W/ DROP END)  
 WW4 - FACE OF RAIL TO HAVE 30' CONVEX RADIUS.

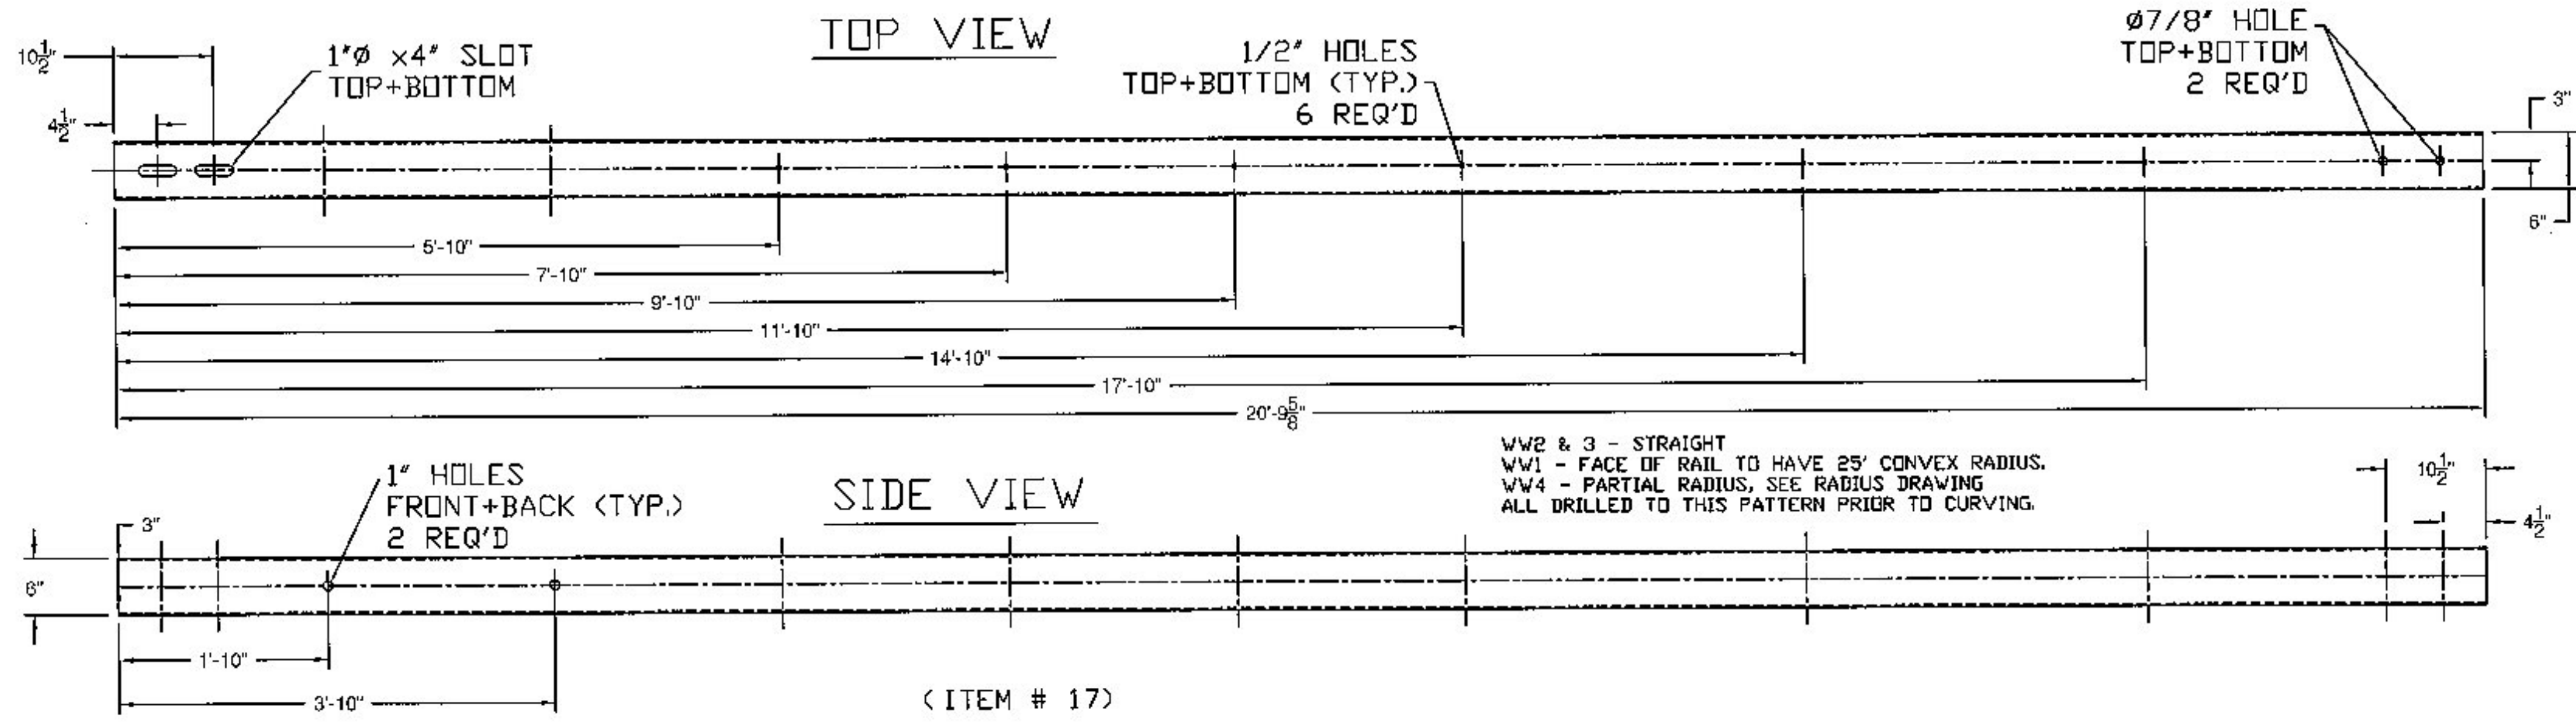


WW2 & 3 - STRAIGHT  
 WW1 - FACE OF RAIL TO HAVE 25' CONVEX RADIUS.  
 WW4 - PARTIAL RADIUS, SEE RADIUS DRAWING  
 ALL DRILLED TO THIS PATTERN PRIOR TO CURVING.

BILL OF MATERIALS				
ITEM #	PART #	QTY	DESCRIPTION	
1	0053.74005	1	IN-PR 5x5x5/16" TUBE @ 27'	
2	0053.74001	2	IN-PR SHIM PL 3/8x4x9 1/2"	
3	0053.74004	2	IN-PR SHIM PL 3/8x4x9 1/2" W/ HOLES	
4	0031.00002	3	IN-PR BACKER, 3/16"x1"x4"	
5	0053.74002	1	IN-PR FORMED BACKER PLATE	

NOTE: PART IS SYMMETRICAL

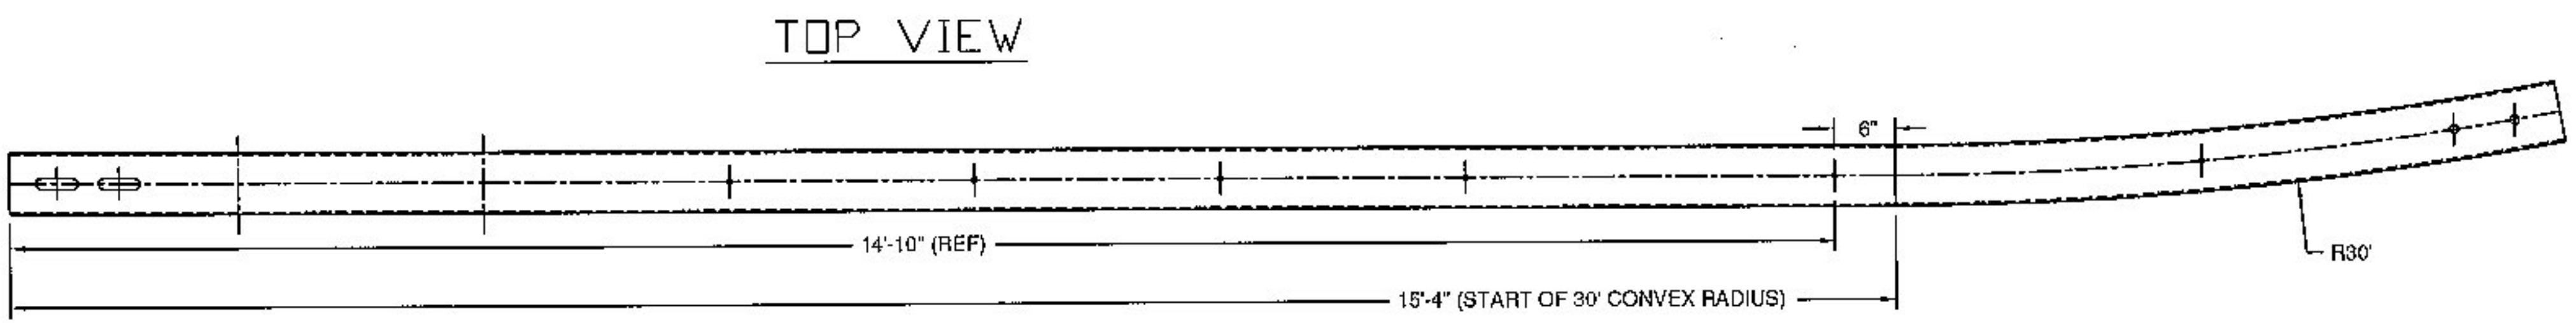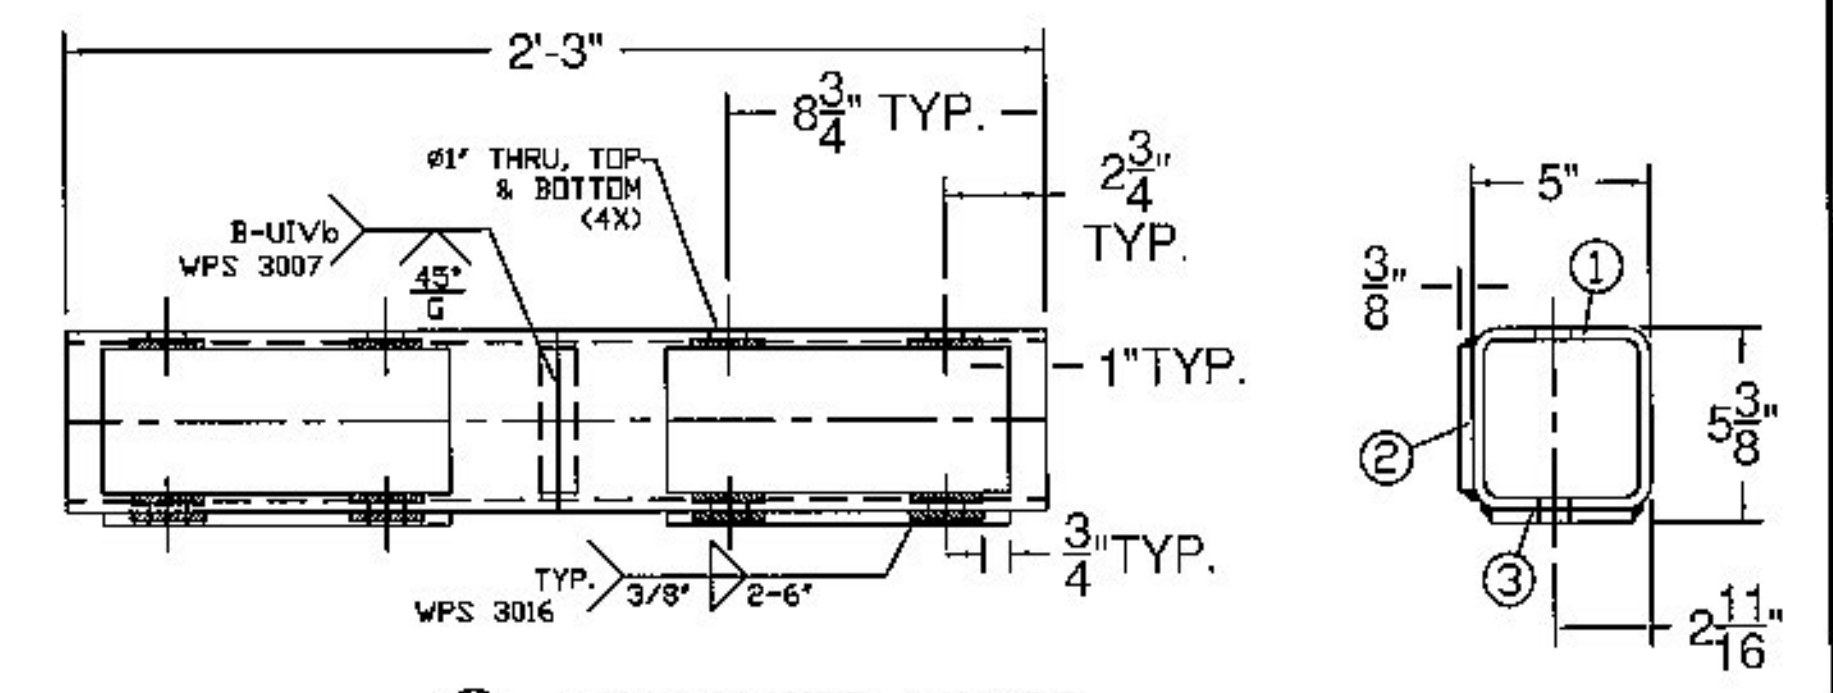


WW4 - PARTIAL RADIUS DETAIL

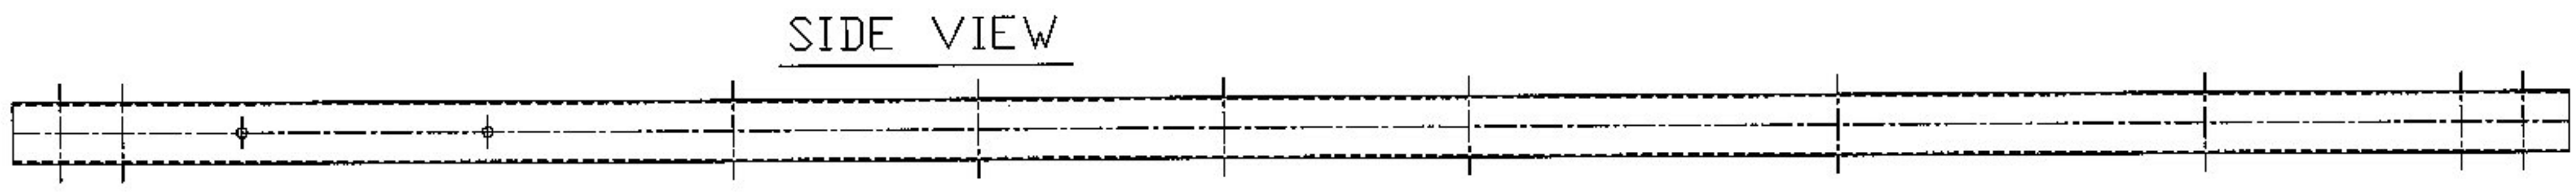

(ITEM # 17)

ITEM #: 621.725  
 STRUCTURAL STEEL TO COMPLY W/ ASTM A6  
 TOLERANCE UNLESS OTHERWISE NOTED:  
 FRACTIONS = ± 1/16"  
 ANGLES = ± 1/2"  
 DIAMETERS = ± 1/32"

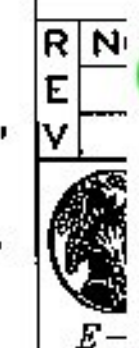





Vermont Agency of Transportation  
**RECEIVED**

OK'D BY CLB OK'D BY HIS

January 19, 2015



RESUBMIT NO Approved  
 BY C. CARLSON DATE 01/20/15

**SPLICE BAR - EXPANSION**

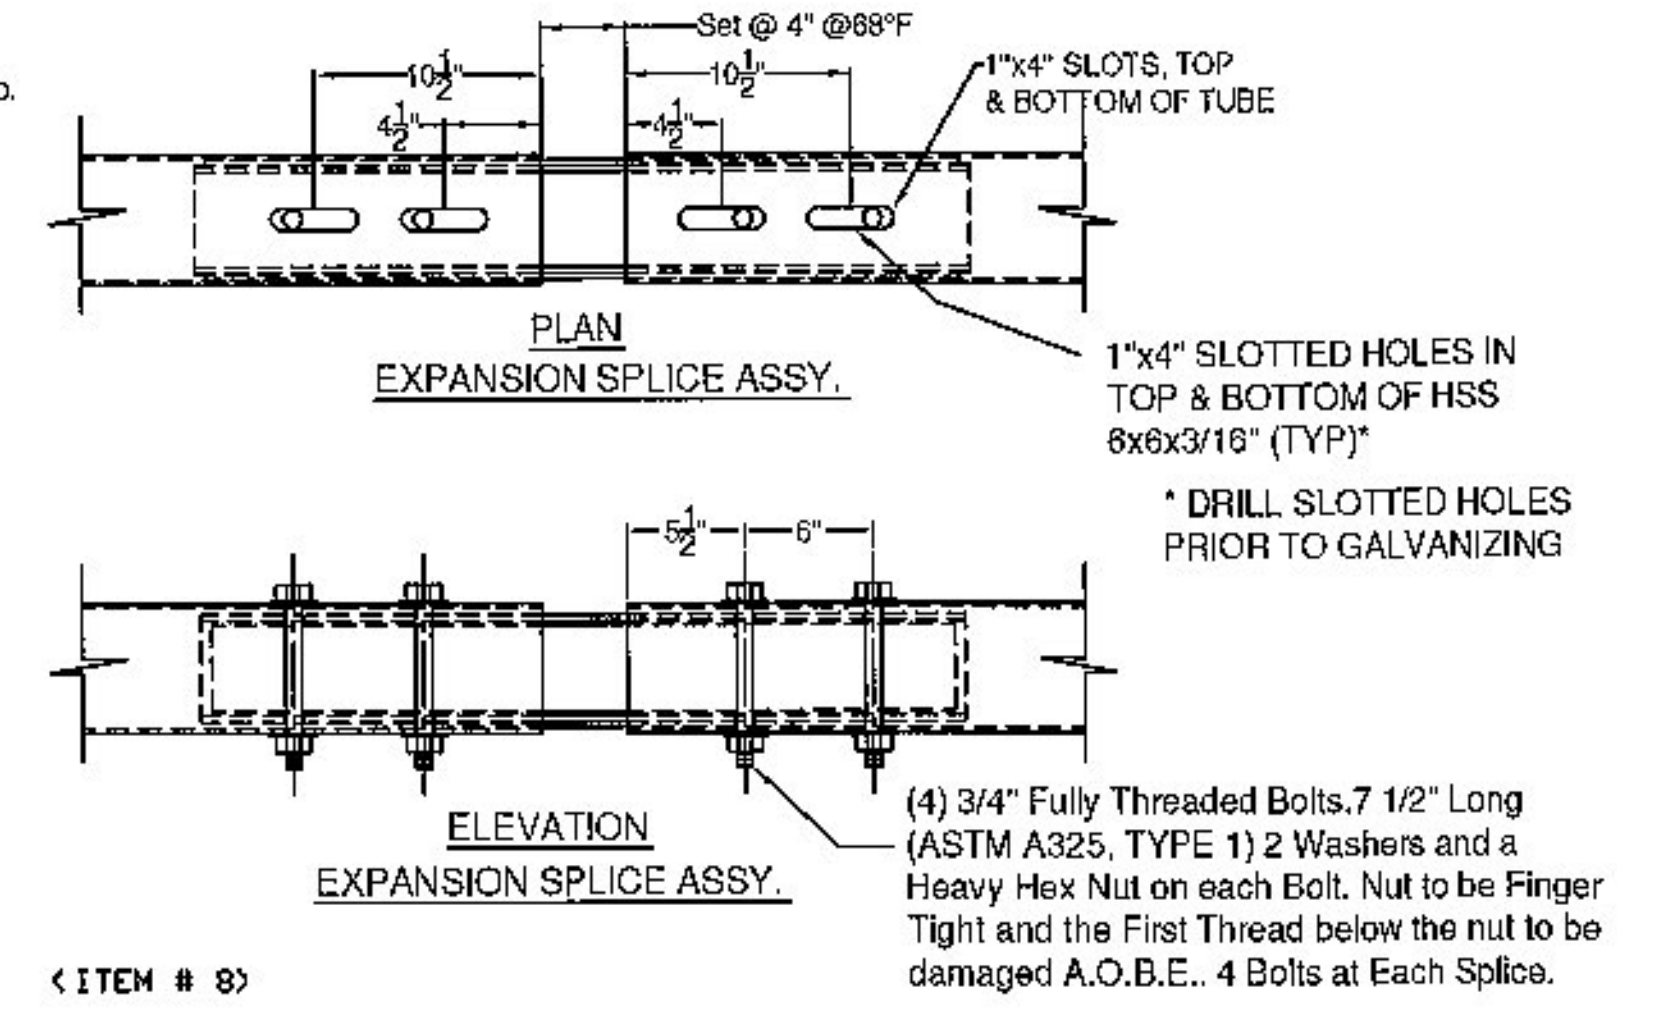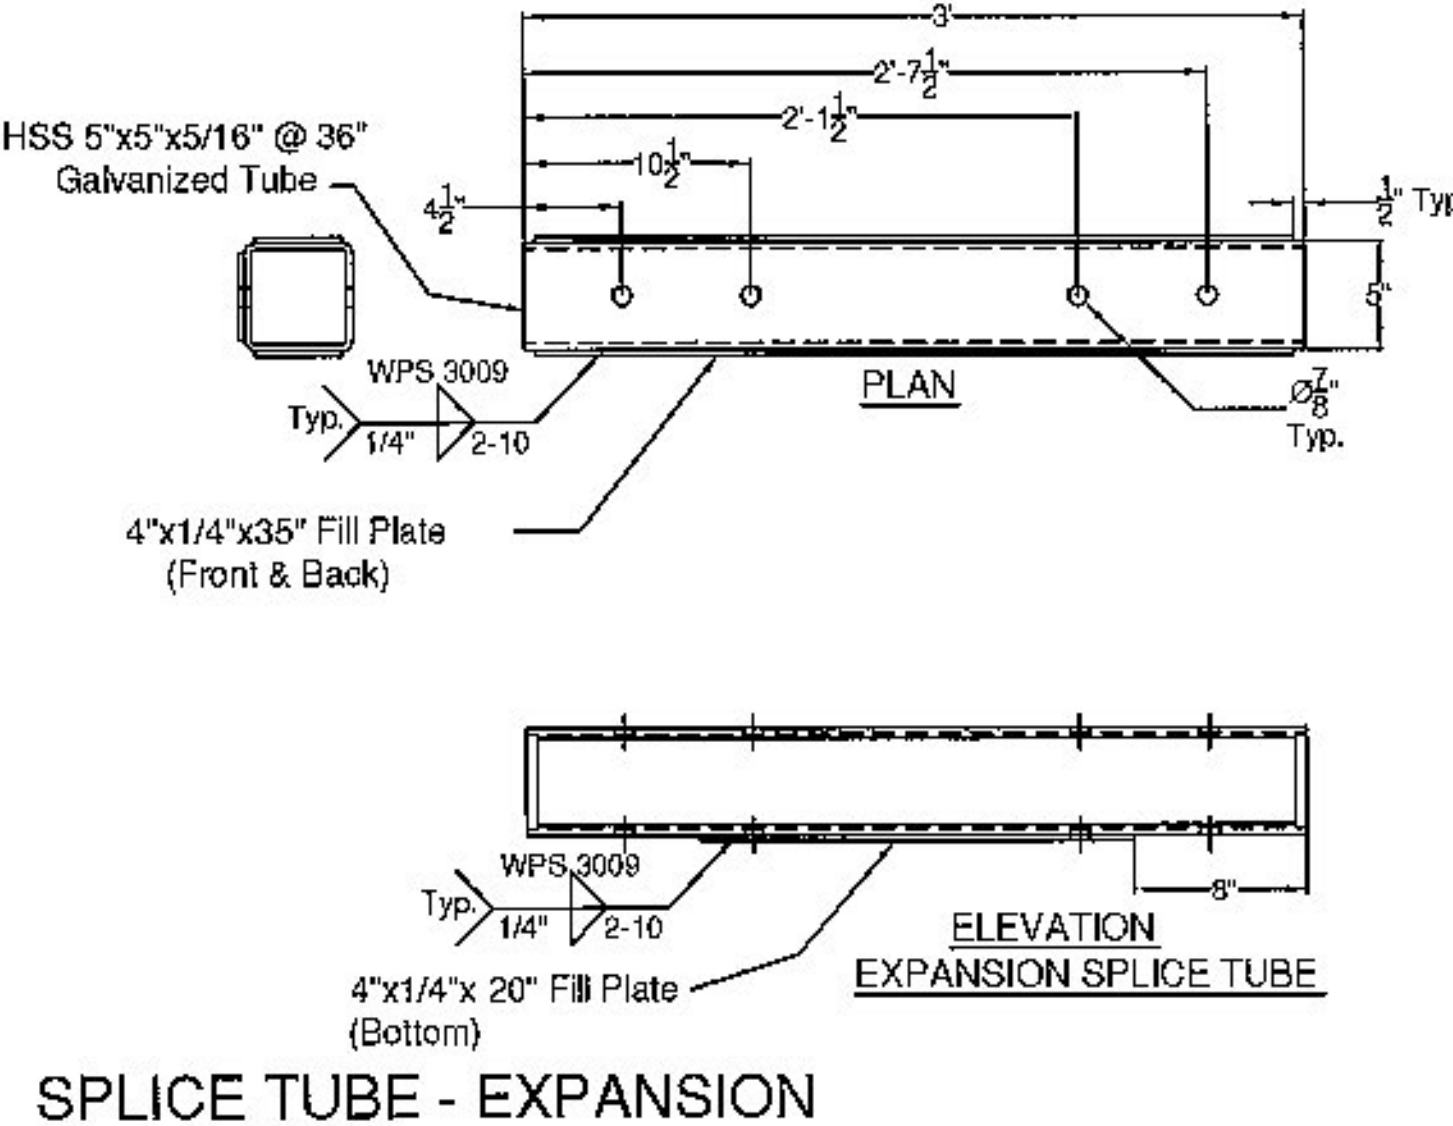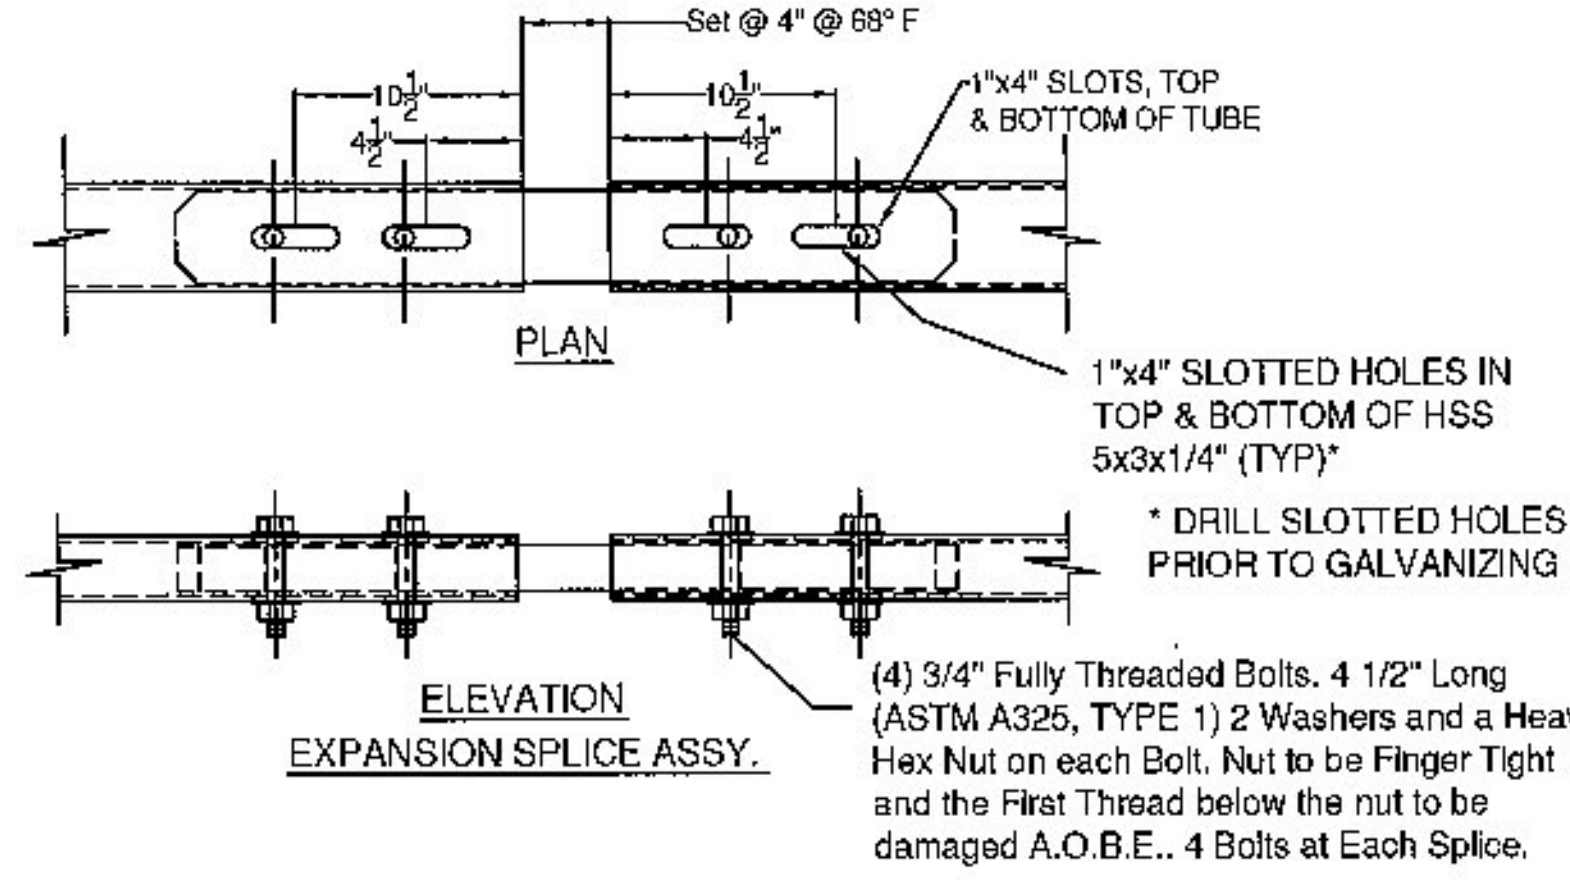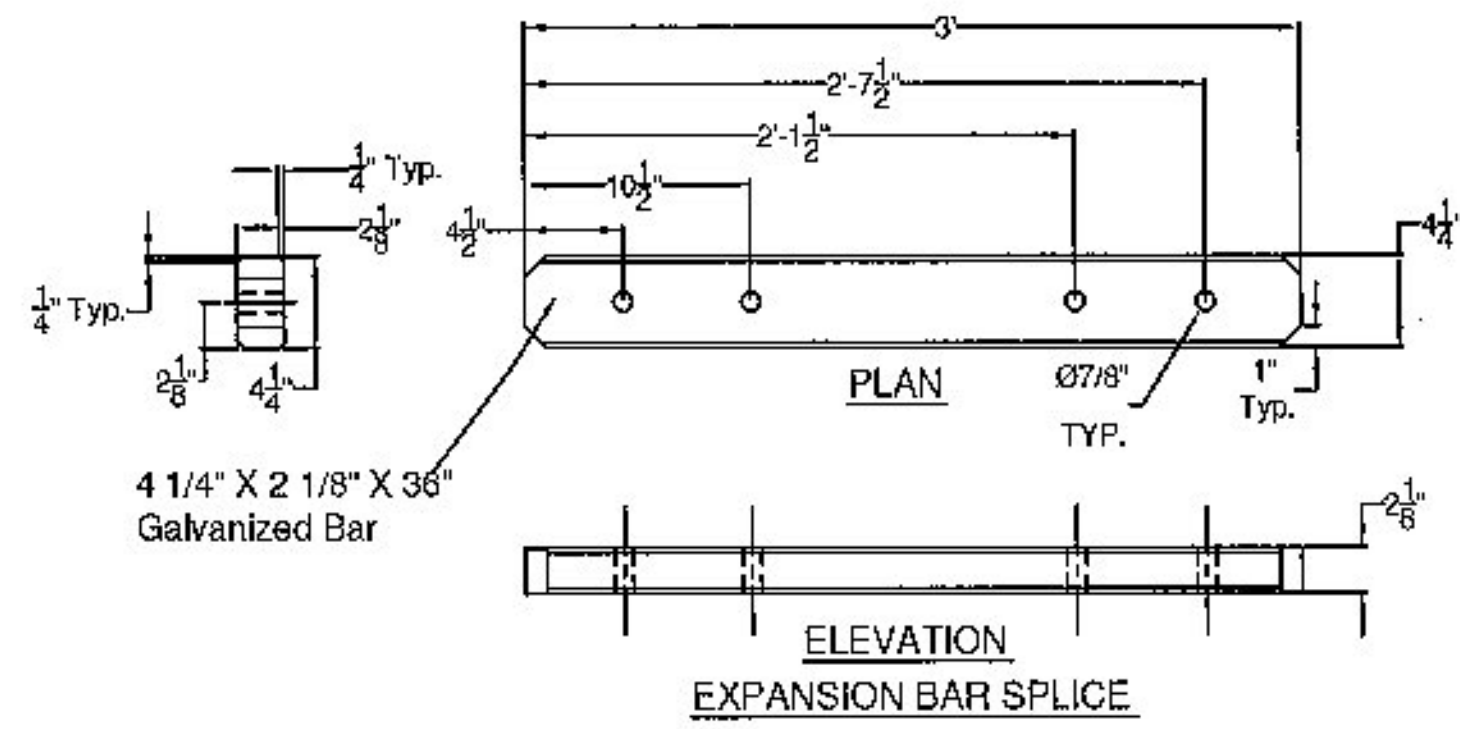

< ITEM # 9 >

< ITEM # 8 >

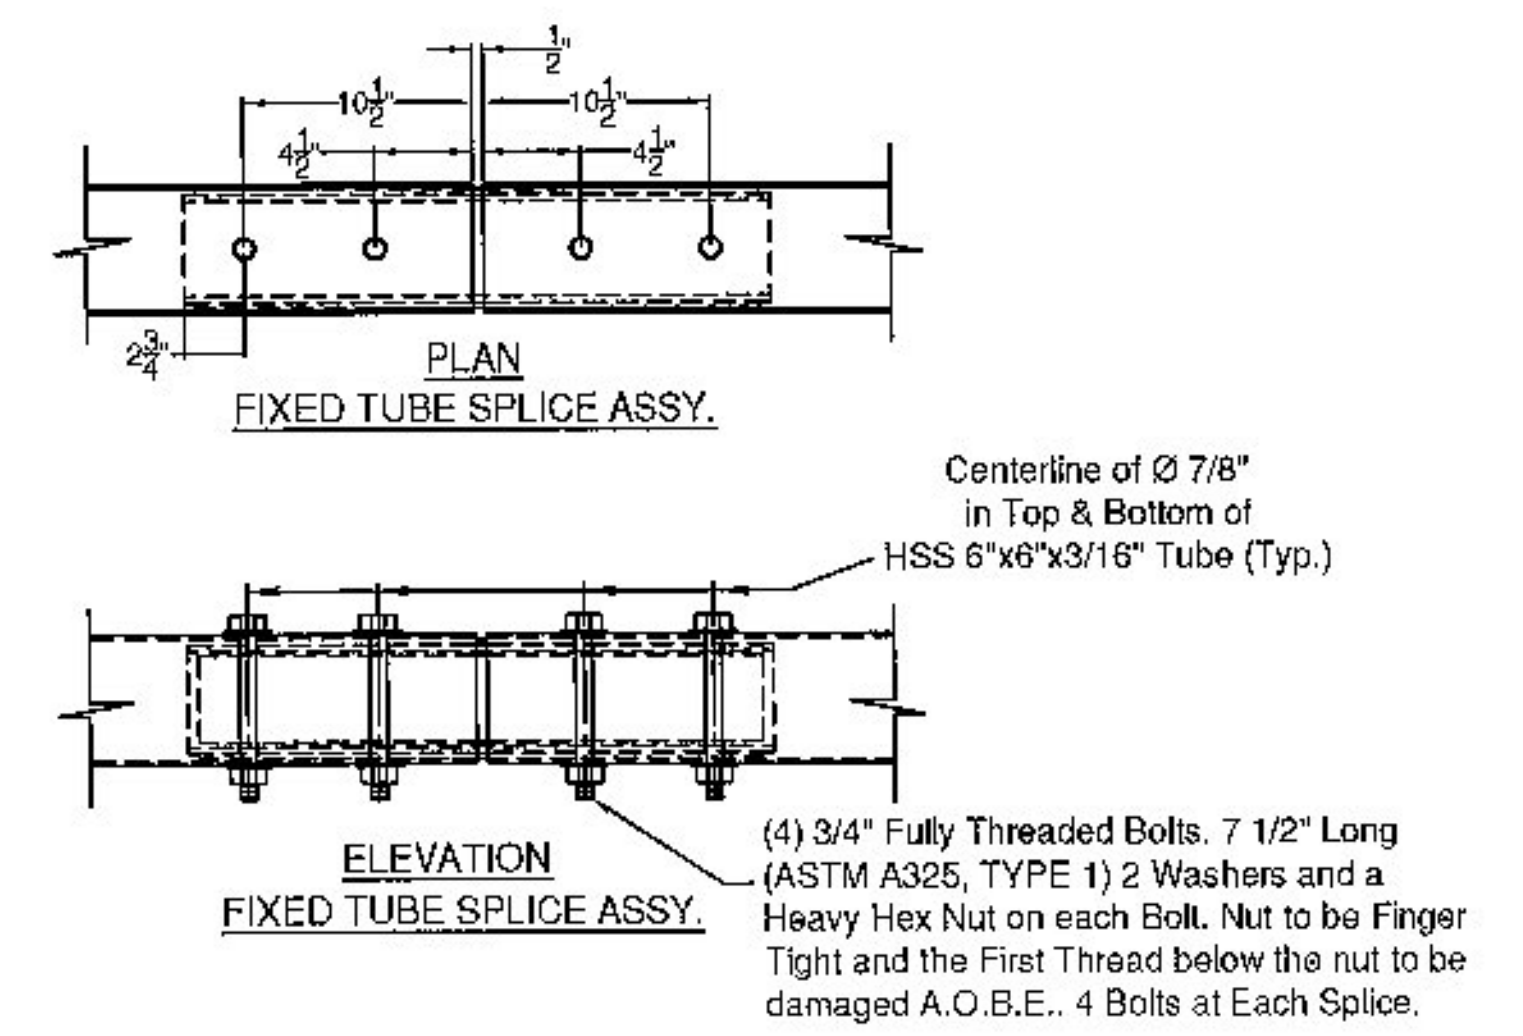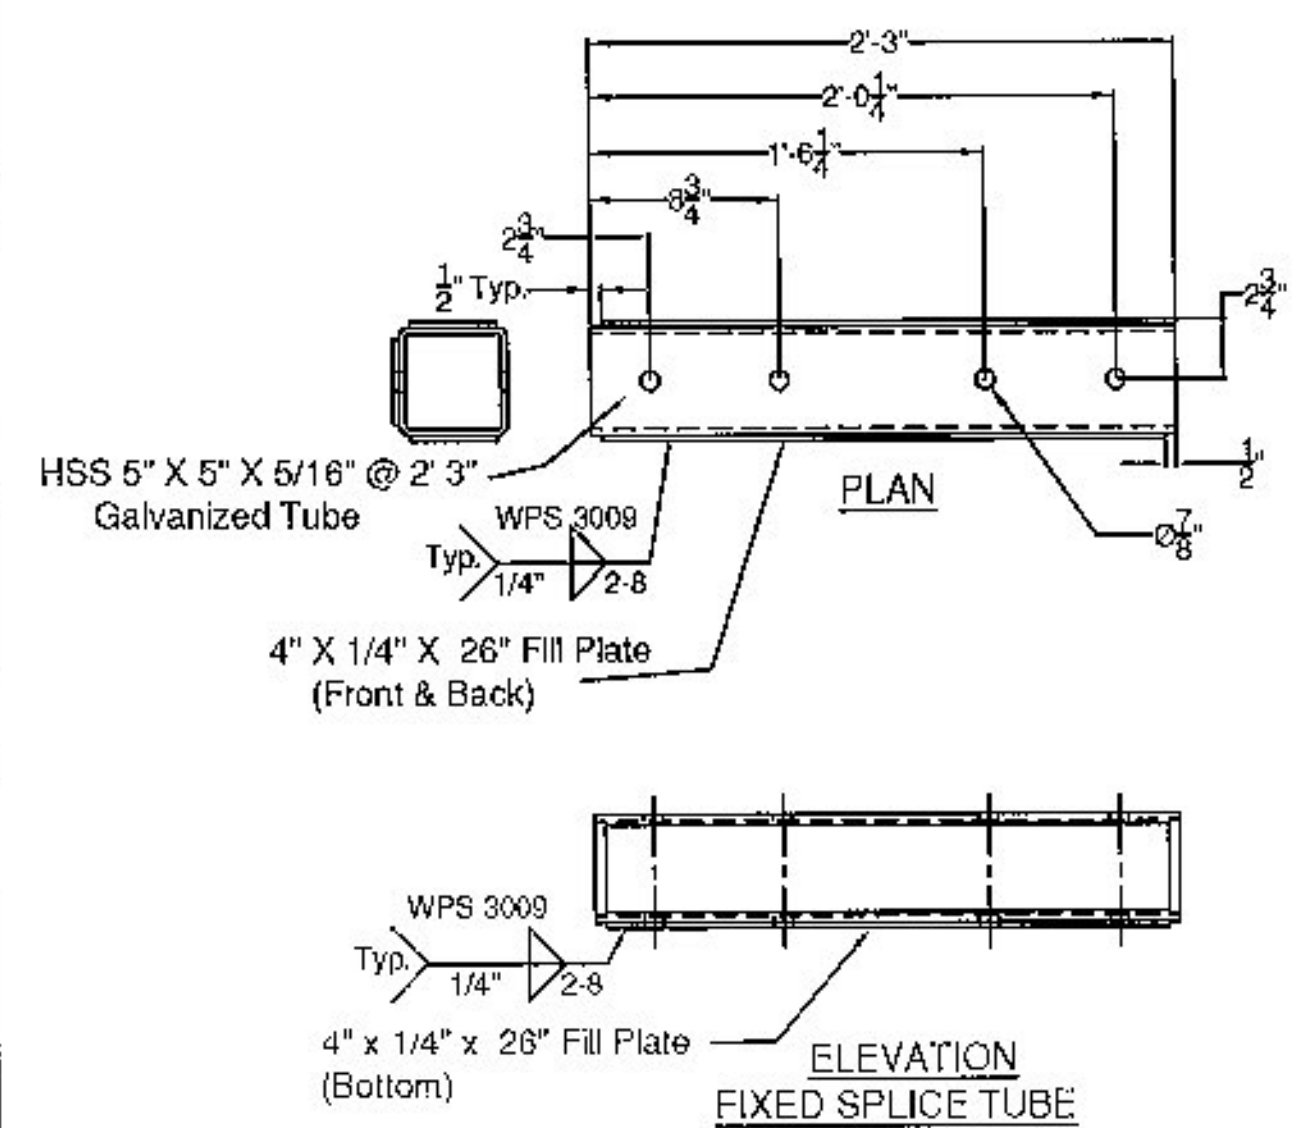

< ITEM # 7 >

**SPLICE TUBE - FIXED**

**Vermont Agency of Transportation**  
**RECEIVED**  
 CK'D BY CLB OK'D BY HIS  
**January 19, 2015**  
 RESUBMIT NO Approved  
 BY C. CARLSON DATE 01/20/15

ITEM #: 621.725

SHEET 5 OF 6

STRUCTURAL STEEL TO COMPLY W/ ASTM A6

**GRAS, GLV 3 RAIL BOX BEAM**  
 JOHNSON BRIDGE 030-2(26), VT ROUTE 15 (MINOR ARTERIAL) BRIDGE # 32  
 TOWN OF JOHNSON, COUNTY OF LAMOILLE, VT.



TOLERANCE UNLESS OTHERWISE NOTED:  
 FRACTIONS = ± 1/16"  
 ANGLES = ± 1/2"  
 DIAMETERS = ± 1/32"

R NO.	DATE	DESCRIPTION	BY	R NO.	DATE	DESCRIPTION	BY
E 1	1/15/15	UPDATED PER 1/8/15 MARK-UP	EP				
V							

DRAWN	E.P.	12/23/14
CHECKED	D.L.	12/23/14
APPROVED		
SCALE	SCHEMATIC	
DRAWING NO.	F.R. LAFAYETTE-JOHNSON	

**ELDERLEE, INC.**  
 OAKS CORNERS, NEW YORK 14518  
 E-Mail: [diong@elderlee.com](mailto:diong@elderlee.com) / [epcek@elderlee.com](mailto:epcek@elderlee.com)  
 Tel: 315-789-6670, Fax: 315-789-6615

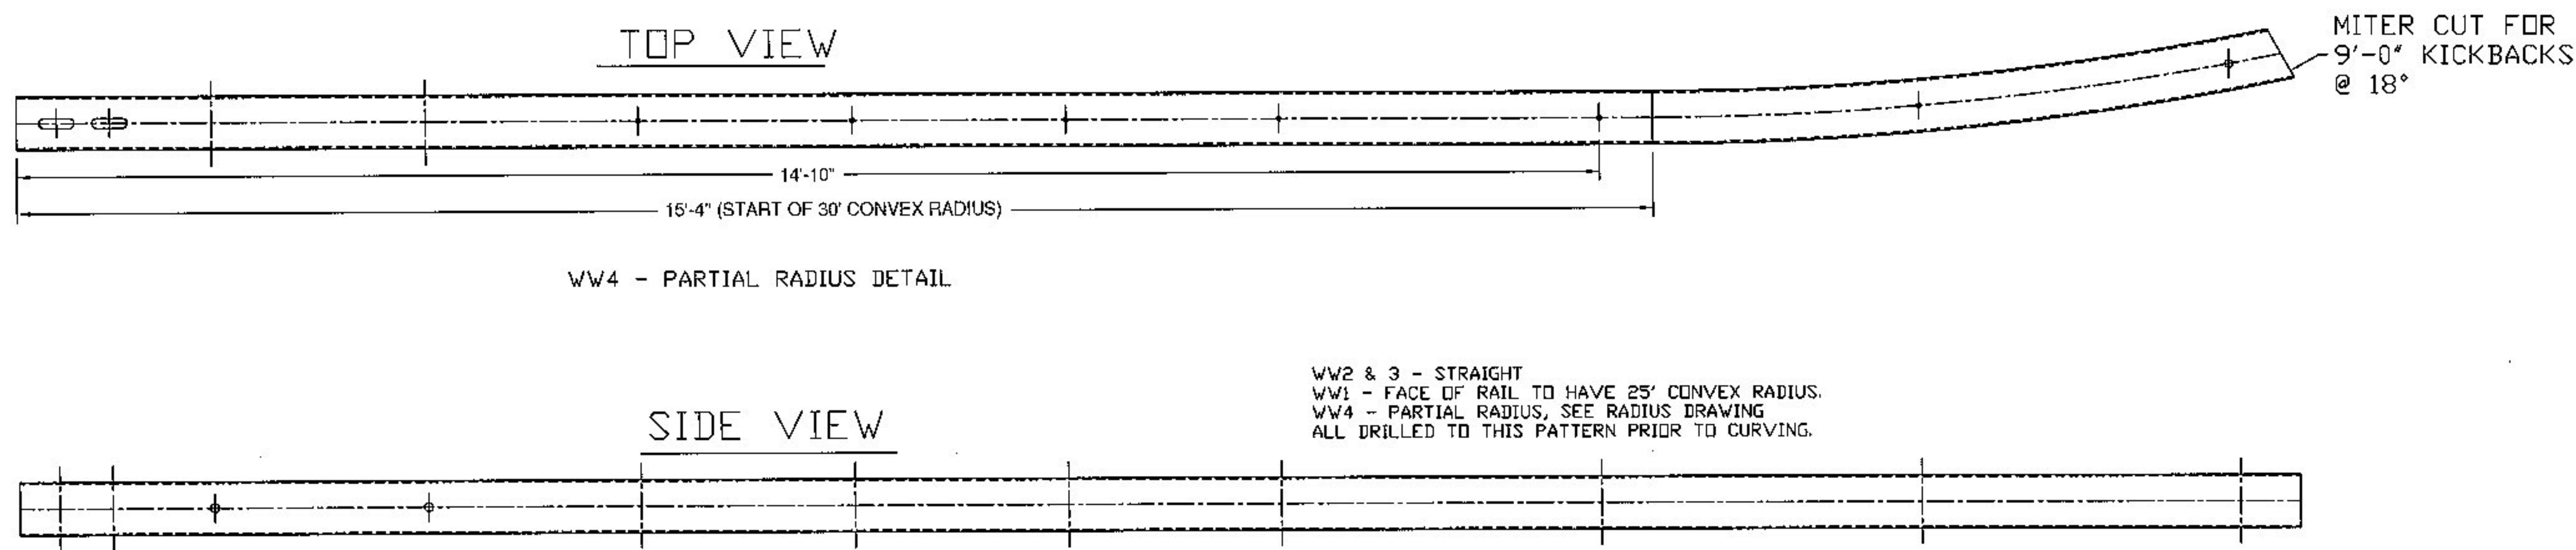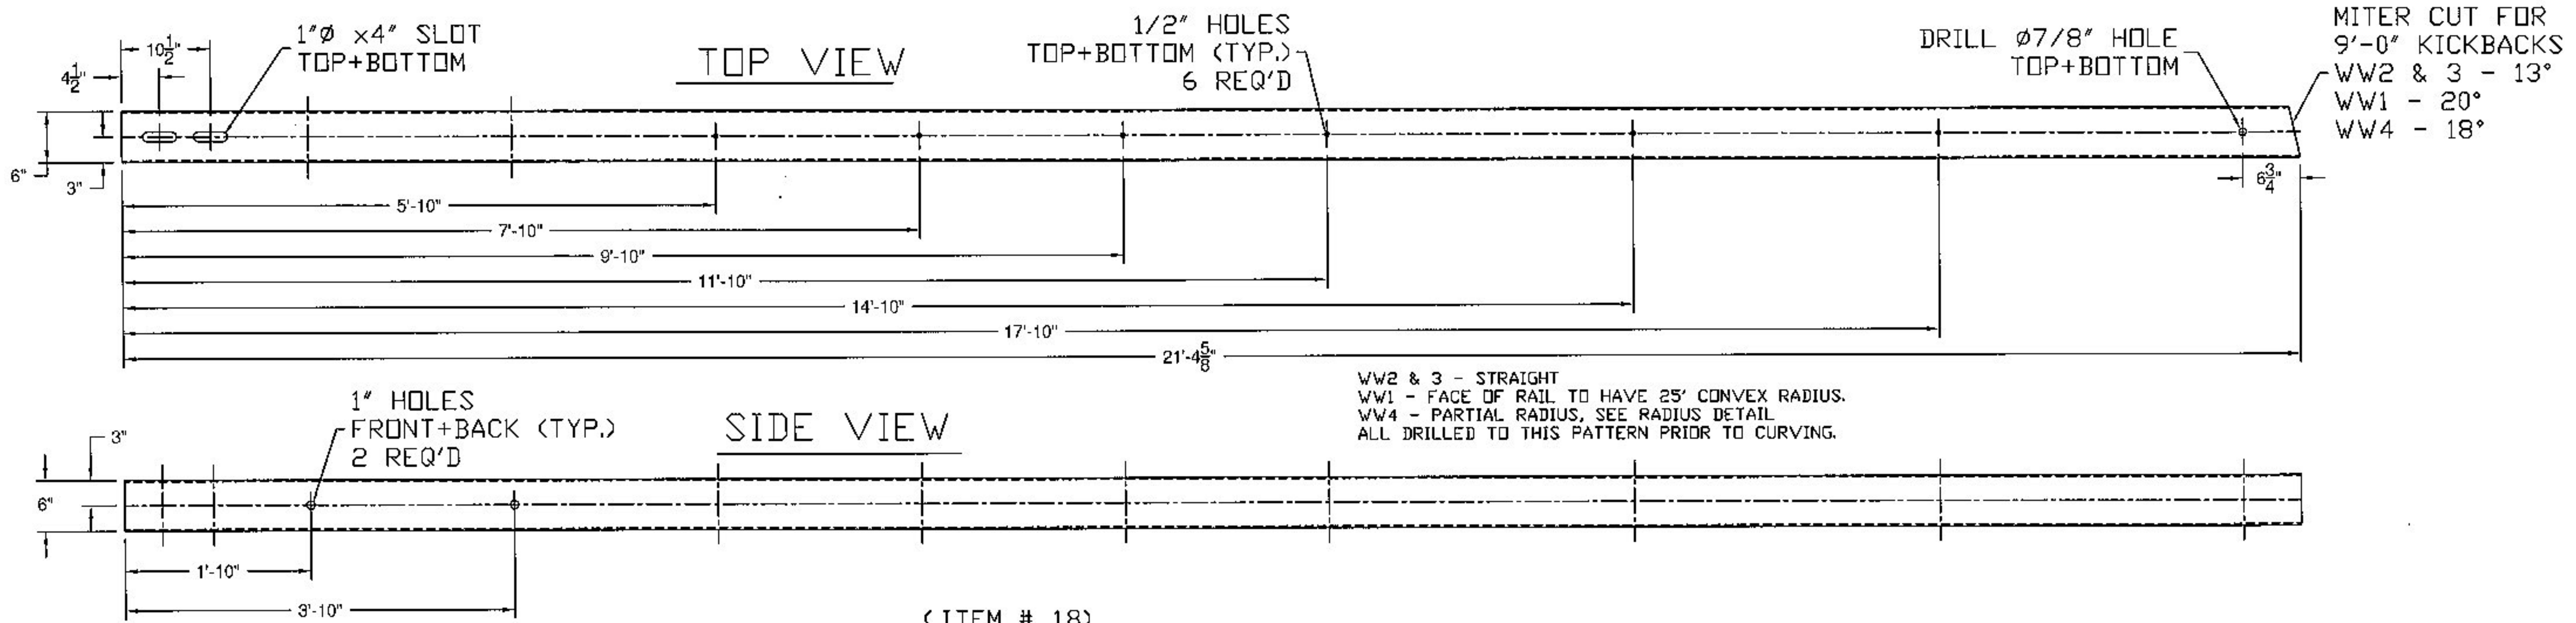

Vermont Agency of Transportation  
**RECEIVED**

CK'D BY CLB OK'D BY HIS  
 January 19, 2015  
 RESUBMIT NO Approved  
 BY C. CARLSON DATE 01/20/15

ITEM #: 621.725 SHEET 6 OF 6

STRUCTURAL STEEL TO COMPLY W/ ASTM A6


**GRAS, GLV 3 RAIL BOX BEAM**  
 JOHNSON BRF 030-2(26), VT ROUTE 15 (MINOR ARTERIAL) BRIDGE # 32  
 TOWN OF JOHNSON, COUNTY OF LAMOILLE, VT.

R NO.	DATE	DESCRIPTION	BY	R NO.	DATE	DESCRIPTION	BY
E 1	1/15/15	UPDATED PER 1/8/15 MARK-UP	EP	E			


TOLERANCE UNLESS OTHERWISE NOTED:  
 FRACTIONS = ± 1/16"  
 ANGLES = ± 1/2°  
 DIAMETERS = ± 1/32"

**ELDERLEE, INC.**  
 OAKS CORNERS, NEW YORK 14518  
 E-Mail: [dlong@elderlee.com](mailto:dlong@elderlee.com) / [epesk@elderlee.com](mailto:epesk@elderlee.com)  
 Tel: 315-789-6670 Fax: 315-789-6615


DRAWN	E.P.	12/23/14
CHECKED	D.L.	12/23/14
APPROVED		
SCALE	SCHEMATIC	
DRAWING NO. F.R. LAFAYETTE JOHNSON		

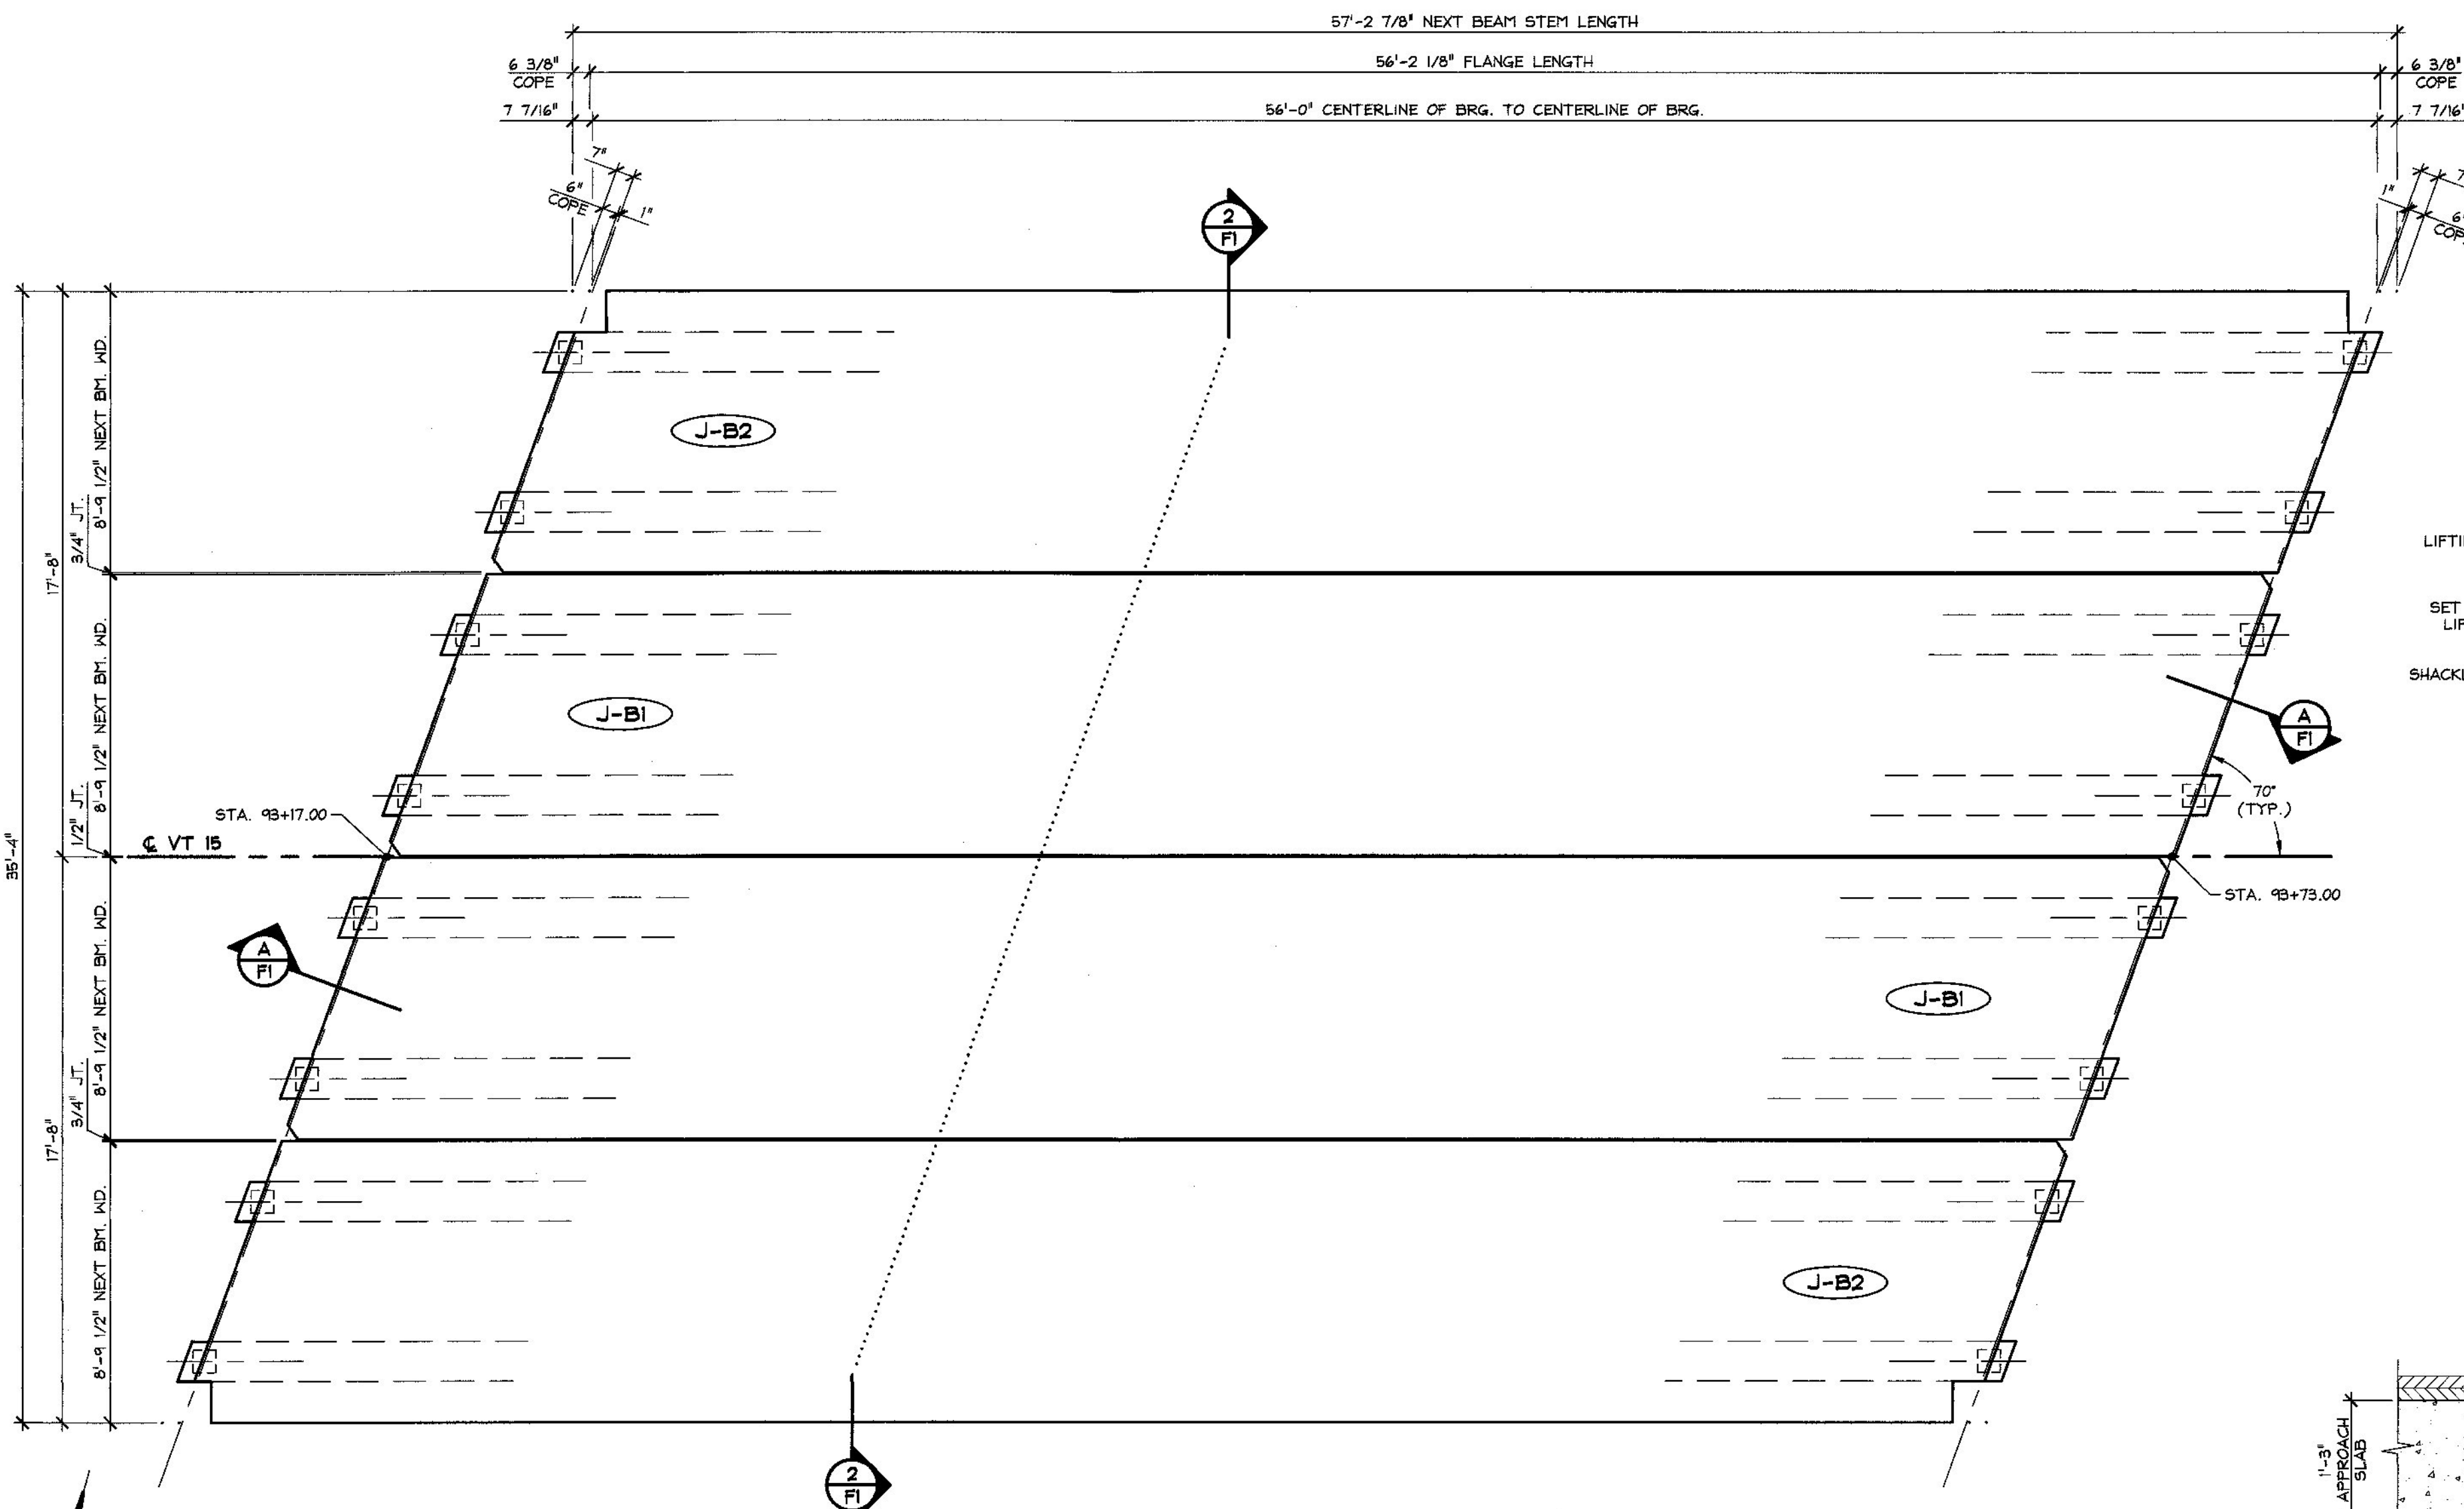

1 PRESTRESSED NEXT BEAM LAYOUT  
1/4" = 1'-0"

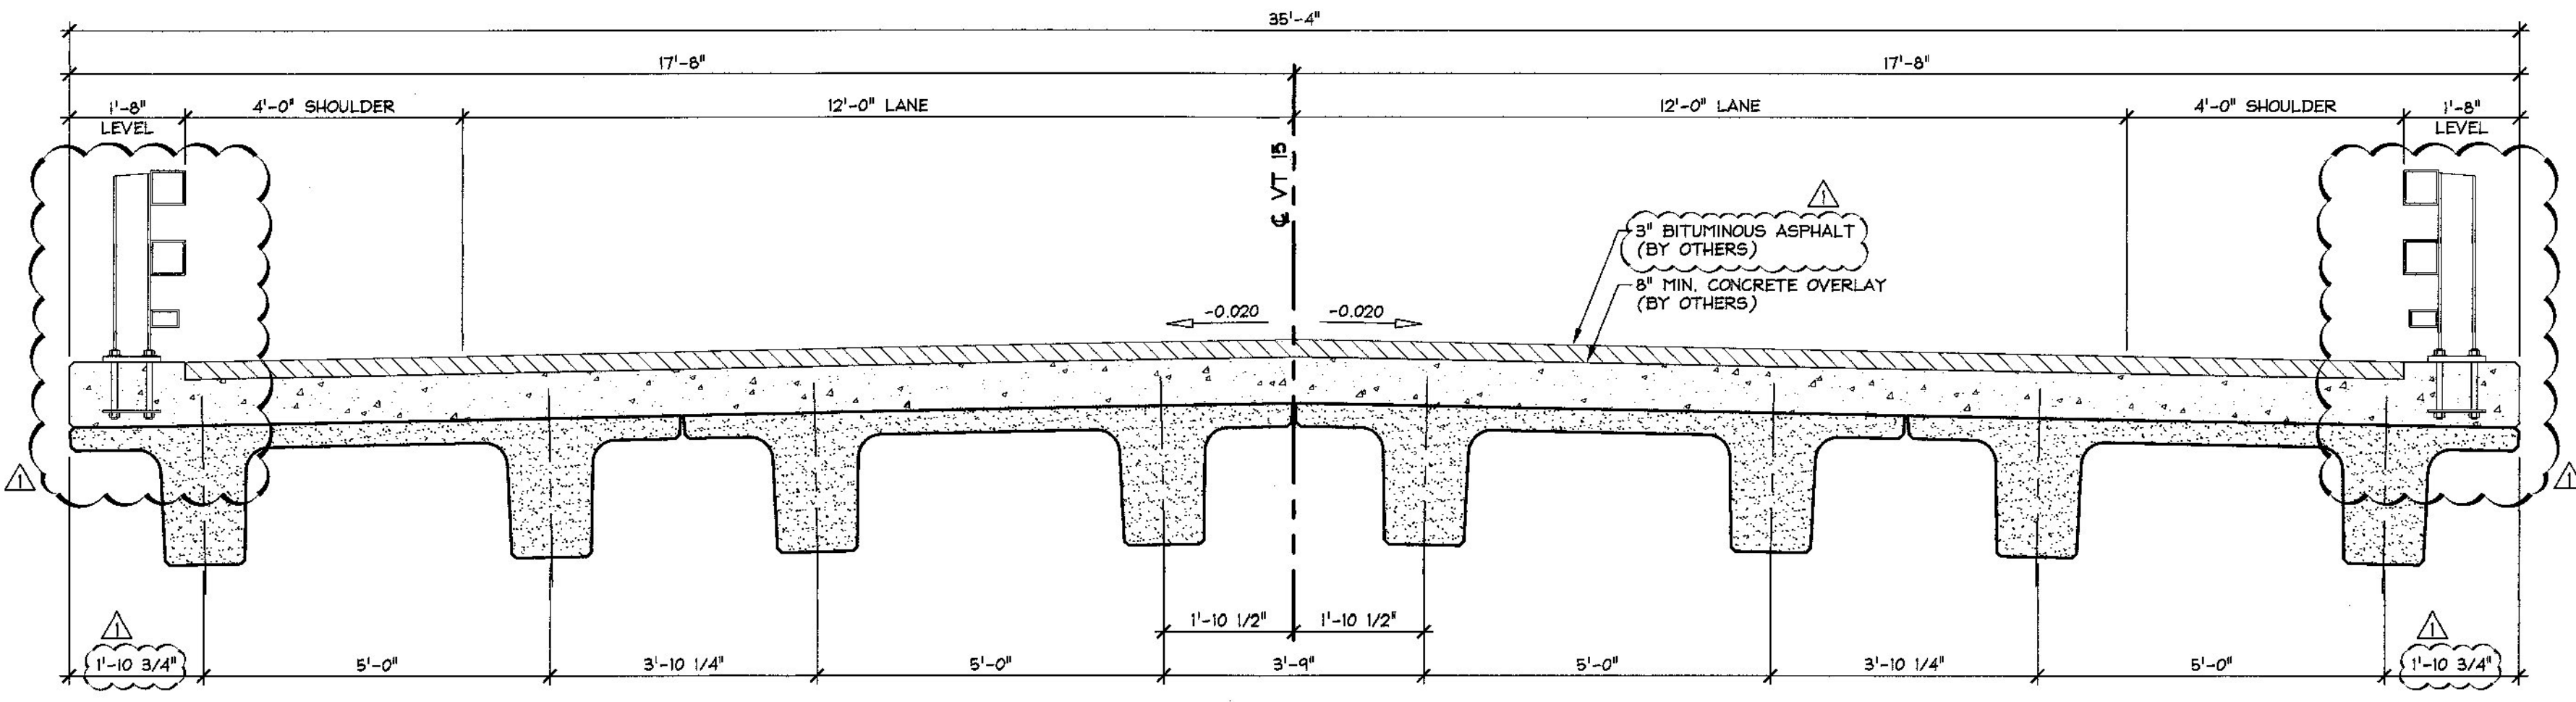


2 TRANSVERSE SECTION  
1/2" = 1'-0"

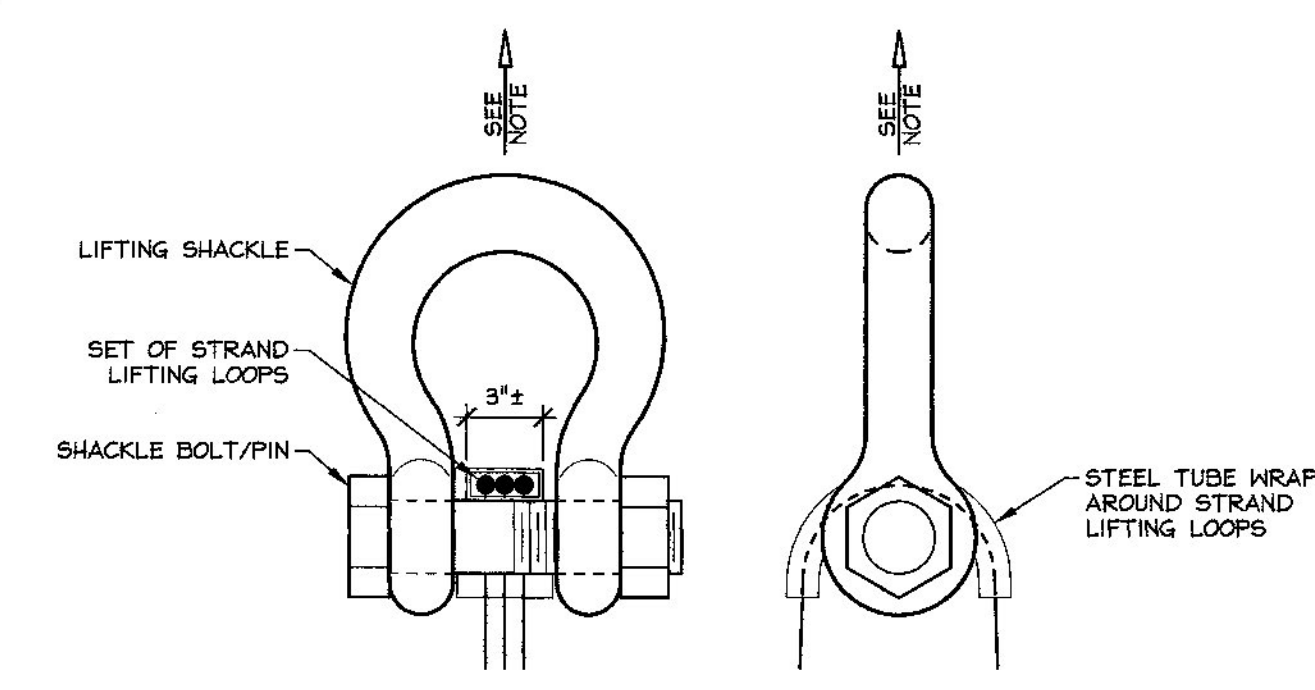

NOTE: BEAMS SHALL BE HANDLED AND ERECTED USING THE LIFTING LOOPS ONLY. RIGGING SHALL BE CONFIGURED SUCH THAT EQUAL FORCES ARE APPLIED TO EACH SET OF LIFTING LOOPS AT EACH END OF THE BEAM. SHACKLE BOLT/PIN SHALL BE PLACED UNDER LIFT LOOPS AS SHOWN. DESIGN AND CONFIGURATION OF RIGGING BY PURCHASER.

LIFTING SHACKLE DETAILS  
N.T.S.

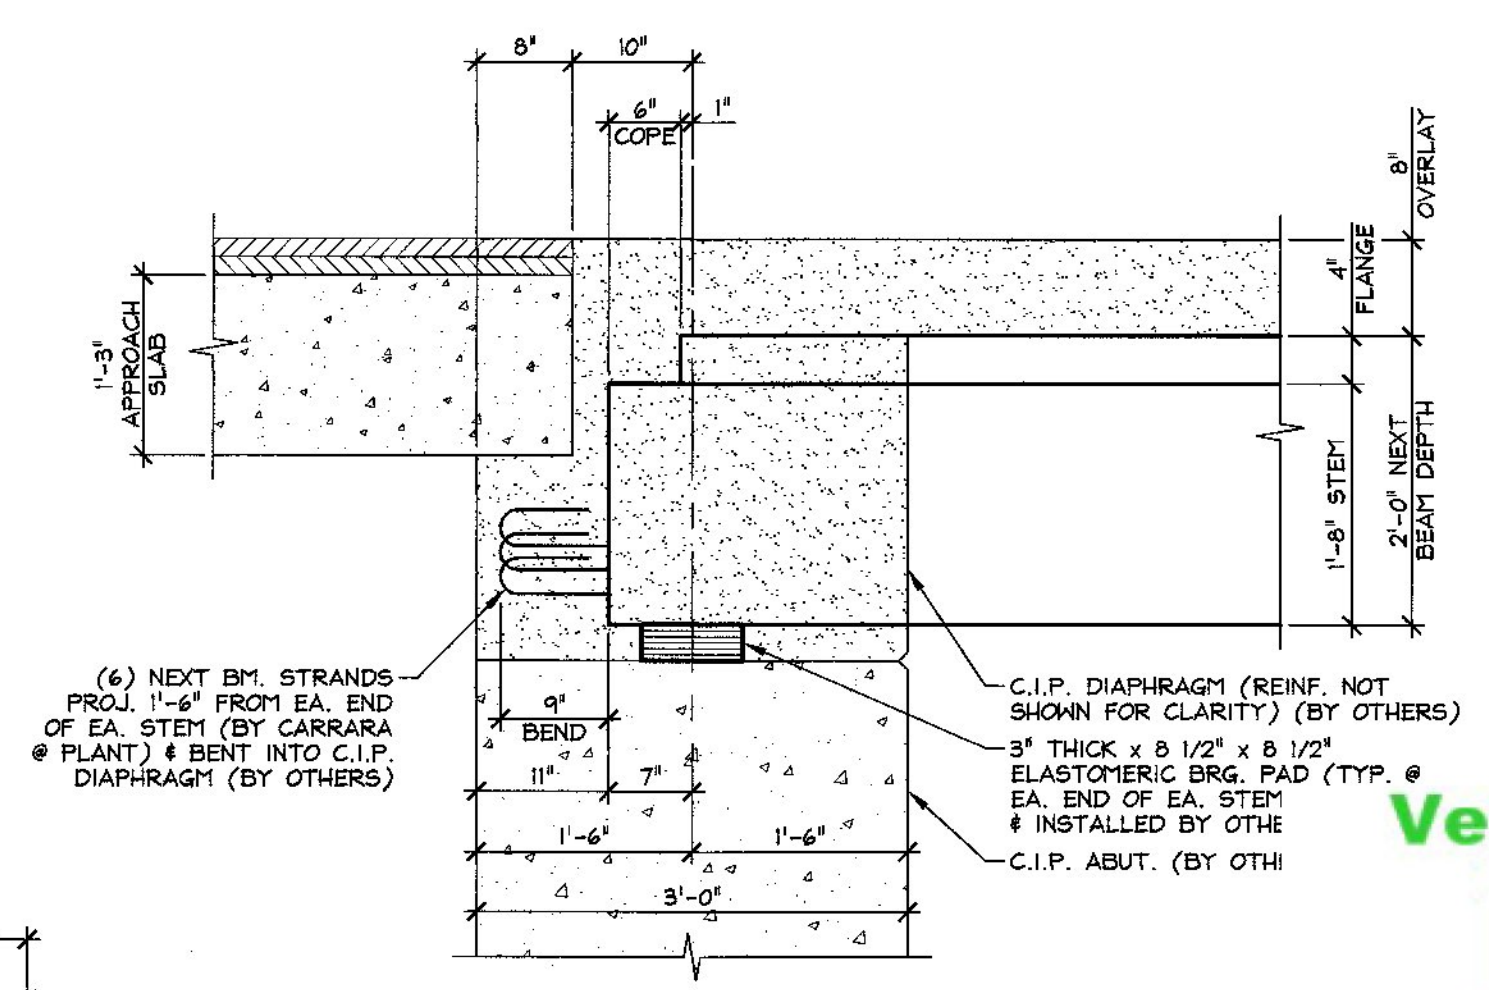

A BEARING SECTION  
1/4" = 1'-0"

GENERAL NOTES

- MIN. CONCRETE STRENGTH AT 28 DAYS SHALL BE 10,000 PSI.
- MIN. CONCRETE STRENGTH AT STRESS TRANSFER SHALL BE 6,500 PSI.
- REINFORCING STEEL SHALL BE GR-60, ASTM A-615 (AASHTO M31) AND SHALL BE LEVEL II (DUAL COATED).
- PRESTRESSING STRANDS SHALL CONFORM TO ASTM A-416 (AASHTO M203) AND SHALL CONSIST OF 0.60" x 270 KSI 7-WIRE LOW RELAXATION STRANDS.
- PRESTRESSING STRANDS SHALL EACH BE PULLED TO HAVE A NET TENSION OF 44.0 K AFTER ACCOUNTING FOR CHUCK SLIPPAGE. TENSION SHALL BE VERIFIED BY MEASURING STRAND ELONGATION. (SEE EXAMPLE ELONGATION CALCULATION AND TENSIONING PROCEDURE, THIS SHEET.)
- ENDS OF PRESTRESSING STRANDS SHALL BE CUT 3"± FROM END OF BEAM STEMS (UNLESS NOTED AS PROJECTING STRANDS, SEE BEAM DETAILS).
- ALL EXPOSED CORNERS SHALL BE CHAMFERED 3/4".
- THE TOP OF BEAMS SHALL RECEIVE A TRANSVERSE RAKE FINISH ROUGHENED TO 1/4" AMPLITUDE.
- BEAMS SHALL BE HANDLED AND ERECTED USING THE LIFTING LOOPS ONLY. THE MINIMUM SLING ANGLE FROM THE HORIZONTAL SHALL BE 60°. THE PINS OF THE SHACKLES SHALL BE PLACED THROUGH THE LIFTING LOOPS. SEE DETAIL, THIS SHEET. BEAMS SHALL BE STORED AND TRANSPORTED WITH TIMBER SUPPORTS WITHIN 2'-0" OF THE BEAM ENDS, UNLESS APPROVED BY J.P. CARRARA & SONS, INC.
- MATERIAL SPECIFICATION AND MIX DESIGN SHALL CONFORM TO VERMONT SPEC. P510.02 AND P510.05 RESPECTIVELY. DESIGN MIX: J.P.C. BRIDGE MIX #430M
- QUALITY CONTROL PROCEDURES ARE IN ACCORDANCE WITH PCI REQUIREMENTS. J.P. CARRARA & SONS, INC. IS A PCI CERTIFIED PLANT.
- CURING METHOD: AS SOON AS THE TOP OF BEAM IS FINISHED, AN INSULATED TARP WILL BE PLACED OVER THE BEAM. THE AMBIENT ENCLOSURE AND INTERNAL CONCRETE TEMPERATURE SHALL BE RECORDED BY AUTOMATIC SENSOR INSTRUMENTS ON GRAPH CHARTS, SPACED NOT MORE THAN 100' APART AND WILL CONTINUE UNTIL RELEASE STRENGTH IS ACHIEVED. RADIANT EXTERNAL HEAT SHALL BE APPLIED IF NECESSARY TO MAINTAIN CURING ENVIRONMENT TEMPERATURE AND/OR TO ACHIEVE THE NECESSARY DETENSIONING STRENGTH. EACH CHART SHALL BE MARKED.
- COLD WEATHER STORAGE PROVISIONS: IN THE EVENT THAT AMBIENT TEMPERATURES IMMEDIATELY FOLLOWING DETENSIONING ARE MORE THAN 40°F BELOW THE INTERIOR CONCRETE TEMPERATURE AS MEASURED BY AUTOMATIC SENSORS, THE BEAMS SHALL BE RE-COVERED AND THE ENCLOSURE ENVIRONMENT MAINTAINED WITHIN 40°F OF THE BEAM TEMPERATURE FOR A MINIMUM OF 48 HOURS IN ACCORDANCE WITH PCI MNL 116 4.19.1.6 AND ACI 308 3.4.4.

EXAMPLE PRESTRESSING STRAND ELONGATION CALC. AND TENSIONING

(NOT TO BE USED FOR CONSTRUCTION)

SIZE & GRADE: 0.60" x 270 KSI  
AREA: 0.217 IN²  
TENSION: 44,000 LB. EACH STRANDS  
GRIP-TO-GRIP: 252'-0" = 252.00'  
E_s = 28,600,000 PSI (ASSUMED FOR THESE CALCULATIONS; VALUE TO BE OBTAINED FOR STRAND SPOOL ACTUALLY USED)

EXAMPLE:  
 $\Delta = \frac{P_L}{AE} = \frac{(44,000 - 3,000) \times 252.00 \times 12}{0.217 \times 28,600,000} = 19.98"$

THEREFORE: (TOLERANCES ± 5%)  
 $\Delta$  UPPER LIMIT = 1.05 x 19.98" = 20.98" = 21"  
 $\Delta$  LOWER LIMIT = 0.95 x 19.98" = 18.98" = 19"

EXTRA FORCE REQUIRED TO COMPENSATE FOR 1/2" CHUCK SLIPPAGE:  
 $\Delta P = \frac{0.5 \times 41,000}{19.98} = 1,026$  LBS.

TOTAL TENSIONING FORCE = 44,000 + 1,026 = 45,026 LBS.

STRAND TENSIONING PROCEDURE:


- PULL EACH STRAND INITIALLY TO 3,000* LBS. AND MARK STRAND.
  - THEN PULL EACH STRAND TO A TOTAL TENSION OF 45,026* LBS. AND MEASURE ELONGATION AFTER SEATING. IT MUST BE BETWEEN 18" & 21".
- * NOTE: FORCES READ ON STRESSING JACK GAUGES MUST BE MADE TO CORRESPOND TO ABOVE VALUES BASED ON CALIBRATION DATA FOR SPECIFIC JACK USED.

Vermont Agency of Transportation  
**RECEIVED**


CK'D BY CLB OK'D BY HIS  
November 20, 2014  
RESUBMIT NO Approved  
BY C. CARLSON DATE 11/21/14

11-5-14 REVISED AS NOTED


APPROVAL STAMP:	J.P. CARRARA & SONS INC. Precast & Prestress Manufacturer 2444 GSE STR. MIDDLEBURY, VERMONT 05753 Phone: (802)388-6361 Fax: (802)388-6010	A.L. ST. ONGE CONTRACTOR MONTMERY, VERMONT
STATE OF VERMONT AGENCY OF TRANSPORTATION COUNTY OF LAMOILLE		DATE: SEPT. 30, 2014 SCALE: NOTED
CITY OF JOHNSON ROUTE NO. VT 15 (MINOR ARTERIAL) BRIDGE NO.: 32 PROJECT NO.: BRF 030-2(26)		CHKD: - DFTM: B.L. JOB NO: 23442-014
COVER SHEET		DWG. NO: F1

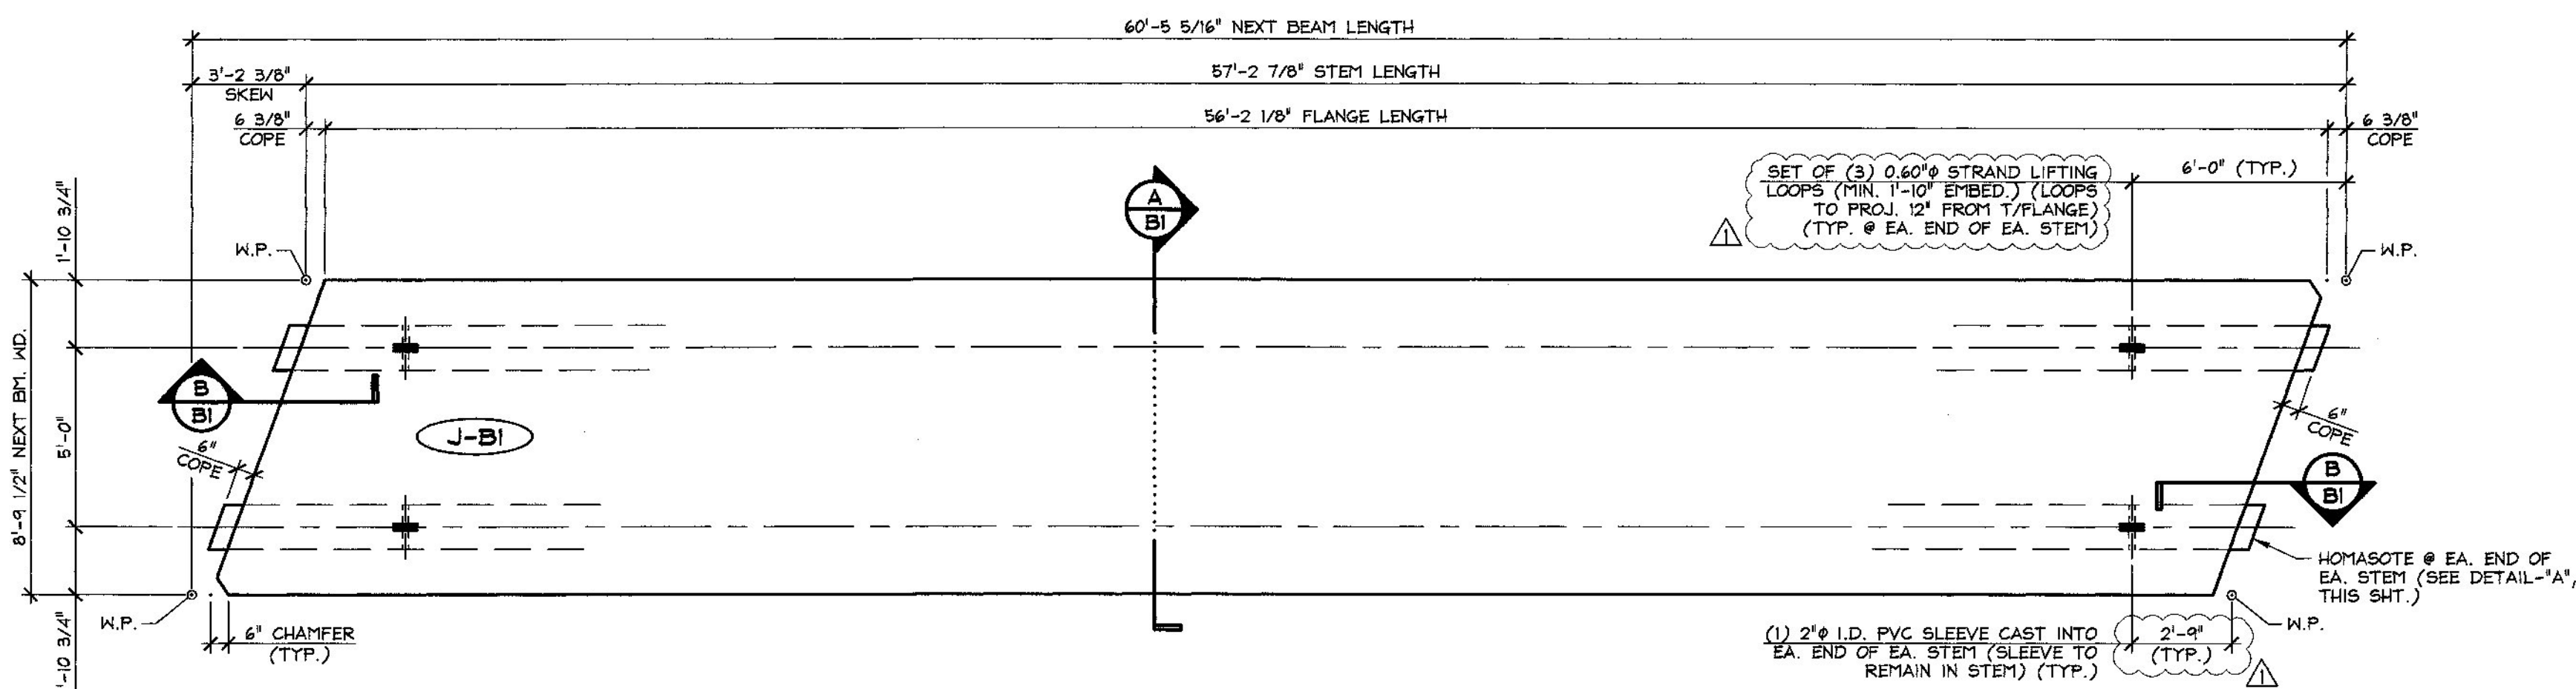


**1** DIMENSIONAL NEXT BEAM PLAN VIEW IN FORM  
1/4" = 1'-0"

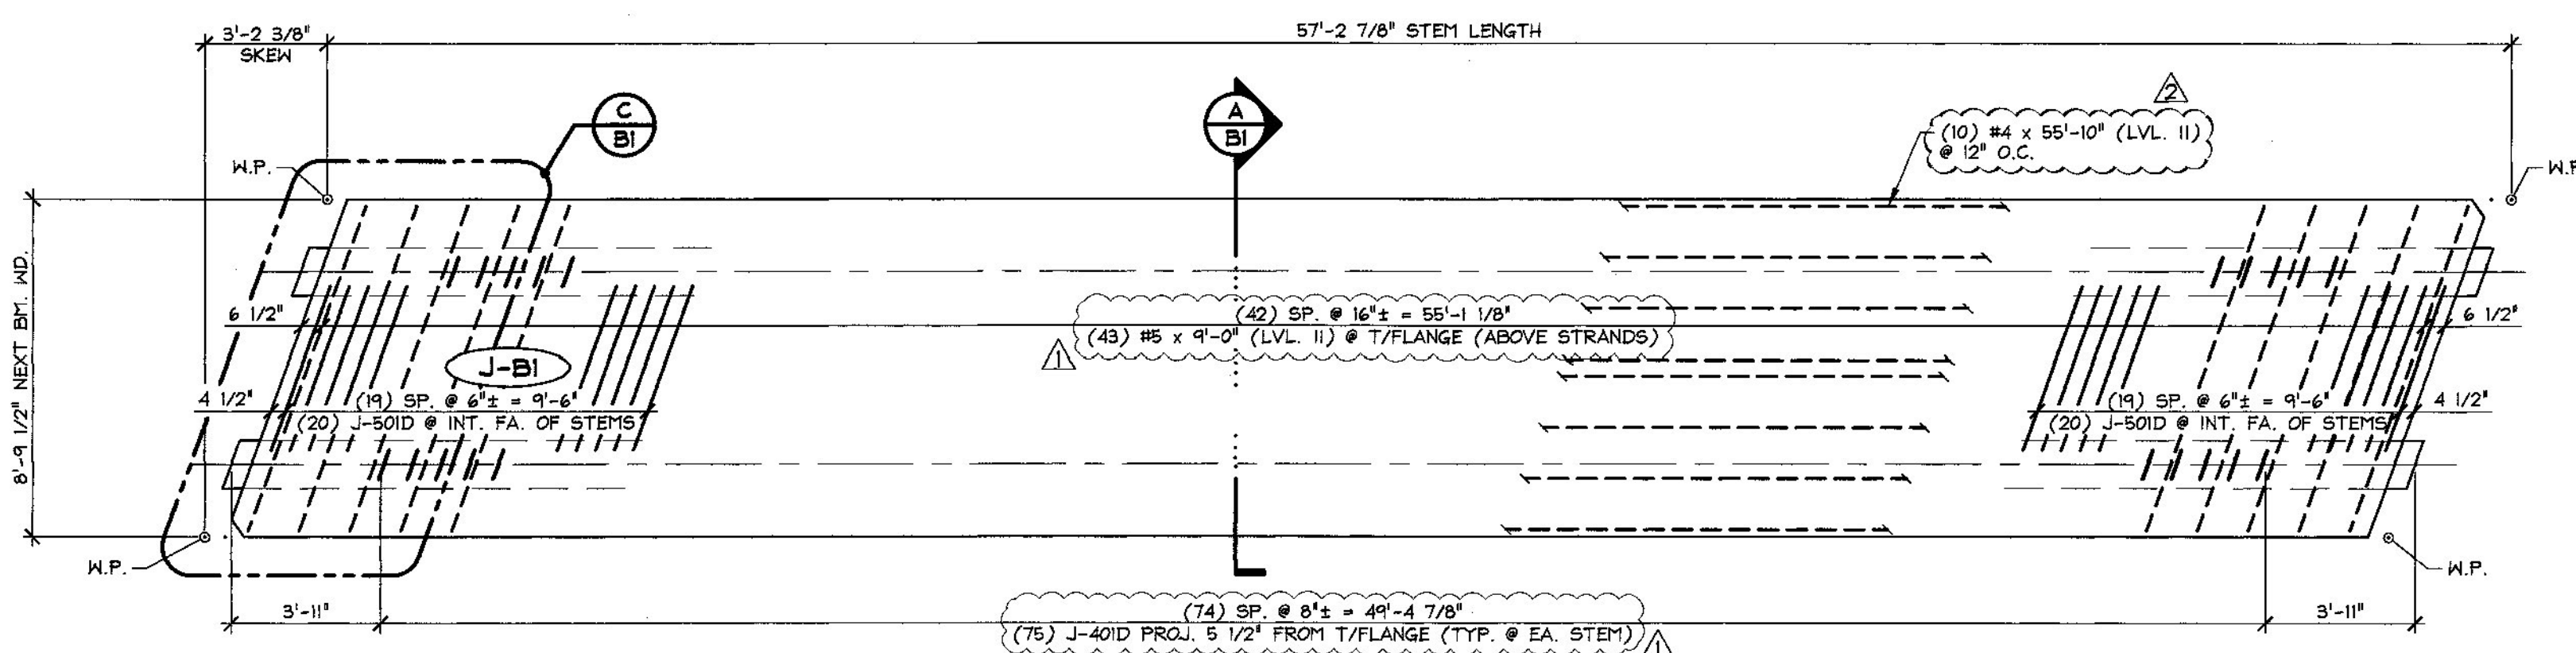

**2** REINFORCING NEXT BEAM PLAN VIEW IN FORM  
1/4" = 1'-0"

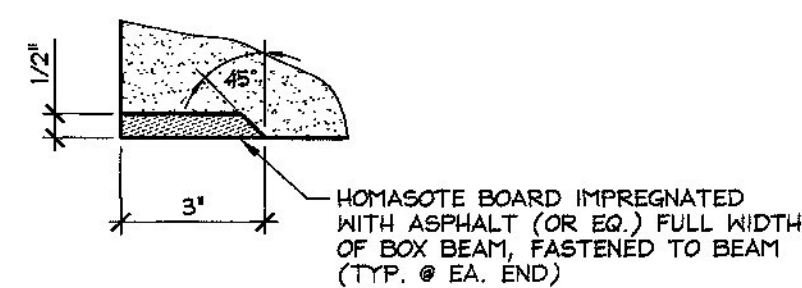


DETAIL - "A"  
3" = 1'-0"

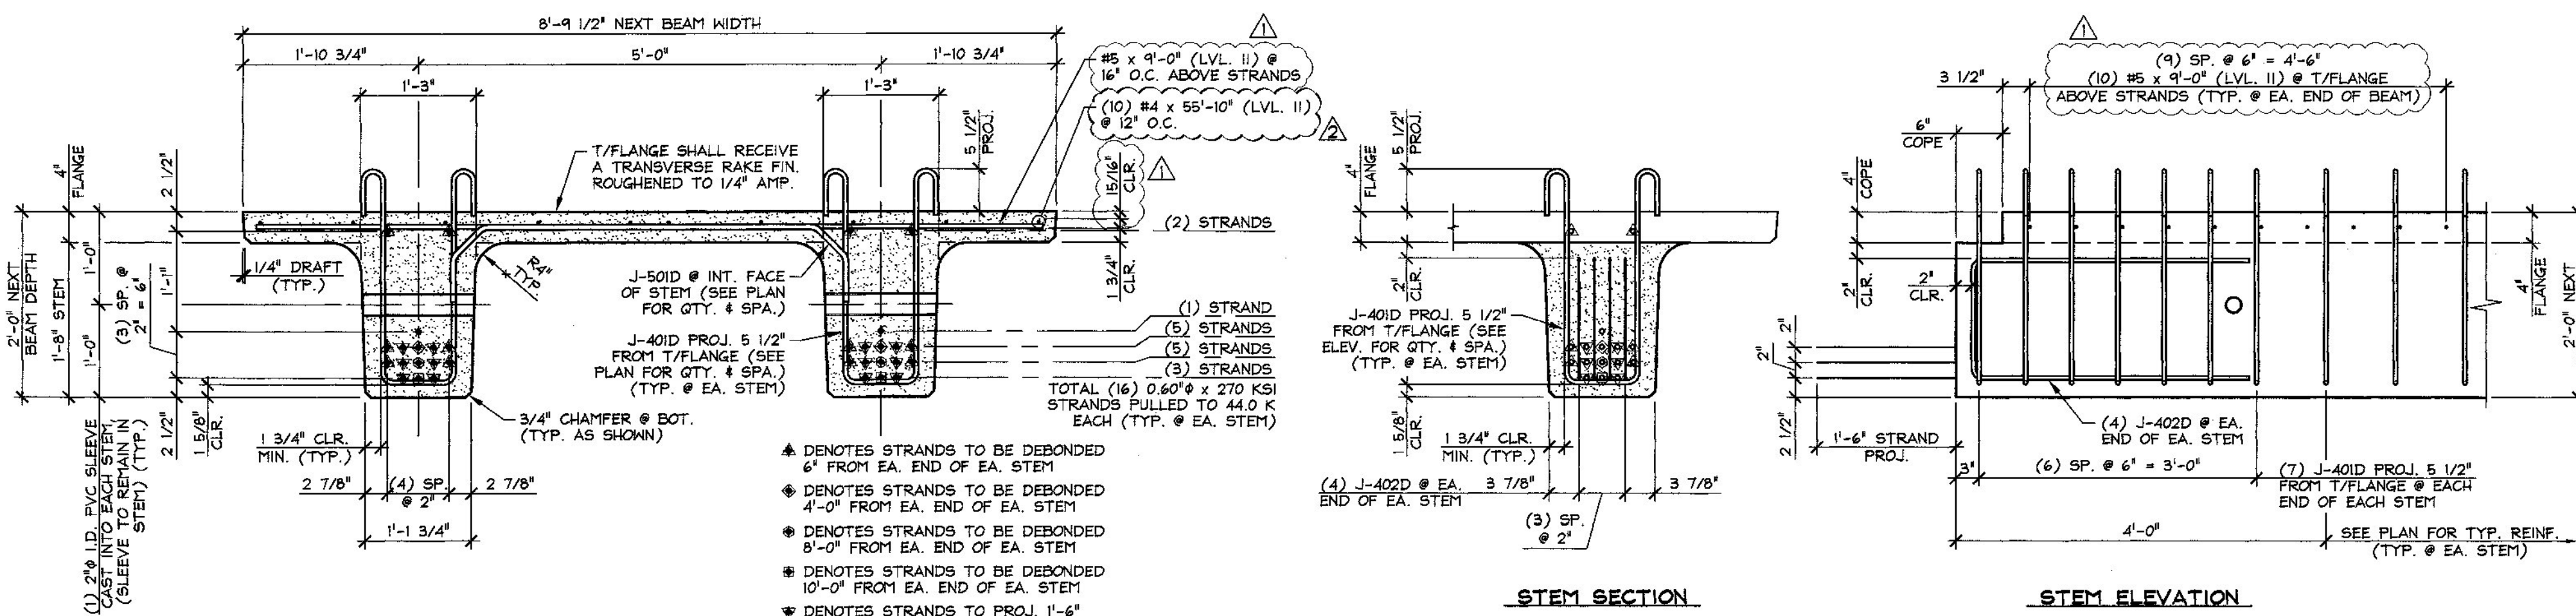

**A** DIMENSIONAL & REINFORCING SECTION  
3/4" = 1'-0"

**B** END BLOCK STEM REINFORCING DETAILS  
3/4" = 1'-0"

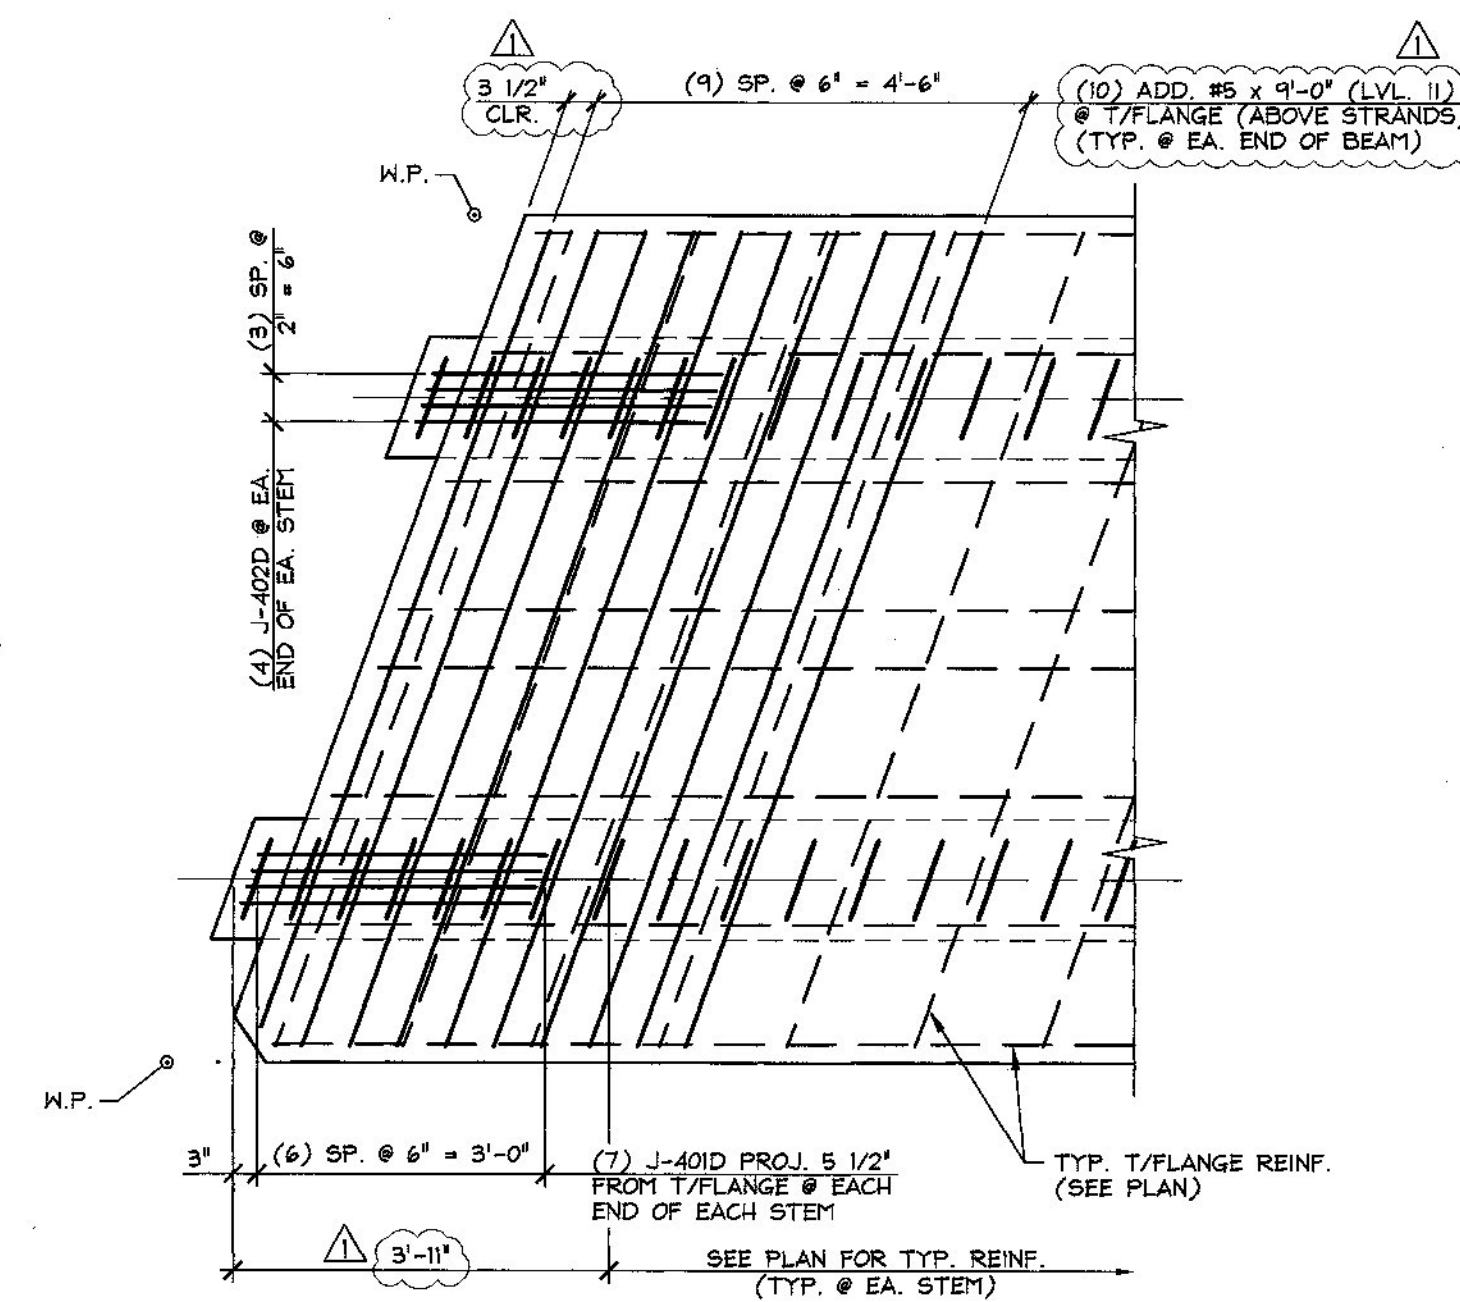


**C** END BLOCK REINFORCING PLAN  
1/2" = 1'-0"

Vermont Agency of Transportation  
**RECEIVED**

CK'D BY CLB OK'D BY HIS  
November 20, 2014


RESUBMIT NO Approved  
BY C. CARLSON DATE 11/21/14

MARK:	J-BI	QTY.:	2	WT.:	29.78 T	VOL.:	14.71 cy
MATERIAL LIST / NEXT BEAM							
ITEM	MARK	DESCRIPTION	QTY.				
1	J-401D	#4 BENT BAR (LEVEL II, DUAL COATED)	(178)				
2	J-402D	#4 BENT BAR (LEVEL II, DUAL COATED)	16				
3		#4 x 55'-10' (LEVEL II, DUAL COATED)	(10)				
4							
5	J-501D	#5 BENT BAR (LEVEL II, DUAL COATED)	40				
6		#5 x 9'-0' (LEVEL II, DUAL COATED)	63				
7							
8							
9							
10							
11							
12							
13							
14		SET OF (3) 0.60" x 270 KSI STRAND LIFTING LOOPS	4				
15							

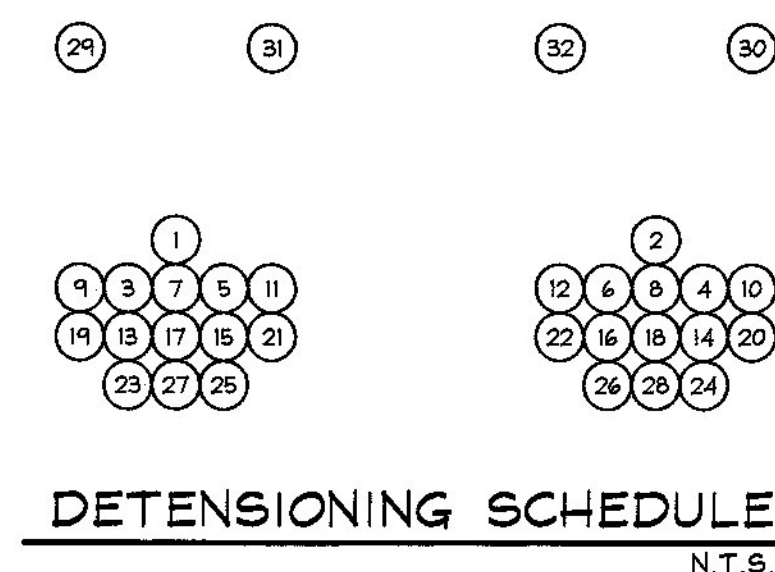


11-19-14 REVISED AS NOTED  
11-5-14 REVISED AS NOTED


APPROVAL STAMP:	<b>J.P. CARRARA &amp; SONS INC.</b> Precast & Prestress Manufacturer 2464 CASE STR., MIDDLEBURY, VERMONT 05753 Phone: (802)388-6361 Fax: (802)388-9010	<b>A.L. ST. ONGE</b> CONTRACTOR MONTOMERY, VERMONT
	STATE OF VERMONT AGENCY OF TRANSPORTATION COUNTY OF LAMOILLE	
	CITY OF JOHNSON ROUTE NO.: VT 15 (MINOR ARTERIAL) BRIDGE NO.: 32 PROJECT NO.: BRP 030-2(26)	
	PRESTRESSED NEXT BEAM DETAILS	
	DATE: SEPT. 30, 2014 SCALE: NOTED CHKD: - DFTM: B.L. JOB NO: 23442-014	DWG. NO: <b>B1</b>

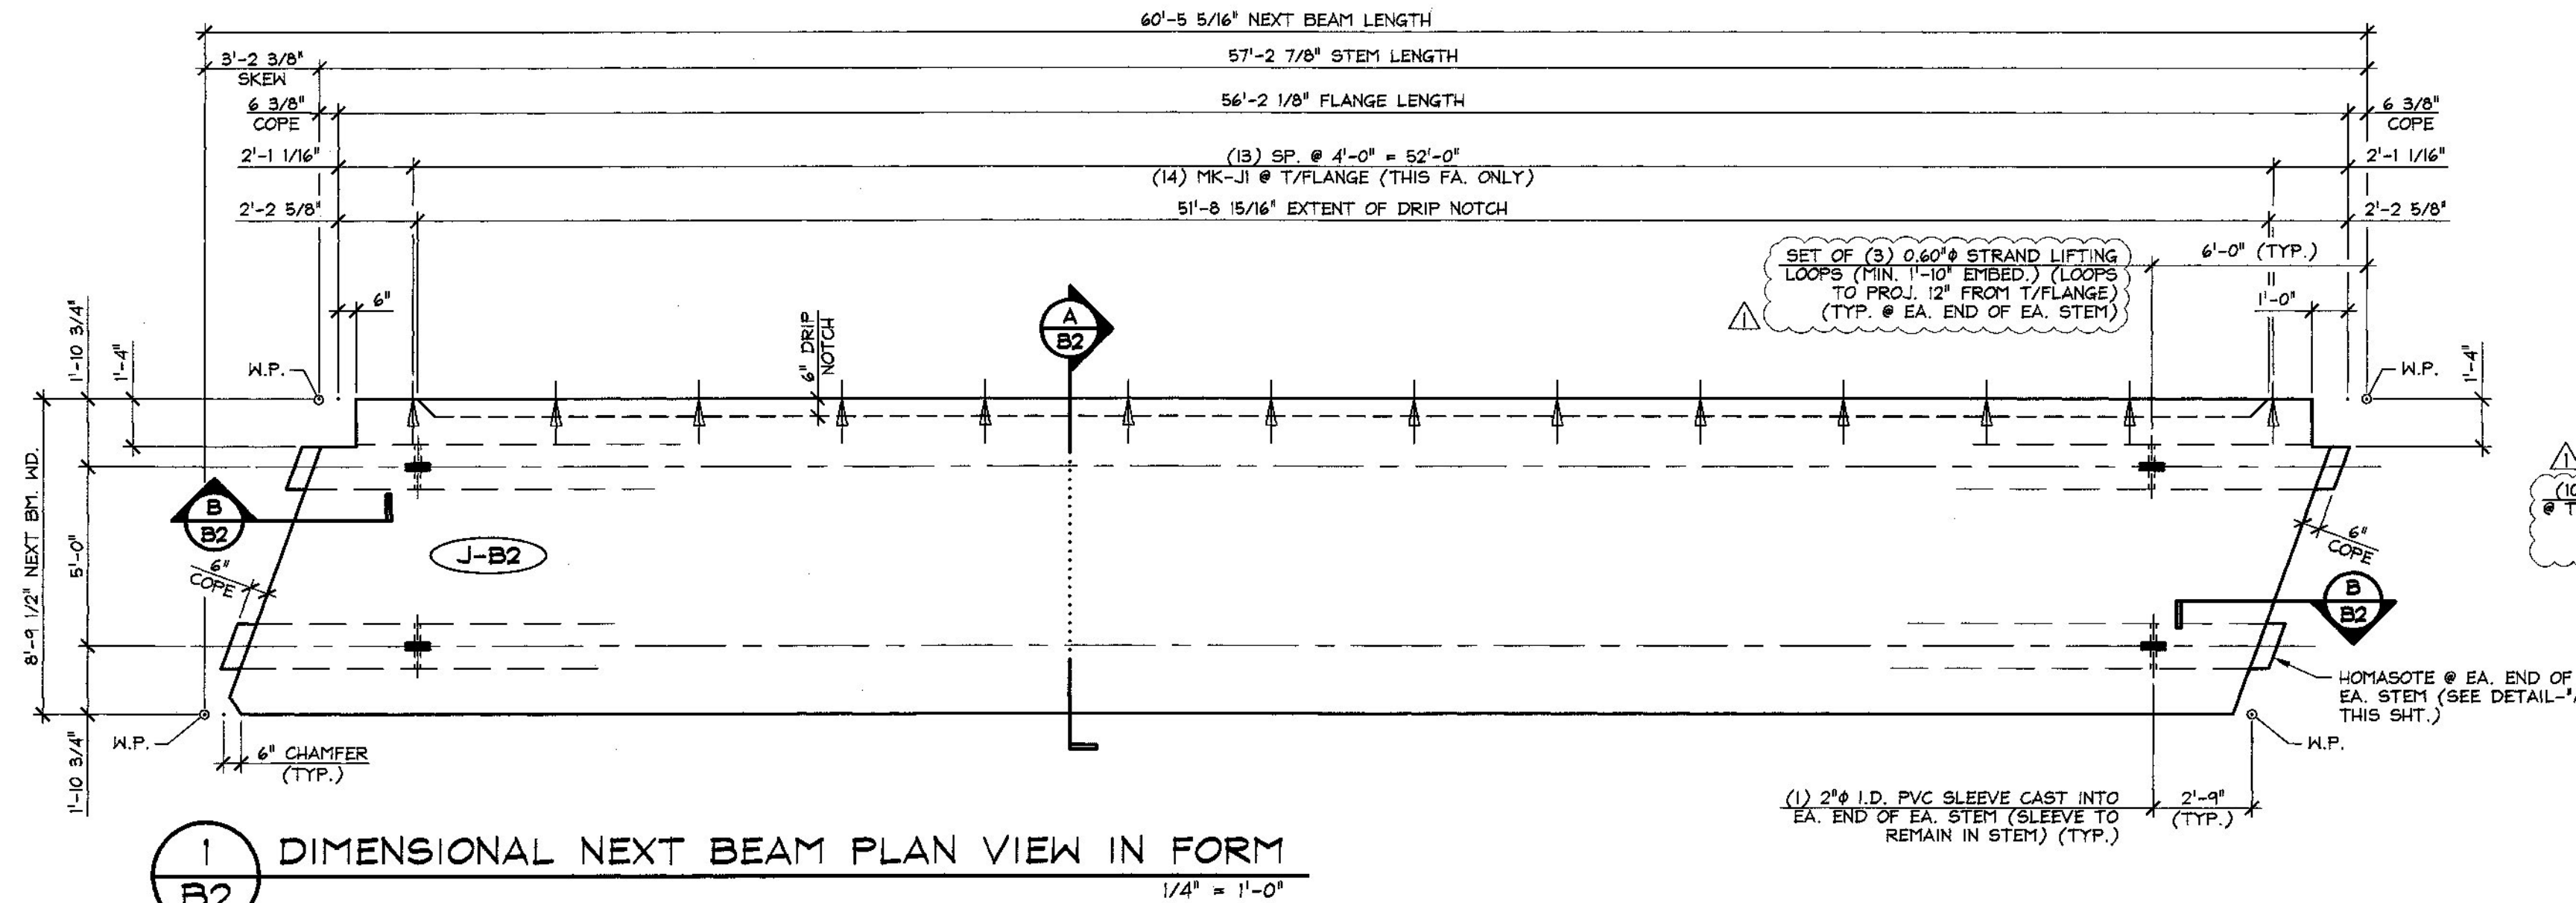


**1** DIMENSIONAL NEXT BEAM PLAN VIEW IN FORM  
B2  
1/4" = 1'-0"

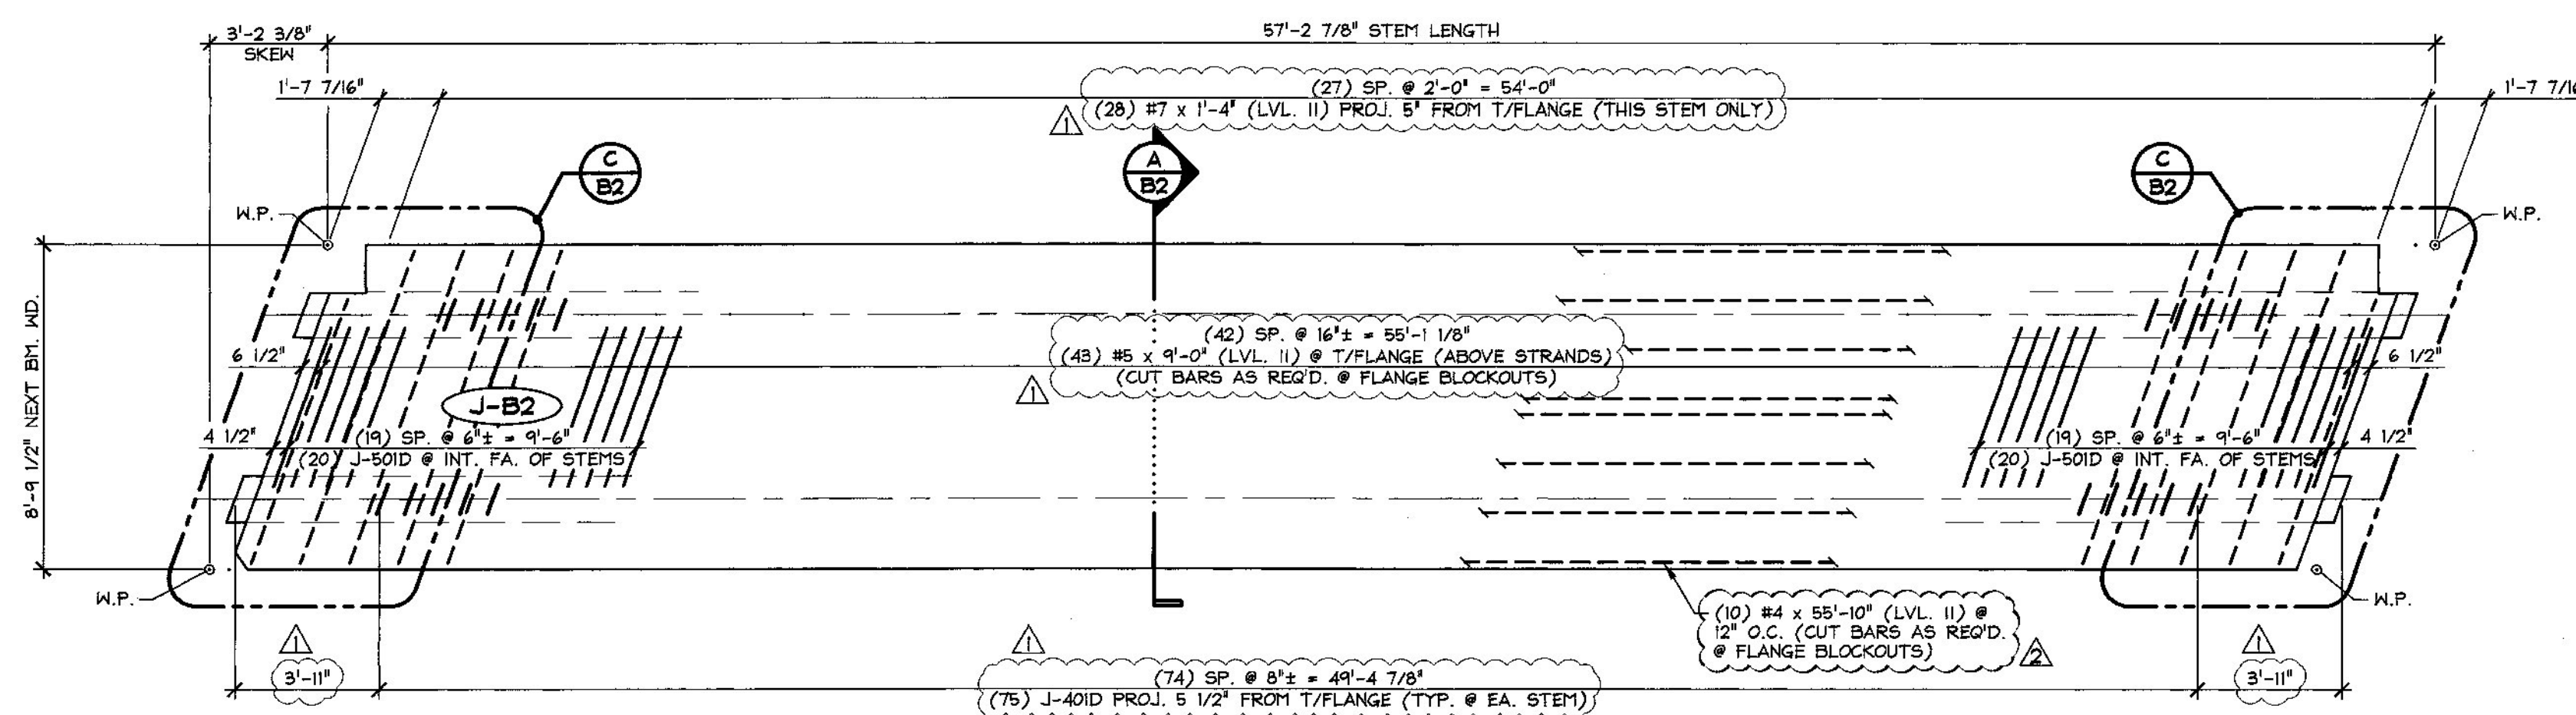


**2** REINFORCING NEXT BEAM PLAN VIEW IN FORM  
B2  
1/4" = 1'-0"

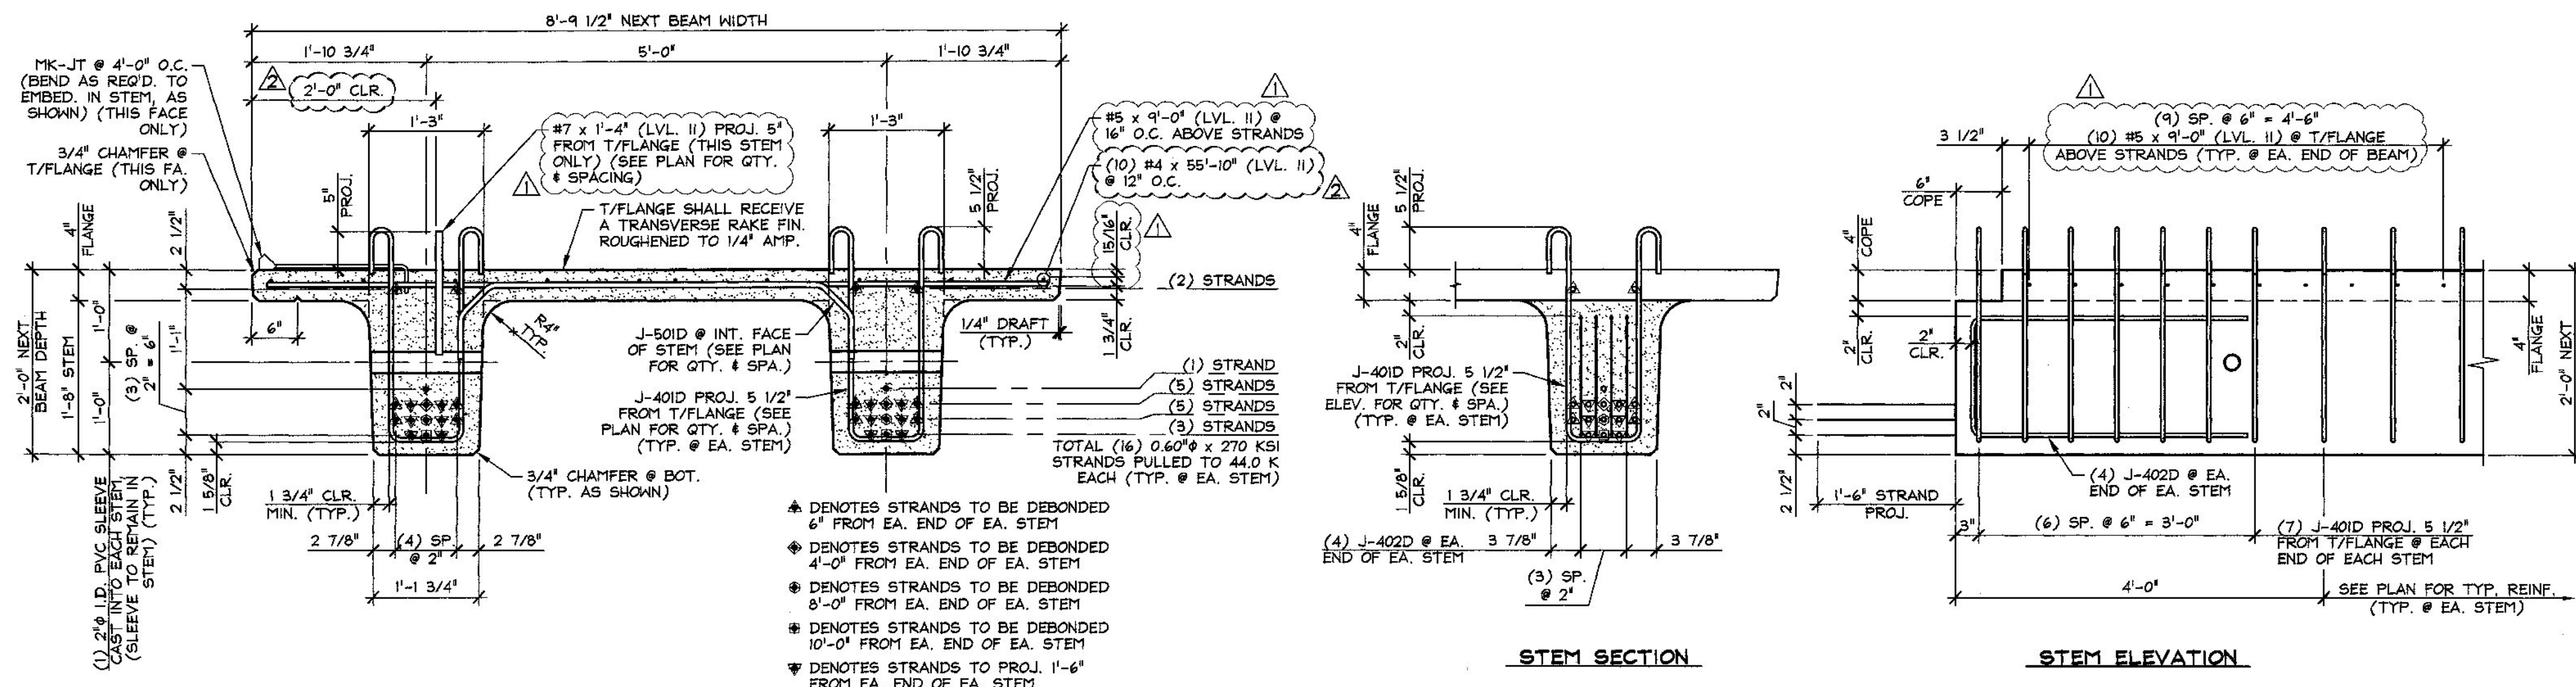


**A** DIMENSIONAL & REINFORCING SECTION  
B2  
3/4" = 1'-0"

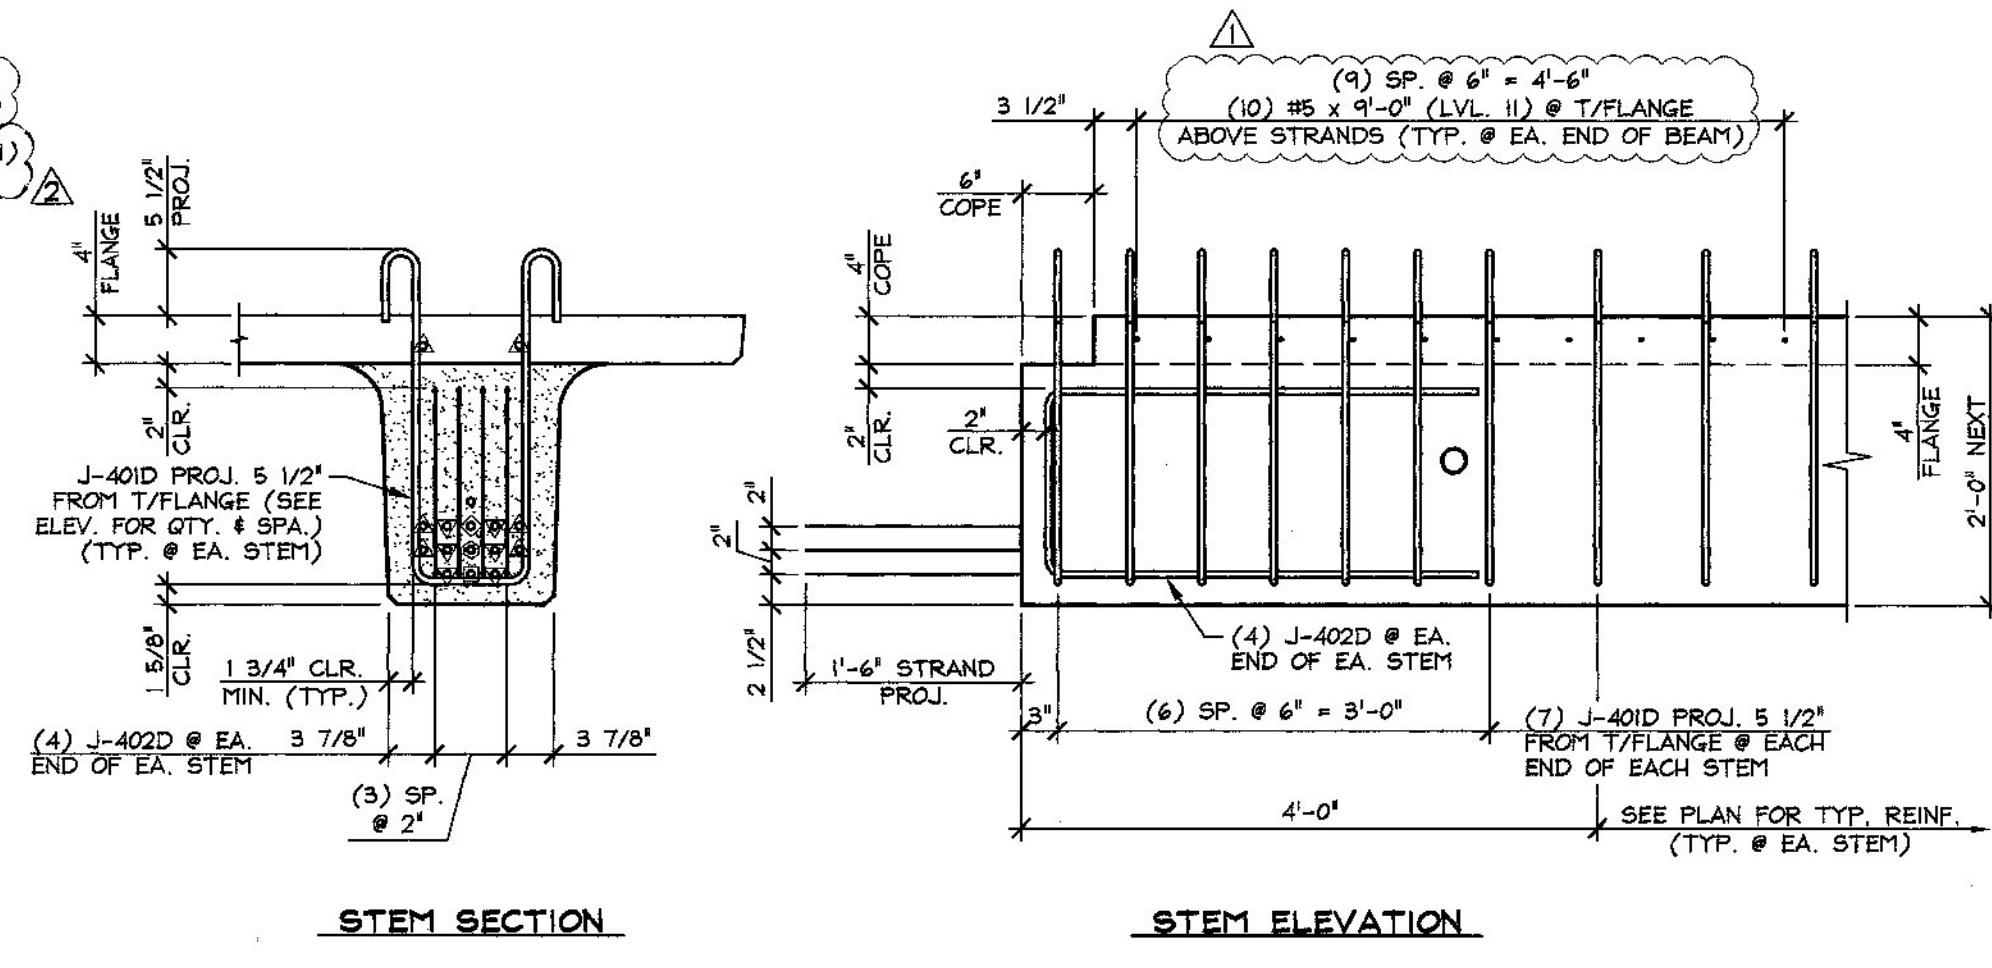


**B** END BLOCK STEM REINFORCING DETAILS  
B2  
3/4" = 1'-0"

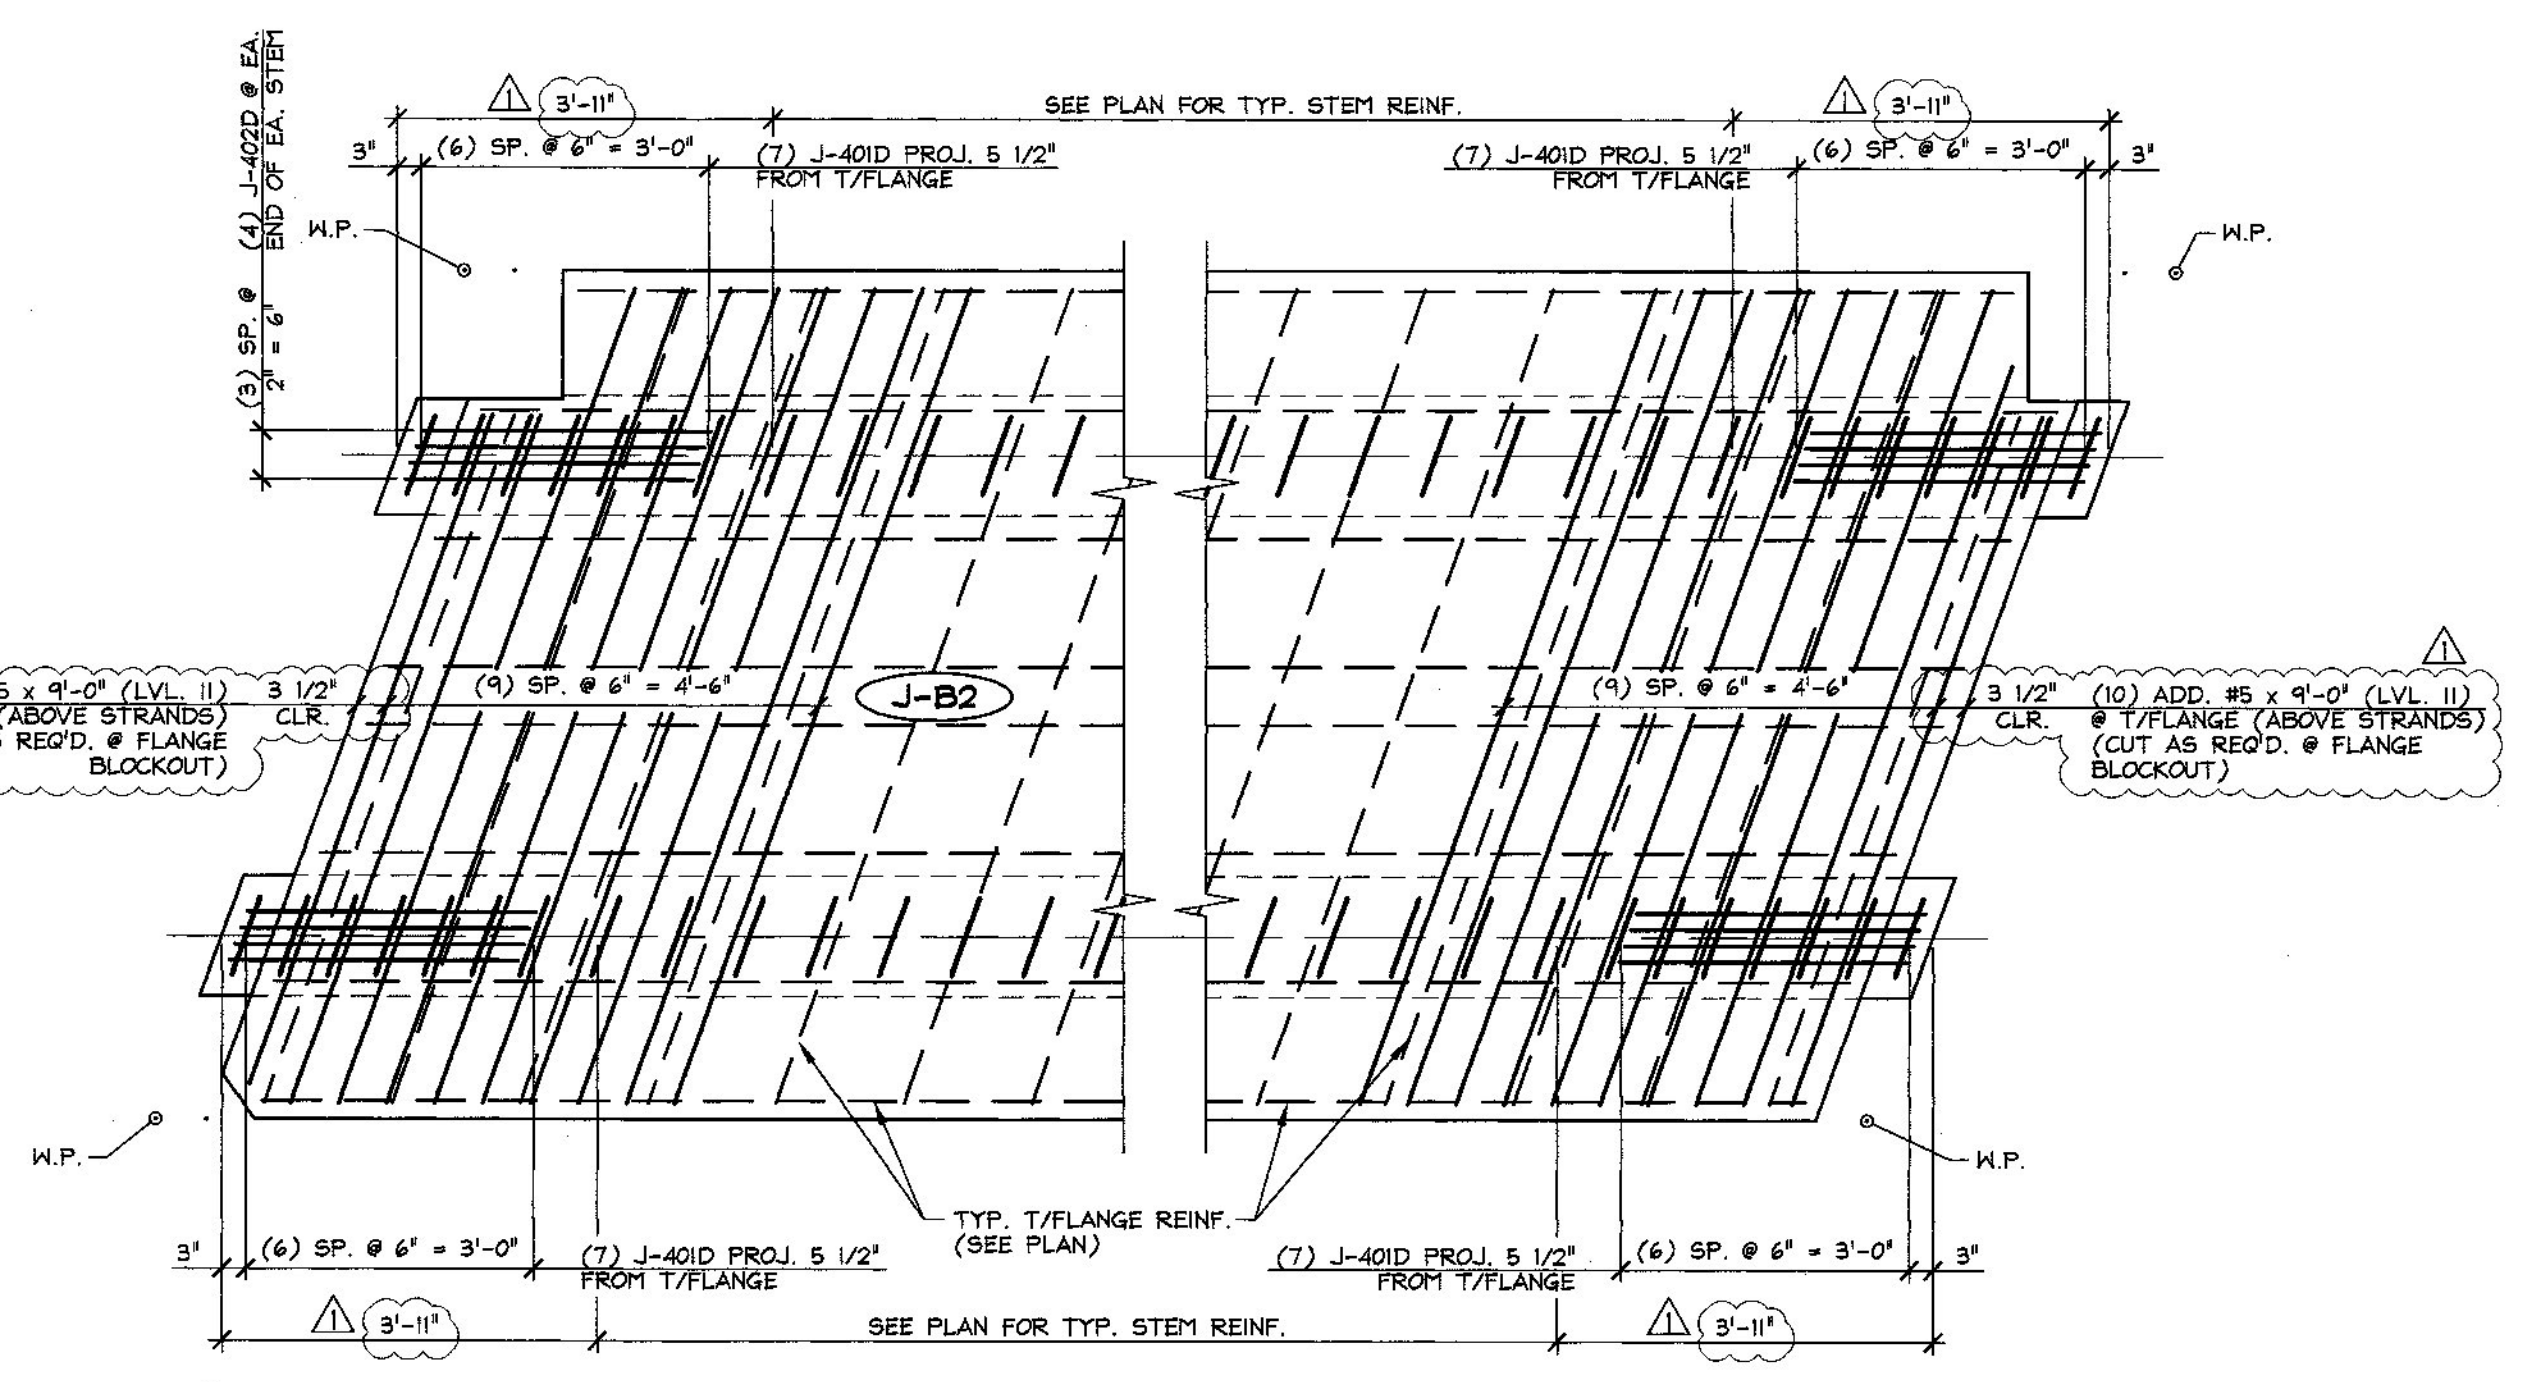

**C** END BLOCK REINFORCING PLAN  
B2  
1/2" = 1'-0"

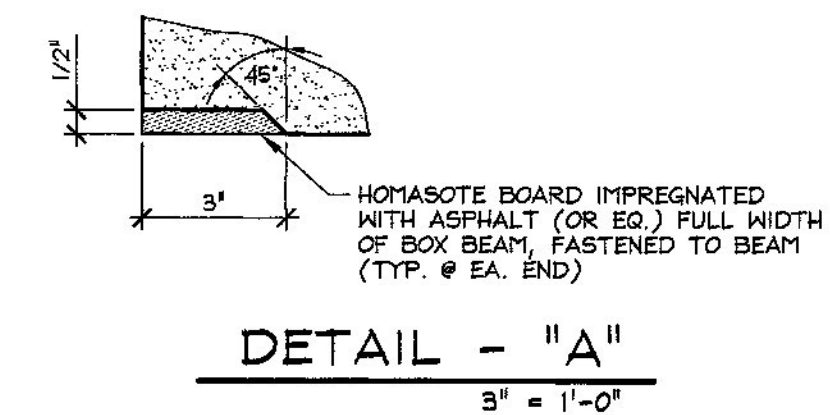

**DETAIL - "A"**  
B B2  
3" = 1'-0"

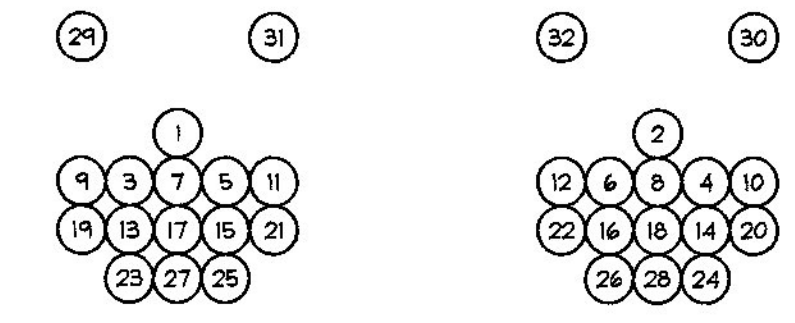

**DETENSING SCHEDULE**  
N.T.S.

△ 11-19-14 REVISED AS NOTED  
△ 11-5-14 REVISED AS NOTED


APPROVAL STAMP:

Vermont Agency of Transportation  
**RECEIVED**  
CK'D BY CLB OK'D BY HIS  
November 20, 2014  
RESUBMIT NO Approved  
BY C. CARLSON DATE 11/21/14


MARK	J-B2	QTY.	2	WT.	29.75 T	VOL.	14.69 cy
MATERIAL LIST / NEXT BEAM							
ITEM	MARK	DESCRIPTION	QTY.				
1	J-401D	#4 BENT BAR (LEVEL II, DUAL COATED)	176				
2	J-402D	#4 BENT BAR (LEVEL II, DUAL COATED)	16				
3		#4 x 55'-10" (LEVEL II, DUAL COATED)	10				
4							
5	J-501D	#5 BENT BAR (LEVEL II, DUAL COATED)	40				
6		#5 x 9'-0" (LEVEL II, DUAL COATED)	63				
7							
8		#7 x 1'-4" (LEVEL II, DUAL COATED)	26				
9							
10							
11							
12	MK-JI	MODIFIED DAYTON SUPERIOR C-24 45' TYPE 4-APR HANGER (GALV.)	14				
13	MK-JI	SHARD-RAIL ANCHOR 3/8" x 10" x 2-1/2" (GALV.)	6				
14		SET OF (3) 0.60" x 270 KSI STRAND LIFTING LOOPS	4				
15							

<b>J.P. CARRARA &amp; SONS INC.</b> Precast & Prestress Manufacturer 2464 CASE ST., MIDDLEBURY, VERMONT 05753 Phone: (802)388-6361 Fax: (802)388-9010	<b>A.L. St. ONGE</b> CONTRACTOR MONTMERY, VERMONT
<b>STATE OF VERMONT AGENCY OF TRANSPORTATION</b> COUNTY OF LAMOILLE	DATE: SEPT. 30, 2014 SCALE: NOTED
<b>CITY OF JOHNSON</b> ROUTE NO.: VT 15 (MINOR ARTERIAL) BRIDGE NO.: 32 PROJECT NO.: BRP 030-2(26)	CHKD: - DFTM: B.L. JOB NO: 23442-014
<b>PRESTRESSED NEXT BEAM DETAILS</b>	DWG. NO: <b>B2</b>


MISCELLANEOUS MATERIALS				
ITEM	MARK	QTY.	DESCRIPTION	REMARKS
1				
2	40		#4 x 55'-10" (LEVEL II, DUAL COATED)	
3				
4	262		#5 x 9'-0" (LEVEL II, DUAL COATED)	
5				
6	56		#7 x 1'-4" (LEVEL II, DUAL COATED)	
7				
8				
9				
10	MK-J1	28	MODIFIED DAYTON SUPERIOR C-24 45° TYPE 4-APR HANGER (GALV.)	SEE DETAIL THIS SHEET
11	MK-J2		GUARD RAIL ANCHOR E-3/8" x 10" x 1 1/2" (4) 1/2" HEX NUTS (GALV.)	SUPPLIED BY OTHERS
12				
13				
14		16	SET OF (3) 0.60" x 270 KSI STRAND LIFTING LOOPS	
15				

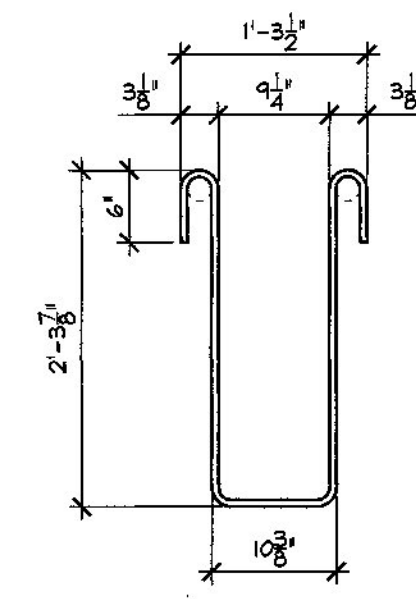


**J-401D**  
#4 BENT BAR  
LEVEL II, DUAL COATED  
USE 2" (50 mm) PIN  
(712) REQ'D.

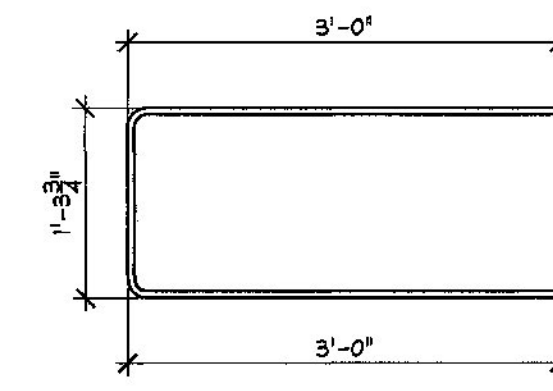

**J-402D**  
#4 BENT BAR  
LEVEL II, DUAL COATED  
USE 2" (50 mm) PIN  
(64) REQ'D.

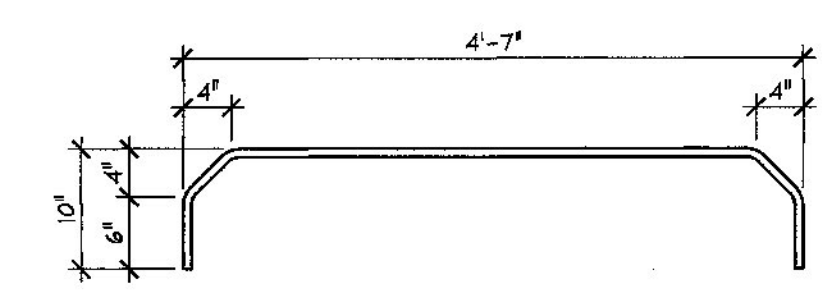

**J-501D**  
#5 BENT BAR  
LEVEL II, DUAL COATED  
USE 2 3/8" (70 mm) PIN  
(160) REQ'D.

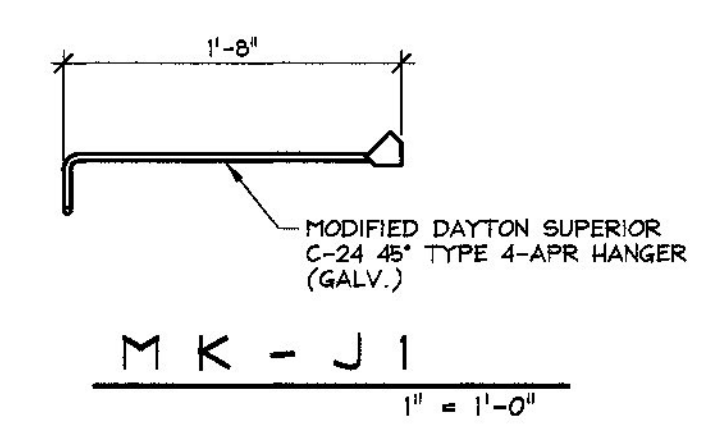

Vermont Agency of Transportation

**RECEIVED**

Next Beam Fabrication Resubmit Approved 11.21.14.pdf

CK'D BY CLB OK'D BY HIS

November 20, 2014

RESUBMIT NO Approved  
BY C. CARLSON DATE 11/21/14

△ 11-19-14 REVISED AS NOTED  
△ 11-5-14 REVISED AS NOTED

APPROVAL STAMP:	<b>J.P. CARRARA &amp; SONS INC.</b> Precast & Prestress Manufacturer <small>246 GSE STR., MIDDLEBURY, VERMONT 05753 Phone: (802)388-9361 Fax: (802)388-9010</small>		A.L. St. ONGE CONTRACTOR MONTMERY, VERMONT	
	STATE OF VERMONT AGENCY OF TRANSPORTATION COUNTY OF LAMOILLE		DATE: SEPT. 30, 2014	
	CITY OF JOHNSON ROUTE NO.: VT 15 (MINOR ARTERIAL) BRIDGE NO.: 32 PROJECT NO.: BRF 030-2(26)		SCALE: NOTED	
	MATERIALS LIST		CHKD: - DFTM: B.L. JOB NO: 23442-014 DWG. NO: M1	

**RECEIVED**






CK'D BY CLB

OK'D BY HIS

January 7, 2015

RESUBMIT NO  
BY C. CARLSON

Approved  
DATE 01/07/15

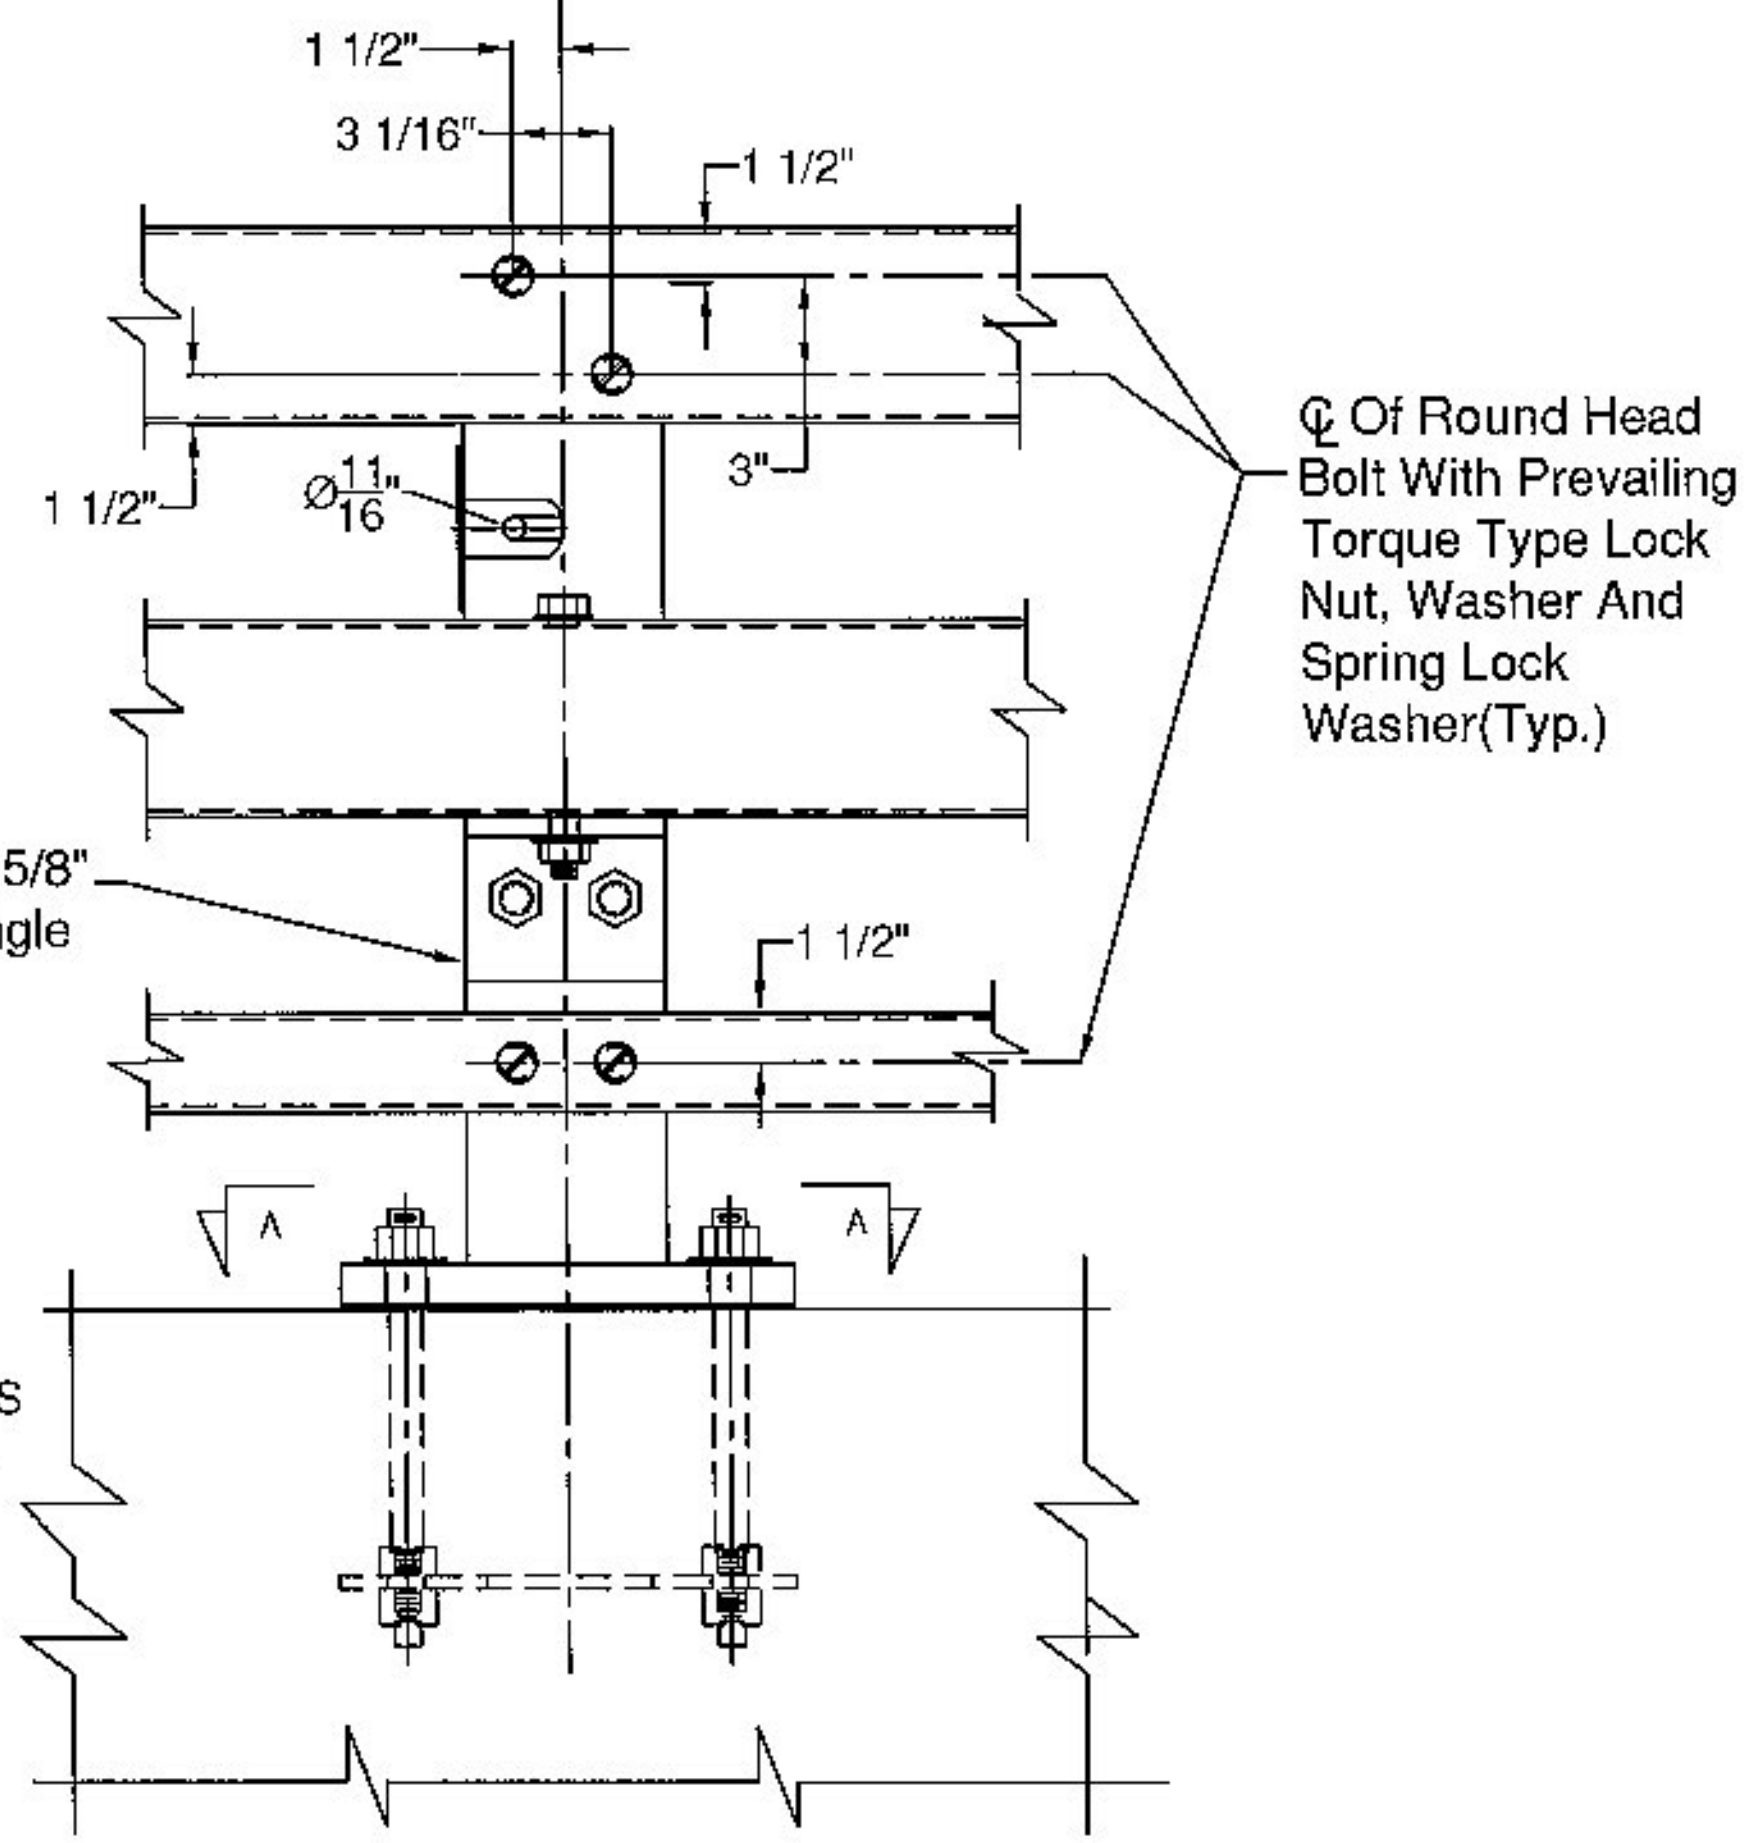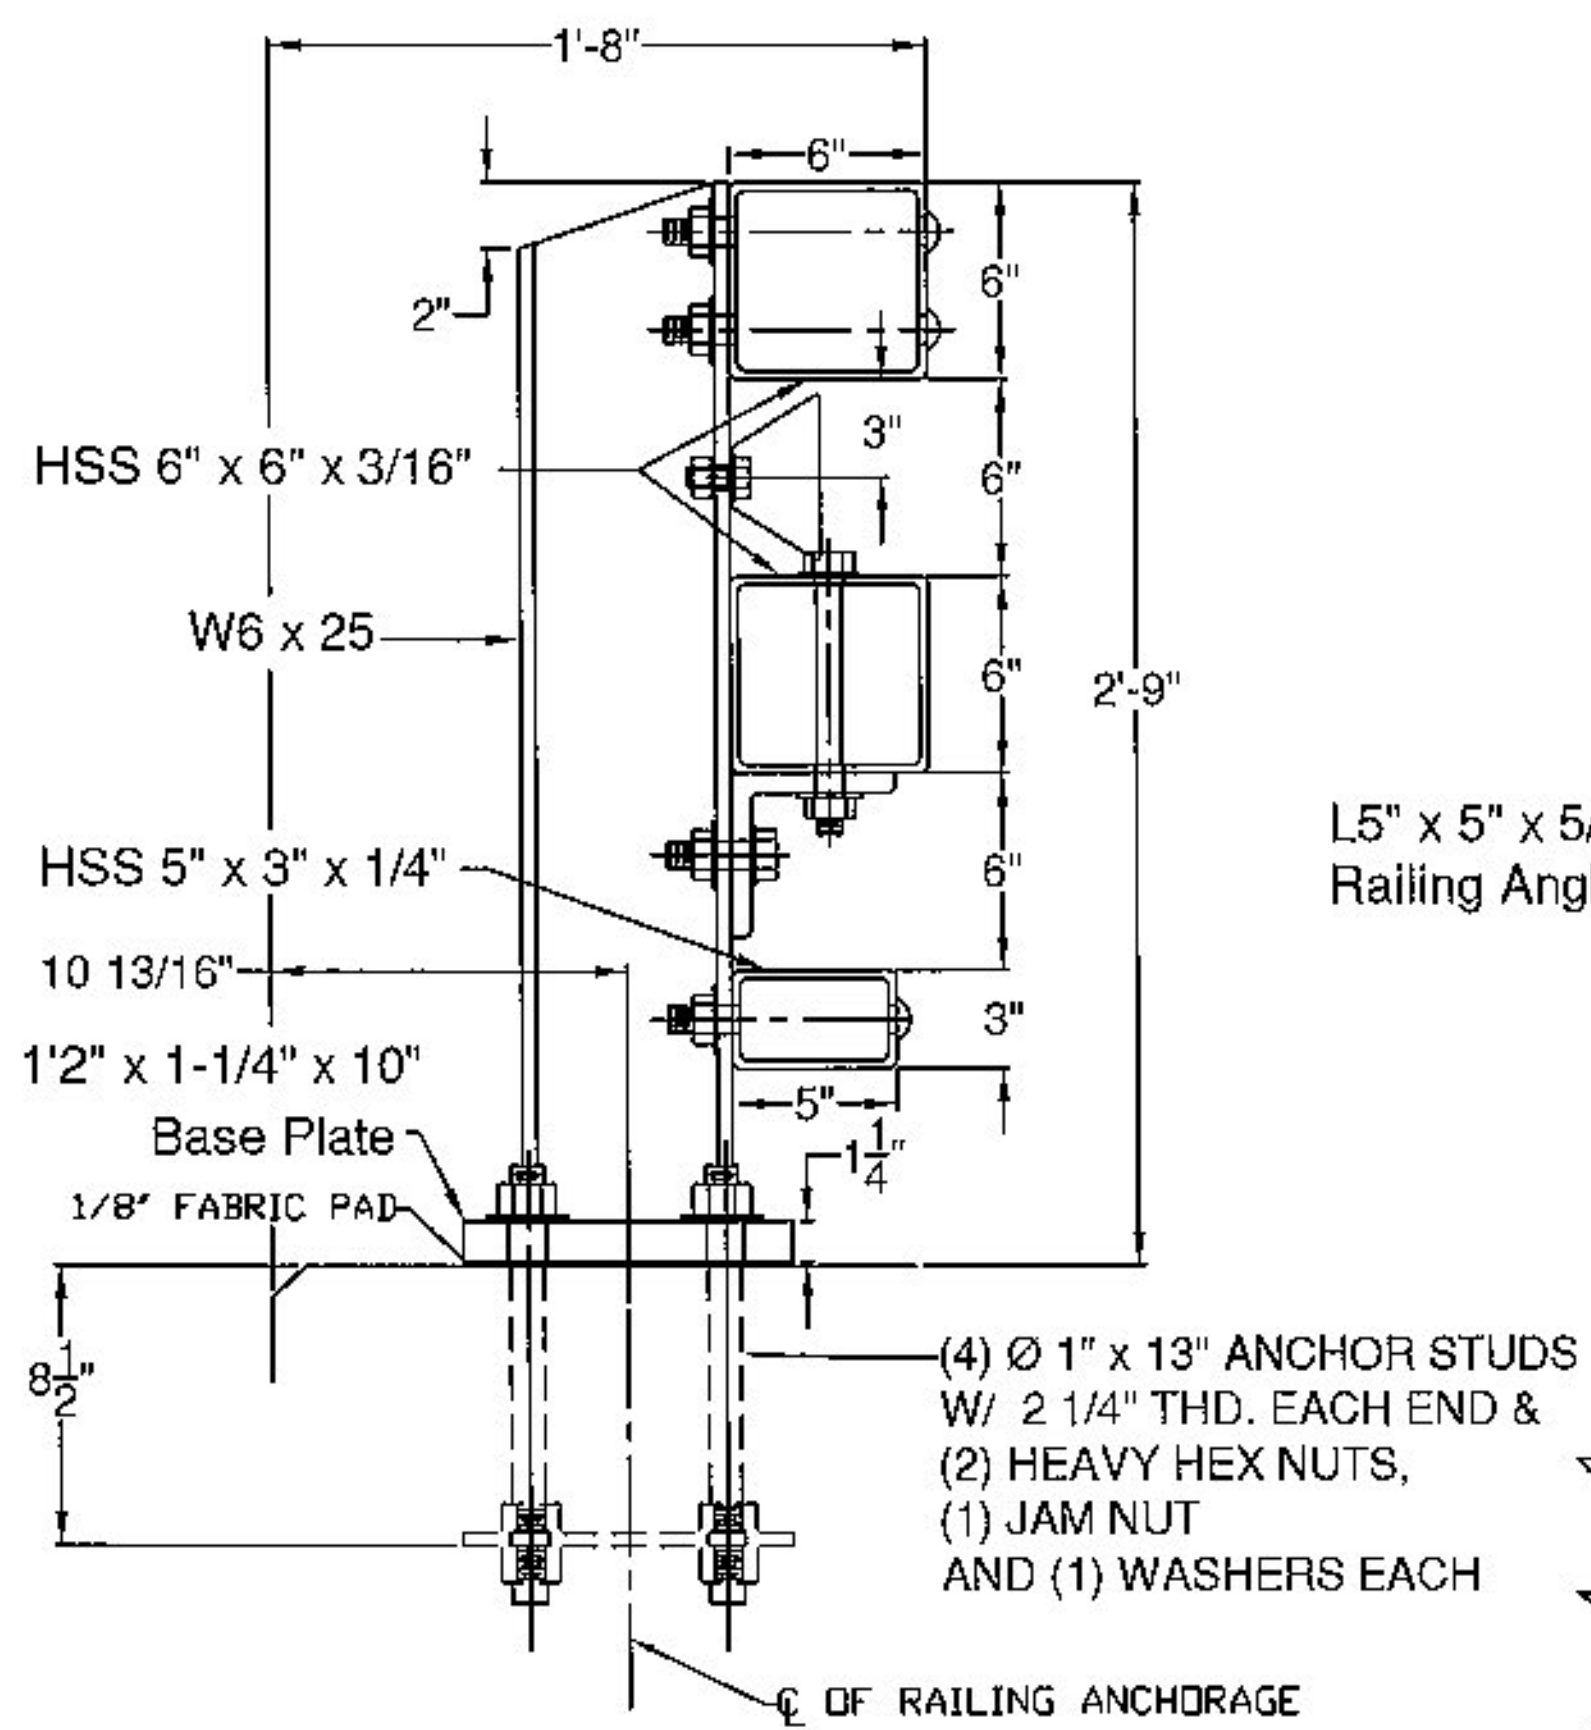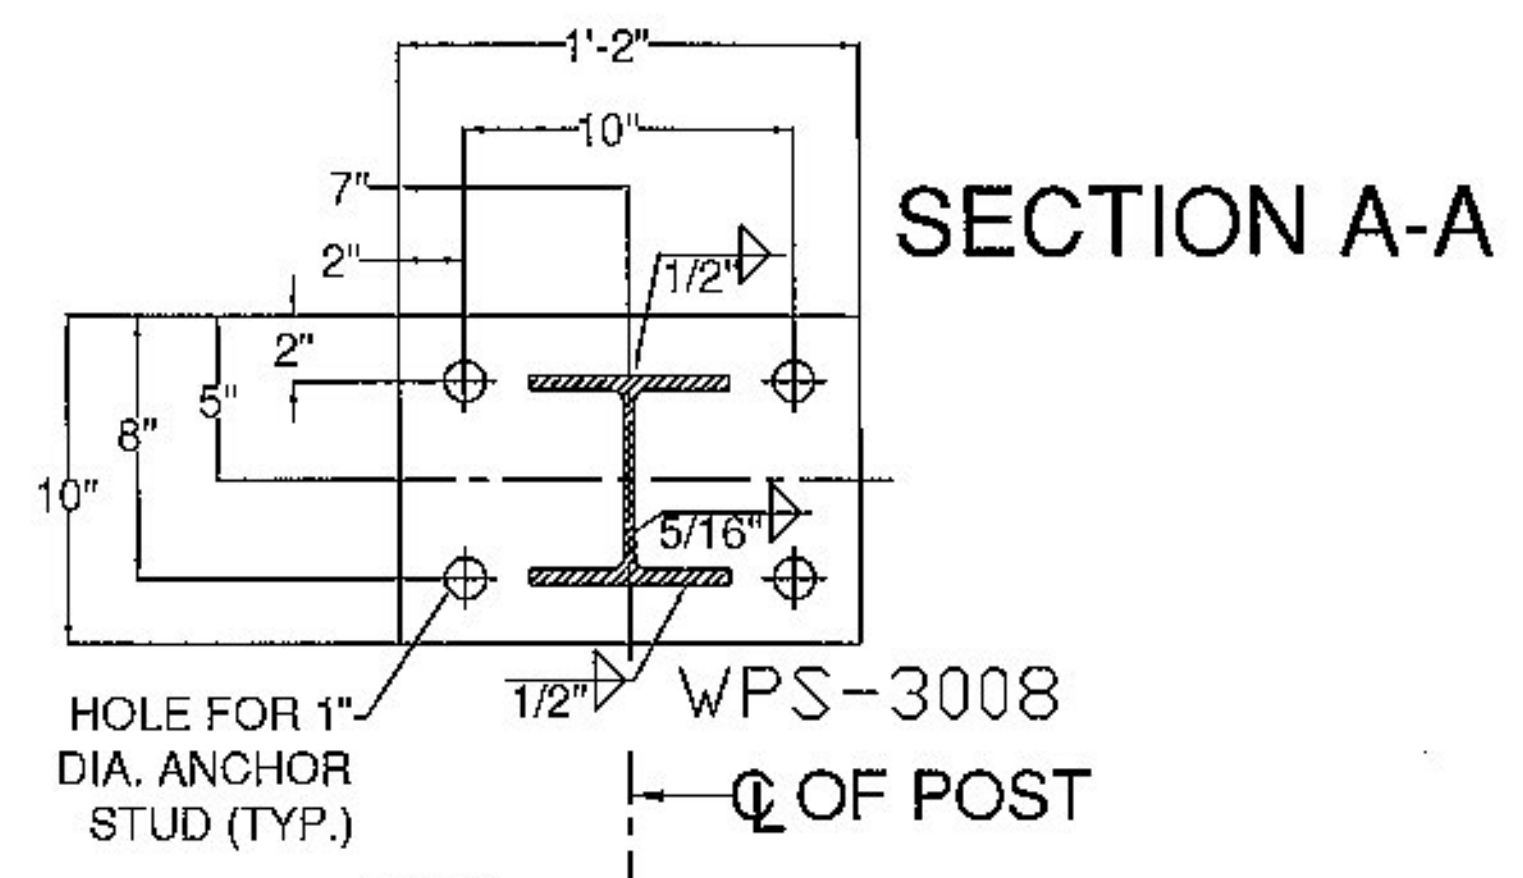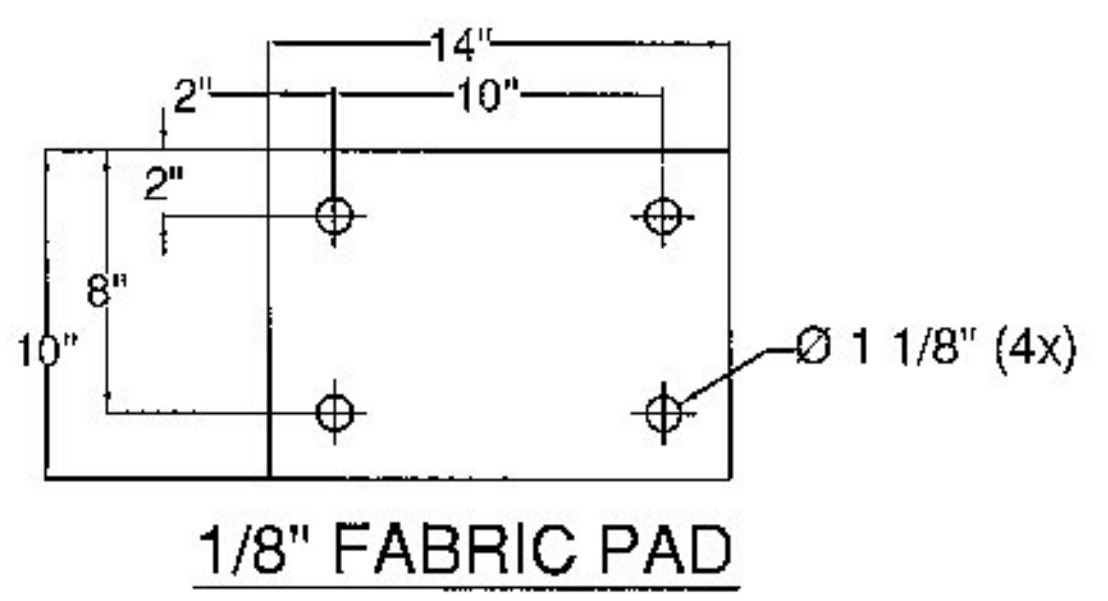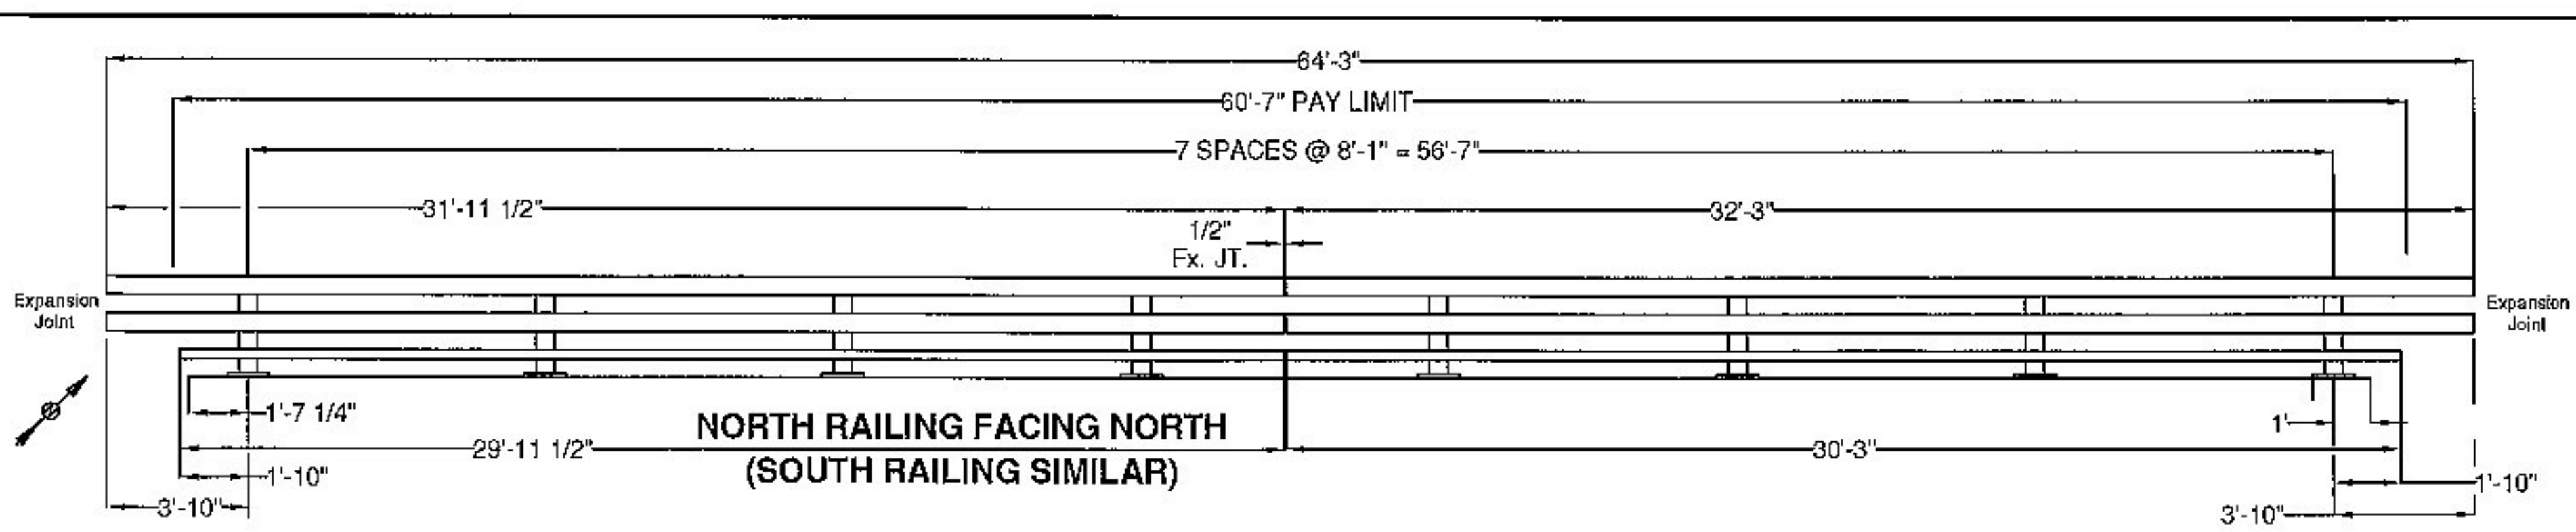

**BILL OF MATERIAL**

ITEM #	QTY	PART #	DESCRIPTION	ASTM DESIGNATION
1	16	0033.03610	W6x25, THREE RAIL POST @ 2'-9" DA ON 1 1/4x10x1'-2" B.P.	A572 Gr. 50
2	2	0033.23000	HSS 3" X 5" X 1/4" RAIL @ 29'-11 1/2"	A500 Gr. B
3	2	0033.23003	HSS 3" X 5" X 1/4" RAIL @ 30'-3"	A500 Gr. B
5	4	0033.63200	HSS 6" X 6" X 3/16" RAIL @ 31'-11 1/2"	A500 Gr. B
6	4	0033.63203	HSS 6" X 6" X 3/16" RAIL @ 32'-3"	A500 Gr. B
8	2	0033.00840	2-1/8" X 4-1/4" FIX. SPLICE BAR @ 2'-3"	A572 Gr. 50
9	4	0033.00640	HSS 5" X 5" X 5/16" FIX. SPLICE TUBE @ 2'-3"	A500 Gr. B, A572 Gr. 50
10	16	0033.00220	3/8" X 10" X 14" ANCHOR PLATES	A572 Gr. 50
11	16	0033.90050	1/8" X 10" X 14" FABRIC PAD	AASHTO M251
12	66*	0042.21013	Ø 1" X 13" ANCHOR STUDS, W/ 2 1/4" THD. EACH END	A449 TYPE 1
13	130*	0080.18901	Ø 1" HEAVY HEX NUTS	A563
14	64	0080.18911	Ø 1" FLAT WASHERS	F436
15	64	0080.18905	Ø 1" HEX JAM NUTS	A563
16	64	0080.07500	Ø 7/8" X 8" ROUND HEAD BOLT, NUT, SQ. WASHER, L.W.	A449, A563, F436, ASME D18.2
17	16	0080.06400	Ø 3/4" X 8" HEX BOLT, NUT, (2) F.W., & L.W.	A325, A563, F436, & ASME D18.2
18	32	0080.06140	Ø 3/4" X 2-3/4" HEX BOLT, NUT, (2) F.W., & L.W.	A325, A563, F436, & ASME D18.2
19	16	0080.06340	Ø 3/4" X 7-1/2" HEX BOLT, NUT, & (2) F.W.	A325, A563, & F436
20	8	0080.06255	Ø 3/4" X 4-1/2" HEX BOLT, NUT, & (2) F.W.	A325, A563, & F436
21	16	0033.00500	L5" X 5" X 5/8" RAILING ANGLE @ 6°	A572 Gr. 50
22	6		DELINEATORS - NOT SHOWN	(SUPPLIED BY CUSTOMER)

*-2 EXTRA FOR VDOT TESTING

**GENERAL NOTES:**

- 1) ALL RAILING IS TO BE FABRICATED AND ERECTED ACCORDING TO SECTION 525 OF THE STANDARD SPECIFICATIONS.
- 2) PRIOR TO GALVANIZING THE ASSEMBLED POST, GRIND ALL EDGES TO A MINIMUM RADIUS OF 1/16".
- 3) ALL POST SHALL BE SET NORMAL TO GRADE. THE MAXIMUM CENTER TO CENTER SPACING OF BRIDGE RAIL POST IS 8' 3".
- 4) SECTIONS OF RAIL TUBE SHALL BE ATTACHED TO A MINIMUM OF TWO BRIDGE POSTS AND PREFERABLY TO AT LEAST 4 POSTS.
- 5) RAIL TUBE EXPANSION JOINTS SHALL BE PROVIDED IN ANY RAIL BAY SPANNING THE END OF AN INTEGRAL ABUTMENT BRIDGE AND AT ALL SUPER STRUCTURE EXPANSION JOINTS. EXPANSION JOINT WIDTH SHALL BE 4" @ 68°F AND WILL BE ADJUSTED IN THE FIELD BY THE ENGINEER FOR OTHER TEMPERATURES.
- 6) STD. SPLICE HOLES ONLY IN BRIDGE RAIL TUBES. REST TO BE DRILLED BY CUSTOMER. FIELD DRILLED HOLES TO BE COATED WITH AN APPROVED ZINC-RICH PAINT PRIOR TO INSTALLATION.
- 7) BOLTS SHALL BE TORQUED SNUG TIGHT (APPROXIMATELY 100 FT-LB).
- 8) SEE STANDARD DRAWING G-18 FOR DETAILS OF DELINEATORS. A DELINEATOR SHALL BE INSTALLED AT 30 FOOT SPACING OR THE NEAREST POST. WHITE IS TO BE INSTALLED ON THE DRIVER'S RIGHT. FOR ONE WAY BRIDGES, YELLOW IS TO BE INSTALLED ON THE DRIVER'S LEFT. PAYMENT FOR DELINEATORS SHALL BE INCIDENTAL TO OTHER ITEMS.
- 9) ANY BENDING OF RAIL SHALL BE DONE AT THE FABRICATION PLANT ACCORDING TO A PROCEDURE PROVIDED BY THE FABRICATOR.
- 10) THE MINIMUM DISTANCE FROM THE POST TO AN EXPANSION JOINT SHALL BE DETERMINED BY THE MINIMUM EDGE DISTANCE OF 5" FROM ANY ANCHOR STUD TO THE END OF THE SLAB, OR THE EXPANSION JOINT RECESS POUR, IF ONE IS USED.
- 11) PROTRUSIONS CAUSED BY WELDING OR GALVANIZING ARE NOT PERMITTED ON THE ADJOINING SURFACES OF THE BOX BEAM RAILS, SPLICE TUBES AND FILL PLATES.
- 12) THIS RAILING MEETS THE REQUIREMENTS FOR A TL-4 SERVICE LEVEL.

ITEM #: 525.335

SHEET 1 OF 2

STRUCTURAL STEEL TO COMPLY W/ ASTM A6

**BRIDGE RAIL DETAILS SHEET**

JOHNSON, VT ROUTE 15 (MINOR ARTERIAL) BRIDGE # 32  
TOWN OF JOHNSON, COUNTY OF LAMOILLE, VT.

TOLERANCE UNLESS OTHERWISE NOTED:  
FRACTIONS = ± 1/16"  
ANGLES = ± 1/2"  
DIAMETERS = ± 1/32"

R NO.	DATE	DESCRIPTION	BY	R NO.	DATE	DESCRIPTION	BY
1	12/28/14	REVISED PER 12/22/14 MARK-UP	E.P.				

**ELDERLEE, INC.**  
OAKS CORNERS, NEW YORK 14518  
E-Mail: [dlong@elderlee.com](mailto:dlong@elderlee.com), [epcek@elderlee.com](mailto:epcek@elderlee.com)  
Tel: 315-789-6670 Fax: 315-789-6616




DRAWN  
 CHECKED  
 APPROVED  
 SCALE  
 SCHEMATIC

E.P. 11/1/14  
 D.L. 11/18/14  
 DRAWING NO. F.R. LAFAYETTE-JOHNSON

**SECTION**

**ELEVATION  
STEEL BRIDGE RAILING**

**SPLICE BAR - FIXED**

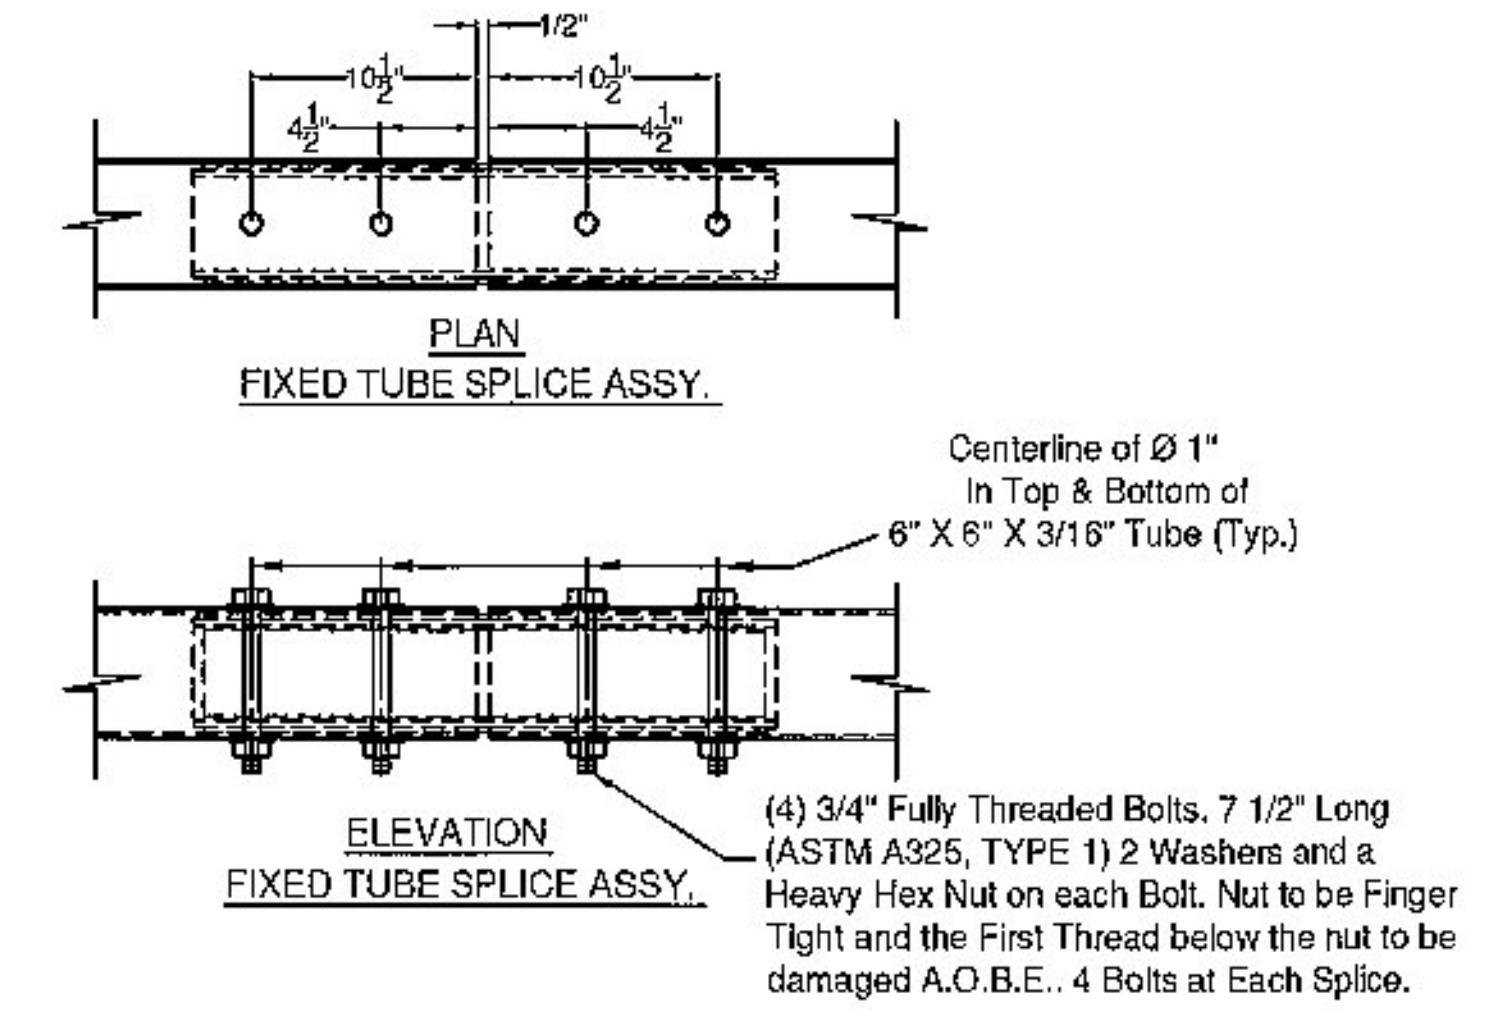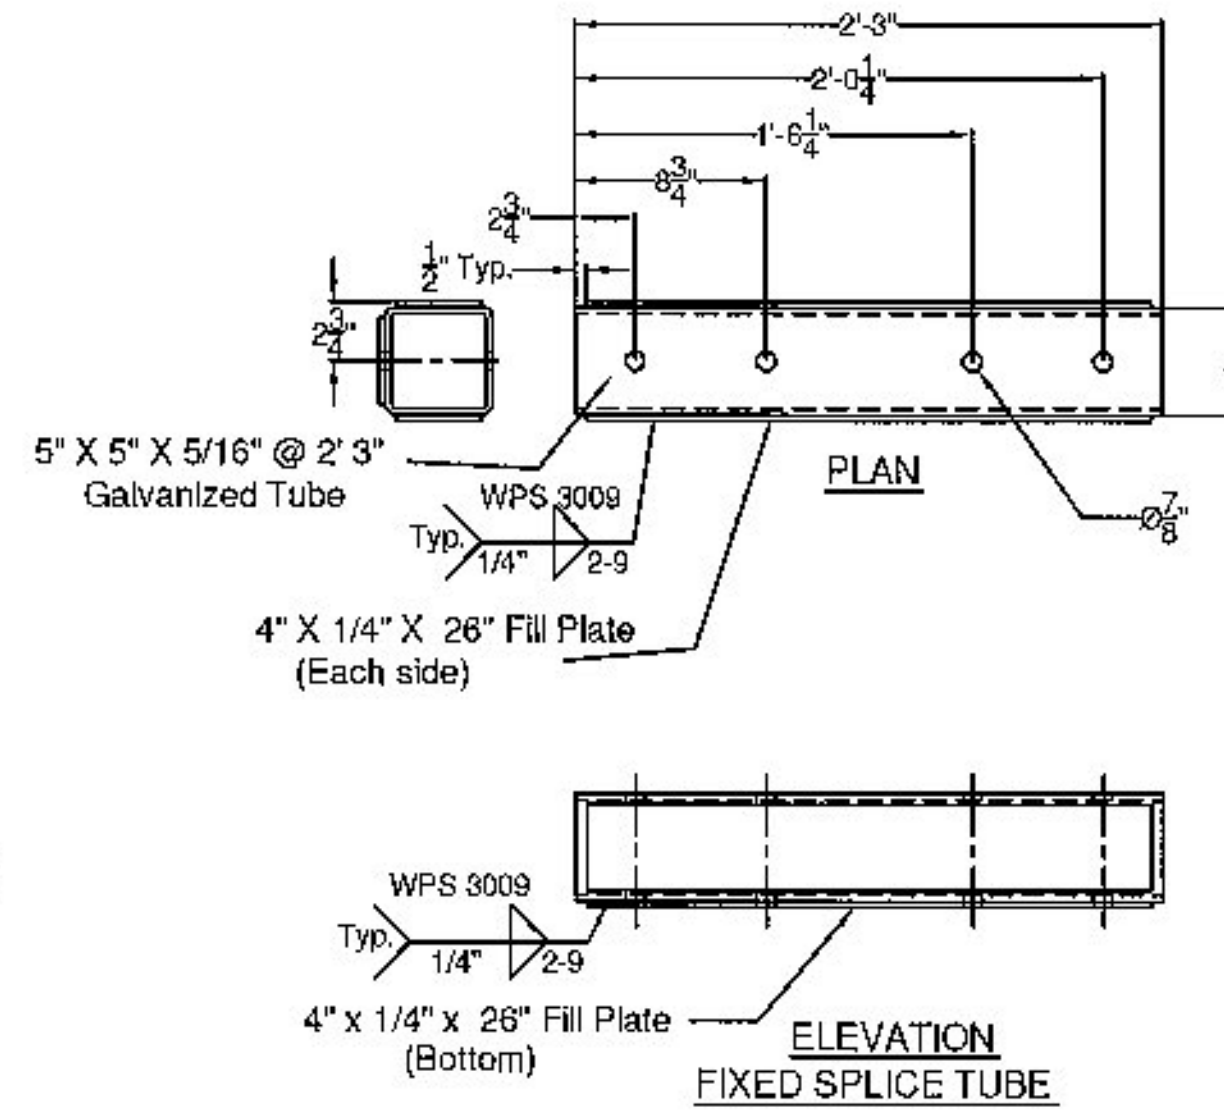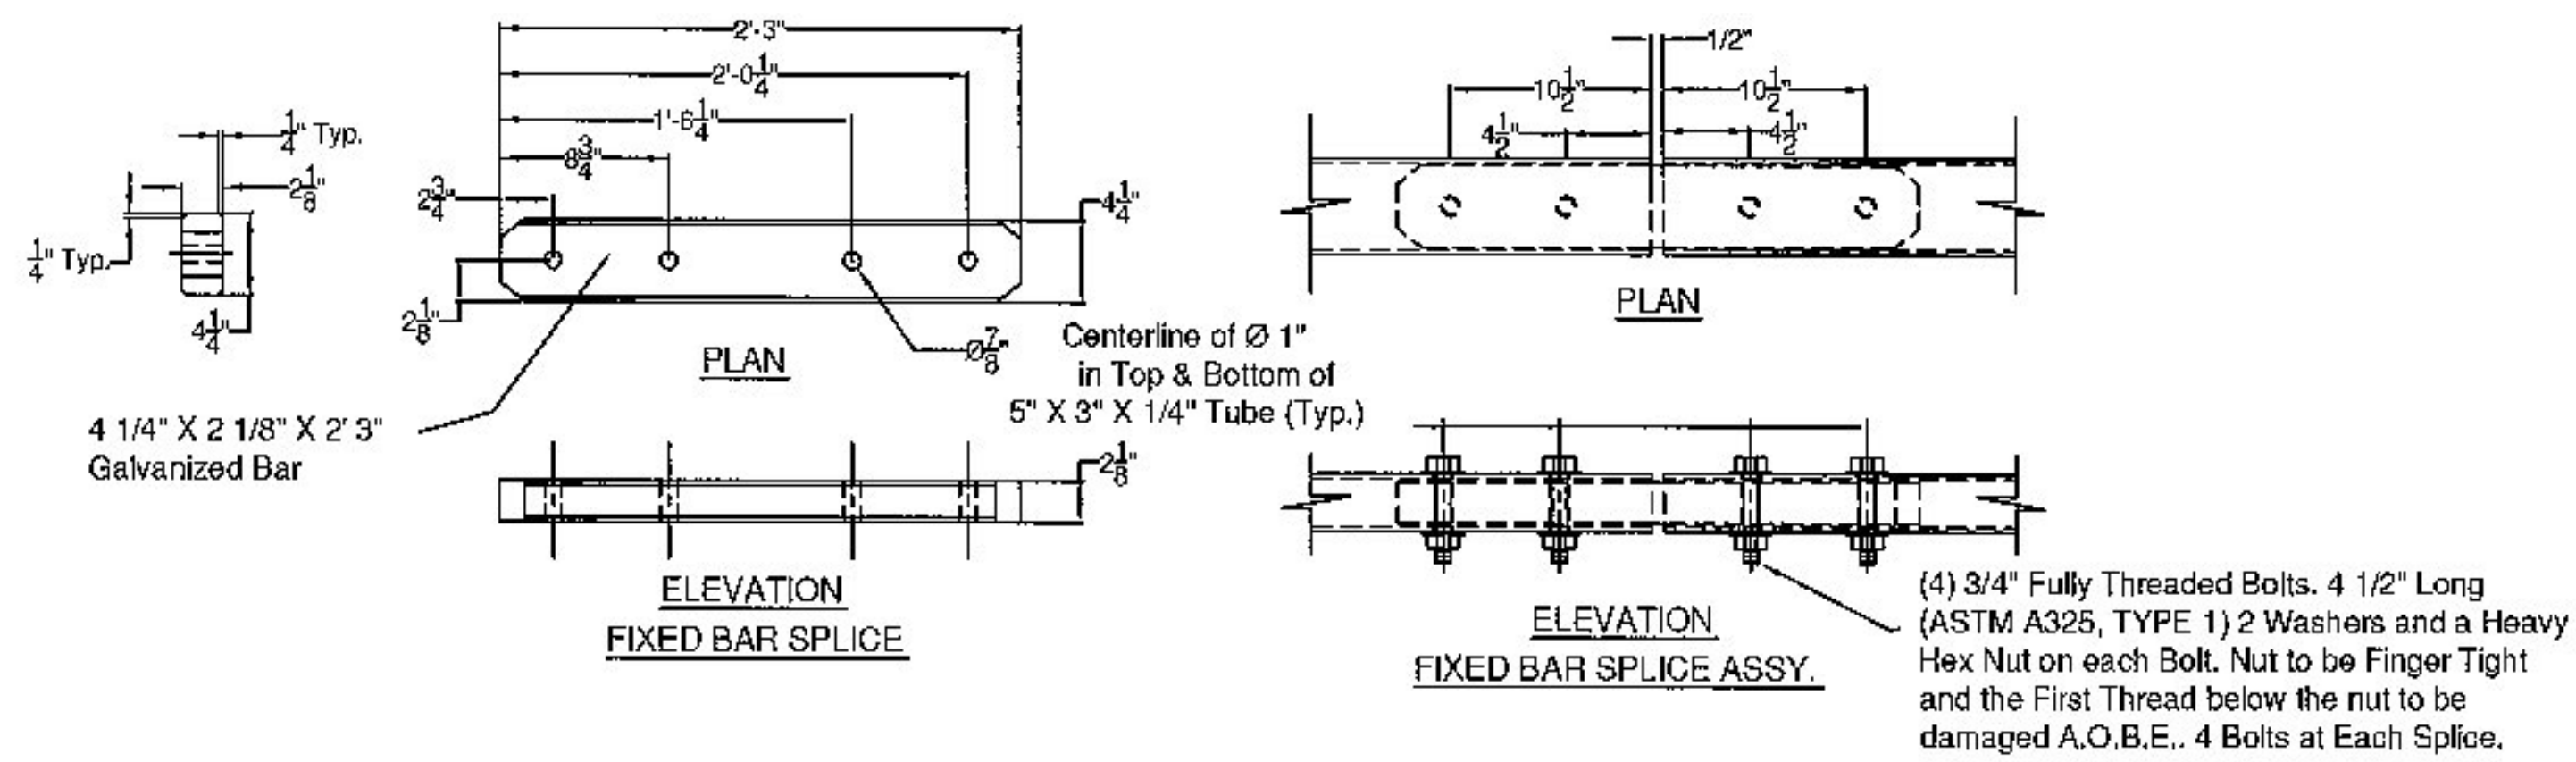

**SPLICE TUBE - FIXED**





Vermont Agency of Transportation  
**RECEIVED**

CK'D BY CLB OK'D BY HIS

January 7, 2015

RESUBMIT NO Approved  
BY C. CARLSON DATE 01/07/15

**BRIDGE POST DETAIL**

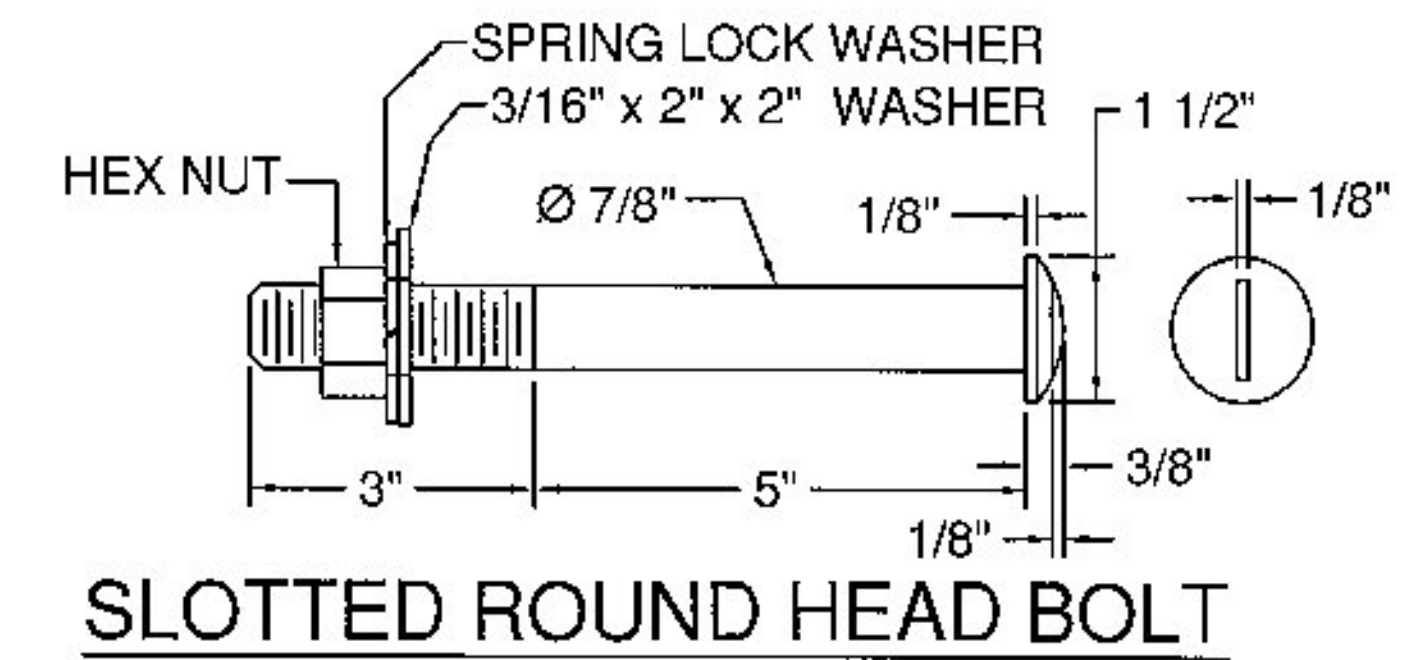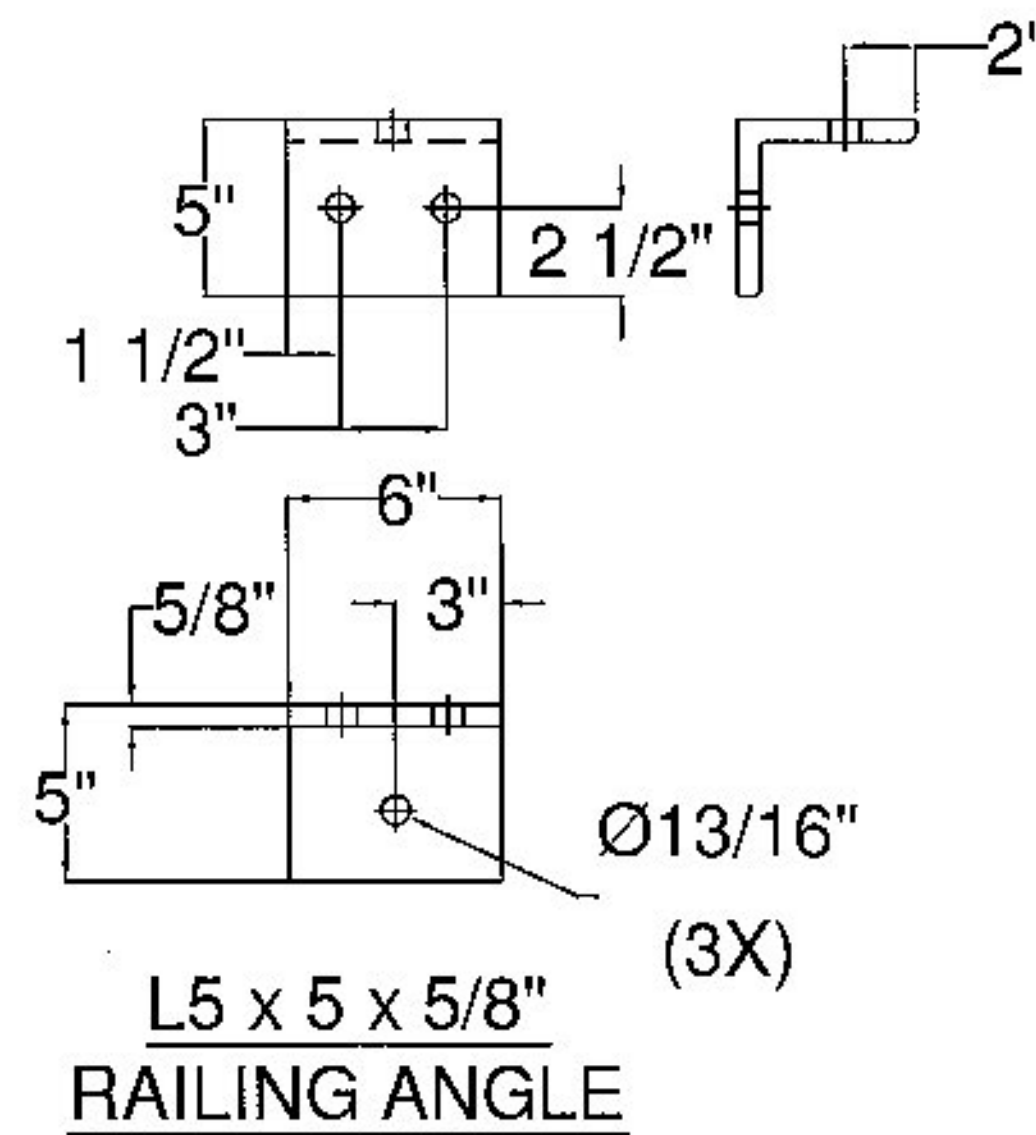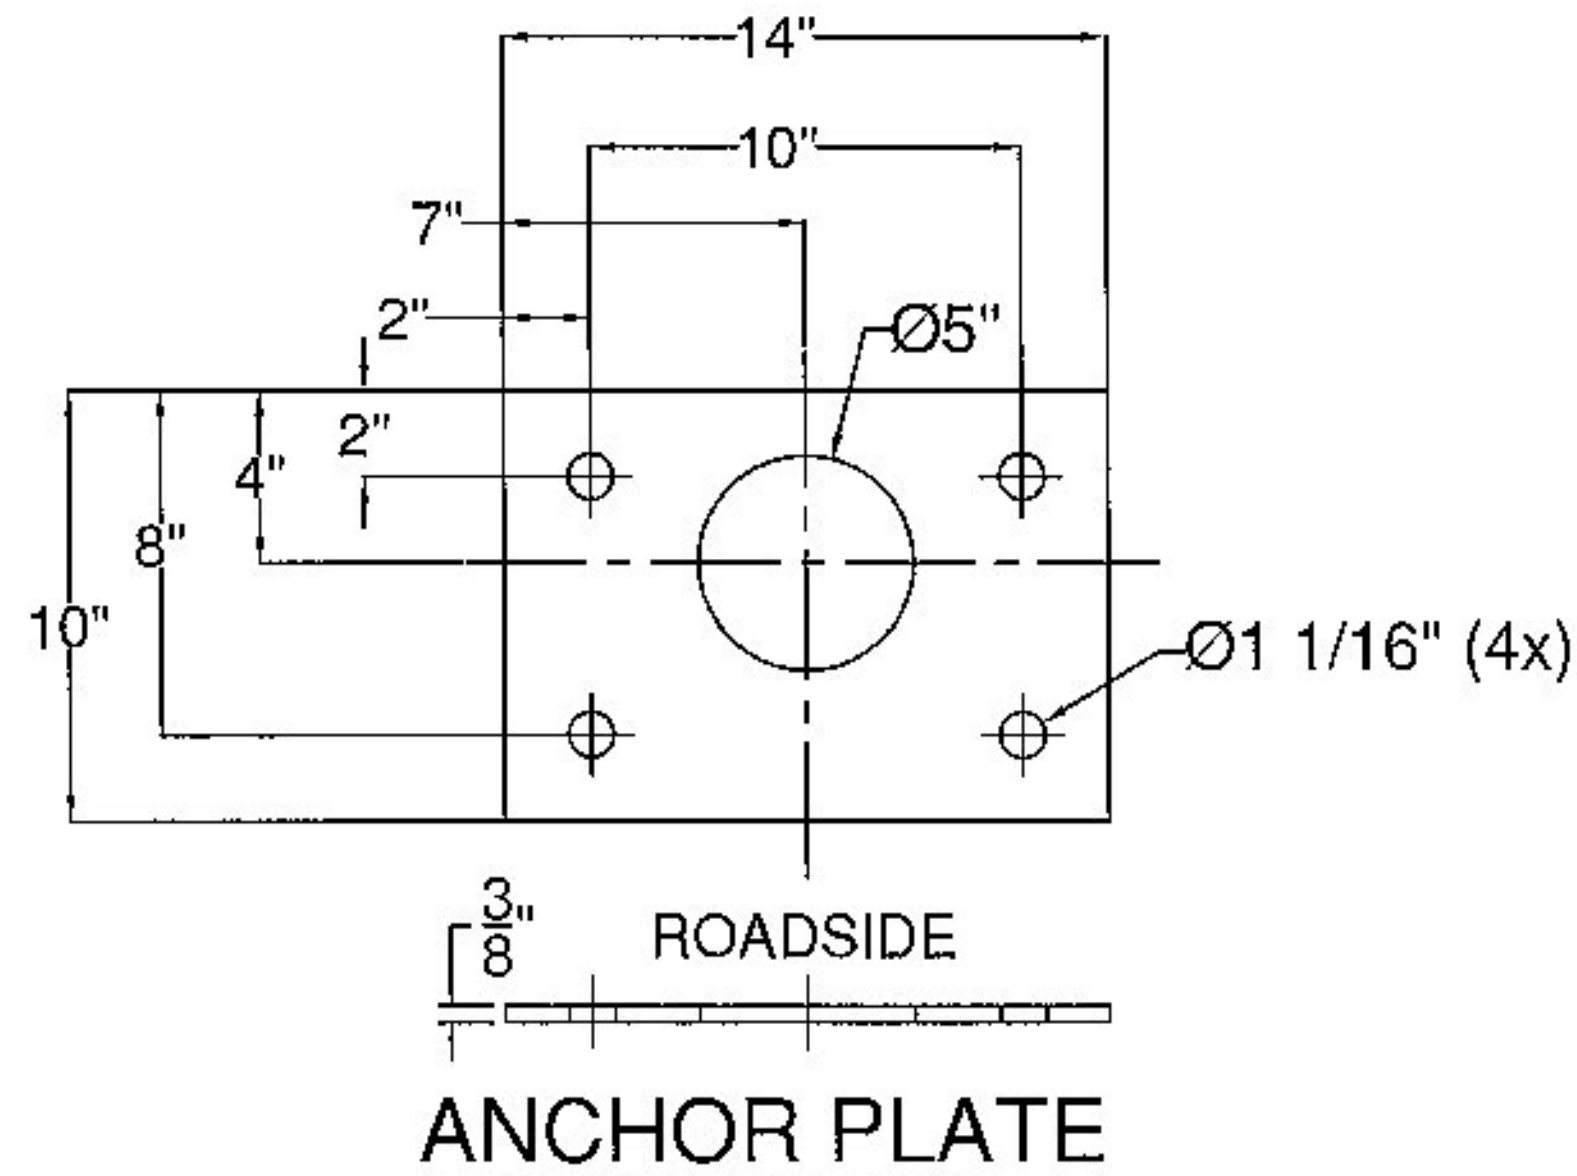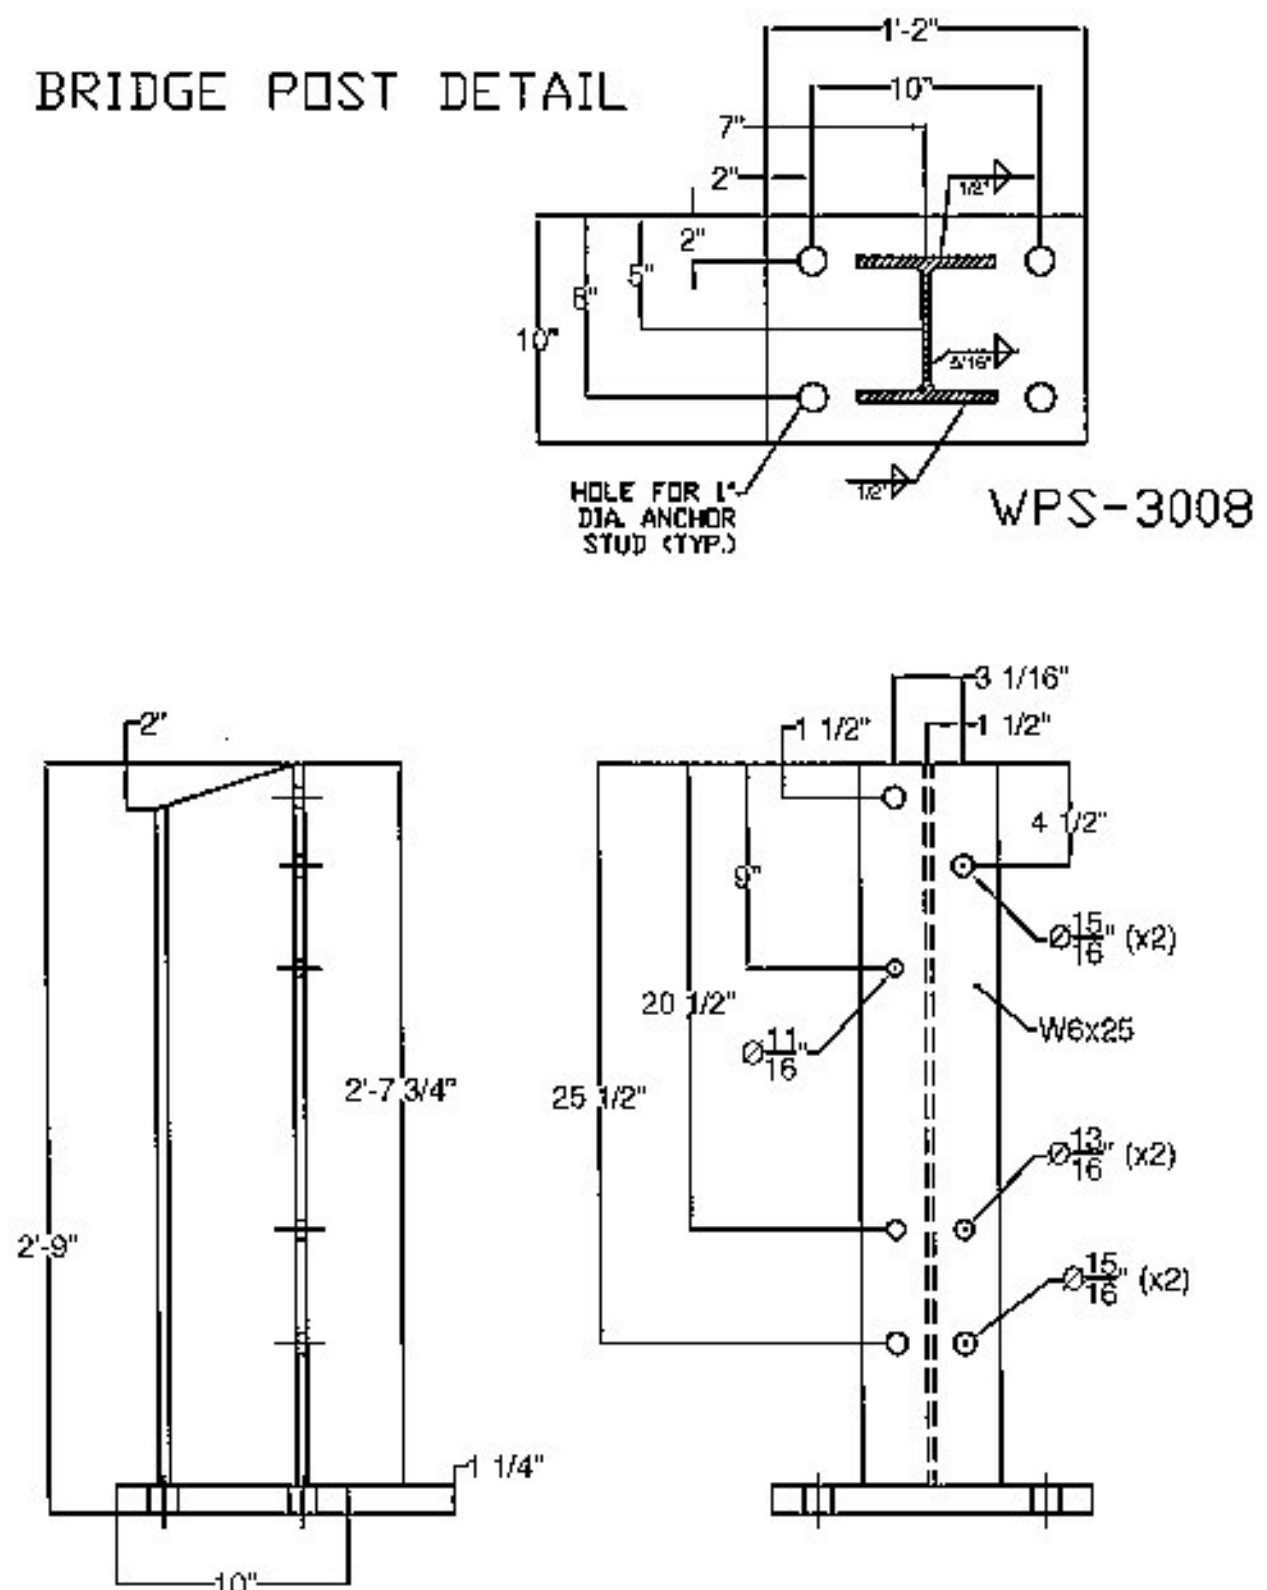

ITEM #: 525.335

SHEET 2 OF 2

STRUCTURAL STEEL TO COMPLY W/ ASTM A6

TOLERANCE UNLESS OTHERWISE NOTED:  
FRACTIONS =  $\pm 1/16"$   
ANGLES =  $\pm 1/2"$   
DIAMETERS =  $\pm 1/32"$

**BRIDGE RAIL DETAILS SHEET**

JOHNSON, VT ROUTE 15 (MINOR ARTERIAL) BRIDGE #32  
TOWN OF JOHNSON, COUNTY OF LAMOILLE, VT.

R NO.	DATE	DESCRIPTION	BY	R NO.	DATE	DESCRIPTION	BY
E 1	12/23/14	REVISED PER 12/22/14 MARK-UP	E.P.				
V			V				

DRAWN	E.P.	11/11/14
CHECKED	D.L.	11/18/14
APPROVED		
SCALE	SCHEMATIC	
DRAWING NO. P.R. LAFAYETTE-JOHNSON		



**ELDERLEE, INC.**  
OAKS CORNERS, NEW YORK 14512  
E-Mail: [dlong@elderlee.com](mailto:dlong@elderlee.com), [epcek@elderlee.com](mailto:epcek@elderlee.com)  
Tel: 315-789-6670 Fax: 315-789-6615

