


GUARD RAIL TO BRIDGE RAIL TRANSITION

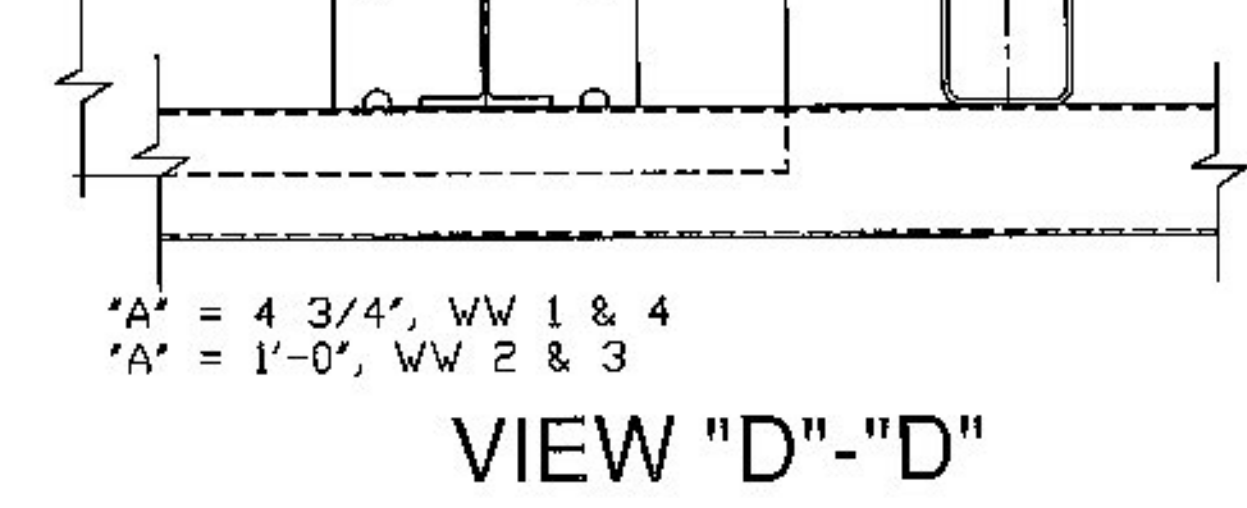

ITEM #: 621.725
 STRUCTURAL STEEL TO COMPLY W/ ASTM A6
 TOLERANCE UNLESS OTHERWISE NOTED:
 FRACTIONS = ± 1/16"
 ANGLES = ± 1/2"
 DIAMETERS = ± 1/32"

Vermont Agency of Transportation

RECEIVED

CK'D BY CLB OK'D BY HIS

January 19, 2015

RESUBMIT NO BY C. CARLSON

Approved DATE 01/20/15

*A' = 4 3/4", WW 1 & 4
 *A' = 1'-0", WW 2 & 3