


PROFILE VT 11

NOTES:
 GRADES SHOWN TO THE NEAREST TENTH ARE EXISTING GROUND ALONG ϕ .
 GRADES SHOWN TO THE NEAREST HUNDREDTH ARE FINISH GRADE ALONG ϕ .

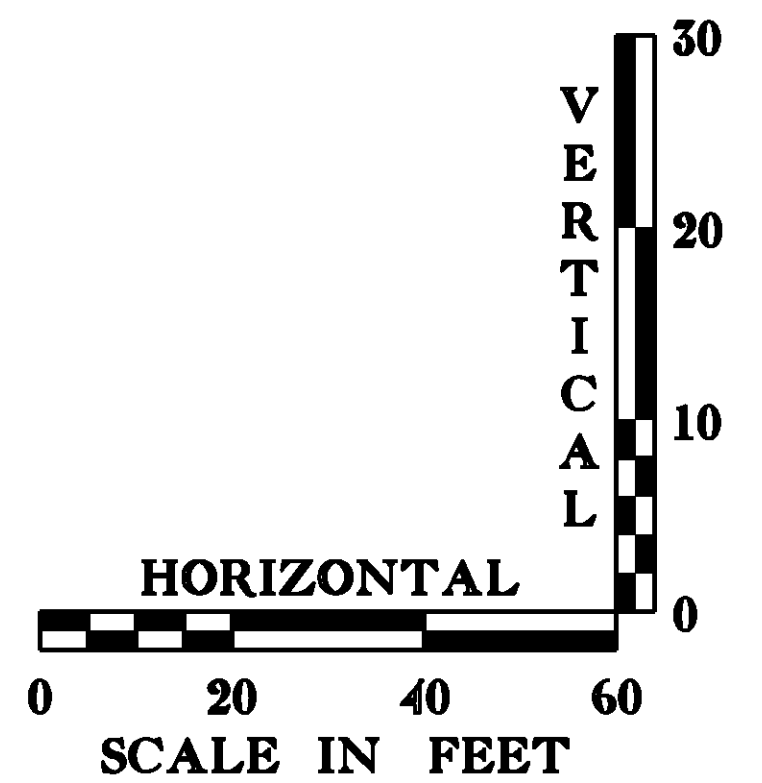

PROFILE VT 11

PROJECT: CHESTER	PROJECT NO.: BRF 016-1 (25)
DESIGN FILE NAME: 88b194/structures/s88b194pro1.dgn	PLOT DATE: 16-MAR-2011
IPARM FILE NAME: s88b194pro1.dgn	DRAWN BY: M. GAGULIC
DESIGNED BY: E. L. RUSTAY	CHECKED BY: R. S. YOUNG
SQUAD LEADER: C. P. WILLIAMS	SHEET: 9 OF 50
VT 11 PROFILE	