


- NOTES:**
- NF = NEAR FACE
  - FF = FAR FACE
  - EF = EACH FACE
  - ▲ = CUT TO FIT IN FIELD
  - 3" CLEAR UNLESS OTHERWISE SPECIFIED ON THE PLANS
  - ALL LAPS 2'-2" UNLESS OTHERWISE NOTED.
  - ALL REINFORCING STEEL SHALL BE EPOXY COATED.

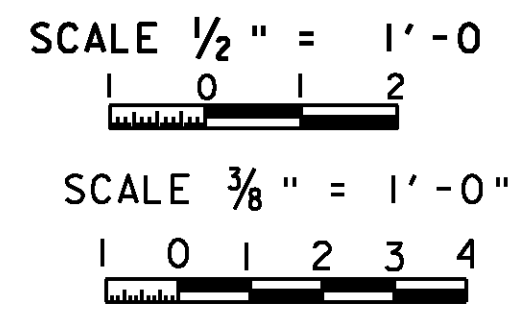

\* 1/4" WIDE X 1/2" SAW CUT INTO CONCRETE TO BE MADE DURING THE SAME WORKDAY AS PLACEMENT. SEE DETAIL SHEET 21.

\*\* DISTANCES PER JOINT MANUFACTURER'S RECOMMENDATIONS. DESIGN BASED ON TEMPERATURE RANGE FROM -15°F TO 105°F, WITH 1/2" EXPANSION. 9" MINIMUM BLOCKOUT REQUIRED.

\*\*\* TILT BAR TO MAINTAIN 3" CLR AT TOP.

PROJECT: <b>CHESTER</b>	PROJECT NO.: <b>BRF 016-1 (25)</b>
DESIGN FILE NAME: 88b194\Structures\s88b194aps.dgn	PLOT DATE: 16-MAR-2011
IPARM FILE NAME: s88b194aps.i	DRAWN BY: E.L. RUSTAY
DESIGNED BY: E.L. RUSTAY	CHECKED BY: R.S. YOUNG
SQUAD LEADER: C.P. WILLIAMS	SHEET: 27 OF 50
APPROACH SLAB DETAILS	