


**EPSC EXISTING CONDITIONS  
SITE PLAN SHEET - 2**

PROJECT: CHESTER	PROJECT NO.: BRF 016-1 (25)
DESIGN FILE NAME: 88b194/str/s88b194bdr_ero.dgn	PLOT DATE: 16-MAR-2011
IPARM FILE NAME: s88b194excon2.i	DRAWN BY: M. FESSEL
DESIGNED BY: K.M. HIGGINS	CHECKED BY: K.M. HIGGINS
SQUAD LEADER: C.P. WILLIAMS	SHEET: 37 OF 50
EPSC EXISTING CONDITIONS - SHEET 2	

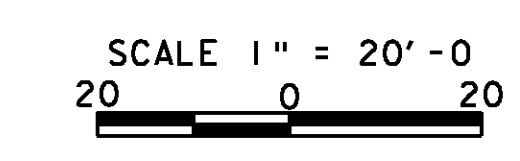

LEGEND	
— AER E&T — · · ·	AERIAL ELECTRIC & TELEPHONE

DATUM	
VERTICAL	NAVD 88
HORIZONTAL	NAD 83 (96)