




12+50

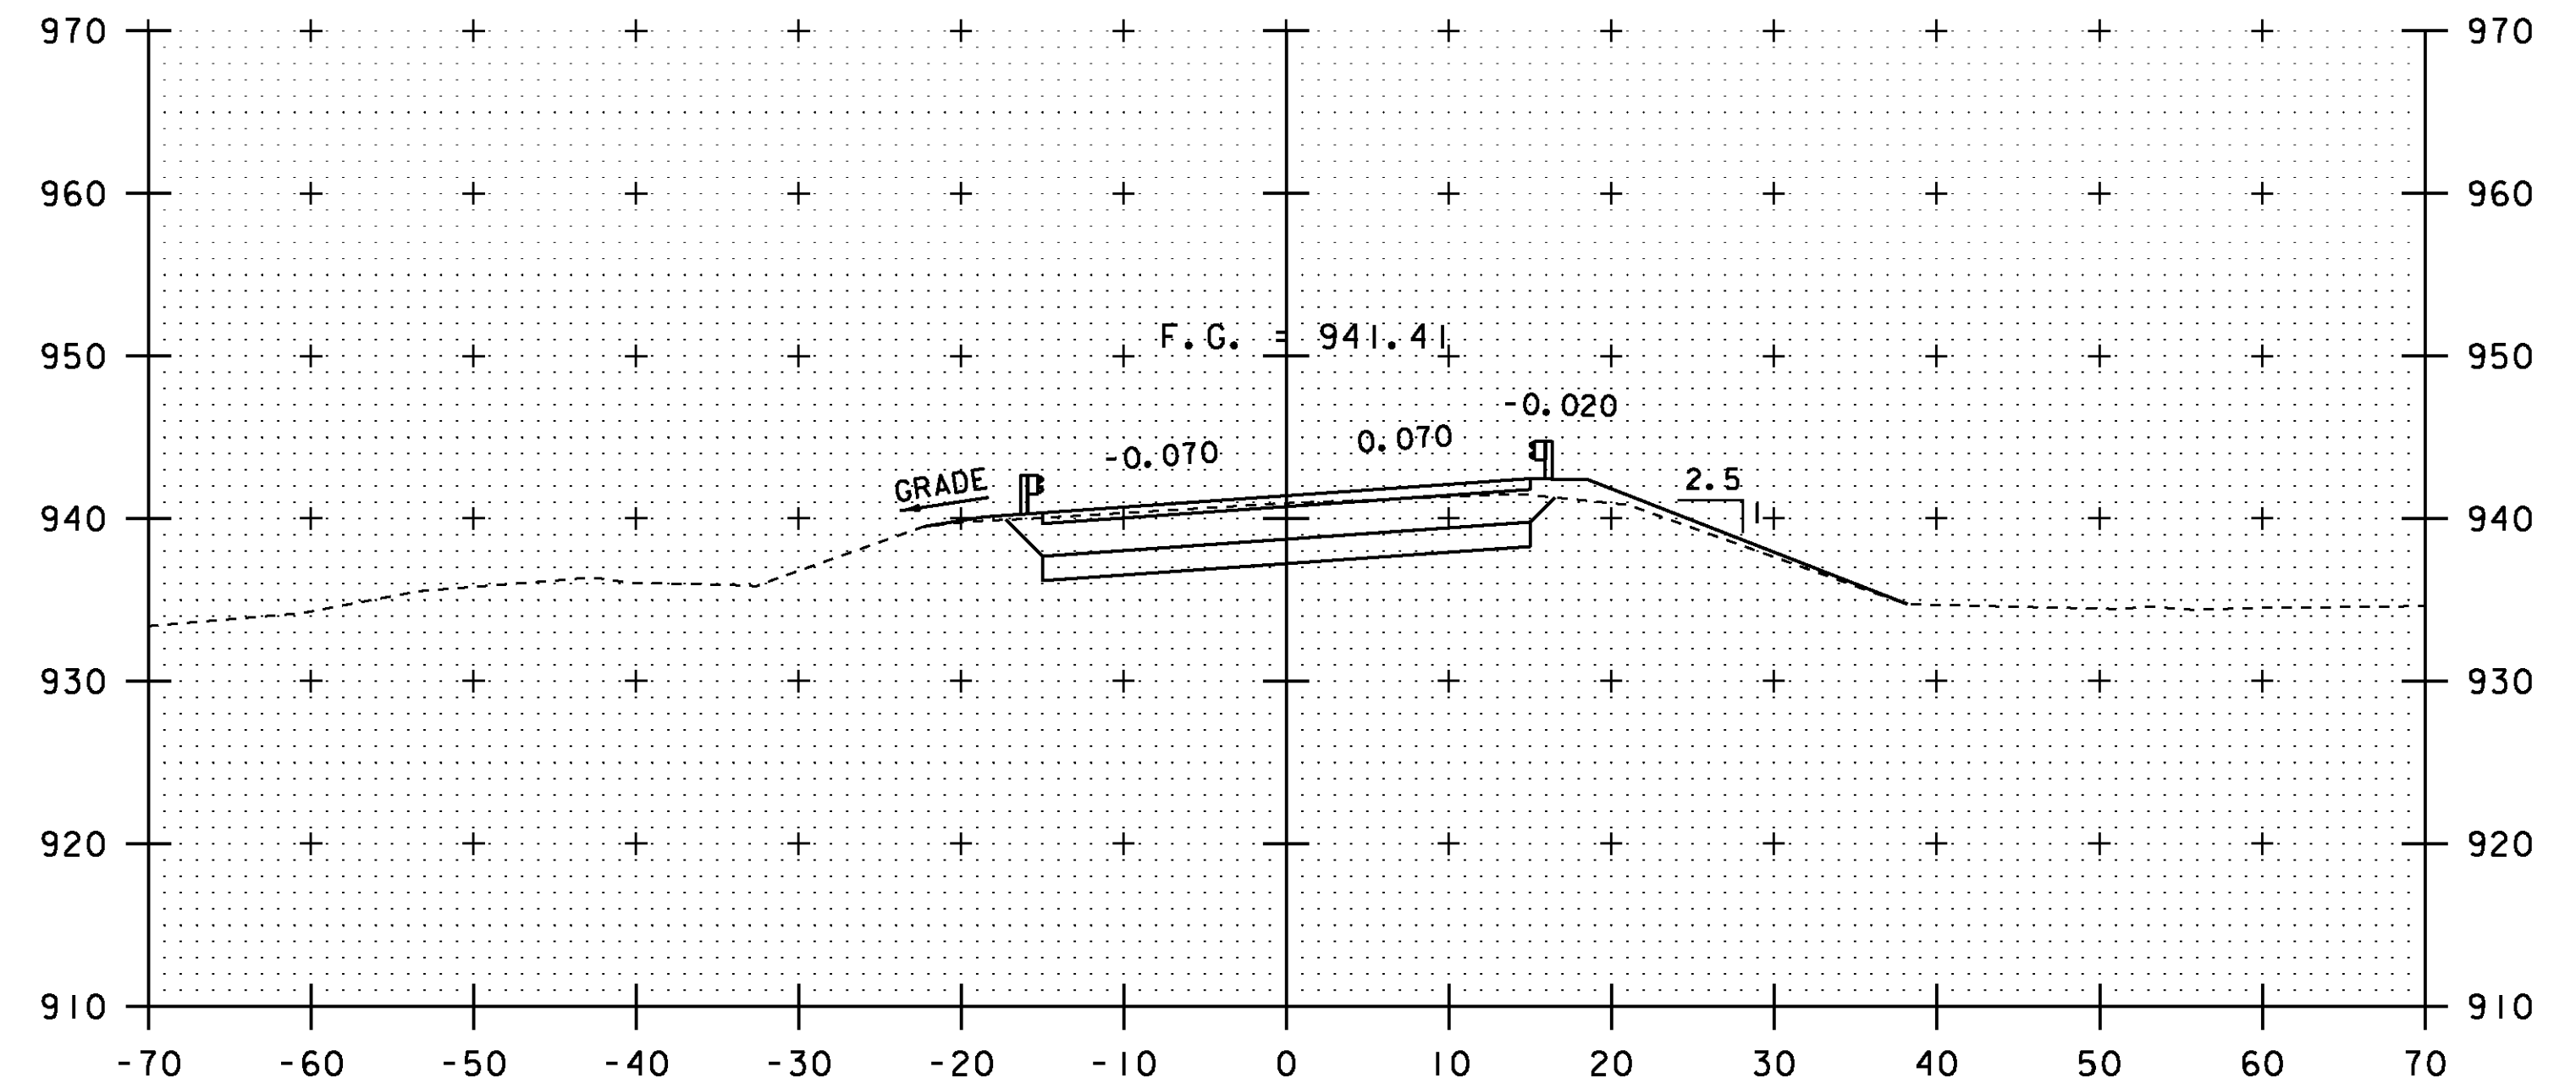

13+50

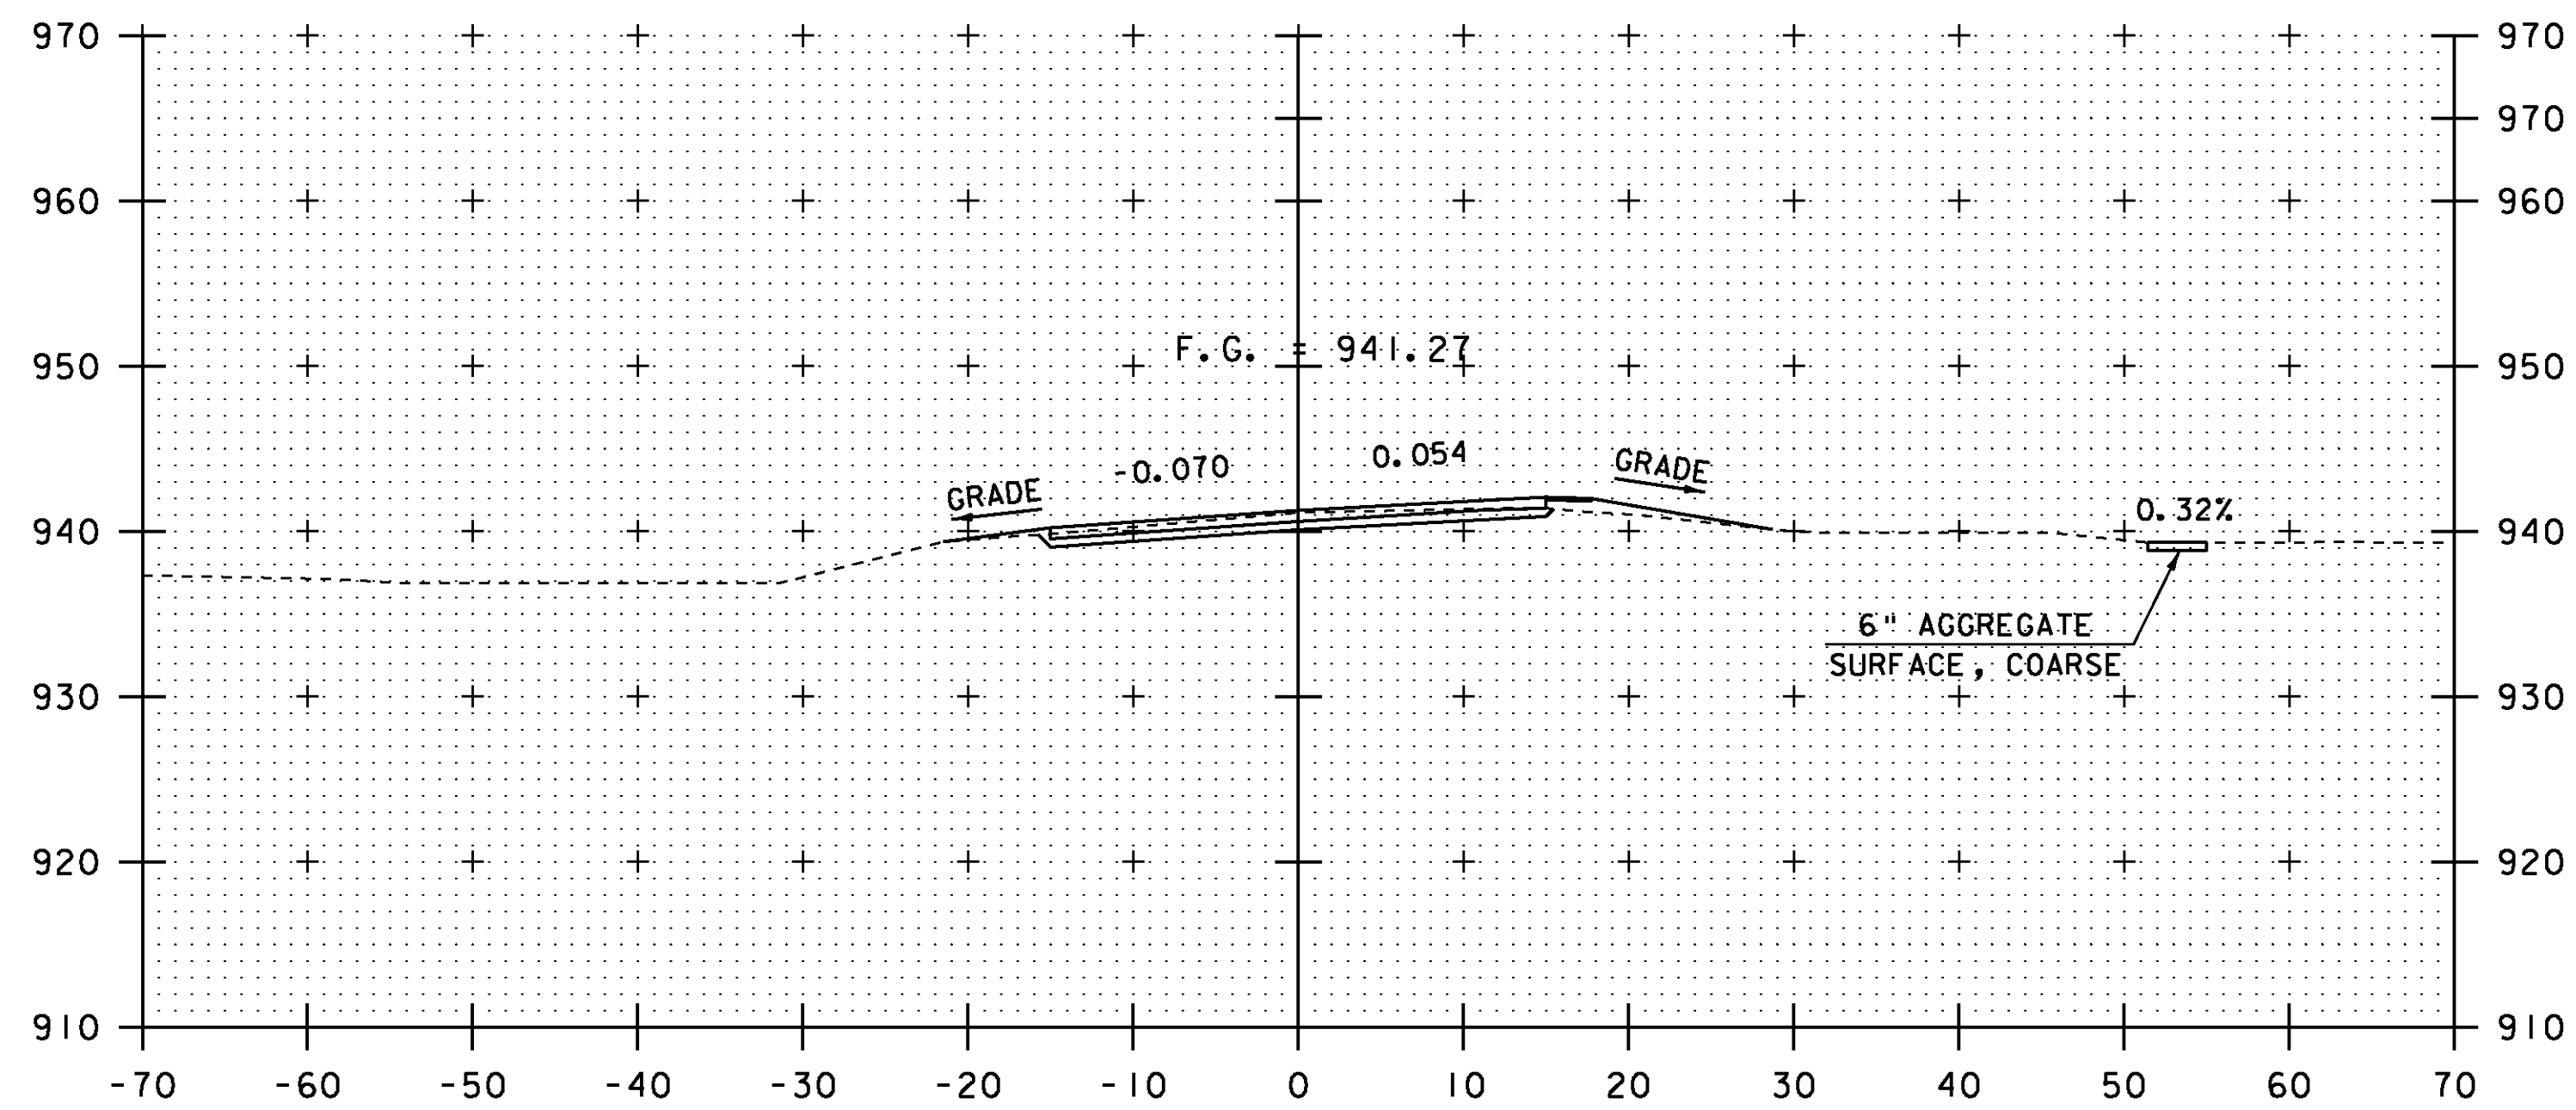


12+00  
DRIVE RIGHT

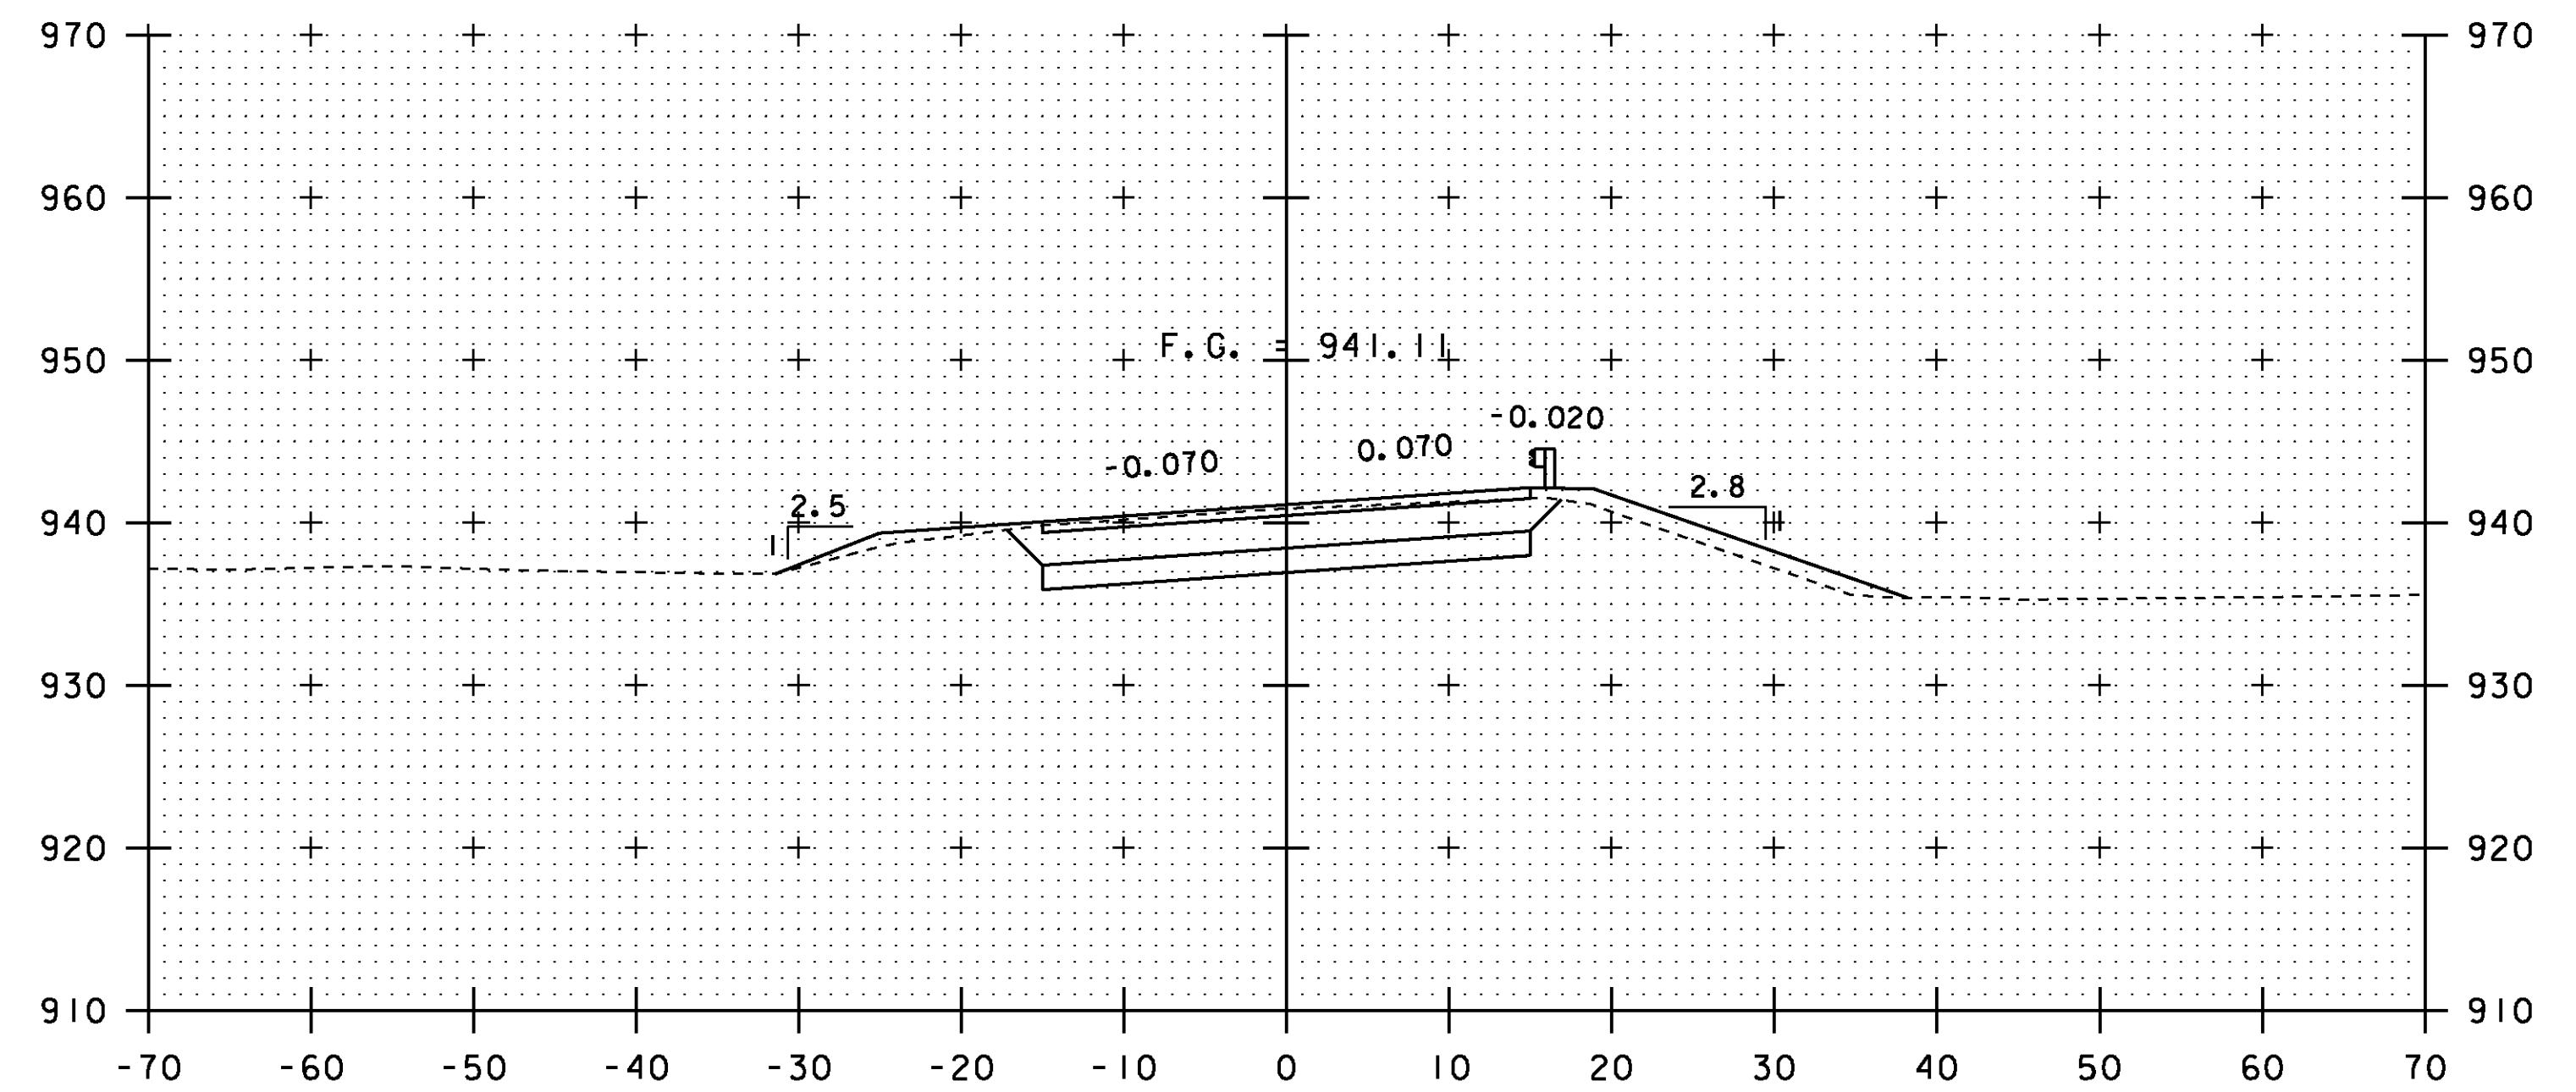

13+00  
BEGIN PROJECT

STA. 12+00 TO STA. 13+50

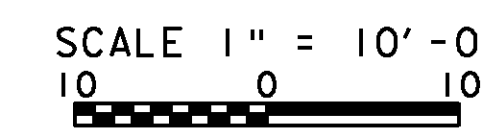

PROJECT:	CHESTER	PROJECT NO.:	BRF 016-1 (25)
DESIGN FILE NAME:	88b194/structures/s88b194xsl.dgn	PLOT DATE:	16-MAR-2011
IPARM FILE NAME:	s88b194m12.i	DRAWN BY:	M. FESSEL
DESIGNED BY:	E. L. RUSTAY	CHECKED BY:	R. S. YOUNG
SQUAD LEADER:	C. P. WILLIAMS	MAINLINE CROSS SECTIONS	SHEET: 45 OF 50